

A SET OF AS-BUILT PLANS FOR **PENNIAL PARK** PHASE 3

A TRACT OF LAND BEING PART OF FRACTIONAL SECTION 4,
TOWNSHIP 46 NORTH, RANGE 3 EAST
OF THE FIFTH PRINCIPAL MERIDIAN,
CITY OF O'FALLON, ST. CHARLES COUNTY, MISSOURI

GRADING NOTES

- A Geotechnical Engineer shall be employed by the owner and be on site during grading operations. All soils tests shall be verified by the Geotechnical Engineer concurrent with the grading and backfilling operations.
- The grading contractor shall perform a complete grading and compaction operation as shown on the plans, stated in these notes, or reasonably implied there from, all in accordance with the plans and notes as interpreted by the Geotechnical Engineer.
- The Contractor shall notify the Soils Engineer at least two days in advance of the start of the grading operation.
- All areas shall be allowed to drain. All low points shall be provided with temporary ditches.
- A sediment control plan that includes monitored and maintained sediment control basins and/or straw bales should be implemented as soon as possible. No graded area is to be allowed to remain bare without being seeded and mulched. Care should be exercised to prevent soil from damaging adjacent property and silting up existing downstream storm drainage system.
- Debris and foundation material from any existing on-site building or structure which is scheduled to be razed for this development must be disposed of off-site.
- All trash and debris on site, either existing or from construction, must be removed and properly disposed of off-site.
- Soft soil in the bottom and banks of any existing or former pond sites or tributaries or on any sediment basins or traps should be removed, spread out and permitted to dry sufficiently to be used as fill. None of this material should be placed in proposed public right-of-way locations or on any storm sewer locations.
- Site preparation includes the clearance of all stumps, trees, bushes, shrubs, and weeds; the grubbing and removal of roots and other surface obstructions from the site; and the demolition and removal of any man-made structures. The material shall be properly disposed of off-site. Topsoil and grass in the fill areas shall be thoroughly disced prior to the placement of any fill. The Soils Engineer shall approve the discing operation.
- Compaction equipment shall consist of tamper rollers, pneumatic-tire rollers, vibratory roller, or high speed impact type drum rollers acceptable to the Soils Engineer. The roller shall be designed so as to avoid the creation of a layered fill without proper blending of successive fill layers.
- The Soils Engineer shall observe and test the placement of the fill to verify that specifications are met. A series of fill density tests will be determined on each lift of fill. Interim reports showing fill quality will be made to the Owner at regular intervals.
- The Soils Engineer shall notify the Contractor of rejection of a lift of fill or portion thereof. The Contractor shall rework the rejected portion of fill and obtain notification from the Soils Engineer of its acceptance prior to the placement of additional fill.
- All areas to receive fill shall be scarified to a depth of not less than 6 inches and then compacted in accordance with the specifications given below. Natural slopes steeper than 1 vertical to 5 horizontal to receive fill shall have horizontal benches, cut into the slopes before the placement of any fill. The width and height to be determined by the Soils Engineer. The fill shall be loosely placed in horizontal layers not exceeding 8 inches in thickness and compacted in accordance with the specifications given below. The Soils Engineer shall be responsible for determining the acceptability of soils placed. Any unacceptable soils placed shall be removed at the Contractor's expense.
- The sequence of operation in the fill areas will be fill, compact, verify acceptable soil density, and repetition of the sequence. The acceptable moisture contents during the filling operation are those at which satisfactory dry densities can be obtained. The acceptable moisture contents during the filling operation in the remaining areas are from 2 to 8 percent above the optimum moisture control.
- The surface of the fill shall be finished so that it will not impound water. If at the end of a day's work it would appear that there may be rain prior to the next working day, the surface shall be finished smooth. If the surface has been finished smooth for any reason, it shall be scarified before proceeding with the placement of succeeding lifts. Fill shall not be placed on frozen ground, nor shall filling operations continue when the temperature is such as to permit the layer under placement to freeze.
- Fill and backfill should be compacted to the criteria specified in the following table:

CATEGORY	MINIMUM PERCENT COMPACTION
Fill in building areas below footings	90%
Fill under slabs, walks, and pavement	90%
Fill other than building areas	88%
Natural subgrade	88%
Pavement subgrade	90%
Pavement base course	90%

Measured as a percent of the maximum dry density as determined by modified Proctor Test (ASTM-D-1557).

Moisture content must be within 2 percent below or 4 percent above optimum moisture content if fill is deeper than 10 feet.

GENERAL NOTES

- Underground utilities have been plotted from available information and therefore their locations shall be considered approximate only. The verification of the location of all underground utilities, either shown or not shown on these plans shall be the responsibility of the contractor, and shall be located prior to any grading or construction of the improvements.
- All manhole tops & flowlines built without elevations furnished by the Engineer will be the responsibility of the sewer contractor.
- 8" P.V.C. sanitary sewer pipe shall meet the following standards. A.S.T.M.-D-3034 SDR-35, with wall thickness compression joint A.S.T.M.-D-3212. An appropriate rubber seal watertop as approved by the sewer district shall be installed between P.V.C. pipe and masonry structures.
- All filled places, including trench backfills, under buildings, proposed storm and sanitary sewer lines and/or paved areas, shall be compacted to 90% maximum density as determined by the "Modified AASHTO T-180 Compaction Test." All filled places within public roadways shall be compacted to 95% of maximum density as determined by the "Standard Proctor Test AASHTO T-99, Method C" (A.S.T.M.-D-698).
- All trench backfills under paved areas shall be granular backfill, and shall be compacted to 90% of the maximum density as determined by the "Modified AASHTO T-180 Compaction Test," (A.S.T.M.-D-1557). All other trench backfills may be earth material (free of large clogs or stones). All trench backfills shall be water jetted.
- All sanitary house connections have been designed so that the minimum vertical distance from the low point of the basement to the flow line of a sanitary sewer at the corresponding house connection is not less than the diameter of the pipe plus the vertical distance of 2 1/2 feet.
- No area shall be cleared without the permission of the Project Engineer.
- All P.V.C. sanitary sewer is to be SDR-35 or equal with clean 1/2" to 1" granular stone bedding uniformly graded. This bedding shall extend from 4" below the pipe to the springline of the pipe. Immediate backfill over pipe shall consist of some size "clean" or minus stone from springline of pipe to 6" above the top of pipe.
- All sanitary and storm sewer trench backfills shall be water jetted. Granular backfill will be used under pavement areas.
- All existing areas disturbed during construction of the off-site sanitary sewer line shall be seeded and mulched to prevent erosion.
- All soils test shall be verified by a Soils Engineer concurrent with the grading and backfilling operations.
- Easements shall be provided for sanitary sewers, and all utilities on the Record Plat. See Record Plat for location and size of easements.
- Maintenance and upkeep of the common ground area shall be the responsibility of the developer and/or successors.
- A 25' building line shall be established along all Public Rights-Of-Way.
- All water lines shall be laid at least 10 feet horizontally, from any sanitary sewer, storm sewer, or manhole. 18" vertical clearance from outside of pipe to outside of pipe shall be maintained wherever water lines must cross sanitary sewers, laterals, or storm drains. The water line shall be laid at such an elevation that the bottom of the water line is above the top of the drain or sewer. A full length of water pipe shall be centered over the sewer line to be crossed so that the joints will be equally distant from the sewer end as remote from that portion of the water line located within 10 feet horizontally, of any sewer or drain it crosses.
- All PVC water pipe shall conform to A.S.T.M.-D-2241, SDR 21 Standard Specification for P.V.C. Pressure Pipe, 200 P.S.I. working pressure for water, with approved joint.
- Water lines, valves, sleeves, meters, and fittings shall meet all specifications and installation requirements of Public Water Supply District No. 2 of St. Charles County.
- All water hydrants and valves shall be ductile iron and installed in accordance with plans and details. All ductile iron pipe for water mains shall conform to A.W.W.A. Specifications C-106 and/or C-108. The ductile iron fittings shall conform to A.W.W.A. Specification CC-110. All rubber gasket joints for water ductile iron pressure pipe and fittings shall conform to A.W.W.A. Specification C-111.
- All sanitary manholes shall be waterproofed on the exterior in accordance with Missouri Department of Natural Resources specifications 10 CSR-8.120 (7)E.
- Brick will not be used in the construction of sanitary sewer manholes.
- All pipes shall have positive drainage through manholes. No flat base structures are allowed.
- The City of O'Fallon and Duckett Creek Sanitary District shall be notified 48 hours prior to construction for coordination and inspection.
- Gas, water and other underground utilities shall not conflict with the depth or horizontal location of existing or proposed sanitary or storm sewers, including house laterals.

ASBUILTS NOTE:
ALL DISTANCE AND SLOPE CALCULATIONS ARE FROM
CENTER OF STRUCTURE TO CENTER OF STRUCTURE.



DEVELOPMENT NOTES

- Area of Tract: 54.17 Acres
- Existing Zoning: R-1 (City of O'Fallon)
- Proposed Use: Single Family Homes
- Number of Lots Proposed: 153 Lots
- The proposed height and lot setbacks are as follows:
 - Minimum Front Yard: 25 feet
 - Minimum Side Yard: 6 feet
 - Minimum Rear Yard: 25 feet
 - Minimum Lot Area: 10,000 square feet
 - Maximum Height of Building: 2 1/2 stories or 35 feet
- Current Owner/Developer: Kaplan Development Company 5140 North Service Road St. Peters, MO 63376
- Site is served by: Duckett Creek Sanitary District AmerenUE St. Charles Gas Company St. Charles County Public Water District No. 2 Verizon Telephone Company Fort Zumwalt School District O'Fallon Fire Protection District
- No Flood Plain exists on this site per F.I.R.M. #29183 C 0243E, dated Aug. 2, 1996.
- Topographic information is per Walker and Associates Topo on U.S.G.S. Datum.
- Boundary information is per Box Engineering during August, 1999.
- All streets will be constructed to City of O'Fallon standards. Streets will consist of 26 foot wide concrete pavements with integral rolled curbs centered in a 50 foot right-of-way.
- All cul-de-sacs and bubbles will have pavement radii of 42 feet with right-of-way radii of 54 feet. Street intersections shall have a minimum rounding radius of 25 feet with pavement radii of 37 feet.
- Minimum street grades shall be 1%.
- A 4 foot wide concrete sidewalk shall be constructed on one side of streets where indicated.
- All homes shall have a minimum of 2 off-street parking places with 2-car garages.
- All utilities must be located underground.
- The following lots are eligible to street movement:
 - 45, 46, 47, 48, 49, 55, 57, 58, 59, 60, 61, 65, 66, 67, 68, 76, 77, 78, 79, 80, 81, 82, 83, 84, 85, 86, 87, 89, 90, 91, 92, 93, 94, 95, 96, 97, 183, 184, 185, 186, 187, 188, 189, 190, 191, 192, 193, 194, 195, 196, 198, 199, 200, 201, 203, 206, 207, 208, 209, 241, 244, 245, 246, 247, 300, 301, 308, 318, 319, 320, 321, 322, 324, 331, 332, 333, 336, 337, 338, 344, 345, 346.
- Calculations in accordance to the Tree Preservation Ordinance:

Existing trees	0.28 acres
x 20%	0.06 acres
Saved trees	0.07 acres
Trees to be Replaced	No trees to be replaced
- Street Tree Requirements: 1 per lot/2 per corner lot = 177 trees
- Total Required 177 trees

DISCLAIMER OF RESPONSIBILITY
I hereby specify that the documents intended to be used by the contractor and are limited to the information contained on this sheet, and I hereby disclaim any responsibility for any errors or omissions in the drawings, Estimates, Reports or other documents or information which may be furnished to be used for any part or parts of the architecture or engineering project or survey.

Copyright 2000
Box Engineering Company, Inc.
All Rights Reserved

REVISIONS


3-9-07	City Comments

SITE BENCHMARK

R.M. #74 - ELEV.=493.07 (U.S.G.S. DATUM)
CHISELED SQUARE ON TOP OF EAST CONCRETE HEADWALL
OF BIRDIE HILLS ROAD BRIDGE OVER TRIBUTARY NO. 2
(APPROXIMATELY 500 FEET SOUTH OF EISENHOWER DRIVE)



ELEV.=572.28 (U.S.G.S. DATUM)
OLD CROSS CL-CL SWEETBAY DRIVE AND CHERRYWOOD PARC DRIVE
CHERRYWOOD PARK SUBDIVISION

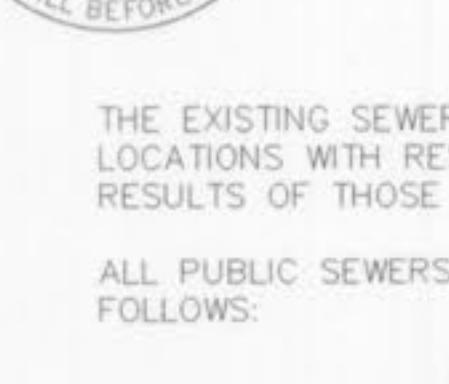

MISSOURI ONE CALL SYSTEM INC.
1-800-344-7487
STOP CALL BEFORE YOU DIG!

SIGNED: _____
P.E./L.S. _____

DATE: 10/29/07

DARREL R.
OAKLEY
WILDERBERGER
LS-228

REGISTERED LAND SURVEYOR

DATE: 10/29/07

DRO
DESIGNED CHECKED

SEWER MEASUREMENTS

THE EXISTING SEWER LENGTHS, SIZES, FLOWLINES, DEPTHS OF STRUCTURES AND SEWERS AND LOCATIONS WITH RESPECT TO EXISTING OR PROPOSED EASEMENTS HAVE BEEN MEASURED. THE RESULTS OF THOSE MEASUREMENTS ARE SHOWN ON THIS SET OF FINAL MEASUREMENT PLANS.

ALL PUBLIC SEWERS ARE LOCATED WITHIN DESIGNATED EXISTING OR PROPOSED EASEMENTS EXCEPT AS FOLLOWS:



DATE: 10/29/07

97-8791

PROJECT NUMBER

1 OF 12

SHEET OF

8791ASBPH3.DWG

FILE NAME

ECF

DRAWN

DRO

DESIGNED CHECKED

CALL BEFORE YOU DIG! 1-800-DIG-RITE



ENGINEERING PLANNING SURVEYING

221 Point West Blvd.

St. Charles, MO 63301

636-928-5552

FAX 928-1718

6-02-04

DATE

97-8791

PROJECT NUMBER

1 OF 12

SHEET OF

8791ASBPH3.DWG

FILE NAME

ECF

DRAWN

DRO

DESIGNED CHECKED


Pennial Park Phase 3
As built 1/12

AN AS-BUILT SITE PLAN FOR
PENNIAL PARK
PHASE 3

6-02-04

96-8791

PROPERTY N/F
TJC DEVELOPMENT, INC.
3009/647

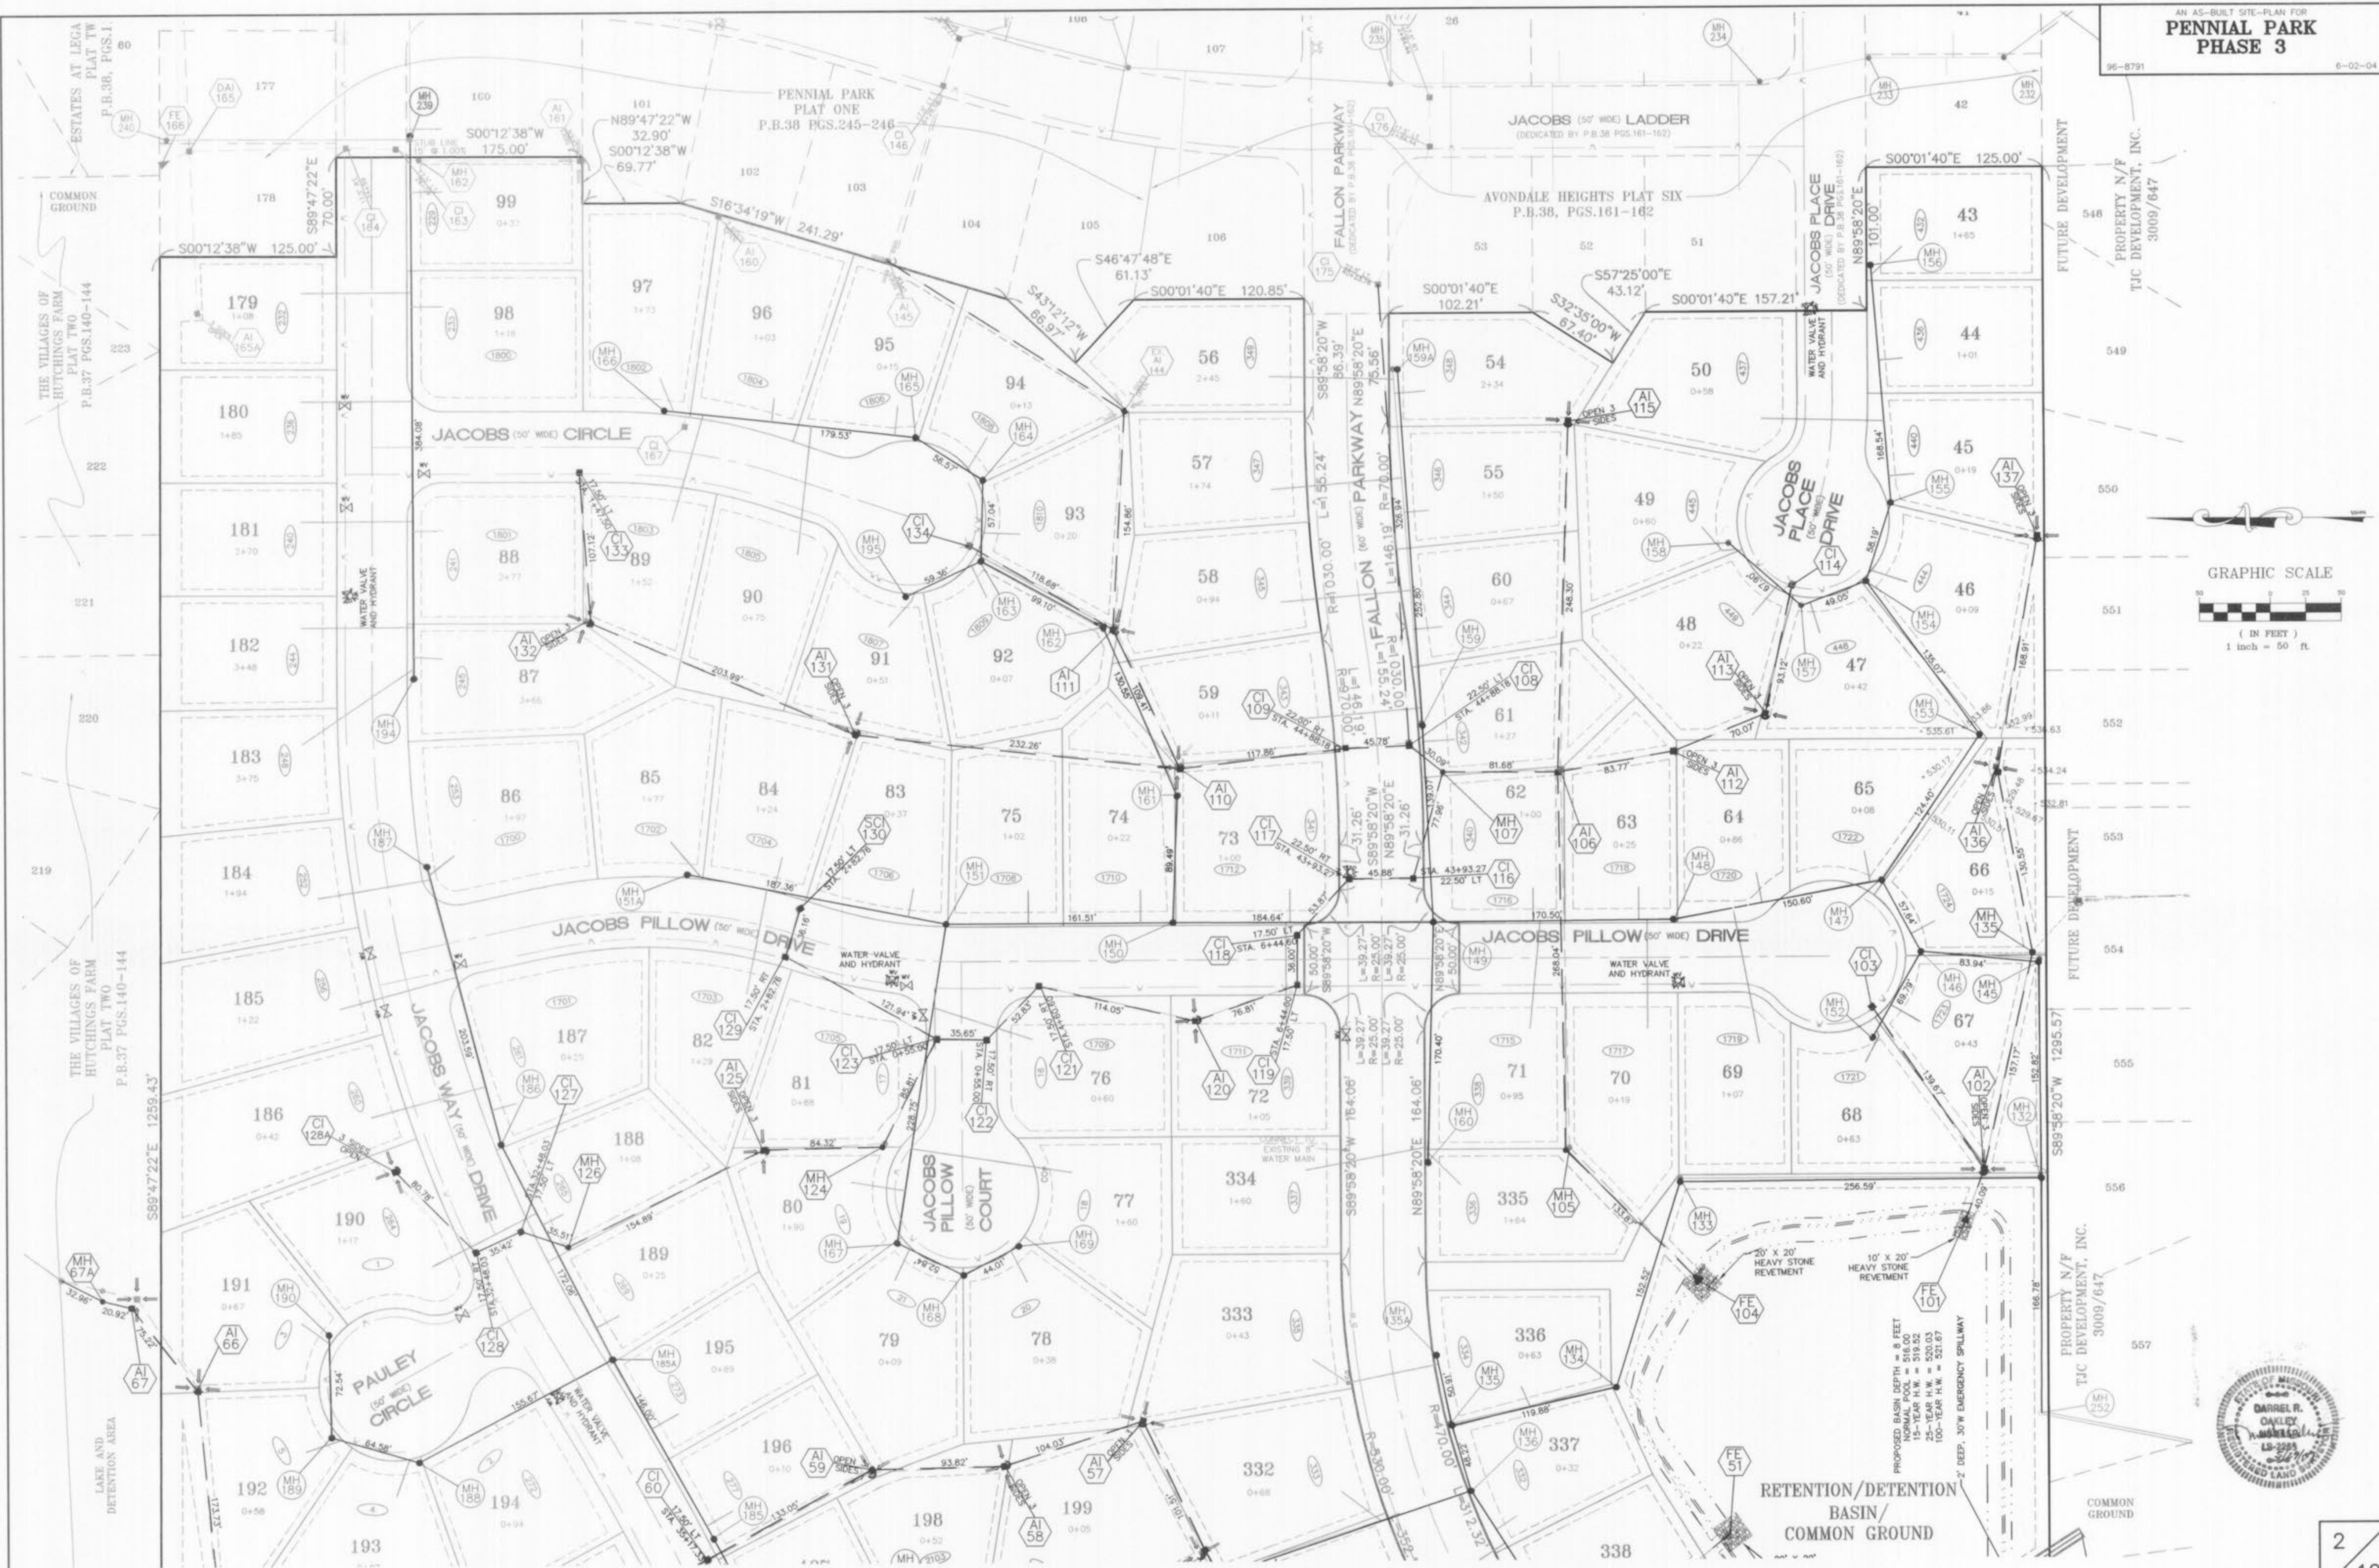


AN AS-BUILT SITE-PLAN FOR
PENNIAL PARK
PHASE 3

96-8791


6-02-04


SEE SHEET TWO


SEE SHEET FOUR

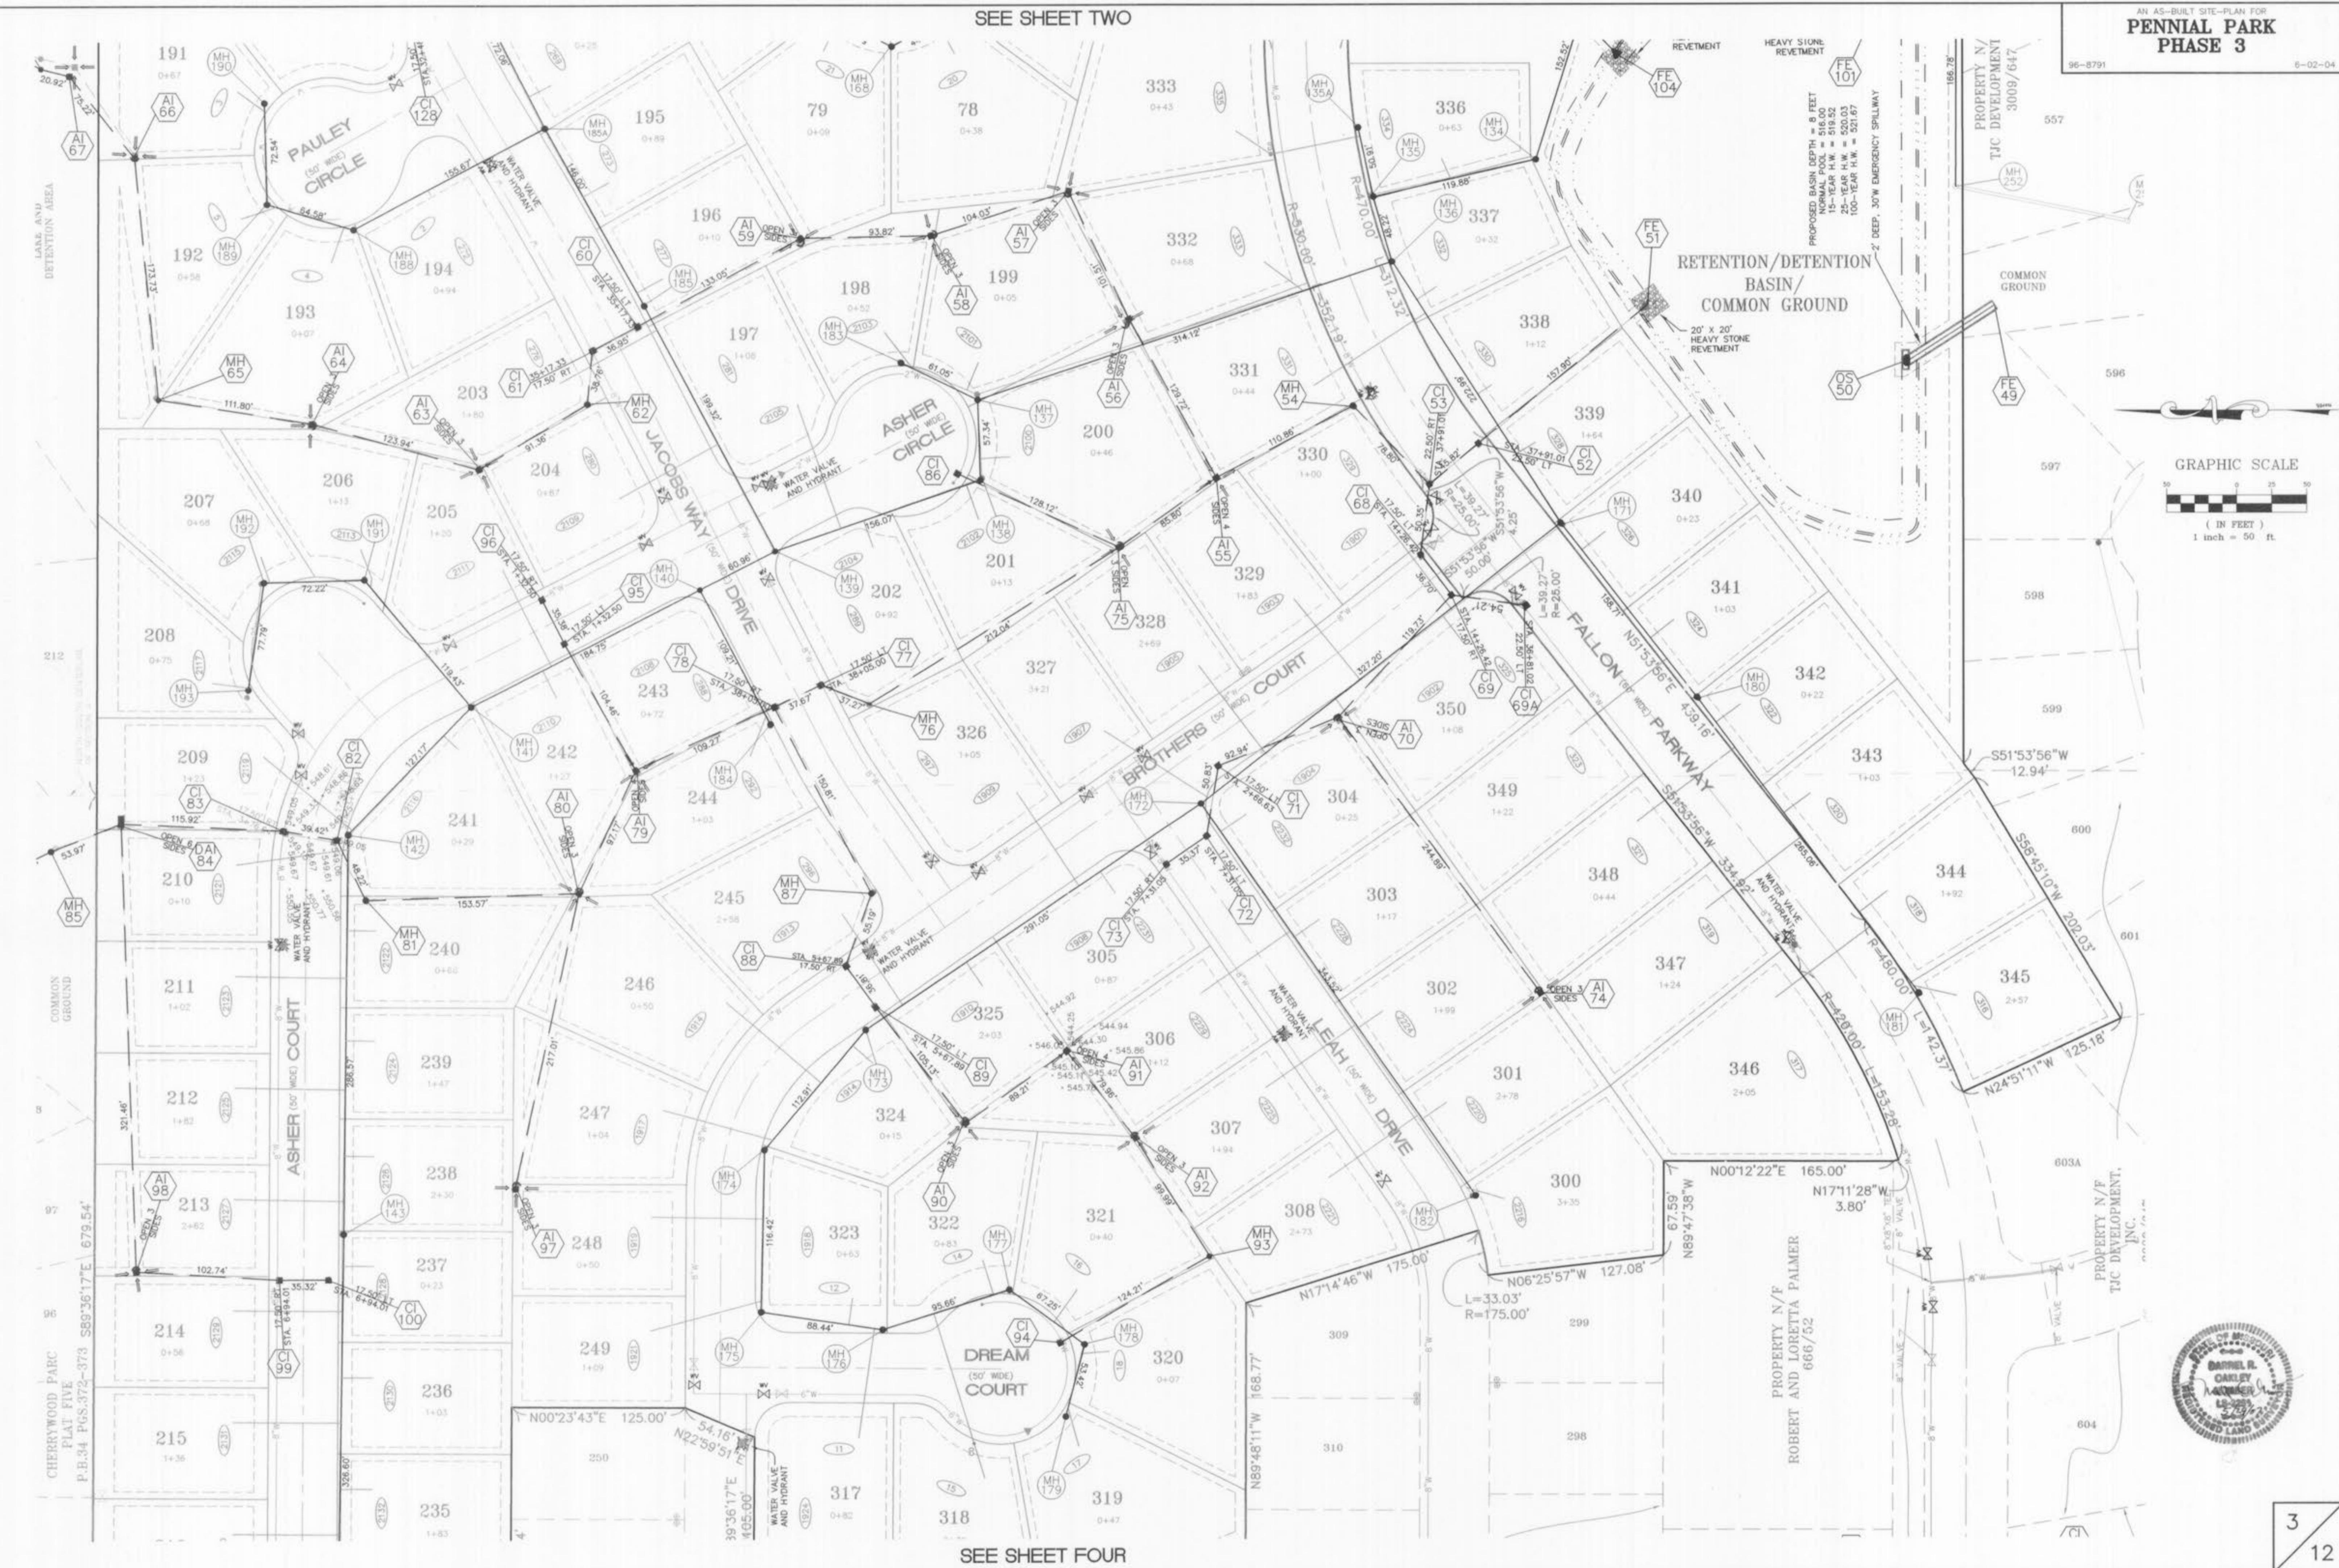

SEE SHEET THREE


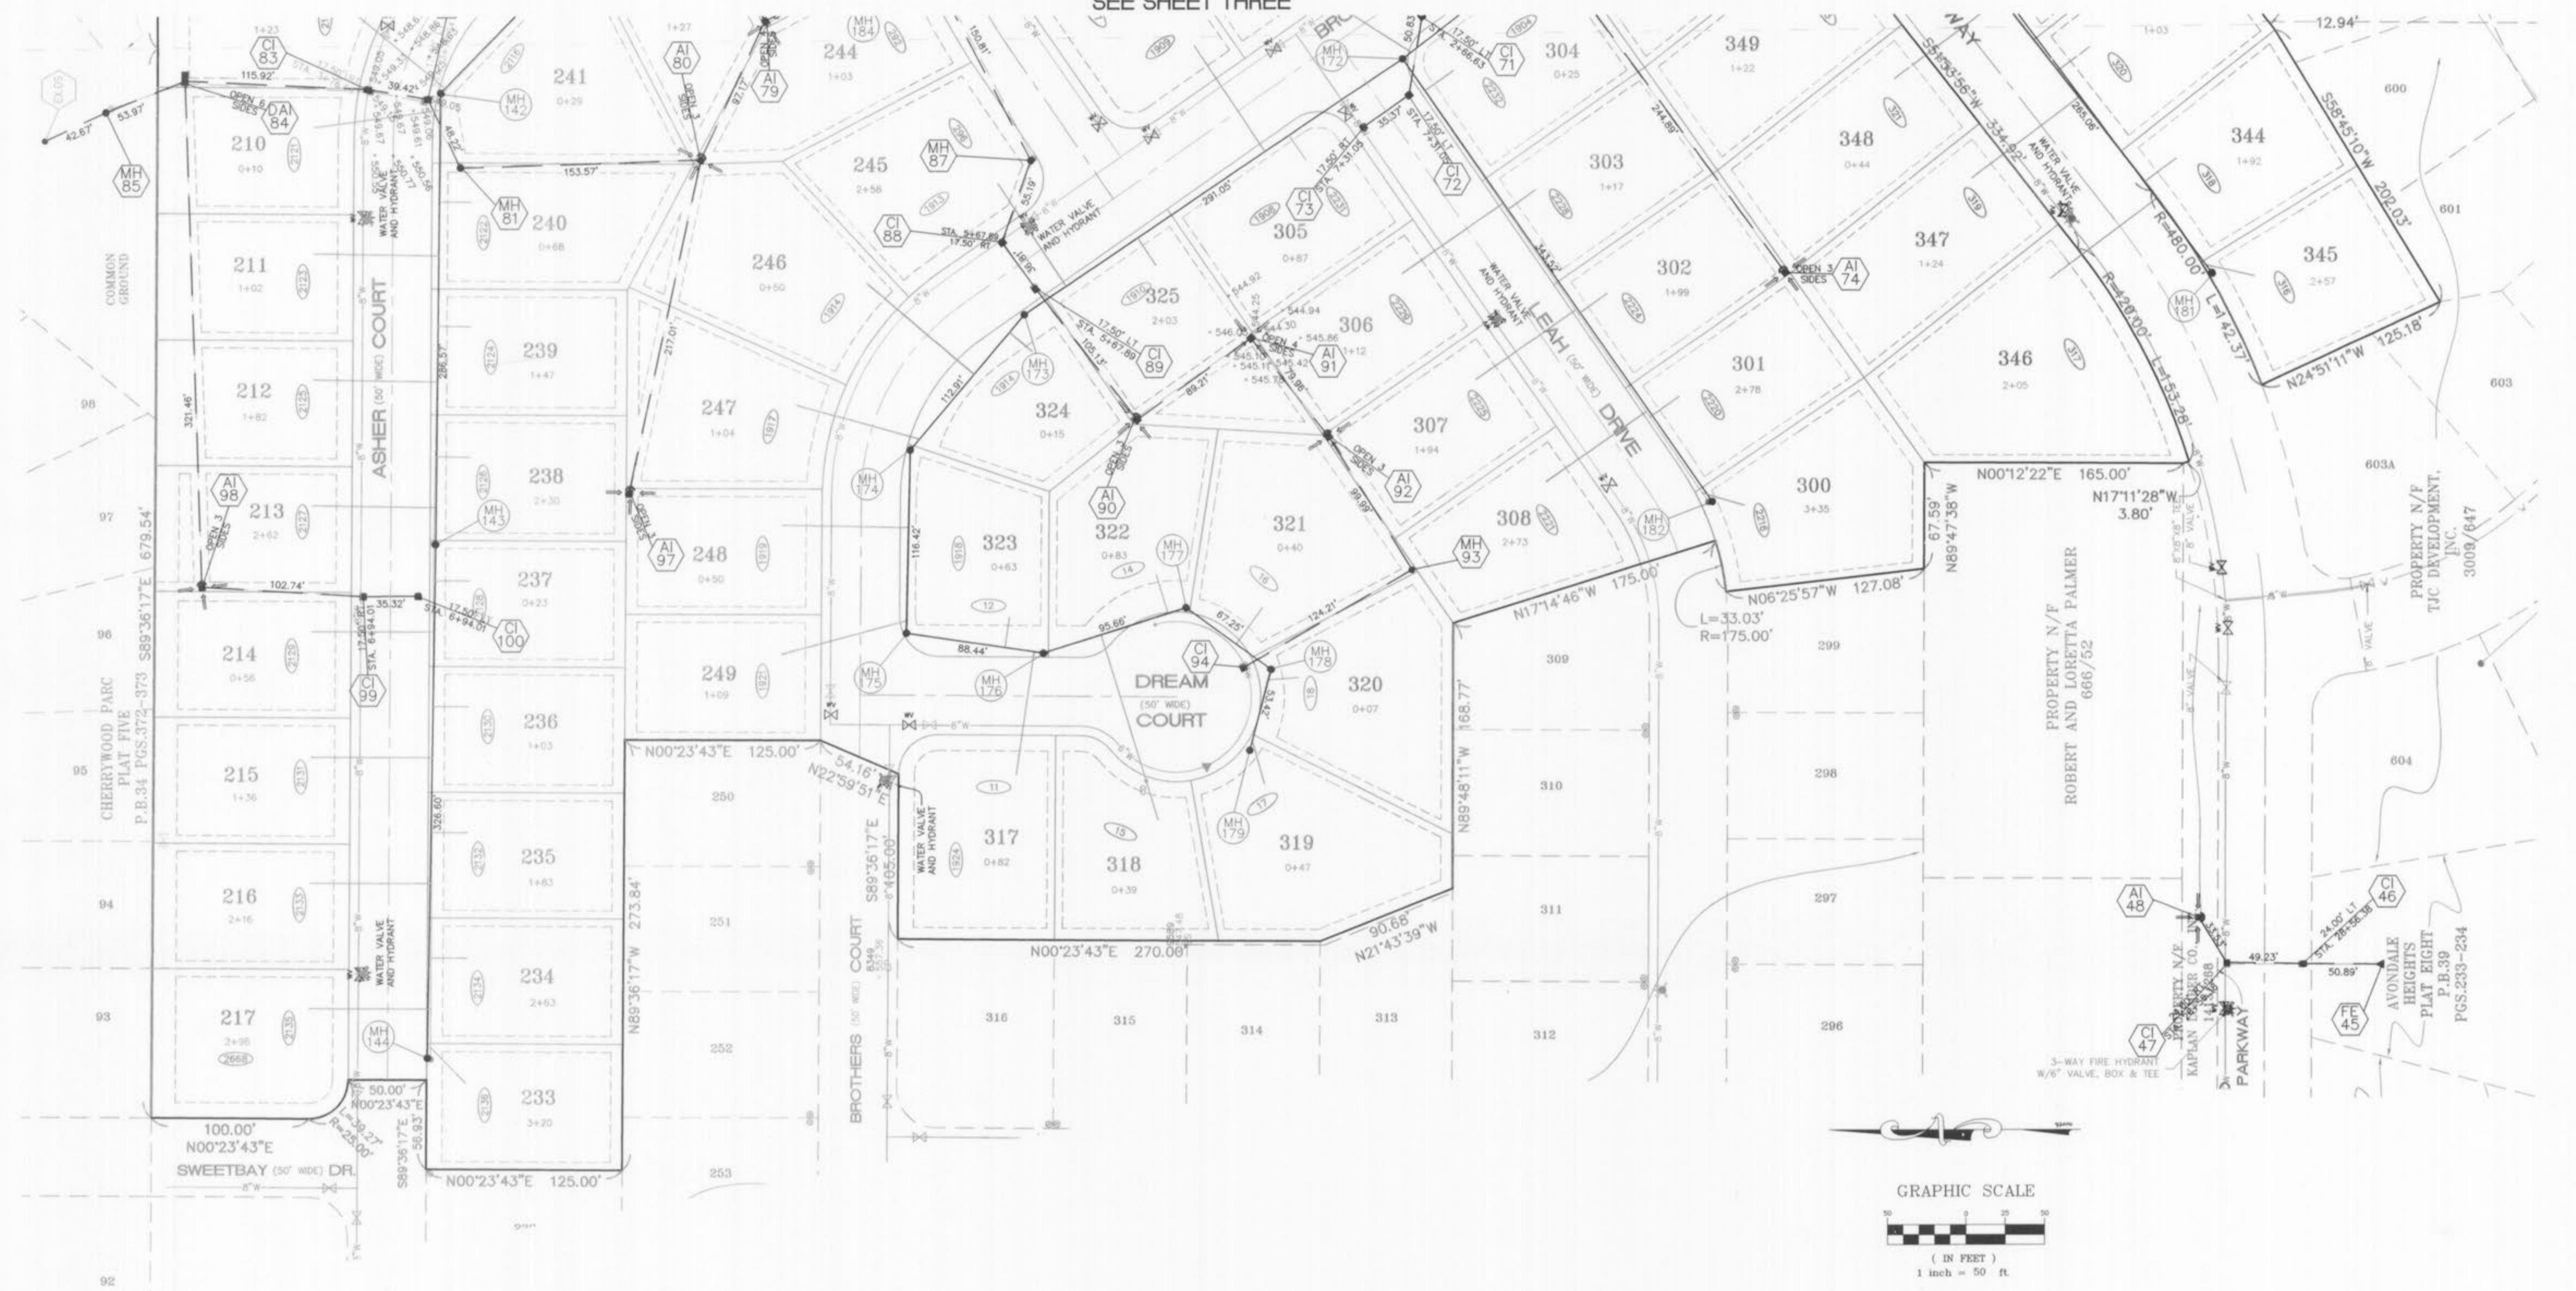


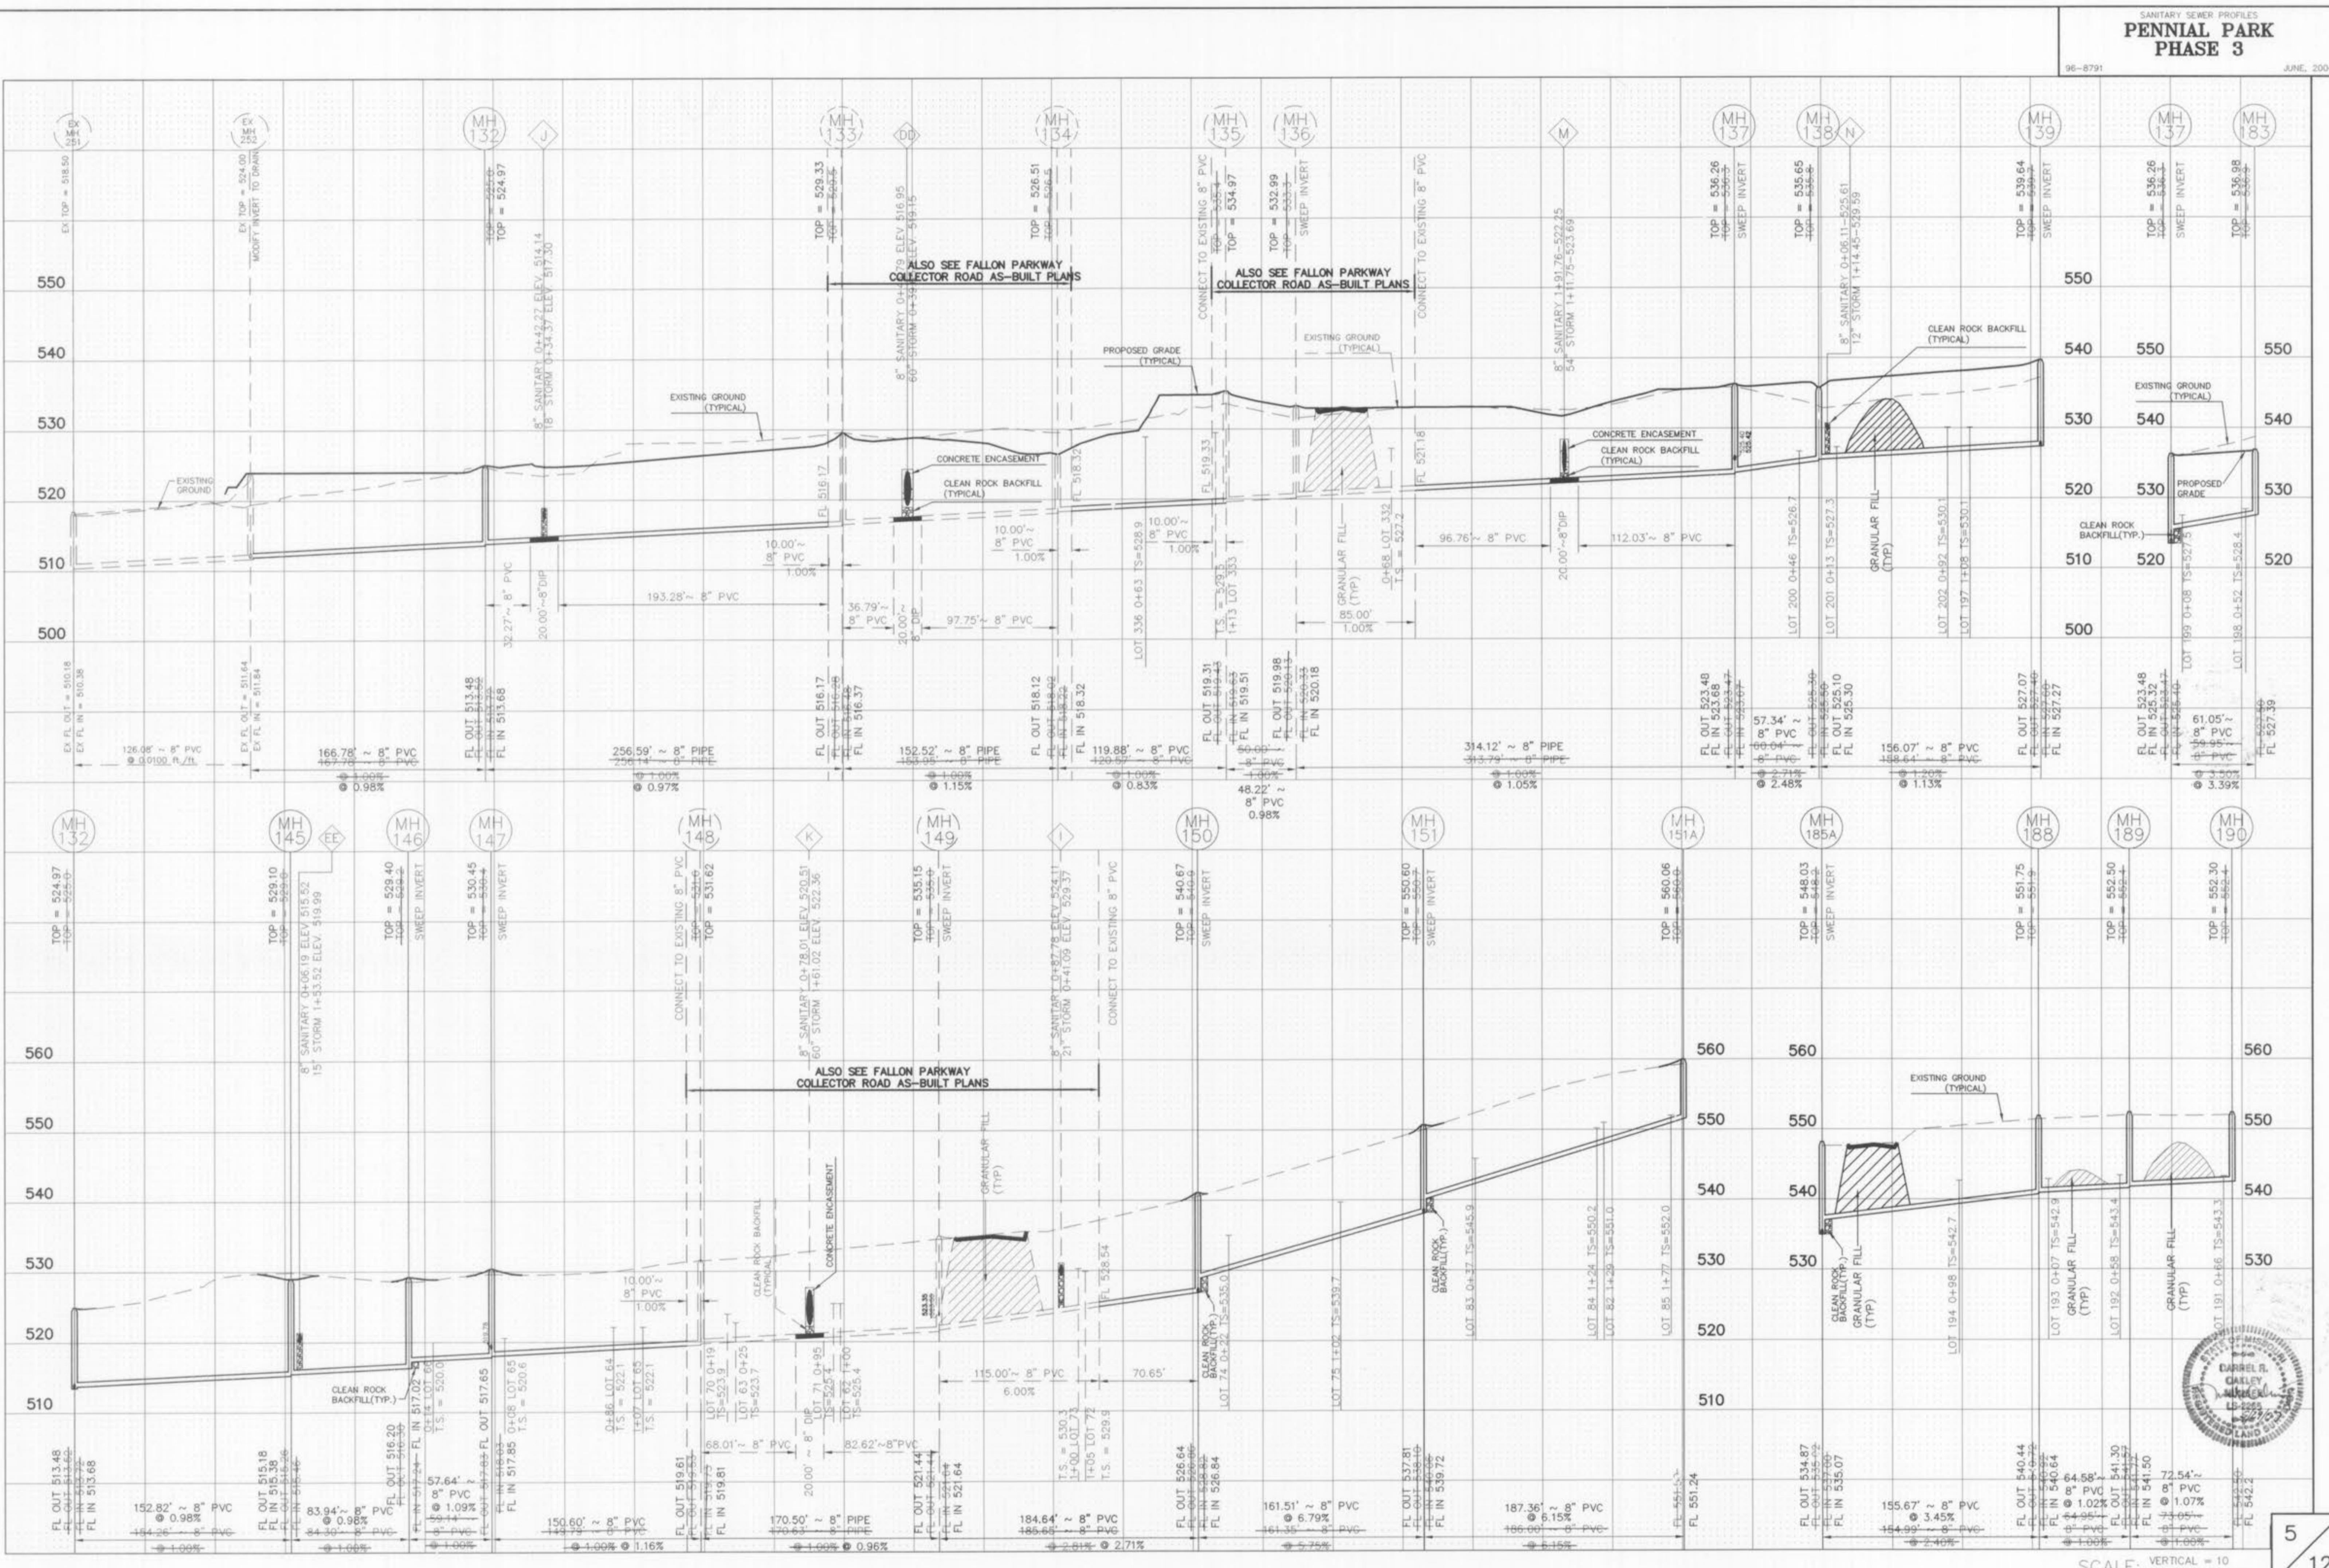


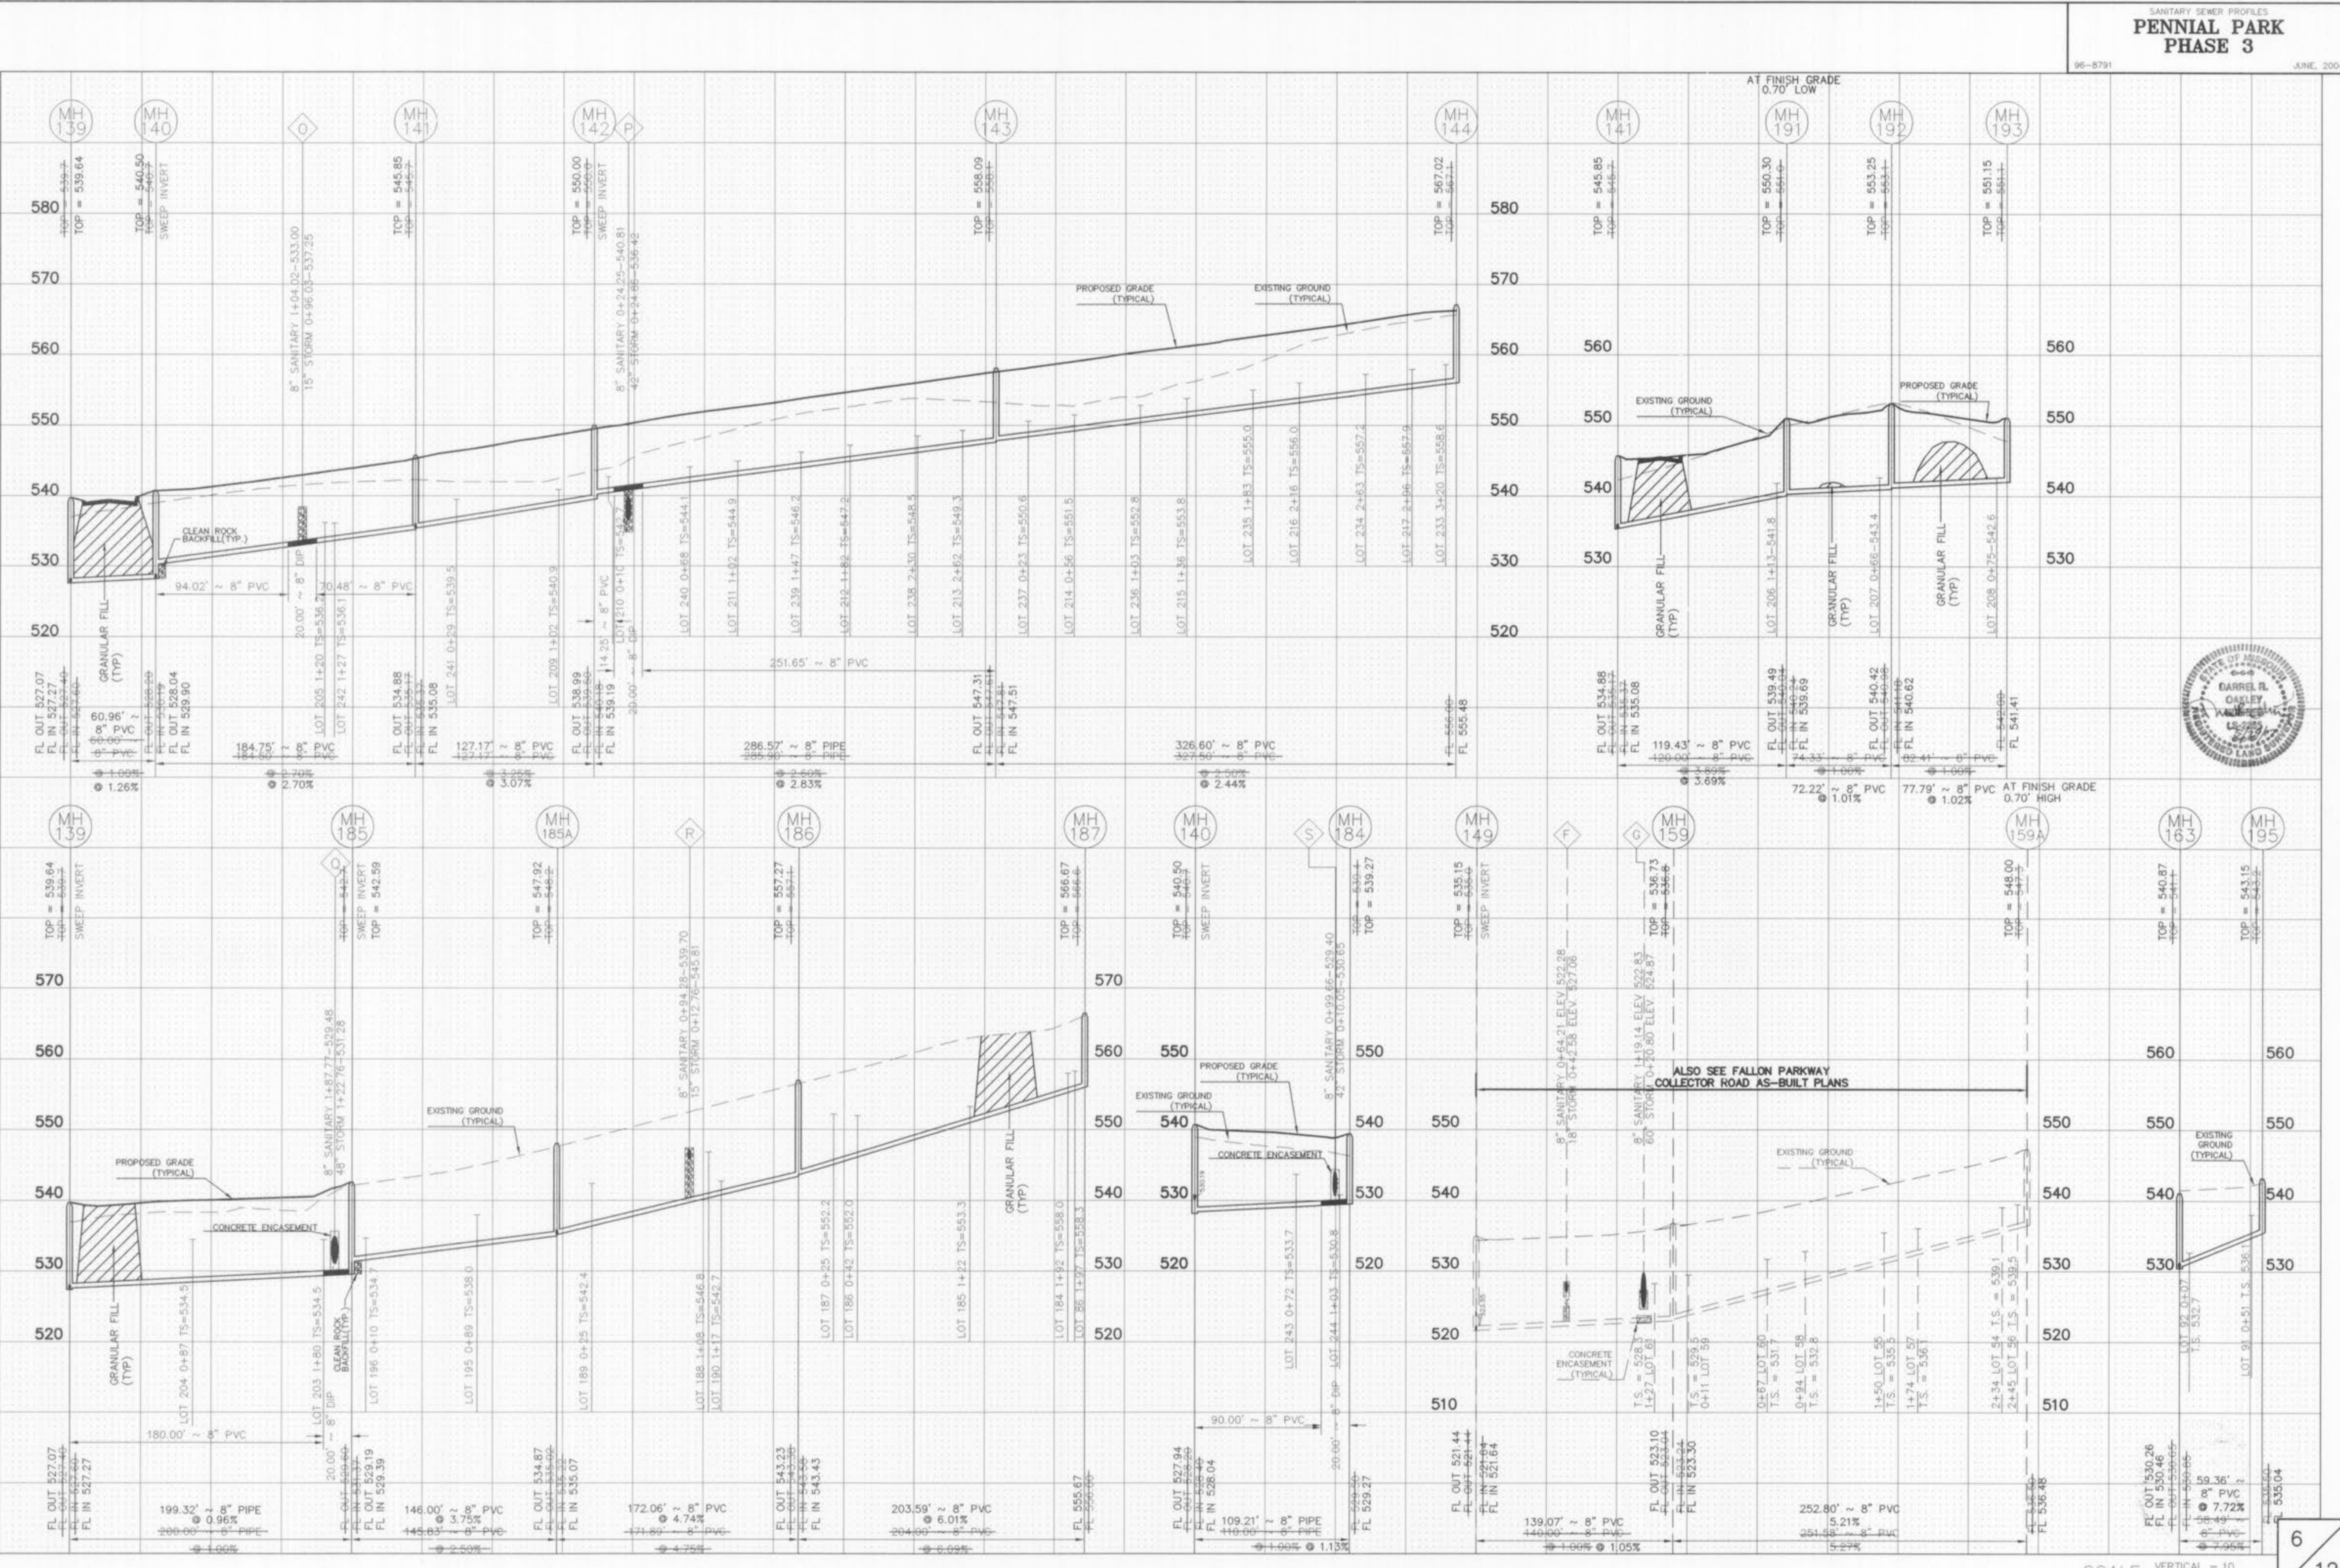



SCALE: VERTICAL = 10
HORIZONTAL = 50


Pennial Park Phase 3
As built 1/5
10/12

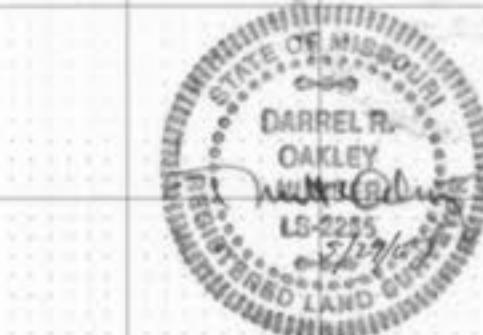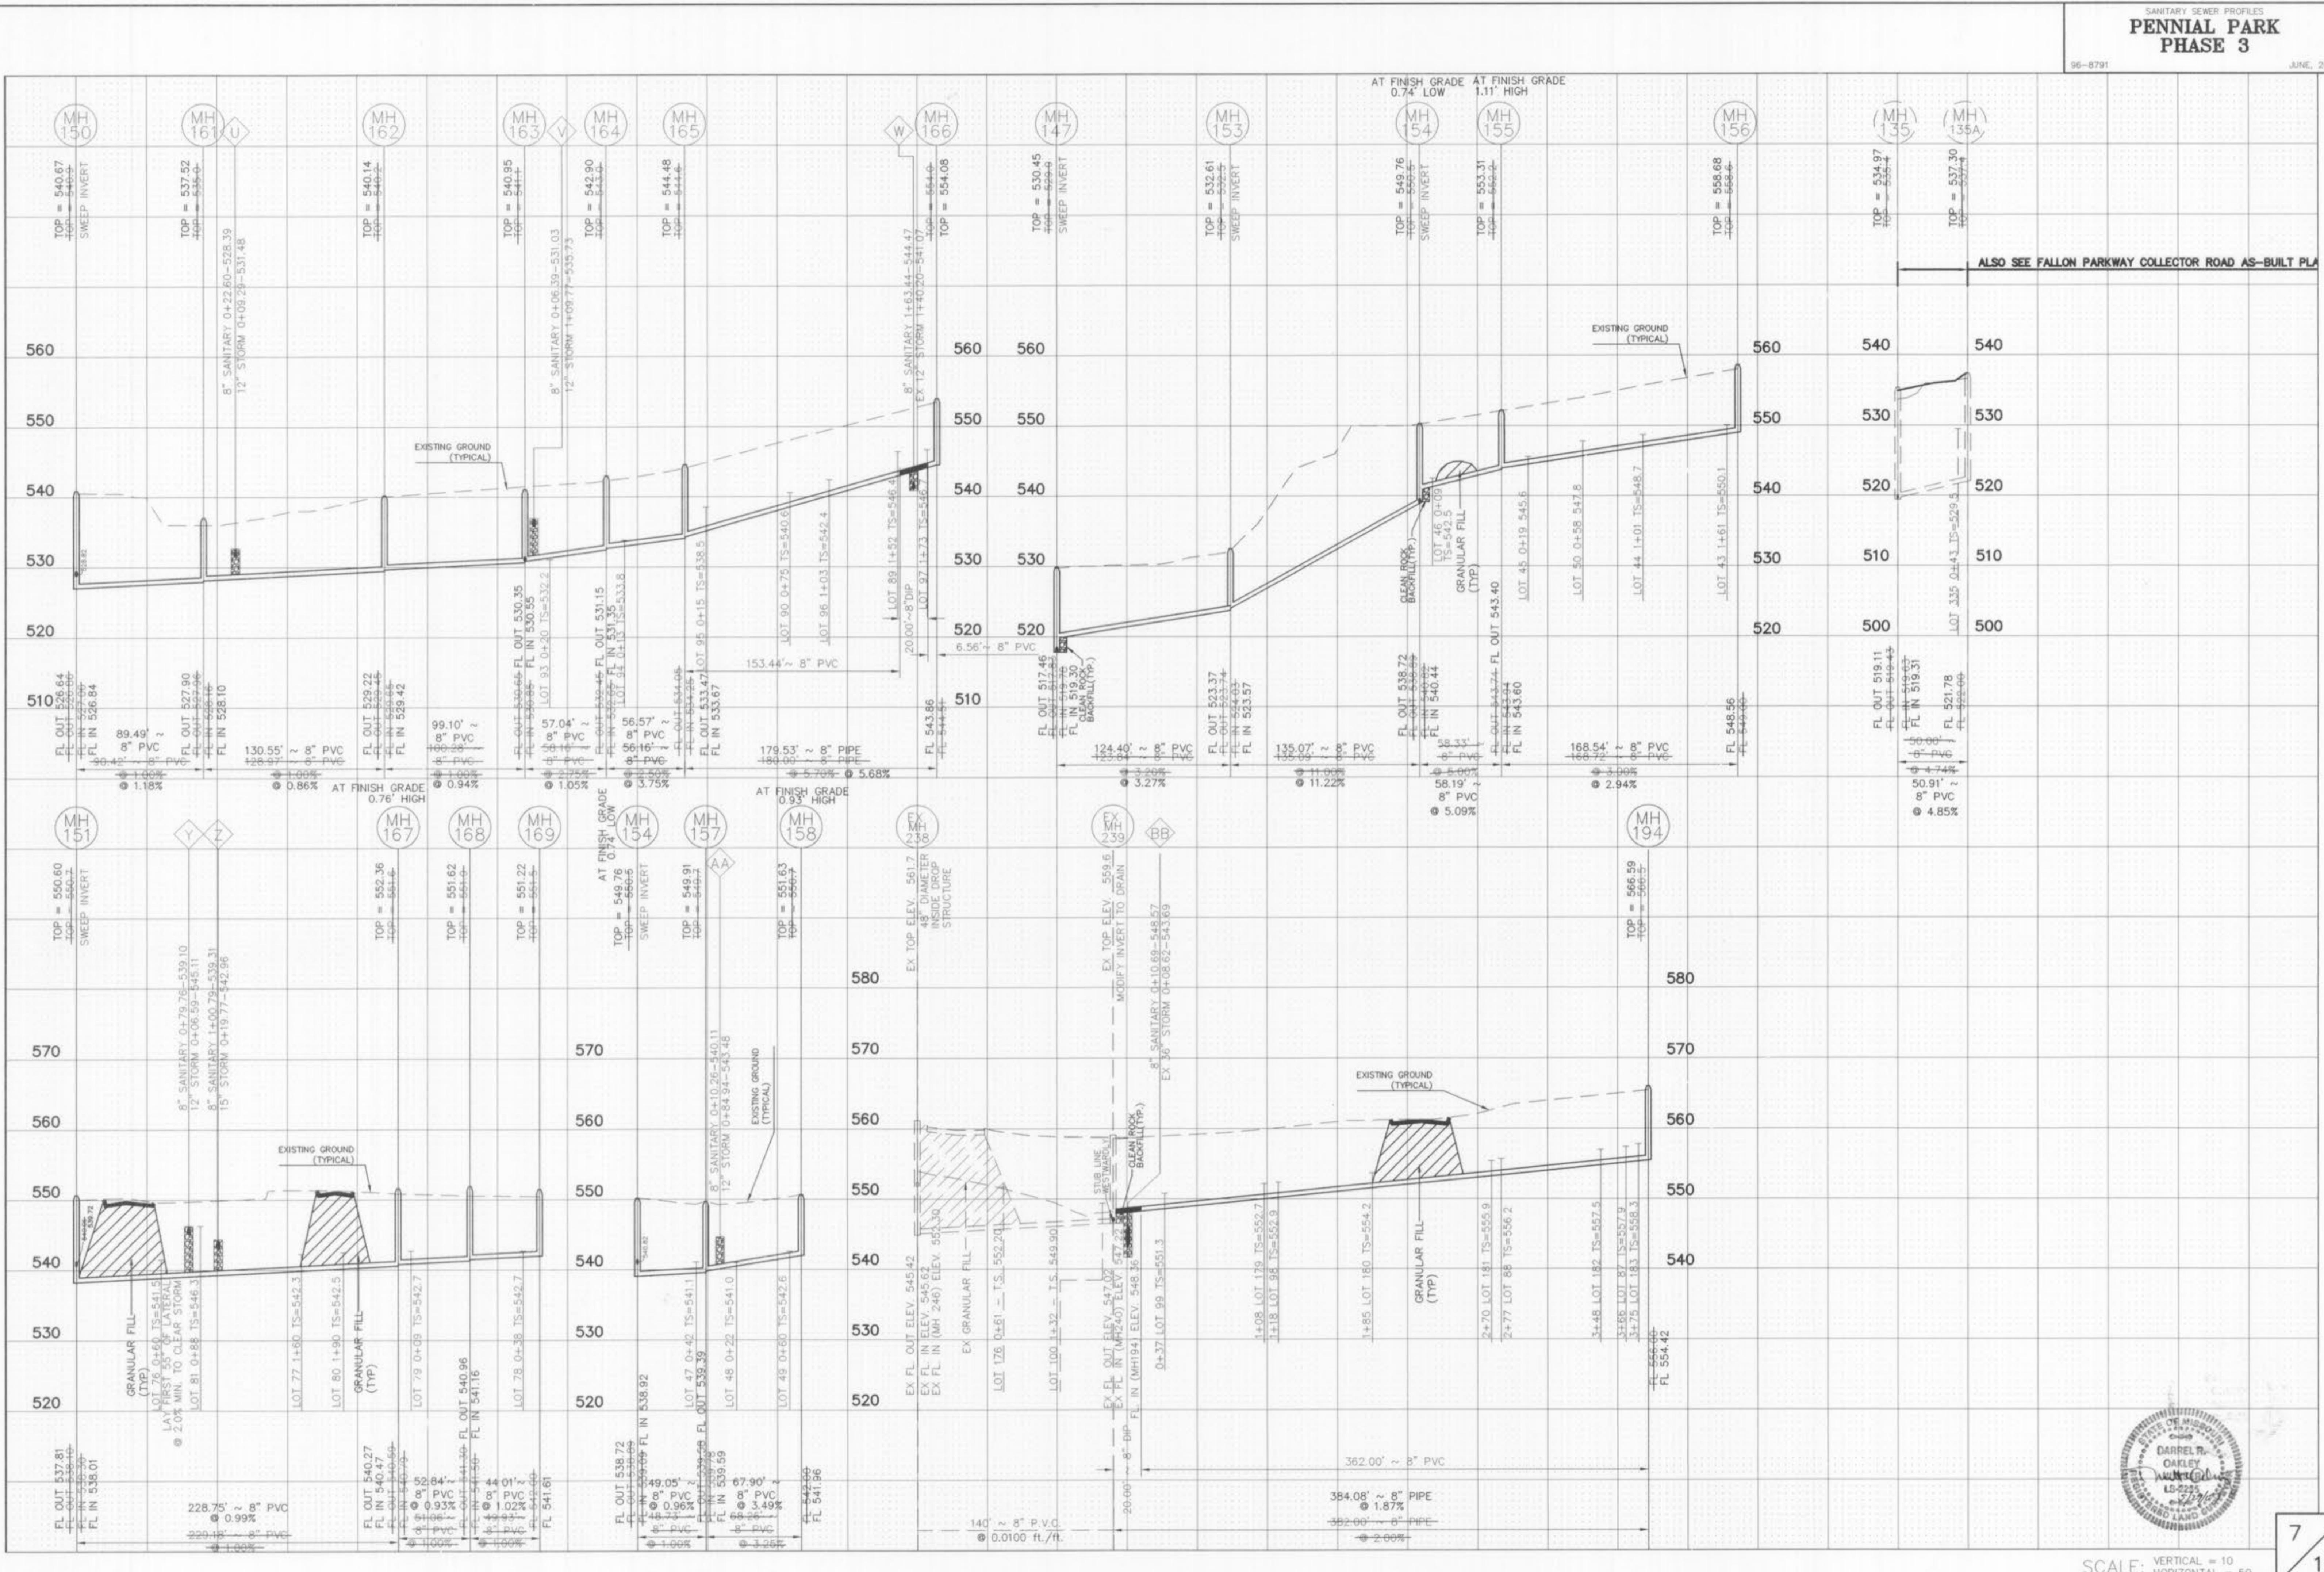

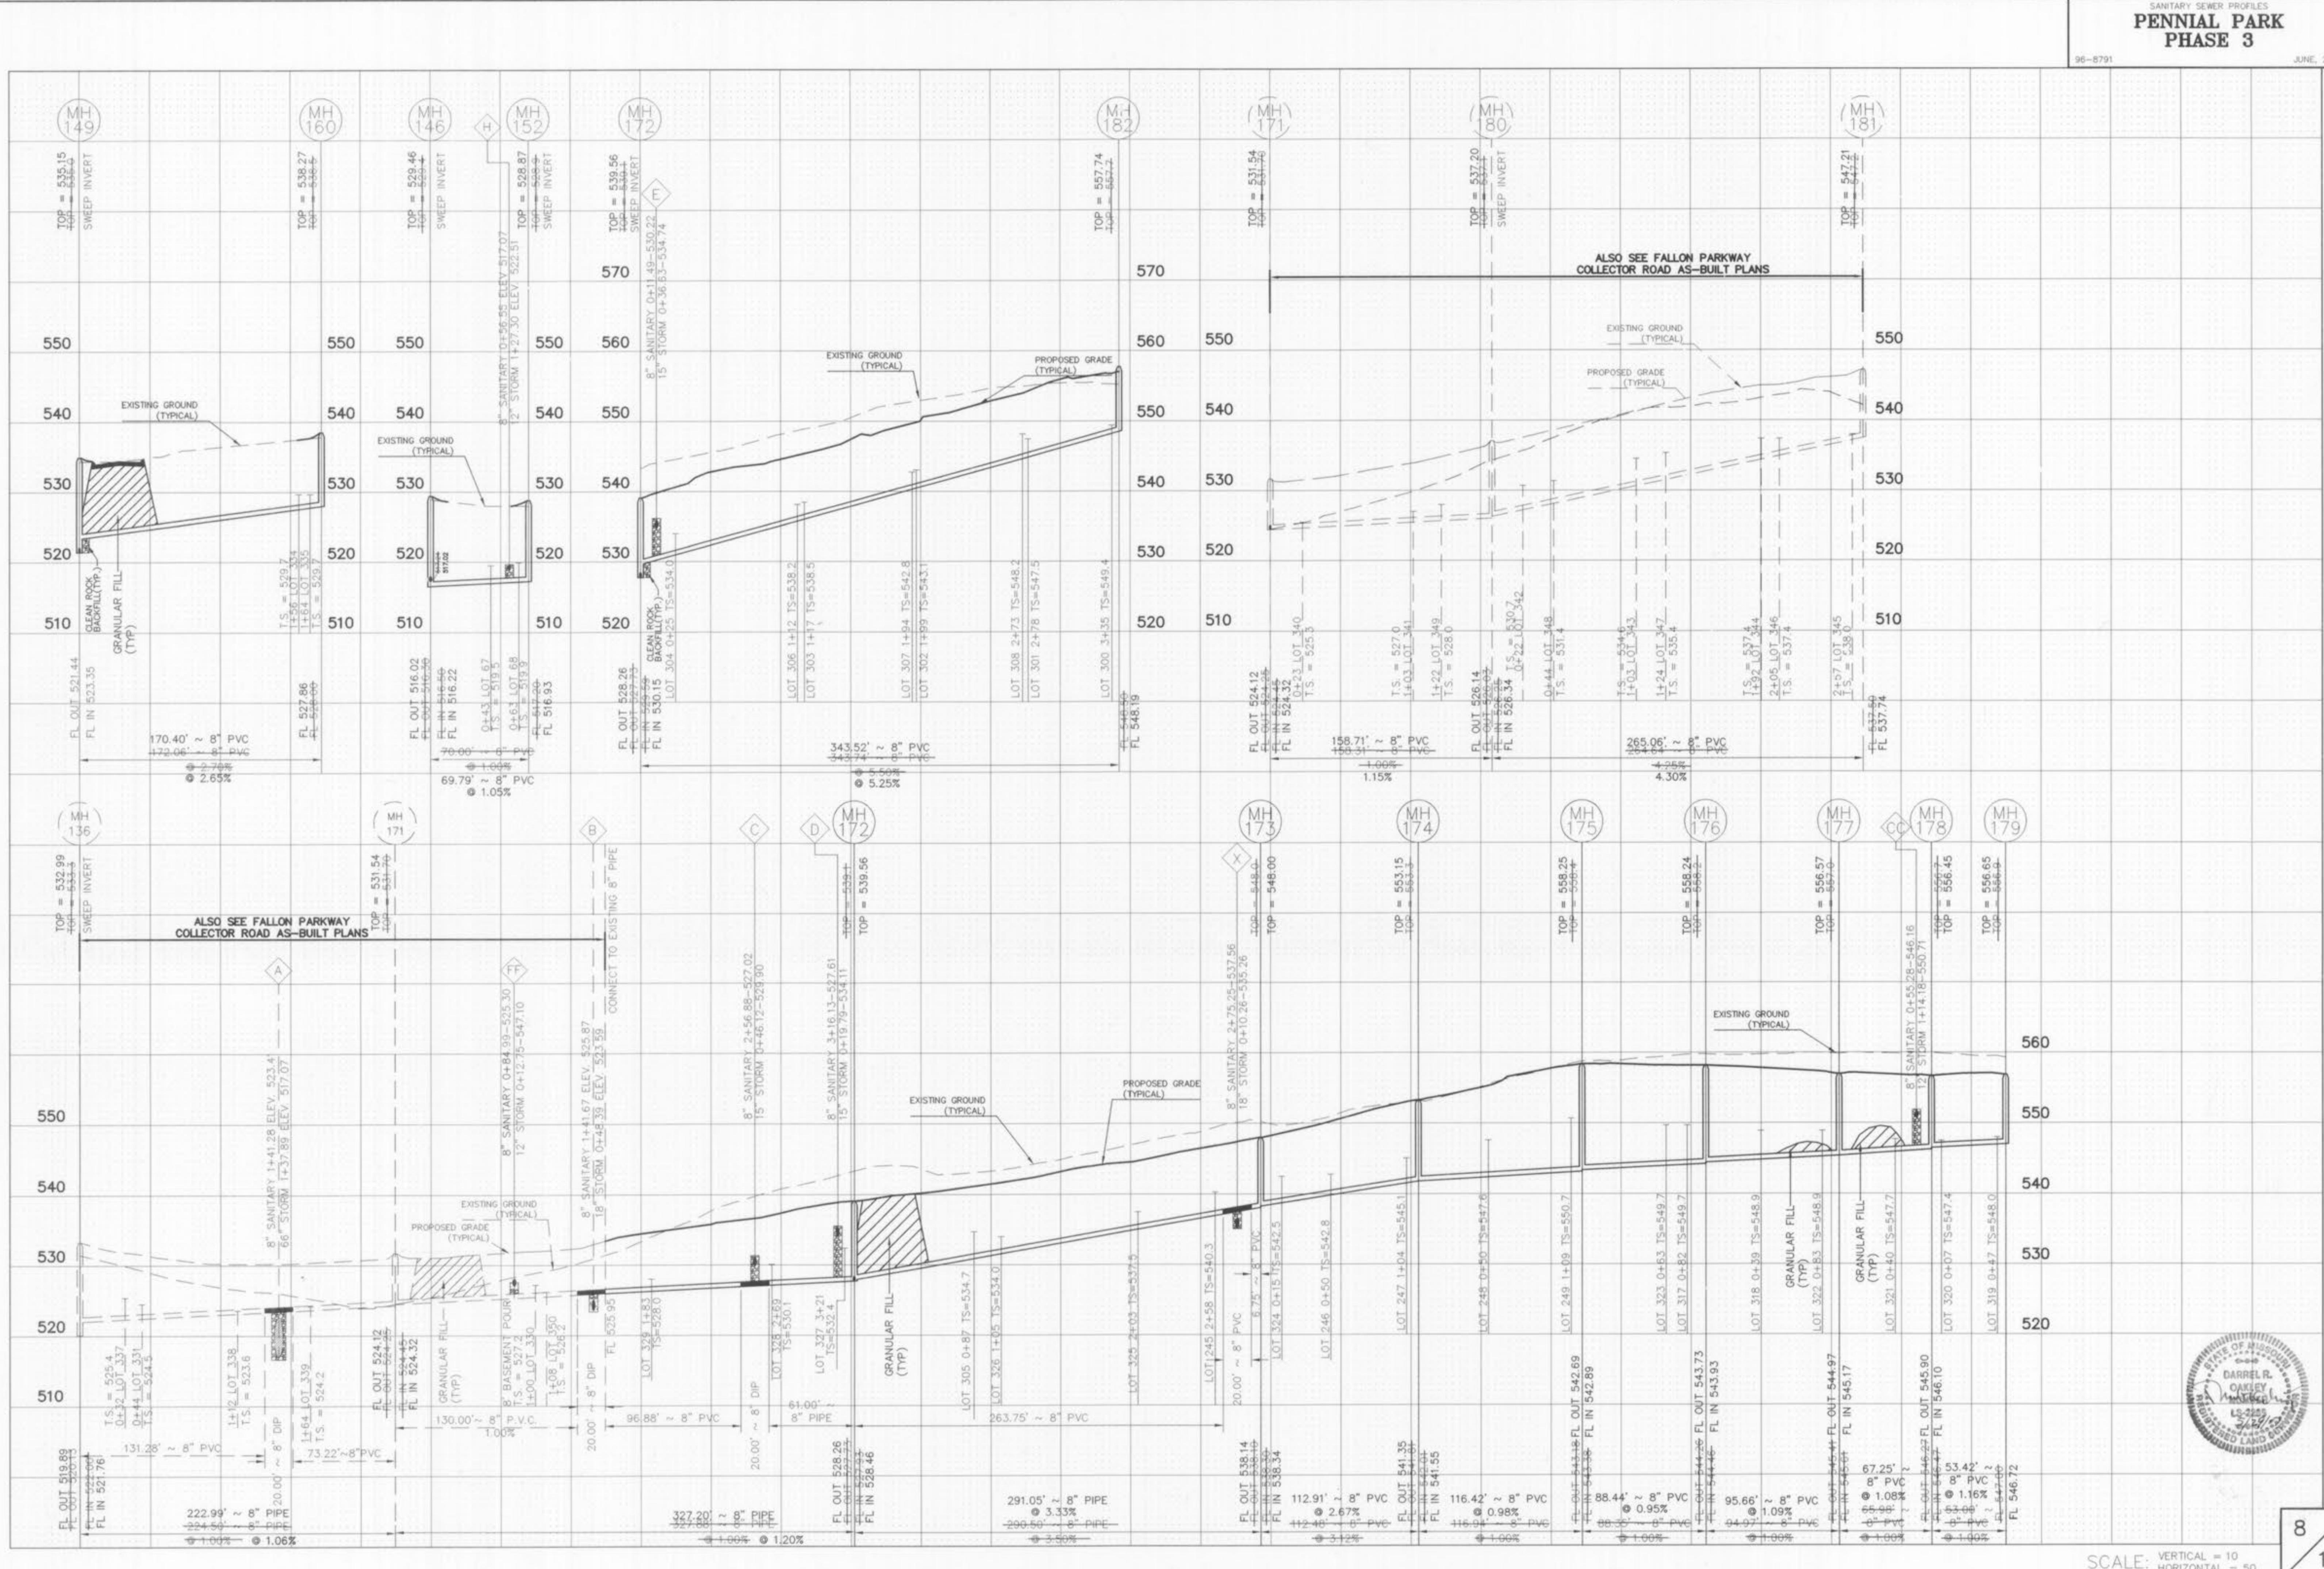

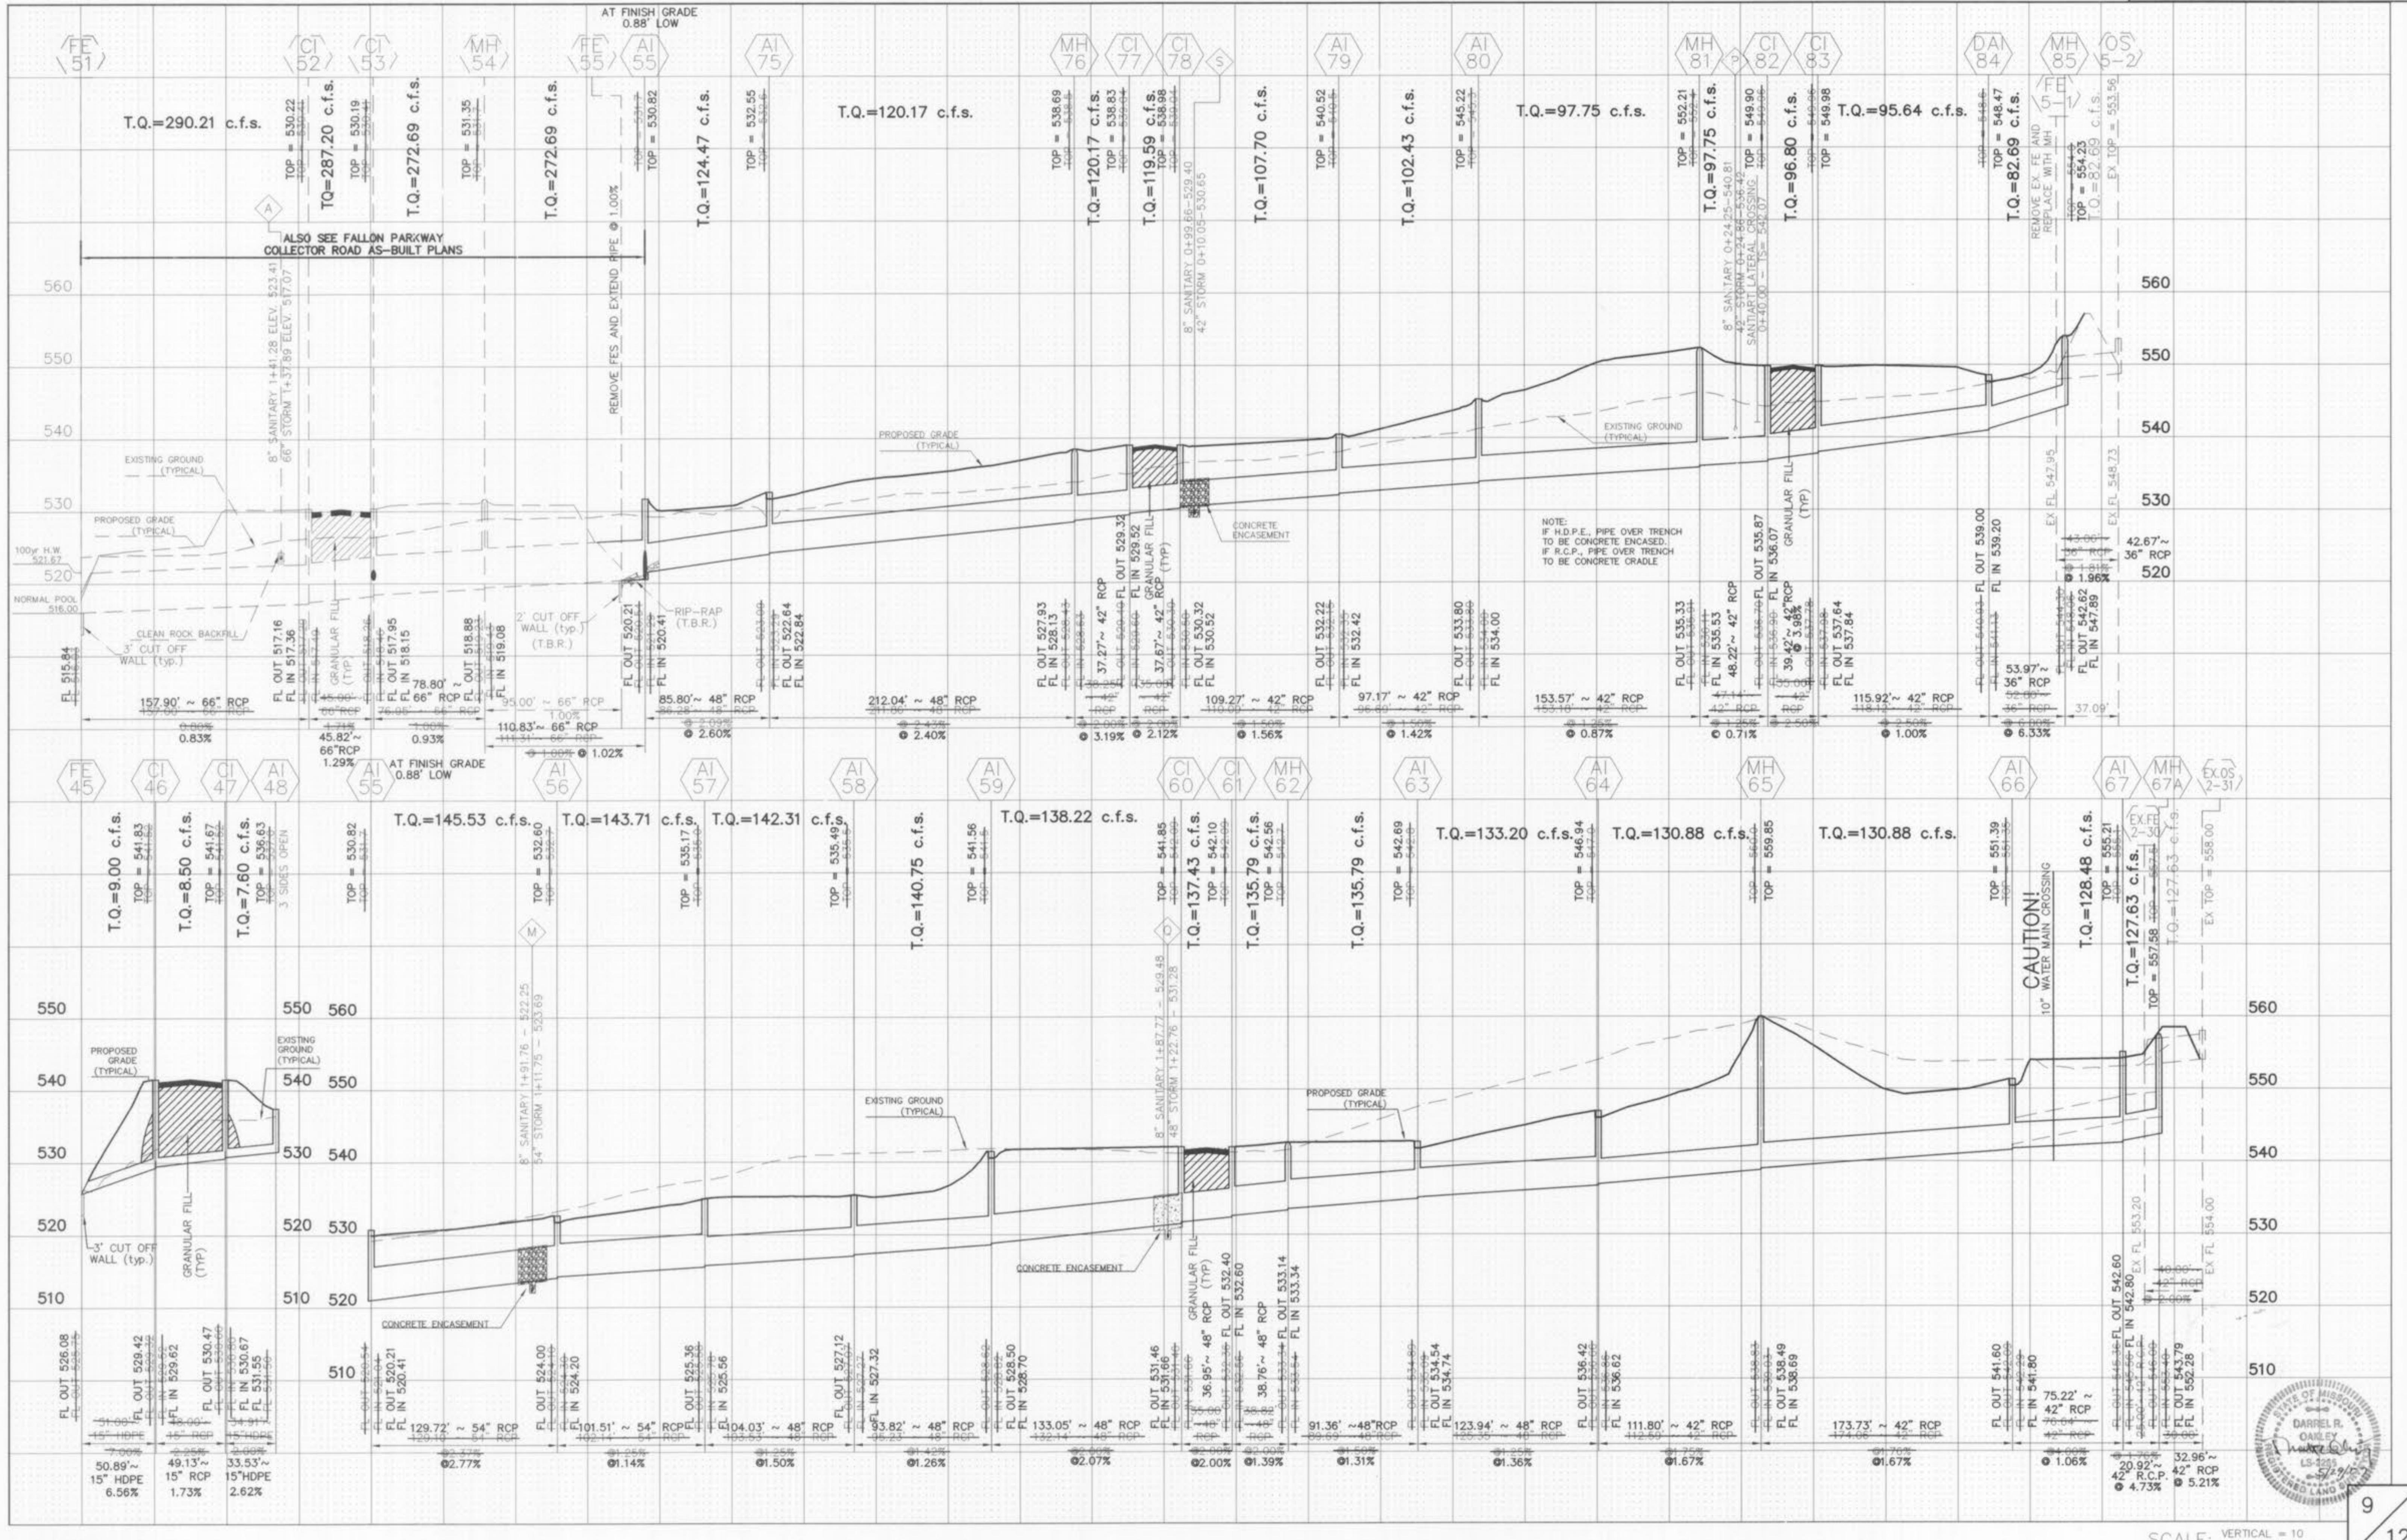

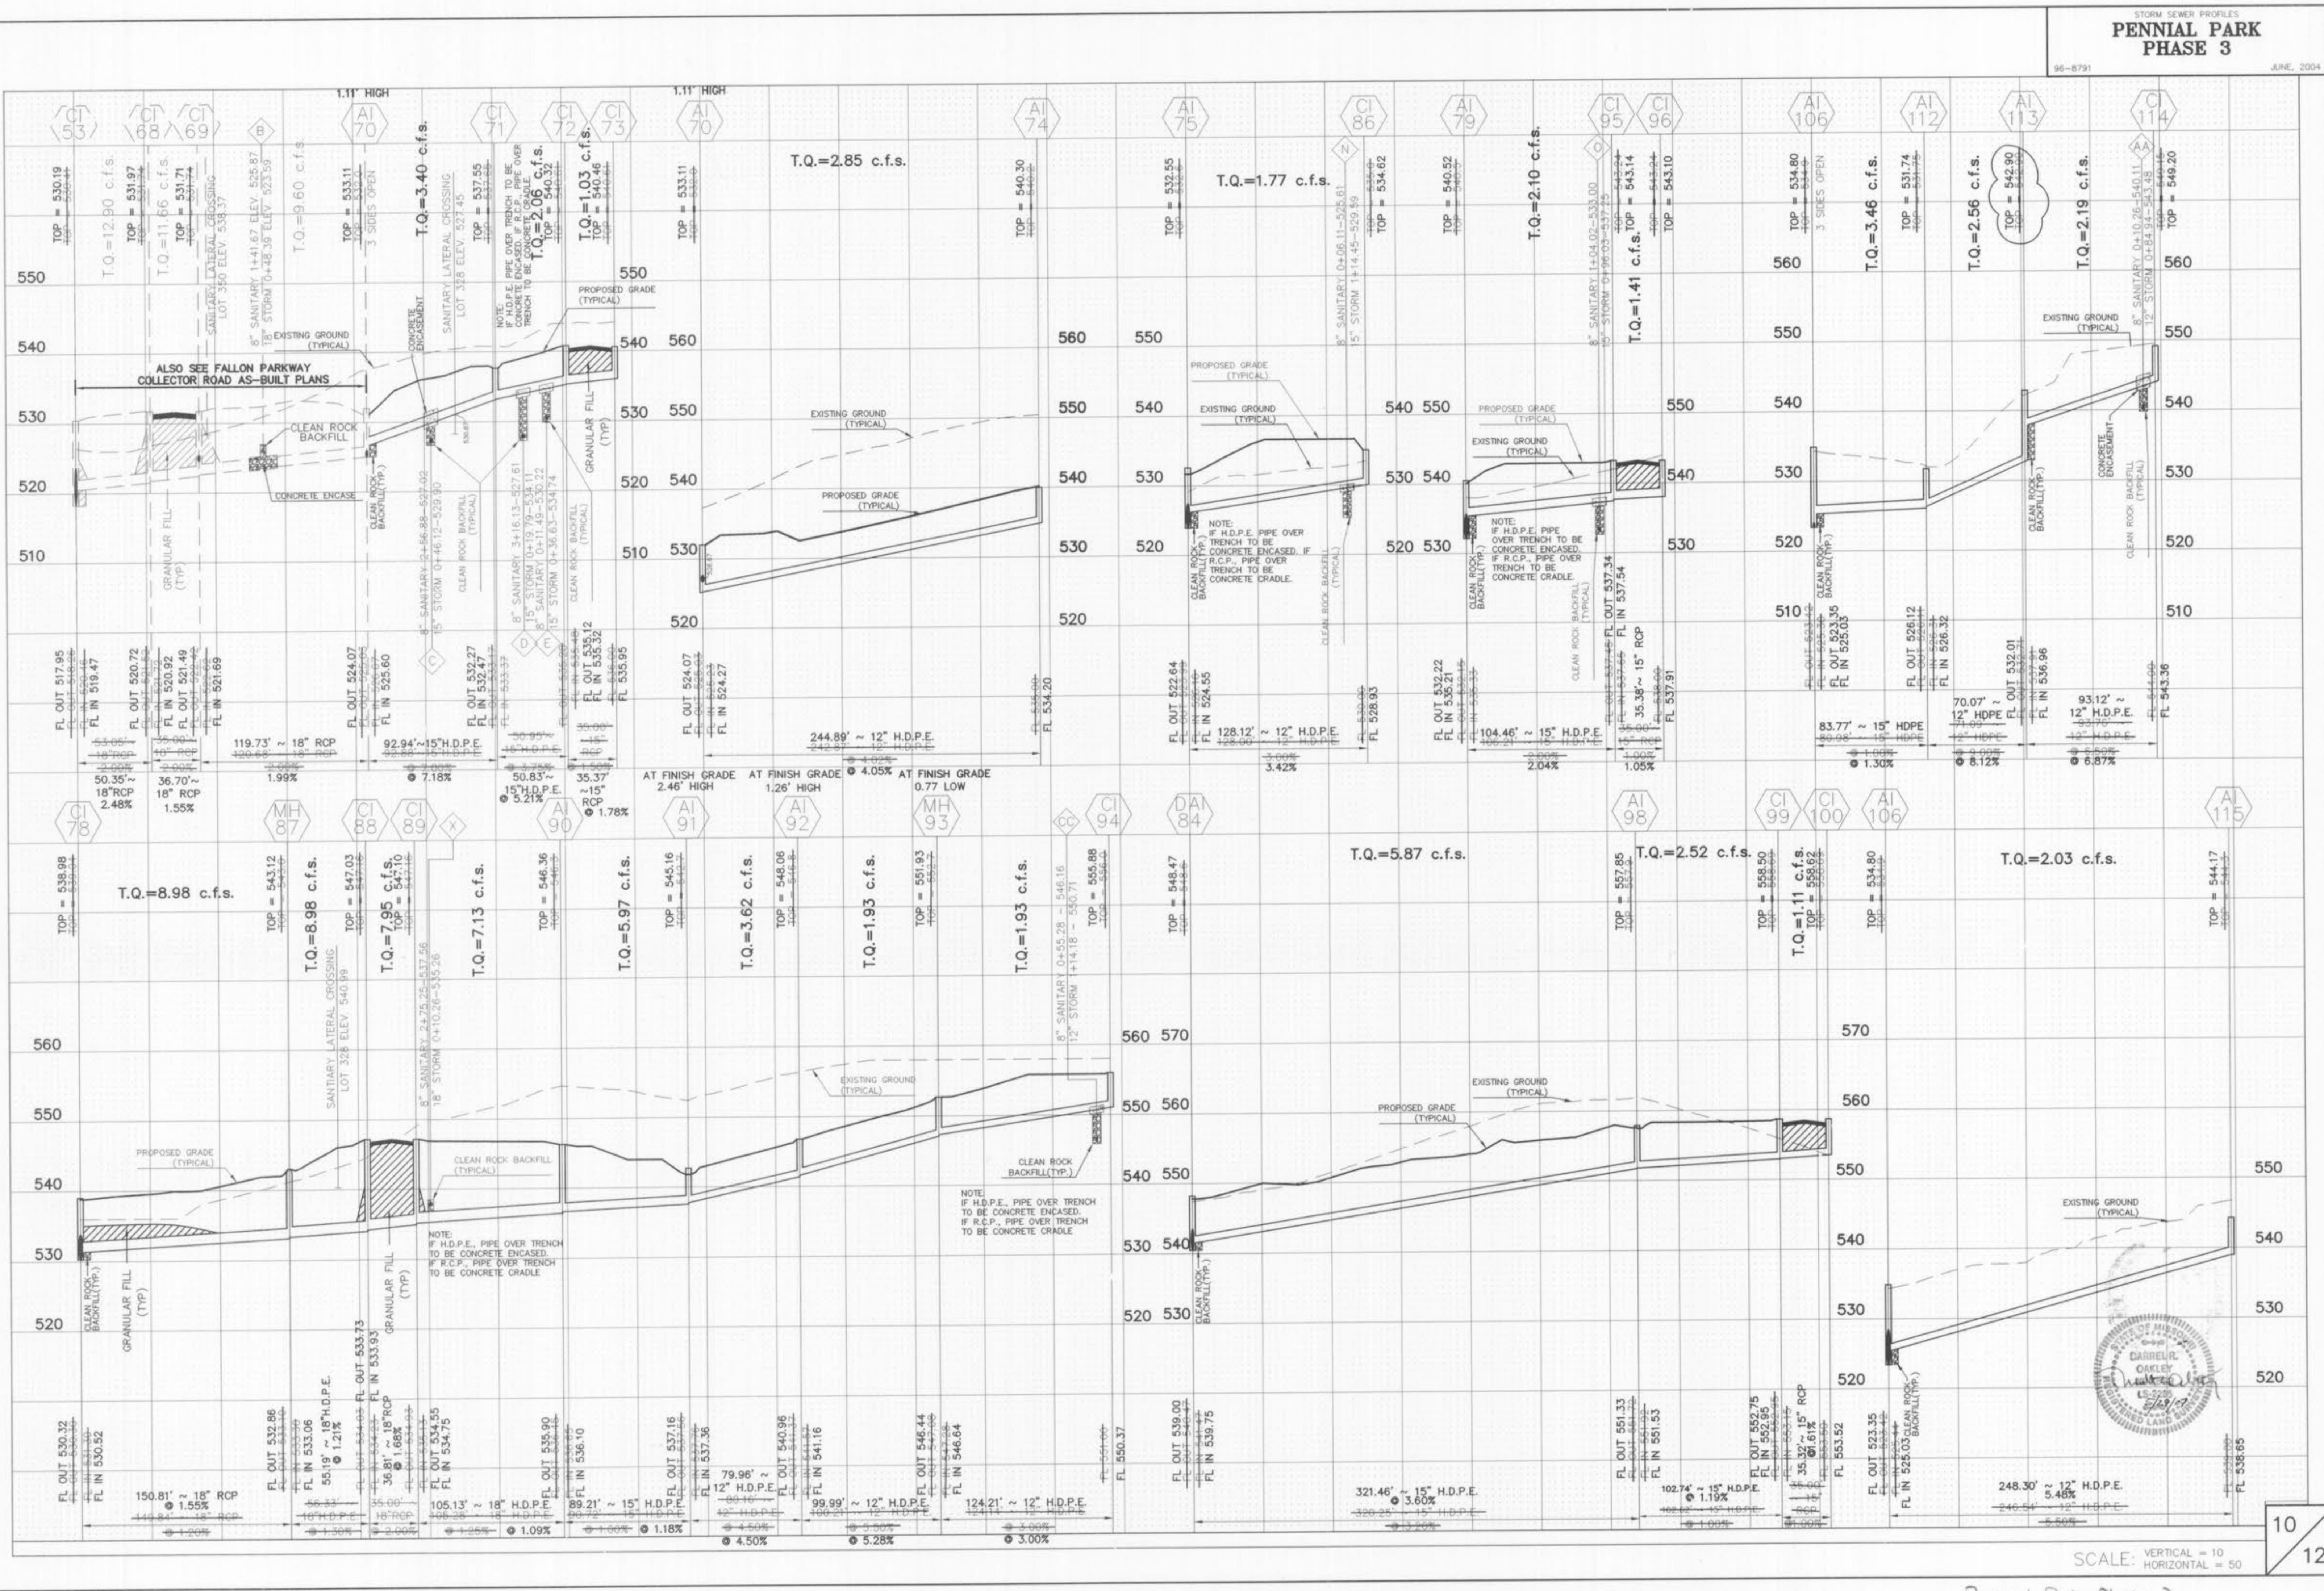

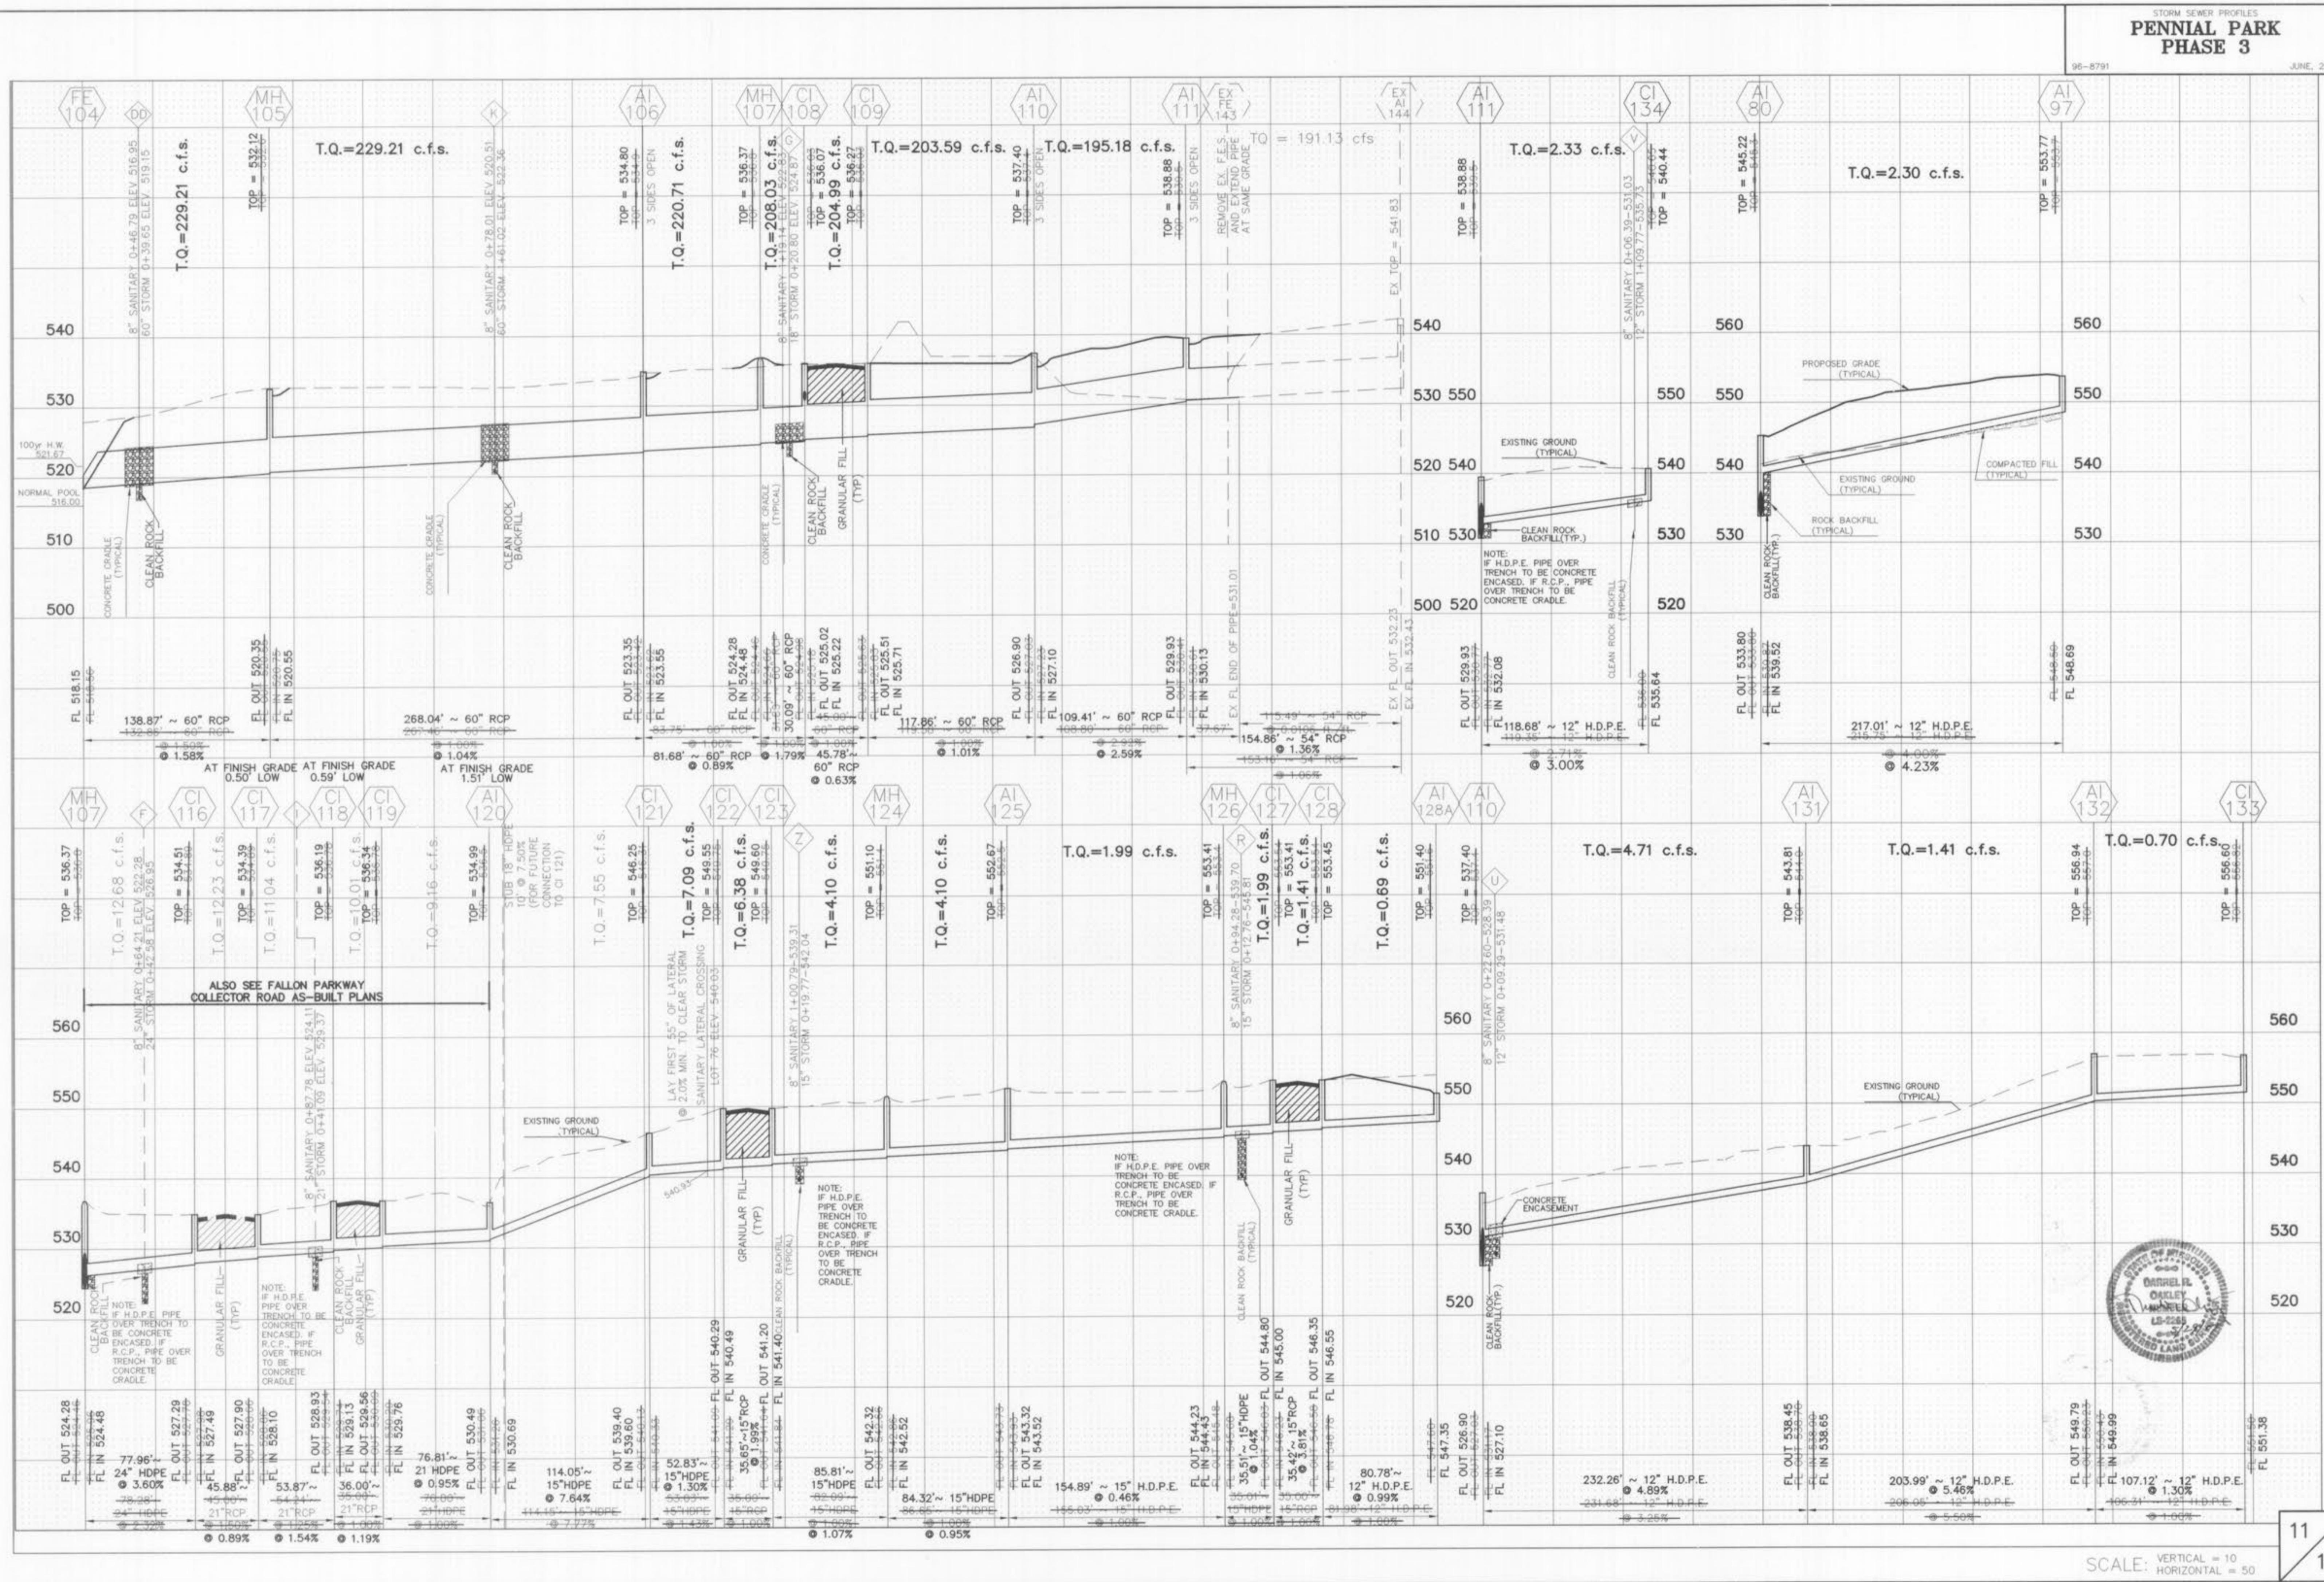


SCALE: VERTICAL = 10
HORIZONTAL = 50

STORM SEWER PROFILES
PENNIAL PARK
PHASE 3

-8791

2004

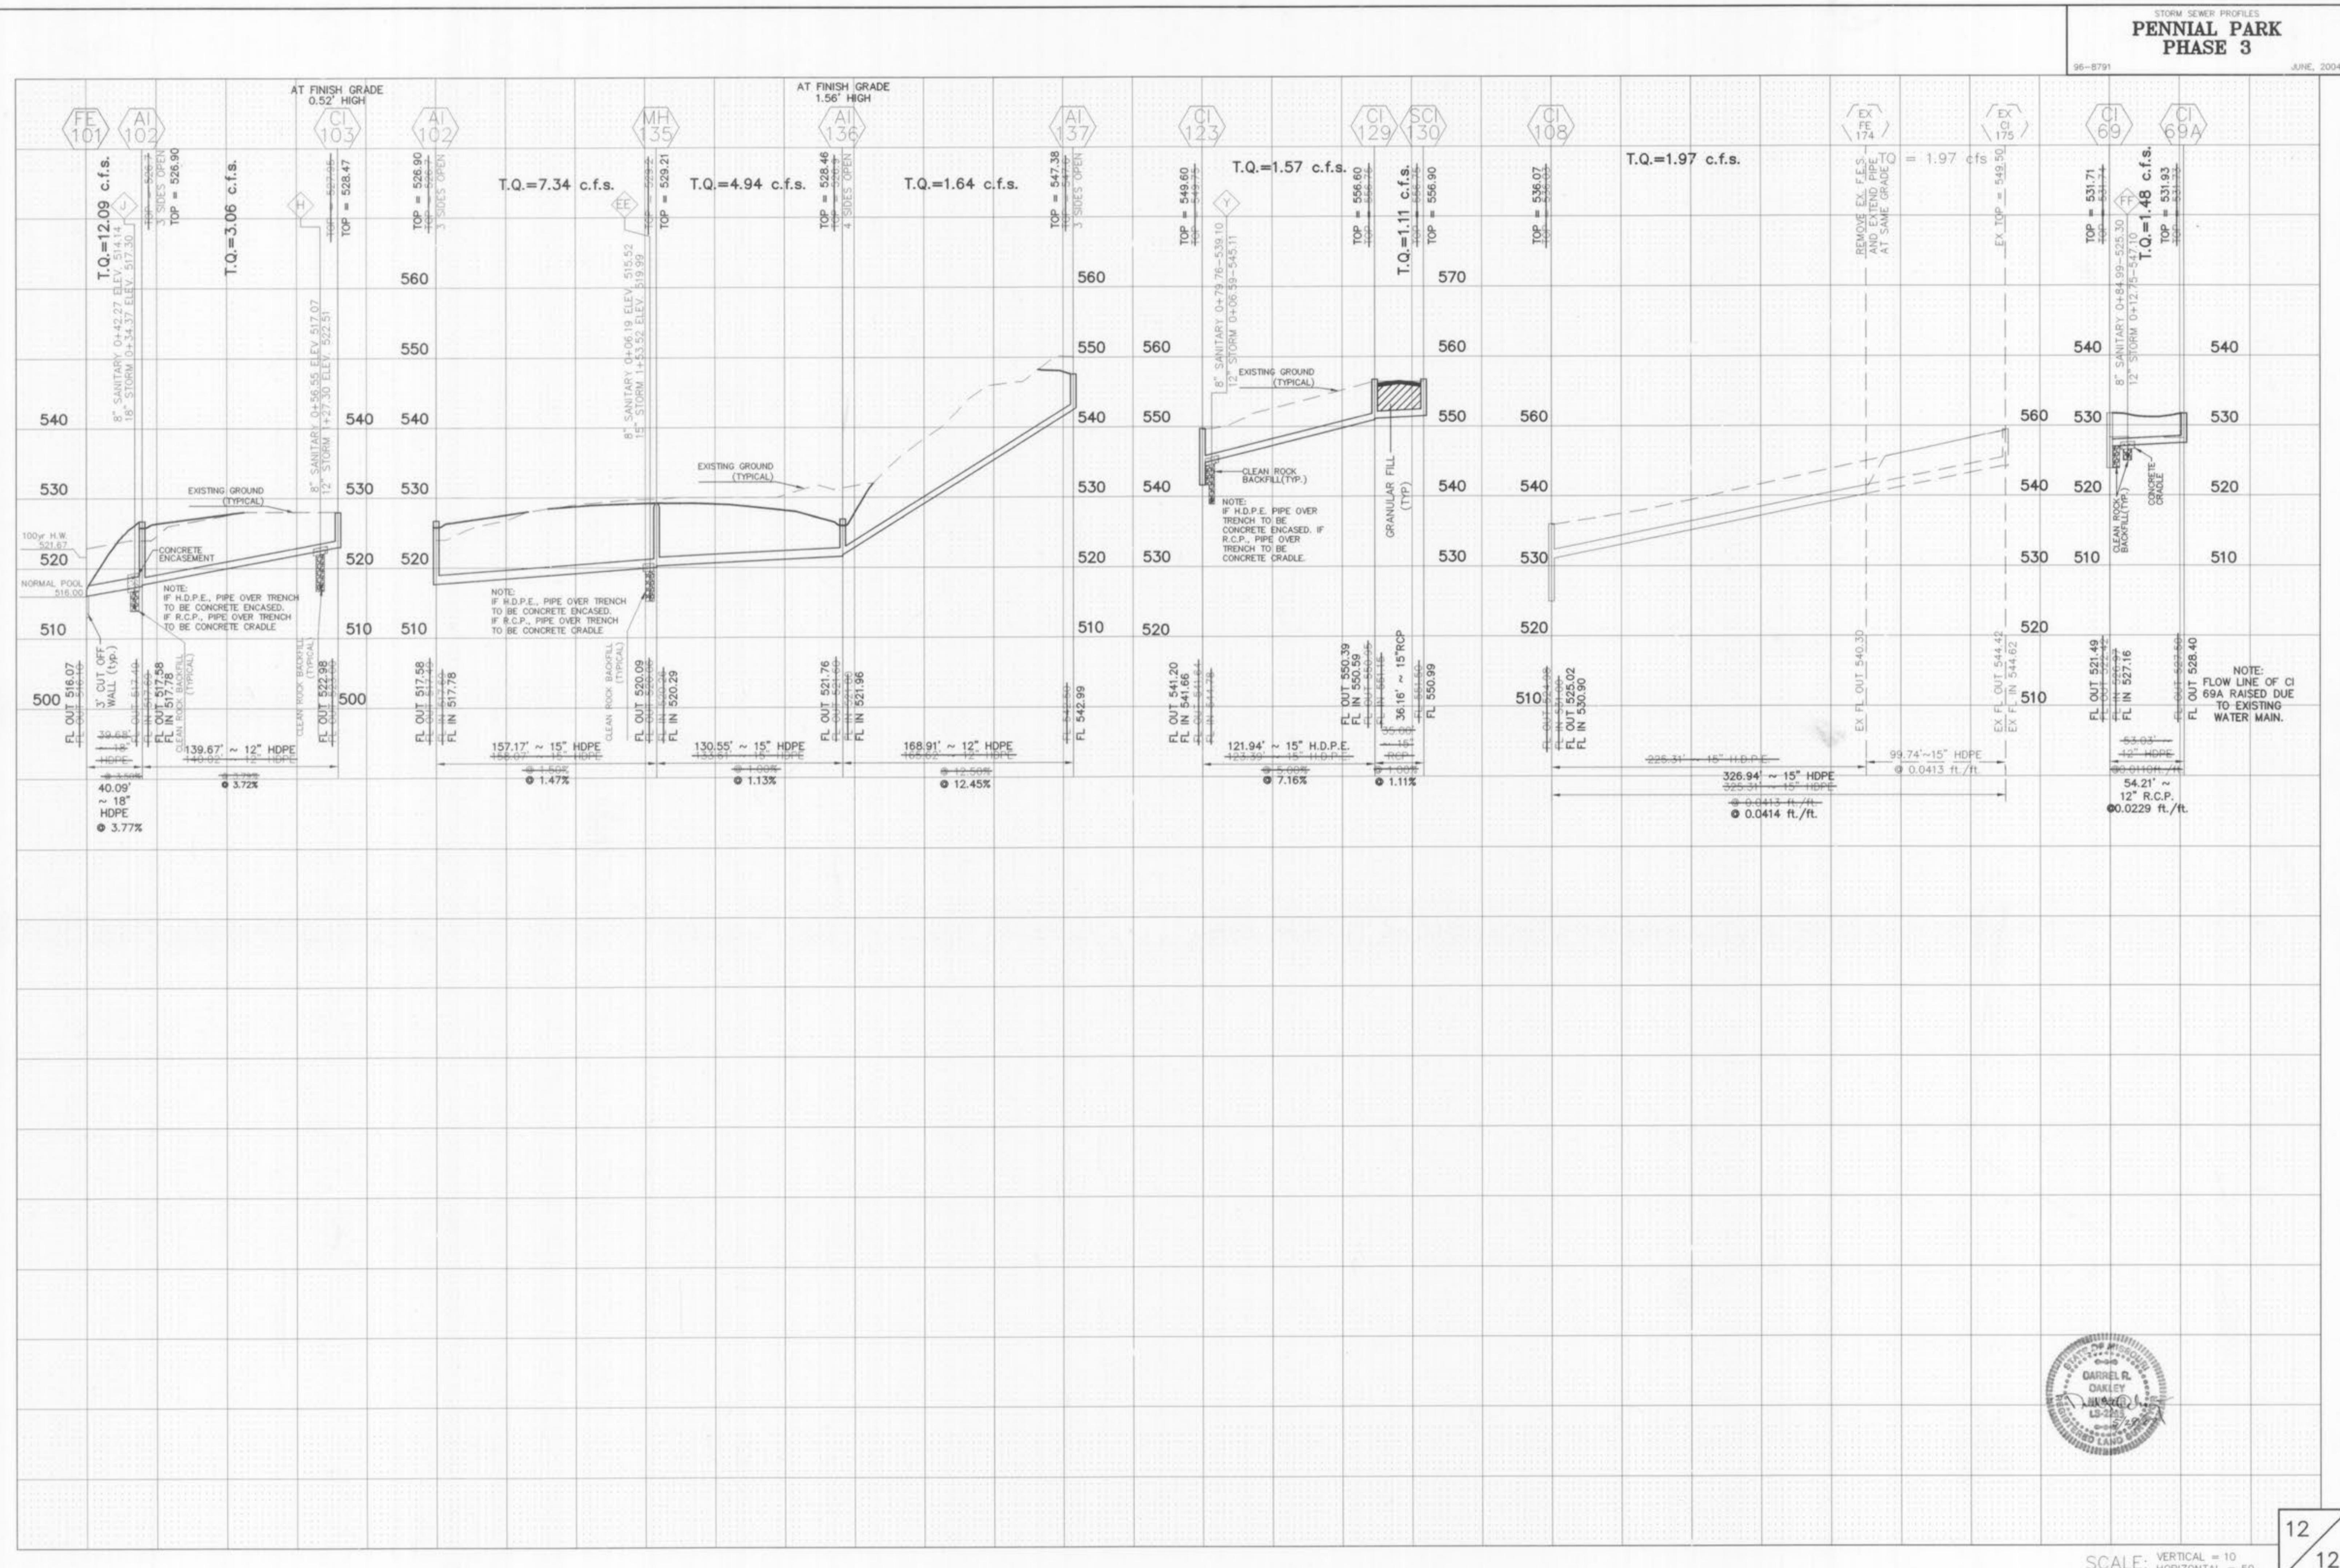

SCALE: VERTICAL = 10
HORIZONTAL = 50

12

Pennial Park Phase 3