

# A SET OF AS-BUILT PLANS FOR PENNIAL PARK PHASE TWO-PLAT TWO

A TRACT OF LAND BEING PART OF FRACTIONAL SECTION 4,  
TOWNSHIP 46 NORTH, RANGE 3 EAST  
OF THE FIFTH PRINCIPAL MERIDIAN,  
CITY OF O'FALLON, ST. CHARLES COUNTY, MISSOURI

## GRADING NOTES

- A Geotechnical Engineer shall be employed by the owner and be on site during grading operations. All soils tests shall be verified by the Geotechnical Engineer concurrent with the grading and backfilling operations.
- The grading contractor shall perform a complete grading and compaction operation as shown on the plans, stated in these notes, or reasonably implied therefrom, all in accordance with the plans and notes as interpreted by the Geotechnical Engineer.
- The Contractor shall notify the Soils Engineer at least two days in advance of the start of the grading operation.
- All areas shall be allowed to drain. All low points shall be provided with temporary ditches.
- A sediment control plan that includes monitored and maintained sediment control basins and/or straw bales should be implemented as soon as possible. No graded area is to be allowed to remain bare without being seeded and mulched. Care should be exercised to prevent soil from damaging adjacent property and silt up existing downstream storm drainage system.
- Debris and foundation material from any existing on-site building or structure which is scheduled to be razed for this development must be disposed of off-site.
- All trash and debris on site, either existing or from construction, must be removed and properly disposed of off-site.
- Soft soil in the bottom and banks of any existing or former pond sites or tributaries or on any sediment basins or traps should be removed, spread out and permitted to dry sufficiently to be used as fill. None of this material should be placed in proposed public right-of-way locations or on any storm sewer locations.
- Site preparation includes the clearance of all stumps, trees, bushes, shrubs, and weeds; the grubbing and removal of roots and other surface obstructions from the site; and the demolition and removal of any man-made structures. The material shall be properly disposed of off-site. Topsoil and grass in the fill areas shall be thoroughly disced prior to the placement of any fill. The Soils Engineer shall approve the discing operation.
- Compaction equipment shall consist of tamping rollers, pneumatic-tired rollers, vibratory roller, or high speed impact type drum rollers acceptable to the Soils Engineer. The roller shall be designed so as to avoid the creation of a layered fill without proper blending of successive fill layers.
- The Soils Engineer shall observe and test the placement of the fill to verify that specifications are met. A series of fill density tests will be determined on each lift of fill. Interim reports showing fill quality will be made to the Owner at regular intervals. Developer must supply City construction inspectors with soil reports prior to or during site soil testing. If reports have been prepared for the project.
- The Soils Engineer shall notify the Contractor of rejection of a lift of fill or portion thereof. The Contractor shall rework the rejected portion of fill and obtain notification from the Soils Engineer of its acceptance prior to the placement of additional fill.
- All areas to receive fill shall be scarified to a depth of not less than 6 inches and then compacted in accordance with the specifications given below. Natural slopes steeper than 1 vertical to 5 horizontal to receive fill shall have horizontal benches, cut into the slopes before the placement of any fill. The width and height to be determined by the Soils Engineer. The fill shall be loosely placed in horizontal layers not exceeding 8 inches in thickness and compacted in accordance with the specifications given below. The Soils Engineer shall be responsible for determining the acceptability of soils placed. Any unacceptable soils placed shall be removed at the Contractor's expense.
- The sequence of operation in the fill areas will be fill, compact, verify acceptable soil density, and repetition of the sequence. The acceptable moisture contents during the filling operation are those at which satisfactory dry densities can be obtained. The acceptable moisture contents during the filling operation in the remaining areas are from 2 to 8 percent above the optimum moisture control.
- The surface of the fill shall be finished so that it will not erode. If at the end of a day work it would appear that there may be rain prior to the next working day, the surface shall be finished smooth. If the surface has been finished smooth for any reason, it shall be scarified before proceeding with the placement of succeeding lifts. Fill shall not be placed on frozen ground, nor shall filling operations continue when the temperature is such as to permit the layer under placement to freeze.
- Fill and backfill should be compacted to the criteria specified in the following table:


CATEGORY	MINIMUM PERCENT COMPACTION
Fill in building areas below footings	90%
Fill under slabs, walks, and pavement	90%
Fill other than building areas	88%
Natural subgrade	88%
Pavement subgrade	90%
Pavement base course	90%

Measured as a percent of the maximum dry density as determined by modified Proctor Test (ASTM-D-1557).

Moisture content must be within 2 percent below or 4 percent above optimum moisture content if fill is deeper than 10 feet.

## GENERAL NOTES

- Underground utilities have been plotted from available information and therefore their locations shall be considered approximate only. The verification of the location of all underground utilities, either shown or not shown on these plans shall be the responsibility of the contractor, and shall be located prior to any grading or construction of the improvements.
- All manhole tops & flowlines built without elevations furnished by the Engineer will be the responsibility of the sewer contractor.
- 8" P.V.C. sanitary sewer pipe shall meet the following standards. A.S.T.M.-D-3034 SDR-35, with wall thickness compression joint A.S.T.M.-D-3212. An appropriate rubber seal waterstop as approved by the sewer district shall be installed between P.V.C. pipe and masonry structures.
- All filled places, including trench backfills, under buildings, proposed storm and sanitary sewer lines and/or paved areas, shall be compacted to 90% maximum density as determined by the "Modified AASHTO T-180 Compaction Test," (A.S.T.M.-D-1557). All filled places within public roadways shall be compacted to 95% of maximum density as determined by the "Standard Proctor Test AASHTO T-99, Method C" (A.S.T.M.-D-698).
- All trench backfills under paved areas shall be granular backfill, and shall be compacted to 90% of the maximum density as determined by the "Modified AASHTO T-180 Compaction Test," (A.S.T.M.-D-1557). All other trench backfills may be earth material (free of large clods or stones). All trench backfills shall be water jetted.
- All sanitary house connections have been designed so that the minimum vertical distance from the low point of the basement to the flow line of a sanitary sewer at the corresponding house connection is not less than the diameter of the pipe plus the vertical distance of 2 1/2 feet.
- No area shall be cleared without the permission of the Project Engineer.
- All P.V.C. sanitary sewer is to be SDR-35 or equal with clean 1/2" to 1" granular stone bedding uniformly graded. This bedding shall extend from 4" below the pipe to the springline of the pipe. Immediate backfill over pipe shall consist of some size "clean" or minus stone from springline of pipe to 6" above the top of pipe.
- All soils test shall be verified by a Soils Engineer concurrent with the grading and backfilling operations.
- Easements shall be provided for sanitary sewers, and all utilities on the Record Plat. See Record Plat for location and size of easements.
- Maintenance and upkeep of the common ground area shall be the responsibility of the developer and/or successors.
- A 25' building line shall be established along all Public Rights-Of-Ways.
- All water lines shall be laid at least 10 feet horizontally, from any sanitary sewer, storm sewer, or manhole, 18" vertical clearance from outside of pipe to outside of pipe shall be maintained wherever water lines cross sanitary sewers, laterals, or storm drains the water line shall be laid at such an elevation that the bottom of the water line is above the top of the drain or sewer. A full length of water pipe shall be centered over the sewer line to be crossed so that the joints will be equally distant from the sewer and as remote therefrom as possible. This vertical separation shall be maintained for that portion of the water line located within 10 feet horizontally, of any sewer or drain it crosses.
- All PVC water pipe shall conform to A.S.T.M.-D-2241, SDR 21 Standard Specification for P.V.C. Pressure Pipe, 200 P.S.I. working pressure for water, with approved joint.
- Water lines, valves, sleeves, meters, and fittings shall meet all specifications and installation requirements of Public Water Supply District No. 2 of St. Charles County.
- All water hydrants and valves shall be ductile iron and installed in accordance with plans and details. All ductile iron pipe for water mains shall conform to A.W.W.A. Specifications C-108 and/or C-108. The ductile iron fittings shall conform to A.W.W.A. Specification CC-110. All rubber gasket joints for water ductile iron pressure pipe and fittings shall conform to A.W.W.A. Specification C-111.
- All sanitary manholes shall be waterproofed on the exterior in accordance with Missouri Department of Natural Resources specifications 10 CSR-8120 (7)E.
- Brick will not be used in the construction of sanitary sewer manholes.
- All pipes shall have positive drainage through manholes. No flat base structures are allowed.
- The City of O'Fallon and Duckett Creek Sanitary District shall be notified 48 hours prior to construction for coordination and inspection.
- Gas, water and other underground utilities shall not conflict with the depth or horizontal location of existing or proposed sanitary or storm sewers, including house laterals.
- All existing site improvements disturbed, damaged or destroyed shall be repaired or replaced to closely match pre-construction conditions.
- The contractor shall prevent all storm, surface water, mud and construction debris from entering the existing sanitary sewer system.
- All construction and materials shall conform to the current construction standards of the City of O'Fallon and Duckett Creek Sanitary District.
- All sanitary and storm sewer trench backfills shall be water jetted. Granular backfill will be used under pavement areas.
- All existing areas disturbed during construction of the off-site sanitary sewer line shall be seeded and mulched to prevent erosion.
- All sanitary sewer laterals shall be a minimum of 4" in diameter per City of O'Fallon.
- No flushing hydrants or water meters shall be located in driveways and/or walkways.
- All storm inlets must be installed with a 5/8" trash bar across the opening.

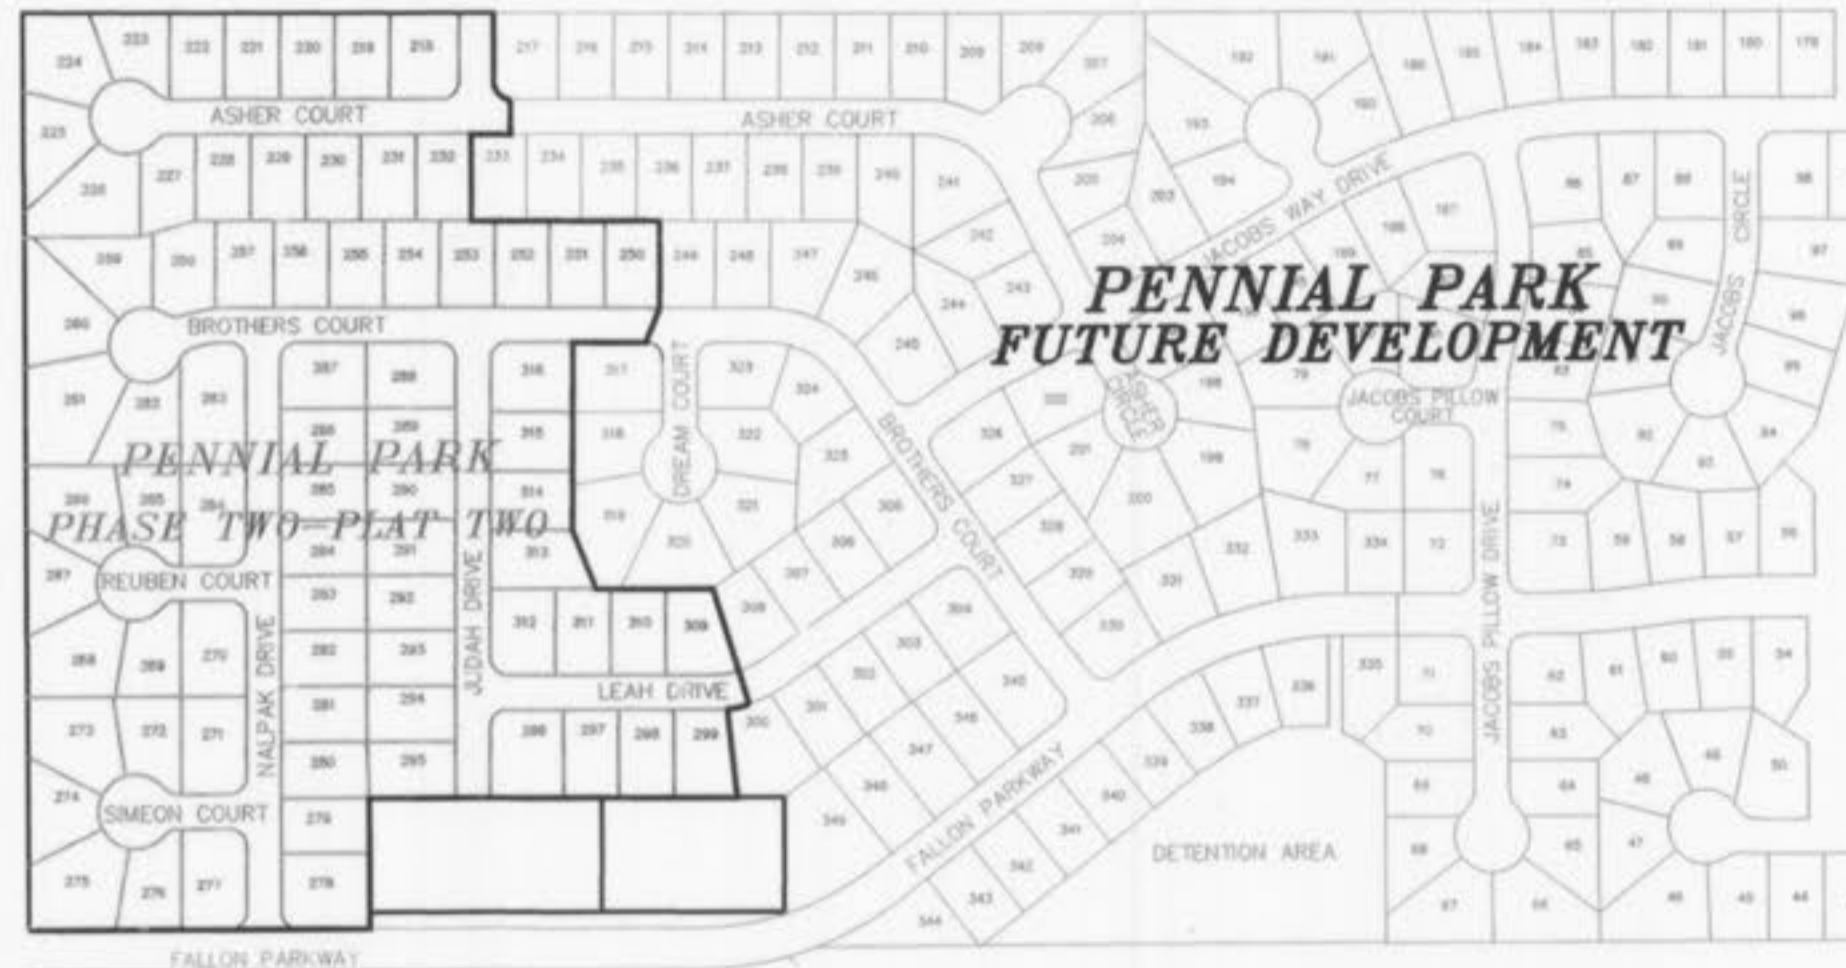

## GENERAL NOTES (CONT.)

- Concrete pipe for storm sewers shall be Class III, A.S.T.M. C-76 with a minimum diameter of 12" except in the R.O.W. it shall be 15".
- The ADS N-12 pipe shall have a smooth interior wall.
- Concrete pipe joints shall be MSD type "A" approved compression-type joints and shall conform to the requirements of the specifications for joints for circular concrete sewer and culvert pipe, using flexible, watertight, rubber-type gaskets (A.S.T.M.-C-443). Band-type gaskets depending entirely on cement for adhesion and resistance to displacement during jointing shall not be used.
- When HDPE pipe is used, City of O'Fallon specifications or manufacturers specifications, which ever are more stringent, shall be followed.
- The use of High Density Polyethylene Corrugated pipe, ADS N-12 or equal will be permitted as an acceptable alternative to reinforced concrete pipe, ADS N-12 HC shall be used for all ADS pipe greater than 36". Pipe shall meet A.S.T.M.-D-2321 and A.A.S.H.T.O. M-294-291.
- All flared end sections and inlet structures will be concrete.
- All storm sewer pipe installed in the Public Right-of-Way shall be Reinforced concrete Class III pipe.
- All concrete pipe or ADS N-12 pipe shall be installed with "O-Ring" Rubber type gaskets per M.S.D. standard construction specifications or manufacturer.
- Blow-off hydrants and water meters shall not be located in any pavement or hard surfaced area including, but not limited to, driveways, sidewalks, and streets. Since the location of all such areas is not shown on this plan all costs to relocate any blow-off hydrants and water meters from any pavement or hard surfaced areas shall be borne by the Developer or the Builders.
- All creek crossings shall be grouted rip-rap as directed by District inspectors. (All grout shall be high slump ready-mix concrete.)
- Existing sanitary sewer service shall not be interrupted.
- Pre-manufactured adapters shall be used at all PVC to DIP connections. Rubber boot/Mission-type couplings will not be allowed.
- Any permits, licenses, easements, or approvals required to work on public or private properties or roadways are the responsibility of the developer.
- No slopes shall exceed 3(H):1(V).
- Driveway locations shall not interfere with the sidewalk handicap ramps in the cul-de-sacs.
- All sign posts and hardware to be painted black, per City of O'Fallon requirements.
- City approval of the Construction plans does not mean that Single Family and Two Family dwelling units can be constructed on lots without meeting the minimum building setbacks as required by the Zoning Code.
- Sidewalks and sidewalk curb ramps shall be constructed in accordance with the current approved "Americans with Disabilities Act Accessibility Guidelines" (A.D.A.A.G.). If any conflict occurs between the above information and the plans the A.D.A.A.G. shall take precedence and the contractor prior to any construction shall notify the Project Engineer.
- Contractor shall assume complete responsibility for controlling all siltation and erosion of the project area. The contractor shall use whatever means necessary to control erosion and siltation including, but not limited to, staked straw bales and/or siltation fabric fences (possible methods of control are detailed in the plan). Control shall commence with grading and be maintained throughout the project until acceptance of the work by the owner and/or the City of O'Fallon. The contractor's responsibilities include oil design and implementation as required to prevent erosion and the depositing of silt. The Owner and/or the City of O'Fallon may at their option direct the contractor in his methods as deemed fit to protect property and improvements. Any depositing of silts or mud on new or existing pavement or in new or existing storm sewers or swales shall be removed after each rain and affected areas cleaned to the satisfaction of the Owner and/or City of O'Fallon.

## REFERENCE BENCHMARK

R.M. #74 - ELEV=493.07 (U.S.G.S. DATUM)  
CHISELED SQUARE ON TOP OF EAST CONCRETE  
HEADWALL OF BIRDIE HILLS ROAD BRIDGE OVER  
TRIBUTARY NO. 2 (APPROXIMATELY 500 FEET  
SOUTH OF EISENHOWER DRIVE)

## SITE BENCHMARK

ELEV=572.28 (U.S.G.S. DATUM)  
OLD CROSS-CL. SWEETBAY DRIVE AND  
CHERRYWOOD PARK DRIVE, CHERRYWOOD  
PARK SUBDIVISION

## NOTE:

**INSPECTION MUST BE 90% COMPLETED  
AND PASSED ON EXISTING SEWERS PRIOR  
TO NEW DEVELOPMENT CONNECTION.**

VEGETATIVE ESTABLISHMENT  
For Urban Development Sites  
APPENDIX A

Seeding Rates:	
Permanent:	
Tall Fescue	30 lbs./ac.
Smooth Brome	20 lbs./ac.
Combined Fescue & Brome	15 lbs./ac. and Brome @ 10 lbs./ac.
Temporary:	
Wheat or Rye	150 lbs./ac. (3.5 lbs. per square foot)
Oats	120 lbs./ac. (2.75 lbs. per square foot)
Seeding Periods:	
Fescue or Brome	March 1 to June 1
	August 1 to October 1
Wheat or Rye	March 15 to November 1
Oats	March 15 to September 15
Mulch Rates:	100 lbs. per 1,000 sq. feet (4,356 lbs. per acre)
Fertilizer Rates:	
Nitrogen	30 lbs./ac.
Phosphate	30 lbs./ac.
Potassium	30 lbs./ac.
Lime	600 lbs./ac. ENM*
* ENM = effective neutralizing material as per State evaluation of quarried rock.	

## SEWER MEASUREMENTS

THE EXISTING SEWER LENGTHS, SIZES, FLOWLINES, DEPTHS OF STRUCTURES AND SEWERS AND LOCATIONS WITH RESPECT TO EXISTING OR PROPOSED EASEMENTS HAVE BEEN MEASURED. THE RESULTS OF THOSE MEASUREMENTS ARE SHOWN ON THIS SET OF FINAL MEASUREMENT PLANS.

ALL PUBLIC SEWERS ARE LOCATED WITHIN DESIGNATED EXISTING OR PROPOSED EASEMENTS EXCEPT AS FOLLOWS:



ASBUILT NOTE:  
ALL DISTANCE AND SLOPE CALCULATIONS ARE FROM CENTER OF STRUCTURE TO CENTER OF STRUCTURE.



## DEVELOPMENT NOTES

- Area of Tract: 24.00 Acres
- Existing Zoning: R-1 (City of O'Fallon)
- Proposed Use: Single Family Homes
- Number of Lots Proposed: 73 Lots
- The proposed height and lot setbacks are as follows:  
Minimum Front Yard: 25 feet  
Minimum Side Yard: 6 feet  
Minimum Rear Yard: 25 feet  
Minimum Lot Area: 10,000 square feet  
Maximum Height of Building: 2 1/2 stories or 35 feet
- Current Owner/Developer: Kaplan Development Company  
5140 North Service Road  
St. Peters, MO 63376
- Site is served by: Duckett Creek Sanitary District  
AmerenUE  
St. Charles Gas Company  
St. Charles County Public Water District No. 2  
Verizon Telephone Company  
Fort Zumwalt School District  
O'Fallon Fire Protection District
- No Flood Plain exists on this site per F.I.R.M. #29183 C 0243E, dated Aug. 2, 1996.
- Topographic information is per Walker and Associates Topo on U.S.G.S. Datum.
- Boundary information is per Bax Engineering during August, 1999.
- All streets will be constructed to City of O'Fallon standards. Streets will consist of 26 foot wide concrete pavement with integral rolled curb centered in a 50 foot right-of-way. With exception to Fallon Parkway which will consist of 36 foot wide concrete pavement with integral rolled curb centered in a 60 foot right-of-way. Minimum radius shall be 150 feet.
- All cul-de-sacs and bunnies will have pavement radii of 42 feet with right-of-way radii of 54 feet. Street intersections shall have a minimum rounding radius of 25 feet with pavement radii of 37 feet.
- Minimum street grades shall be 1%.
- All subdivision streets to have concrete pavement on prepared earth subgrade. No rock or lime base will be used.
- All homes will have driveway access to interior subdivision streets. Lots 275, 276, 277 & 278 will not have access to Fallon Parkway.
- A 4 foot wide concrete sidewalk shall be constructed on one side of streets where indicated.
- All homes shall have a minimum of 2 off-street parking places with 2-car garages.
- All utilities must be located underground.
- Offsite detention in Avondale Heights Plat Seven must be constructed and functioning with the development of this phase.
- No construction traffic will be allowed from Cherrywood parc.
- The following lots are susceptible to street movement:  
223, 224, 225, 226, 258, 259, 260, 261, 262, 263, 265, 266, 267, 268, 269, 272, 273, 274, 275, 276, 299, 309.
- Calculations in accordance to the Tree Preservation Ordinance:  
Existing trees: 0.30 acres  
x 20%: 0.06 acres  
Saved trees: 0.07 acres  
Trees to be Replaced: No trees to be replaced  
Street Tree Requirements: 1 per lot/2 per corner lot = 86 trees  
Total Required: 86 trees
- Proposed street trees shall be hardwood varieties with a 2" minimum diameter and a minimum height of 8' per City of O'Fallon standards. Trees to be planted on the individual lots shall be selected by the homeowner from the O'Fallon Tree Planting Guide and planted after home construction and yard finish grading by the homeowner. Street trees to be maintained by the Home Owner's Association per subdivision Covenants and Restrictions. Street trees shall be centered within the area between back of curb and sidewalk or back of curb and property line.



CALL BEFORE  
YOU DIG!  
1-800-DIG-RITE

## SHEET INDEX

1	COVER SHEET
2	SITE PLAN
3-4	SANITARY SEWER PROFILES
5-6	STORM SEWER PROFILES

STATE OF MISSOURI  
I, Daniel R. Gabley, do hereby certify that the documents intended to be recorded by me and the seal attached to this document are true and correct copies of the original documents and that I am duly qualified to perform the duties of a Professional Engineer in the State of Missouri.

REVISIONS

NO.	DATE	REVISION
1	9-11-06	City Comments
2	2-28-07	City Comments
3	8-07	City Comments





11 Point West Blvd.  
Charles, MO 63301  
928-5552  
928-1718

SEPT. 2006  
TE  
PROJECT NUMBER  
96-8791  
SHEET OF 6  
8791ASBLTS2.DWG  
E NAME  
E F/SAZ  
AWN  
DRO  
SIGNED CHECKED

AS-BUILT ADDED SEPTEMBER, 2006


Penial Park Phase 2 Plat 2

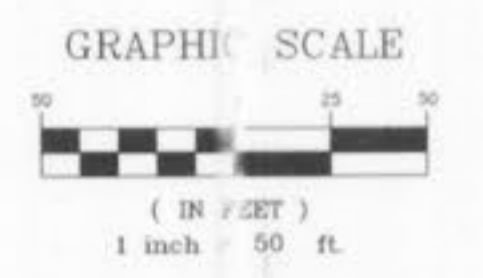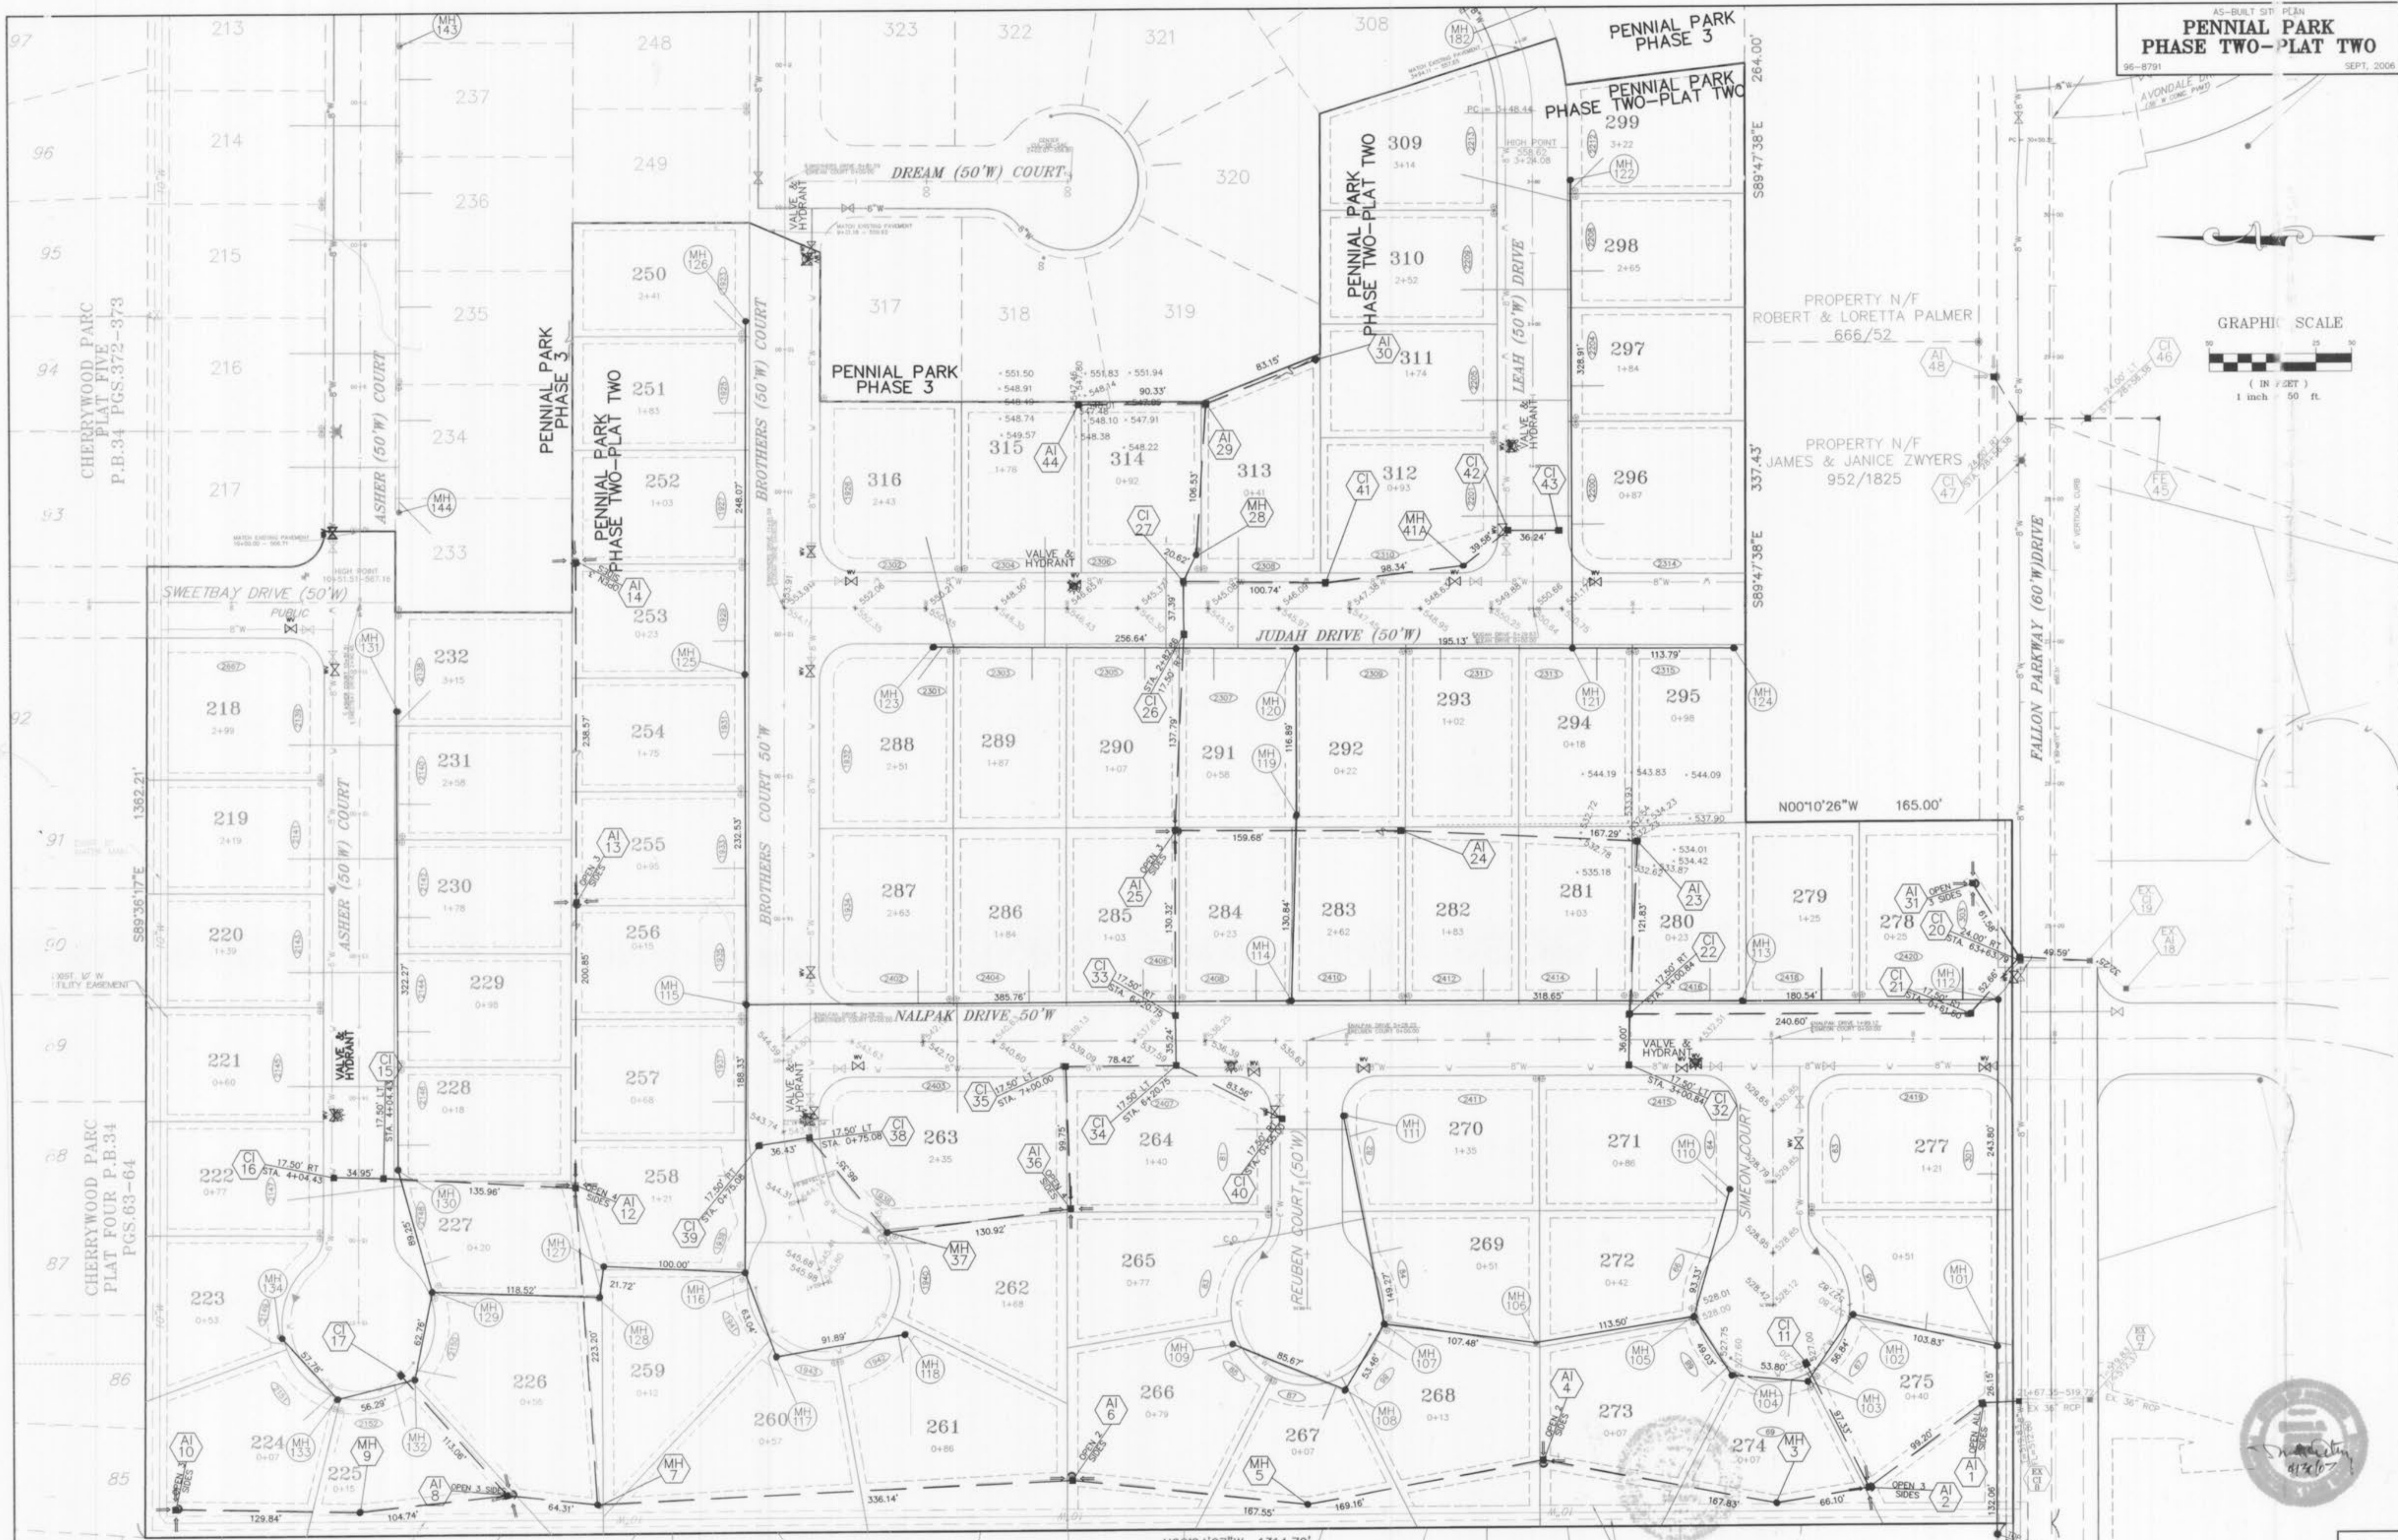

AS-BUILT ADDED SEPTEMBER, 2006

CHERRYWOOD PARC  
 PLAT TWO  
 P.B.33 PGS.117-118



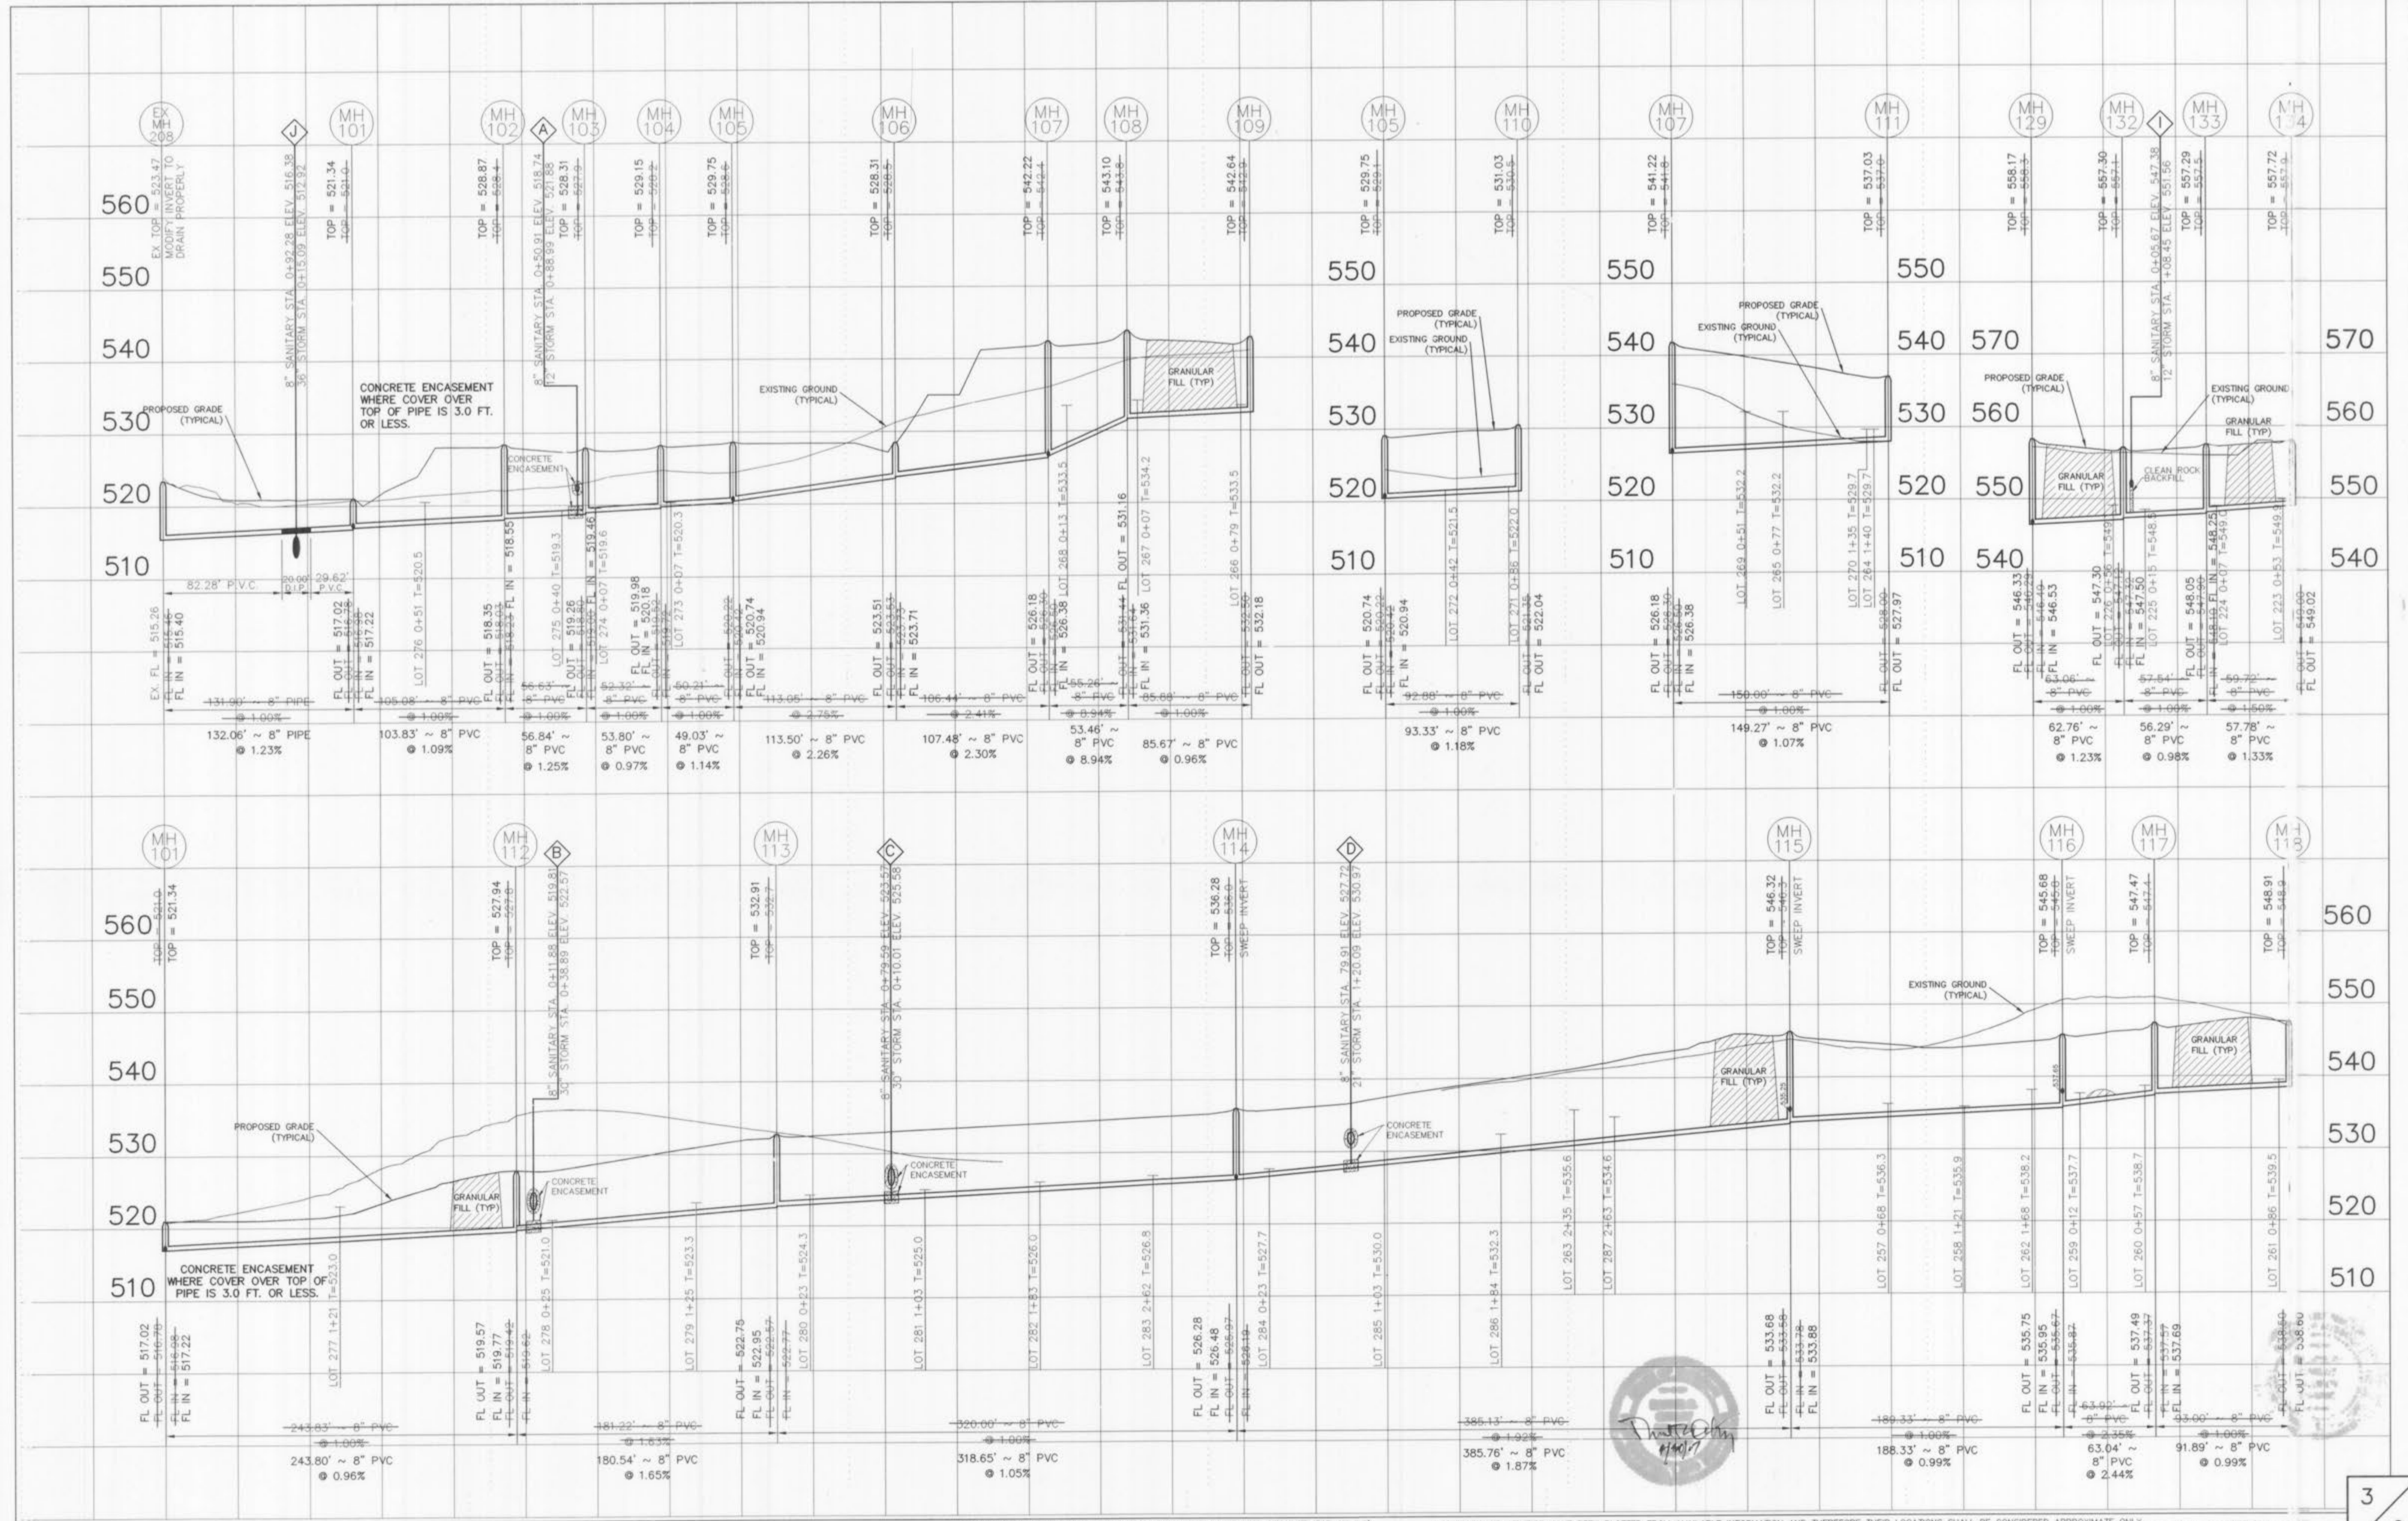


ALL SANITARY SEWER LATERAL TAILSTACK ELEVATIONS HAVE BEEN DESIGNED FOR AN 8.0' BASEMENT POUR IN HOMES WITH THE TOP OF FOUNDATION ELEVATION BEING SET A MINIMUM OF 2.0' ABOVE THE TOP OF CURB ELEVATION AT THE DRIVEWAY.

UNDERGROUND UTILITIES HAVE BEEN PLOTTED FROM AVAILABLE INFORMATION AND THEREFORE THEIR LOCATIONS SHALL BE CONSIDERED APPROXIMATE ONLY. THE VERIFICATION OF THE LOCATION OF ALL UNDERGROUND UTILITIES, EITHER SHOWN OR NOT SHOWN ON THESE PLANS SHALL BE THE RESPONSIBILITY OF THE CONTRACTOR, AND SHALL BE LOCATED PRIOR TO ANY GRADING OR CONSTRUCTION OF THE IMPROVEMENTS.


SCALE: VERTICAL = 1" = 5'  
 HORIZONTAL = 1" = 50'

AS-BUILT ADDED SEPTEMBER, 2006

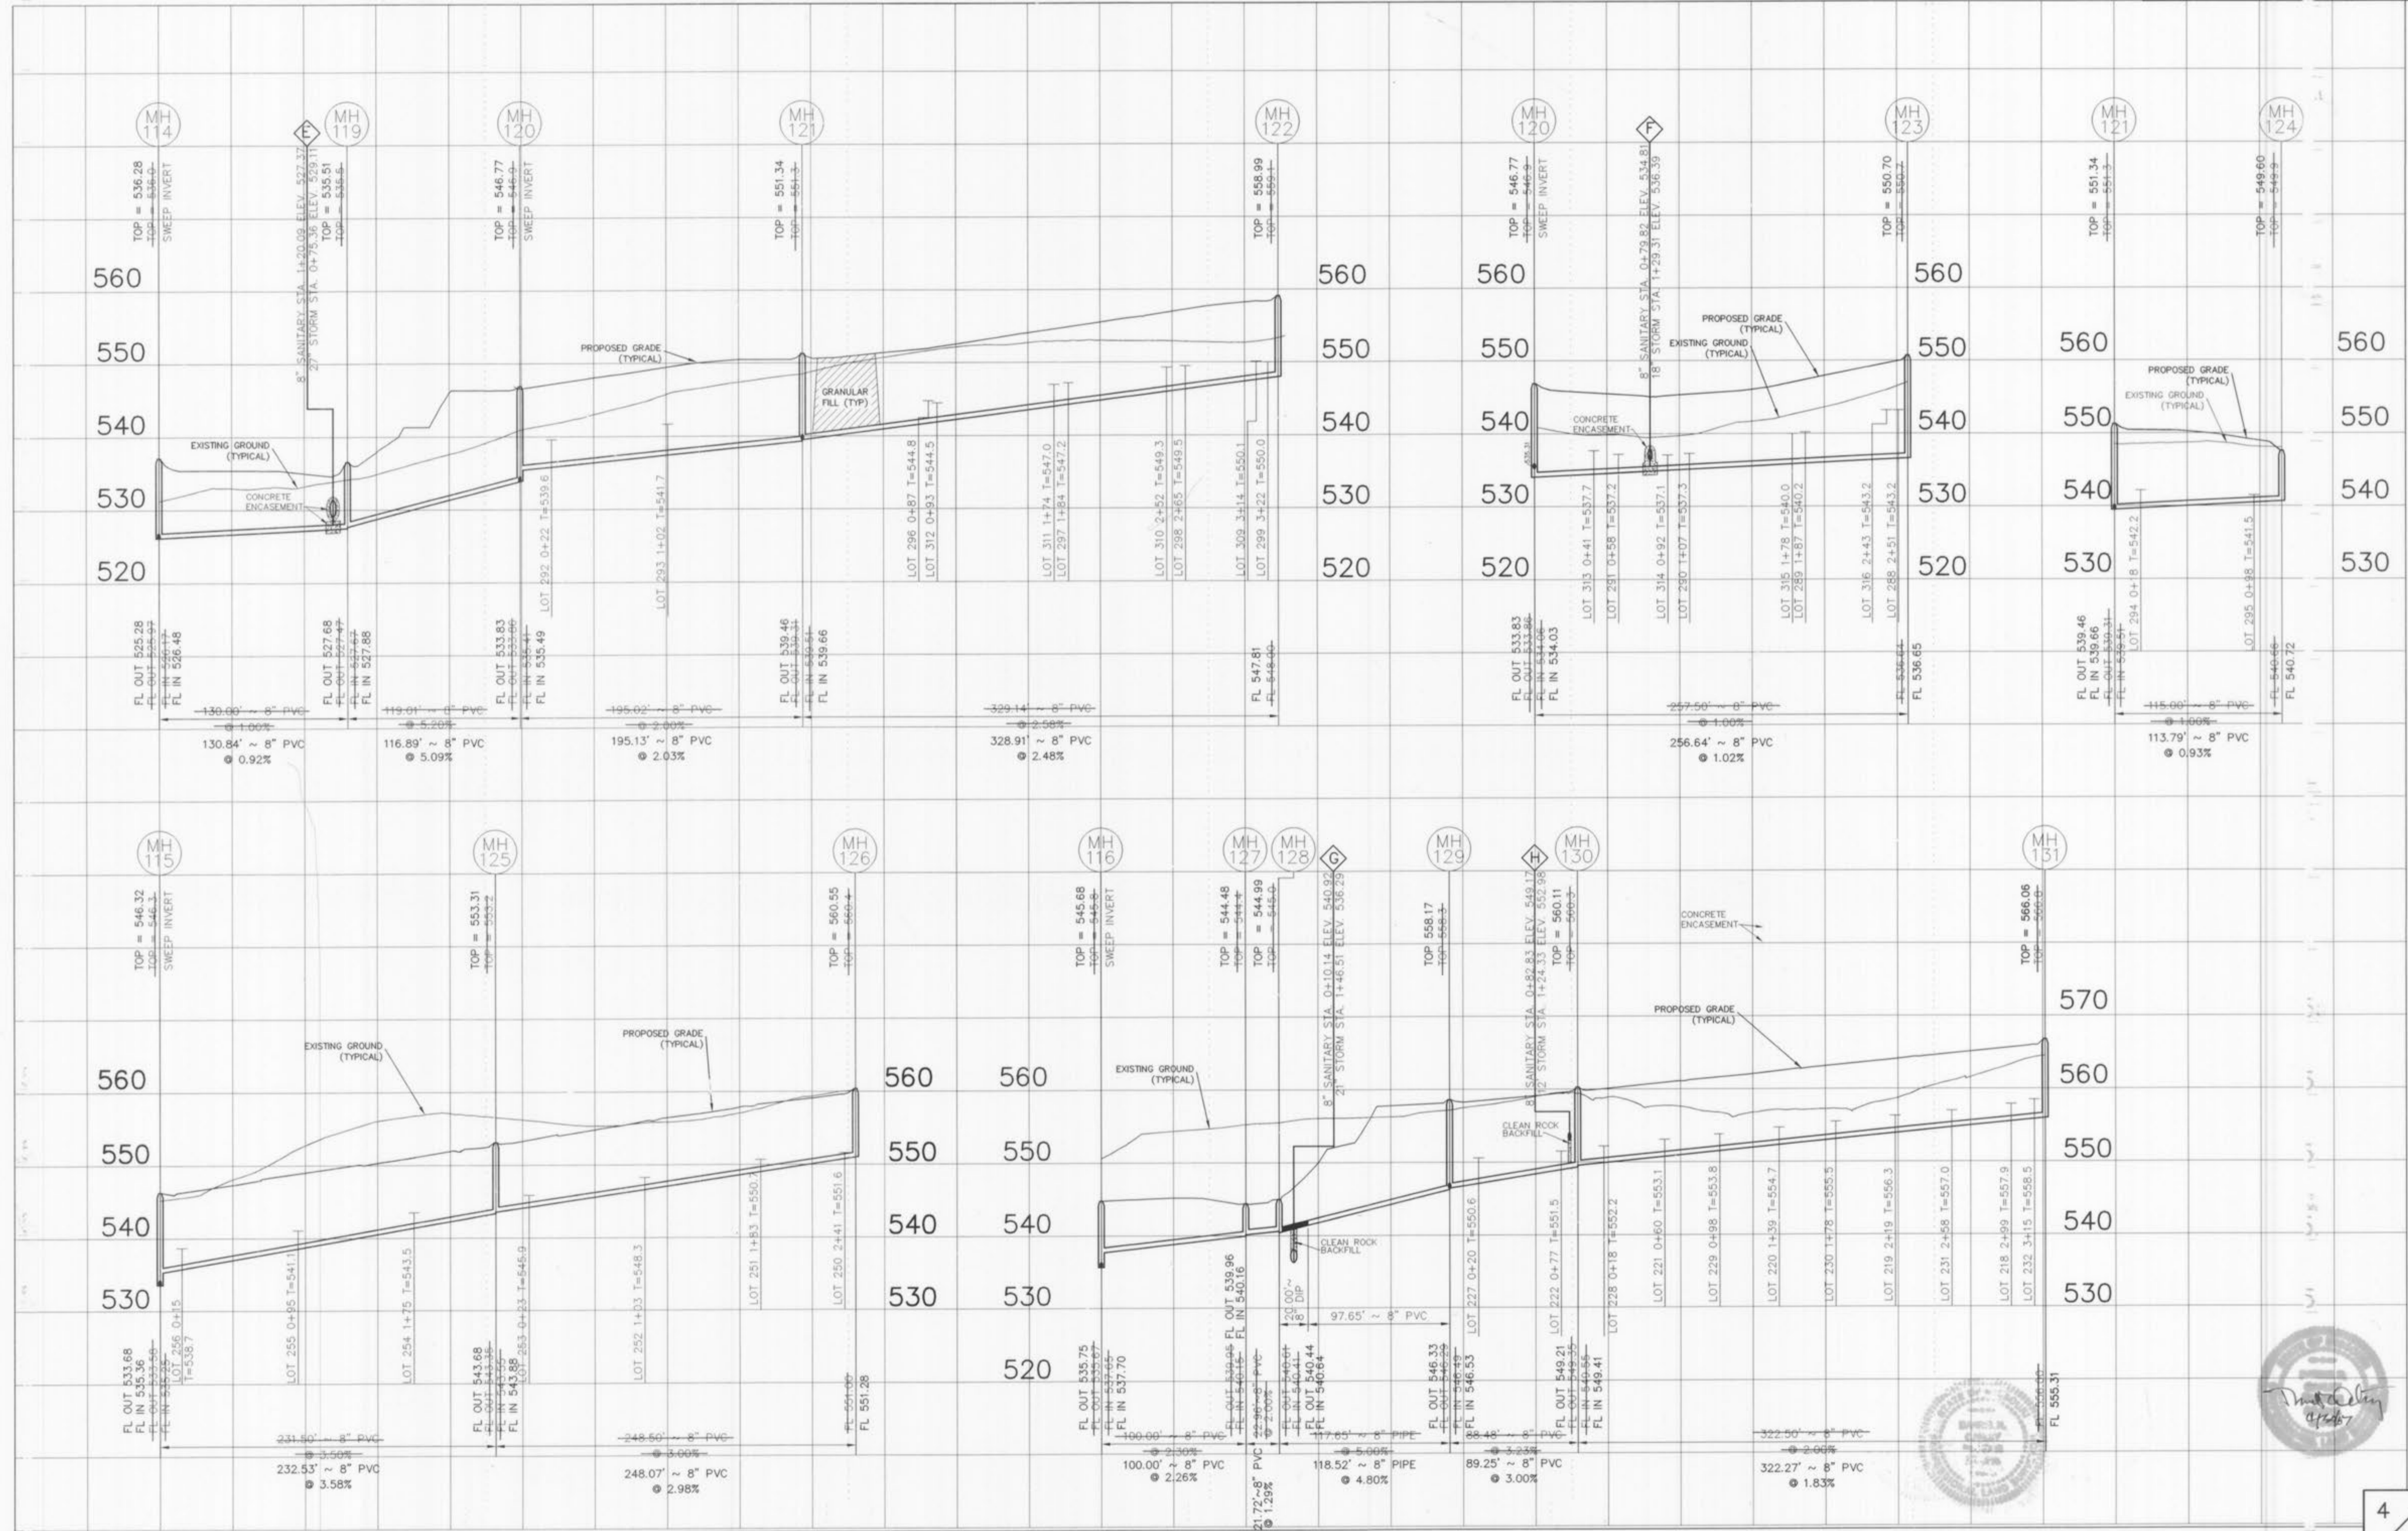

ALL SANITARY SEWER LATERAL TAILSTAKE ELEVATIONS HAVE BEEN DESIGNED FOR AN 8'0\"/>



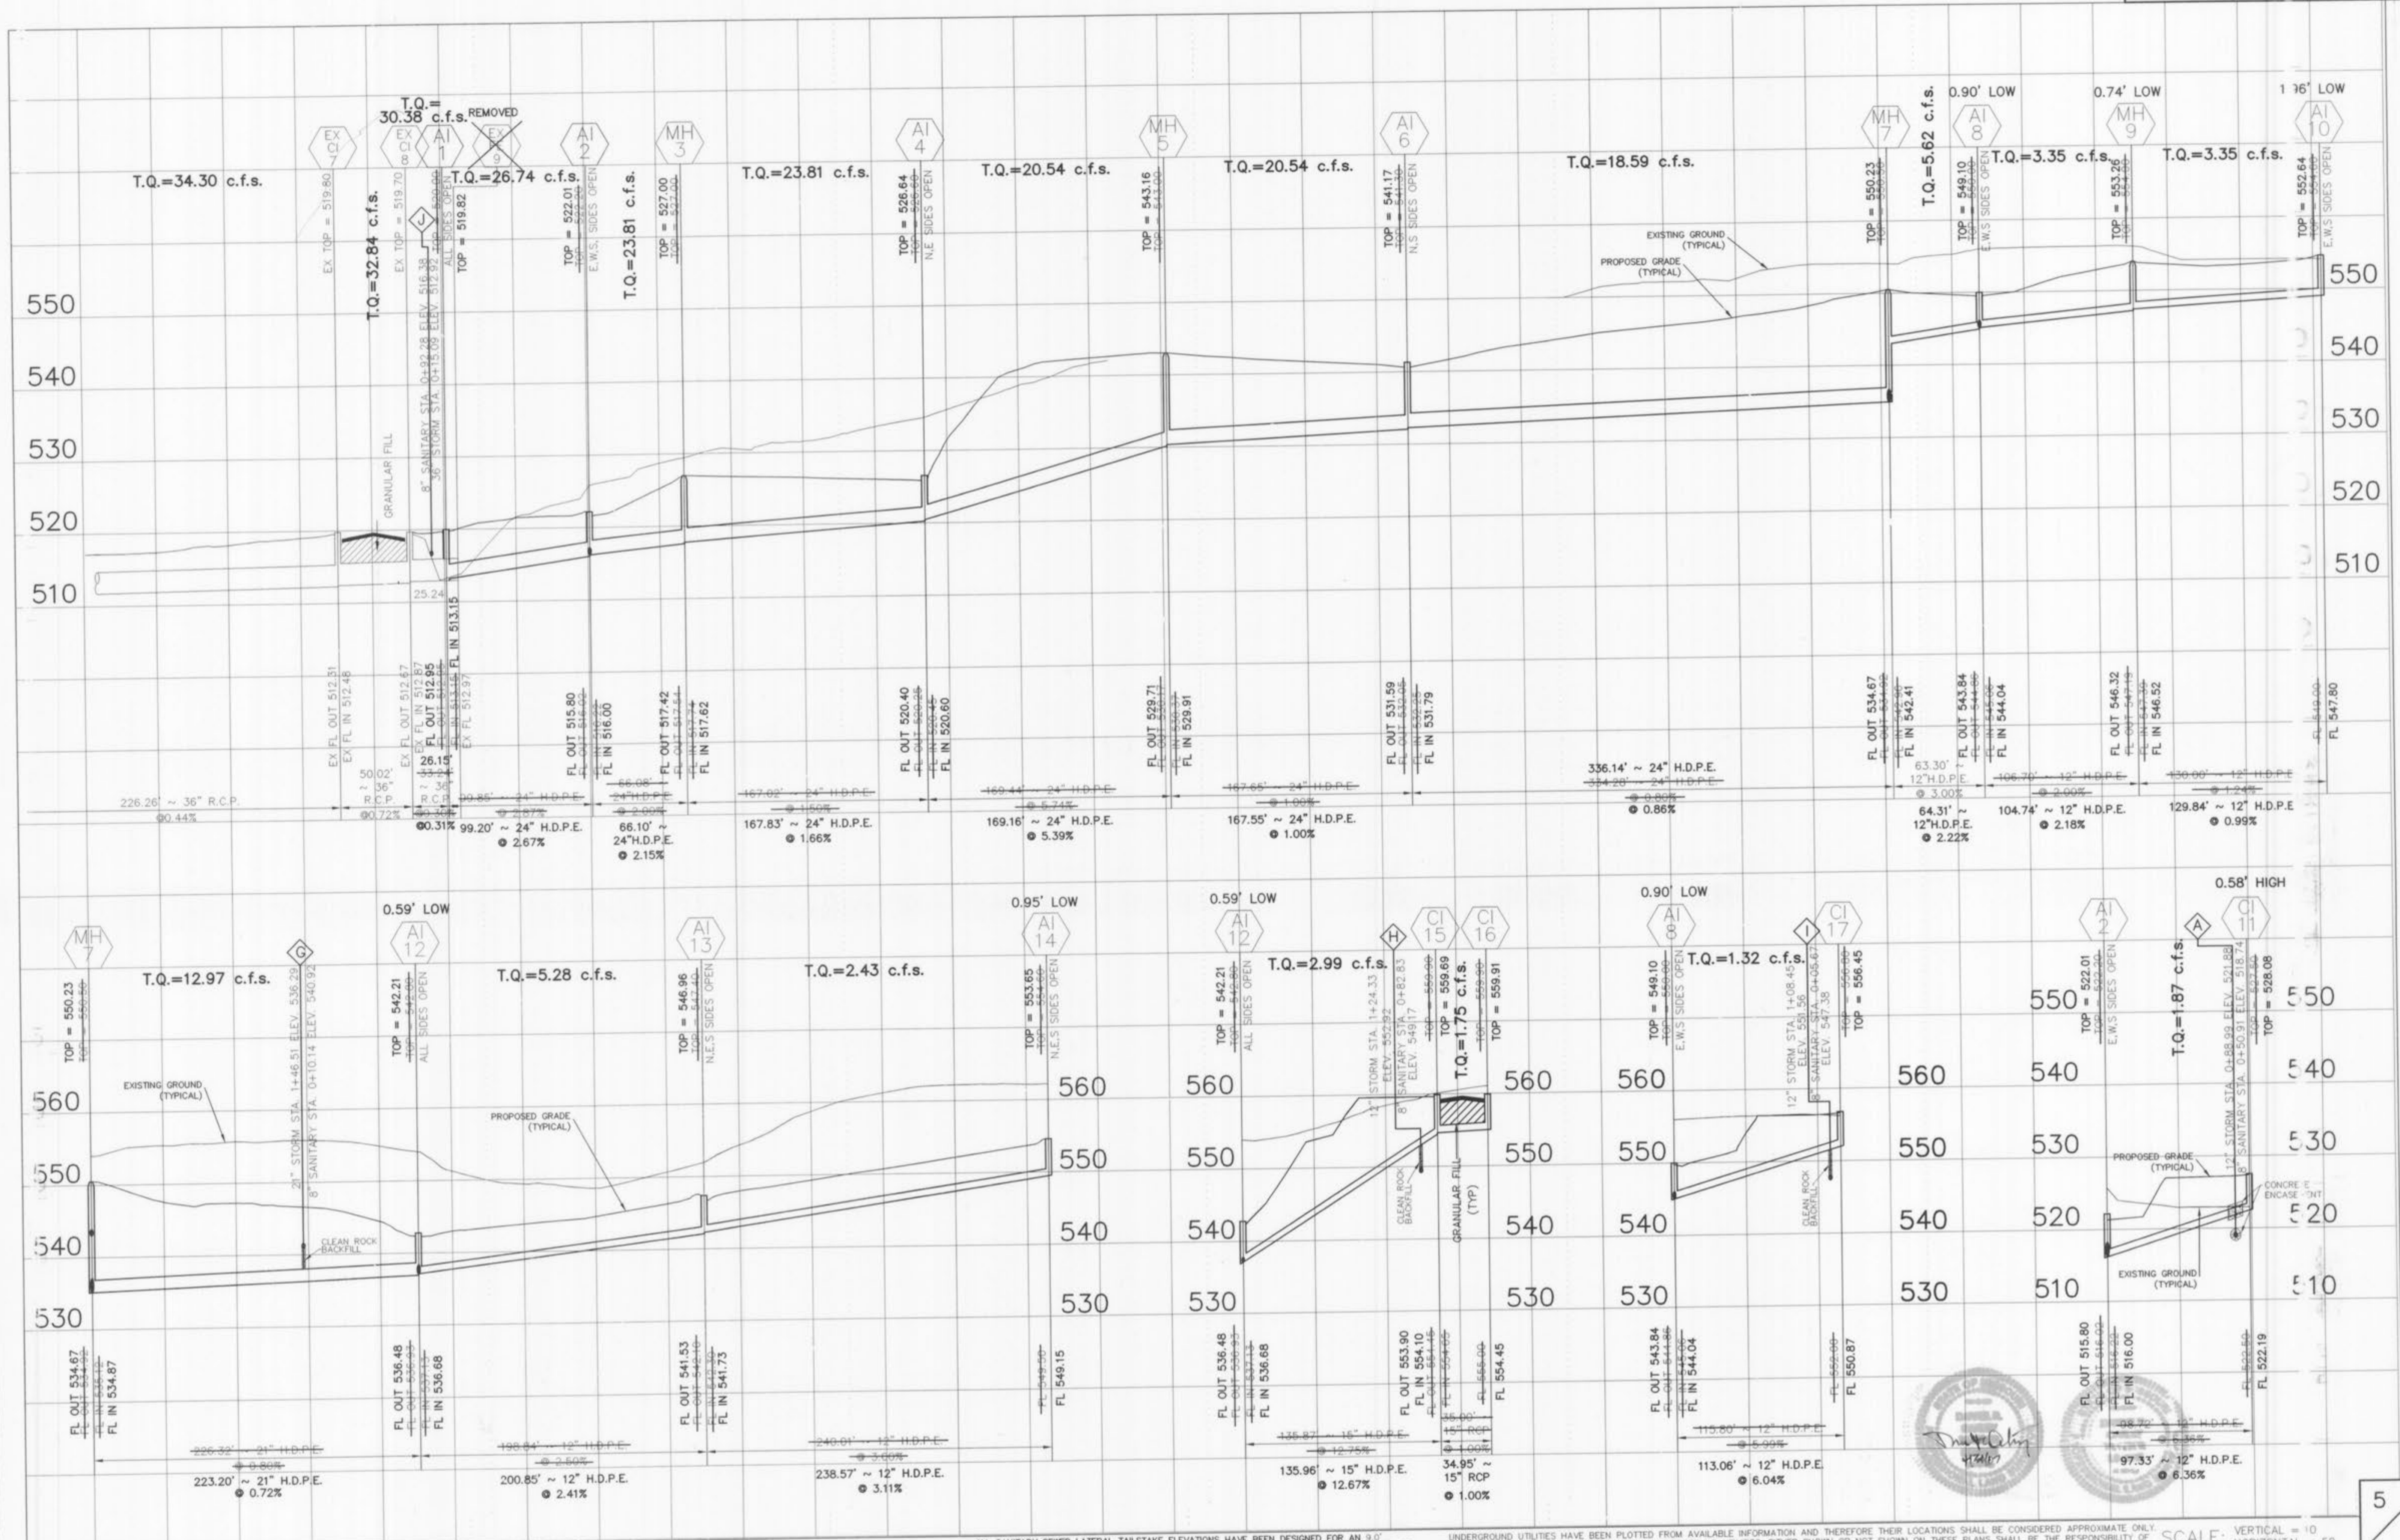

ALL SANITARY SEWER LATERAL TAILSTAKE ELEVATIONS HAVE BEEN DESIGNED FOR AN 8.0' BASEMENT POUR IN HOMES WITH THE TOP OF FOUNDATION ELEVATION BEING SET A MINIMUM OF 2.5' ABOVE THE TOP OF CURB ELEVATION AT THE DRIVEWAY.

UNDERGROUND UTILITIES HAVE BEEN PLOTTED FROM AVAILABLE INFORMATION AND THEREFORE THEIR LOCATIONS SHALL BE CONSIDERED APPROXIMATE ONLY. THE VERIFICATION OF THE LOCATION OF ALL UNDERGROUND UTILITIES, EITHER SHOWN OR NOT SHOWN ON THESE PLANS SHALL BE THE RESPONSIBILITY OF THE CONTRACTOR, AND SHALL BE LOCATED PRIOR TO ANY GRADING OR CONSTRUCTION OF THE IMPROVEMENTS.

SCALE: VERTICAL = 10  
HORIZONTAL = 50



ALL SANITARY SEWER LATERAL TAILSTAKE ELEVATIONS HAVE BEEN DESIGNED FOR AN 8.0' BASEMENT FLOOR IN HOMES WITH THE TOP OF FOUNDATION ELEVATION BEING SET A MINIMUM OF 2.5' ABOVE THE TOP OF CURB ELEVATION AT THE DRIVEWAY.

UNDERGROUND UTILITIES HAVE BEEN PLOTTED FROM AVAILABLE INFORMATION AND THEREFORE THEIR LOCATIONS SHALL BE CONSIDERED APPROXIMATE ONLY. THE VERIFICATION OF THE LOCATION OF ALL UNDERGROUND UTILITIES, EITHER SHOWN OR NOT SHOWN ON THESE PLANS SHALL BE THE RESPONSIBILITY OF THE CONTRACTOR, AND SHALL BE LOCATED PRIOR TO ANY GRADING OR CONSTRUCTION OF THE IMPROVEMENTS.

SCALE: VERTICAL = 1" = 5' HORIZONTAL = 1" = 50'

