

AS-BUILTS PARKSIDE VILLAS

A TRACT OF LAND BEING PART OF THE SOUTHWEST 1/4 OF
THE NORTHWEST FRACTIONAL 1/4 OF SECTION 22
TOWNSHIP 41 NORTH, RANGE 3 EAST
ST. CHARLES COUNTY, MISSOURI

TOM GINNEVER AVENUE



FILED
APPROVED
7.1.99
[Signature]
[Signature]

PROPERTY M/F
CITY OF FALLON

COOL SPRINGS ROAD

INDEX

- 1 COVER SHEET/FLAT PLAN
- 2 SANITARY SEWER PROFILES
- 3 STORM SEWER PROFILES

Legend

- ⊕ Sewer structure (as-built)
- ⊕ Storm Sewer structure (design)
- Sanitary Sewer structure (design)
- 50.00' Storm Sewer alignment (as-built)
- 50.00' Storm Sewer alignment (design)
- 50.00' Sanitary Sewer alignment (as-built)
- 50.00' Sanitary Sewer alignment (design)




The responsibility for professional Land Surveying liability on this project is hereby limited to the set of "As-Built" plans
authenticated by the seal, signature and date hereunder. Responsibility is disclaimed for all other plans in this project.

FRED WILKINSON 3-29-99
MISSOURI REG. L.S. #2073



DATE:	NO.:	REVISION:
MUSLER ENGINEERING COMPANY		
CIVIL ENGINEERING - PLANNING - LAND SURVEYING		
32 Port West Court, ST. Charles, Missouri 63303		
Telephone: (314) 916-0444		
DATE: MAR99	DRAWN: HFV	CHECKED: FRV
PROJECT NO.:	96-2592	SHEET NO.:
		023

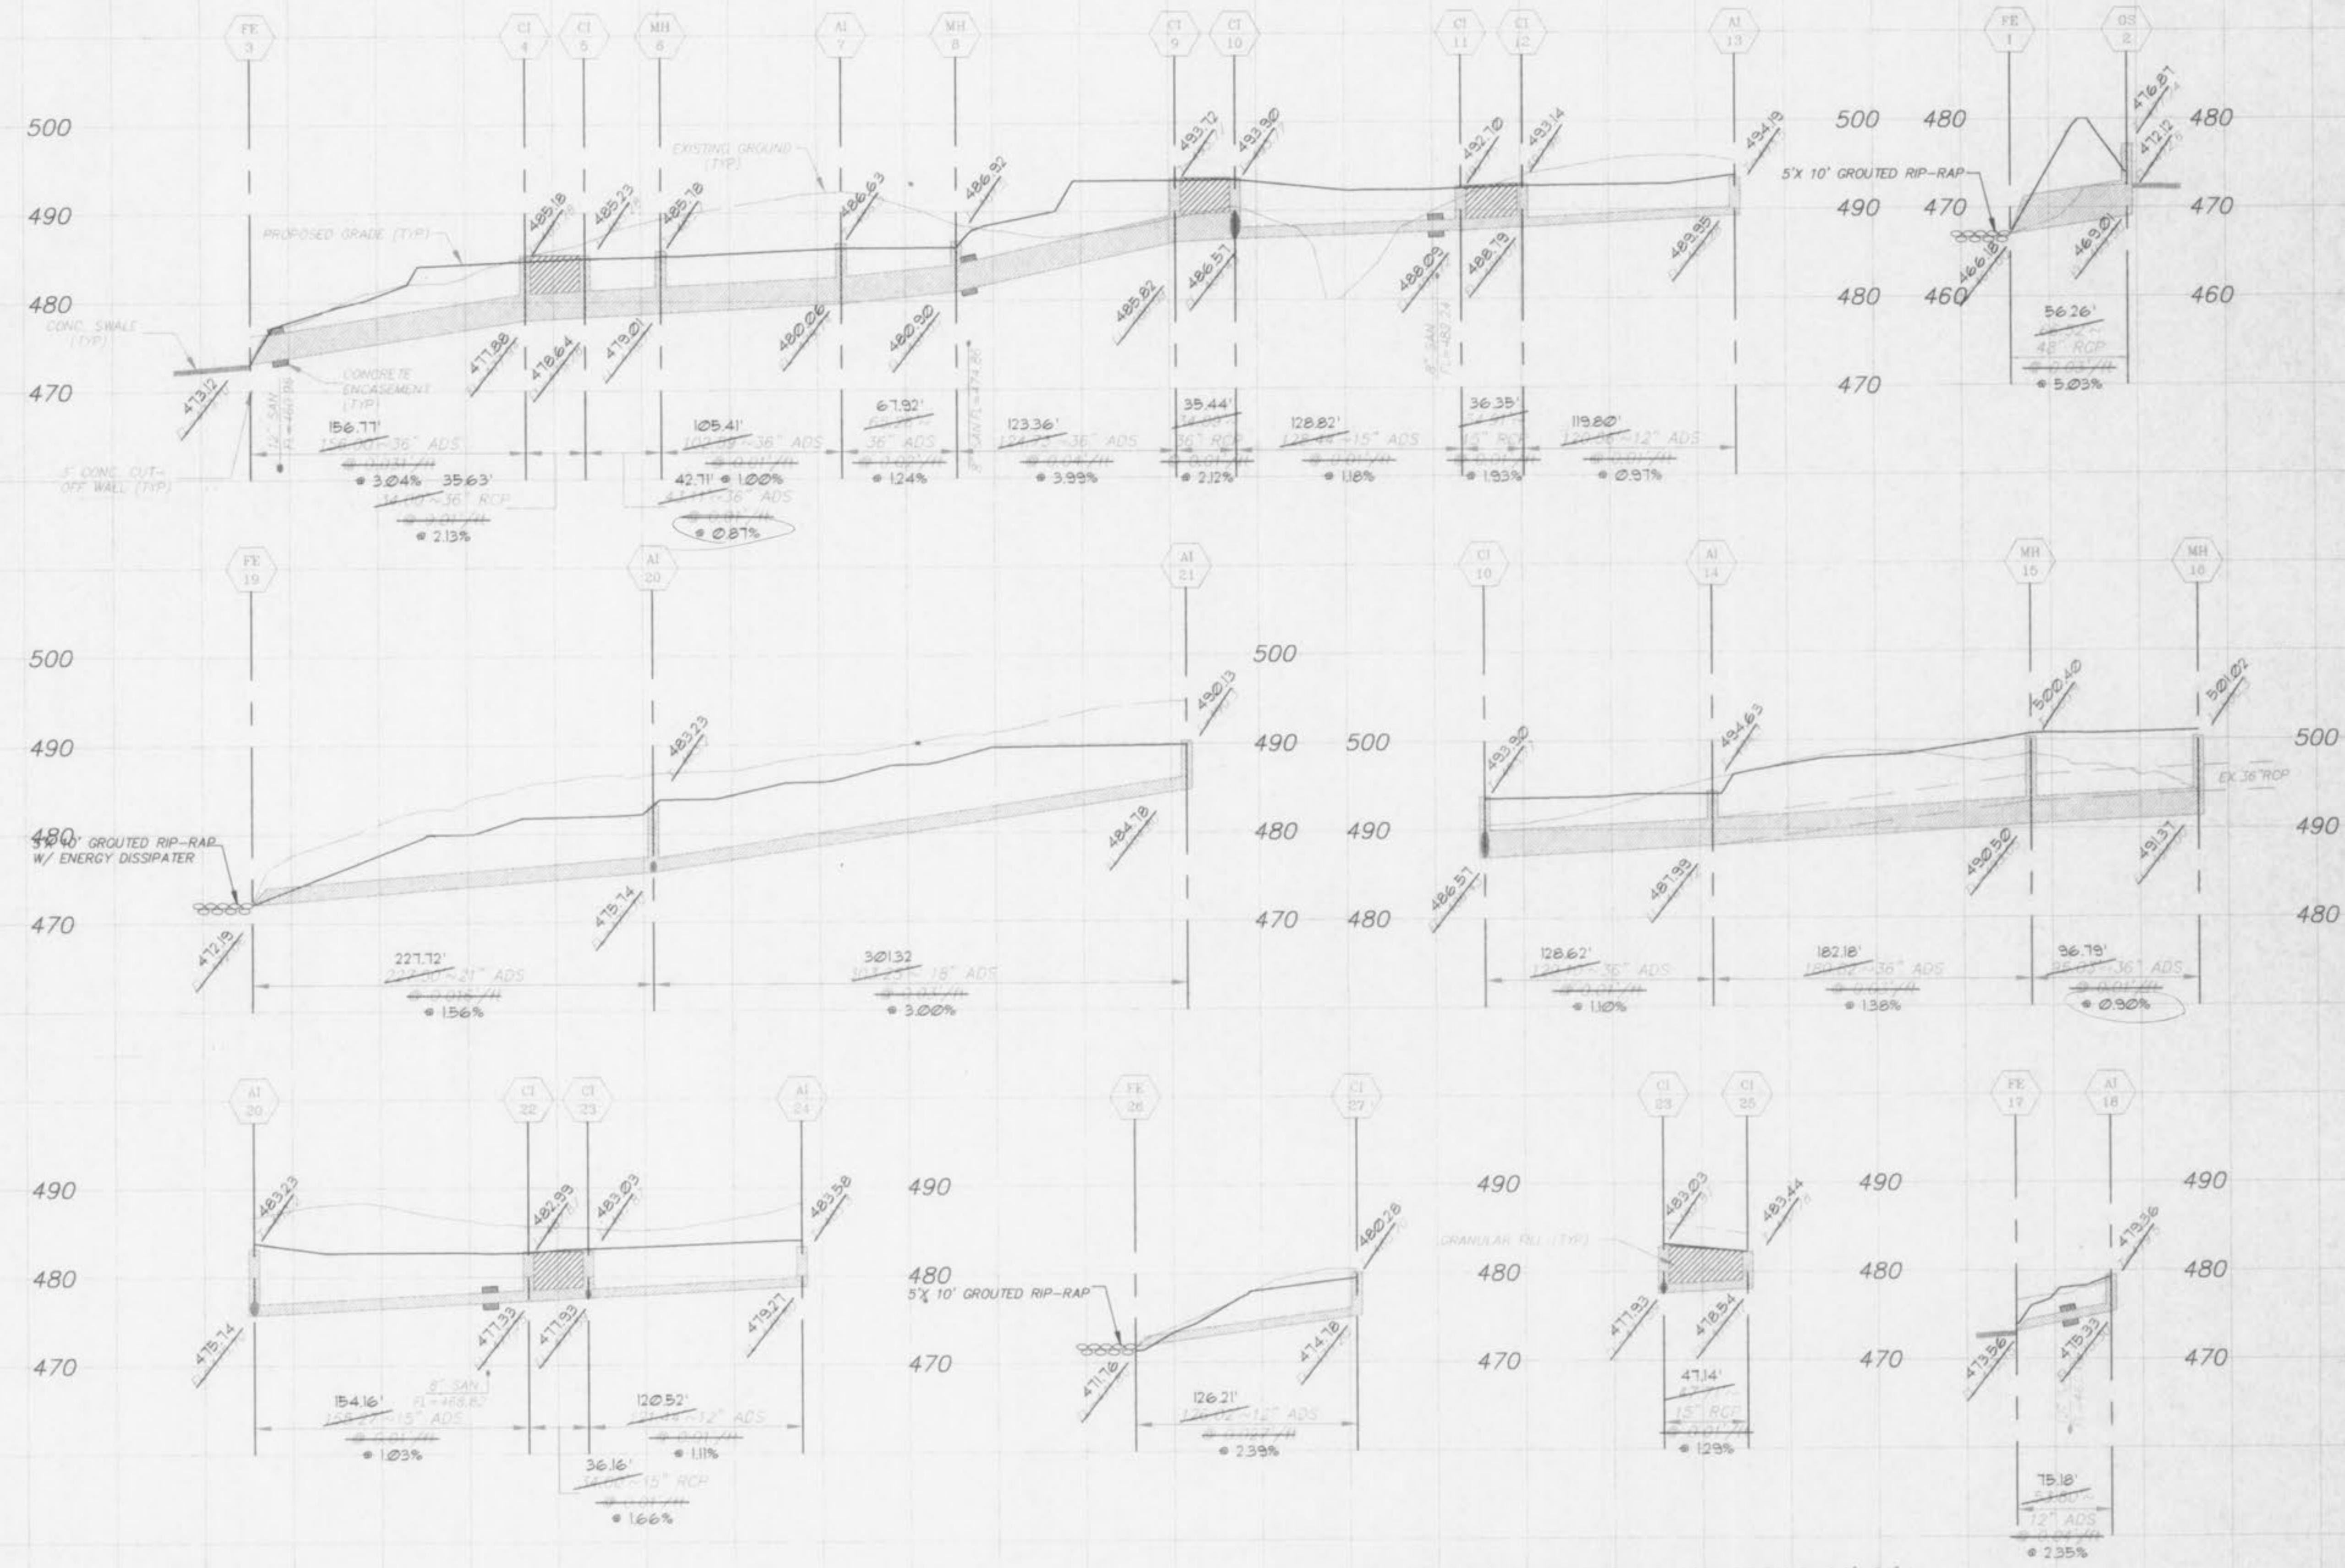

NOTE:
 AN EQUIVALENT TO A.D.S. SHALL BE ACCEPTABLE
 WHENEVER A.D.S. IS PERMITTED.

NOTE:
 ALL STORM SEWERS SHALL HAVE POSITIVE DRAINAGE
 THROUGH MANHOLES. NO FLAT BASE STRUCTURES ARE ALLOWED.

The responsibility for professional Land Surveying liability on this project is hereby limited to the set of "As-Built" plans
 authorized by the seal, signature and date hereunder. Responsibility is disclaimed for all other plans in this project.

FRED TALORAM
 MISSOURI REG. L.S. #2073
 3-27-99

Horizontal Scale: 1"=50'
 Vertical Scale: 1"=10'