


Sanitary Sewer Profile
 Parkview Place
 June 8 78 020
 As Built 4/1/80

DATE
 BY
 SURVEYED
 PLOTTED
 TEMPLATE
 AREAS
 CHECKED
 FINAL SURVEY NOTE BOOK NO.

DATE
 BY
 SURVEYED
 PLOTTED
 TEMPLATE
 AREAS
 CHECKED
 ORIGINAL SURVEY NOTE BOOK NO.

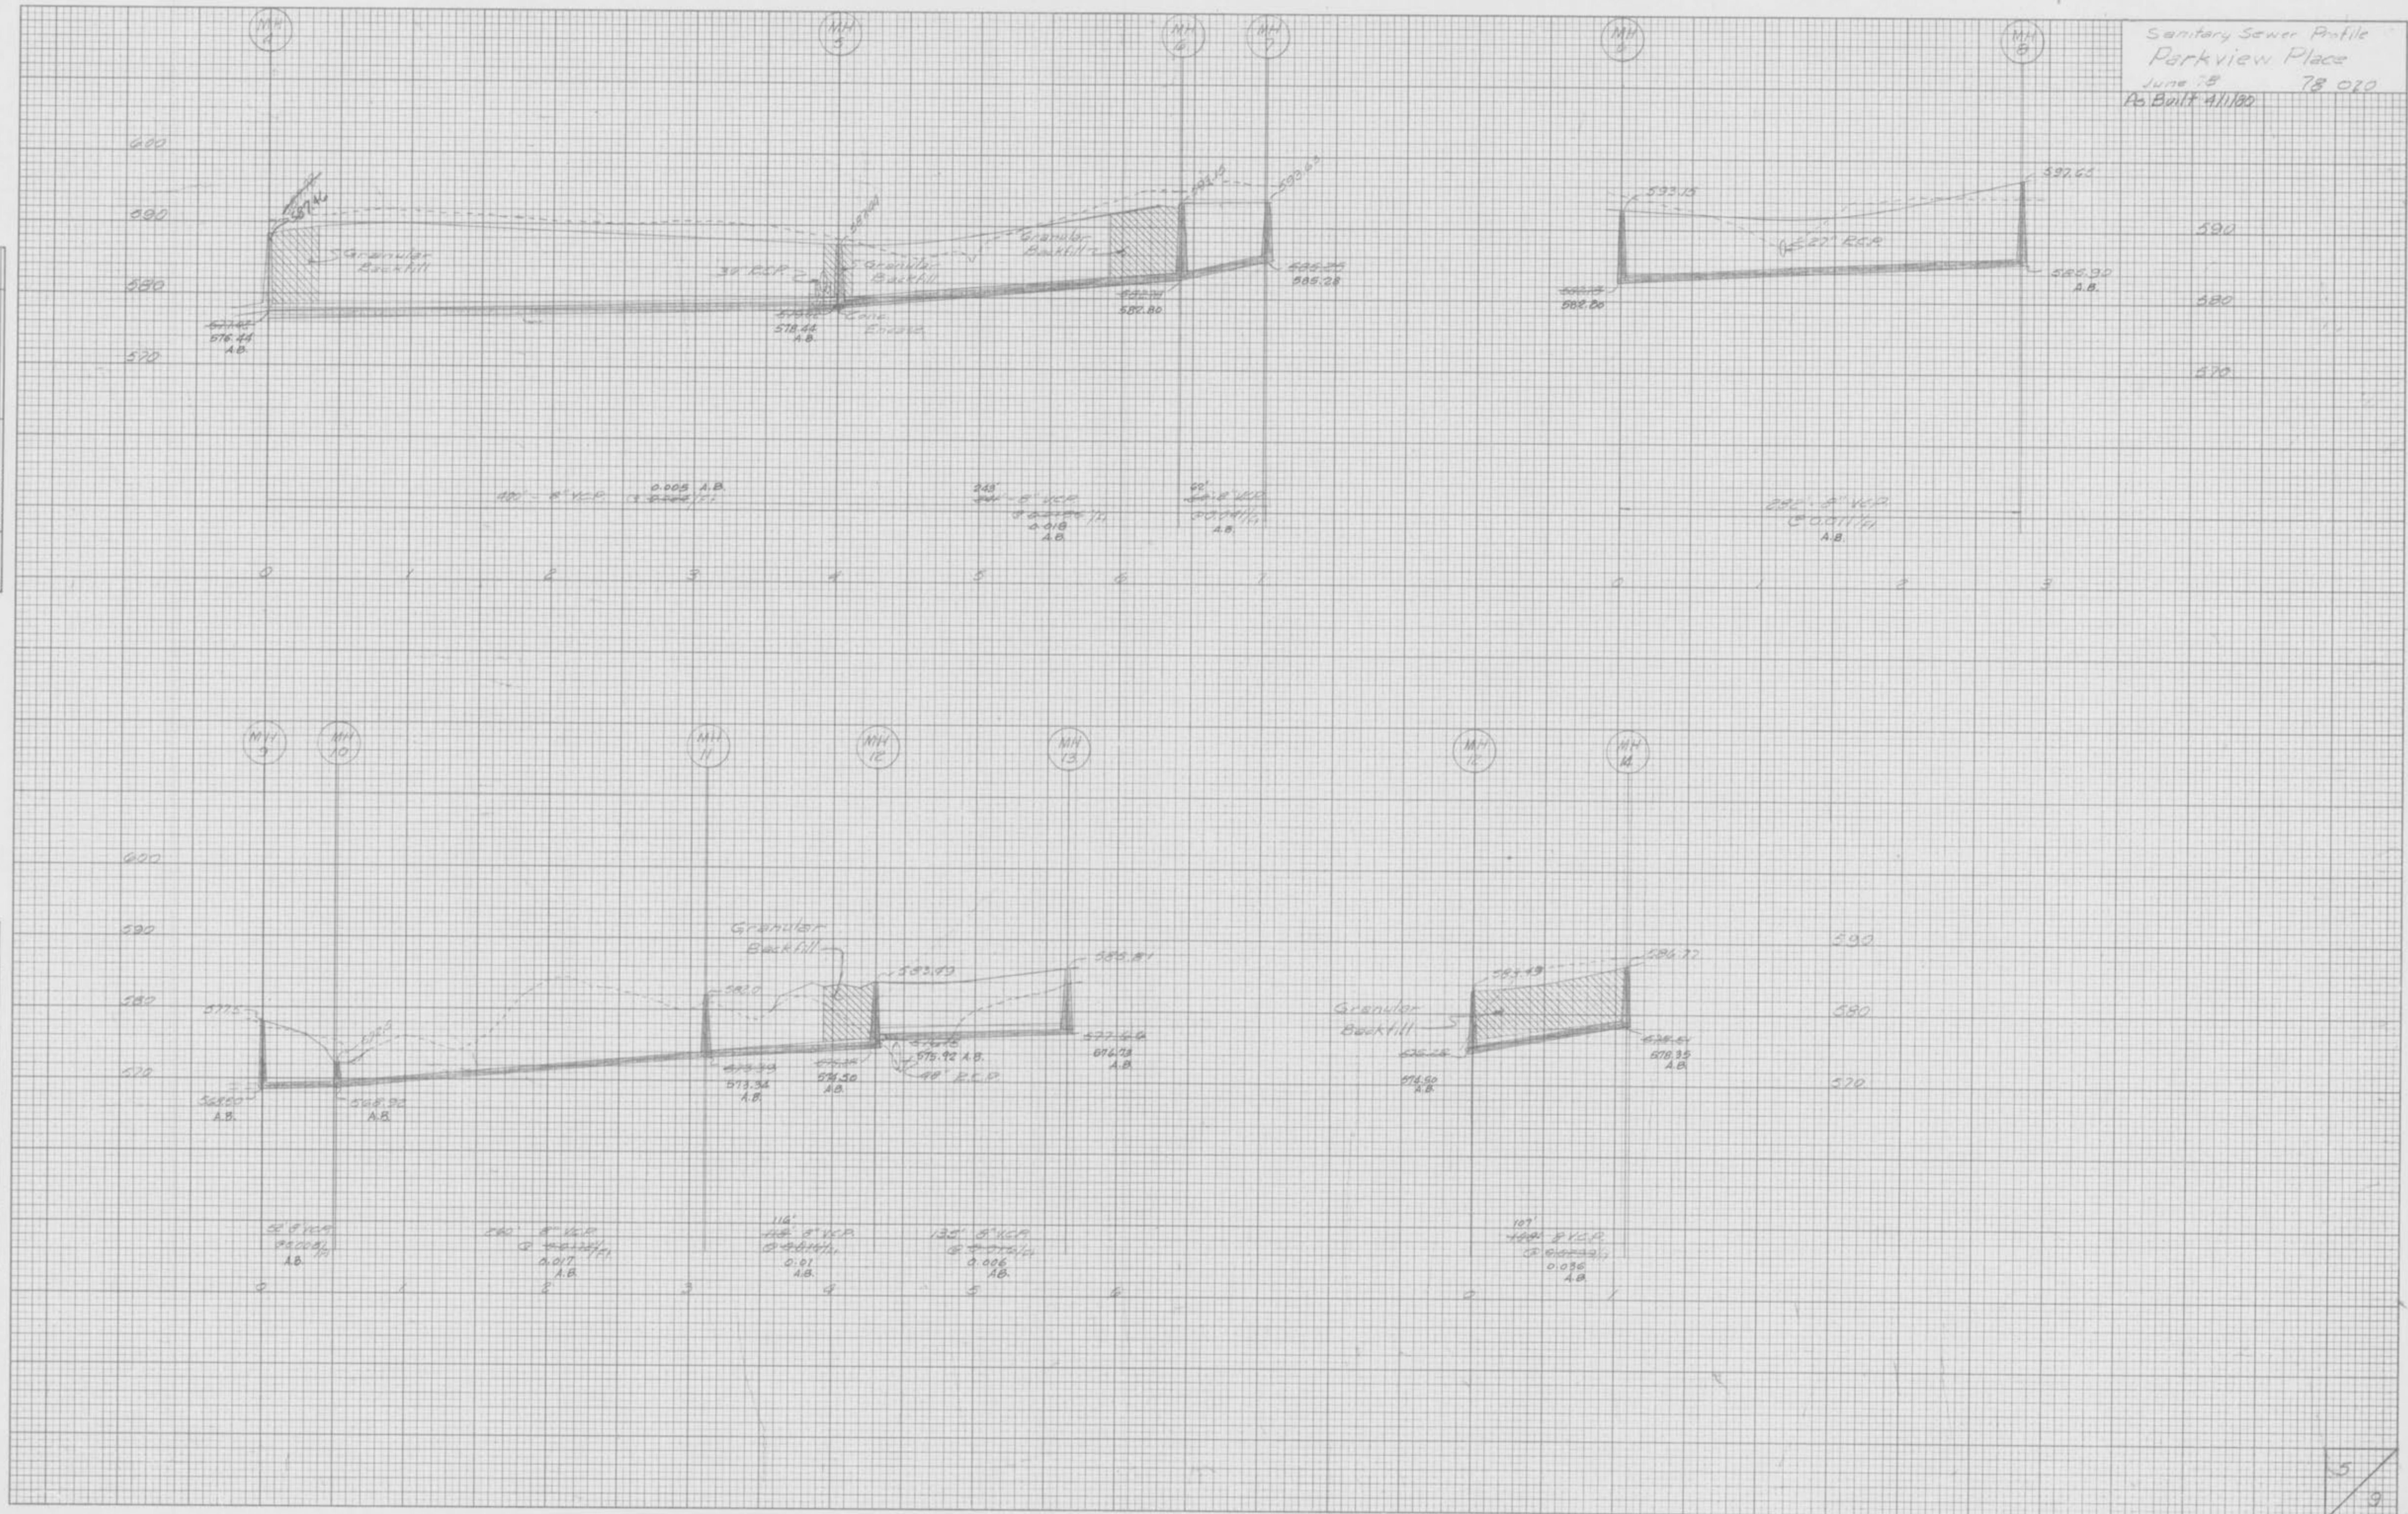

K&E PLATE 3, CROSS SECTION
 KEUFEL & ESSER CO.
 48 7056 MADE IN U.S.A.

PROPERTY OF
 CITY OF FALLON
 BUILDING DEPARTMENT
 PARKVIEW PLACE
 SANITARY SEWER PROFILES
 AS BUILT