
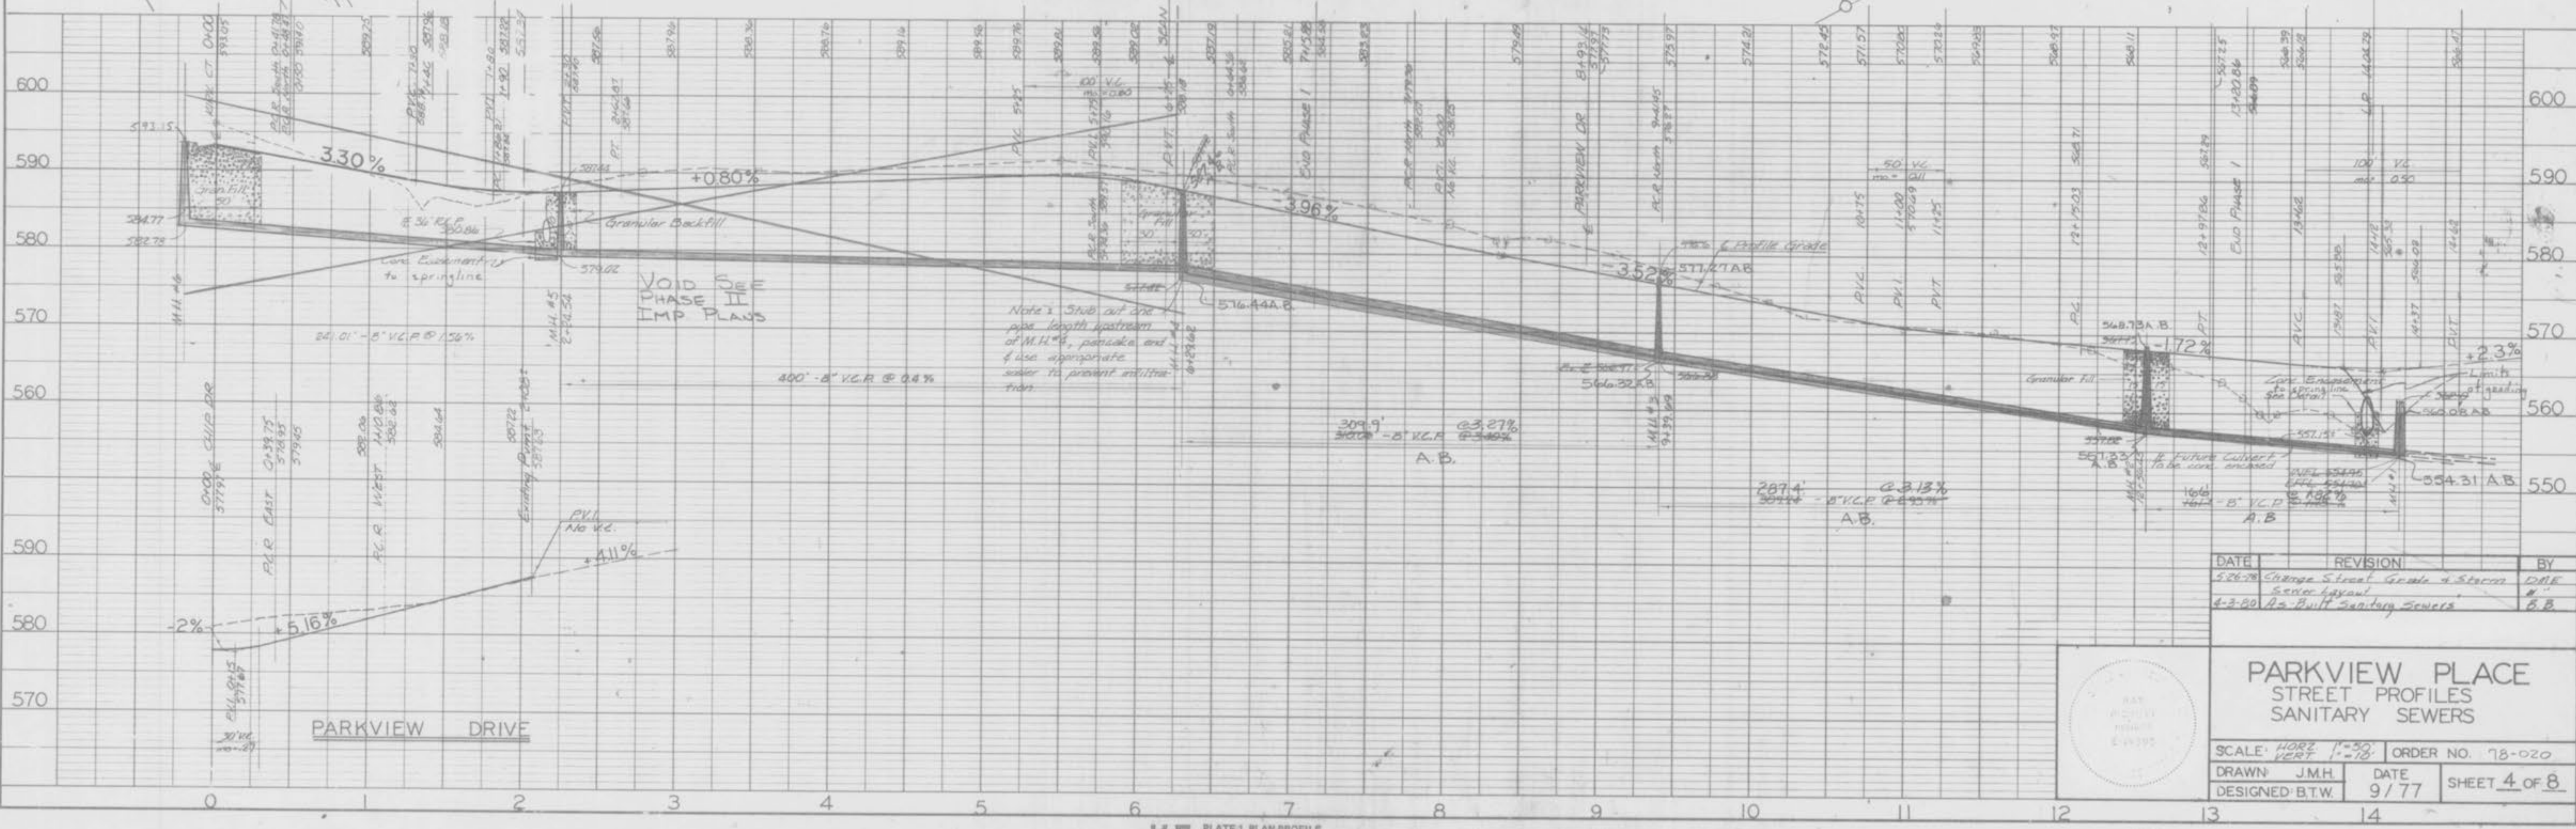


DATE	
BY	
PLAN	
DESIGNED BY	
NOTED BY	
DATE	
BY	

DATE	
BY	
PROFILE	
DESIGNED BY	
NOTED BY	
DATE	
BY	

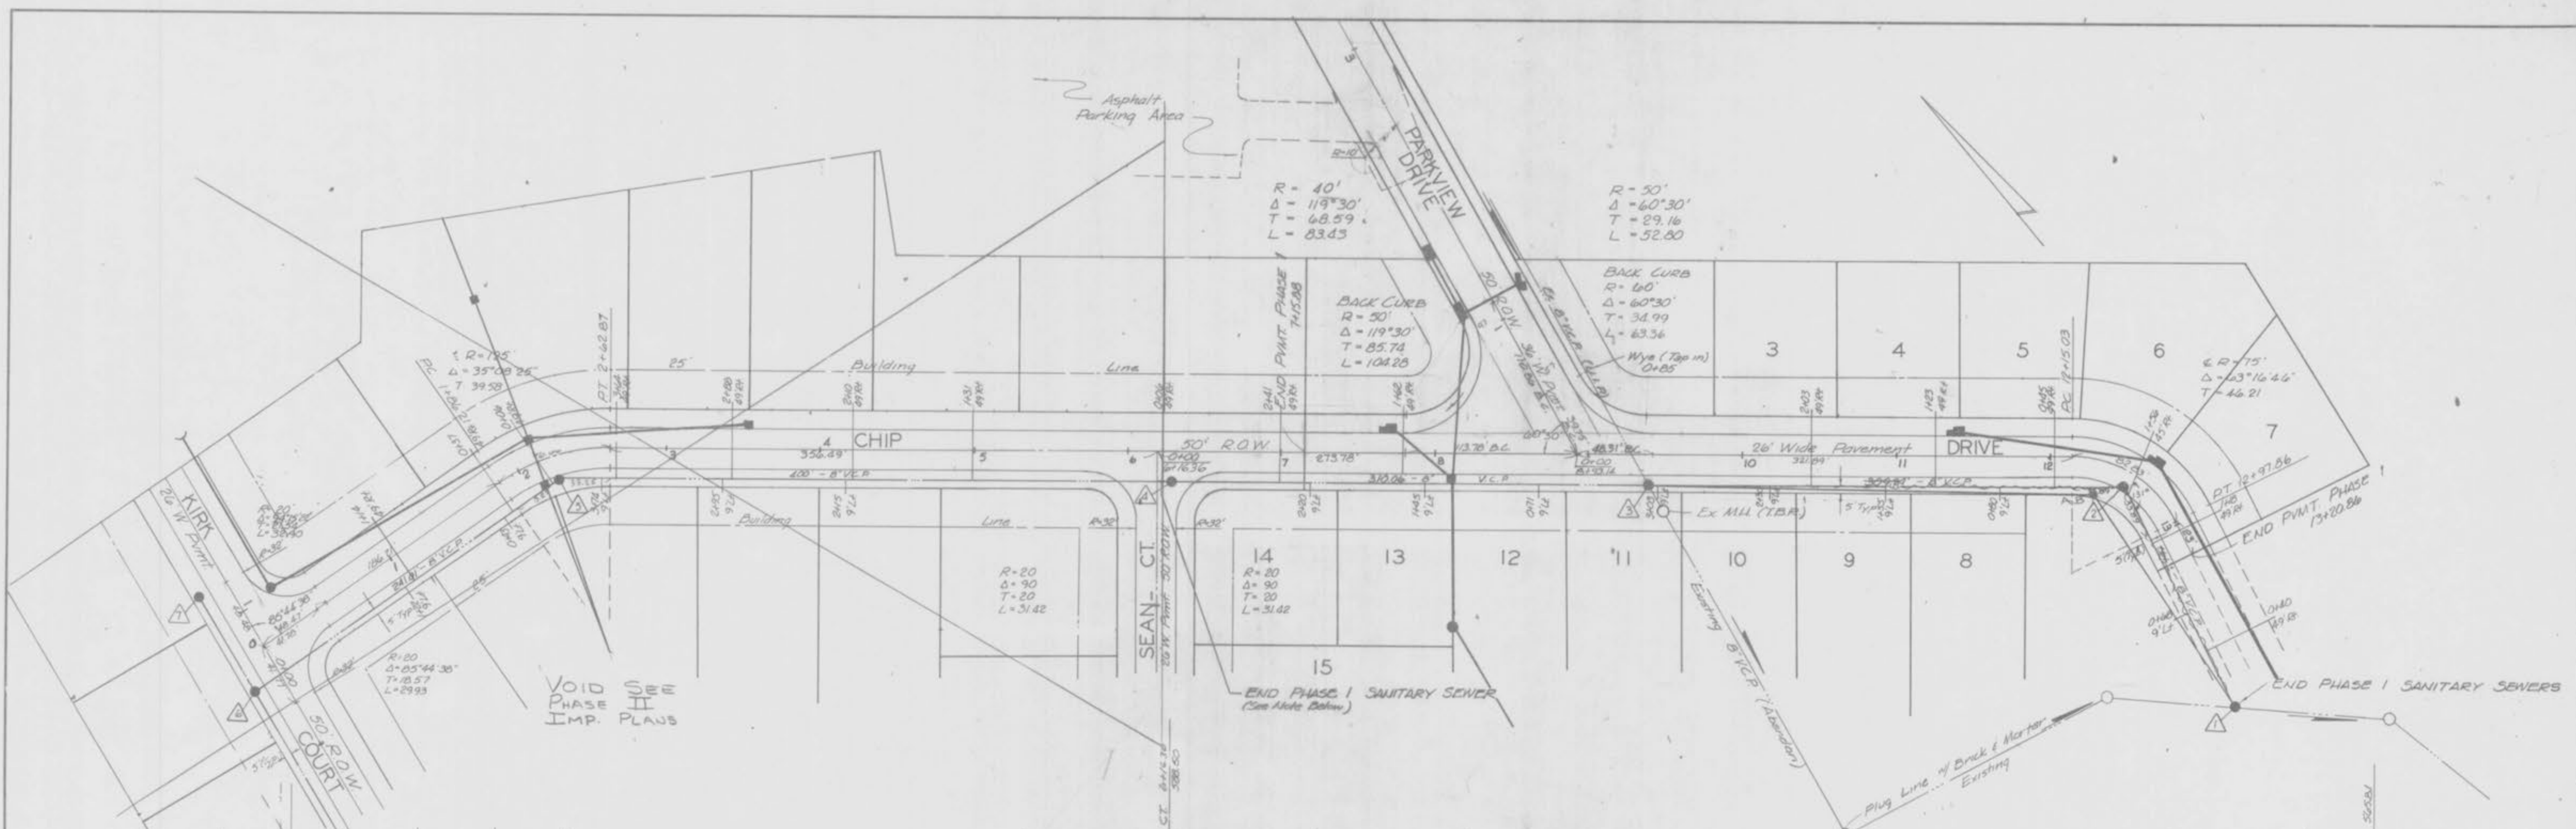

DATE	REVISION	BY
5-26-78	Change Street Grade & Station D&E	D&E
4-2-80	As-Built Sanitary Sewers	B.B.

**PARKVIEW PLACE
STREET PROFILES
SANITARY SEWERS**

SCALE: $\frac{HORIZ}{VERT} = \frac{1''}{20'}$ ORDER NO. 78-020

DRAWN: J.M.H. DATE: 9/77 SHEET 4 OF 8

DESIGNED: B.T.W.