
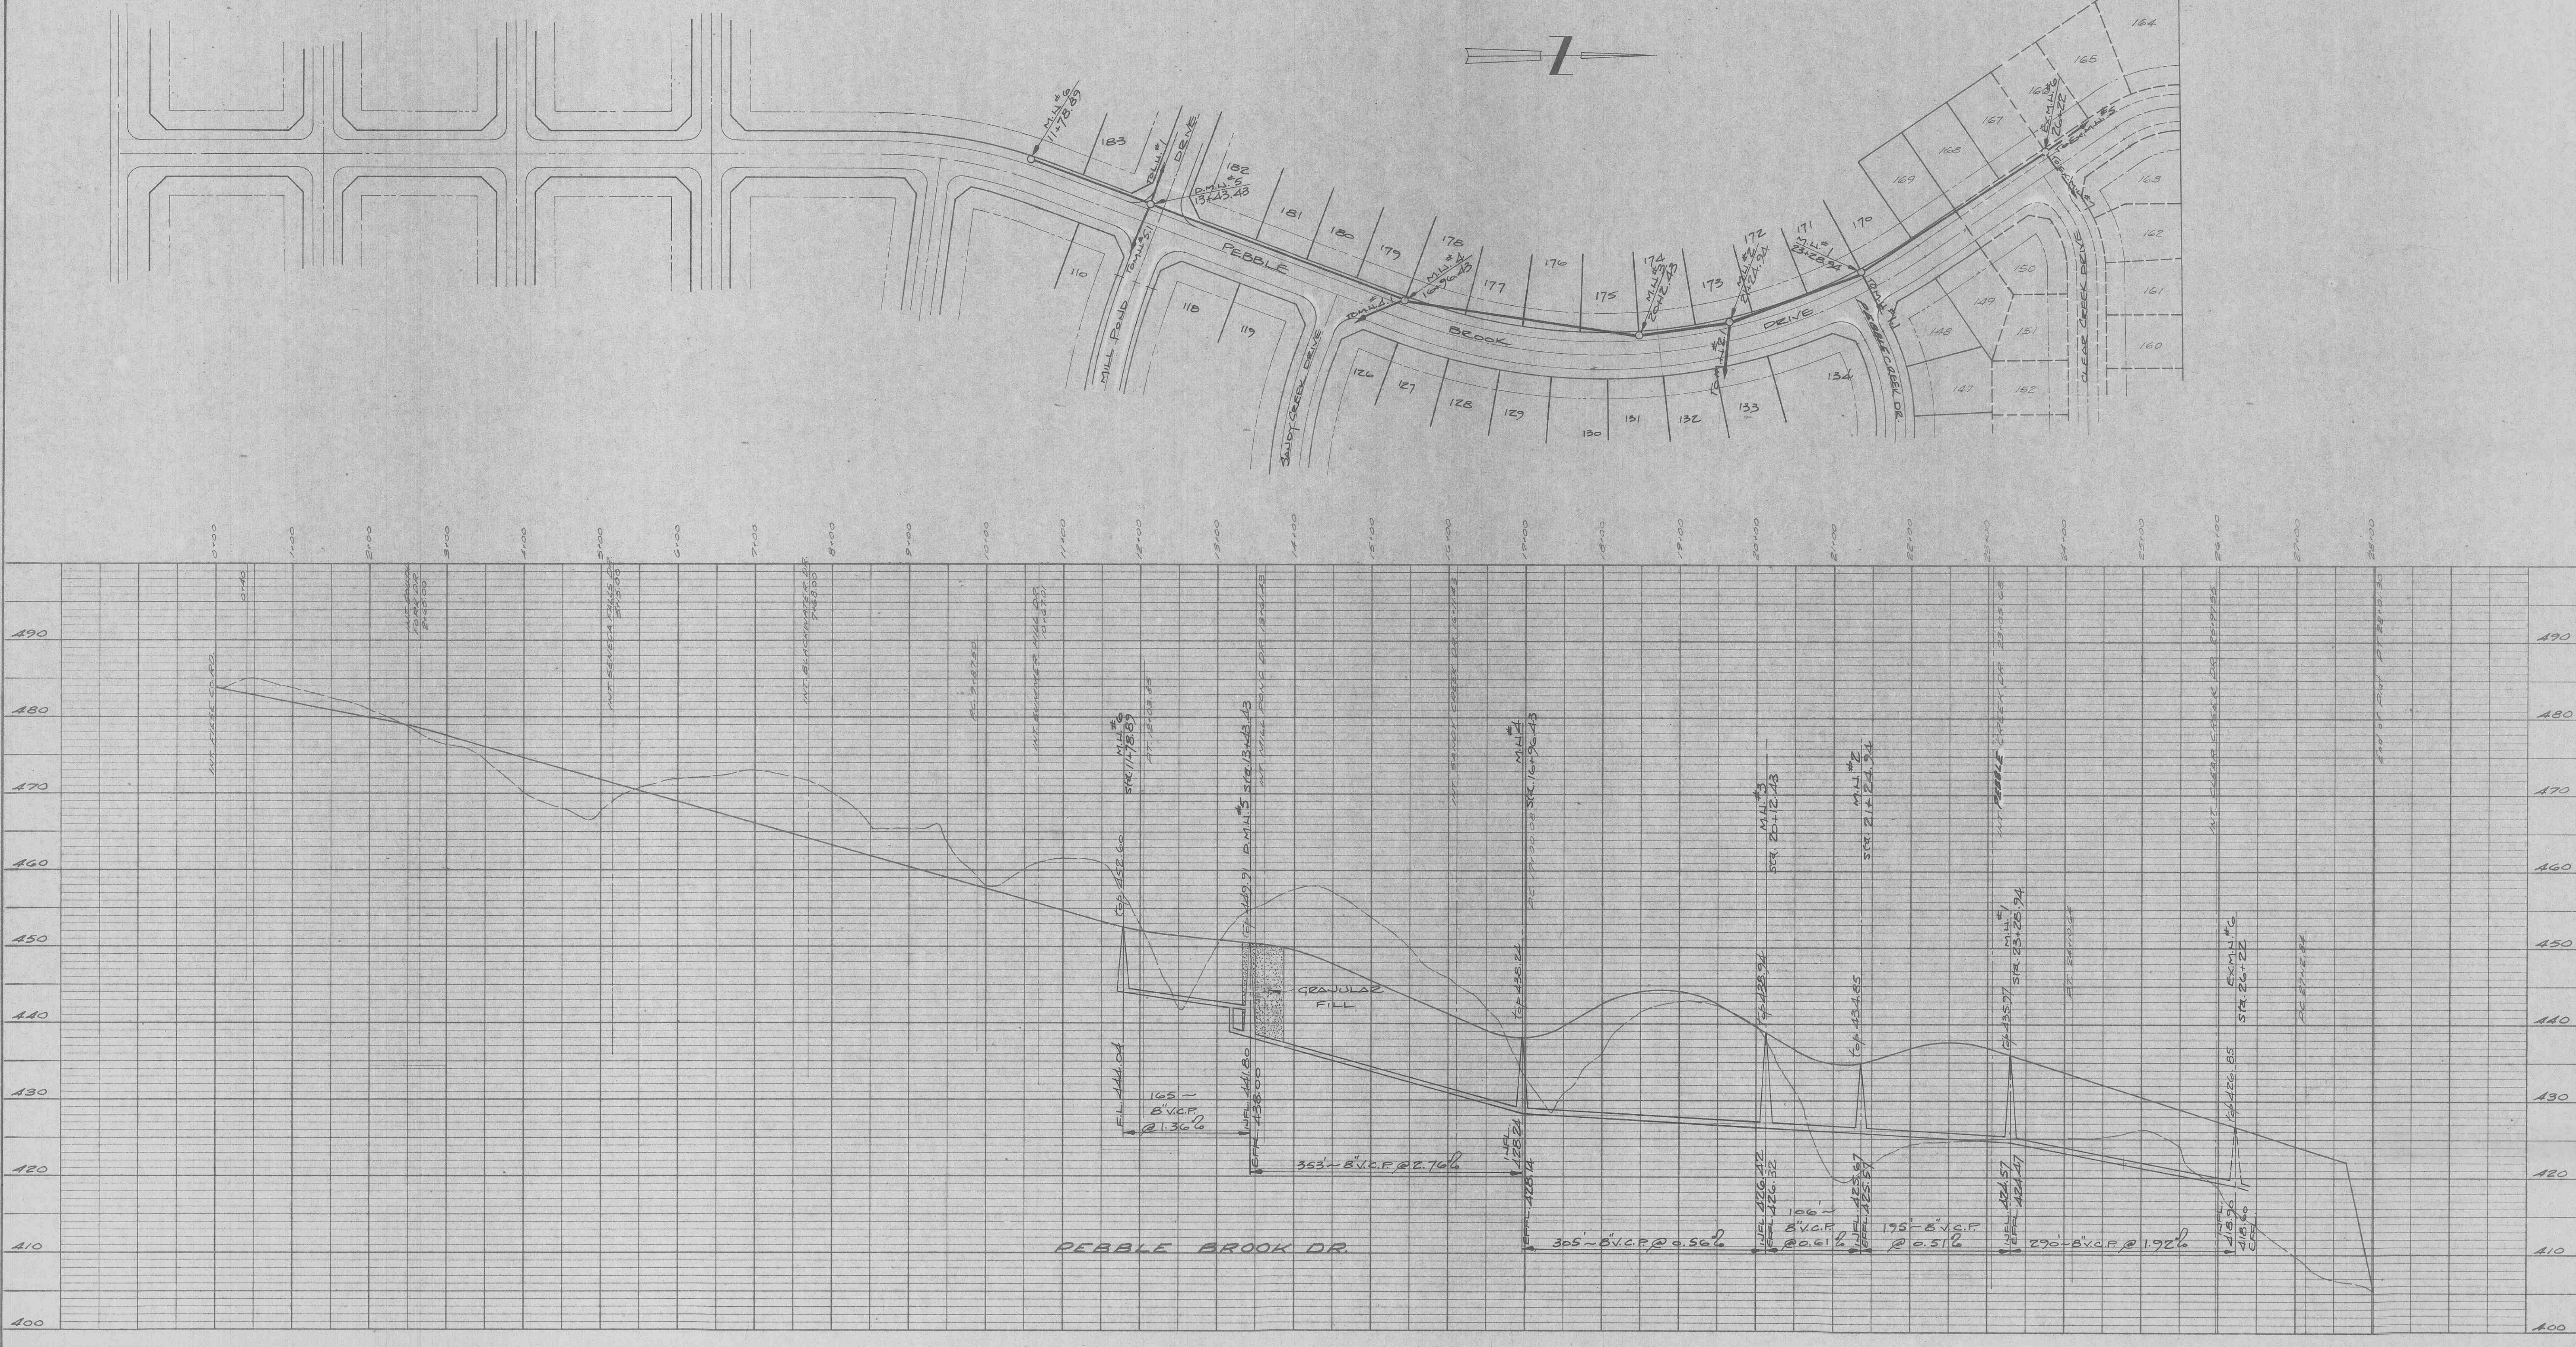


DATE _____ BY _____
 SURVEYED _____
 ACCURACY CHECKED _____
 PLAN NOTE BOOK No. _____


DATE _____ BY _____
 SURVEYED _____
 GRADES CHECKED _____
 PROFILE NOTE BOOK No. _____

REVISED:	PEBBLE BROOK	
	PLAT TWO	
	SANITARY SEWERS	
W. J. SHEAR	SHEET 14 OF 24	
DATE 11-13-72	VERT. 1"=10'	SCALE HORIZ. 1"=100'
Engineering & Surveying, Inc.		
523 S. 5th St. ST. CHARLES, MISSOURI		RA 4-3330 AX 1-0876

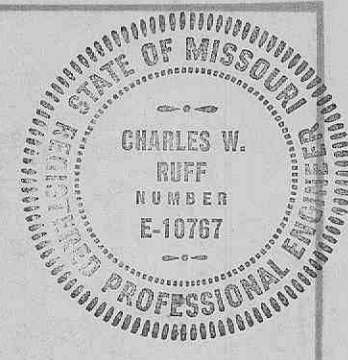

DATE: _____
 BY: _____
 SUBMITTED: _____
 PLOTTED: _____
 ALIGNMENT CHECKED: _____
 NO. OF WAYS CHECKED: _____
PLAN
 NOTE BOOK No. _____

DATE: _____
 BY: _____
 SUBMITTED: _____
 PLOTTED: _____
 STRUCTURE LOCATIONS CHECKED: _____
PROFILE
 NOTE BOOK No. _____

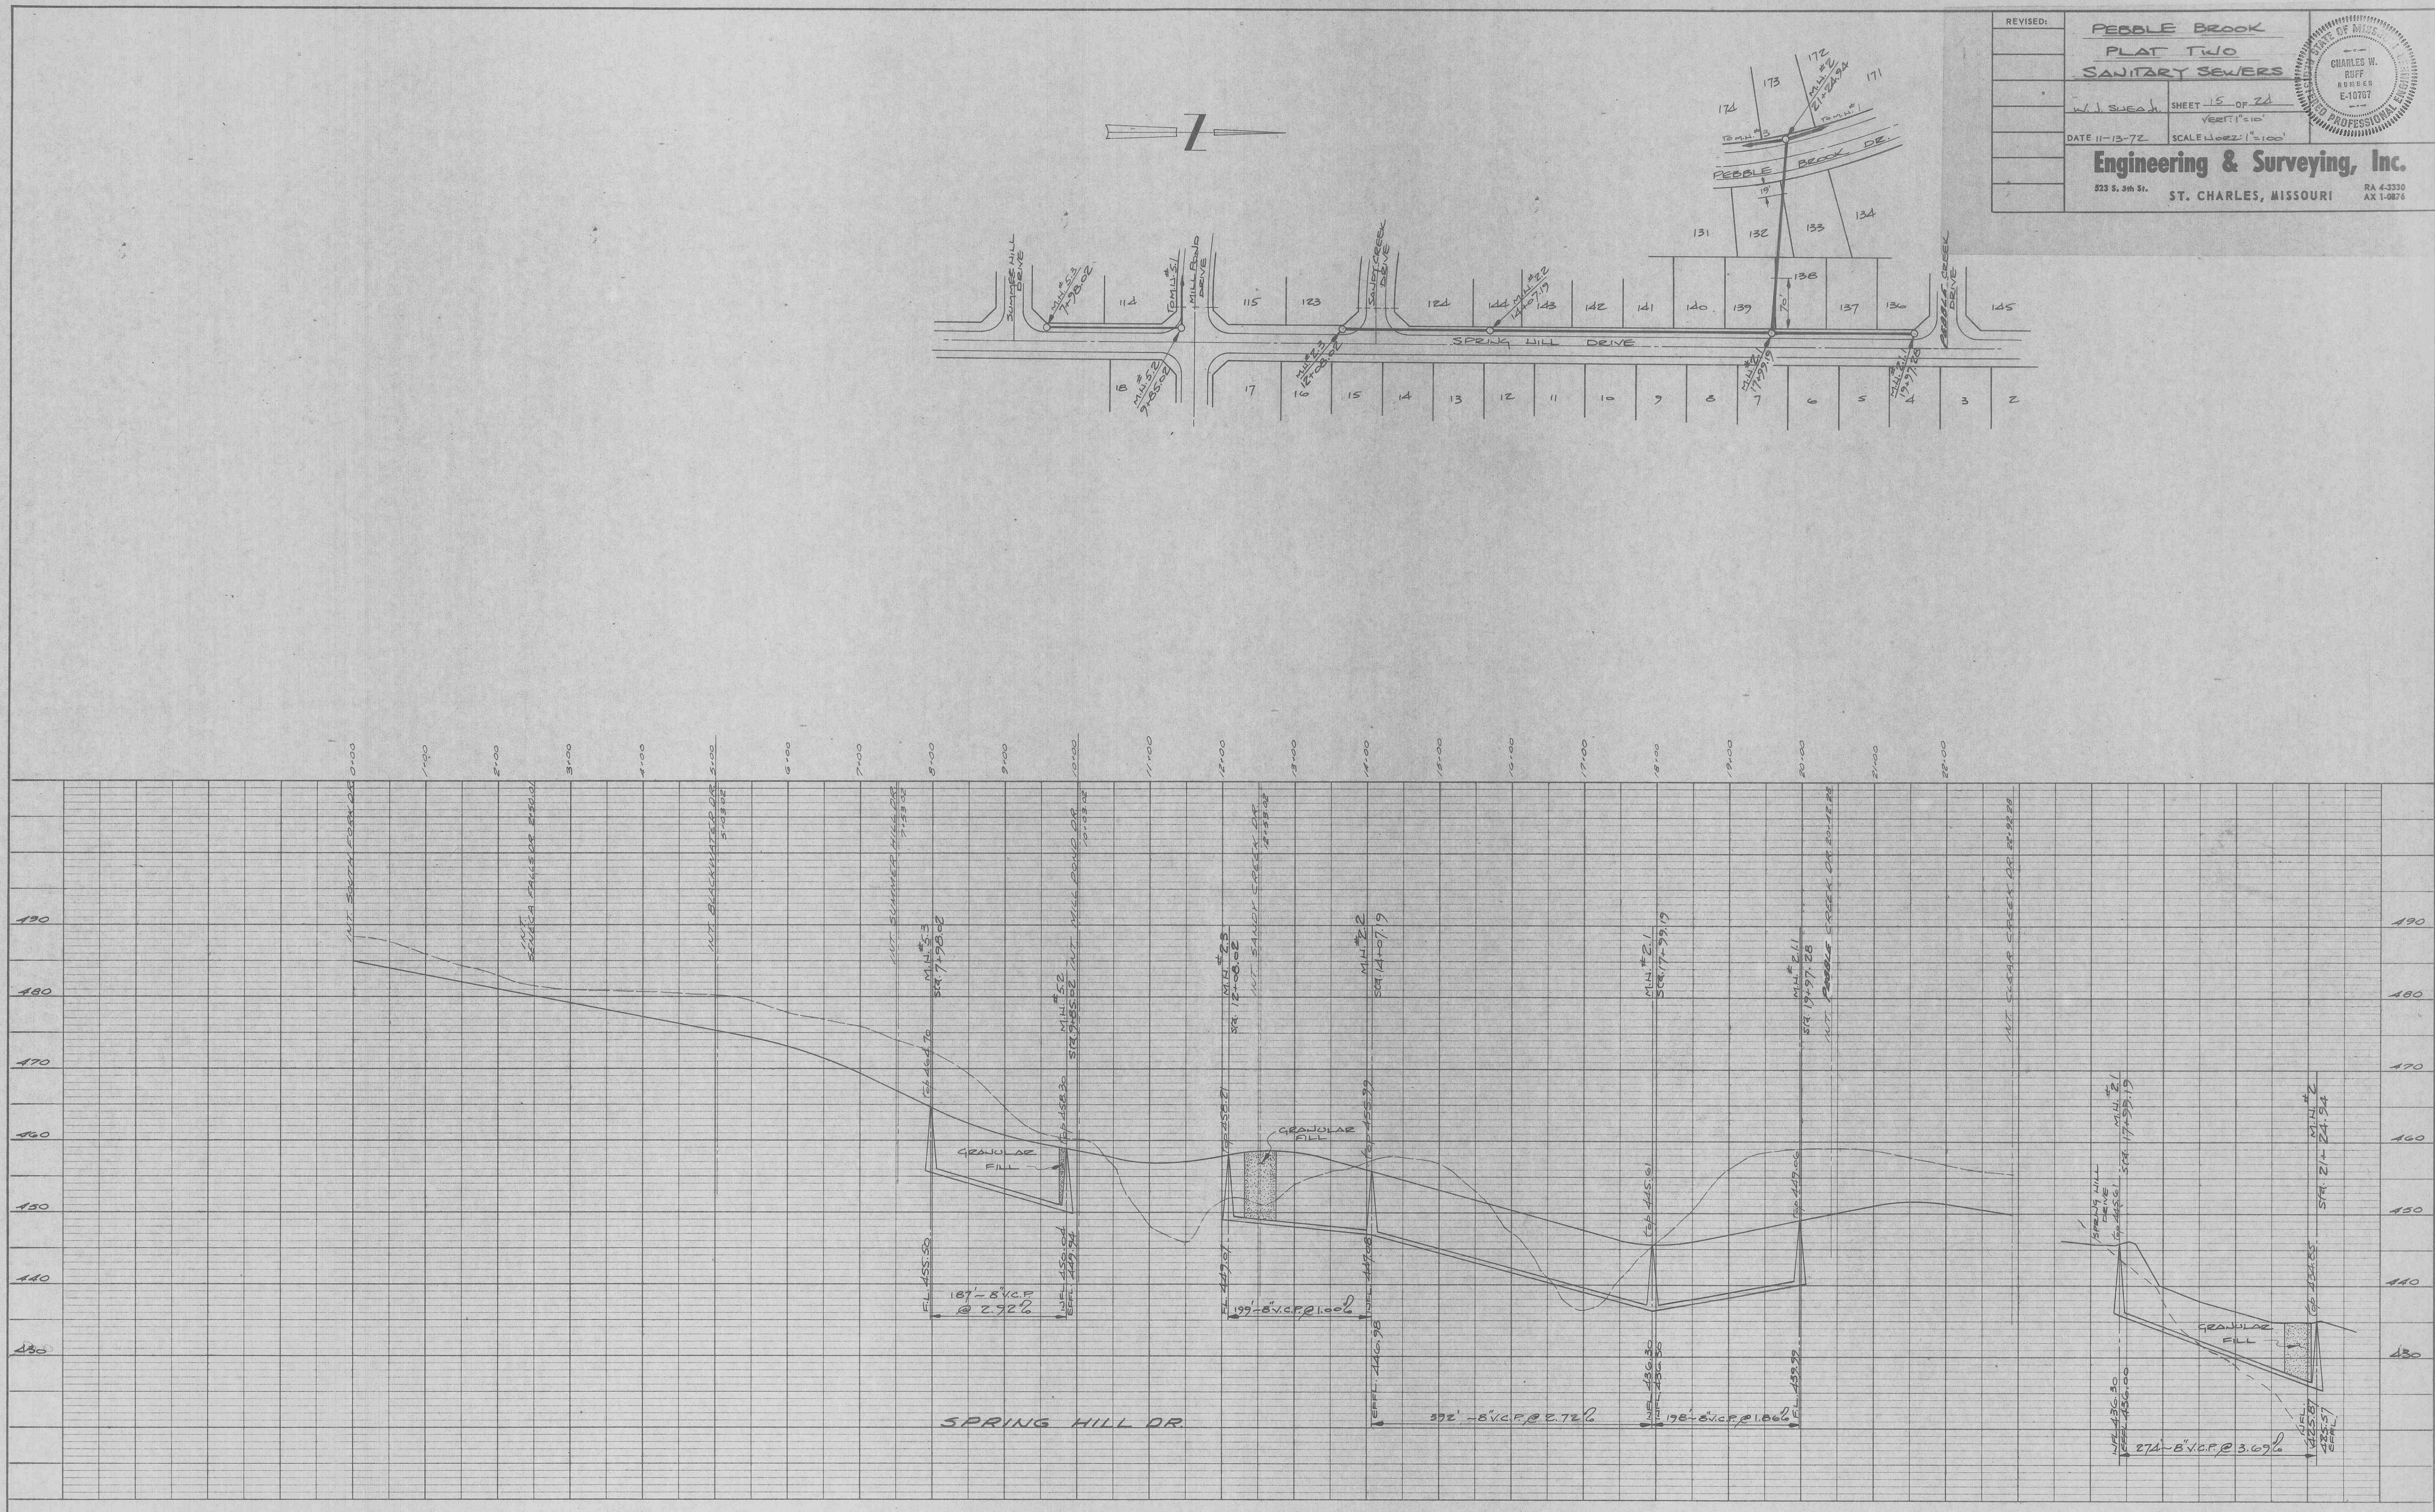

REVISED:	PEBBLE BROOK		
	PLAT TWO		
	SANITARY SEWERS		
	W. J. SUEHR	SHEET 15 OF 24	
		VERT. 1"=10'	
	DATE 11-13-72	SCALE 1/2"=100'	
Engineering & Surveying, Inc.			
823 S. 9th St. ST. CHARLES, MISSOURI			RA 4-3330 AX 1-0874




DATE	
BY	
REVISIONS	
NOTED	
ALIGNMENT CHECKED	
RT. OF WAY CHECKED	
PLAN	
NOTE BOOK	
No.	

DATE	
BY	
REVISIONS	
NOTED	
GRADES CHECKED	
R.M. NOTED	
VERTICAL CURVES CHECKED	
PROFILE	
NOTE BOOK	
No.	



115'
150'
210'
238'
115'

REVISED:	PEBBLE BROOK
	PLAT TWO
	SANITARY SEWERS
W.J. SUEB	SHEET 16 OF 24
DATE 11-13-72	SCALE 1/2" = 1'-00"
Engineering & Surveying, Inc.	
ST. CHARLES, MISSOURI	

REGISTERED PROFESSIONAL ENGINEER
 MISSOURI
 E-10767

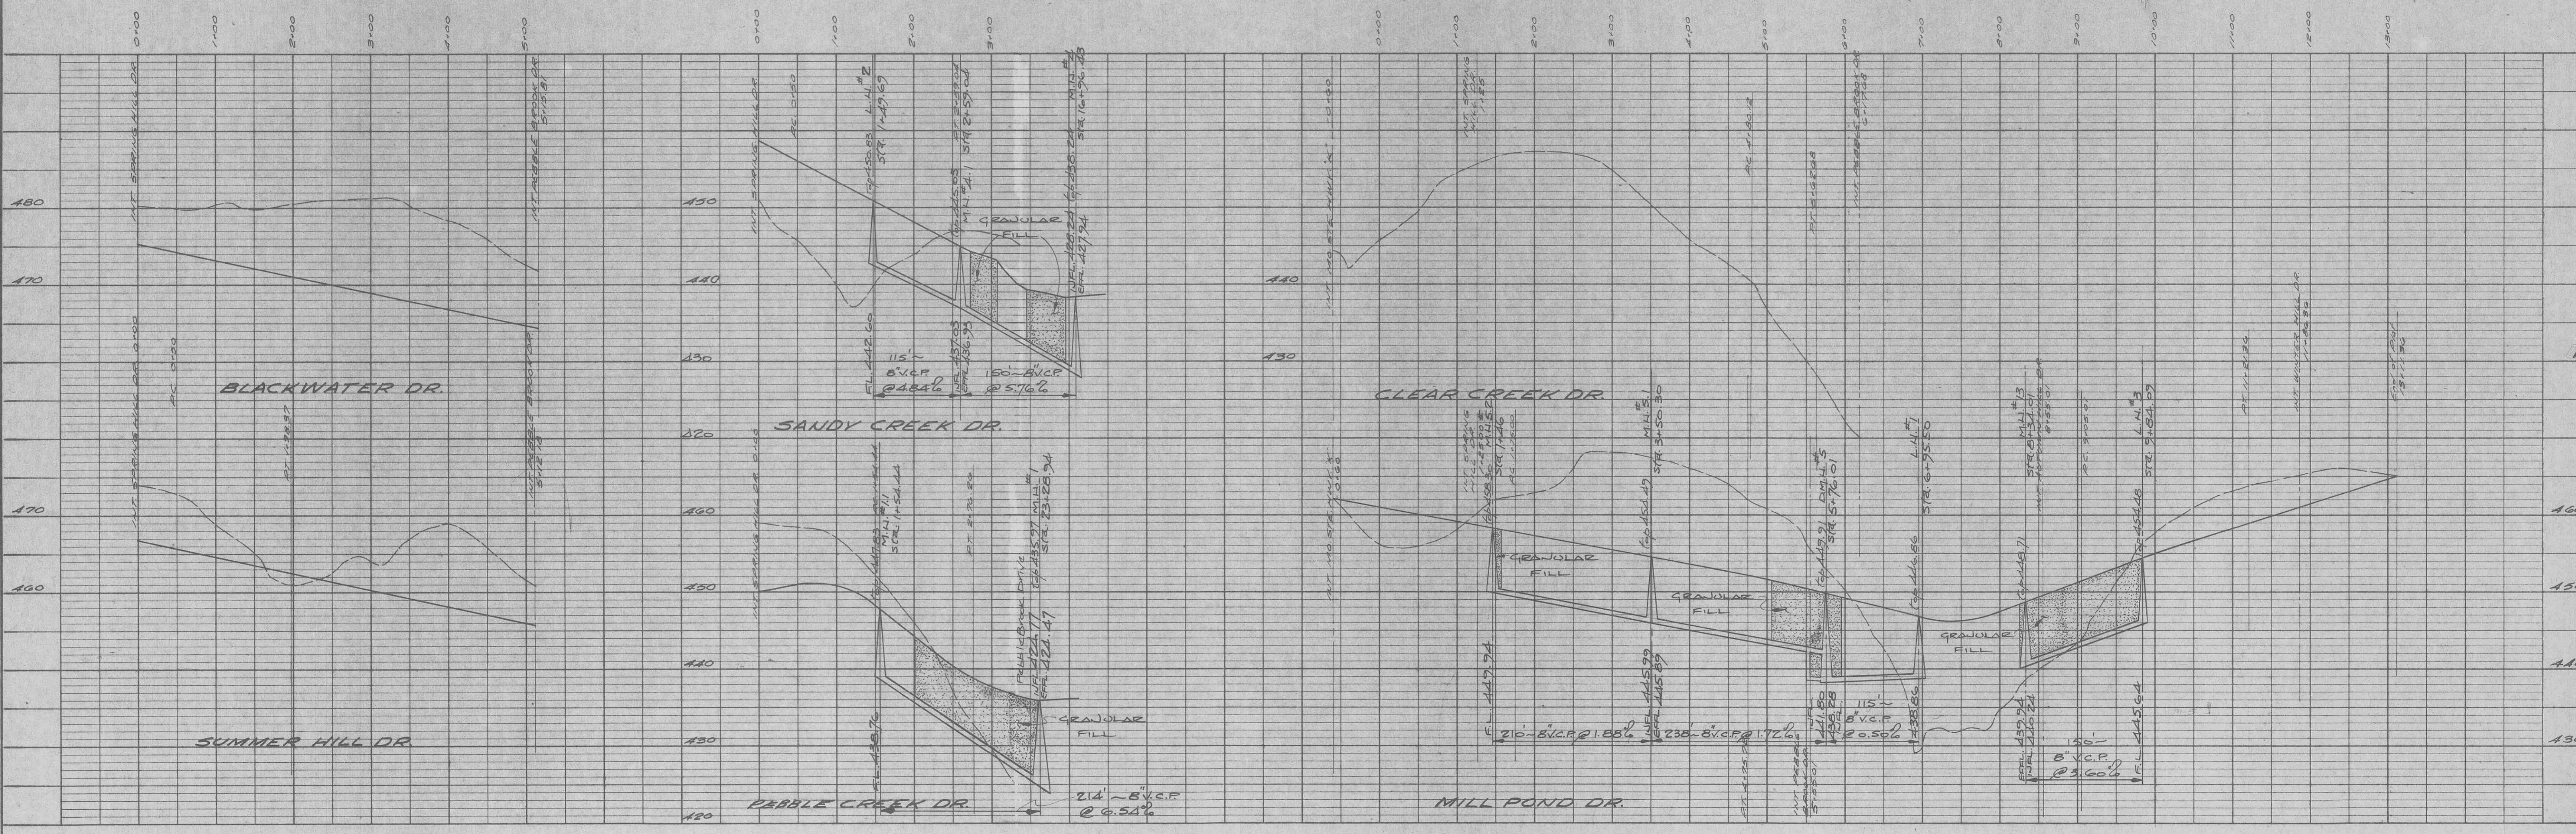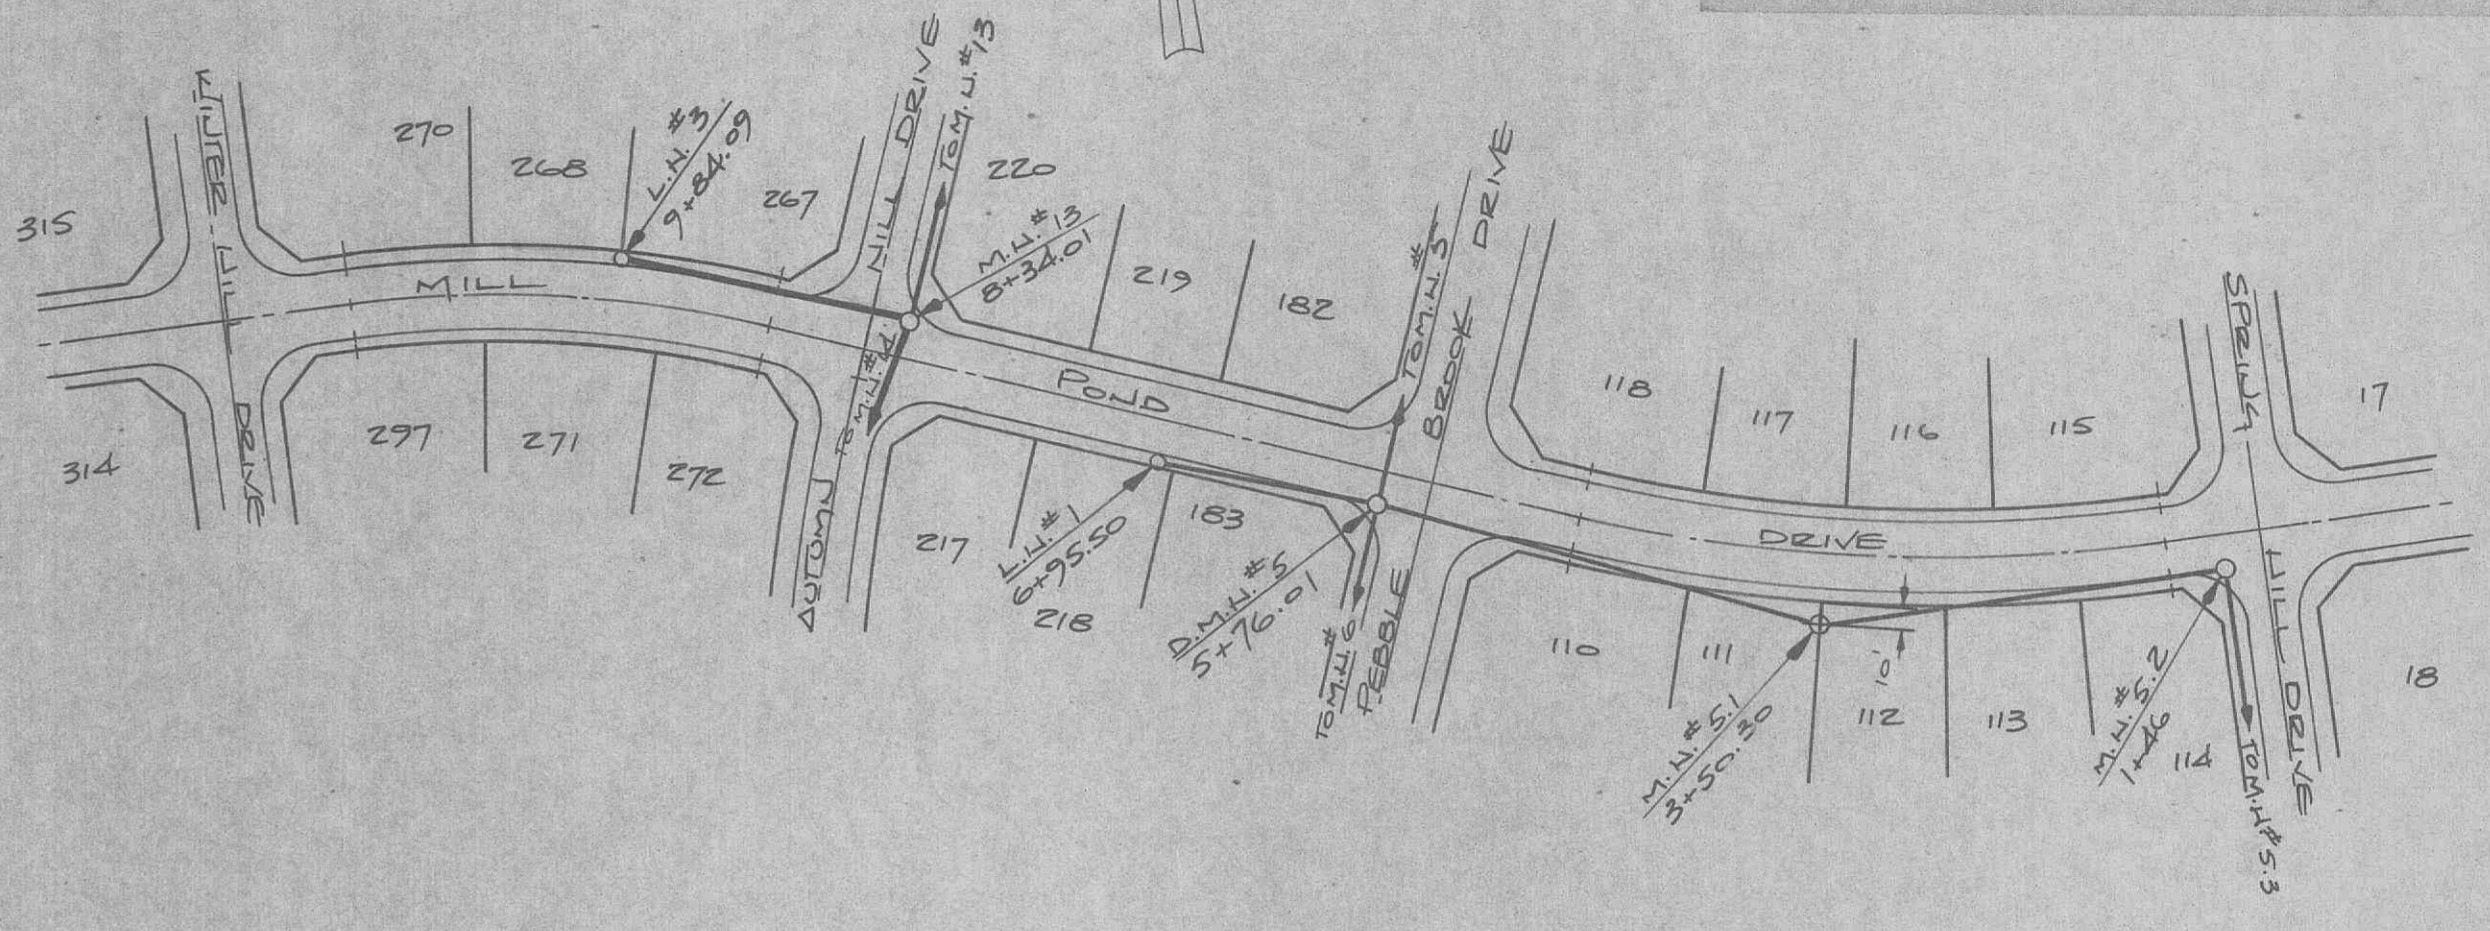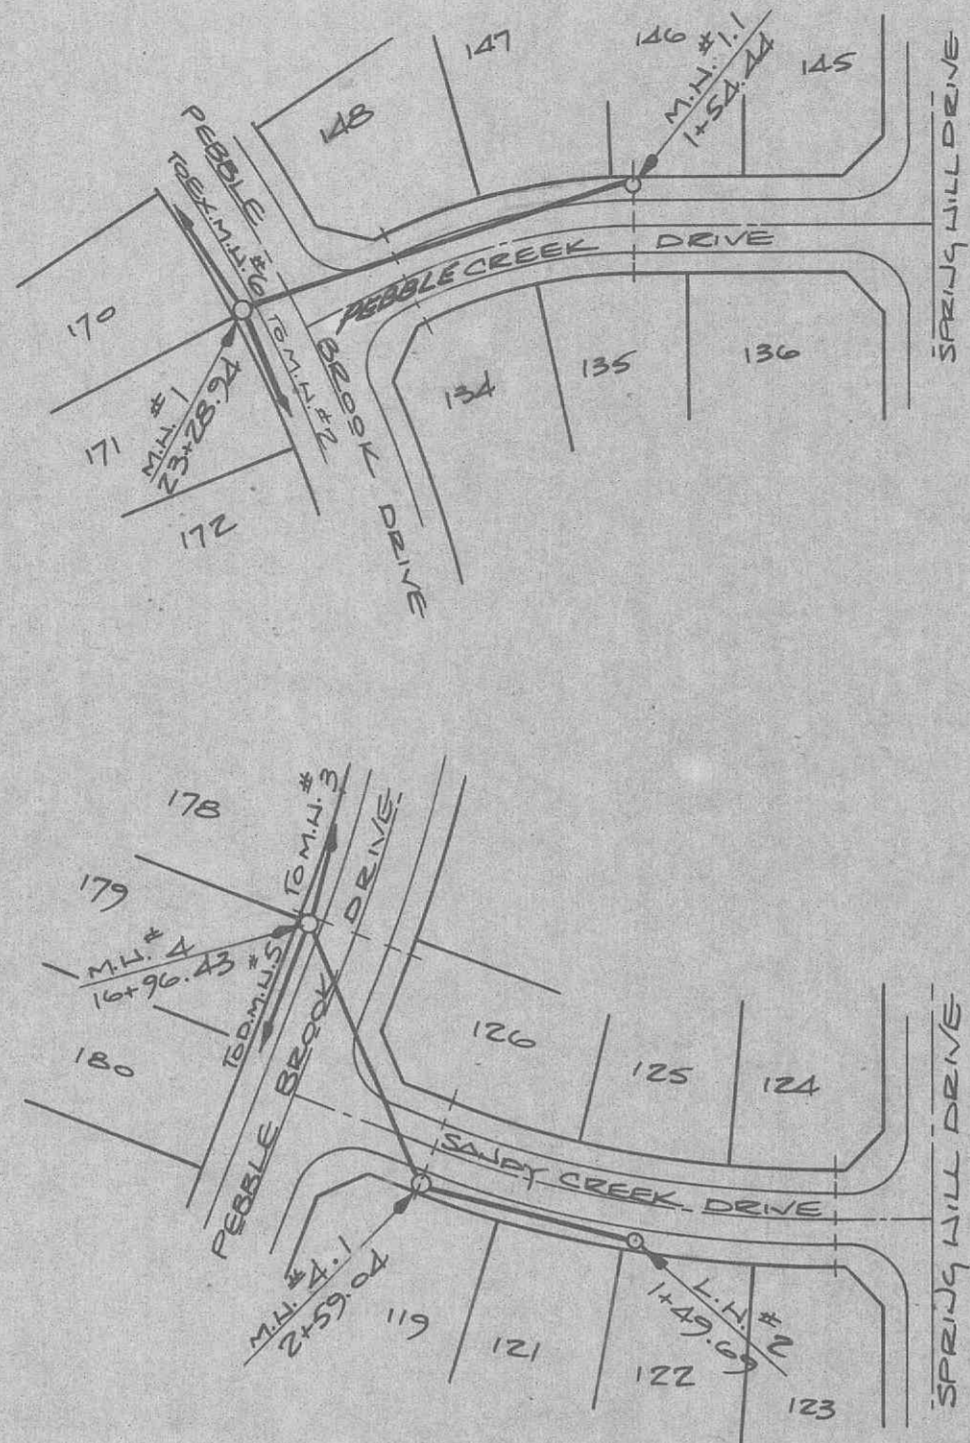

REVISED:	PEBBLE BROOK FLAT TWO SANITARY SEWERS	
	W.J. Swann SHEET 17 OF 24 VERT. 1"=10' SCALE HORIZ. 1"=100'	
	DATE 11-13-72	
	Engineering & Surveying, Inc. 223 S. 9th St. ST. CHARLES, MISSOURI RA 4-33 AX 1-08	

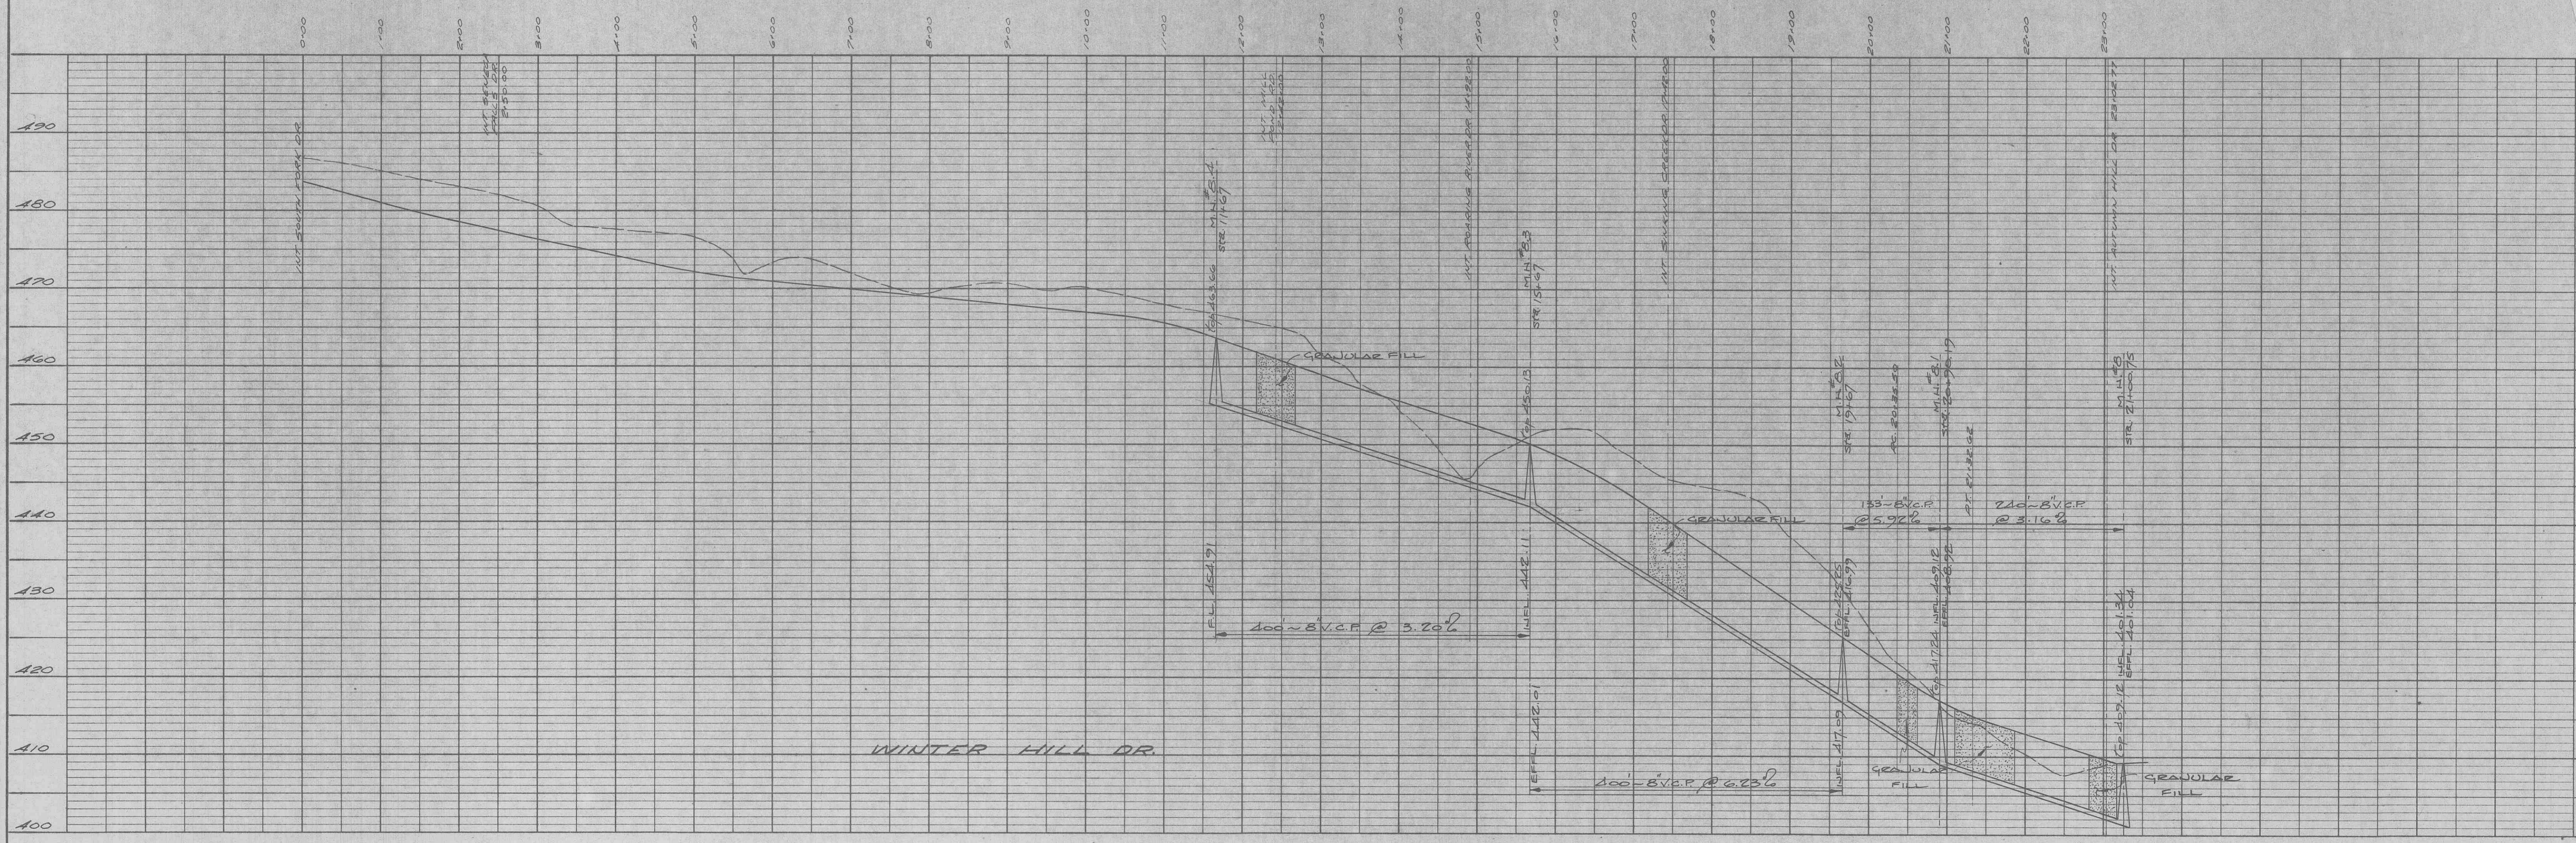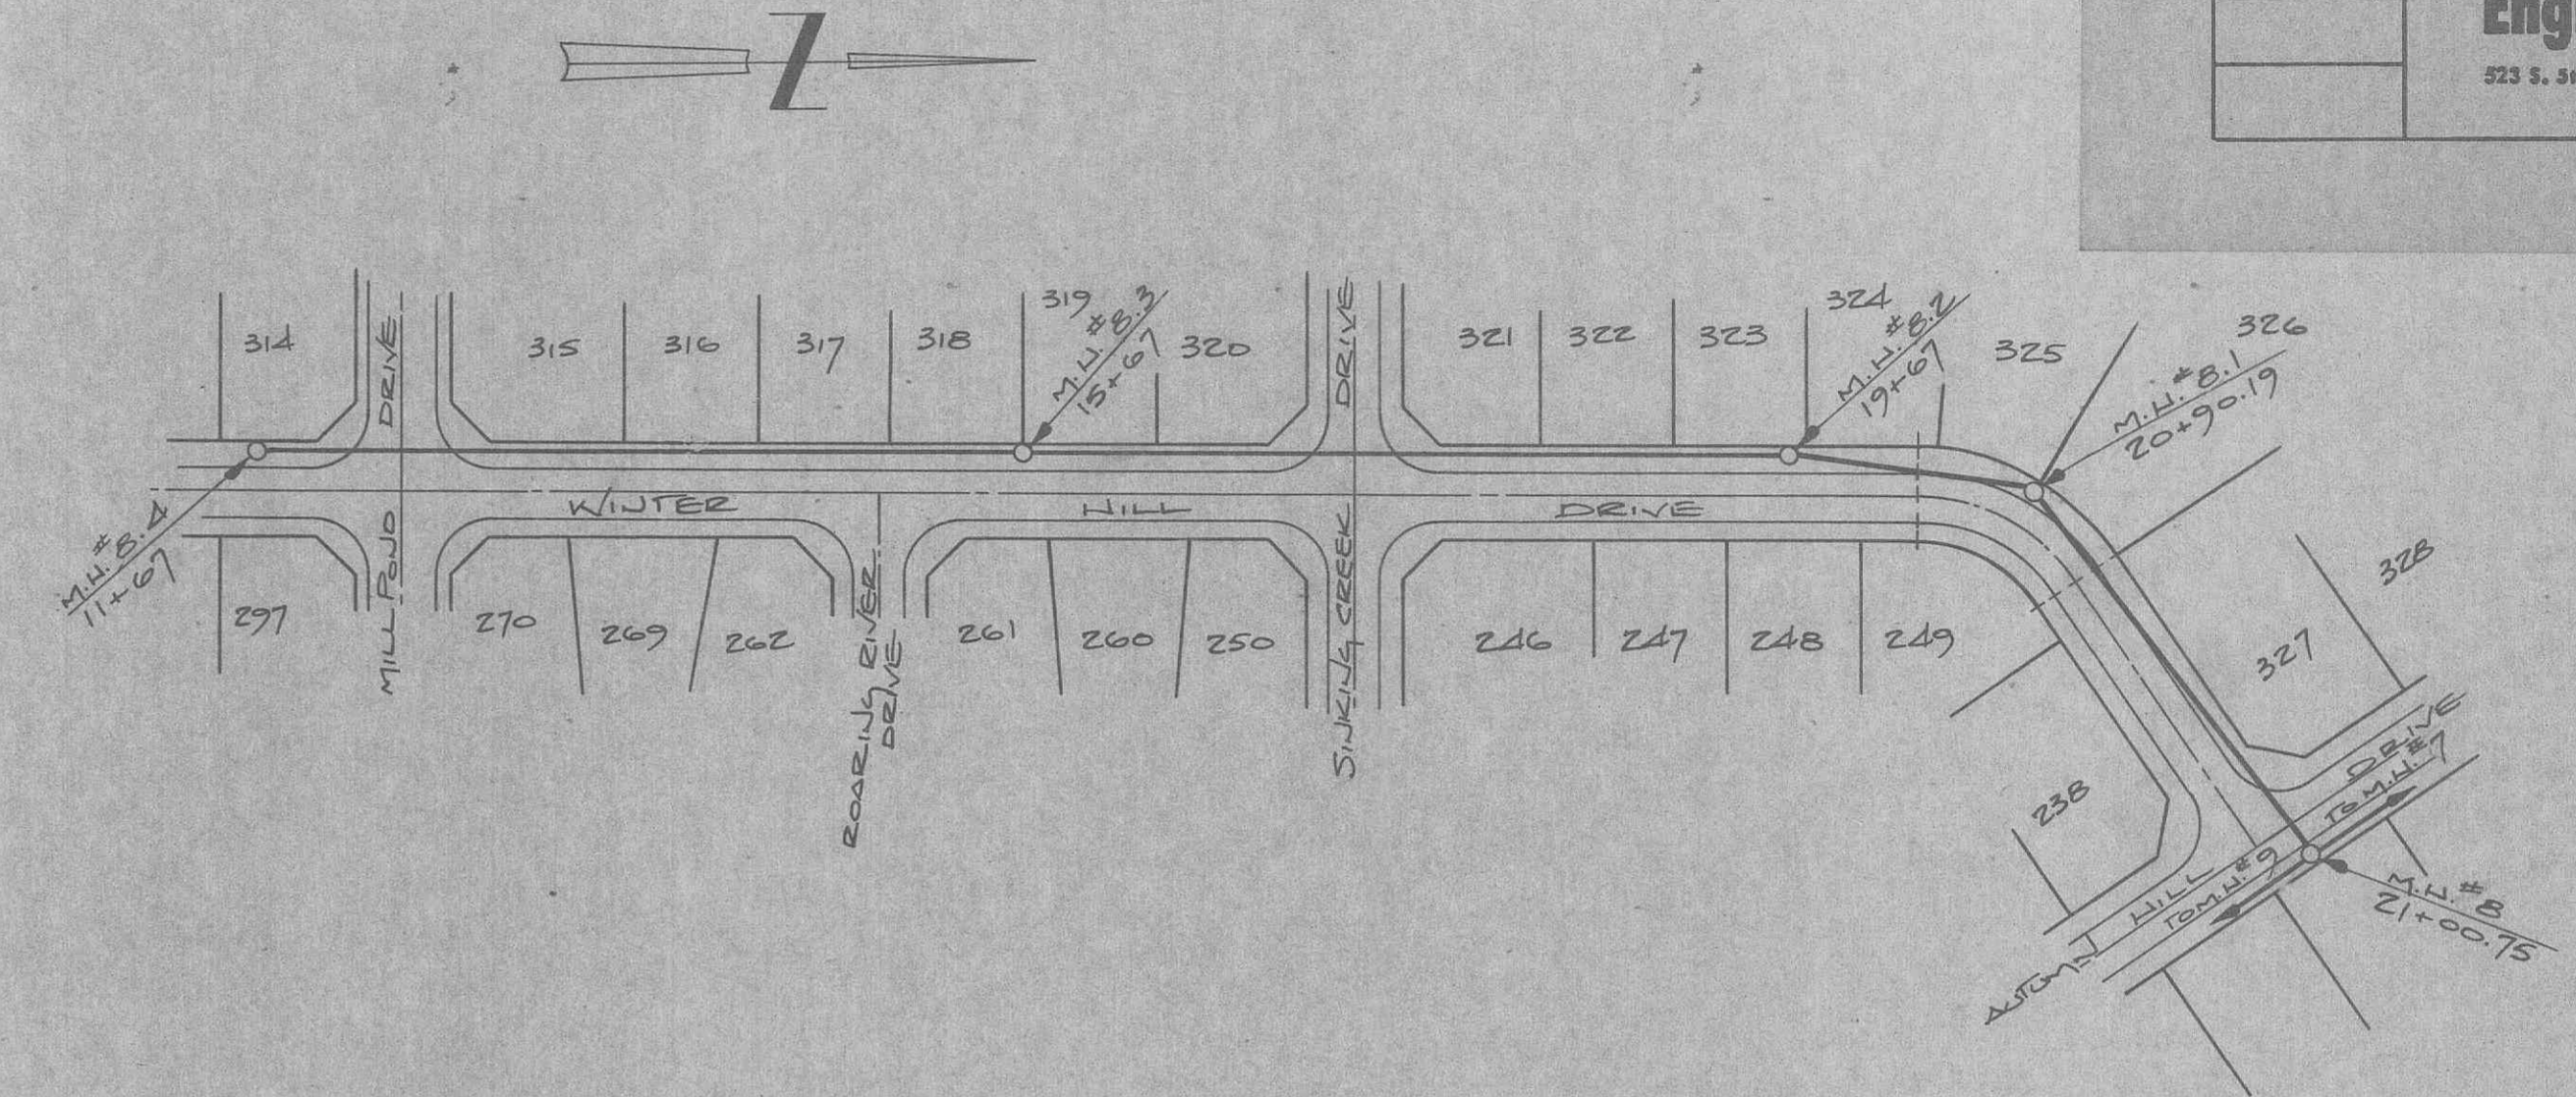

PLAN	DATE
BY	
NO. 1	
NO. 2	
NO. 3	
NO. 4	
NO. 5	
NO. 6	
NO. 7	
NO. 8	
NO. 9	
NO. 10	

PROFILE	DATE
BY	
NO. 1	
NO. 2	
NO. 3	
NO. 4	
NO. 5	
NO. 6	
NO. 7	
NO. 8	
NO. 9	
NO. 10	

410
400
123
240
1173 1 ft. 8" VCP

PLAN
 SURVEYED BY DATE
 PLOTTED BY
 NOTE BOOK No. ALORWAY CHECKED BY
 IN ALL PARTS

PROFILE
 SURVEYED BY DATE
 PLOTTED BY
 NOTE BOOK No. STRUCTURE NOTATIONS CHECKED BY



REVISIONS:

PEBBLE BROOK
PLAT TWO
SANITARY SEWERS

W.J. SWEENEY SHEET 18 OF 24
 VEGET: 1"=10'
 DATE 11-13-72 SCALE 4"=100'

Engineering & Surveying, Inc.
 223 S. 5th St. ST. CHARLES, MISSOURI
 RA 4-3330 AX 1-0876

CHARLES W. RUFF
 REGISTERED PROFESSIONAL ENGINEER
 E-10767

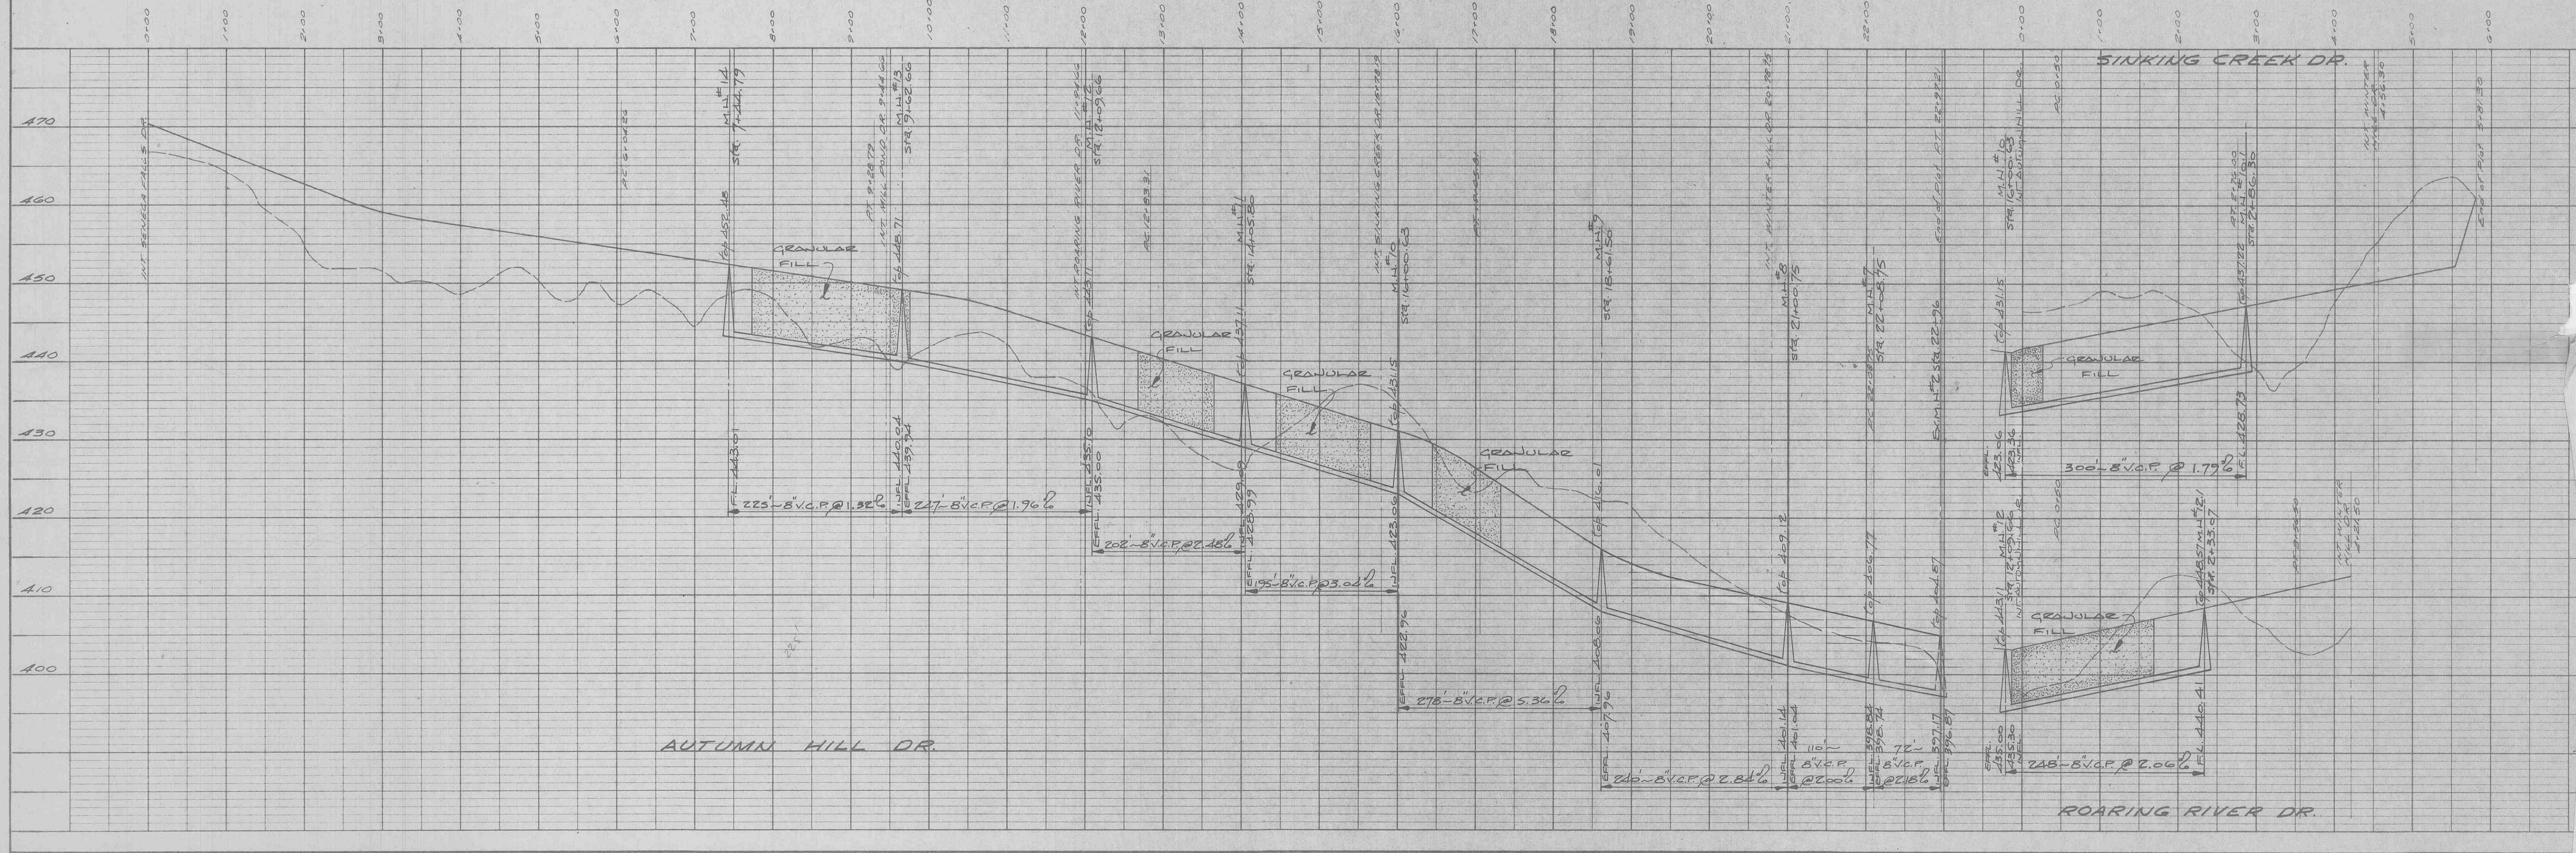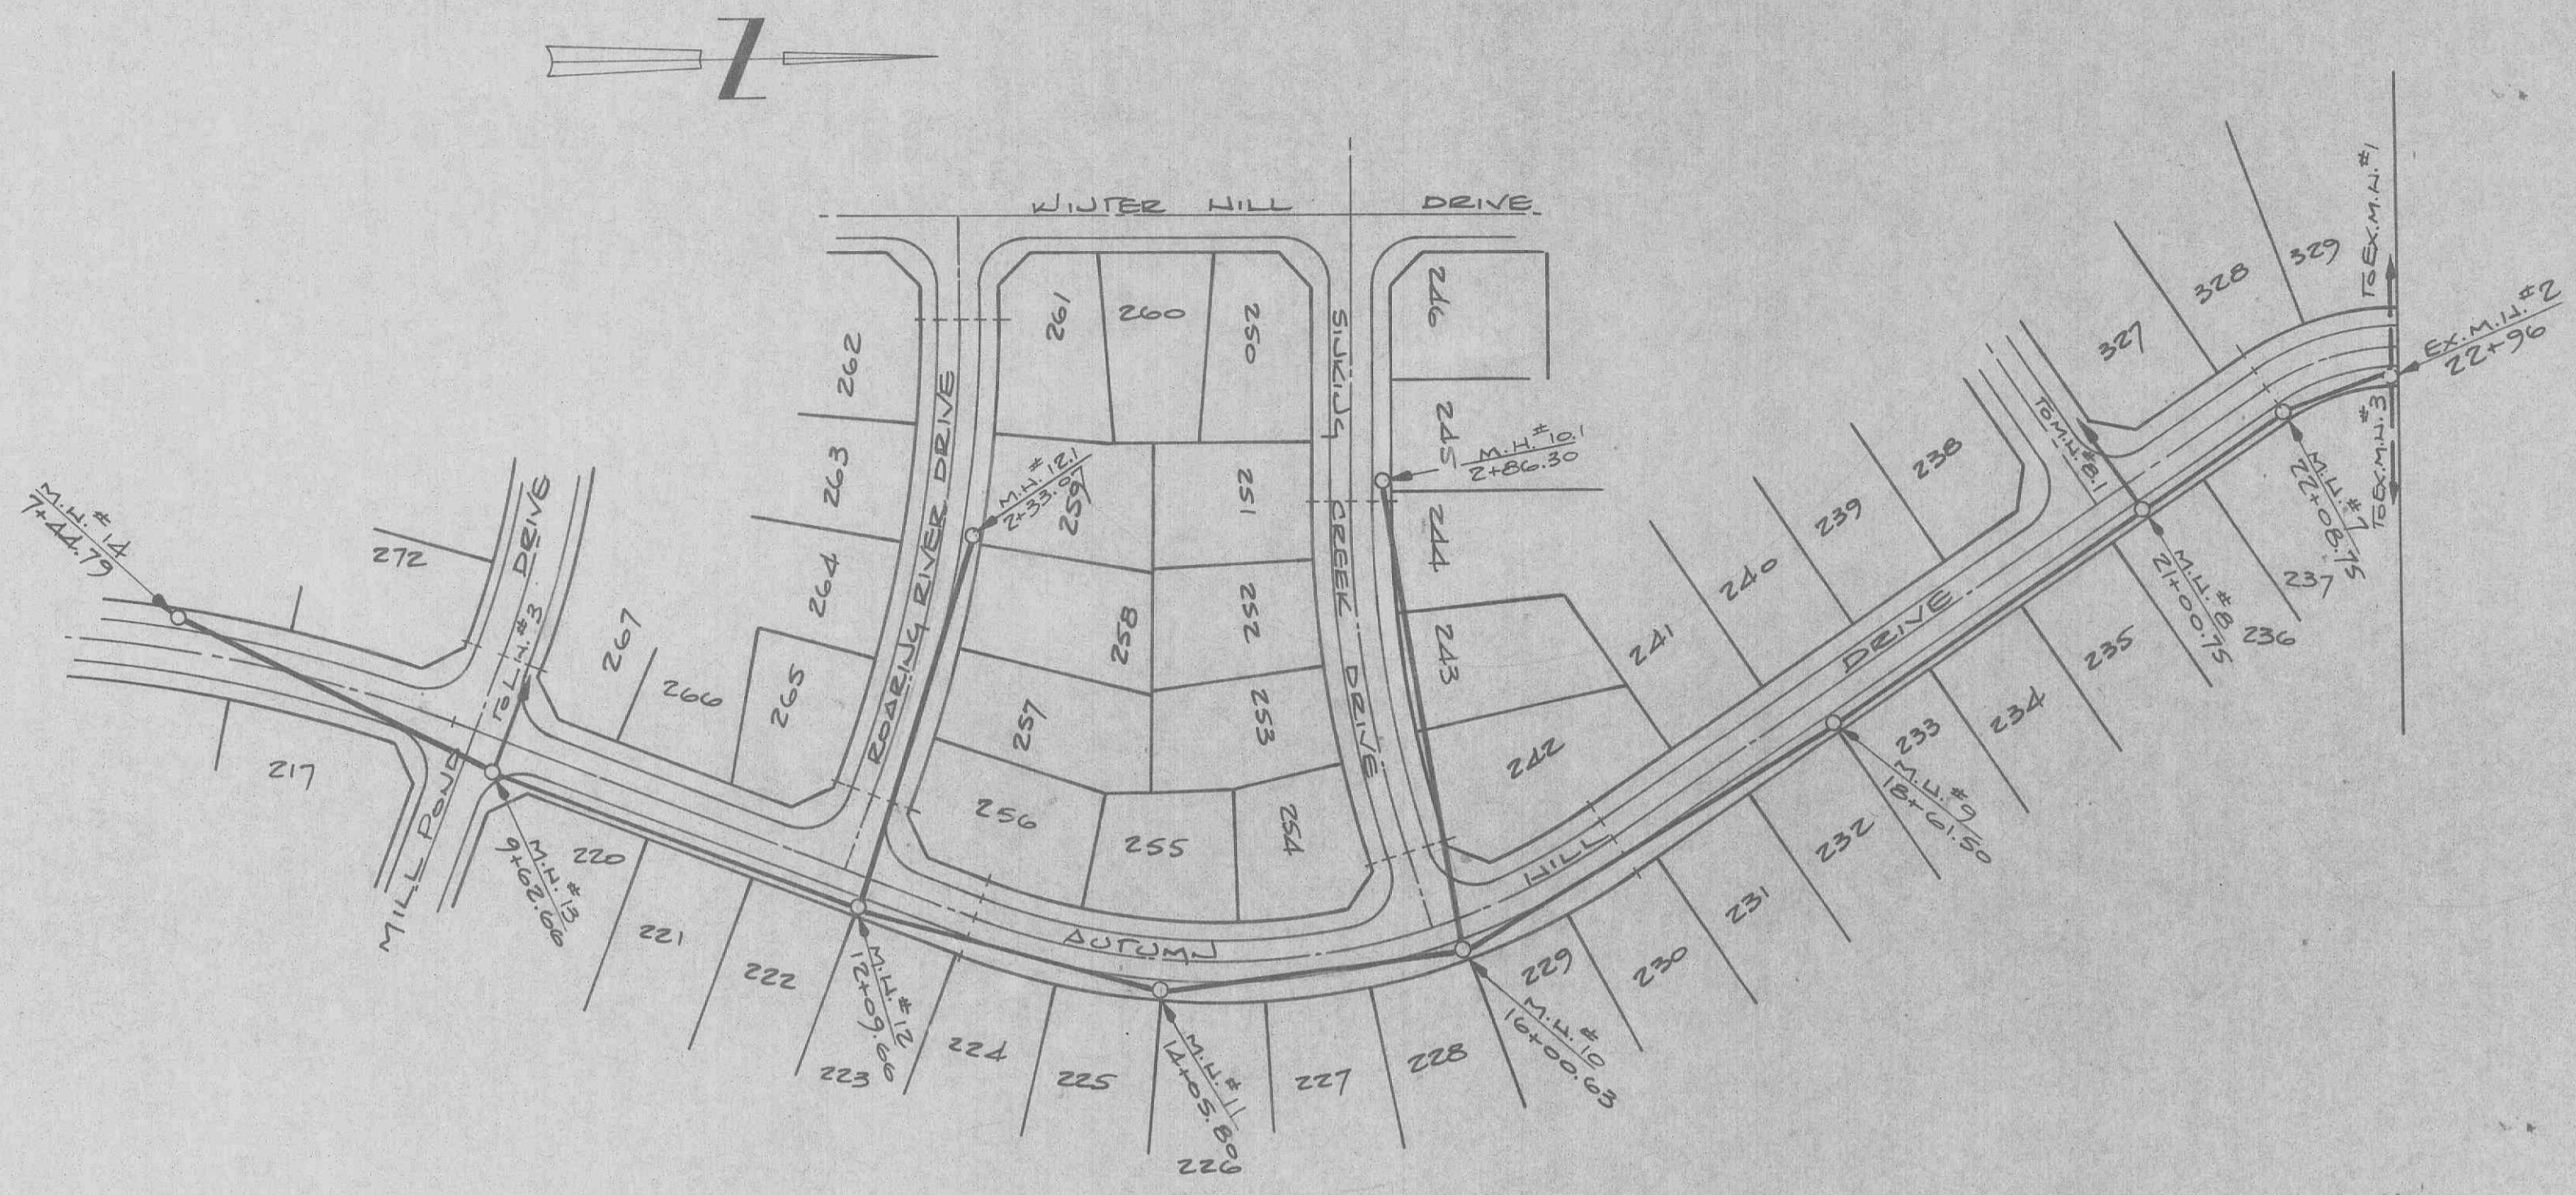

247
 242
 175
 278
 240
 110
 272
 248