

IMPROVEMENT PLANS POST MEADOWS

PART OF FRACTIONAL SECTION 12
TOWNSHIP 46 NORTH, RANGE 2 EAST,
ST. CHARLES COUNTY, MISSOURI

PHASE
TWO

CITY OF O'FALLON GENERAL NOTES


1. Gas, water and other underground utilities shall not conflict with the depth or horizontal locations of existing and proposed sanitary and storm sewers, including house laterals.
2. Underground utilities have been plotted from available information and, therefore, their locations must be considered approximate only. The verification of the location of all underground utilities, either shown or not shown on these plans, shall be the responsibility of the contractor and shall be located prior to grading or construction of improvements.
3. Polyvinyl Chloride (PVC) shall conform to the requirements of ASTM D-3034 Standard Specifications for the PVC Polyvinyl Chloride (PVC) Sewer Pipe and Fittings, SDR-35.
4. All storm sewer pipe, regardless of size, shall be reinforced concrete pipe (ASTM C-76, Class III), unless noted otherwise in the plans.
5. Corrugated metal pipe shall conform to the standard specifications for corrugated culvert pipe M-36, A.A.S.H.T.O. See plans for gauge.
6. All filled places under buildings, proposed sanitary and storm sewer lines, and/or paved areas including trench backfills shall be compacted to 90% of maximum density as determined by the "Modified A.A.S.H.T.O. T-180 Compaction Test" (ASTM D-1557) unless otherwise specified by the local governing authority specifications. All tests will be verified by a soils engineer.
7. All earthen filled places within State, County, or City roads (highways) shall be compacted to 95% of maximum density as determined by the "Standard Proctor Test" A.A.S.H.T.O. T-99 (ASTM D-698) unless otherwise specified by local governing authority specifications. All tests will be verified by a soils engineer.
8. All storm and sanitary trench backfills shall be water jetted. Granular fill will be used under paved areas.
9. Easements shall be provided for storm sewers, sanitary sewers, and oil utilities on the record plat. See record plat for location and size of easements. This does not apply to house laterals.
10. No area shall be cleared without the permission of the developer.
11. All grades shall be within 0.2 feet (more or less) of those shown on the grading plan.
12. No slope shall be greater than 3:1 and shall be either sodded or seeded and mulched.
13. Hazard markers will consist of three (3) standard specification "Manual on Uniform Traffic Control Devices," and of roadway markers mounted on two (2) pound "U" channel sign post. Each marker shall consist of an eighteen (18) inch diamond reflectorized red panel. The bottom of each panel shall be mounted a minimum of four (4) feet above the elevation of the pavement surface.
14. All manhole and curb inlet tops built without elevations furnished by the Engineer will be the responsibility of the sewer contractor. At the time of construction, stakes out of the sewer lines, curb and inlet tops will be face staked. If normal face stakes fail in line with sewer construction, the Engineer will set these stakes on a second offset. It shall be the responsibility of the sewer contractor to preserve all face stakes from destruction.
15. All standard street curb inlets to have front of inlet 2 feet behind curb.
16. The minimum vertical distance from the low point of the basement to the flowline of a sanitary sewer at the corresponding house connection shall not be less than the diameter of the sanitary sewer plus a vertical distance not less than two and one-half feet (2 1/2').
17. Water lines, valves, sleeves, meters and etc., shall meet all specifications and installation requirements of the local governing authority.
18. All water hydrants and valves shall be cast iron and installed in accordance with plans and details.
19. All sanitary and storm sewers shall meet all specifications and installation requirements of the local governing authority.
20. All PVC water pipe shall have a minimum pressure rating of PR-200 or SDR-21.
21. All PVC sanitary sewer pipe is to be SDR-35 or equal with "clean" 1/2 inch to 1-inch granular stone bedding uniformly graded 1/2 inch bedding shall extend from 4 inches below the pipe to springline of pipe immediate backfill over pipe shall consist of same size clean or minus stone from springline of pipe to 6 inches above the top of pipe.
22. All grading on Missouri State Highway Right-of-Way shall be seeded and mulched on disturbed Right-of-Way markers shall be reset at the completion of grading.
23. All streets must meet the specifications and installation requirements of the City of O'Fallon.
24. All sanitary manholes top shall be set 0.2' higher than the proposed ground except in pavement areas.
25. All exterior sanitary sewer manholes shall be waterproofed on the exterior in accordance with Missouri Dept of Natural Resources specification 10 CSR 810(MKE).
26. All sanitary service lines shall have a 6" diameter for multi-family and a 4" diameter for single-family developments.
27. Manhole frame and cover shall be Clay and Bailey No. 2008 or Neenah R-1736 or Deeter 1315 or approved equal.
28. A drop of 0.2 feet is required through each sanitary manhole.
29. All pipes shall have positive drainage through manholes. No flat base structures are allowed.
30. The contractor shall prevent all storm, surface water and construction debris from entering the existing sanitary sewer system.
31. Brick shall not be used on manholes.
32. All existing site improvements disturbed, damaged or destroyed shall be repaired or replaced to closely match preconstruction conditions.
33. All sanitary sewer pipelines and manholes without elevations furnished by the engineer will be the responsibility of the sewer contractor.
34. All creek crossings shall be grouted up-rap as directed by District inspectors. All grout shall be high slump ready-mix concrete.
35. Premanufactured adapters shall be used at all PVC to D/P connections. Rubber boot/mession type couplings will not be allowed.
36. NOTE: The grading and elevations shown on the grading plans are for construction purposes only. Finished grades and slopes will vary from those shown on the plans depending upon the location, size and type of house built on the lot. However, care should be taken to insure that finished grading conforms to drainage area maps.
37. As needed, siltation fence shall be installed as a protective barrier for trees to remain.
38. This tract is in or served by:
 - A. WATER - St. Charles Co. Public Water District No. 2
 - B. SEWER - Duckett Creek Sanitary District
 - C. ELECTRIC - St. Charles Electric Company
 - D. TELEPHONE - G.T.T. Telephone Company
 - E. GAS - St. Charles Gas Company
 - F. FIRE - Wentzville Fire Protection District
 - G. SCHOOL - Wentzville School District
39. The contractor shall be responsible for insuring that all areas within the grading limits that have been disturbed shall be seeded and mulched within ninety (90) days of completion.
40. The contractor shall be responsible for the removal and disposal of all existing improvements, except those designated to be left in place, from within the limits of the construction area.
41. The Duckett Creek Sanitary District shall be notified at least 48 hours prior to construction of sanitary sewers, for coordination and inspection.
42. All intersections within this subdivision meet the sight distance requirements.

160° LOTS

DRAWING INDEX

Sheet	Description
1	COVER SHEET
2-5	FLAT PLANS
6-9	GRADING PLANS
10-13	STREET PROFILES
14-16	STORM PROFILES
17-19	SANITARY PROFILES
20-23	WATER PLANS
24	ENTRANCE DETAILS
25-28	DRAINAGE AREA PLANS
29-34	CONSTRUCTION DETAILS

LOCATION MAP

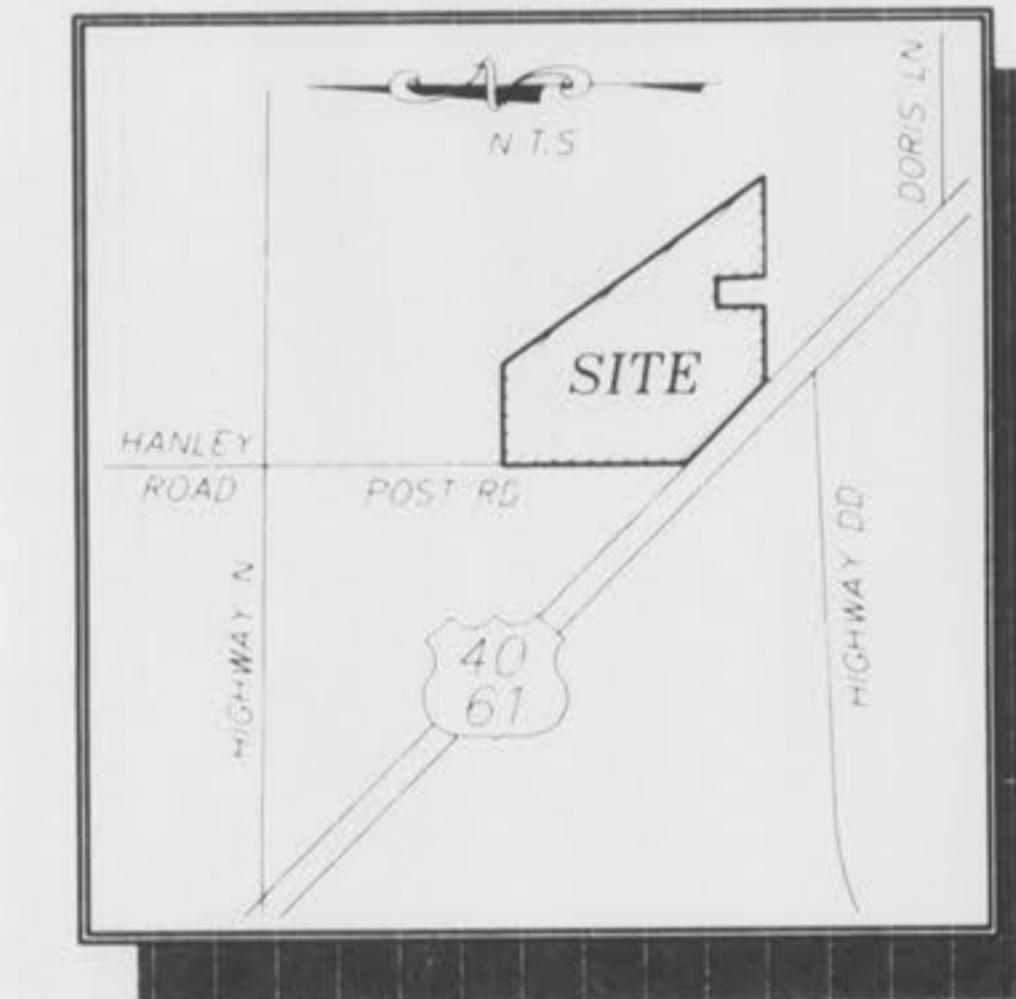

"AS-BUILTS"

This is to certify to City of O'Fallon that these "As-Built" Post Meadow plans are based on actual field surveys conducted during August, 1996 and the results are shown hereon.

By: Daniel Ehlmann
DANIEL EHLMANN, R.L.S., #2215
STATE OF MISSOURI

PICKETT, RAY & SILVER'S CORPORATE
REGISTRATION NO. LS-54-D

"AS-BUILTS"

LEGEND

● Sanitary Sewer (Proposed)	R.C.P.	Reinforced Concrete Pipe
— Sanitary Sewer (Existing)	C.M.P.	Corrugated Metal Pipe
- - ■ Storm Sewer (Proposed)	C.I.P.	Cast Iron Pipe
= ◻ Storm Sewer (Existing)	P.V.C.	Polyvinyl Chloride
— Water Line & Size	V.C.P.	Vitrified Clay Pipe
■ Light Standard		
- EX — Existing water line		
● Double Water Meter Setting		
— Tee & Valve	C.O.	Clean Out
Hydrant	V.T.	Vent Trap
Cap	T.B.R.	To Be Removed
18 Lot or Building Number	T.B.R.&R.	To Be Removed & Relocated
- X — Existing Fence Line	T.B.P.	To Be Protected
Existing Tree Line	T.B.A.	To Be Abandoned
Street Sign	D.A.I.	Double Area Inlet
Existing Contour	B.C.	Base Of Curb
Proposed Contour	T.C.	Top Of Curb
Grouted Rip-Rap	F.E.	Flared End Section
End of Lateral	B.W.	Base Of Wall
Asphalt Pavement	E.D.	Energy Dissipator (Typical)
Concrete Pavement	M.H.	Unless Noted Otherwise
Concrete Pipe	C.P.	In Place

SITE BENCHMARK

RM #39
CHISELED "□" SQUARE ON NORTH END OF WEST HEADWALL OF POST ROAD BRIDGE OVER TRIBUTARY NO. 15
ELEV. 556.90 (NGVD. & USGS)

REVISIONS

REV. 10/23/96 PER CITY OF O'FALLON COMMENTS
REV. 11/28/96 SHEETS 2-9, 17-19 San. Sewers
REV. 11/28/96 PER DUCKETT CREEK COMMENTS
REV. 12/9/96 PER CITY OF O'FALLON COMMENTS
REV. 12/9/96 PER DUCKETT CREEK COMMENTS
REV. 1-14-97 PER CITY OF O'FALLON (Sheets 2, 3, 5, 7, 9, 16, 21, 23, 26, 28)
REV. 1-14-97 PER CITY OF O'FALLON (Sheets 3, 5, 7, 9, 16, 21, 23, 26, 28)
REV. 7/15/97 (F.E. III) SHEETS 3, 5, 7, 9, 16, 21, 23, 26, 28

DEVELOPER

L.A.D. PROPERTIES, L.L.C.
2458 OLD DORSETT ROAD
SUITE 110
ST. LOUIS, MISSOURI 63043
PHONE: (314) 298-5108

© Copyright 1996 by Pickett, Ray & Silver Inc.	
CONFIDENTIAL PROPRIETARY MATERIAL The use, reproduction and sales rights of this drawing are reserved by Pickett, Ray & Silver Inc.	
DRAWN <u>R.D.W.</u>	DATE <u>09/96</u>
CHECKED <u>K.J.D.</u>	DATE <u>09/96</u>
FIELD BOOK	PROJECT # <u>96-028</u>
	JOB ORDER # <u>34917</u>

PICKETT RAY & SILVER

Civil Engineers
Planners
Land Surveyors

333 Mid Rivers Mall Dr.
St. Peters, MO 63376
397-1211 FAX 397-1104

IMPROVEMENT PLANS POST MEADOWS

PART OF FRACTIONAL SECTION 12
TOWNSHIP 46 NORTH, RANGE 2 EAST,
ST. CHARLES COUNTY, MISSOURI

PHASE
1/60

CITY OF O'FALLON GENERAL NOTES


1. Gas, water and other underground utilities shall not conflict with the depth or horizontal locations of existing and proposed sanitary and storm sewers, including house laterals.
2. Underground utilities have been plotted from available information and therefore, their locations must be considered approximate only. The location of the location of any utility, either shown or not shown on these plans, shall be the responsibility of the contractor and shall be located prior to grading or construction of improvements.
3. Polyvinyl Chloride (PVC) shall conform to the requirements of ASTM D-3034 Standard Specifications for the Polyvinyl Chloride (PVC) Sewer Pipe and Fittings, SDR-35.
4. All storm sewer pipe, regardless of size, shall be reinforced concrete pipe (ASTM C-76, Class III) unless noted otherwise in the plans.
5. Corrugated metal pipe shall conform to the standard specifications for corrugated culvert pipe M-36, AASHTO. See plans for gauge.
6. All filled places under buildings, proposed sanitary and storm sewer lines, and/or paved areas including trench backfills shall be compacted to 90% of maximum density as determined by the "Modified AASHTO T-180 Compaction Test" (ASTM D-1557) unless otherwise specified by the local governing authority specifications. All tests will be verified by a soils engineer.
7. All earthen filled places within State, County, or City roads (highways) shall be compacted to 95% of maximum density as determined by "Standard Proctor Test" AASHTO T-99 (ASTM D-698) unless otherwise specified by local governing authority specifications. All tests will be verified by a soils engineer.
8. All storm and sanitary trench backfills shall be water jetted. Granular fill will be used under paved areas.
9. Easements shall be provided for storm sewers, sanitary sewers, and all utilities on the record plat. See record plat for location and size of easements. This does not apply to house laterals.
10. No area shall be cleared without the permission of the developer.
11. All grades shall be within 0.2 feet (more or less) of those shown on the grading plan.
12. No slope shall be greater than 3% and shall be either sodded or seeded and mulched.
13. Hazard markers will consist of three (3) standard specification, "Manual on Uniform Traffic Control Devices," and temporary markers mounted on two (2) pound "U" type sign post. Each marker shall consist of an eighteen (18) inch diamond reflectorized red panel. The bottom of each panel shall be mounted a minimum of four (4) feet above the elevation of the pavement surface.
14. All manhole and curb inlet tops built without elevations furnished by the Engineer will be the responsibility of the sewer contractor. At the time of construction, stakes out of the sewer lines, all curb and grate inlets shall be face staked. If normal face stakes are used with sewer construction, the Engineer will set these stakes on a double offset. It shall be the responsibility of the sewer contractor to preserve all face stakes from destruction.
15. All standard street curb inlets to have front of inlet 2 feet behind curb.
16. The minimum vertical distance from the low point of the basement to the flowline of a sanitary sewer at the corresponding house connection shall not be less than the diameter of the sanitary sewer plus a vertical distance not less than two and one-half feet (2-1/2').
17. Water lines, valves, sleeves, meters and etc., shall meet all specifications and installation requirements of the local governing authority.
18. All cast iron pipe for water mains shall conform to AWWA specification C-106 and/or C-108. The cast iron fittings shall conform to AWWA specification C-110. All rubber gasket joints for water cast iron pressure pipe and fittings shall conform to AWWA specification C-111.
19. All water hydrants and valves shall be cast iron and installed in accordance with plans and details.
20. All sanitary and storm sewers shall meet all specifications and installation requirements of the local governing authority.
21. All PVC water pipe shall have a minimum pressure rating of PR-200 or SDR-21.
22. All PVC sanitary sewer pipe is to be SDR-35 or equal with "clean" 1/2 inch greater stone bedding uniformly graded. The bedding shall extend from 4 inches below the pipe to springline of pipe immediate backfill over pipe shall consist of same size clean or minus stone from granule of pipe to 6 inches above the top of pipe.
23. All grading Missouri State Highway Right-of-Way shall be seeded and mulched and an undisturbed Right-of-Way markers shall be reest at the completion of grading.
24. All streets must meet the specifications and installation requirements of the City of O'Fallon.
25. All sanitary manholes top shall be set 0.2' higher than the proposed ground except in pavement areas.
26. All exterior sanitary sewer manholes shall be interpreted on the exterior in accordance with Missouri Dept. of Natural Resources specification 10 CSR 8120(1)(E).
27. All sanitary service lines shall have a 6" diameter for multi-family and a 4" diameter for single-family developments.
28. Manhole frame and cover shall be Clay and Bailey No. 2008 or Neenah R-1736 or Deeter 1315 or approved equal.
29. A drop of 0.2 feet is required through each sanitary manhole.
30. All pipes shall have positive drainage through manholes. No flat base structures are allowed.
31. The contractor shall prevent all storm, surface water, mud and construction debris from entering the existing sanitary sewer system.
32. Bricks shall not be used on manholes.
33. All existing site improvements disturbed, damaged or destroyed shall be repaired or replaced to closely match preconstruction conditions.
34. All sanitary sewer lines and manholes built without elevations furnished by the engineer will be the responsibility of the sewer contractor.
35. All creek crossings shall be grouted no rap as directed by District Inspectors (No rap shall be high slump ready mix concrete).
36. Manufactured adapters shall be used at all PVC to DIP connections. Rubber boot/masonry type couplings will not be allowed.
37. NOTE: The grading and elevations shown on the grading plans are for construction purposes only. Finished grades and slopes will vary from those shown on the plans depending upon the location, size and type of house built on the lot. However, care should be taken to insure that finished grading conforms to drainage area maps.
38. As needed, siteline fence shall be installed as a protective barrier for trees to remain.
39. This tract of land is or served by:
A. WATER - St. Charles Co. Public Water District No. 2
B. SEWER - Duckett Creek Sanitary District
C. ELECTRIC - Duckett Creek Union Electric Company
D. TELEPHONE - GTE Telephone Company
E. GAS - St. Charles Gas Company
F. FIRE - Wentzville Fire Protection District
G. SCHOOL - Wentzville School District
40. The contractor shall be responsible for insuring that all areas within the grading limits that have been disturbed shall be seeded and mulched within ninety (90) days of completion.
41. The contractor shall be responsible for the removal and disposal of all existing improvements, except those designated to be left in place, from within the limits of the construction area.
42. The Duckett Creek Sanitary District shall be notified at least 48 hours prior to construction of sanitary sewers, for coordination and inspection.
43. All intersections within this subdivision meet the sight distance requirements.

160° LOTS

DRAWING INDEX

Sheet	Description
1	COVER SHEET
2-5	FLAT PLANS
6-9	GRADING PLANS
10-13	STREET PROFILES
14-16	STORM PROFILES
17-19	SANITARY PROFILES
20-23	WATER PLANS
24	ENTRANCE DETAILS
25-28	DRAINAGE AREA PLANS
29-34	CONSTRUCTION DETAILS

LOCATION MAP

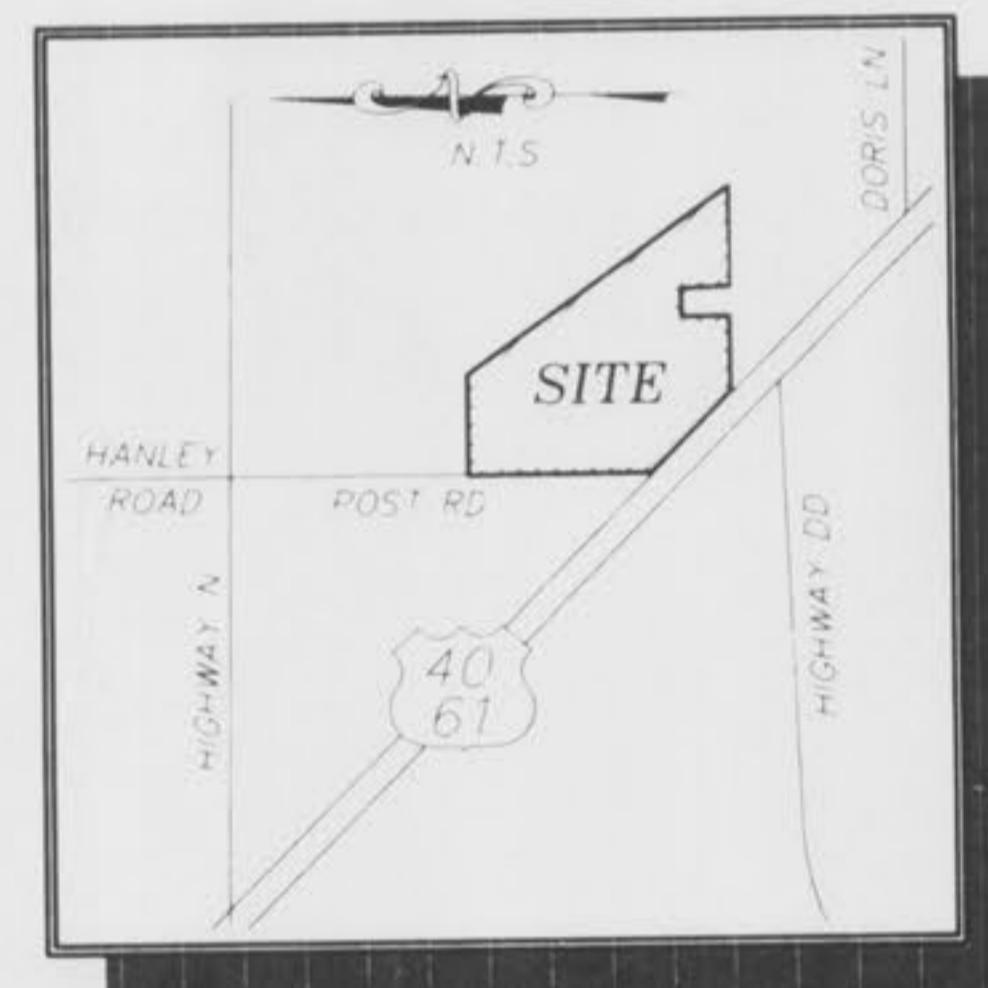

"AS-BUILTS"

This is to certify to City of O'Fallon that these "As-Built" Post Meadow plans are based on actual field surveys conducted during August 1996 and the results are shown herein.

By: Daniel Ehlmann
DANIEL EHLMANN, R.L.S., #2215
STATE OF MISSOURI

PICKETT, RAY & SILVER'S CORPORATE
REGISTRATION NO. LS-54-D



ENGINEERS AUTHENTICATION
The responsible professional engineer(s) on this project is hereby certified that the set of plans and specifications contained in this drawing are prepared for the owner engineering plans included in the project and specifically includes revisions after this date unless otherwise indicated.

PICKETT, RAY & SILVER, INC.

"AS-BUILTS"

SITE BENCHMARK

REV. 10/23/96 PER CITY OF O'FALLON COMMENTS
CHISELED "□" SQUARE ON NORTH END OF WEST
HEADWALL OF POST ROAD BRIDGE OVER
TRIBUTARY NO. 15.
ELEV. 556.90 (NGVD. & USGS)

REVISIONS

REV. 10/23/96 PER CITY OF O'FALLON COMMENTS
CHISELED "□" SQUARE ON NORTH END OF WEST
HEADWALL OF POST ROAD BRIDGE OVER
TRIBUTARY NO. 15.
ELEV. 556.90 (NGVD. & USGS)
REV. 1/16/97 PER CITY OF O'FALLON COMMENTS
CHISELED "□" SQUARE ON NORTH END OF WEST
HEADWALL OF POST ROAD BRIDGE OVER
TRIBUTARY NO. 15.
ELEV. 556.90 (NGVD. & USGS)
REV. 1/16/97 PER CITY OF O'FALLON COMMENTS
CHISELED "□" SQUARE ON NORTH END OF WEST
HEADWALL OF POST ROAD BRIDGE OVER
TRIBUTARY NO. 15.
ELEV. 556.90 (NGVD. & USGS)

DEVELOPER

L.A.D. PROPERTIES, L.L.C.
2458 OLD DORSETT ROAD
SUITE 110
ST. LOUIS, MISSOURI 63043
PHONE: (314) 298-5108

© Copyright 1996 by Pickett, Ray & Silver Inc.



CONFIDENTIAL PROPRIETARY MATERIAL
The use, reproduction and sales rights of this
drawing are reserved by Pickett, Ray & Silver Inc.

DRAWN	R.D.W.	DATE	09/96
CHECKED	K.J.D.	DATE	09/96
FIELD BOOK	PROJECT #	96-028	34917

PICKETT RAY & SILVER
Civil Engineers
Planners
Land Surveyors

333 Mid Rivers Mall Dr.
St. Peters, MO 63376
397-1211 FAX 397-1104

SEE SHEET 3

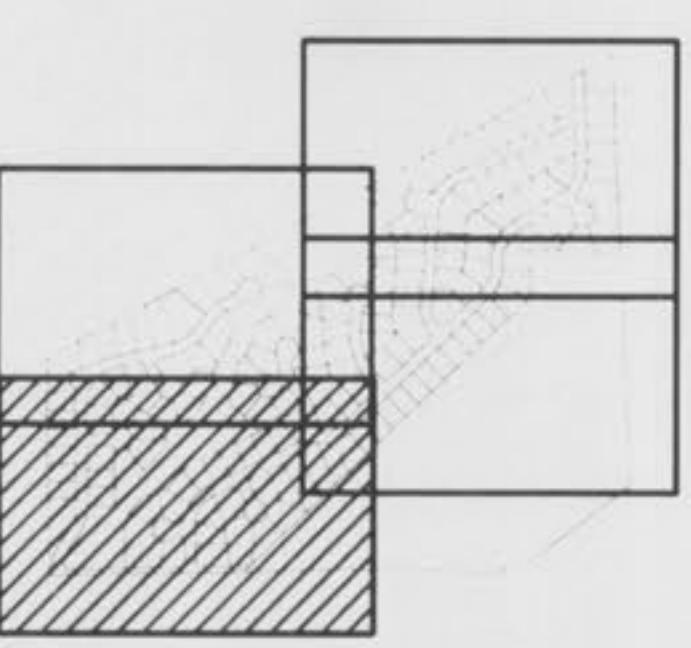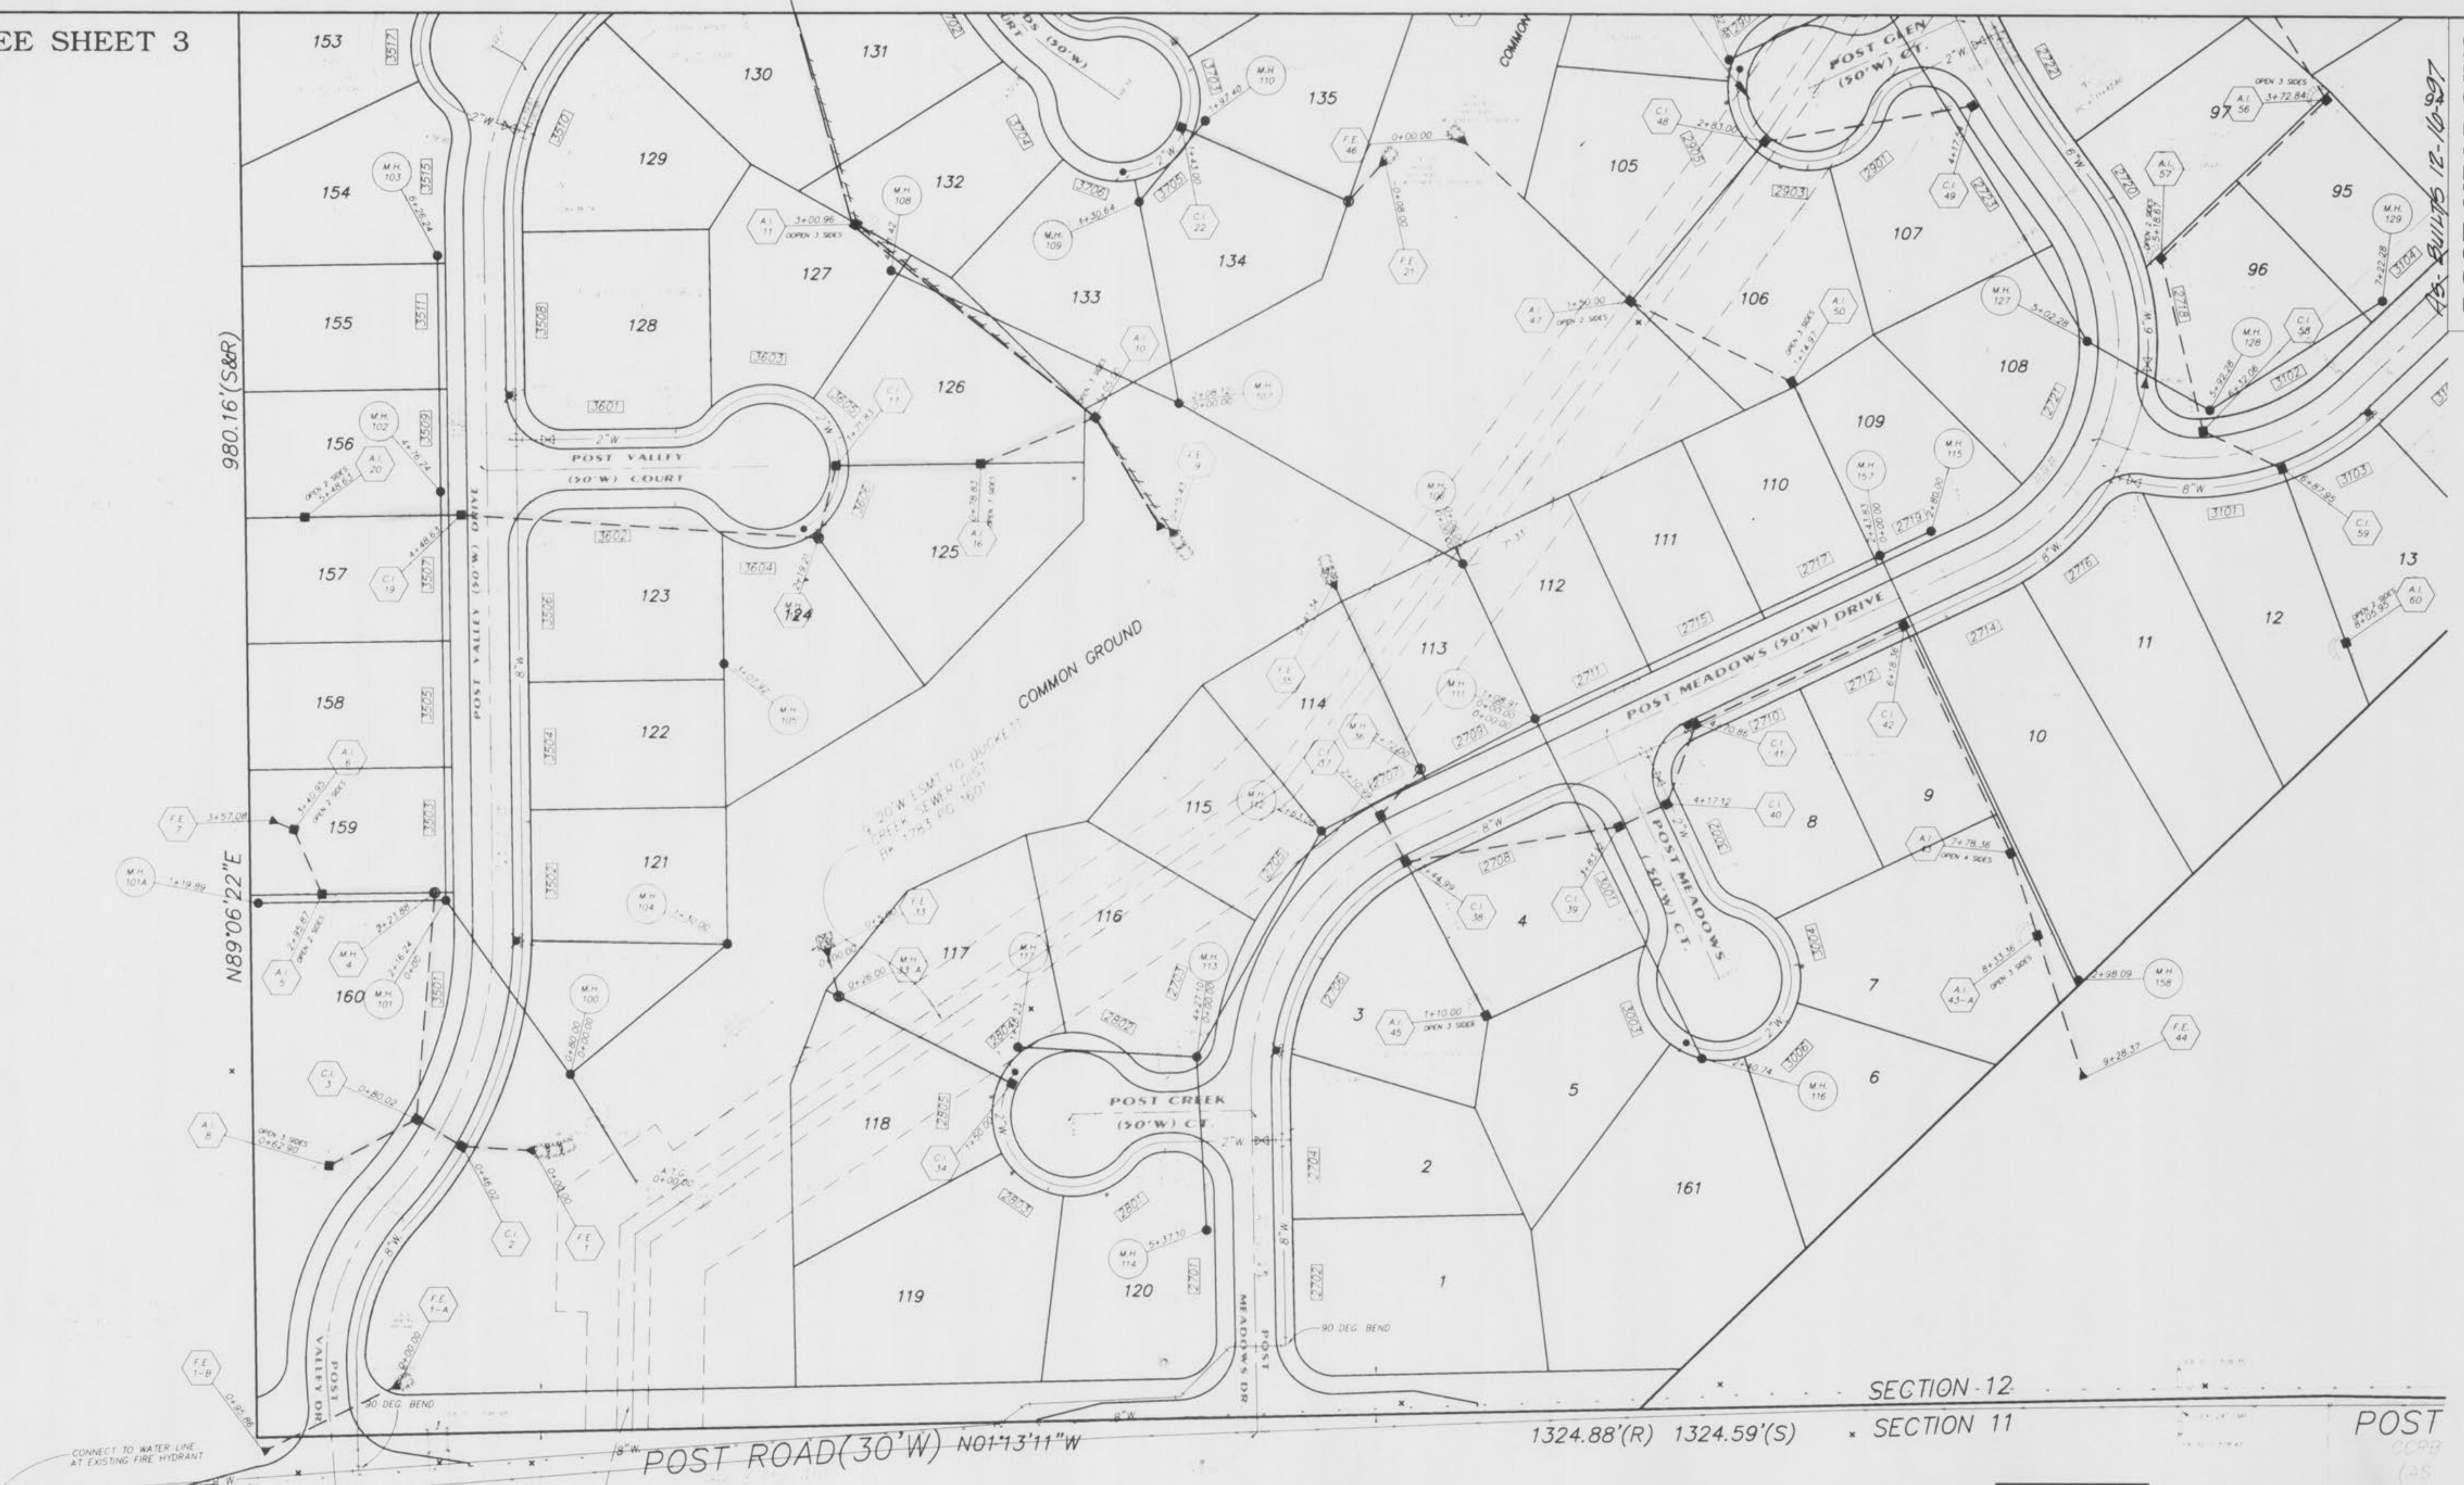

KEY MAP

"AS-BUILT"

AS-BUILTS 12-16-97

**POST MEADOWS
STORM SEWER PROFILES**

REV. 10-23-96
REV. C-2009-MAY-2000
PER. D.G.S.D.
DRAFTED 12-17-2000
PRINTED 12-17-2000

"AS-BUILTS"

FINAL SURVEY PLOTTED

NOTEBOOK NUMBER

AREAS CHECKED

ORIGINAL SURVEY SURVEYED

NOTEBOOK NUMBER

AREAS CHECKED



AS-BUILTS 12-16-97


POST MEADOWS
SANITARY SEWER PROFILES

96-028
 REV 10-23-96 PER CITY OF OTTAWA
 REV 10-28-96
 REV 11-04-96
 Rev. 11-06-96 Per Duckett Creek.

NOTE:
 PREMANUFACTURED ADAPTERS SHALL BE USED AT ALL PVC TO DIP CONNECTIONS.
 RUBBER BOOT/MISSION TYPE COUPLINGS WILL NOT BE ALLOWED.

FINAL SURVEY
SLIPPIED
PLOTTED
NOTE BOOK
TEMPLATE
AREAS CHECKED
NO.

ORIGINAL SURVEY
SLIPPIED
PLOTTED
NOTE BOOK
TEMPLATE
AREAS CHECKED
NO.

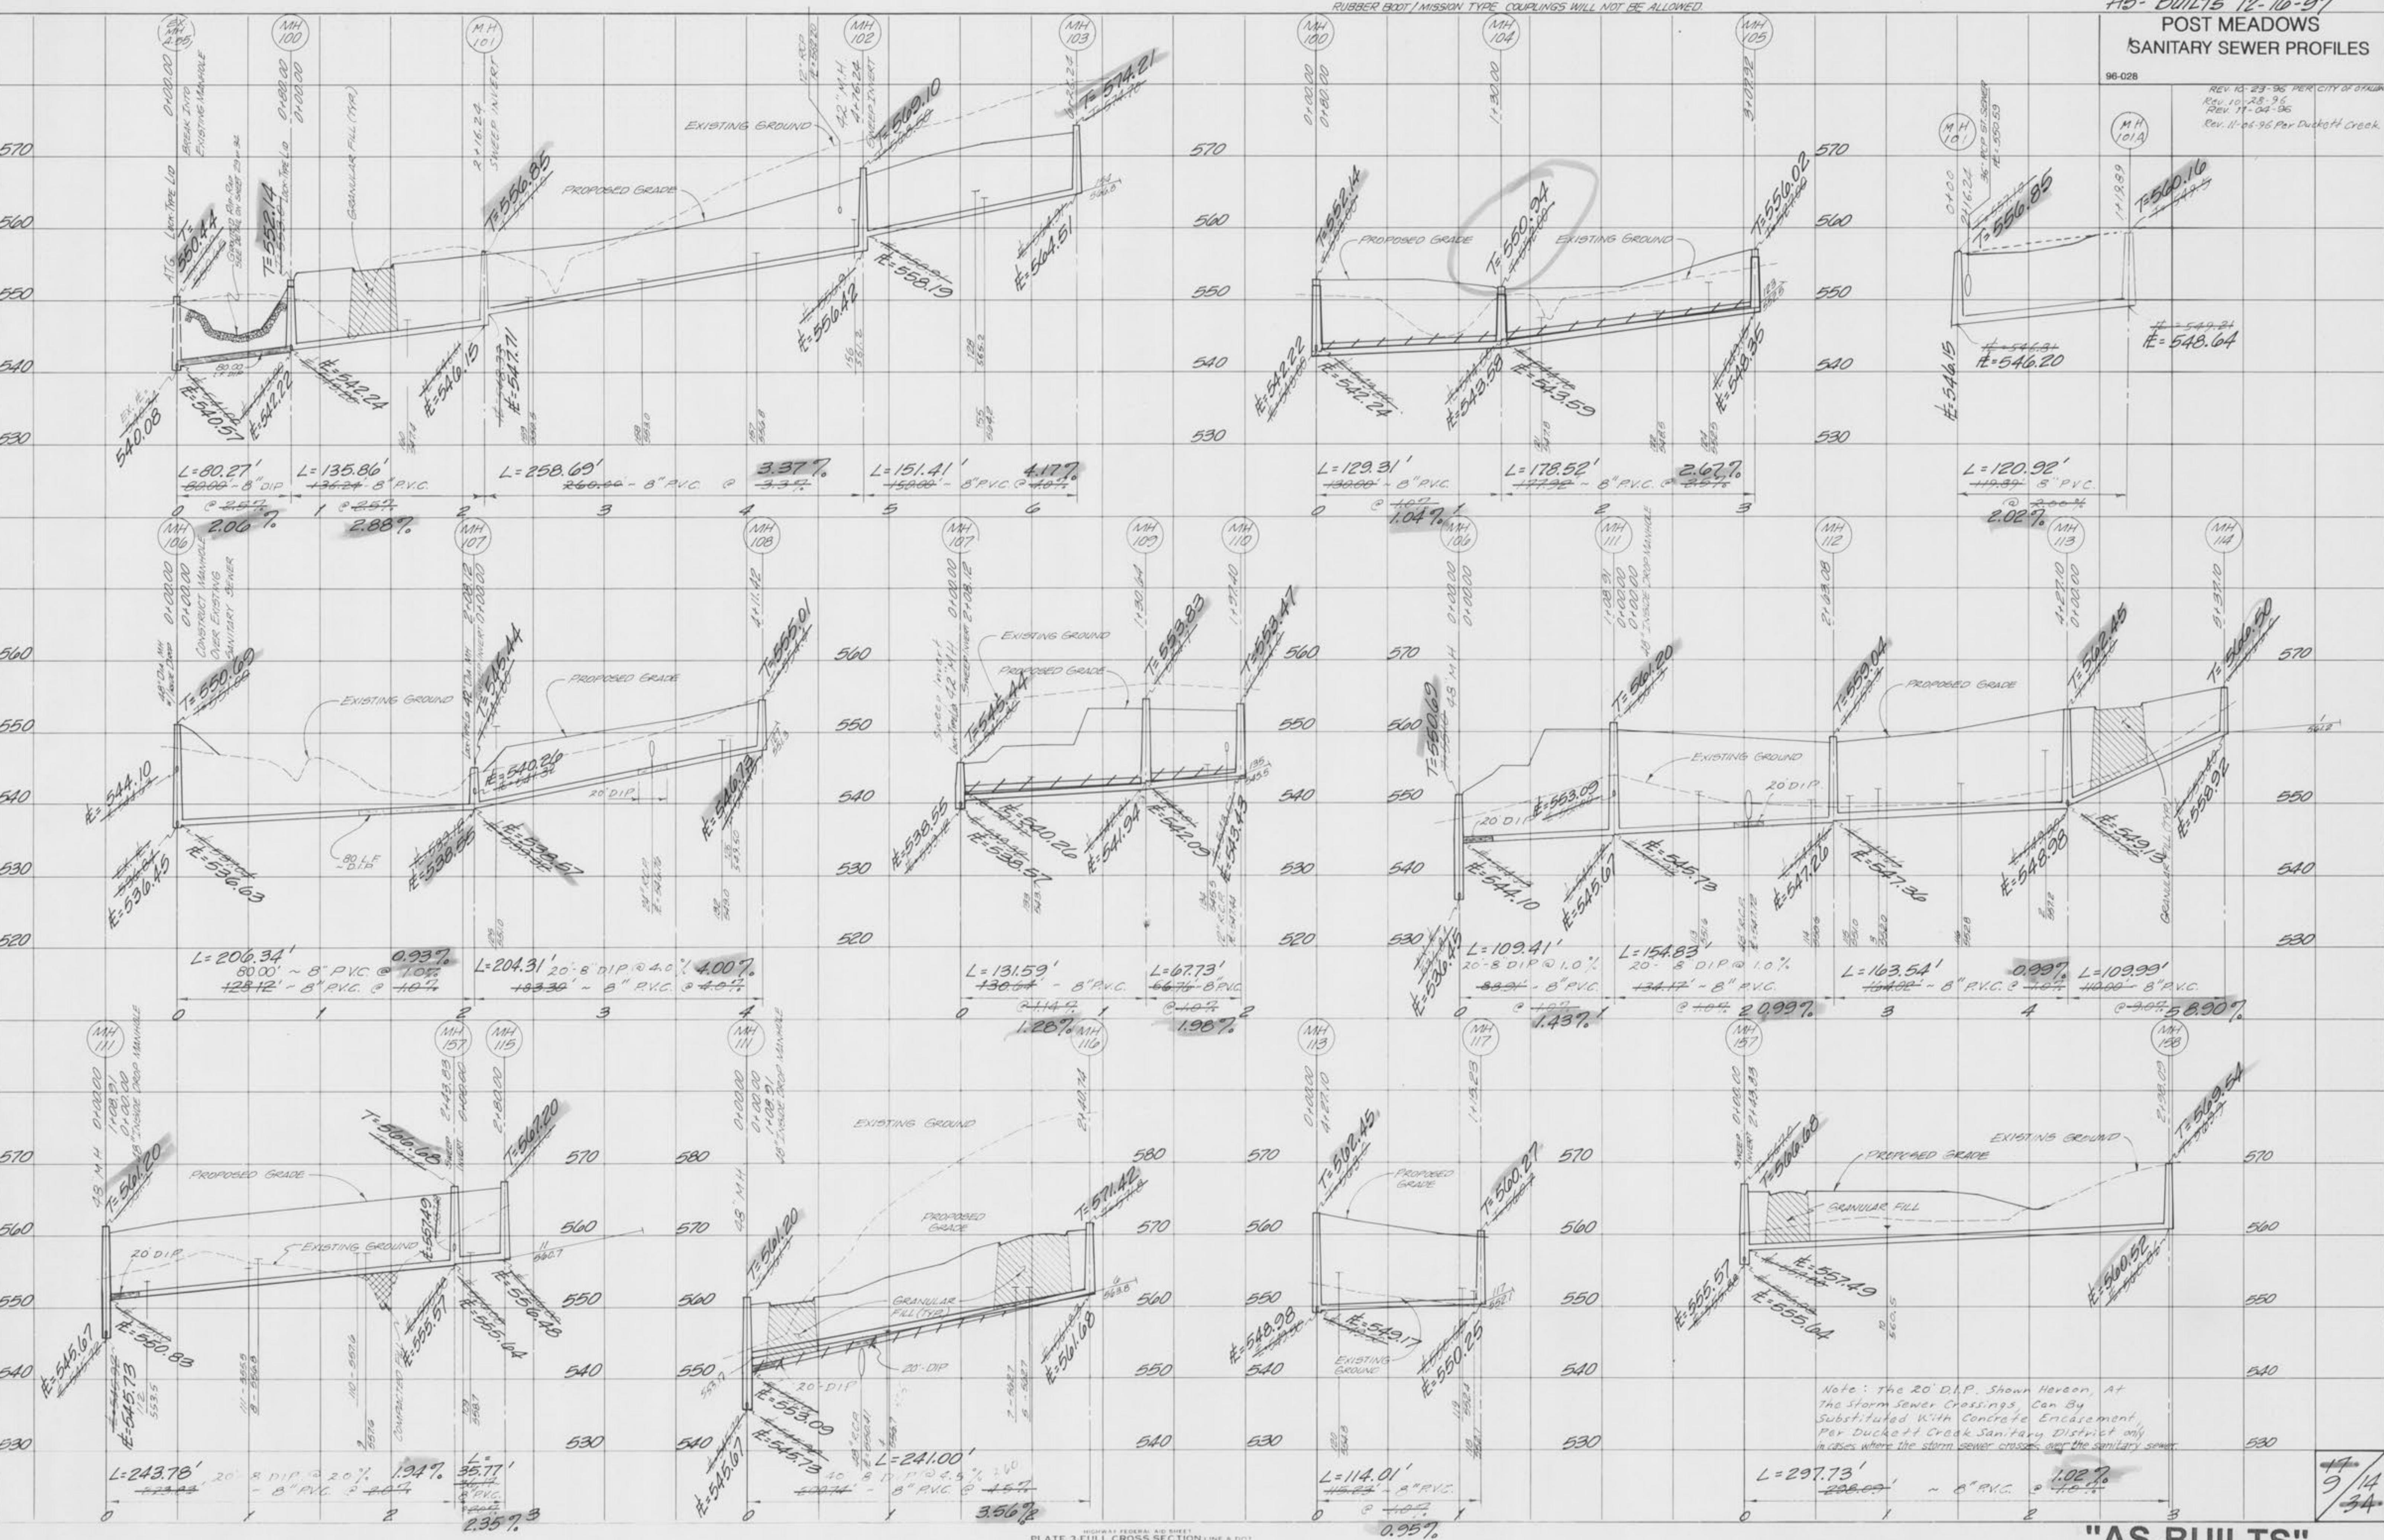

"AS-BUILTS"