
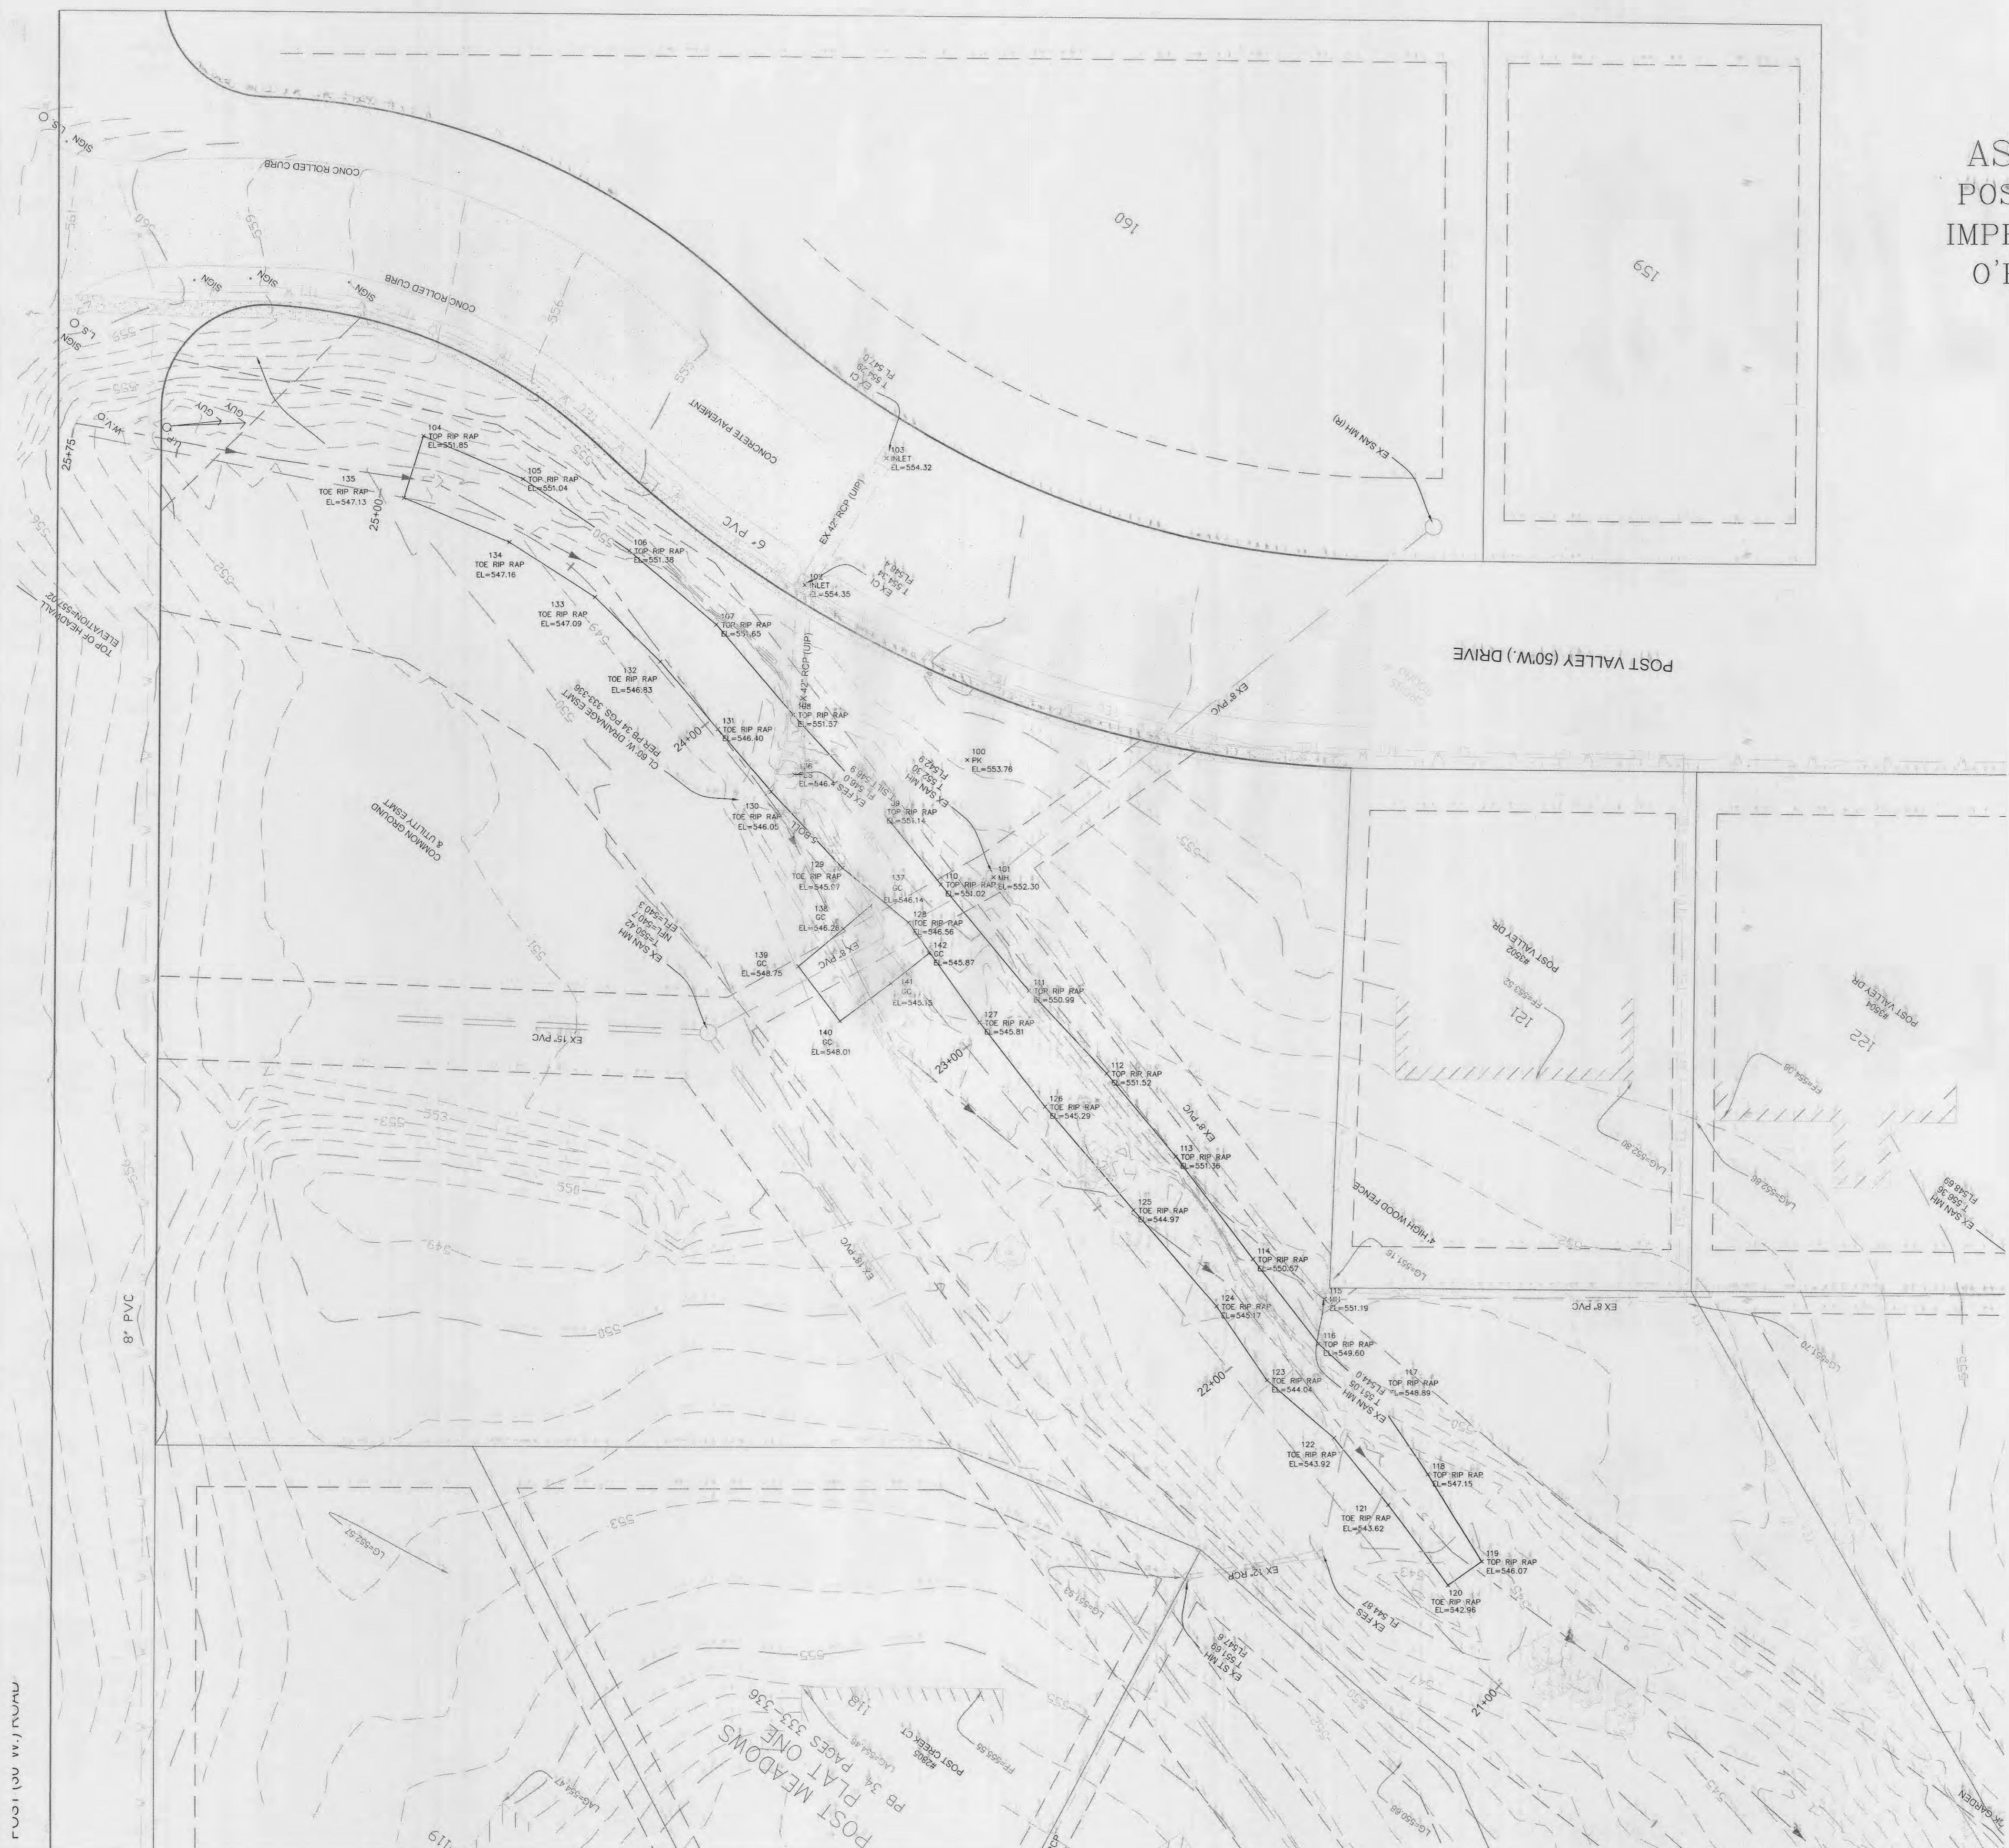


AS-BUILT SURVEY POST ROAD AS-BUILT IMPROVEMENT PROJECT O'FALLON, MISSOURI

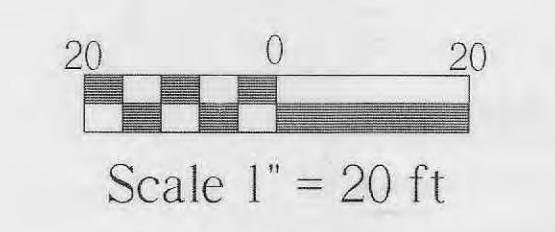

LEGEND	
ASPH	ASPHALT
BOLL	BOLLARD
CI	CURB INLET
CTV	CABLE TELEVISION BOX
DNA	DOES NOT AFFECT
FH	FIRE HYDRANT
FES	FLARED END SECTION
FH	FIRE HYDRANT
GI	GRATE INLET
GM	GAS METER
GR	GROUND
IP	IRON PIPE
IR	IRON ROD
LS	LIGHT STANDARD
MH	MANHOLE
N/P	NOT PLOTTABLE
PCB	PHONE CABLE BOX
R	RECORD
<R>	REPORTED
<S>	SEWER PIPE
SVV	SURVEY
T.C.	TITLE COMMITMENT
(typ)	TYPICAL
UP	UTILITY POLE
WHH	WATER MANHOLE
WM	WATER METER
WV	WATER VALVE
G	GAS MAIN MARKED
W	WATER MAIN MARKED
T	TELEPHONE LINE MARKED
P	POWER LINE/OVERHEAD
CONC	CONCRETE - AS-BUILT
EDGE	EDGE OF ASPHALT PAVEMENT

ROADWAY & SIDEWALK AS-BUILT
THE EXISTING IMPROVEMENTS AND LOCATIONS HAVE BEEN MEASURED. THE RESULTS OF THOSE MEASUREMENTS ARE SHOWN ON THIS SET OF FINAL MEASUREMENT PLANS.

METRON
Surveying & Layout Co.
313 WOOD STREET
O'FALLON, MO. 63366
PH: 314-432-5400 FAX: 636-294-5851

John E. Winkler Jr.
John E. Winkler Jr. PLS-2006016644
Order No. 7217 Date: 11-06-15



11-06-2015


AS-BUILT SURVEY			
For: CITY OF ST. O'FALLON ATTN: CHRIS CLERCX 100 NORTH MAIN STREET O'FALLON, MO. 63366 TEL 314-609-5704			
1.	11-06	CITY COMMENTS	JEW JAW
REV.	DATE	DESCRIPTION	BY CHK'D
	ORDER NO. 7217		
	DATE 10-06-15		
	DRAWN JEW		1 OF 5
	CHECKED BDG		

METRON
Surveying & Layout Co.
313 WOOD STREET
O'FALLON, MO. 63366
314-432-5400 FAX: 636-294-5851

ORDER NO. 7217
DRAWN BY JAW
CHECKED BY BDG
DATE 10-06-15



AS-BUILT SURVEY
 POST ROAD AS-BUILT
 IMPROVEMENT PROJECT
 O'FALLON, MISSOURI

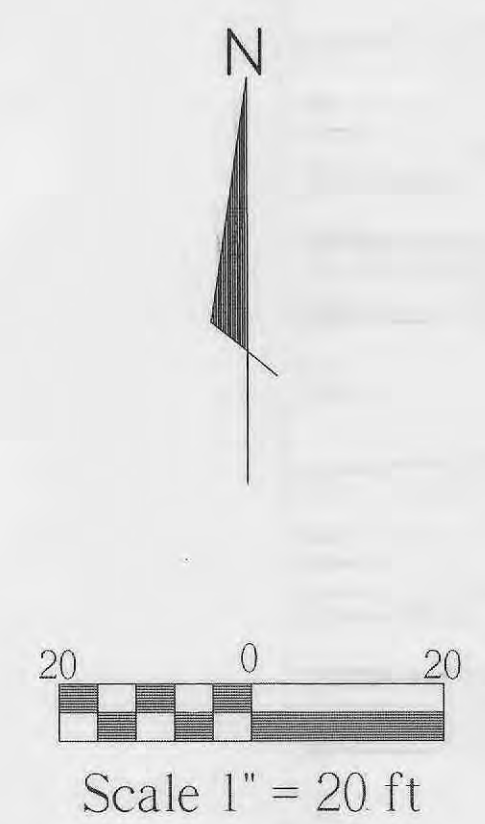

LEGEND	DENOTES	ASPH
ASPH	ASPHALT	ASPH
BOLL	BOLLARD	BOLL
CI	CURB INLET	CI
CTV	CABLE TELEVISION BOX	CTV
DNA	DOES NOT AFFECT	DNA
FH	FIRE HYDRANT	FH
FES	FLARED END SECTION	FES
FH	FIRE HYDRANT	FH
GI	GRATE INLET	GI
GM	GAS METER	GM
GR	GROUND	GR
IP	IRON PIPE	IP
IR	IRON ROD	IR
LS	LIGHT STANDARD	LS
MH	MANHOLE	MH
N/P	NOT PLOTTABLE	N/P
PCB	PHONE CABLE BOX	PCB
R	RECORD	R
CR	REPORTED	CR
CS	SEWER PIPE	CS
SVY	SURVEY	SVY
T.C.	TITLE COMMITMENT	T.C.
(typ)	TYPICAL	(typ)
UP	UTILITY POLE	UP
WMH	WATER MANHOLE	WMH
WM	WATER METER	WM
VV	WATER VALVE	VV
G	GAS MAIN MARKED	G
W	WATER MAIN MARKED	W
T	TELEPHONE LINE MARKED	T
P	POWER LINE(OVERHEAD)	P
CONC	CONCRETE - AS-BUILT	CONC
EDGE	EDGE OF ASPHALT PAVEMENT	EDGE

ROADWAY & SIDEWALK AS-BUILT
 THE EXISTING IMPROVEMENTS AND LOCATIONS HAVE BEEN MEASURED. THE RESULTS OF THESE MEASUREMENTS ARE SHOWN ON THIS SET OF FINAL MEASUREMENT PLANS.

METRON
 Surveying & Layout Co.
 313 WOOD STREET
 O'FALLON, MD, 63366
 PH: 314-432-5400 FAX: 636-294-5851

John E. Winkler Jr.
 John E. Winkler Jr. PLS-2006016644
 Order No. 7217 Date: 11-6-15



11-6-2015

AS-BUILT SURVEY					
For: CITY OF ST. O'FALLON ATTN: CHRIS CLERCX 100 NORTH MAIN STREET O'FALLON, MD. 63366 TEL 314-609-5704					
REV.	DATE	DESCRIPTION	BY	CHK'D	
	11-06	CITY COMMENTS	JEW	JAW	
	10-06-15	ORDER NO. 7217			2 OF 5
		DATE 10-06-15			
		DRAWN: JEW			
		CHECKED: BDG			

METRON
 Surveying & Layout Co.
 313 WOOD STREET
 O'FALLON, MD, 63366
 PH: 314-432-5400 FAX: 636-294-5851

AS-BUILT SURVEY POST ROAD AS-BUILT IMPROVEMENT PROJECT O'FALLON, MISSOURI



Scale 1" = 20 ft

LEGEND	DENOTES
ASPH	ASPHALT
BOLL	BOLLARD
CI	CURB INLET
CTV	CABLE TELEVISION BOX
DNA	DOES NOT AFFECT
FH	FIRE HYDRANT
FES	FLARED END SECTION
FH	FIRE HYDRANT
GI	GRATE INLET
GM	GAS METER
GR	GROUND
IP	IRON PIPE
IR	IRON ROD
LS	LIGHT STANDARD
MH	MANHOLE
N/P	NOT PLOTTABLE
PCB	PHONE CABLE BOX
R	RECORD
<R>	REPORTED
<S>	SEWER PIPE
SVY	SURVEY
T.C.	TITLE COMMITMENT
<typ>	TYPICAL
UP	UTILITY POLE
WMH	WATER MANHOLE
WM	WATER METER
WV	WATER VALVE
G	GAS MAIN MARKED
V	WATER MAIN MARKED
T	TELEPHONE LINE MARKED
P	POWER LINE(OVERHEAD)
CONCRETE	CONCRETE - AS-BUILT
EDGE OF ASPHALT	EDGE OF ASPHALT PAVEMENT

ROADWAY & SIDEWALK AS-BUILT

THE EXISTING IMPROVEMENTS AND LOCATIONS HAVE BEEN MEASURED. THE RESULTS OF THOSE MEASUREMENTS ARE SHOWN ON THIS SET OF FINAL MEASUREMENT PLANS.

METRON
Surveying & Layout Co.
313 WOOD STREET
O'FALLON, MD. 63366
PH 314-432-5400 FAX: 636-294-5851

John E. Winkler Jr.
John E. Winkler Jr. PLS-2006016644
Order No. 7217 Date: 11-6-15



AS-BUILT SURVEY		REV.	DATE	DESCRIPTION	BY	CHK'D
For: CITY OF ST. O'FALLON ATTN: CHRIS CLERCX 100 NORTH MAIN STREET O'FALLON, MD. 63366 TEL 314-609-5704		1.	11-06	CITY COMMENTS	JEW	JAW
METRON Surveying & Layout Co. 313 WOOD STREET O'FALLON, MD. 63366 314-432-5400 FAX: 636-294-5851		ORDER NO.	7217	DATE	10-06-15	DRAWN
		CHECKED	BDG			

DATE: 11-06-15
SCALE: 1"=20'
DRAWN: JEW
CHECKED: JAW

AS-BUILT SURVEY POST ROAD AS-BUILT IMPROVEMENT PROJECT O'FALLON, MISSOURI



20 0 20
Scale 1" = 20 ft

LEGEND	DEFINITIONS
ASPH	ASPHALT
BOLL	BOLLARD
CT	CURB INLET
CTV	CABLE TELEVISION BOX
DNA	DOES NOT AFFECT
FH	FIRE HYDRANT
FES	FLARED END SECTION
FH	FIRE HYDRANT
GI	GRATE INLET
GM	GAS METER
GR	GROUND
IP	IRON PIPE
IR	IRON ROD
LS	LIGHT STANDARD
MH	MANHOLE
N/P	NOT PLOTTABLE
PCB	PHONE CABLE BOX
R	RECORD
(R)	REPORTED
(S)	SEWER PIPE
SVY	SURVEY
T.C.	TITLE COMMITMENT
(typ)	TYPICAL
UP	UTILITY POLE
VMH	WATER MANHOLE
WM	WATER METER
VV	WATER VALVE
-G-	GAS MAIN MARKED
-W-	WATER MAIN MARKED
-T-	TELEPHONE LINE MARKED
-P-	POWER LINE(OVERHEAD)
CONCRETE	CONCRETE - AS-BUILT
	EDGE OF ASPHALT PAVEMENT

ROADWAY & SIDEWALK AS-BUILT

THE EXISTING IMPROVEMENTS AND LOCATIONS HAVE BEEN MEASURED. THE RESULTS OF THOSE MEASUREMENTS ARE SHOWN ON THIS SET OF FINAL MEASUREMENT PLANS.

METRON
Surveying & Layout Co.
313 WOOD STREET
O'FALLON, MD. 63366
PH: 314-432-5400 FAX: 636-294-5851

John E. Winkler Jr.
John E. Winkler Jr. PLS-2006016644
Order No. 7217 Date: 11-6-15





11-06-2015

AS-BUILT SURVEY				
For: CITY OF ST. O'FALLON ATTN: CHRIS CLERCX 100 NORTH MAIN STREET O'FALLON, MD. 63366 TEL 314-609-5704				
1.	11-06	CITY COMMENTS	JEW	JAW
REV.	DATE	DESCRIPTION	BY	CHK'D
		ORDER NO. 7217		
		DATE 10-06-15		
		DRAWN JEW		
		CHECKED BDG		
METRON Surveying & Layout Co. 313 WOOD STREET O'FALLON, MD. 63366 314-432-5400 FAX: 636-294-5851			4	5

ORDER NO. 7217
DRAWN: JEW
CHECKED: BDG
DATE: 10-06-15
PROJECT: POST ROAD AS-BUILT
DRAWN BY: JEW

AS-BUILT SURVEY POST ROAD AS-BUILT IMPROVEMENT PROJECT O'FALLON, MISSOURI

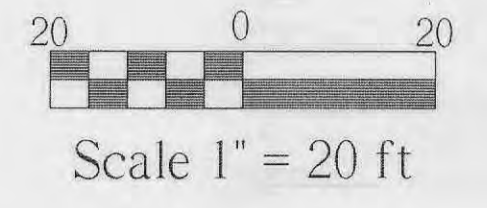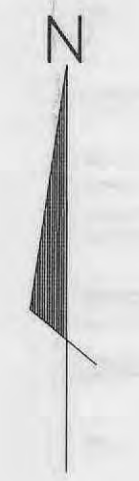


LEGEND	
ASPH	ASPHALT
BOLL	BOLLARD
CI	CURB INLET
CTV	CABLE TELEVISION BDX
DNA	DOES NOT AFFECT
FH	FIRE HYDRANT
FES	FLARED END SECTION
FH	FIRE HYDRANT
GI	GRATE INLET
GM	GAS METER
GRD	GROUND
IP	IRON PIPE
IR	IRON ROD
LS	LIGHT STANDARD
MH	MANHOLE
N/P	NOT PLOTTABLE
PCB	PHONE CABLE BDX
R	RECORD
(R)	REPORTED
(S)	SEWER PIPE
SVY	SURVEY
T.C.	TITLE COMMITMENT
(typ)	TYPICAL
UP	UTILITY POLE
WMH	WATER MANHOLE
WM	WATER METER
WV	WATER VALVE
-G-	GAS MAIN MARKED
-W-	WATER MAIN MARKED
-T-	TELEPHONE LINE MARKED
-P-	POWER LINE (OVERHEAD)
[Symbol]	CONCRETE - AS-BUILT
[Symbol]	EDGE OF ASPHALT PAVEMENT

ROADWAY & SIDEWALK AS-BUILT
THE EXISTING IMPROVEMENTS AND LOCATIONS HAVE BEEN MEASURED. THE RESULTS OF THOSE MEASUREMENTS ARE SHOWN ON THIS SET OF FINAL MEASUREMENT PLANS.

METRON
Surveying & Layout Co.
313 WOOD STREET
O'FALLON, MO. 63366
PH: 314-432-5400 FAX: 636-294-5851

John E. Winkler Jr.
John E. Winkler Jr. PLS-2006016644
Order No. 7217 Date: 11-15-15

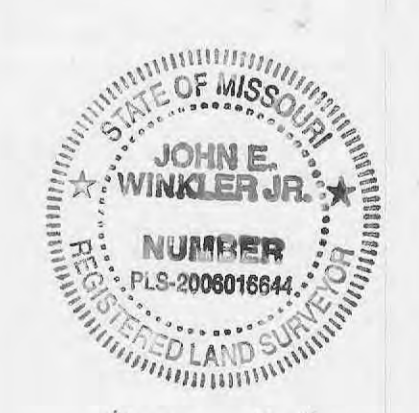

11-06-2015

AS-BUILT SURVEY				
For: CITY OF ST. O'FALLON ATTN: CHRIS CLERCX 100 NORTH MAIN STREET O'FALLON, MO. 63366 TEL 314-609-5704				
1	11-06	CITY COMMENTS	JEW	JAW
REV. DATE		DESCRIPTION	BY	CHK'D
ORDER NO. 7217				
DATE 10-06-15				
DRAWN JEW				
CHECKED BDG				

METRON
Surveying & Layout Co.
313 WOOD STREET
O'FALLON, MO. 63366
314-432-5400 FAX: 636-294-5851

5 OF 5

THESE PLANS, SPECIFICATIONS, AND CONTRACT DOCUMENTS SHALL BE KEPT ON FILE AT THE OFFICE OF THE SURVEYOR AND SHALL BE AVAILABLE FOR REVIEW BY THE PUBLIC AT ALL TIMES.