

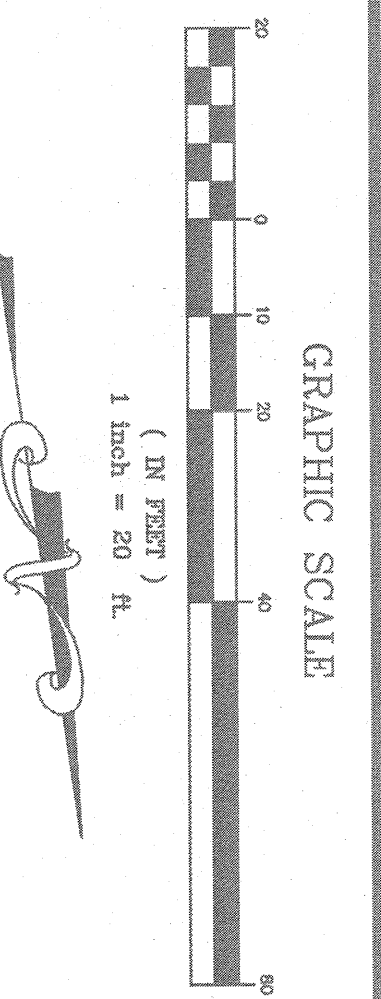


# POOL PARKING ASBUILT PLAN

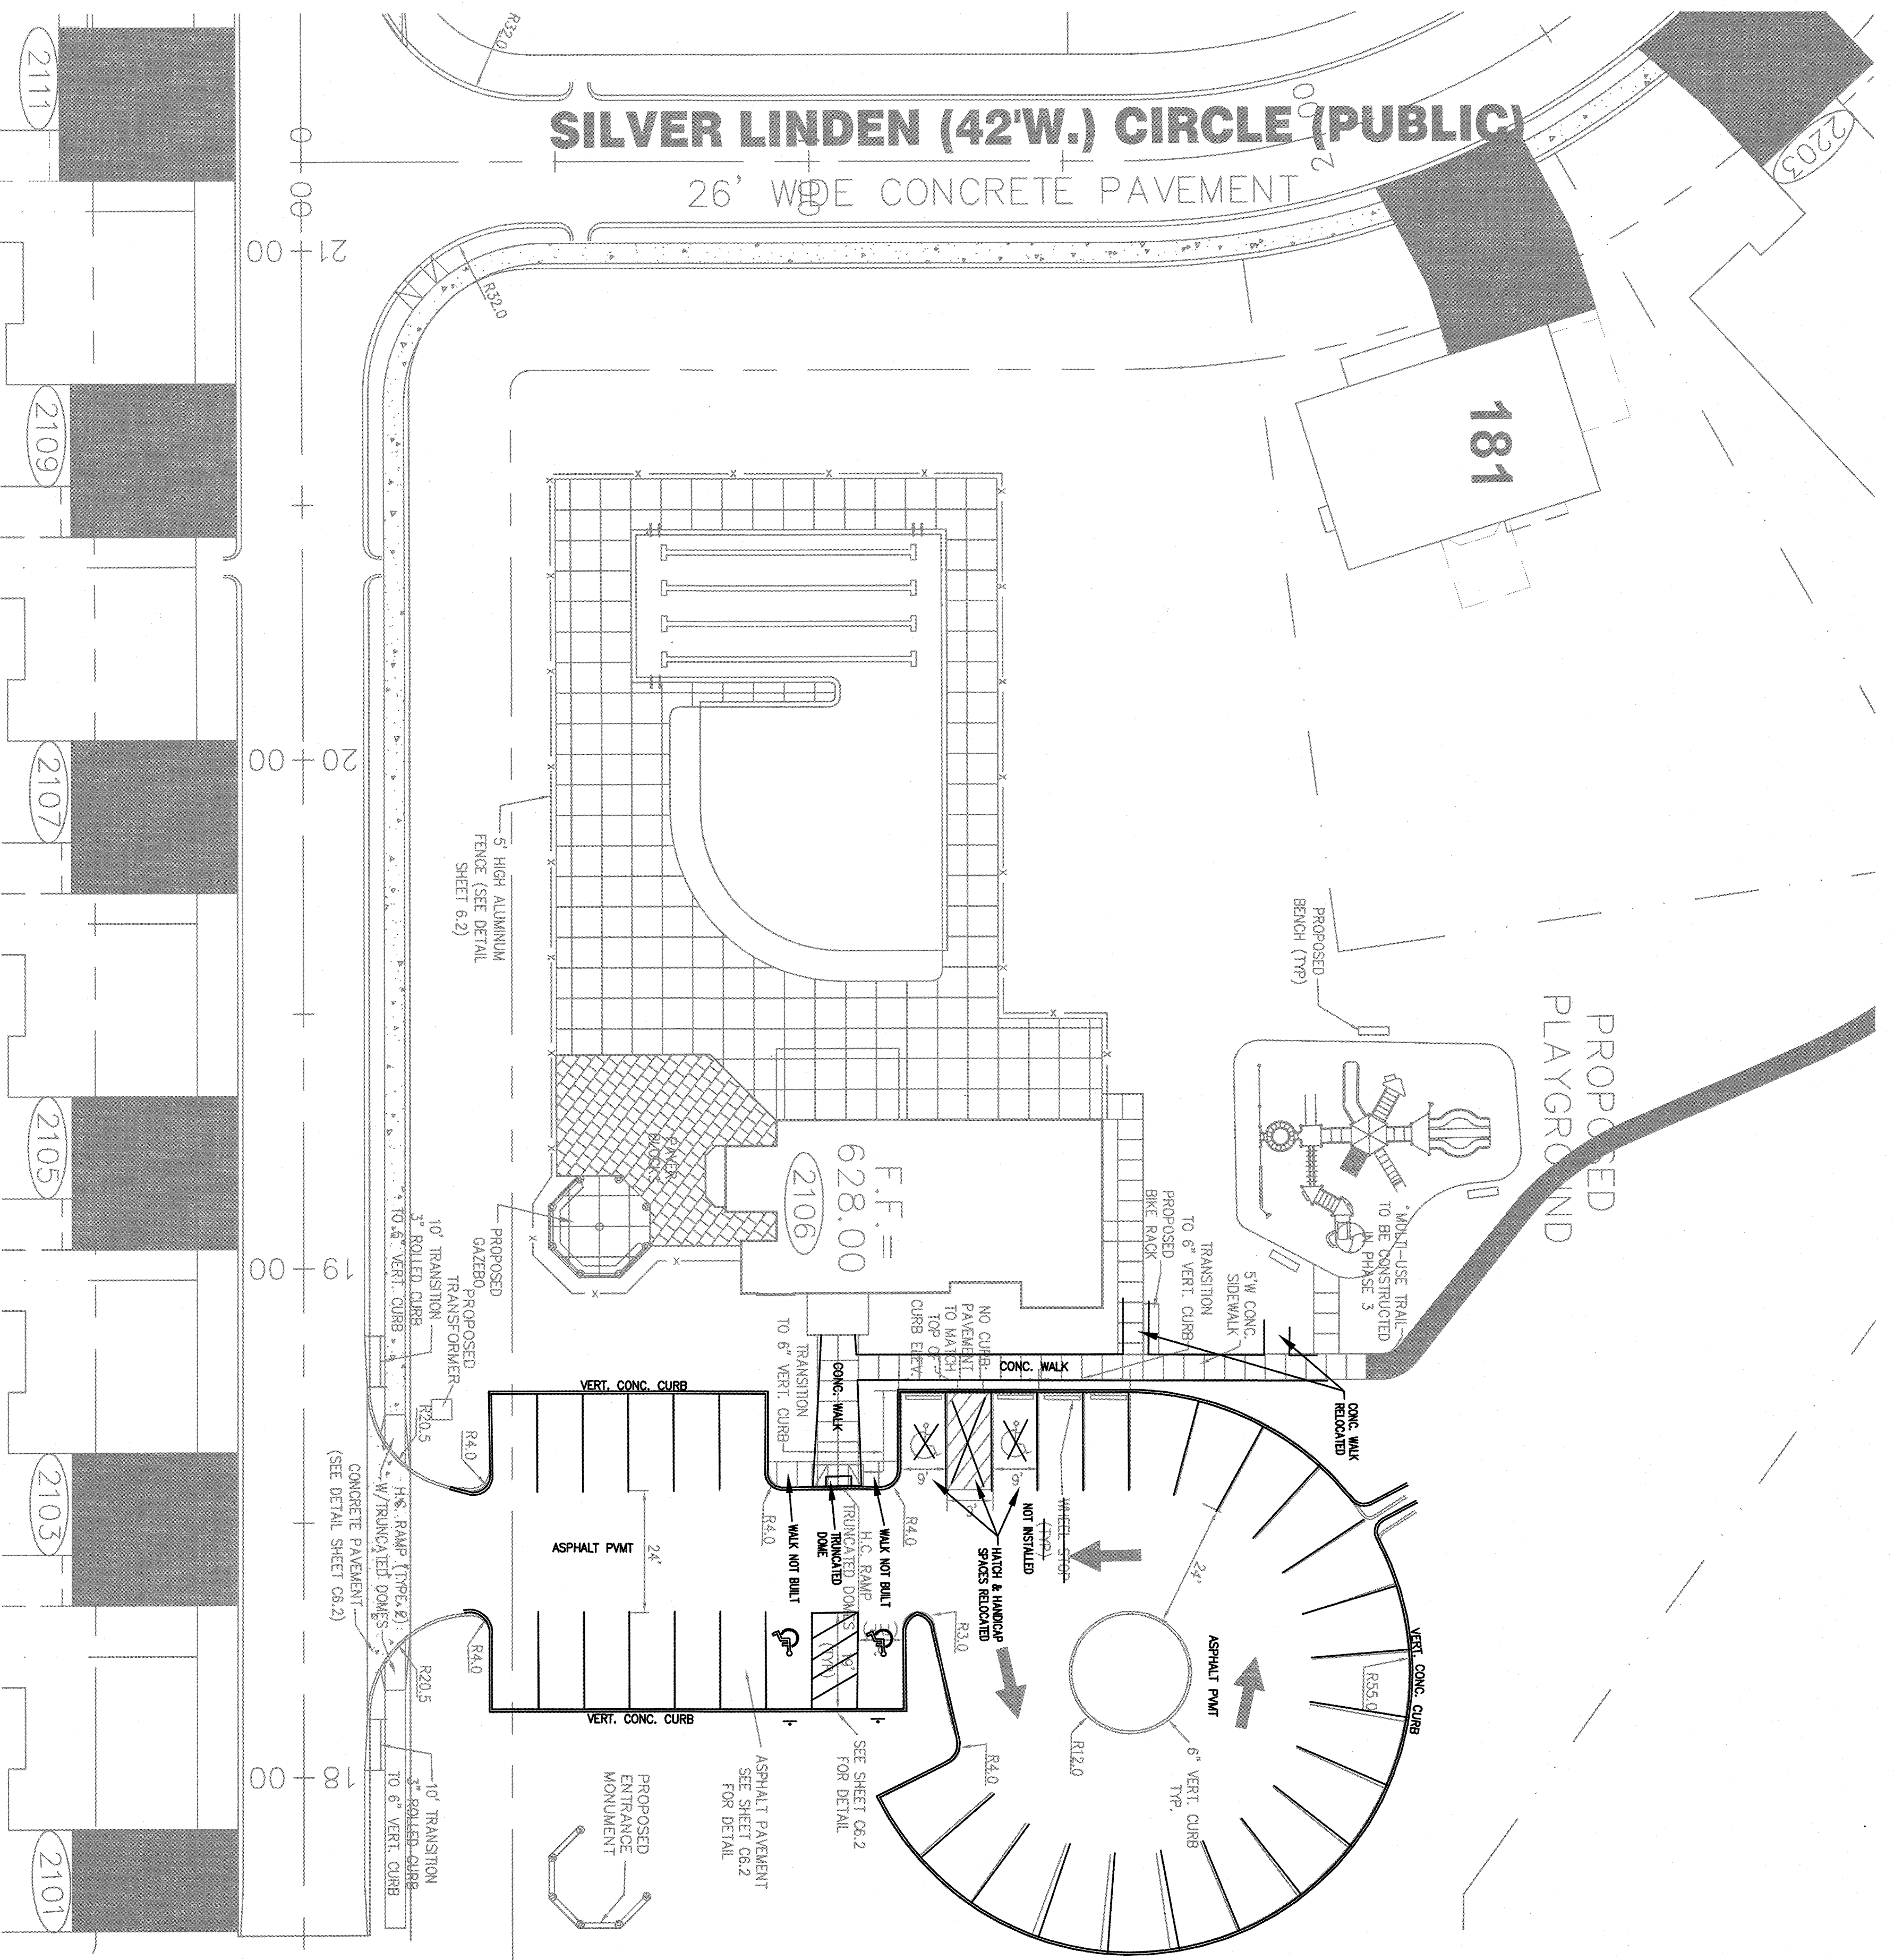

THE EXISTING EXTERIOR PARKING CURB, WALK, AND PARKING SPACES HAVE BEEN MEASURED AND THE RESULTS OF THOSE MEASUREMENTS ARE ON THIS SET OF FINAL MEASUREMENT PLANS AS OF APRIL 26, 2018.  
 COLE & ASSOCIATES INC. L.S. 268-D  
 PROJECT NO. 07-041 (CURB, WALK & PARKING SPACES ONLY)

The Professional, whose signature and personal seal appear hereon, assumes responsibility only for what appears on this page and disclaims (pursuant to Section 327, 411 (RSMO)) any responsibility for all other plans, specifications, estimates, reports, or other documents or instruments not sealed by the undersigned professional relating to, or intended to be used for, any part or parts of the project to which this page refers.

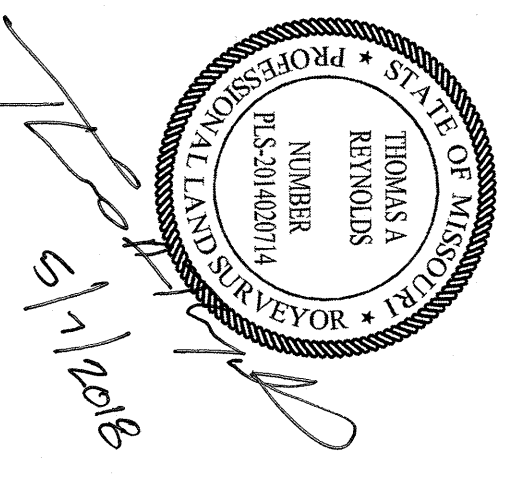

**PRESTON WOODS - PHASE II**  
 POOL PLANS  
 RHODES LANE  
 ST. CHARLES, MO. 63366  
**POOL SITE PLAN**

DEVELOPER/OWNER:  
**THE JONES COMPANY HOMES, L.L.C.**  
 16640 CHESTERFIELD GROVE, SUITE 200  
 CHESTERFIELD, MO 63005  
 PHONE: (636) 537-7192

REVISIONS	
DATE	DESC.
10/30/07	▲ CITY/JONES COMMENTS
11/27/07	▲ CITY COMMENTS
1/17/08	▲ OWNER COMMENTS/PARKING LAYOUT
2/5/08	▲ CITY COMMENTS

planning • engineering • surveying • landscape architecture

**Cole and ASSOCIATES**  
 INCORPORATED

10777 sunset office dr.  
 saint louis, missouri 63127  
 p: 314 984 9887 f: 314 984 0587

DESIGNED BY JKW  
 DRAWN BY CTM  
 CHECKED BY TAR  
 DATE 9/27/07 4/26/18  
 Job Number 07-0041  
 Sheet Number C3.0