


RIDGETOP ESTATES

GENERAL NOTES

- 1) Underground utilities have been plotted from available information and therefore their locations shall be considered approximate only. The verification of the location of all underground utilities, either shown or not shown on these plans, shall be the responsibility of the contractor, and shall be located prior to any grading and/or construction of improvements.
- 2) All Standard Curb Inlets to have front of inlet 2' (two feet) behind curb, within public right-of-way, unless otherwise noted.
- 3) Storm sewers 18" diameter and smaller shall be A.S.T.M. C-14 unless otherwise shown on the plans.
- 4) Storm sewers 21" diameter and larger shall be A.S.T.M. C-76, Class II minimum, unless otherwise shown on the plans.
- 5) All storm sewer pipe in the right-of-way shall be Reinforced Concrete Pipe (A.S.T.M. C-76, Class II minimum).
- 6) Corrugated Metal Pipe shall conform to the standard specifications for corrugated culvert pipe AASHO, M-36, aluminumized or asphalt polymer coated.
- 7) 8" P.V.C. Sanitary Sewer Pipe shall meet the following standards: A.S.T.M. D-3034 SDR35, with wall thickness compression joint A.S.T.M. D-3212. An appropriate rubber seal waterstop as approved by the sewer district shall be installed between P.V.C. pipe and masonry structures.
- 8) All filled places, including under paved areas, under buildings, under proposed storm and sanitary sewer lines and/or paved areas, shall be compacted to 90% of maximum density as determined by the "Modified AASHTO T-180 Compaction Test", (A.S.T.M. D1557), test verified by a soils engineer.
- 9) All trench backfills under paved areas shall be granular backfill, and water jetted. All other trench backfills may be earth material (free of large clods or stones) and shall be water jetted.
- 10) No slope shall be steeper than 3:1. All slopes shall be seeded and mulched.
- 11) Barricades will be constructed per the standard specifications as shown in the "Manual of Uniform Traffic Control Devices". End or roadway markers shall be mounted 4 feet above the pavement on two pound "U" channel sign posts. Each marker shall consist of an 18" diamond panel with red reflectors.
- 12) All construction and materials used shall conform to current City of O'Fallon Standards and Specifications.
- 13) Easements shall be provided for storm sewers, sanitary sewers, and all utilities on the record plat. See record plat for location, size and width of easements.
- 14) All water line construction shall conform to current St. Charles County Water District No. 2 standards and specifications.
- 15) All sanitary sewer construction shall conform to current Duckett Creek Sewer District standards and specifications.
- 16) The length of the concrete **encasement** around the P.V.C. sanitary sewers and the concrete storm sewers shall extend at least 5' into undisturbed soil to bridge the pipe across the trench backfill. Reinforcing steel shall be placed in the concrete **encasement** for tensile strength.
- 17) Erosion control shall not be limited to what is shown on the plan. The contractor shall take whatever means necessary to prevent siltation and erosion from entering adjacent roadways, properties and ditches. Such control might include channeling runoff into sediment basins, channeling runoff into areas where an extra row of straw bales are used. A slit fence might be considered if necessary.
- 18) All construction and materials conform to O'Fallon Fire Protection District Standards.
- 19) The minimum vertical distance from the low point of the basement to the flowline of the sanitary sewer at the corresponding house connection shall not be less than two and one half feet ($2\frac{1}{2}$) plus the diameter of the sanitary sewer.
- 20) The most stringent of the above requirements shall apply.
- 21) All streets and right-of-ways shown on these improvement plans will be dedicated to the City of O'Fallon for public use forever.
- 22) When grading operations are completed or suspended for more than 30 days, permanent grass must be established at sufficient density to provide erosion control on the site. Between permanent grass seeding periods, temporary cover shall be provided according to the City of O'Fallon Specifications.
- 23) The contractor shall place all fire hydrants within 2-3 feet of the street curb per ordinance No. 20.
- 24) The contractor shall place the "steamer" outlet of the fire hydrant towards the street.
- 25) All sanitary sewer manholes shall be waterproofed on the exterior in accordance with Mo.D.N.R. specification 10CSR-6.120 (7) (E).

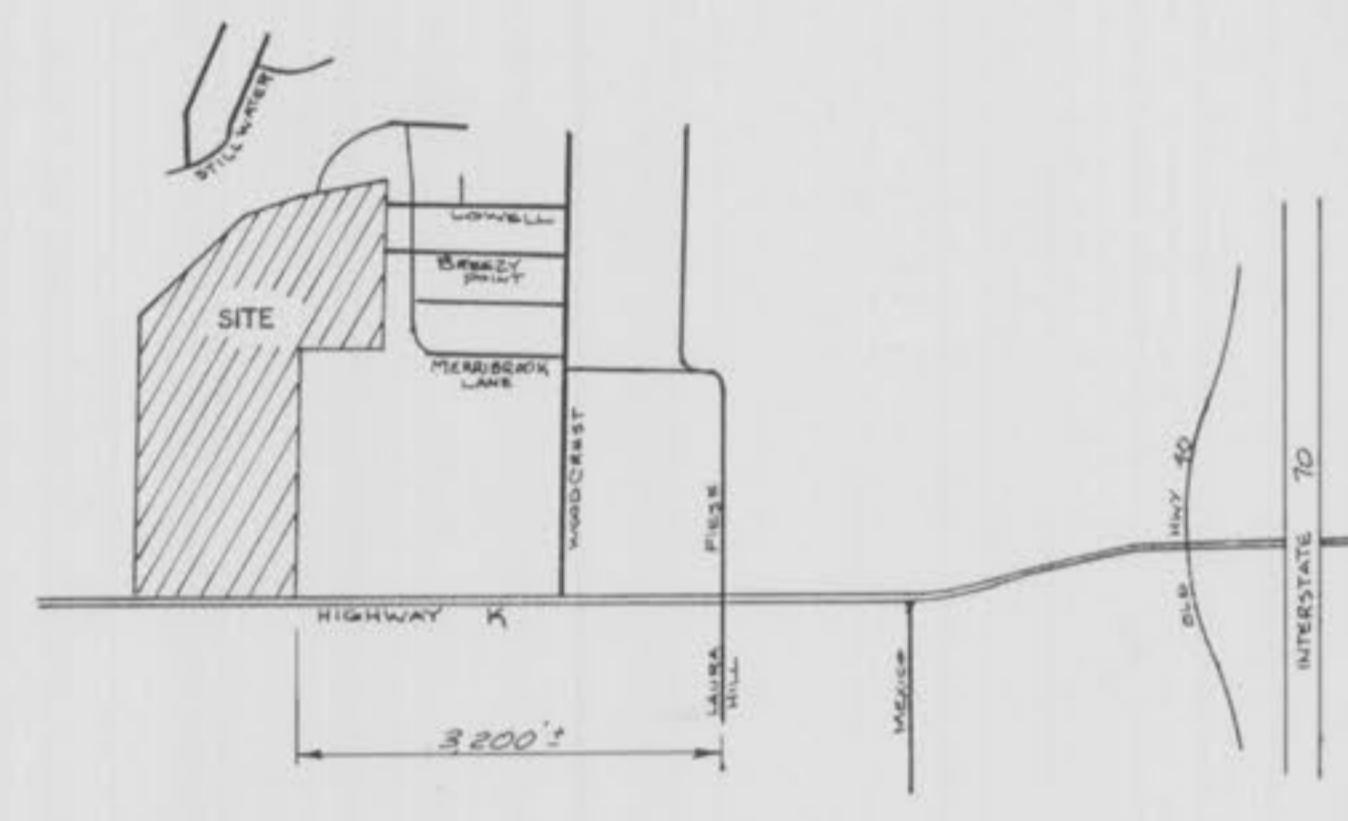

LOCATION MAP

N. T. S.

LEGEND

BUILDING LINE	
EXISTING SANITARY SEWER	
PROPOSED SANITARY SEWER	
EXISTING STORM SEWER	
PROPOSED STORM SEWER	
EXISTING CONTOUR	
PROPOSED CONTOUR	
EXISTING WOOD AREA	
SILTATION CONTROL	
CREEK OR DITCH	
FLOWLINE	
GAS MAIN	
TELEPHONE CABLE	
WATER MAIN	
UNDERGROUND ELECTRIC	
OVERHEAD ELECTRIC	
STREET SIGN	
GENERAL SURFACE DRAINAGE	
LIGHT STANDARD	
CLEARING AND GRADING LIMITS	
STORM SEWER DESIGNATOR	
SANITARY MANHOLE DESIGNATOR	

INDEX

COVER SHEET	1
FLAT PLANS	2, 3 & 4
GRADING PLAN	5, 6 & 7
STREET PROFILES	8, 9 & 10
SANITARY SEWER PROFILES	11, 12, 13 & 14
STORM SEWER PROFILES	14, 15 & 16
DRAINAGE AREA MAPS	17, 18 & 19
CREEK SECTIONS	20
FOR CLOTHING DRAWDOWN	21
PAVING DETAILS	22 & 23
CONSTRUCTION DETAILS	24, 25, 26 & 27
WATER MAIN DETAILS	28

PREPARED FOR:
(RECORD OWNER)
WILLIAM ERKER
II S. MERAMEC SUITE 1002
ST. LOUIS, MO. 63105
(314) 863-6061

Development Notes:

- 1) Area of Tract = 64 Acres
- 2) Present Zoning = R-1 PUD & R-4
- 3) Proposed Use = Single Family Residential
- 4) Total Lots Proposed = 172
- 5) Minimum Lot Area = 7,500 sq. ft.
- 6) Site is located in or is served by:
St. Charles County Public Water District No. 2
Duckett Creek Sewer District
Contel Telephone Co.
Union Electric Co.
St. Charles Gas Co.
O'Fallon Fire Protection District
Fort Zumwalt School District

26. The Duckett Creek Sewer District shall be notified at least 48 hours prior to construction of sanitary sewers for coordination and inspection.
27. All storm and sanitary trench backfills will be water jetted. Granular backfill will be used under pavement areas.
28. Easements shall be provided for storm sewers, sanitary sewers and all utilities on the record plat. See record plat for location and size of easements. This does not apply to house laterals.
29. All PVC sanitary sewer pipe is to be SDR-35 or equal with "clean" 1/2" to 1" granular stone bedding uniformly graded. This bedding shall extend from 4" below the pipe to springline of pipe. Immediate backfill over pipe shall consist of same size "clean" or minus stone from springline of pipe to 6" above the top of pipe.
30. All pipes shall have positive drainage through manholes. No flat base structures are allowed.
31. Brick shall not be used on manholes.

BENCHMARK:
RM - 51 Chiseled square on center of the south headwall of culvert for Tributary B under County Highway N, 0.33 mile east of intersection with County Highway K.
Elevation = 487.13

ENGINEERS AUTHENTICATION

The responsibility for professional engineering liability on this project is hereby limited to the set of plans authenticated by the seal, signature and date hereunder attached. Responsibility is disclaimed for all other engineering plans involved in the project and specifically excludes revisions after this date unless reauthenticated.

St. Charles Consultants



Michael Newell Meiners 11-28-91
MICHAEL NEWELL MEINERS
MISSOURI PROFESSIONAL ENGINEER
NUMBER E-22483

Revised

Plat 3 per D.C. Sewer 3/9/94 San, Storm & Water As-Built-Plat 1,283 8/23/94

Revised 9-20-91 11-19-91, 12-31-91, 2-5-92, 2-26-92, 3-4-92, 6-8-93 Sheet 1 of 28

Order No. 91-355

S/C ST. CHARLES ENGINEERING & SURVEYING

E/S 801 South Fifth Street, Suite 202

St. Charles, Missouri 63301

Off. 947-0607, Fax 947-2448

Date

8-5-91

RidgeTop Estates As-Built-Plat 1,283 8/23/94

St. Charles, Missouri

FLAT PLAN

RIDGETOP ESTATES

SEPT. 20, 1991

91 - 355

Rev. 12-31-91 Rev. 12-14-93 Added Plot 2

As Built's - Plat 1 & 2 Aug. 5, 1994


Plat 3 & 4 Aug. 29, 1994

NOTE: SANITARY & STORM
SEWER AS-BUILT AS
SHOWN ON PROFILES.

N



SCALE-1"=50'

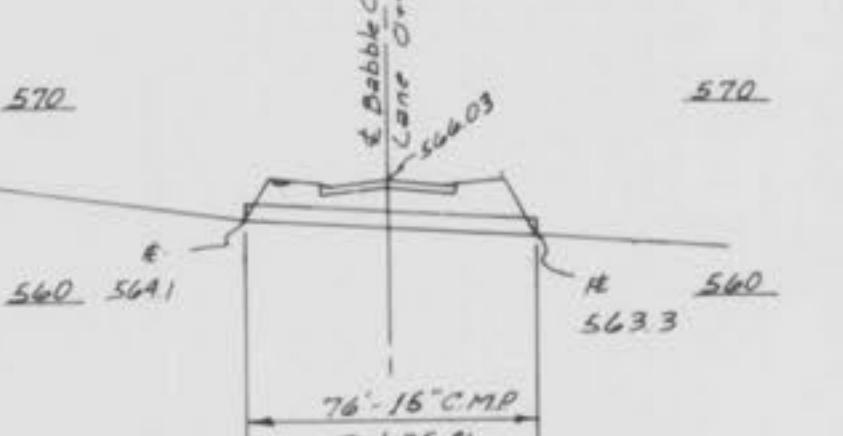


CULVERT AT HWY K

Pipe Capacity Per Manning's Eq.:

$$1486 \text{ ft}^3/\text{s} = Q$$

$$1486 \cdot 0.024 (785)(.597)(.1025) = 1.98 \text{ ft}^3/\text{s}$$

Demand $Q = 0.54 \text{ ft}^3/\text{s}$

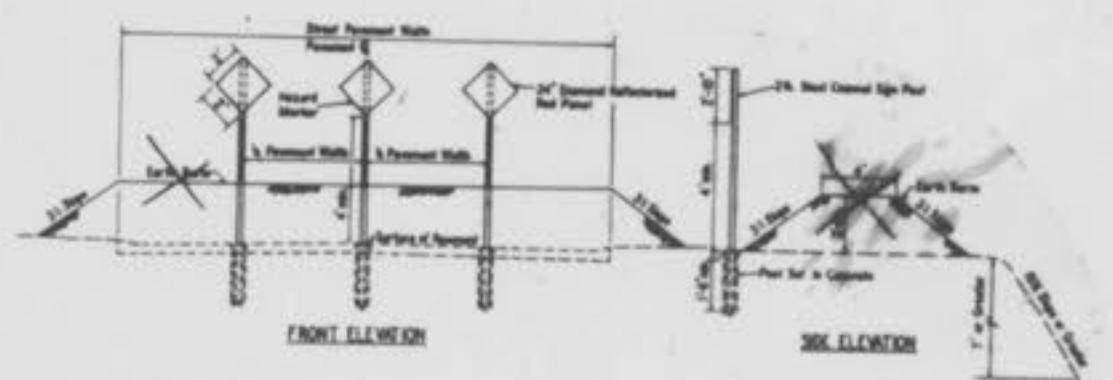

NOTES ON ABANDONMENT OF EXISTING SEWER (MH's G-H)

- 1) Field inspect MH "G", make sure no other connections exist.
- 2) Remove or break down in place MH "G".
- 3) Bulkhead/plug and cut existing PVC pipes @ MH "H" & 141 to abandon subject pipe.
- 4) Dardenne Elementary School sanitary sewer service shall not be interrupted.
- 5) Restoration of school property to be completed as soon as possible and is required prior to initial construction escrow release.
- 6) Lateral connections to existing sanitary sewer main require D.C.S.D. inspection. 24 hour advance notification required (441-1244)

Legend:
A.B. = As Built

Underground utilities have been plotted from available information and therefore their locations shall be considered approximate only. The verification of the location of all underground utilities, either shown or not shown on these plans, shall be the responsibility of the contractor, and shall be located prior to any grading and/or construction of improvements.

Revised 6/1/93 (MHTD)

Sheet 2 of 28

S C ST. CHARLES ENGINEERING & SURVEYING
801 South Fifth Street, Suite 202
St. Charles, Missouri 63301
Off. 947-0607, Fax 947-2448
E S

Order No.

Date

RidgeTop Estates


As-Built

Sheet 2 of 28





SCALE-1"=50'

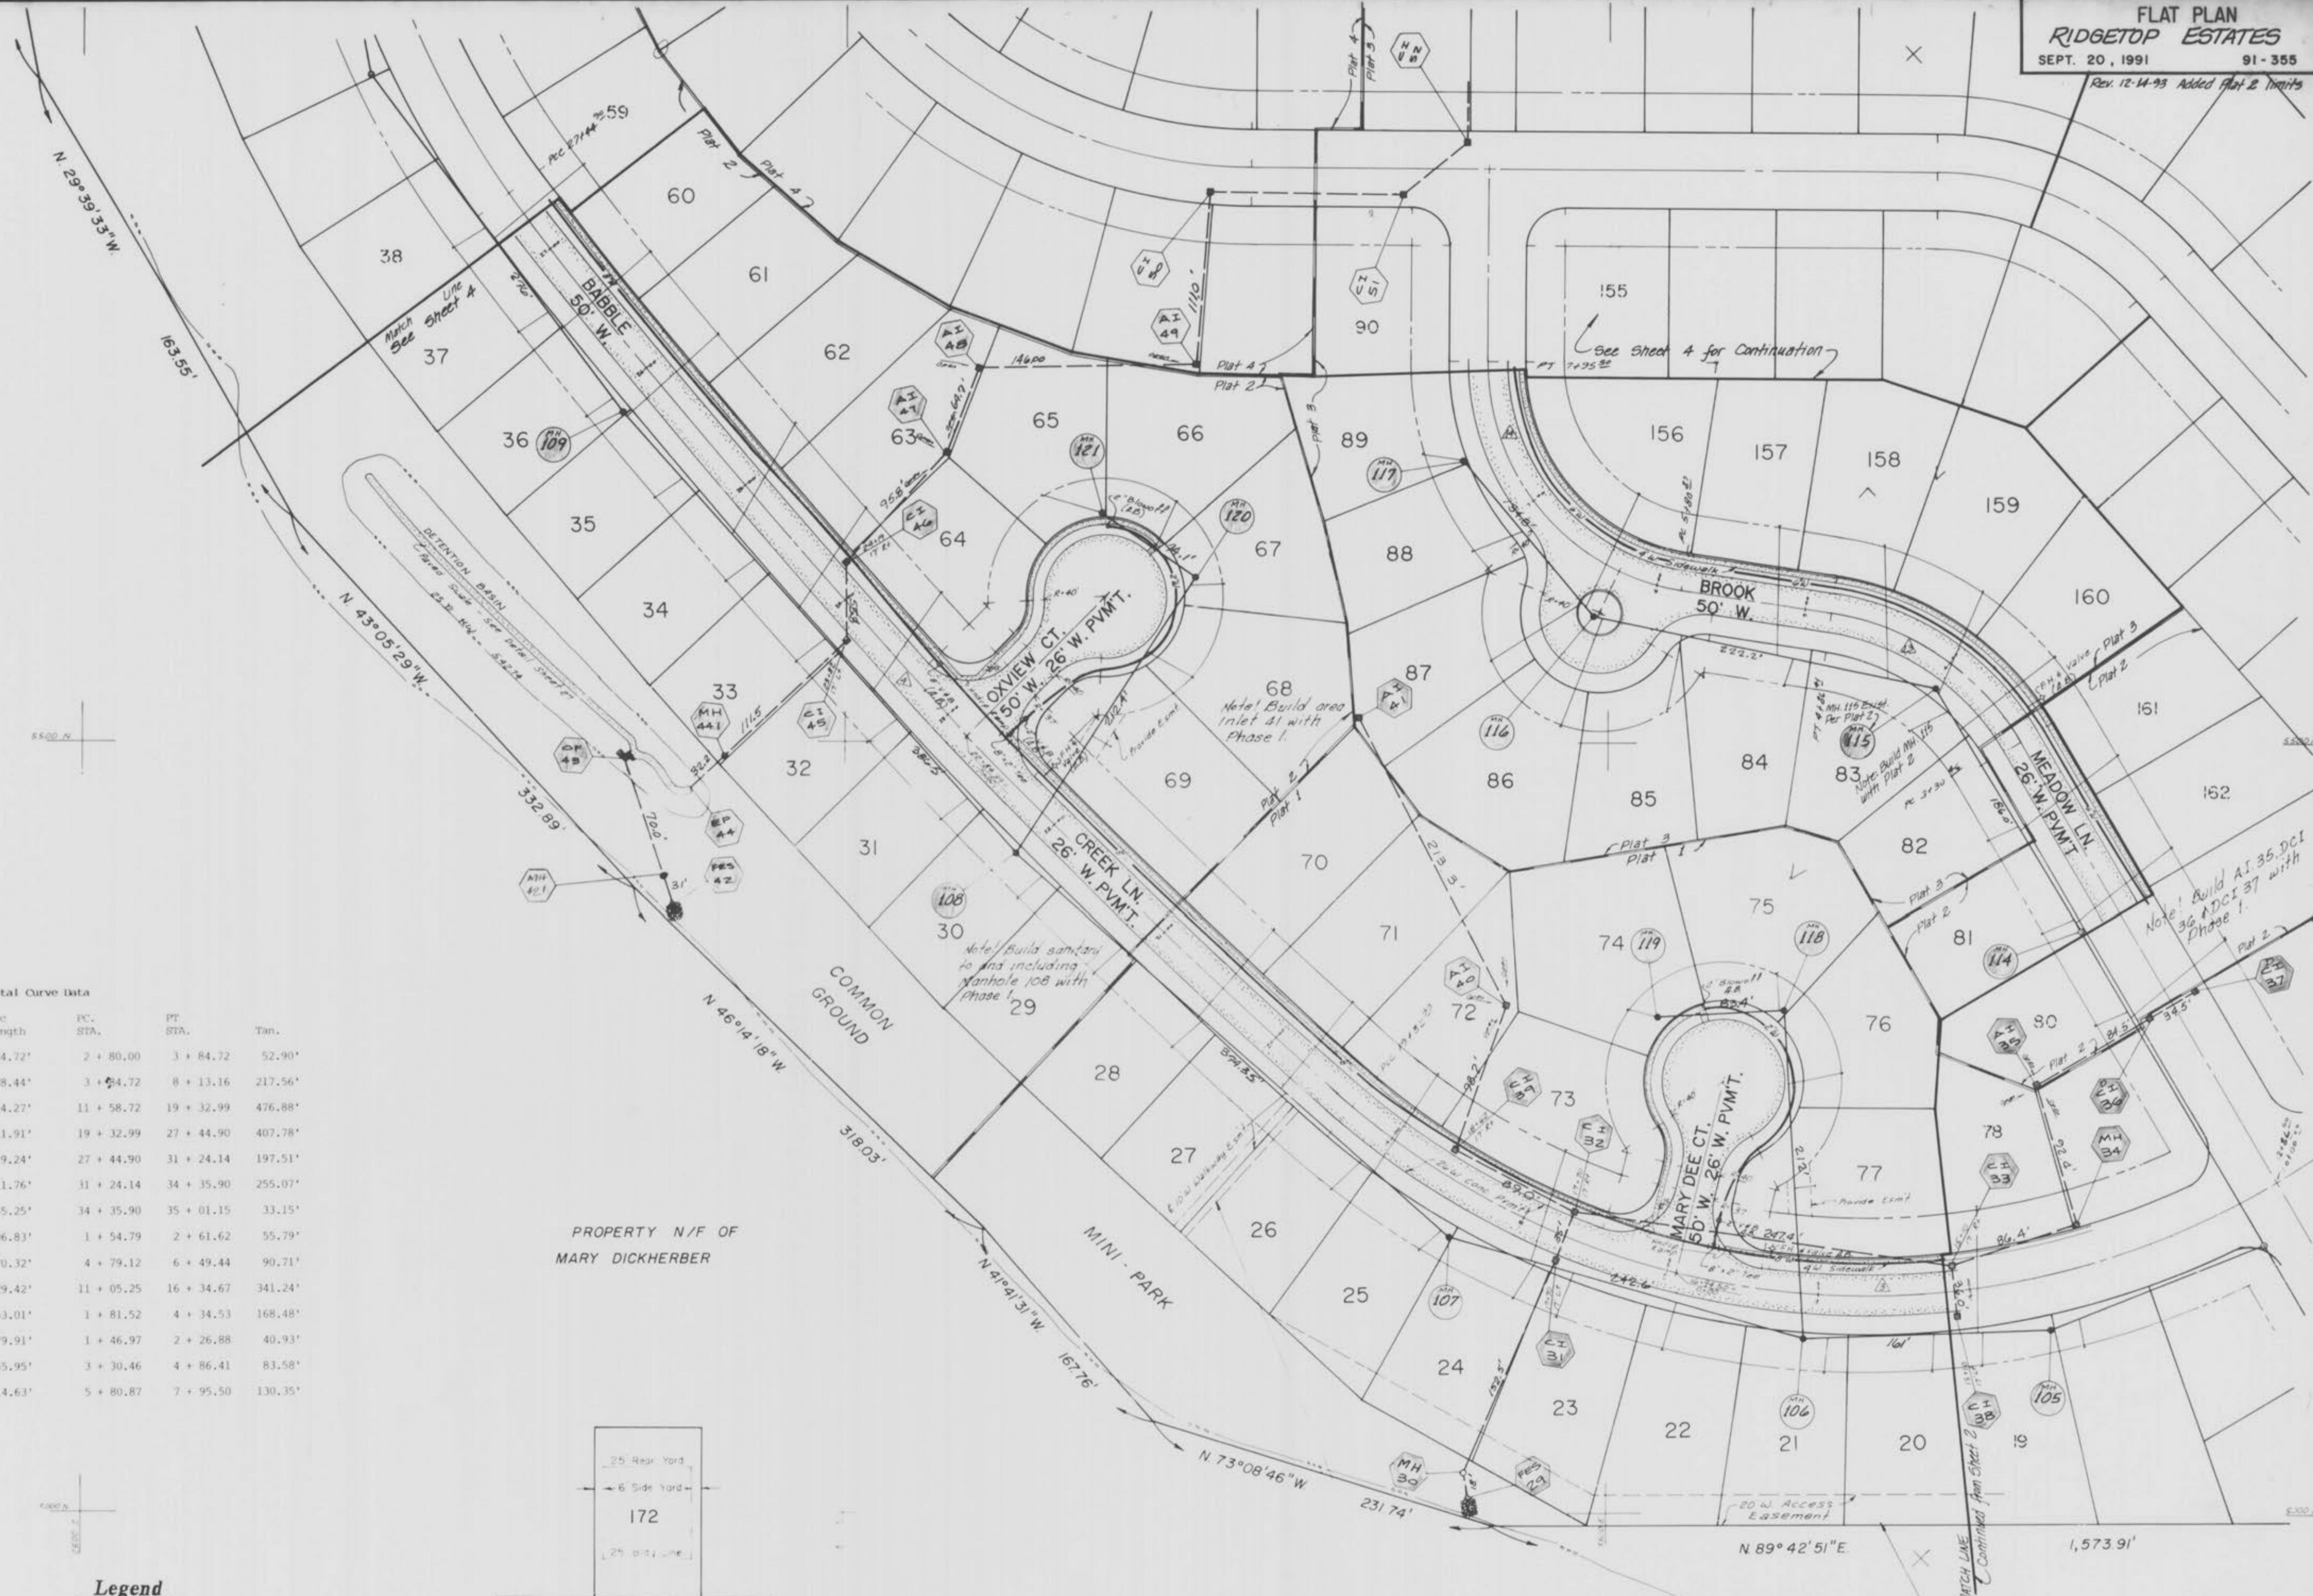

Legend

A.B. = As Built

NOTE: SANITARY & STORM
SEWER AS-BUILT AS
SHOWN ON PROFILES.

R.O.W.

TYPICAL LOT

Underground utilities have been plotted from available information and therefore their locations shall be considered approximate only. The verification of the location of all underground utilities, either shown or not shown on these plans, shall be the responsibility of the contractor, and shall be located prior to any grading and/or construction of improvements.

Revised

S/C
E/S

ST. CHARLES ENGINEERING & SURVEYING
801 South Fifth Street, Suite 202
St. Charles, Missouri 63301
Off. 947-0607, Fax 947-2448

Sheet 3 of 28

Order No.

Date

RidgeTop Estates Ridgetop Estates
As-Built's

FLAT PLAN
RIDGETOP ESTATES

SEPT. 20, 1991

91-355

Rev. 1-30-92
Rev. 12-14-93 Added Plat 2 limits

As Built's - Plat 1 & 2
Aug 5, 1994
Plats 3 & 4 Aug 23, 94

NOTE: SANITARY & STORM
SEWER AS-BUILT AS
SHOWN ON PROFILES.

N



Legend

AB = As Built.

SCALE-1"=50'

DARDENNE ELEMENTARY SCHOOL
PROPERTY N/F OF
FORT ZUMWALT SCHOOL DISTRICT
1087/1038

CAUTION! PETROLEUM PIPELINE

The Contractor shall notify Williams Pipe Line Company to arrange a representative of Williams Pipe Line Company be present for and supervise any construction in the vicinity of the petroleum pipeline.


Williams Pipe Line Company Representative:

K. G. (Kenny) Graham
P.R. 1
Highway 63 South
Columbia, MO 65201
(314) 443-1619

WOOD CREST PLAT TWO

PB. 17, Pg. 20



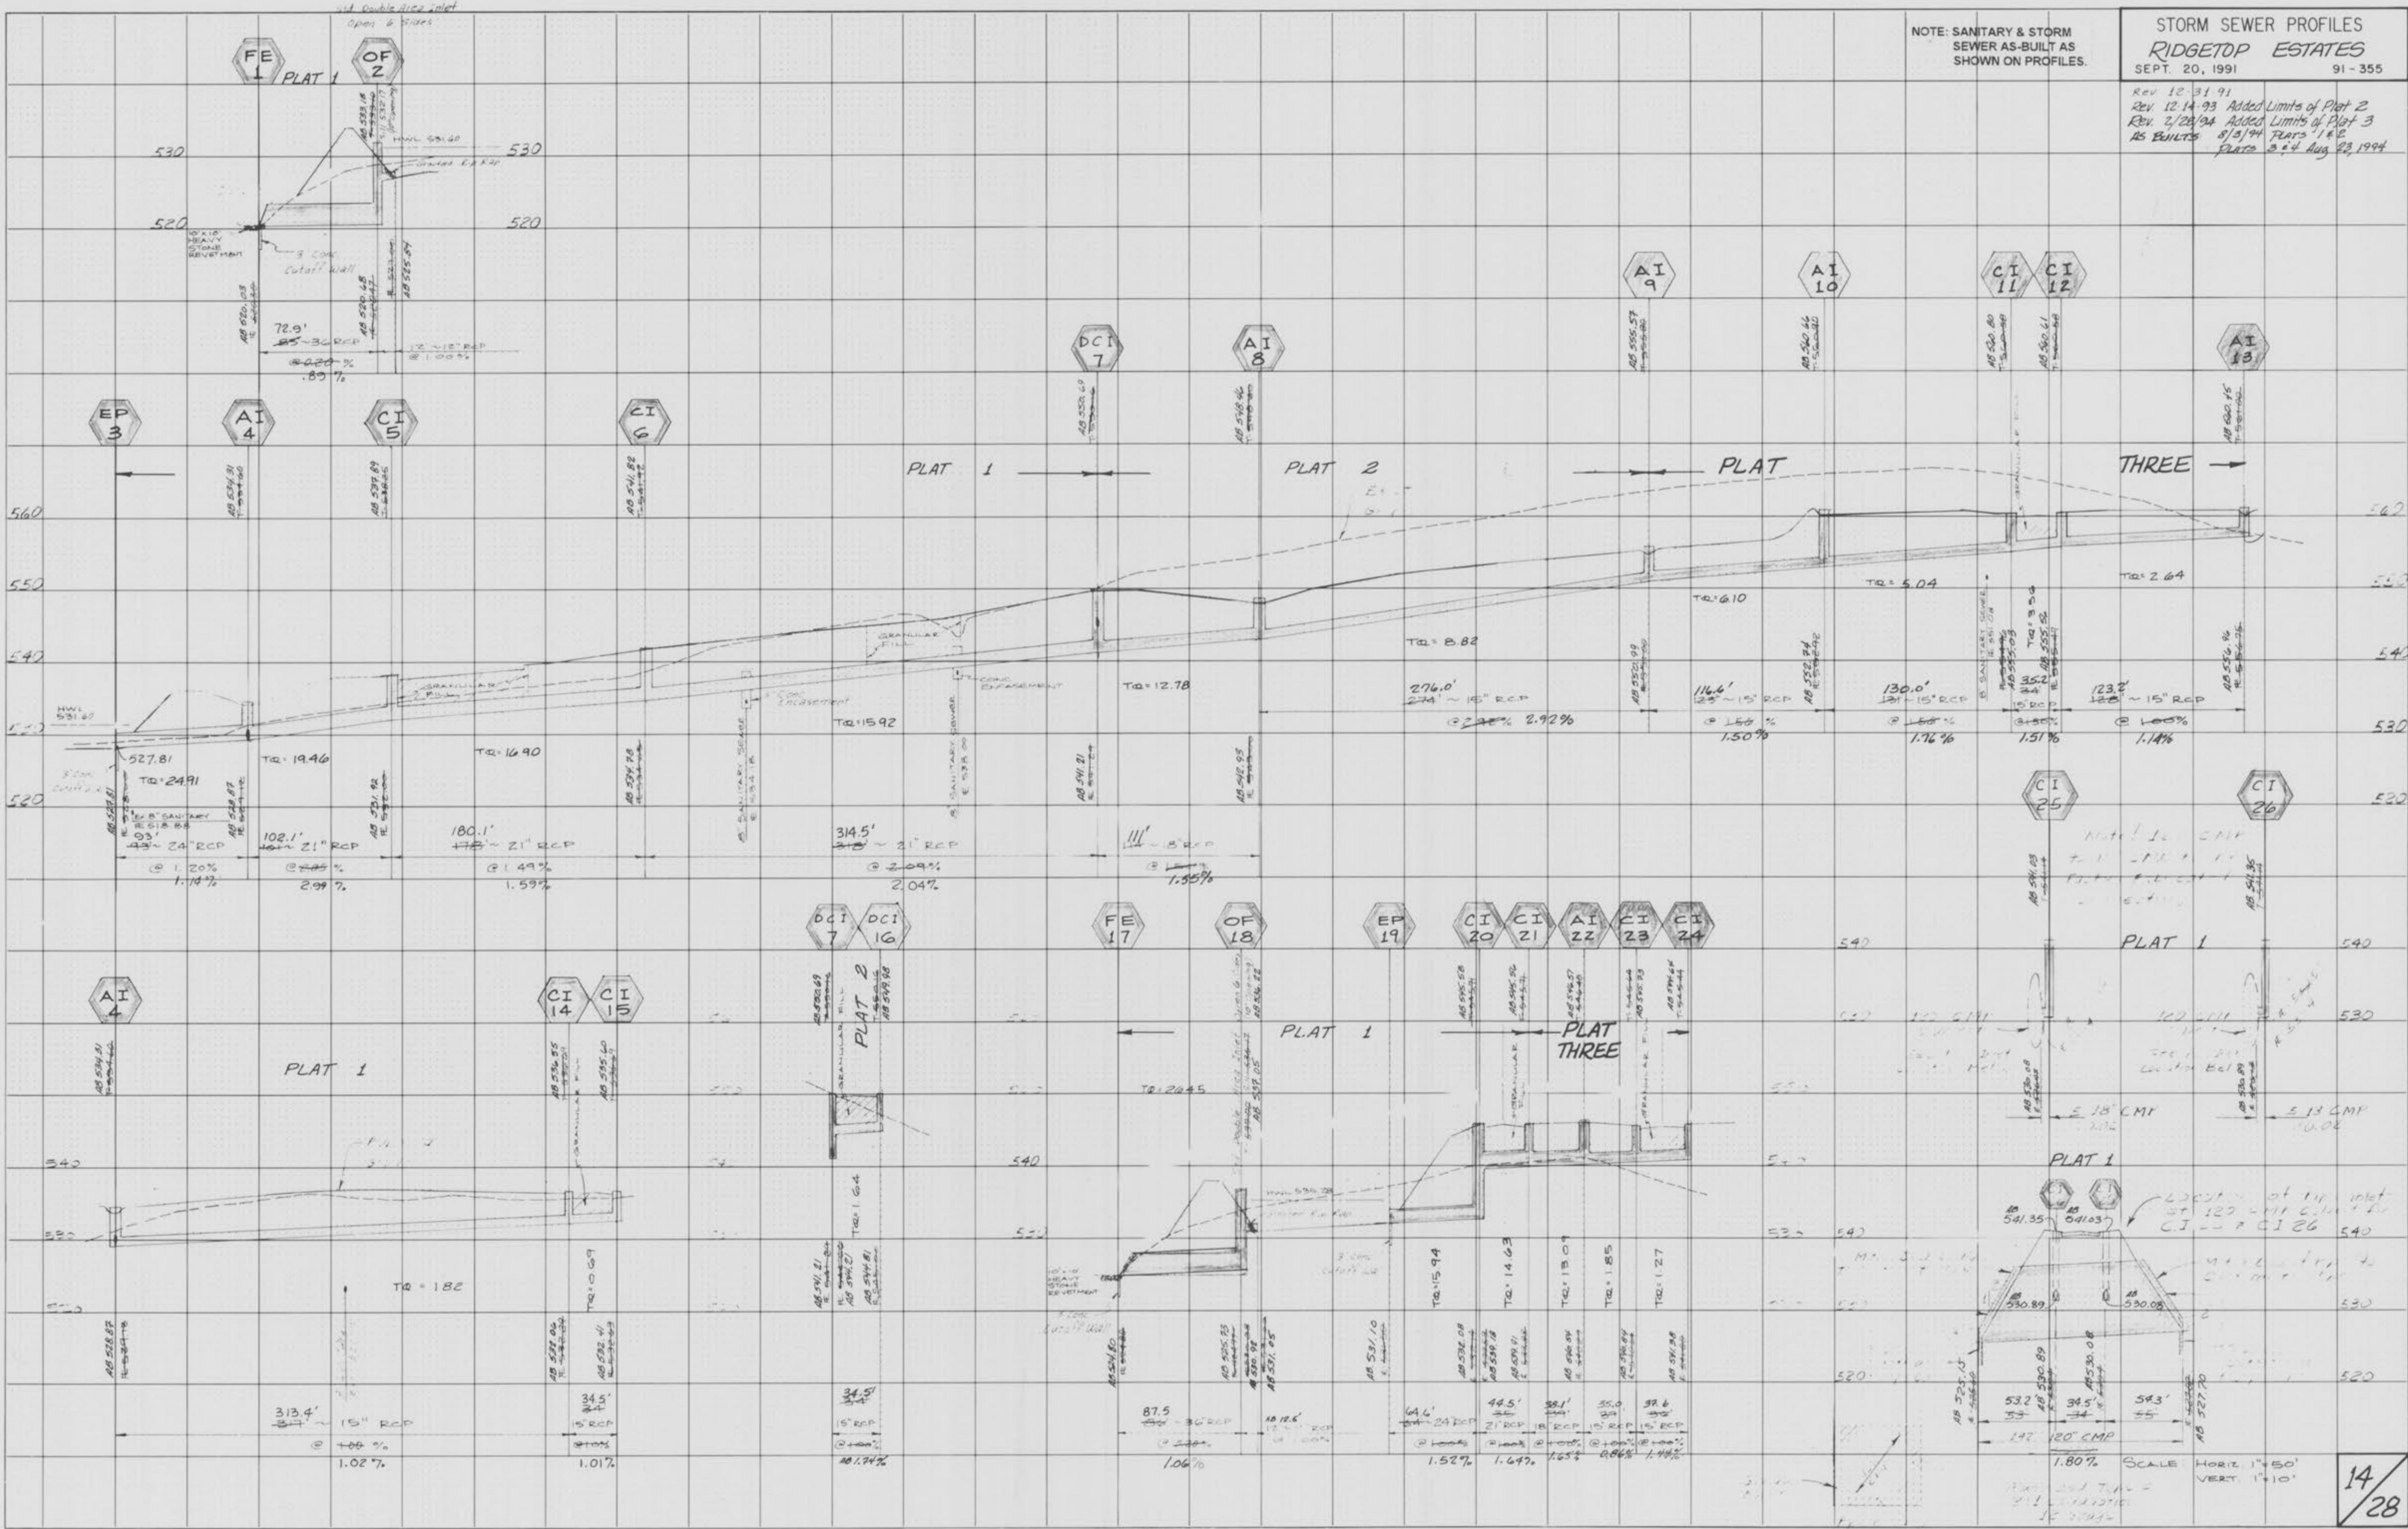

STORM SEWER PROFILES
RIDGETOP ESTATES

Rev. 12-14-93 Added Limits of Plat 2
Rev. 9/28/94 Added Limits of Plat 3 & 4
As Built's - Plots 1 & 2 Aug. 5, 1994
Plots 3 & 4 Aug. 23, 1994

A I
54

580

570

560

550

540

530

520

510

500

A I
41

560

A I
40

550

A I
39

540

A I
38

530

A I
37

520

A I
36

510


Ridgetop Estates Ridge Top Estates
As-Built 14

15
28

NOTE: SANITARY & STORM
SEWER AS-BUILT AS
SHOWN ON PROFILES.

FINAL SURVEY	DATE
BURIED	
PLOTTED	
NOTE BOOK	TEMBLAIR
AREAS	AREA CHECKED

ORIGINAL SURVEY	DATE
BURIED	
PLOTTED	
NOTE BOOK	TEMBLAIR
AREAS	AREA CHECKED

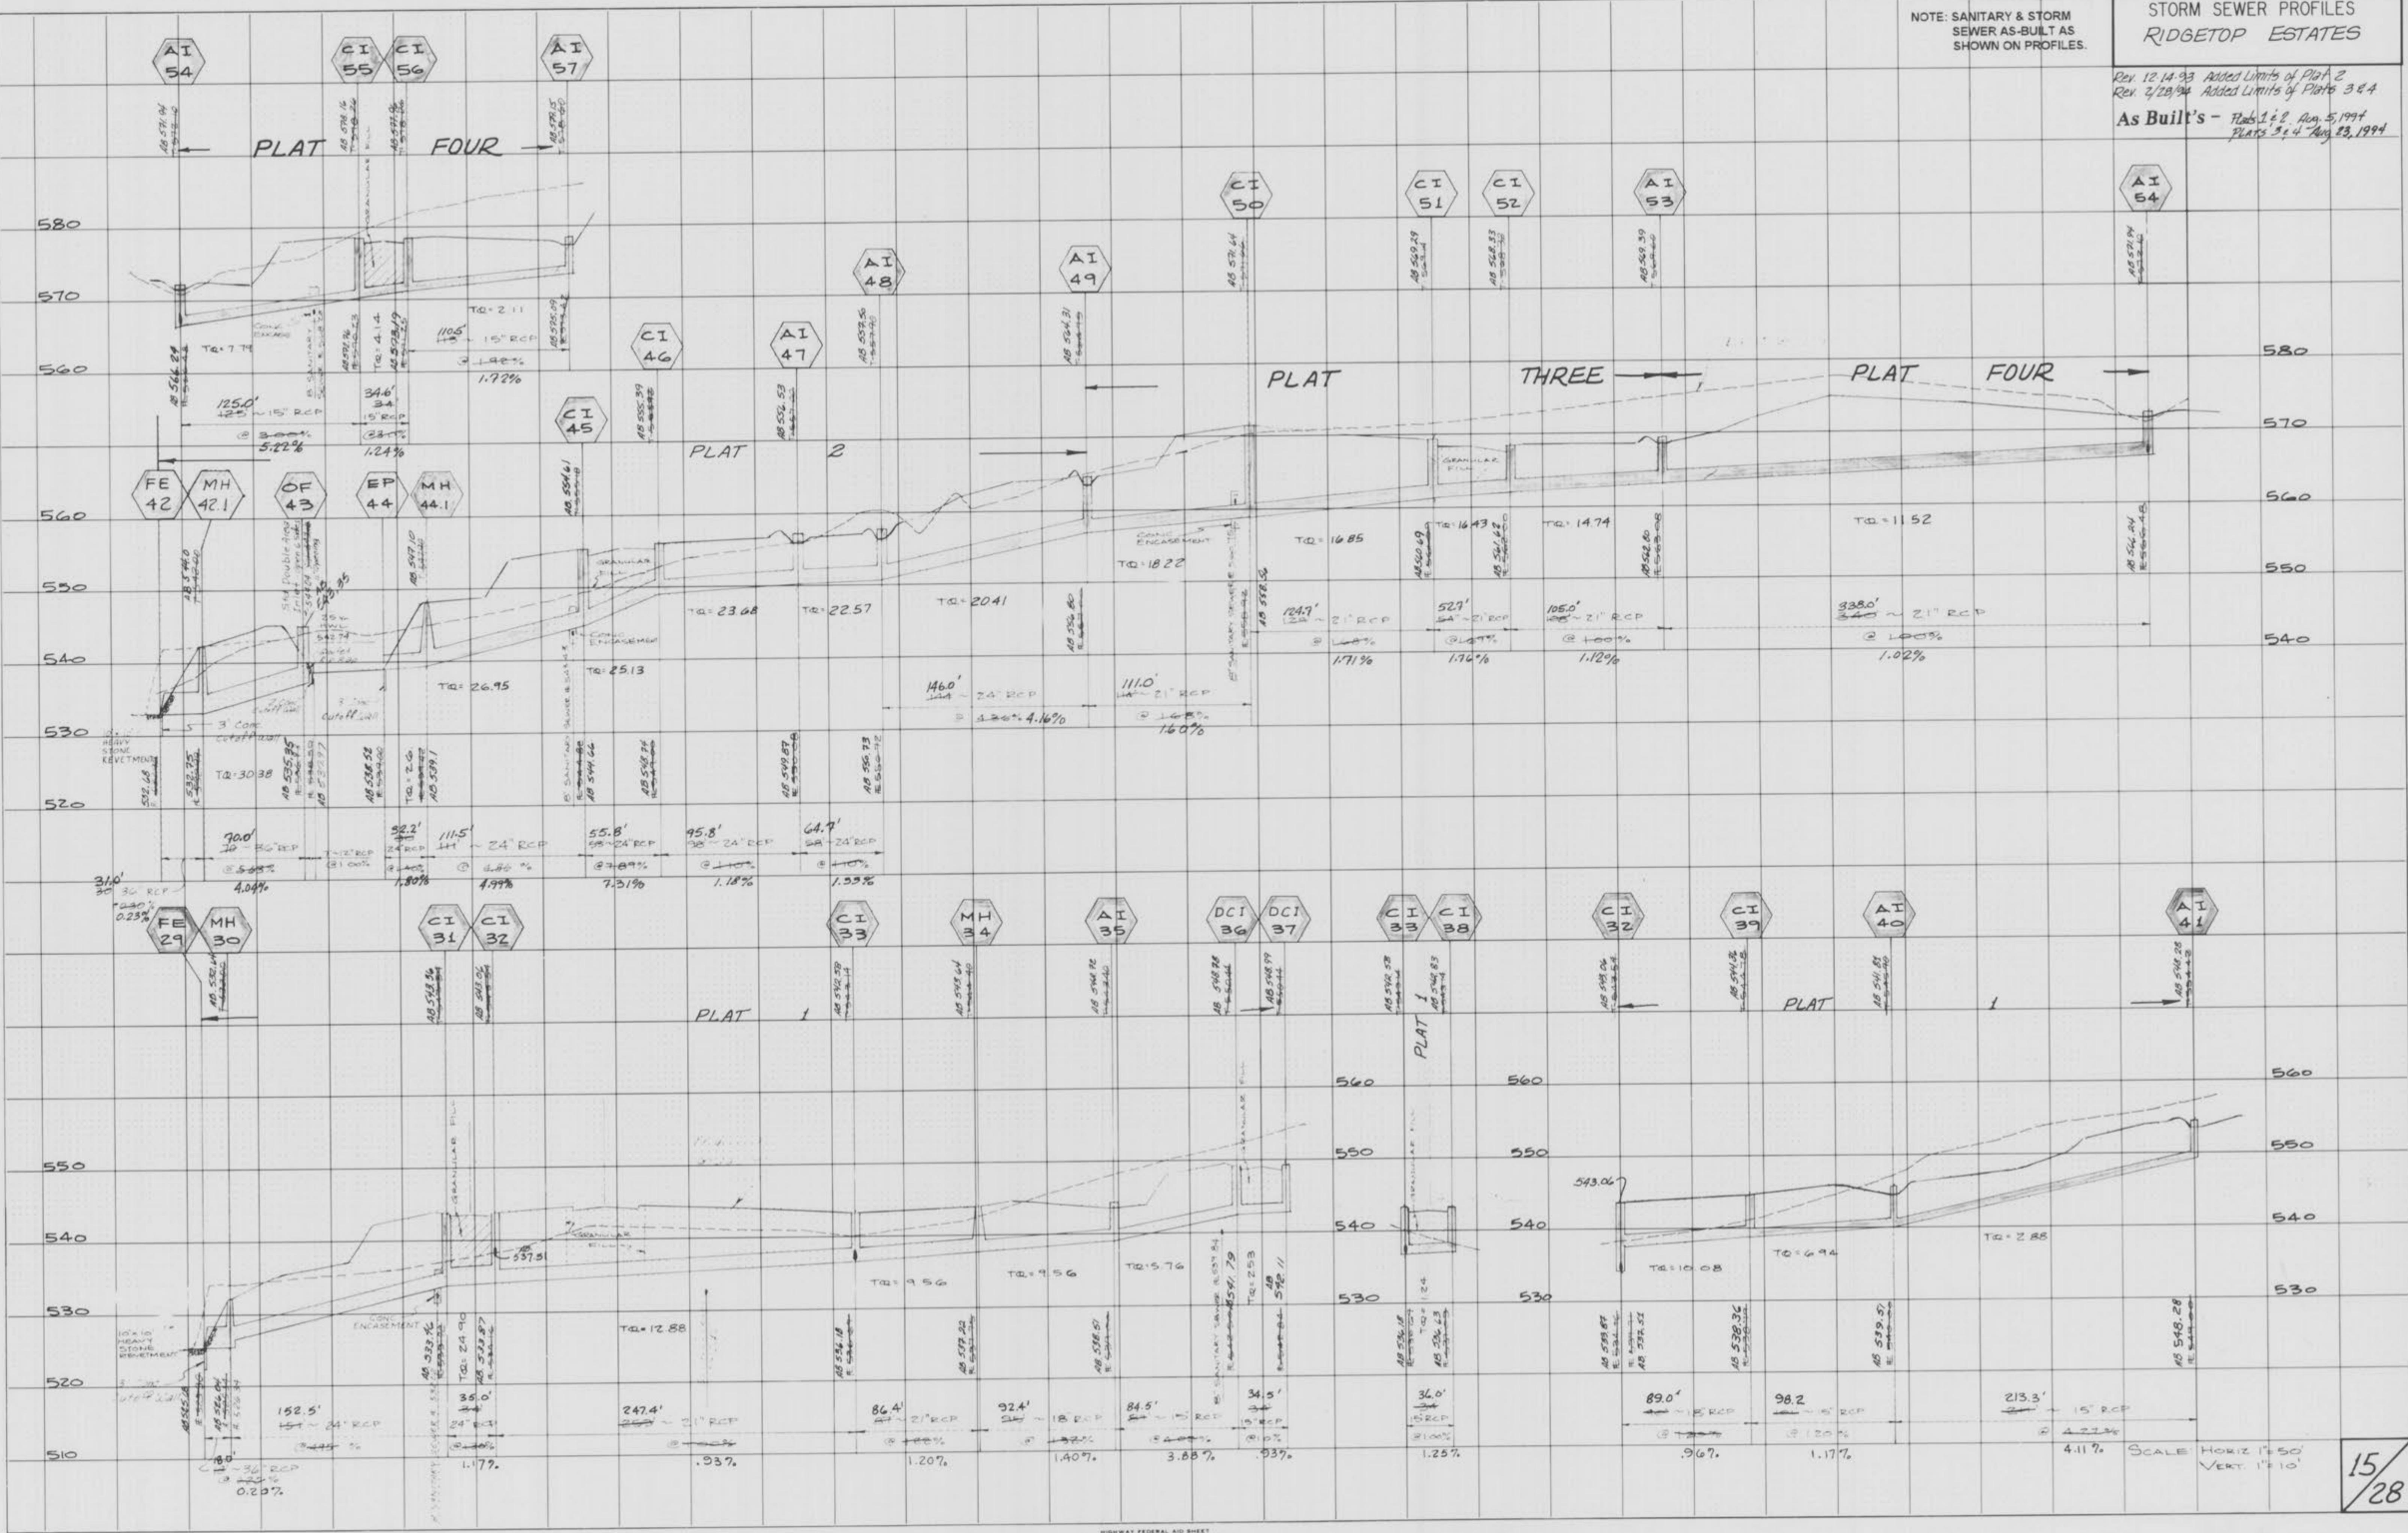


91-355

STORM SEWER PROFILES
RIDGETOP ESTATES
SEPT. 20, 1991

91-355

Rev. 12-14-93 Added Limits of Plat 2
Rev 2/28/94 Limits of Plots 3&4
As Built's - Plat 1 & 2
Aug 5, 1994

Plots 3 & 4 Aug 23, 1994

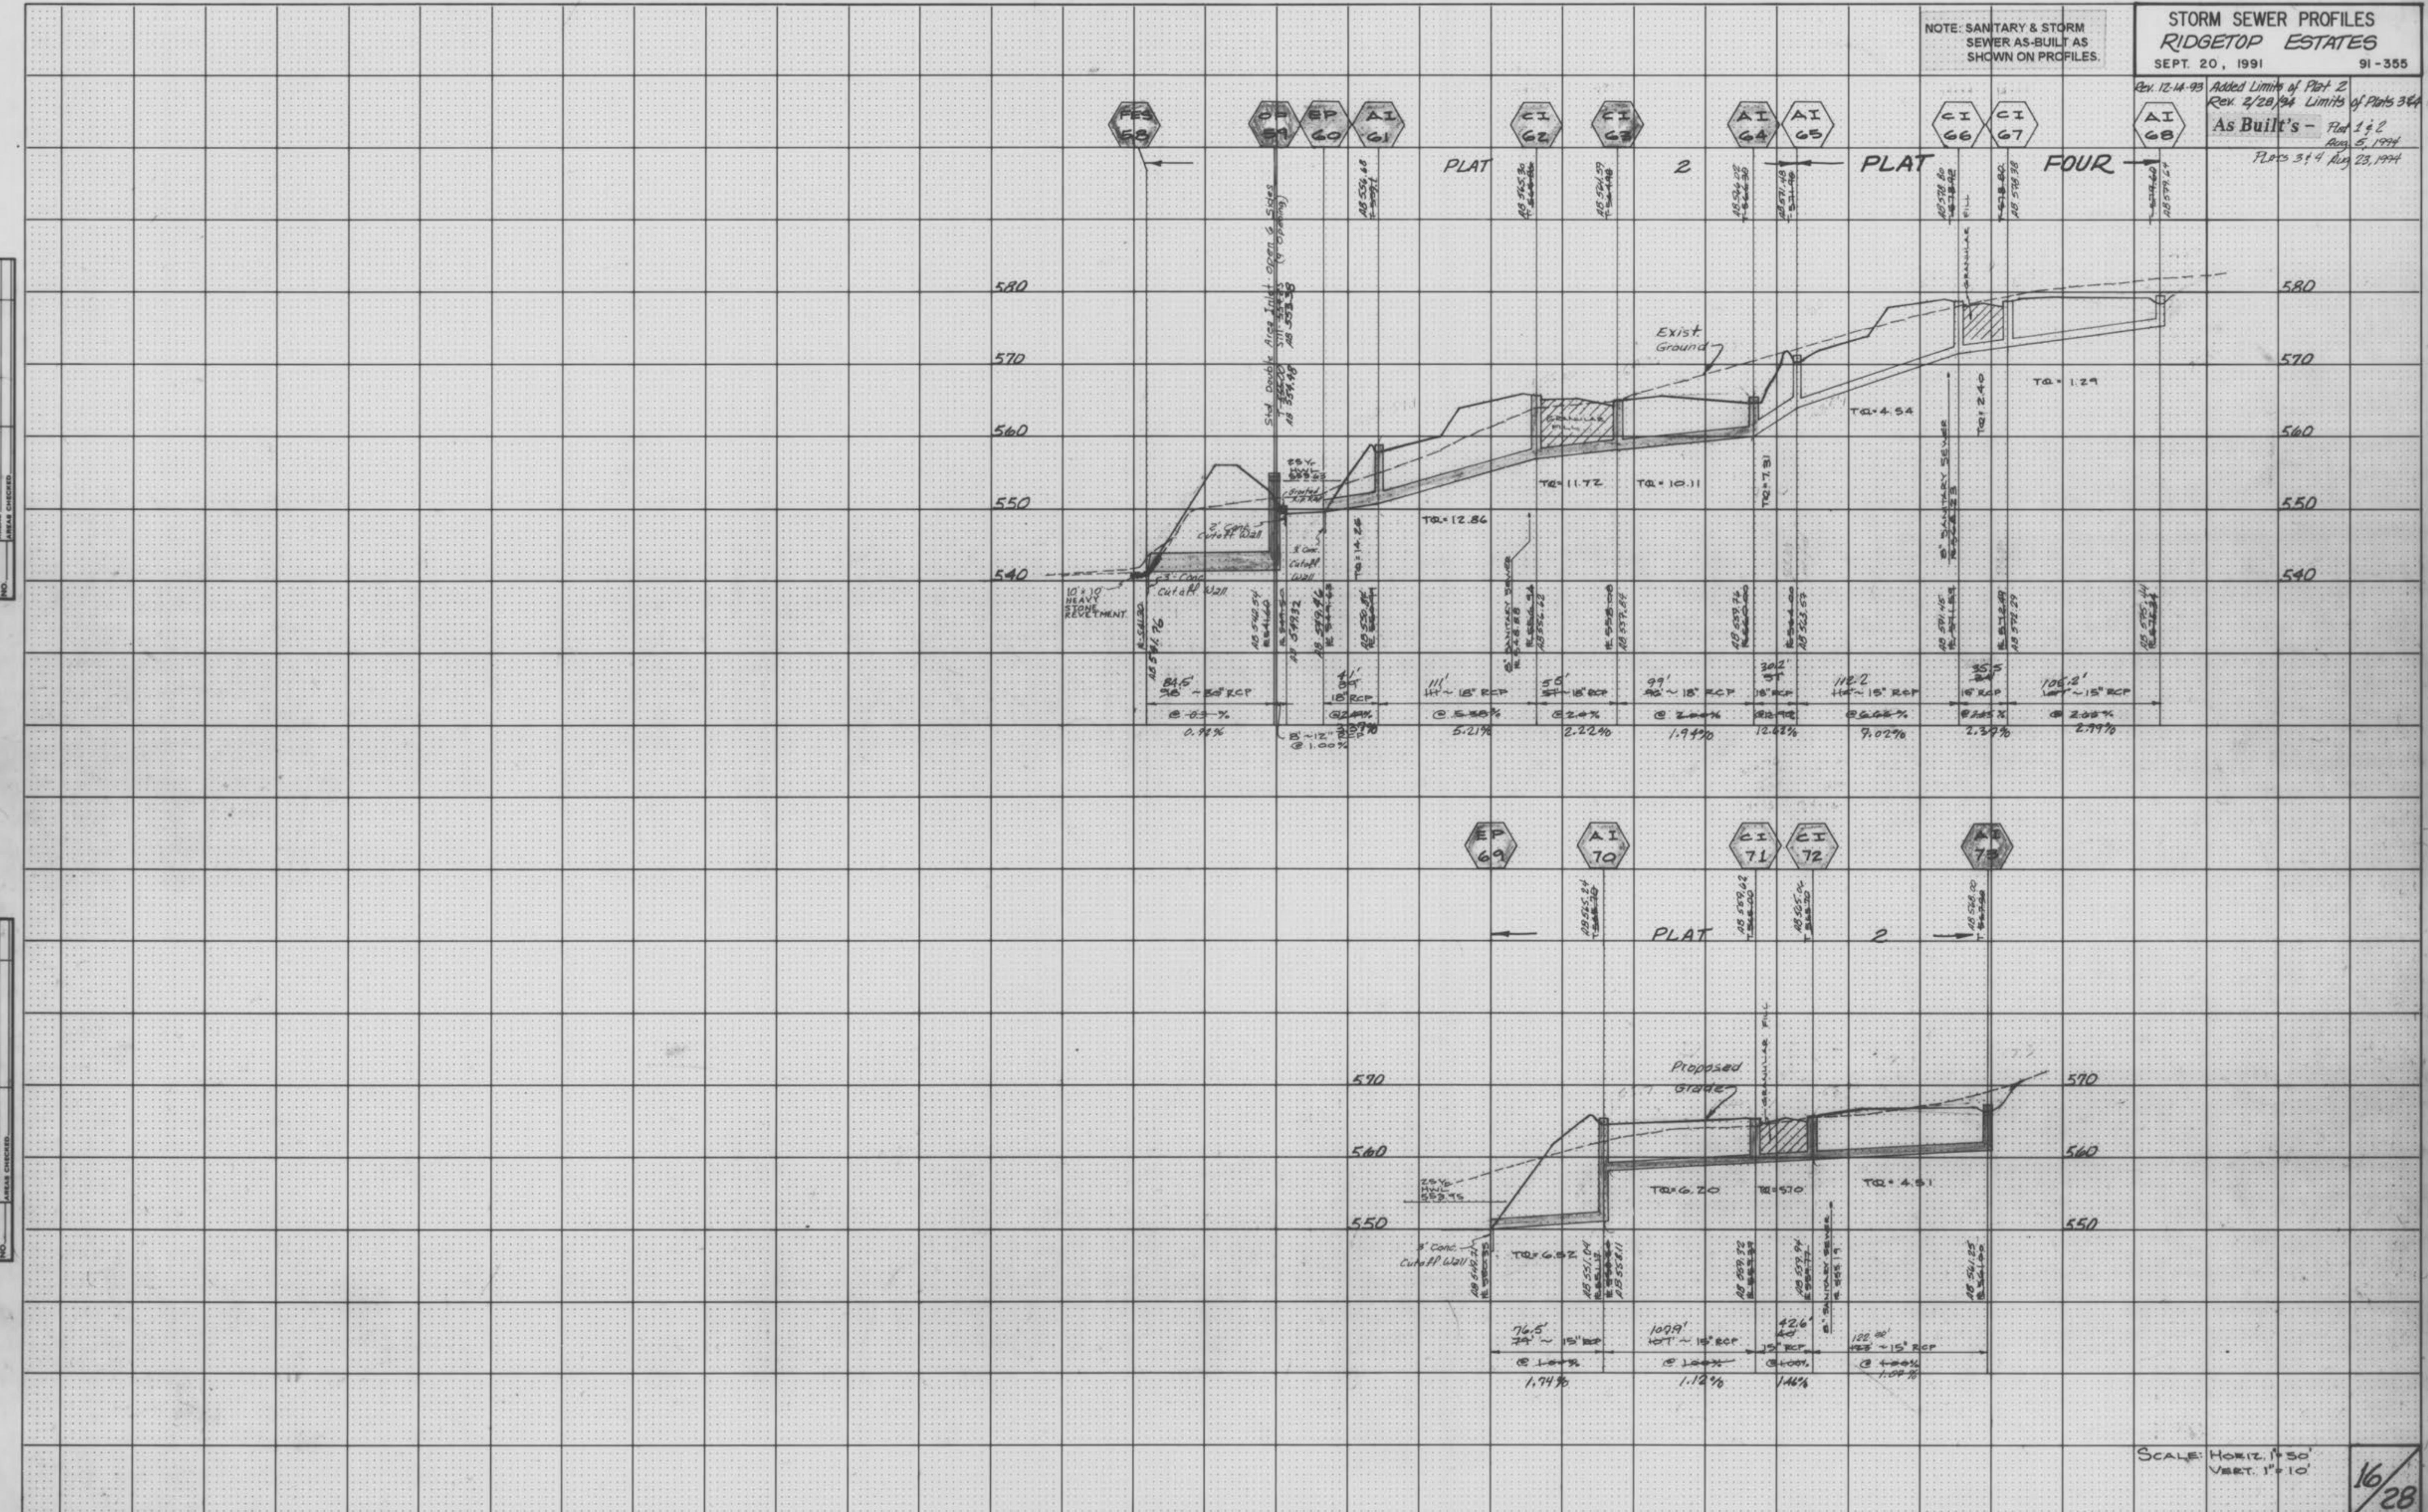

ORIGINAL SURVEYED	BY	DATE
PLATTED		
NOTE BOOK NO.		
CHECKED		

FINAL SURVEYED	BY	DATE
PLATTED		
NOTE BOOK NO.		
CHECKED		