

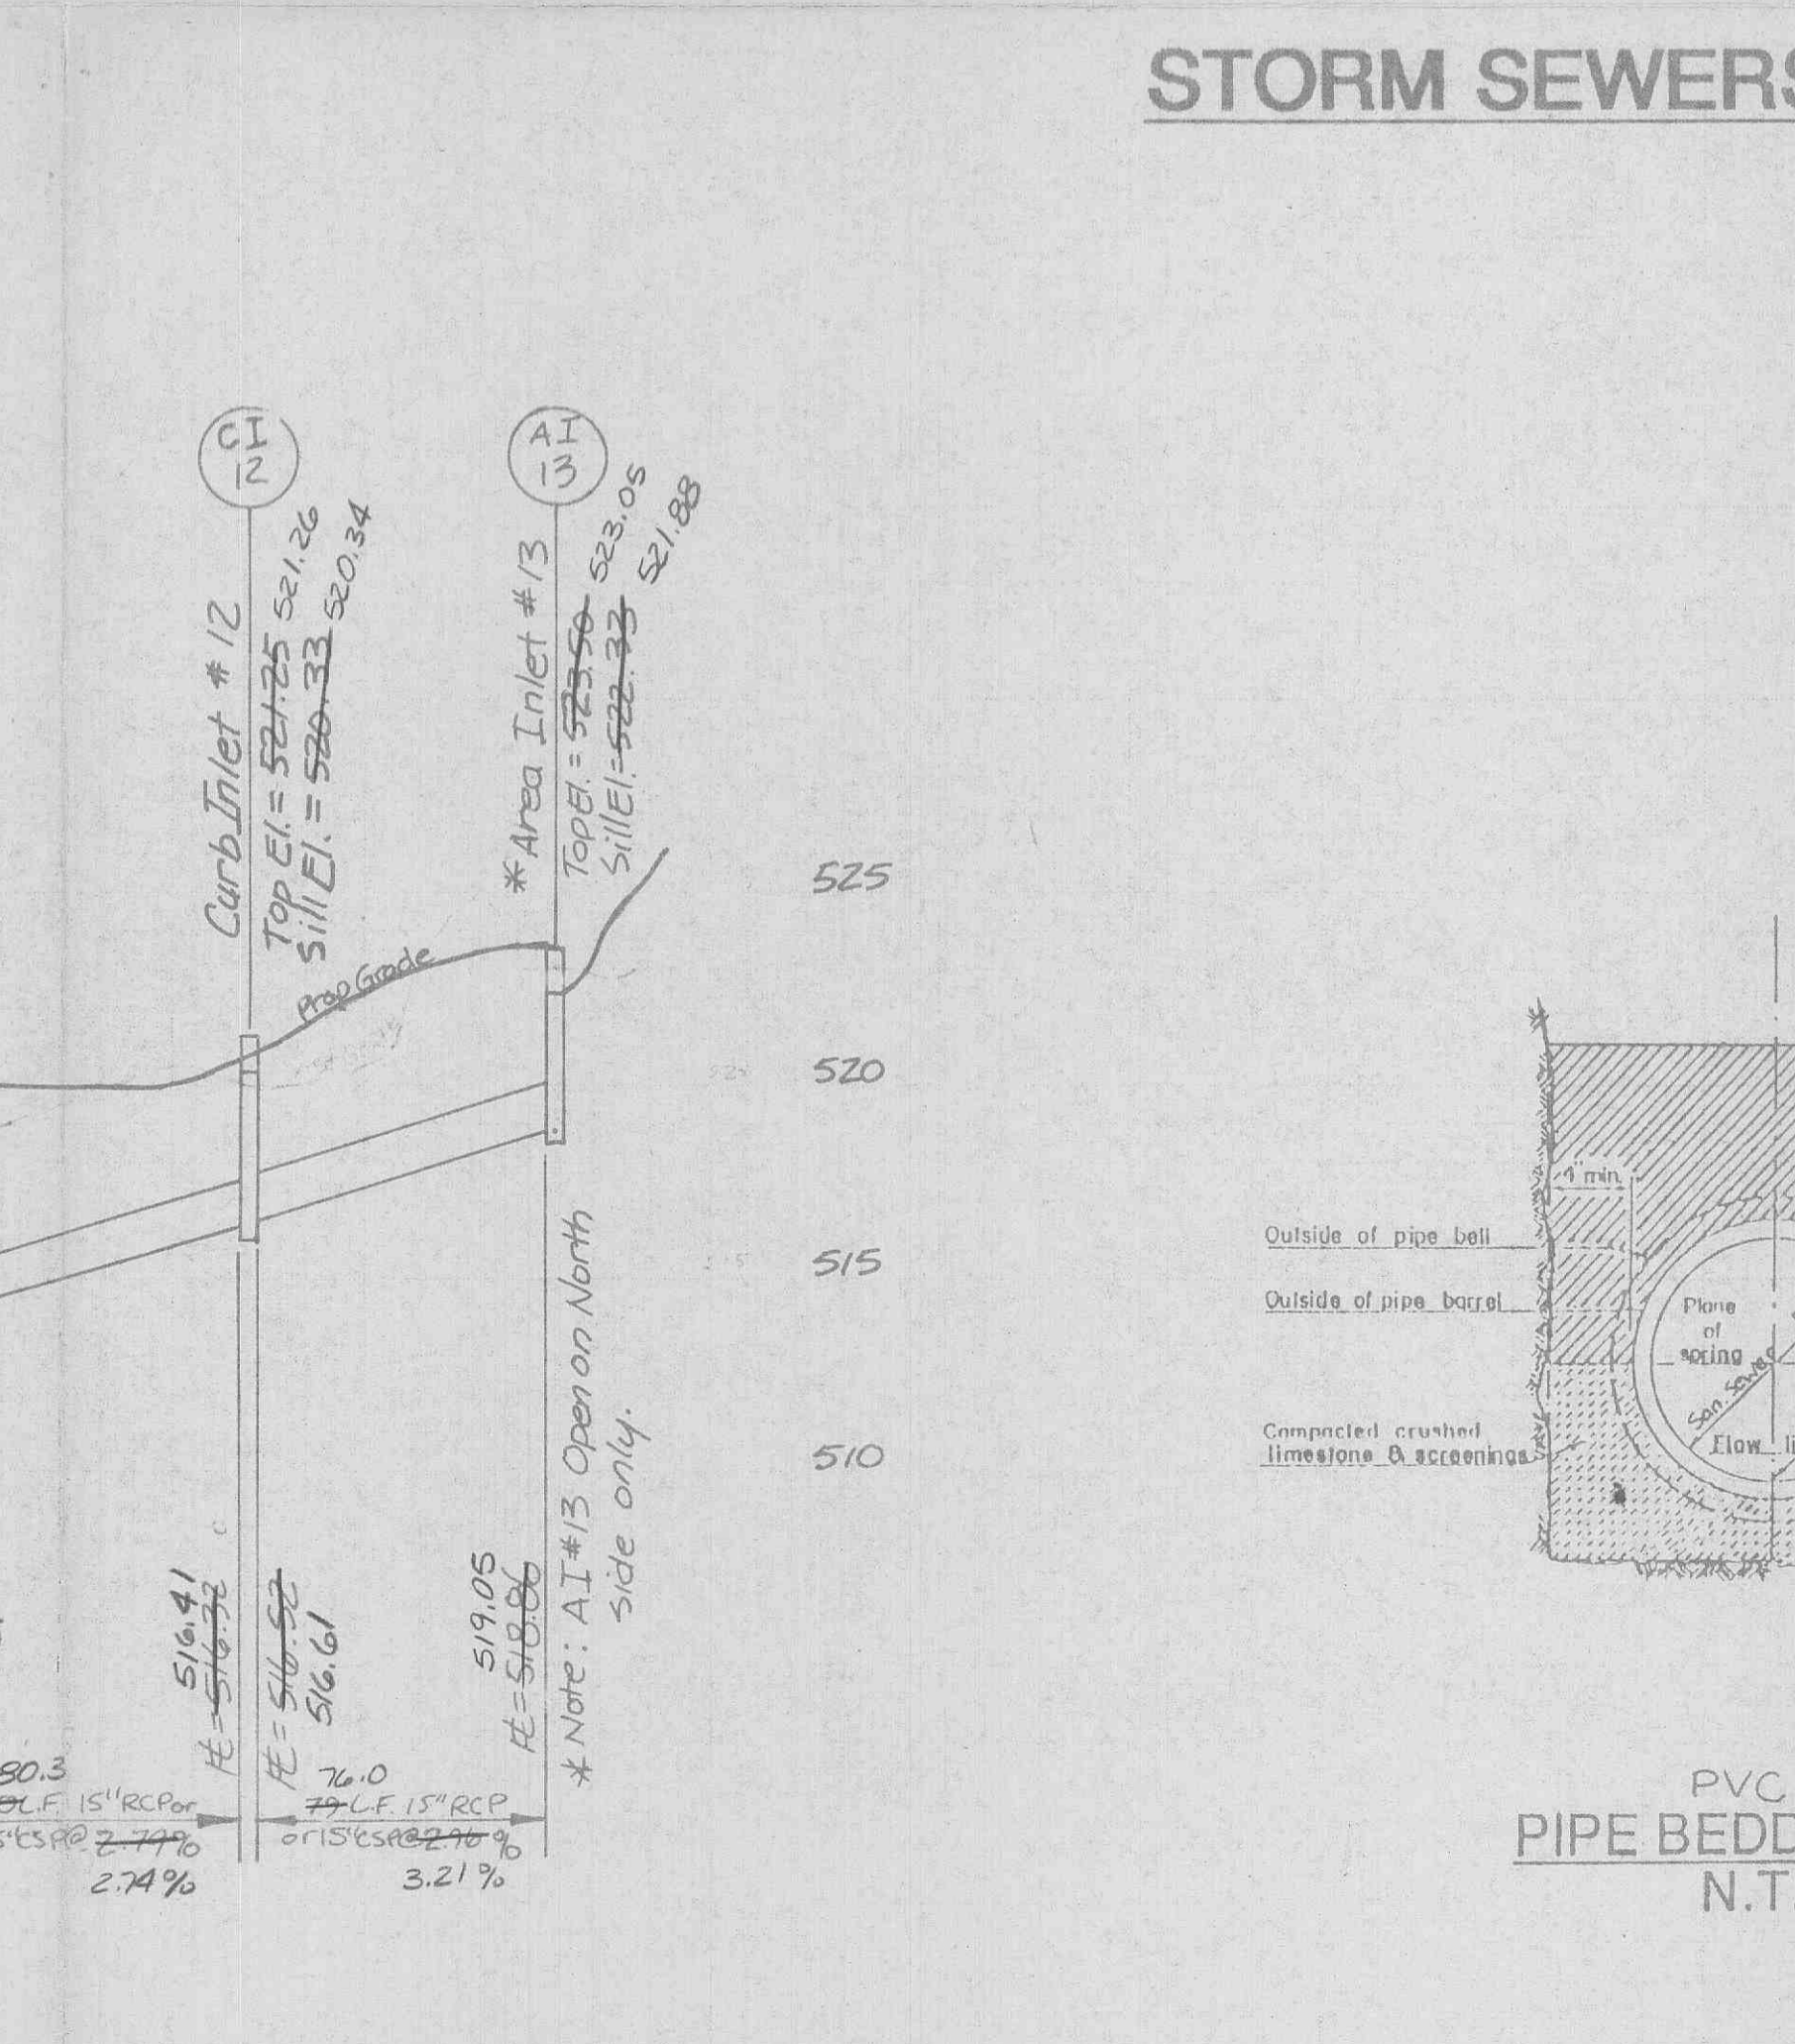
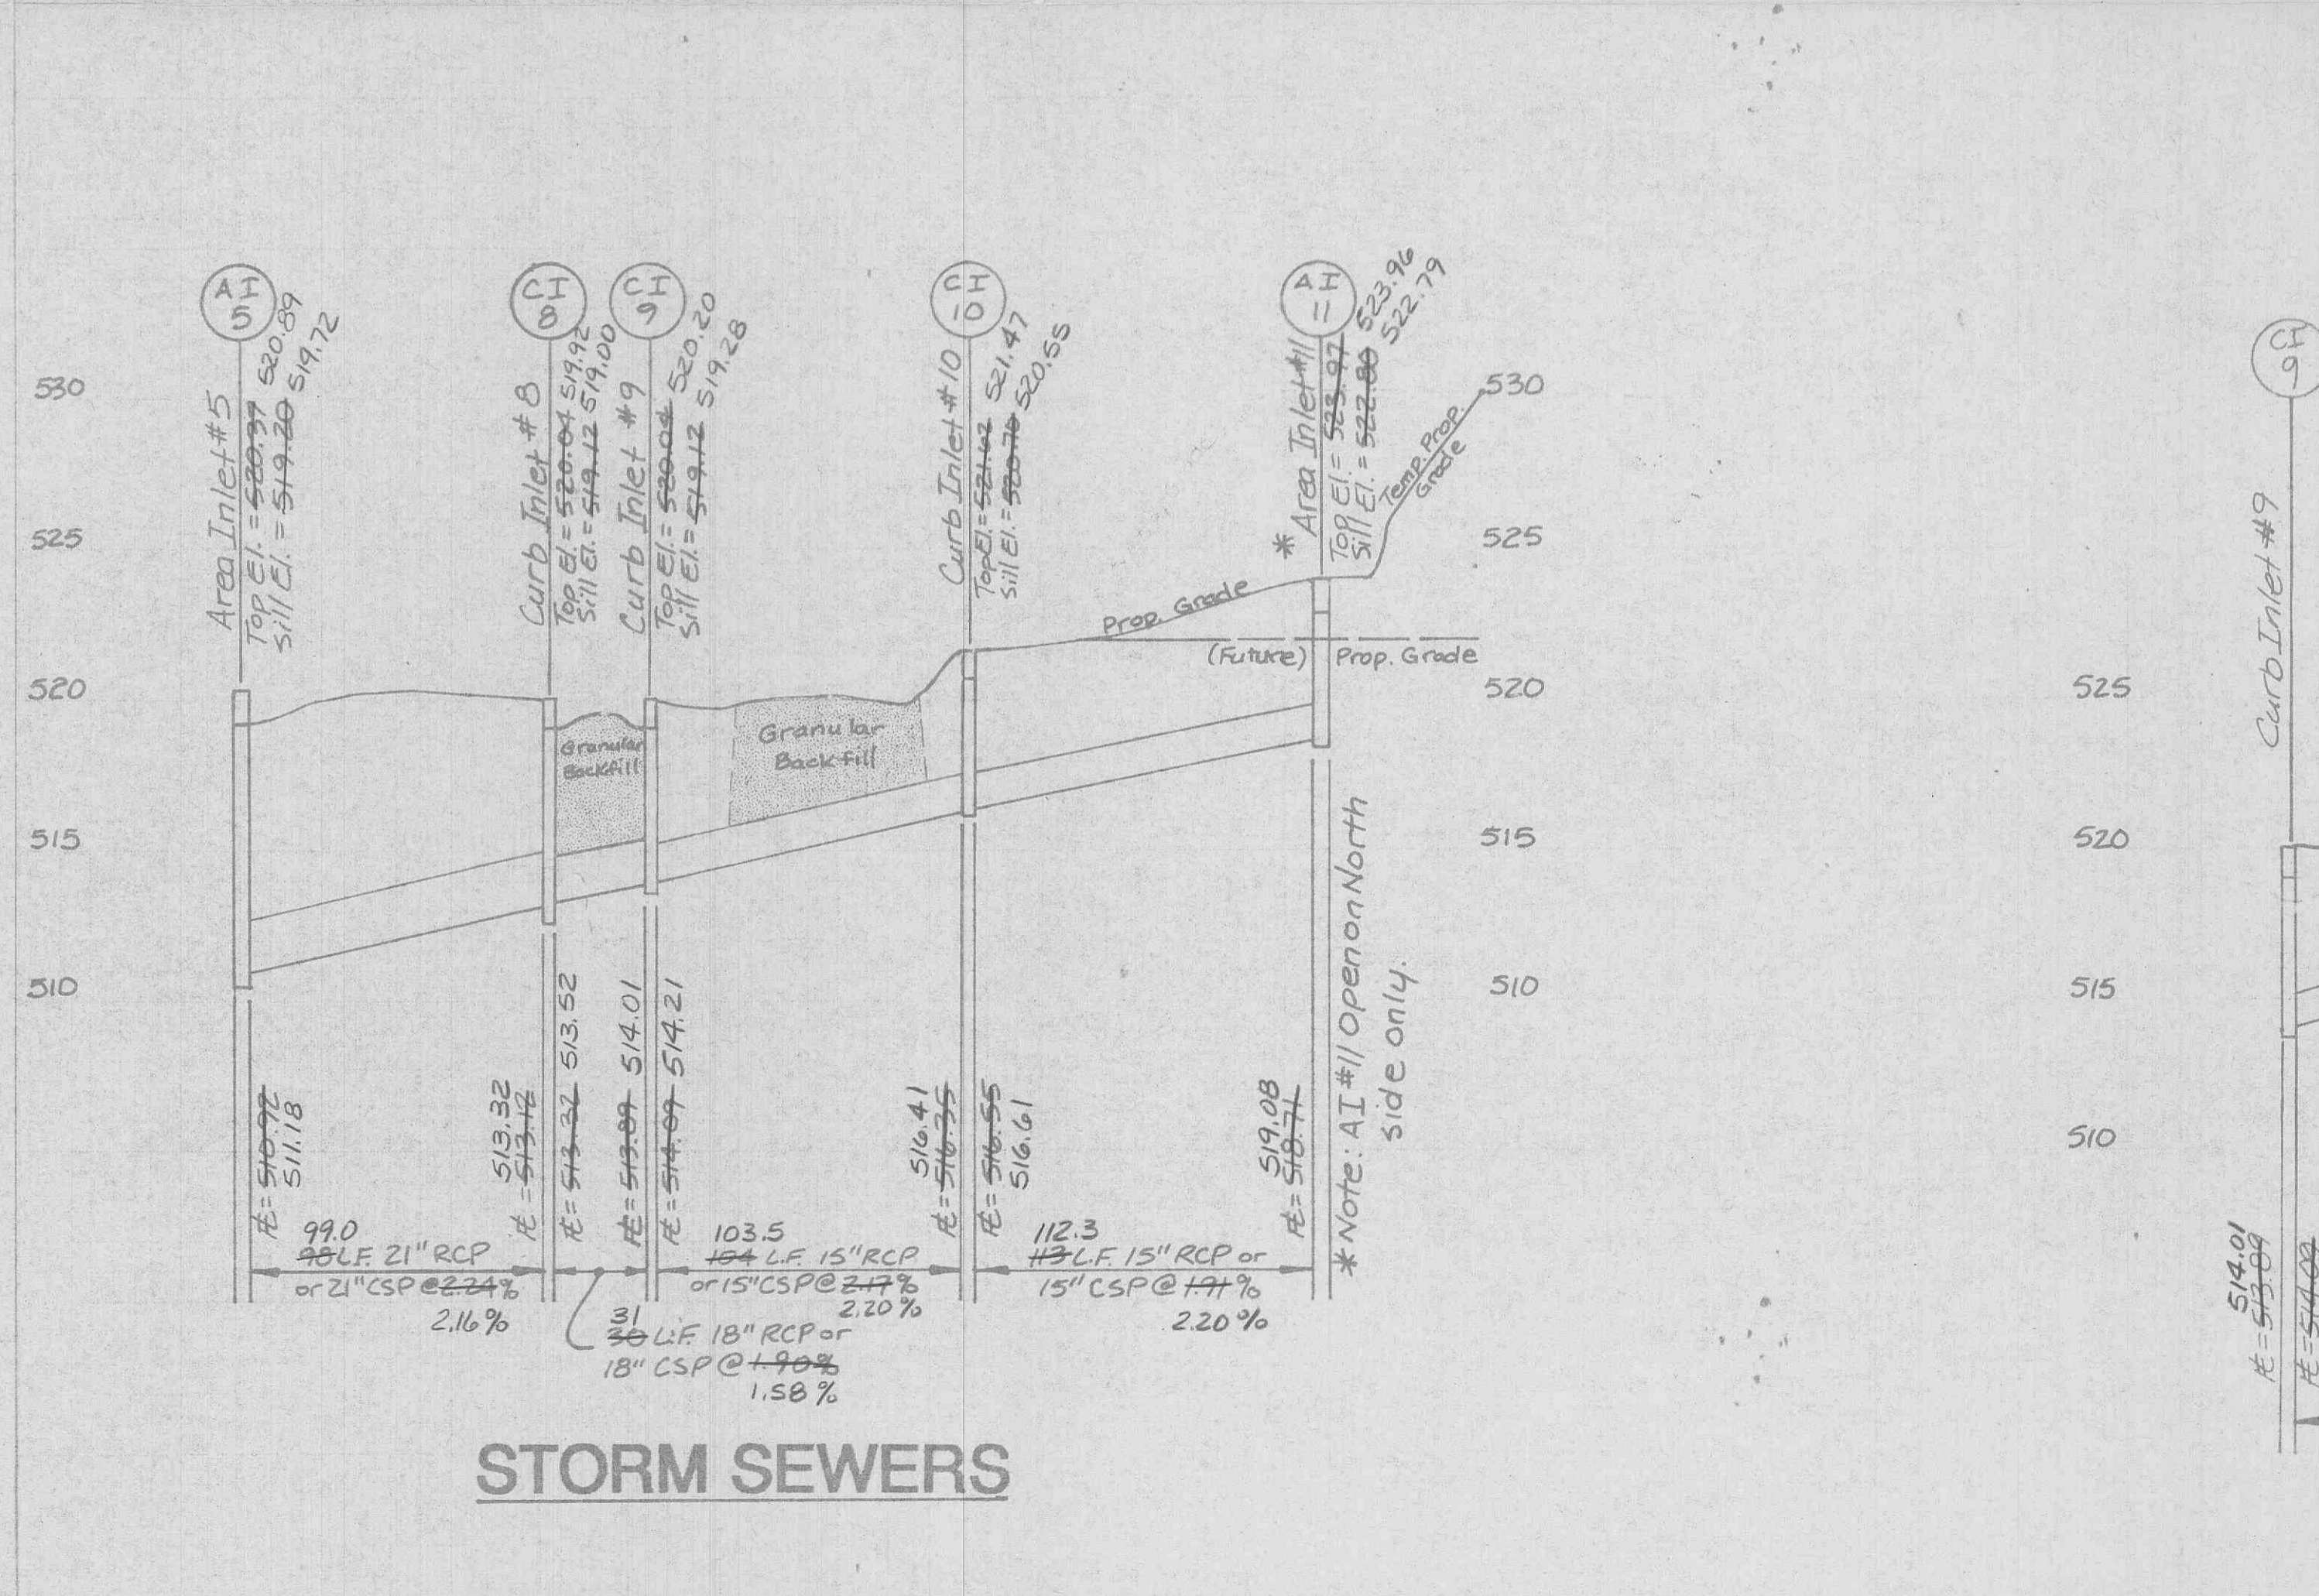
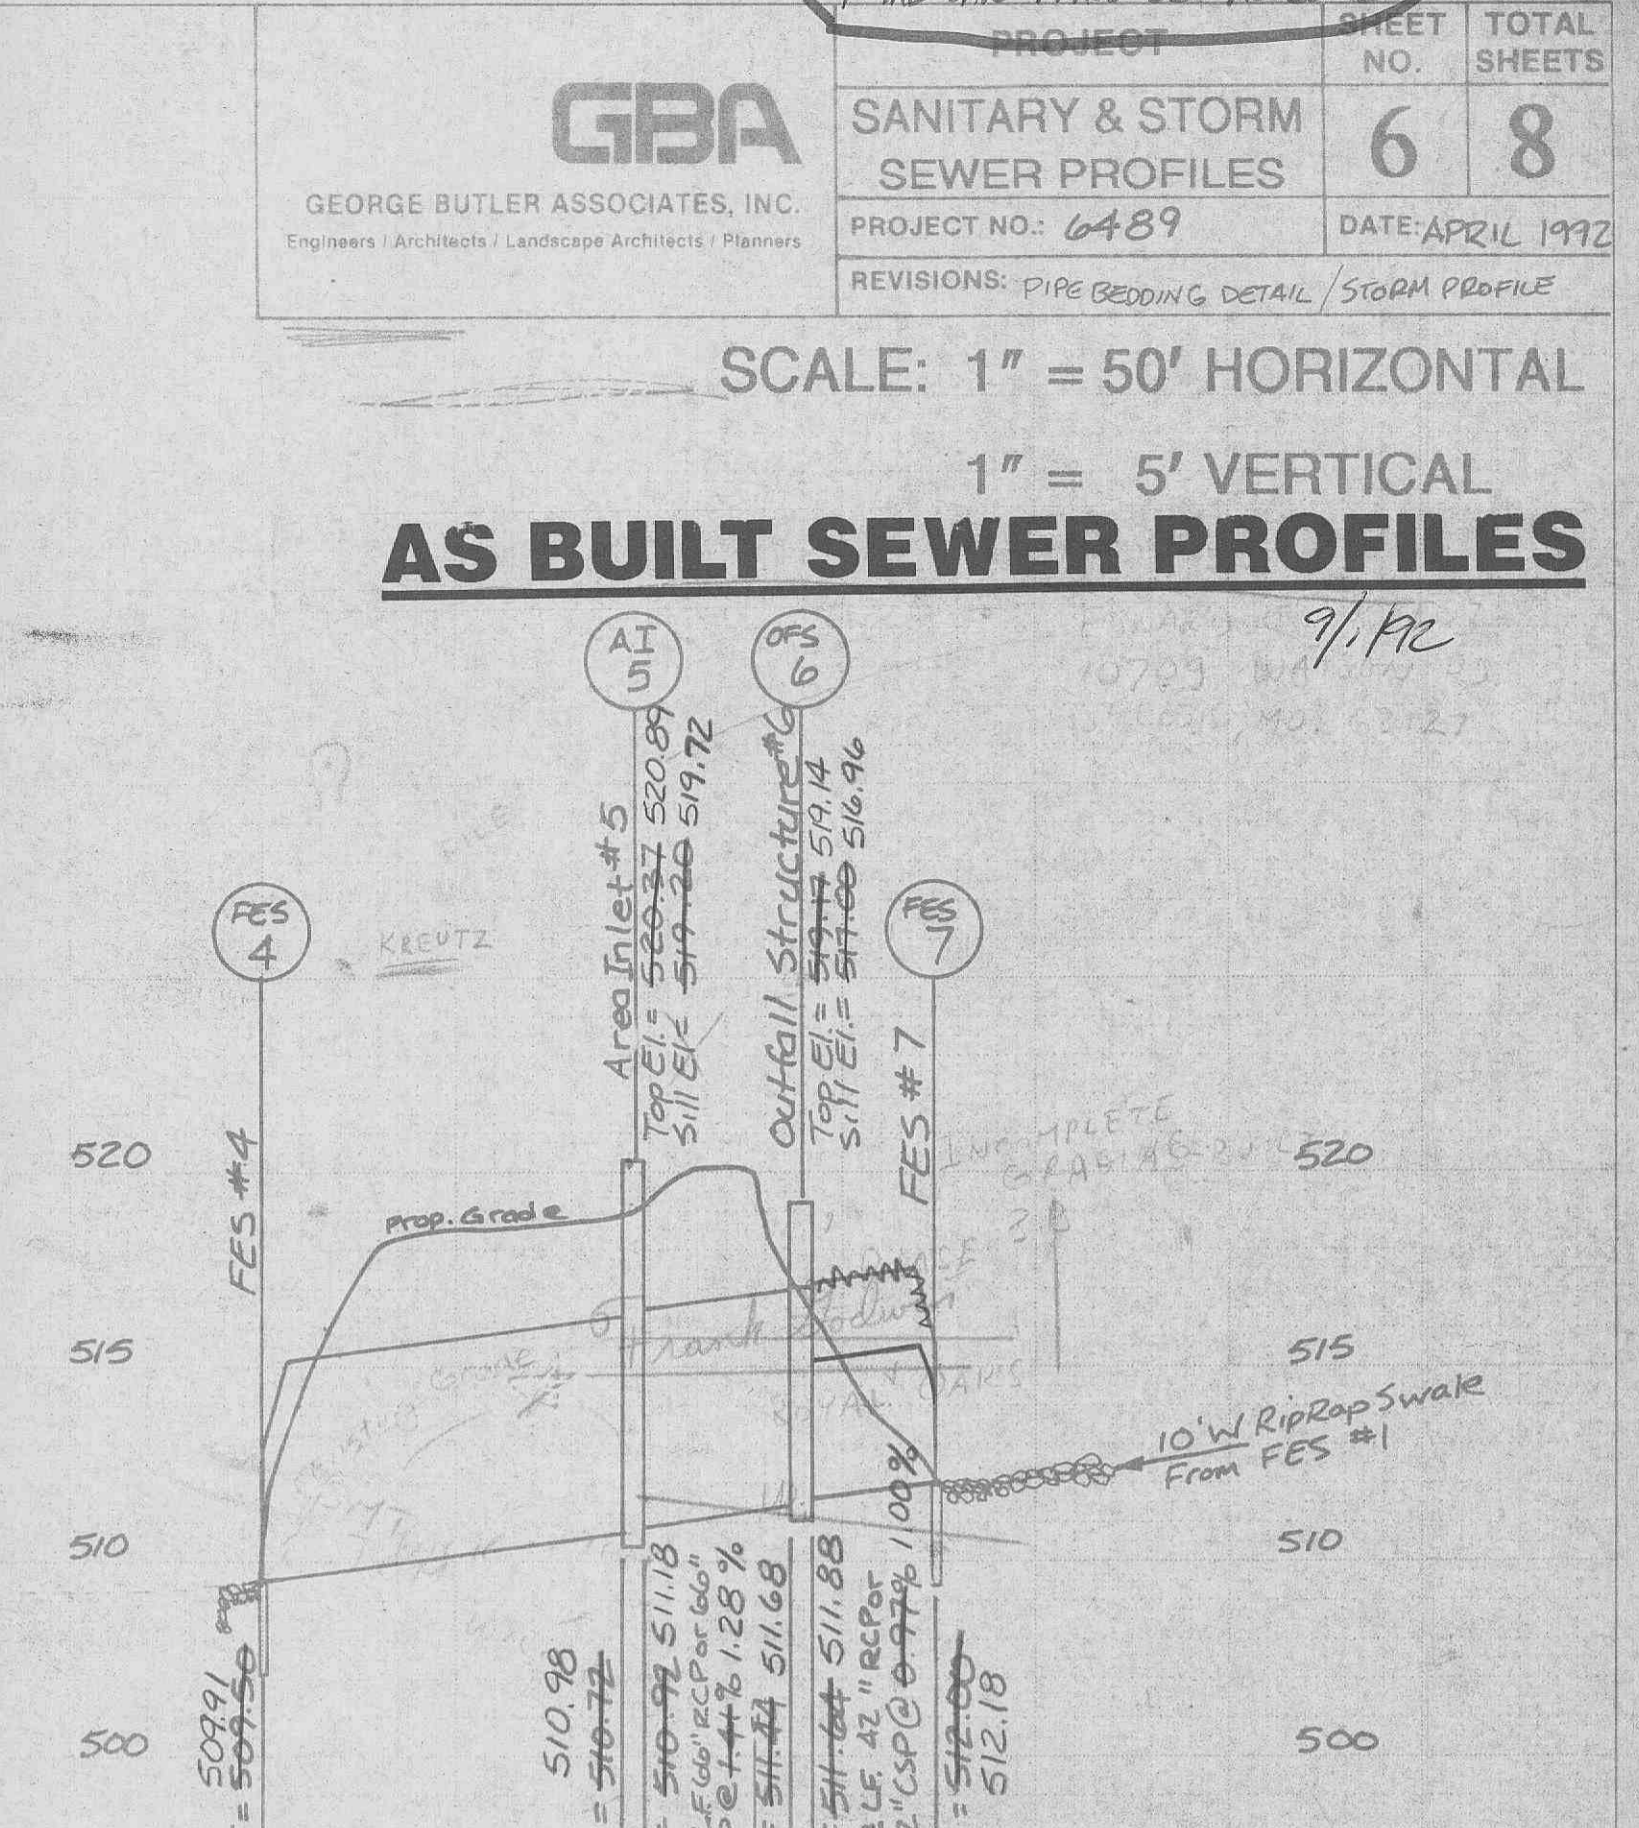
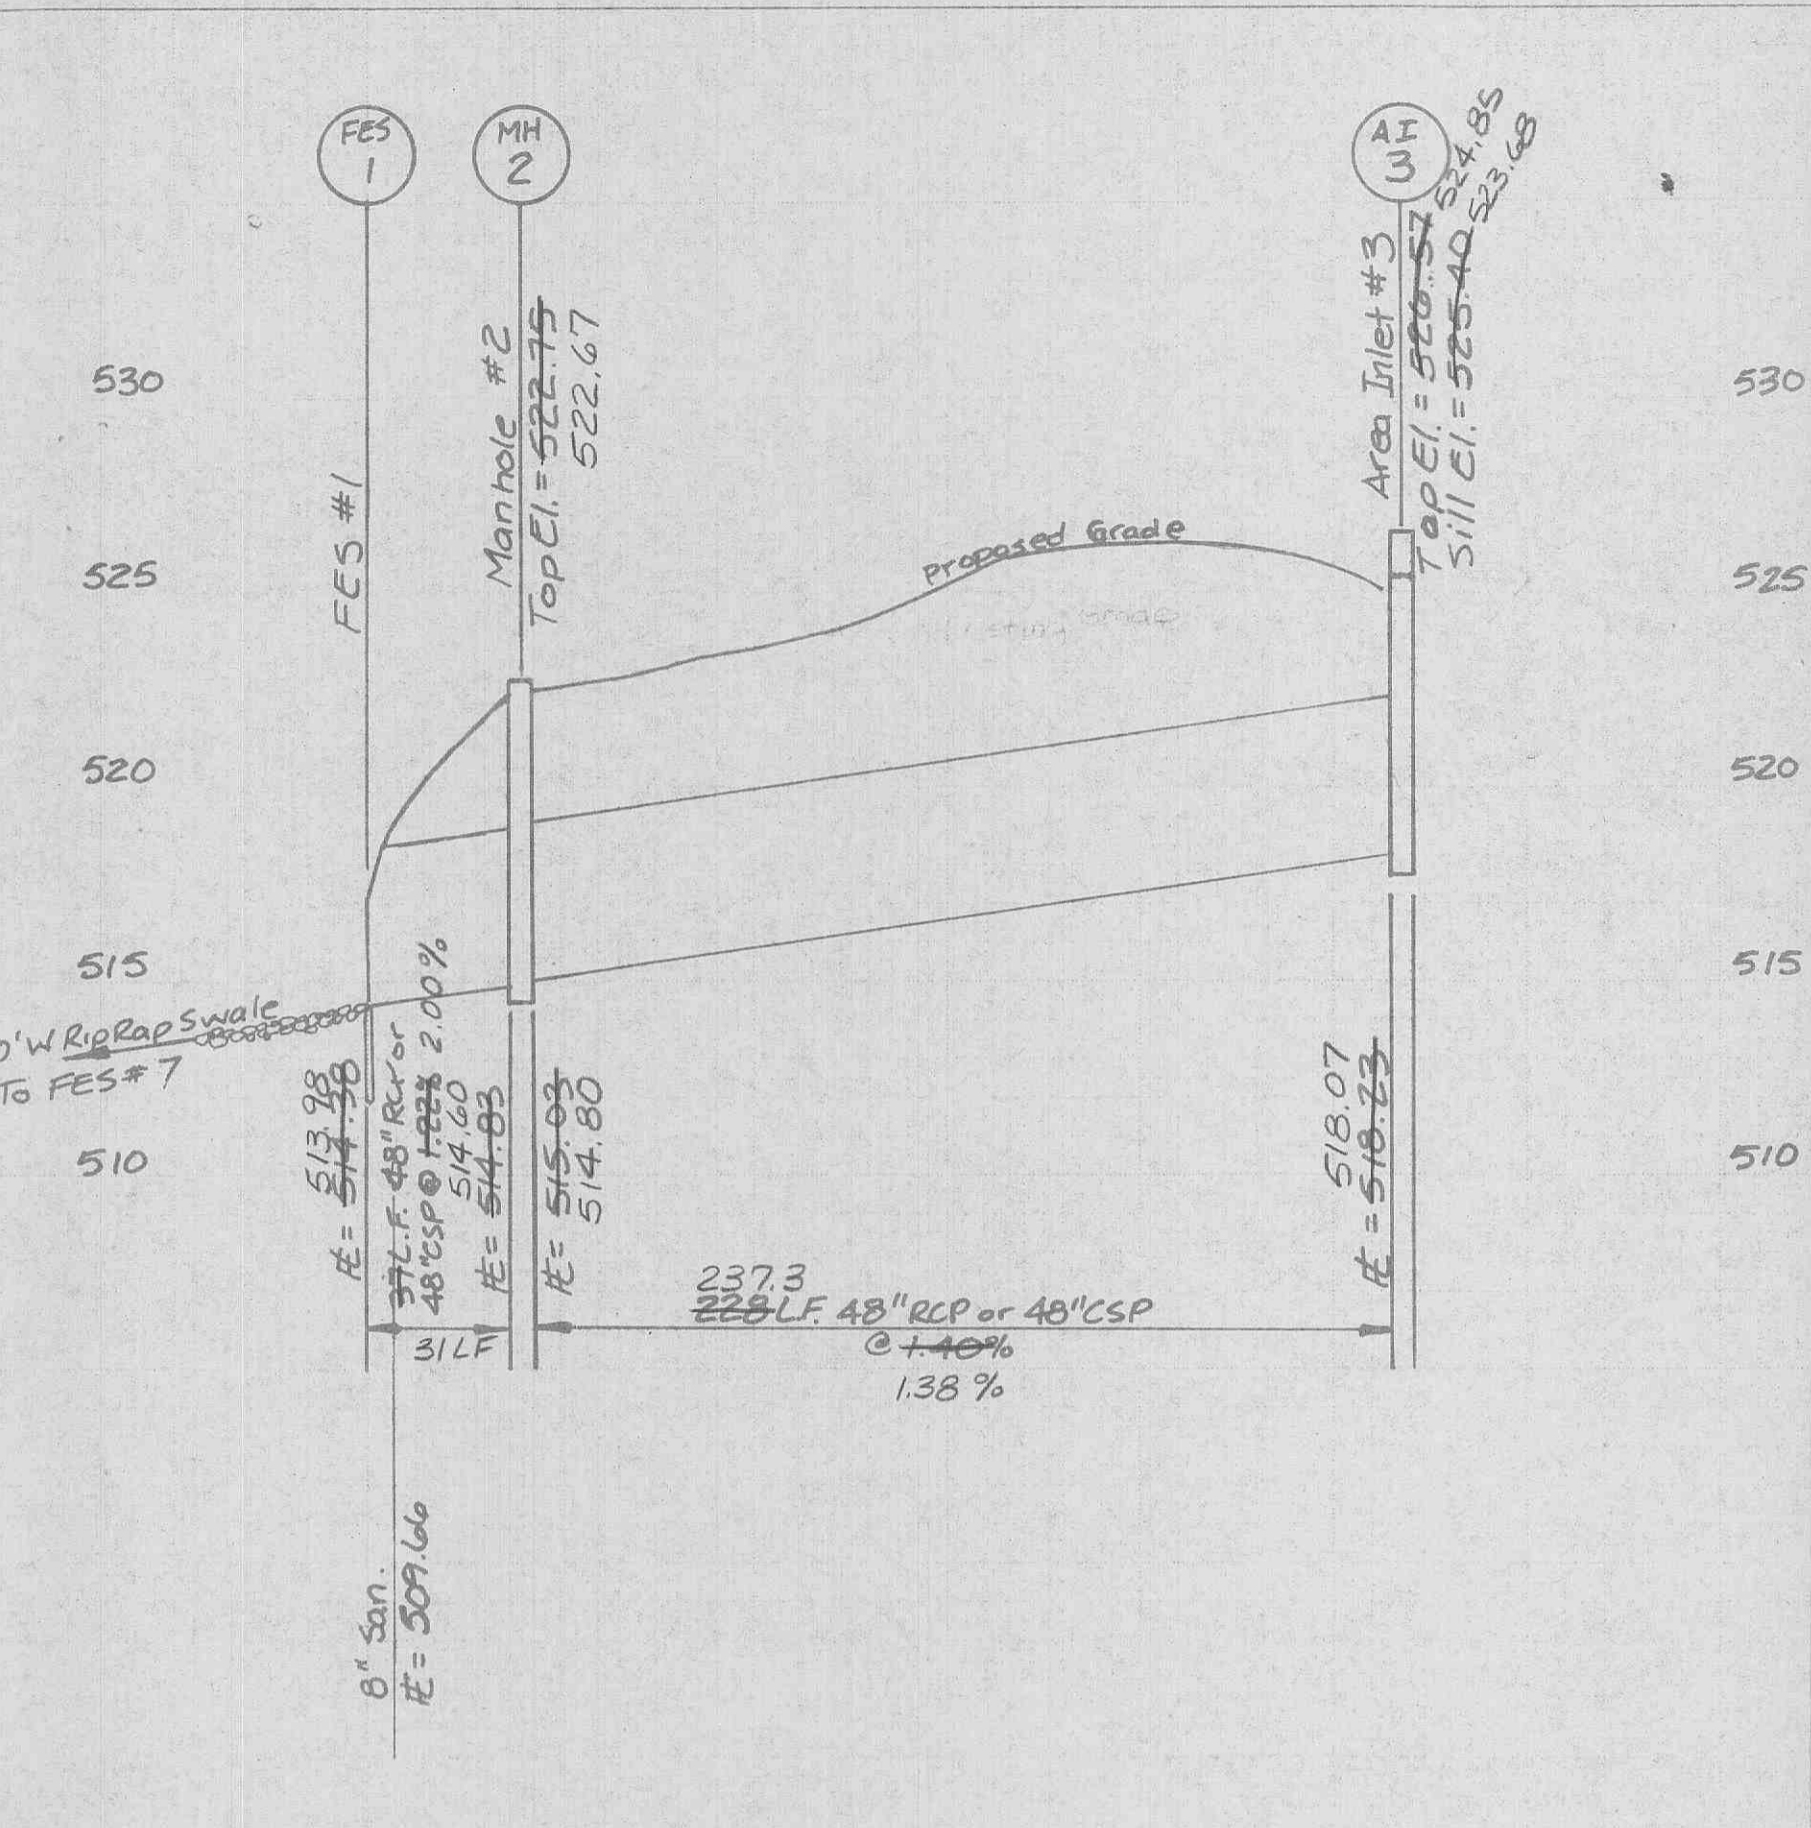


SCALE: 1" = 50' HORIZONTAL

1" = 5' VERTICAL
AS BUILT SEWER PROFILES

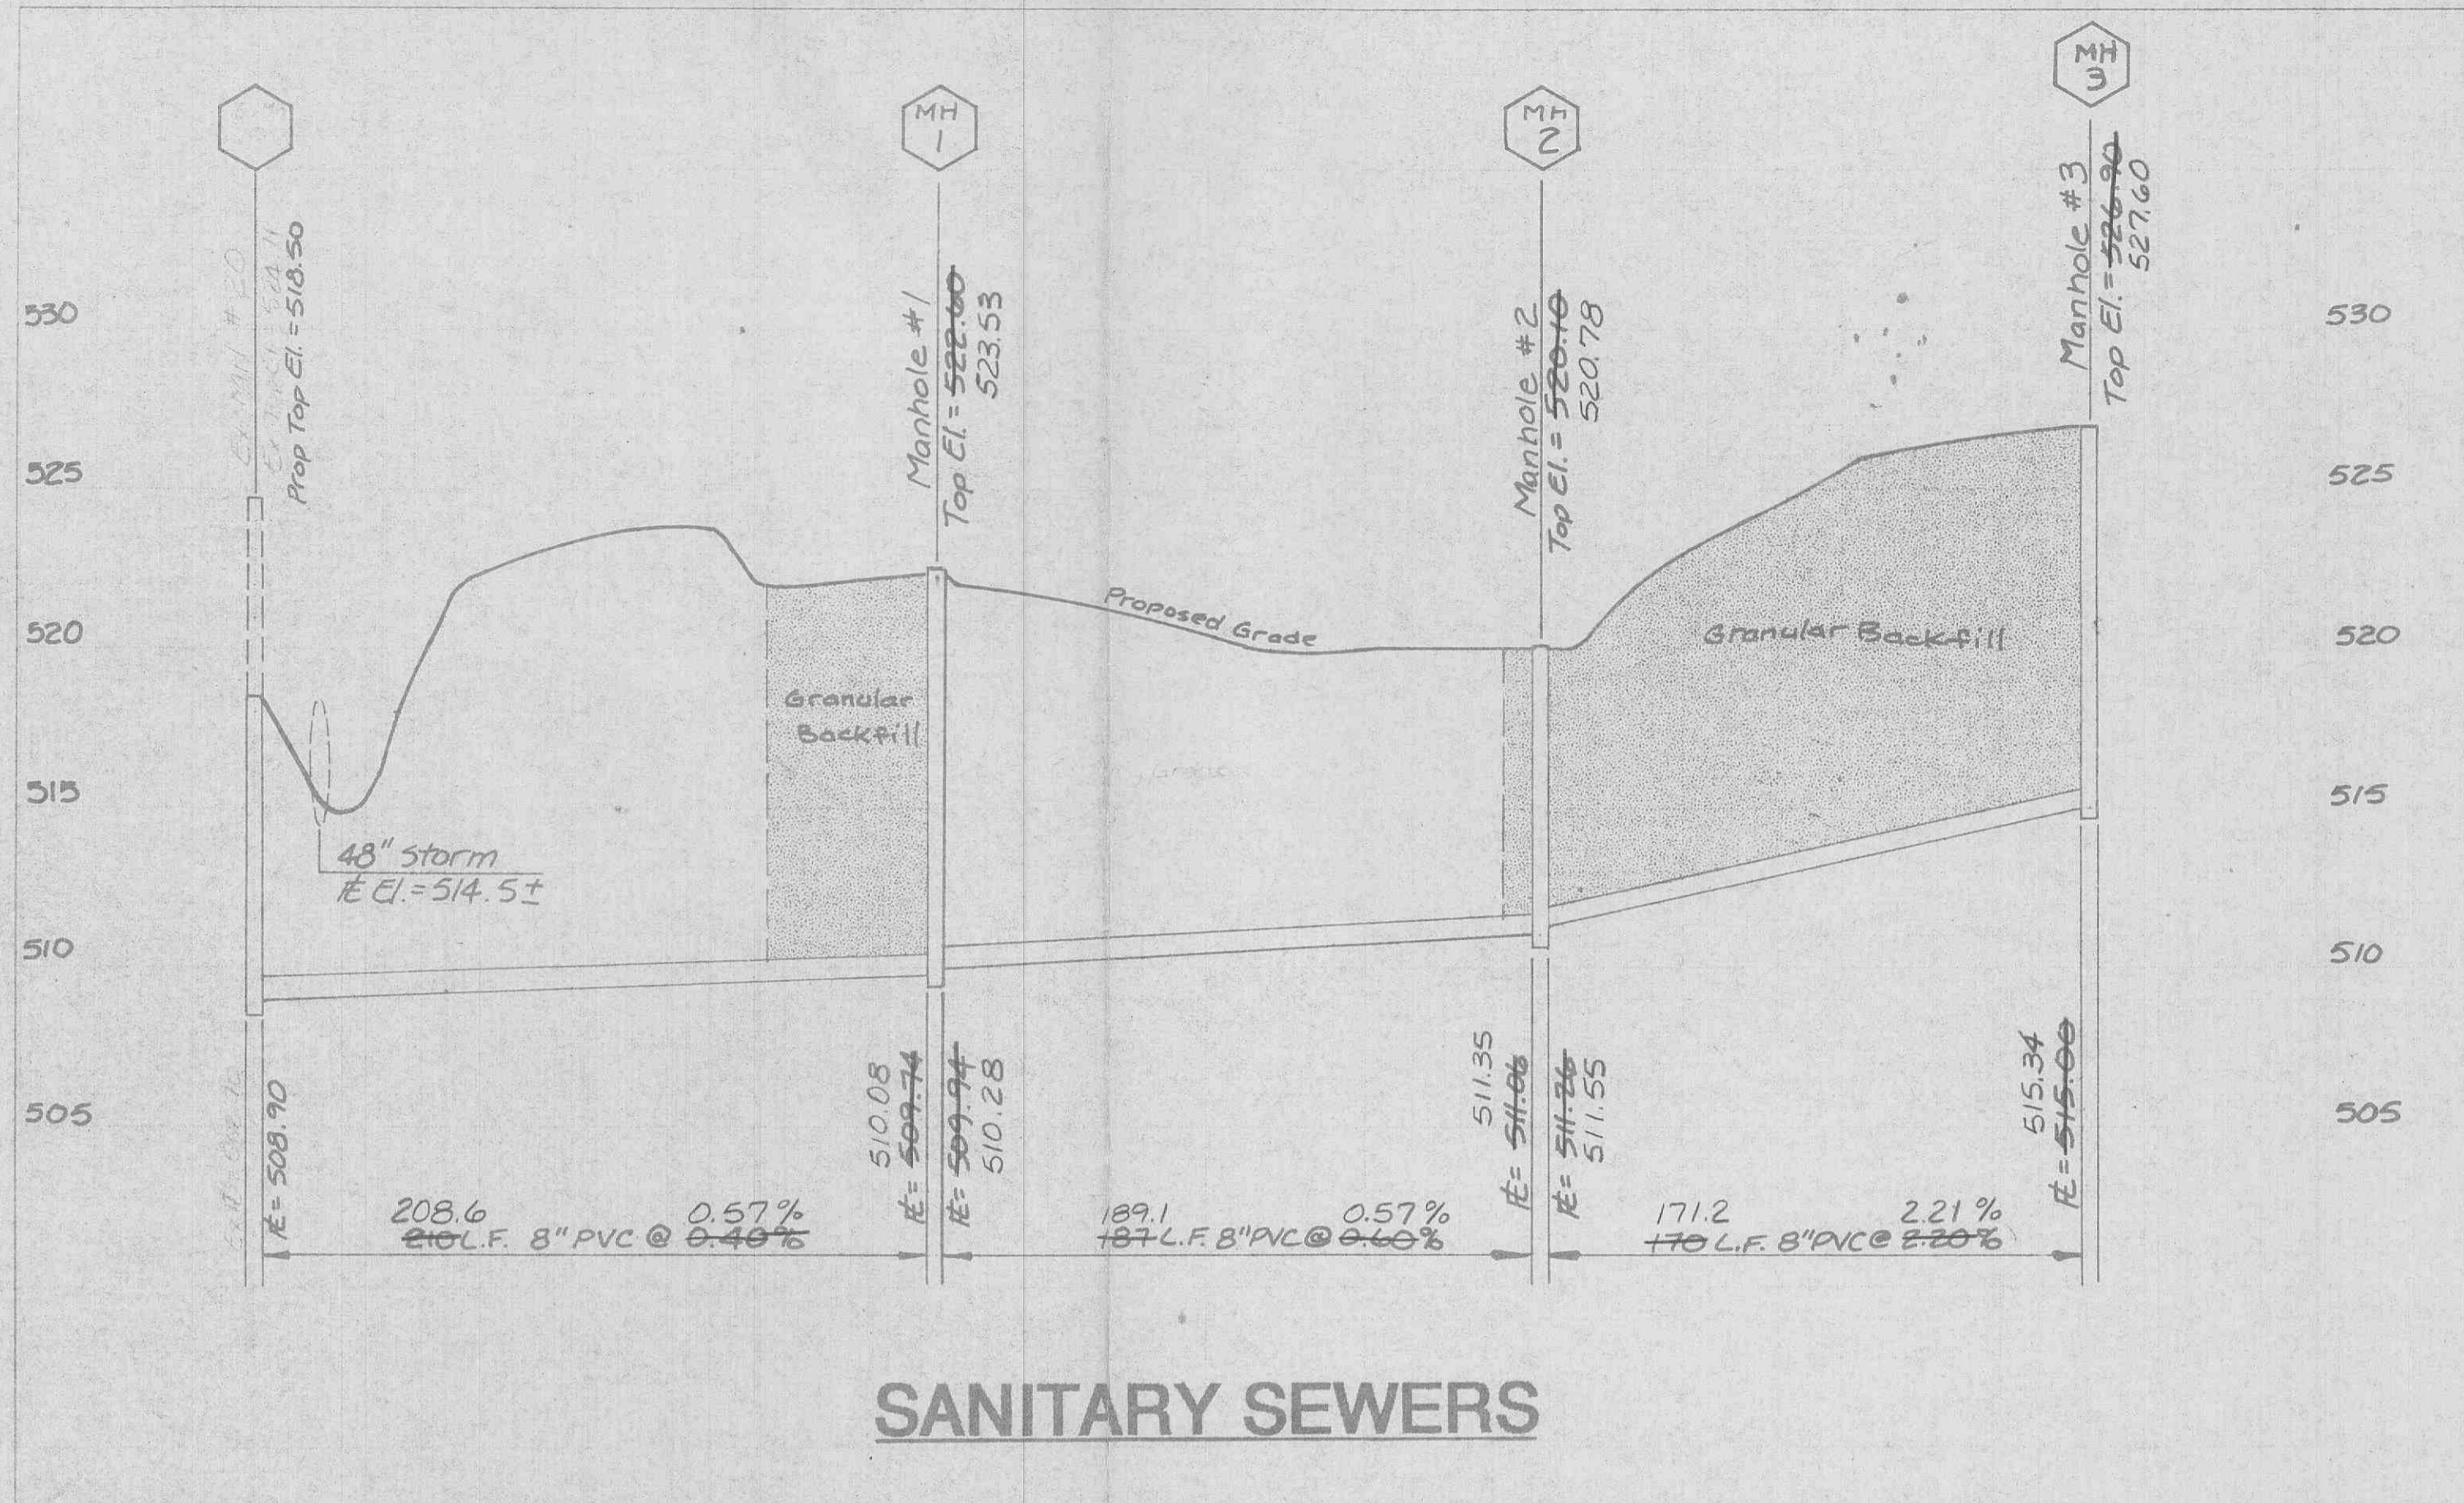

STORM SEWERS

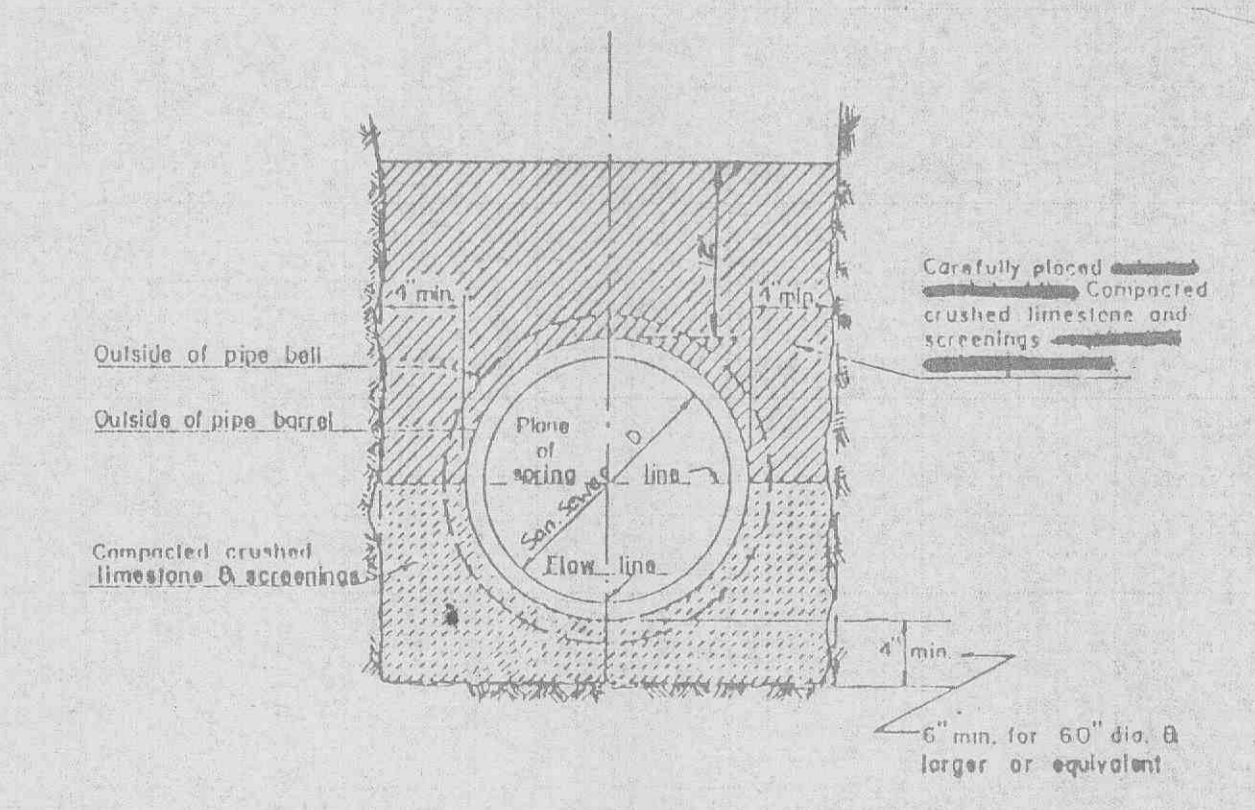

PVC PIPE
 PIPE BEDDING DETAIL
 N.T.S.

STORM STRUCTURES				
STRUCTURE	STA	DISTANCE	STREET	
FES #1	2+79	170' RT	FAWN RIDGE DRIVE	
MH #2	2+61	177.5' RT	FAWN RIDGE DRIVE	
AI #3	1+28	118' RT	FAWN RIDGE DRIVE	
FES #4	5+08.5	131' RT	FAWN RIDGE DRIVE	
AI #5	4+11.17	120' RT	FAWN RIDGE DRIVE	
OFS #6	3+98	161' RT	FAWN RIDGE DRIVE	
FES #7	3+65	172' RT	FAWN RIDGE DRIVE	
CI #8	4+11.17	17' RT	FAWN RIDGE DRIVE	
CI #9	4+11.17	17' LT	FAWN RIDGE DRIVE	
CI #10	5+18.8	17' LT	FAWN RIDGE DRIVE	
AI #11	6+38.17	20' LT	FAWN RIDGE DRIVE	
SANITARY STRUCTURES				
MH #1	2+49	19' LT	FAWN RIDGE DRIVE	
MH #2	4+45.4	25' LT	FAWN RIDGE DRIVE	
MH #3	1+98	-	FAWN OAKS COURT	
EX MH #19	4+45	135.5' RT	FAWN RIDGE DRIVE	
EX MH #20	2+76.5	191.5' RT	FAWN RIDGE DRIVE	
ADDITIONAL STORM STRUCTURES				
MH #12	3+27.5	17' LT	FAWN RIDGE DRIVE	
AI #13	2+75.5	100.02' LT	FAWN RIDGE DRIVE	