


SANITARY AND STORM SEWER AS-BUILTS THE MANORS AT ROYALLSPRINGS PLAT SIX

A TRACT OF LAND BEING PART OF U.S. SURVEY 3180
AND PART OF U.S. SURVEY 67
TOWNSHIP 46 NORTH, RANGE 3 EAST,
OF THE FIFTH PRINCIPAL MERIDIAN
ST. CHARLES COUNTY, MISSOURI

THIS IS TO CERTIFY THAT THE FOLLOWING AS-BUILT LOCATIONS WERE
LOCATED IN THE FIELD AND ARE CORRECTLY SHOWN HEREIN.



AS-BUILTS ADDED JANUARY, 1995

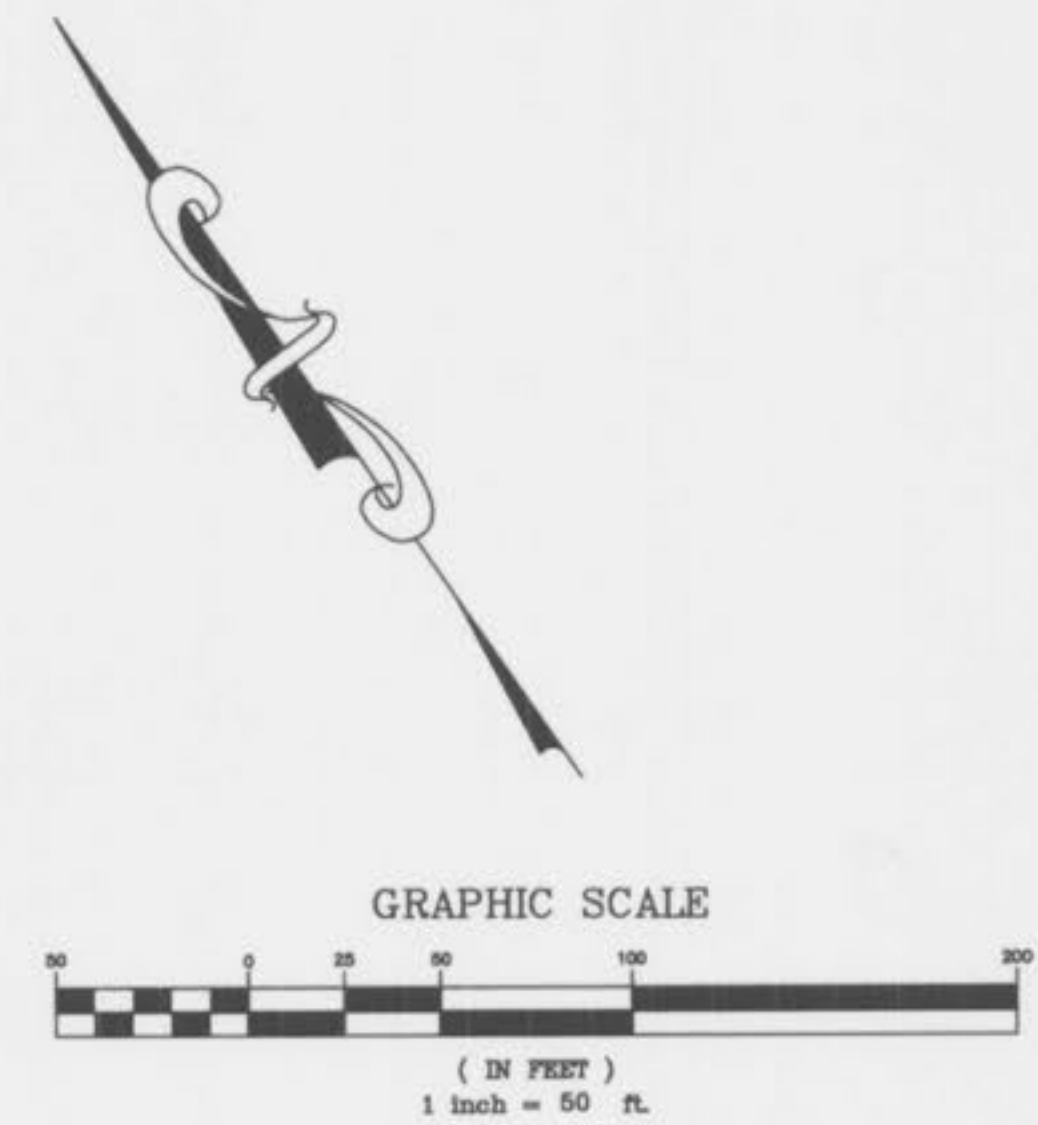

PREPARED FOR: MLS Homes, Inc.
11443 St. Charles Rock Road
Bridgeton, MO 63044
314/739-2110

DISCLAIMER OF RESPONSIBILITY
I hereby certify that the documents intended to be authorized by my seal are limited to the sheet, and I hereby disclaim any responsibility for all other drawings, specifications, estimates, reports or other documents or instruments existing in or intended to be used for any part or parts of the architectural or engineering project or survey.

Copyright 1994
Box Engineering Company, Inc.
All Rights Reserved

REVISIONS

| | |
|--|--|
| | |
| | |
ENGINEERING
PLANNING
SURVEYING

221 Point West Boulevard
St. Charles, MO. 63301
314-946-6588
314-724-3330
FAX 947-9182

JANUARY, 1995
DATE
93-3774
PROJECT NUMBER
1 OF 4
SHEET OF
3774ASBT.DWG
FILE NAME
D.R.K.
DRAWN CHECKED

The Manors at Royall Springs
Plat Six As-Built 1/4

Scale: 1" = 50' Hor.
1" = 10' Vert.

FINAL SURVEY
NOTICE: THIS IS A TEMPLATE
NO FIELD CHANGES

ORIGINAL SURVEY
NOTICE: THIS IS A TEMPLATE
NO FIELD CHANGES

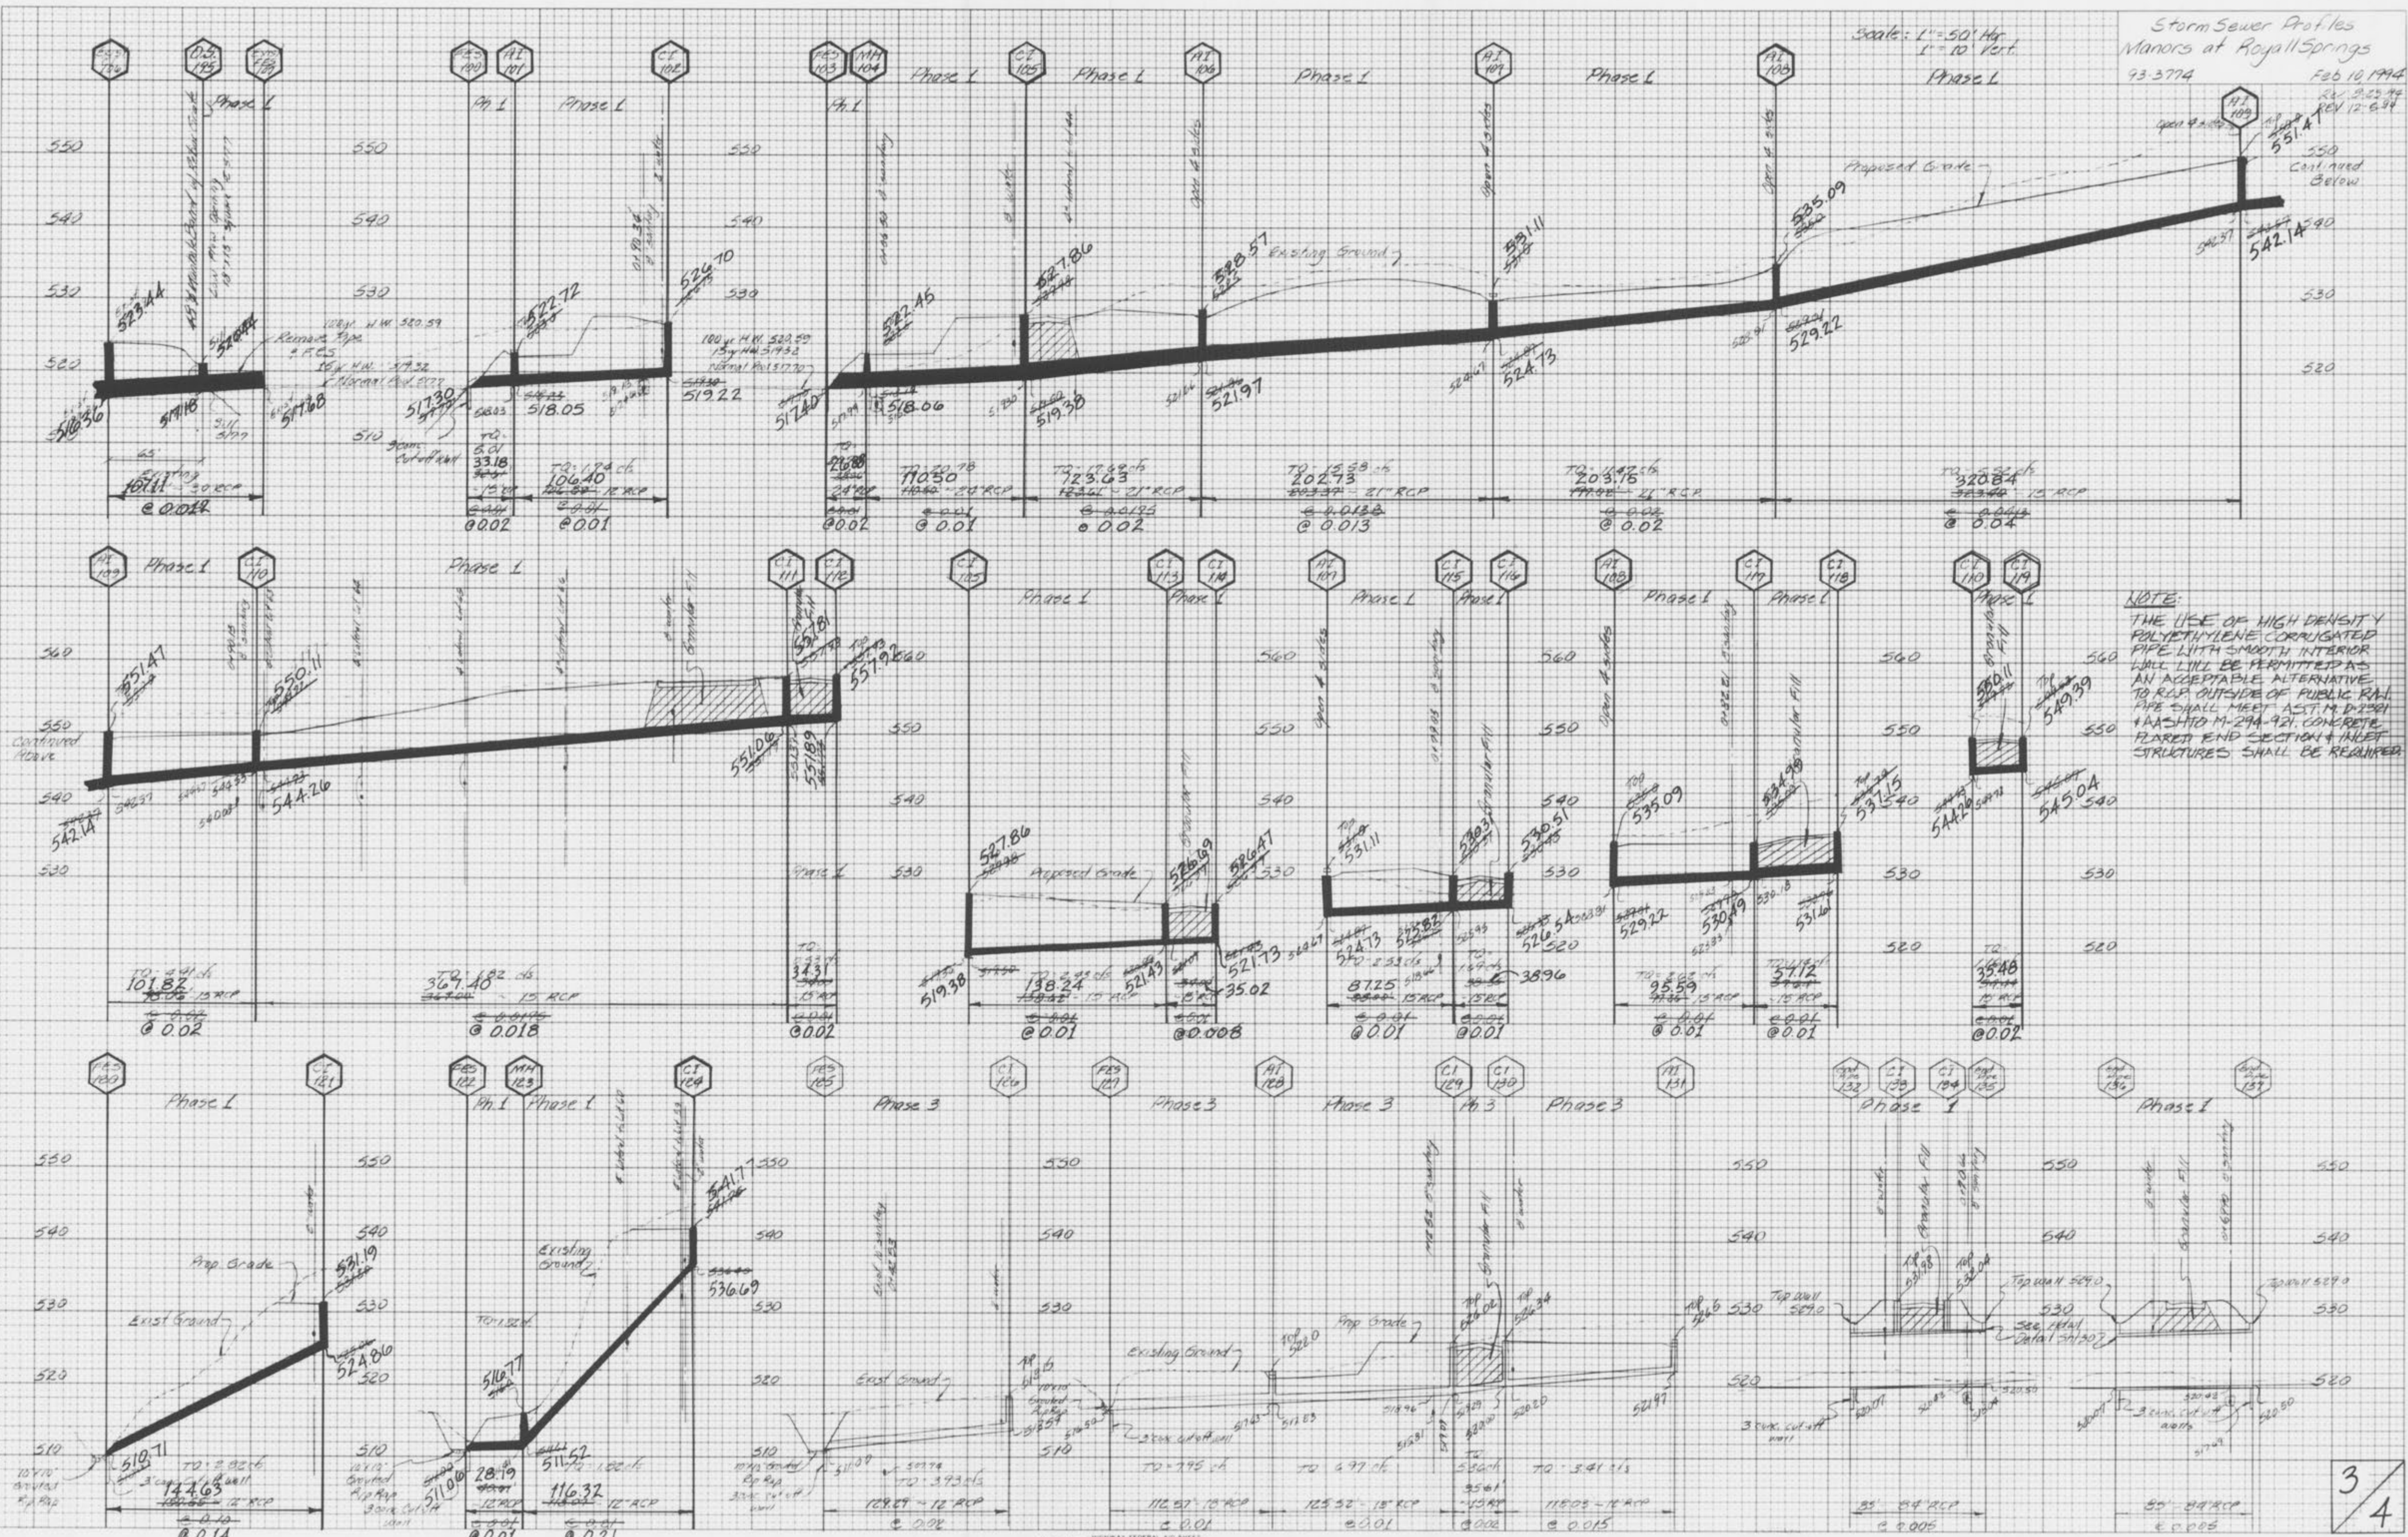


PLATE 3-FULL CROSS SECTION FULL LINE
TELEPHONE
PRINTED IN U.S.A.

AS-BUILTS ADDED JANUARY, 1995

