

SANITARY SEWERS, STORM SEWERS AND
WATER MAINS AS-BUILTS



THE MANORS AT ROYALLSPRINGS PLAT NINE

A TRACT OF LAND BEING PART U.S. SURVEYS 3180 AND
PART OF FRACTIONAL SECTION 5,
TOWNSHIP 46 NORTH, RANGE 3 EAST
OF THE FIFTH PRINCIPAL MERIDIAN,
ST. CHARLES COUNTY, MISSOURI

THIS IS TO CERTIFY THAT WE HAVE DURING THE MONTH OF DECEMBER, 1998,
BY ORDER OF MLS HOMES, INC., EXECUTED AN AS-BUILT SURVEY OF THE
EXISTING SANITARY SEWERS, STORM SEWERS, FIRE HYDRANTS AND WATER
VALVES WITHIN "THE MANORS AT ROYALLSPRINGS" PLAT NINE, A SUBDIVISION
ACCORDING TO THE PLAT THEREOF RECORDED IN PLAT BOOK 35, PAGE 106
OF THE ST. CHARLES COUNTY RECORDS. THE SANITARY LATERALS THAT ARE SHOWN
WERE TAKEN FROM INFORMATION SUPPLIED TO BAX ENGINEERING BY THE SEWER
CONTRACTOR, THEREFORE THEIR LOCATION IS ASSUMED APPROXIMATE. ALL
SEWERS SHOWN LIE WITHIN THE EASEMENTS AS SHOWN ON SAID RECORDED
SUBDIVISION PLAT UNLESS OTHERWISE NOTED. THE RESULTS OF THIS AS-BUILT
SURVEY ARE SHOWN ON THIS PLAT TO THE BEST OF MY KNOWLEDGE AND BELIEF.

Darrel R. Oakley
LS-2265
3-9-98

BAX ENGINEERING COMPANY, INC.
DARREL R. OAKLEY
MISSOURI REGISTERED LAND SURVEYOR #2265

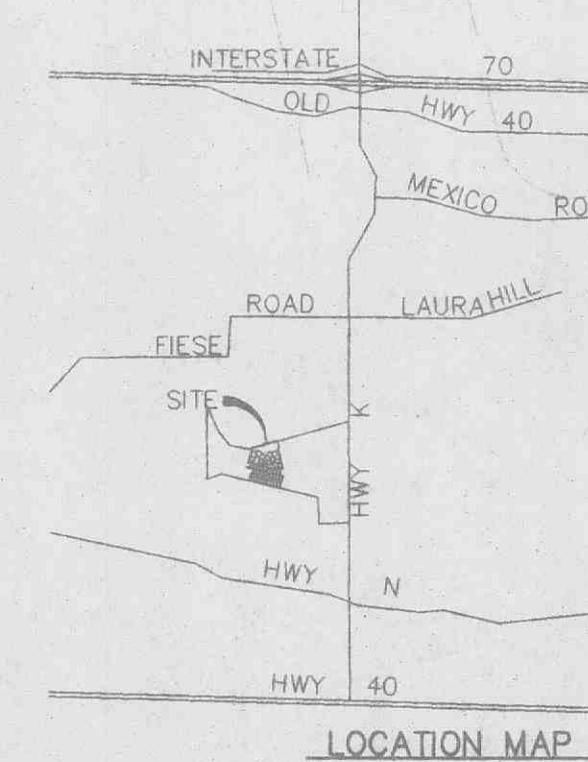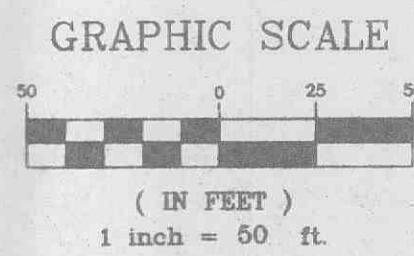

SHEET INDEX

- 1 OF 4 - FLAT PLAN
- 2 OF 4 - SANITARY PROFILES
- 3 OF 4 - SANITARY AND STORM PROFILES
- 4 OF 4 - STORM PROFILES

SANITARY AND STORM SEWER AS-BUILTS
AS-BUILTS ADDED DECEMBER, 1998

PROPERTY OF
RAYMOND A. DICKHERRER
BK. 1362 RS. 367


RECEIVED
SEP 18 1998

PREPARED FOR:
MLS HOMES, INC.
11443 ST. CHARLES ROCK ROAD
BRIDGETON, MO 63044
(314) 739-2110

DISCLAIMER OF RESPONSIBILITY
I hereby certify that the documents enclosed
to be true and correct to the best of my knowledge and are limited to
use for the above drawings. Specifications,
Estimates, Reports or other documents or
instruments relating to or intended to be used
for any part or parts of the architectural or
engineering project or survey.

Copyright 1998
Bax Engineering Company, Inc.
All Rights Reserved

REVISIONS

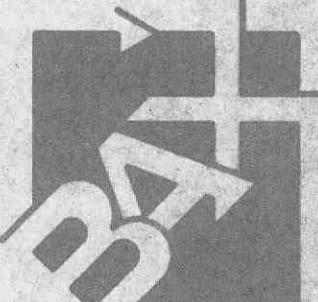

ENGINEERING
PLANNING
SURVEYING

■ 1052 South Cloverleaf Drive
St. Peters, MO 63376-6445
314-928-5552
FAX 928-1718


12-29-98
DATE


93-3774
PROJECT NUMBER

1 OF 4
SHEET OF


3774ASBLT9.DWG
FILE NAME

DWM DRAWN DRO CHECKED

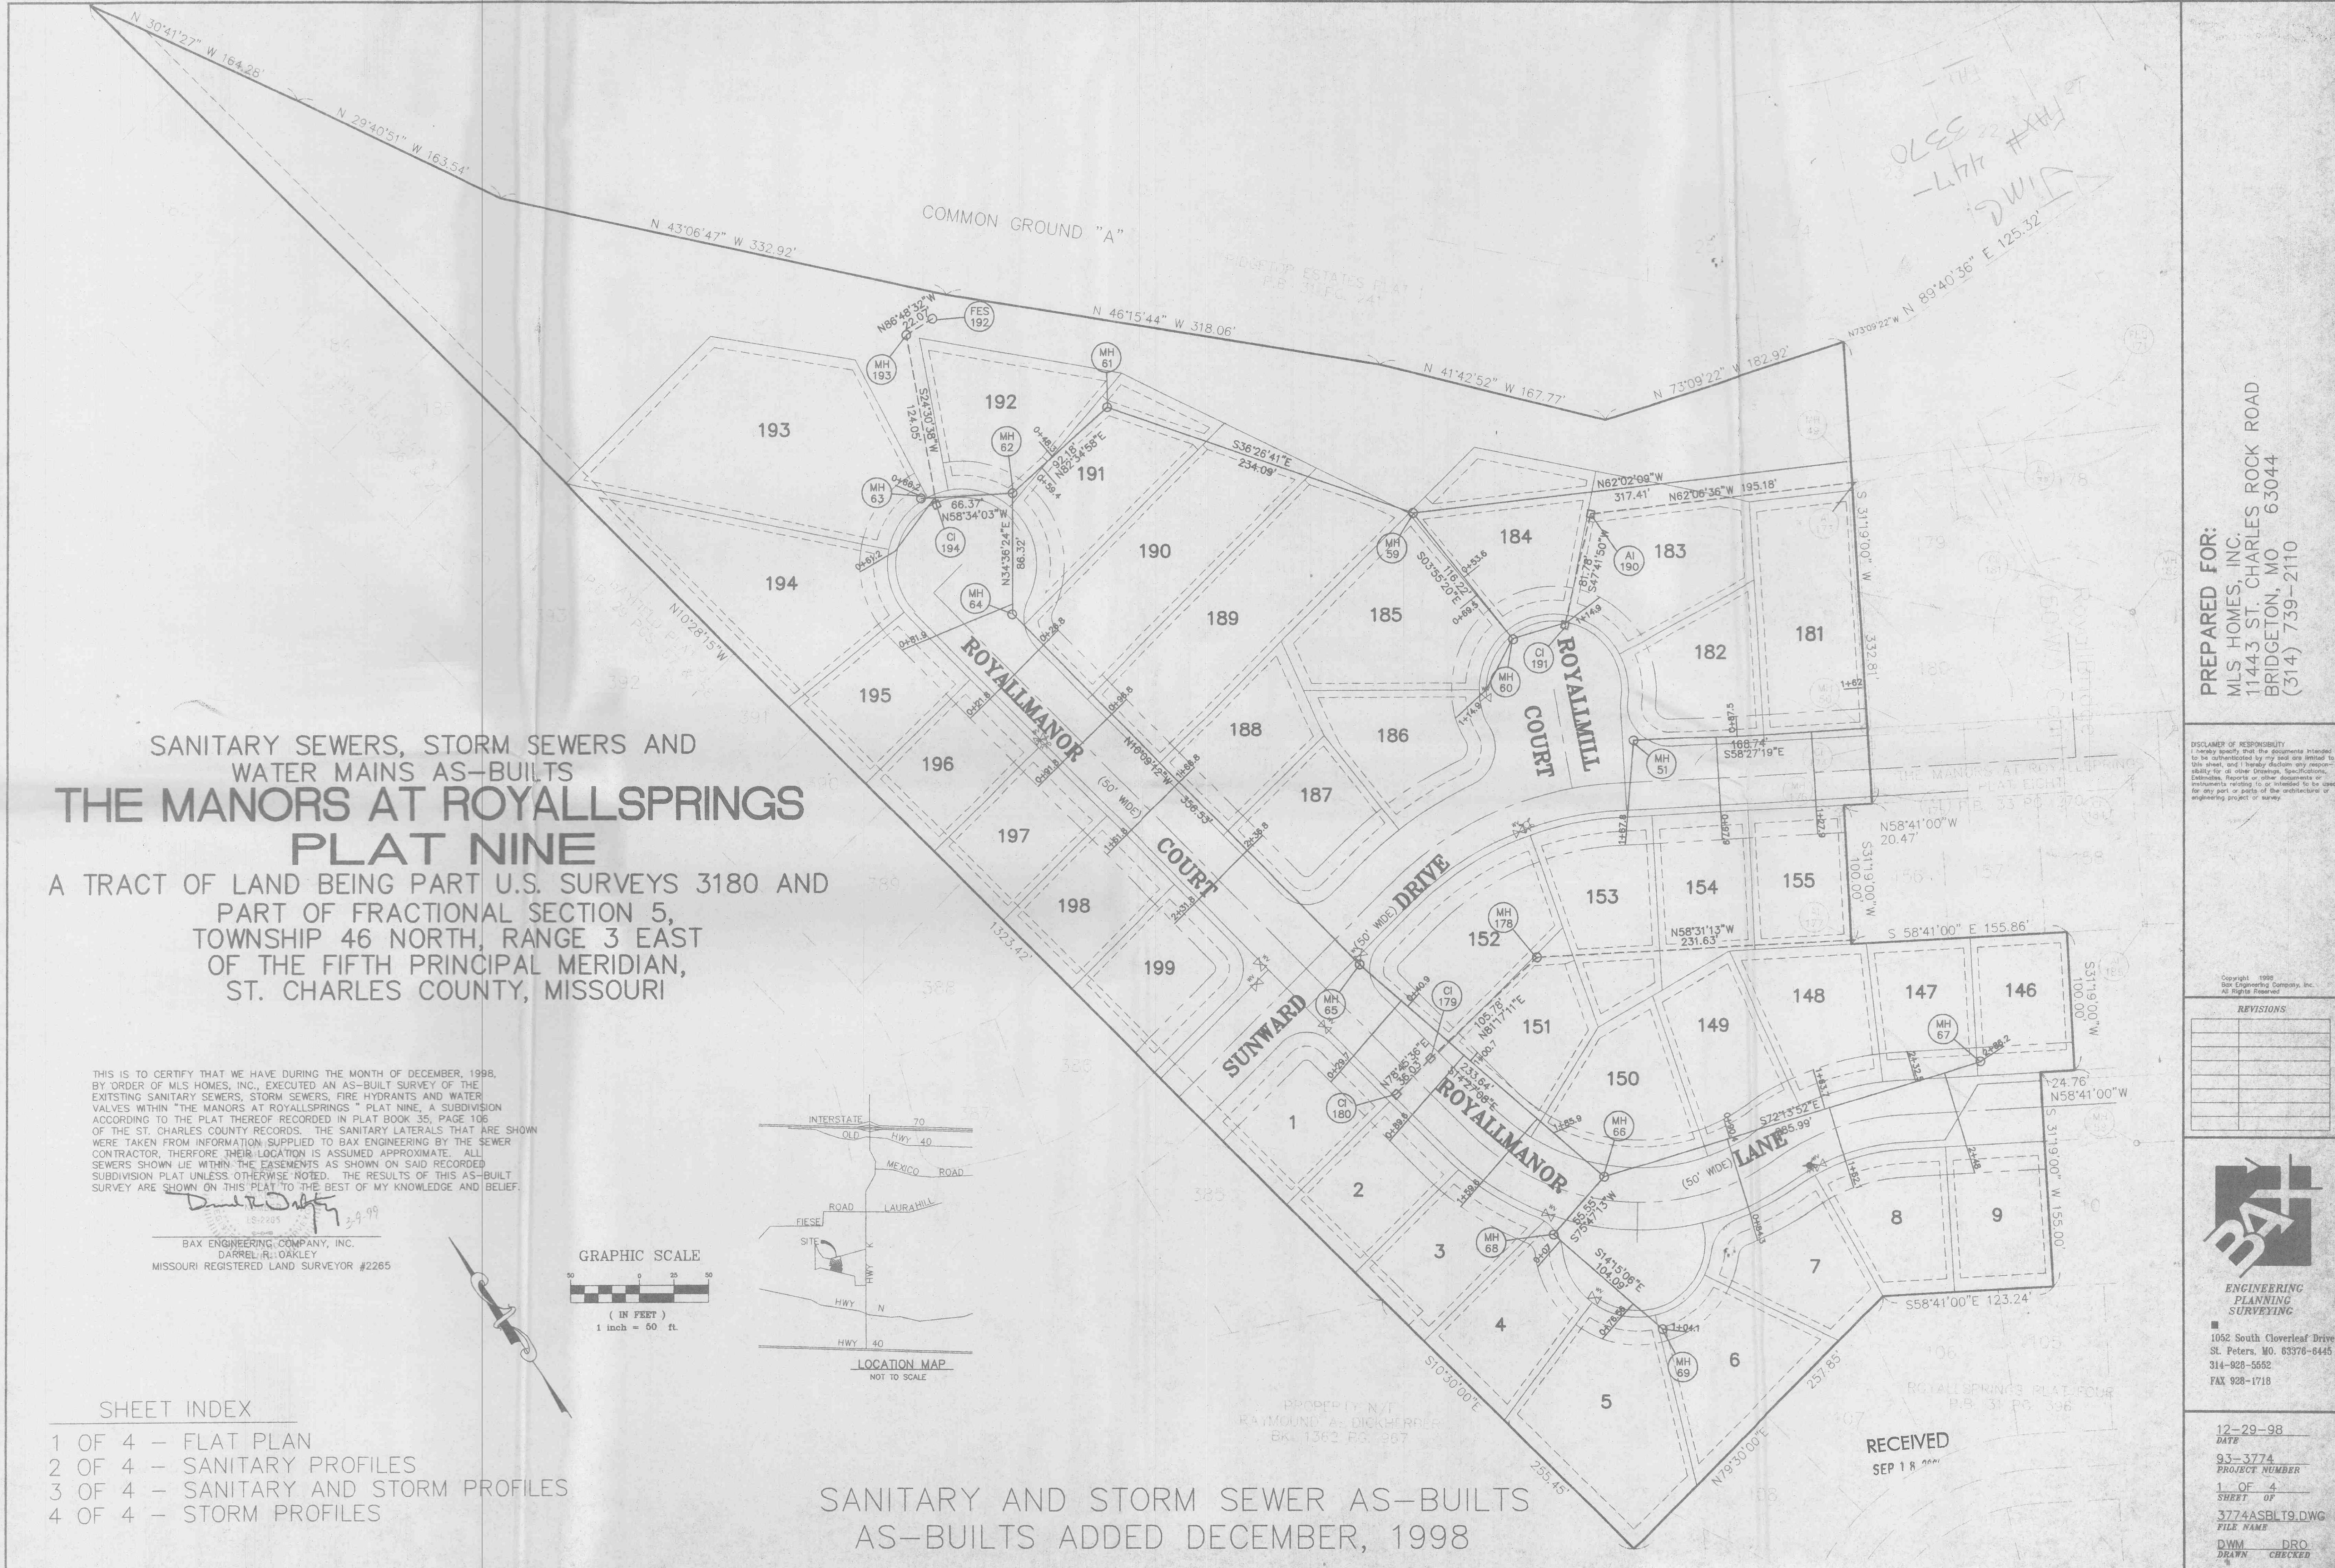

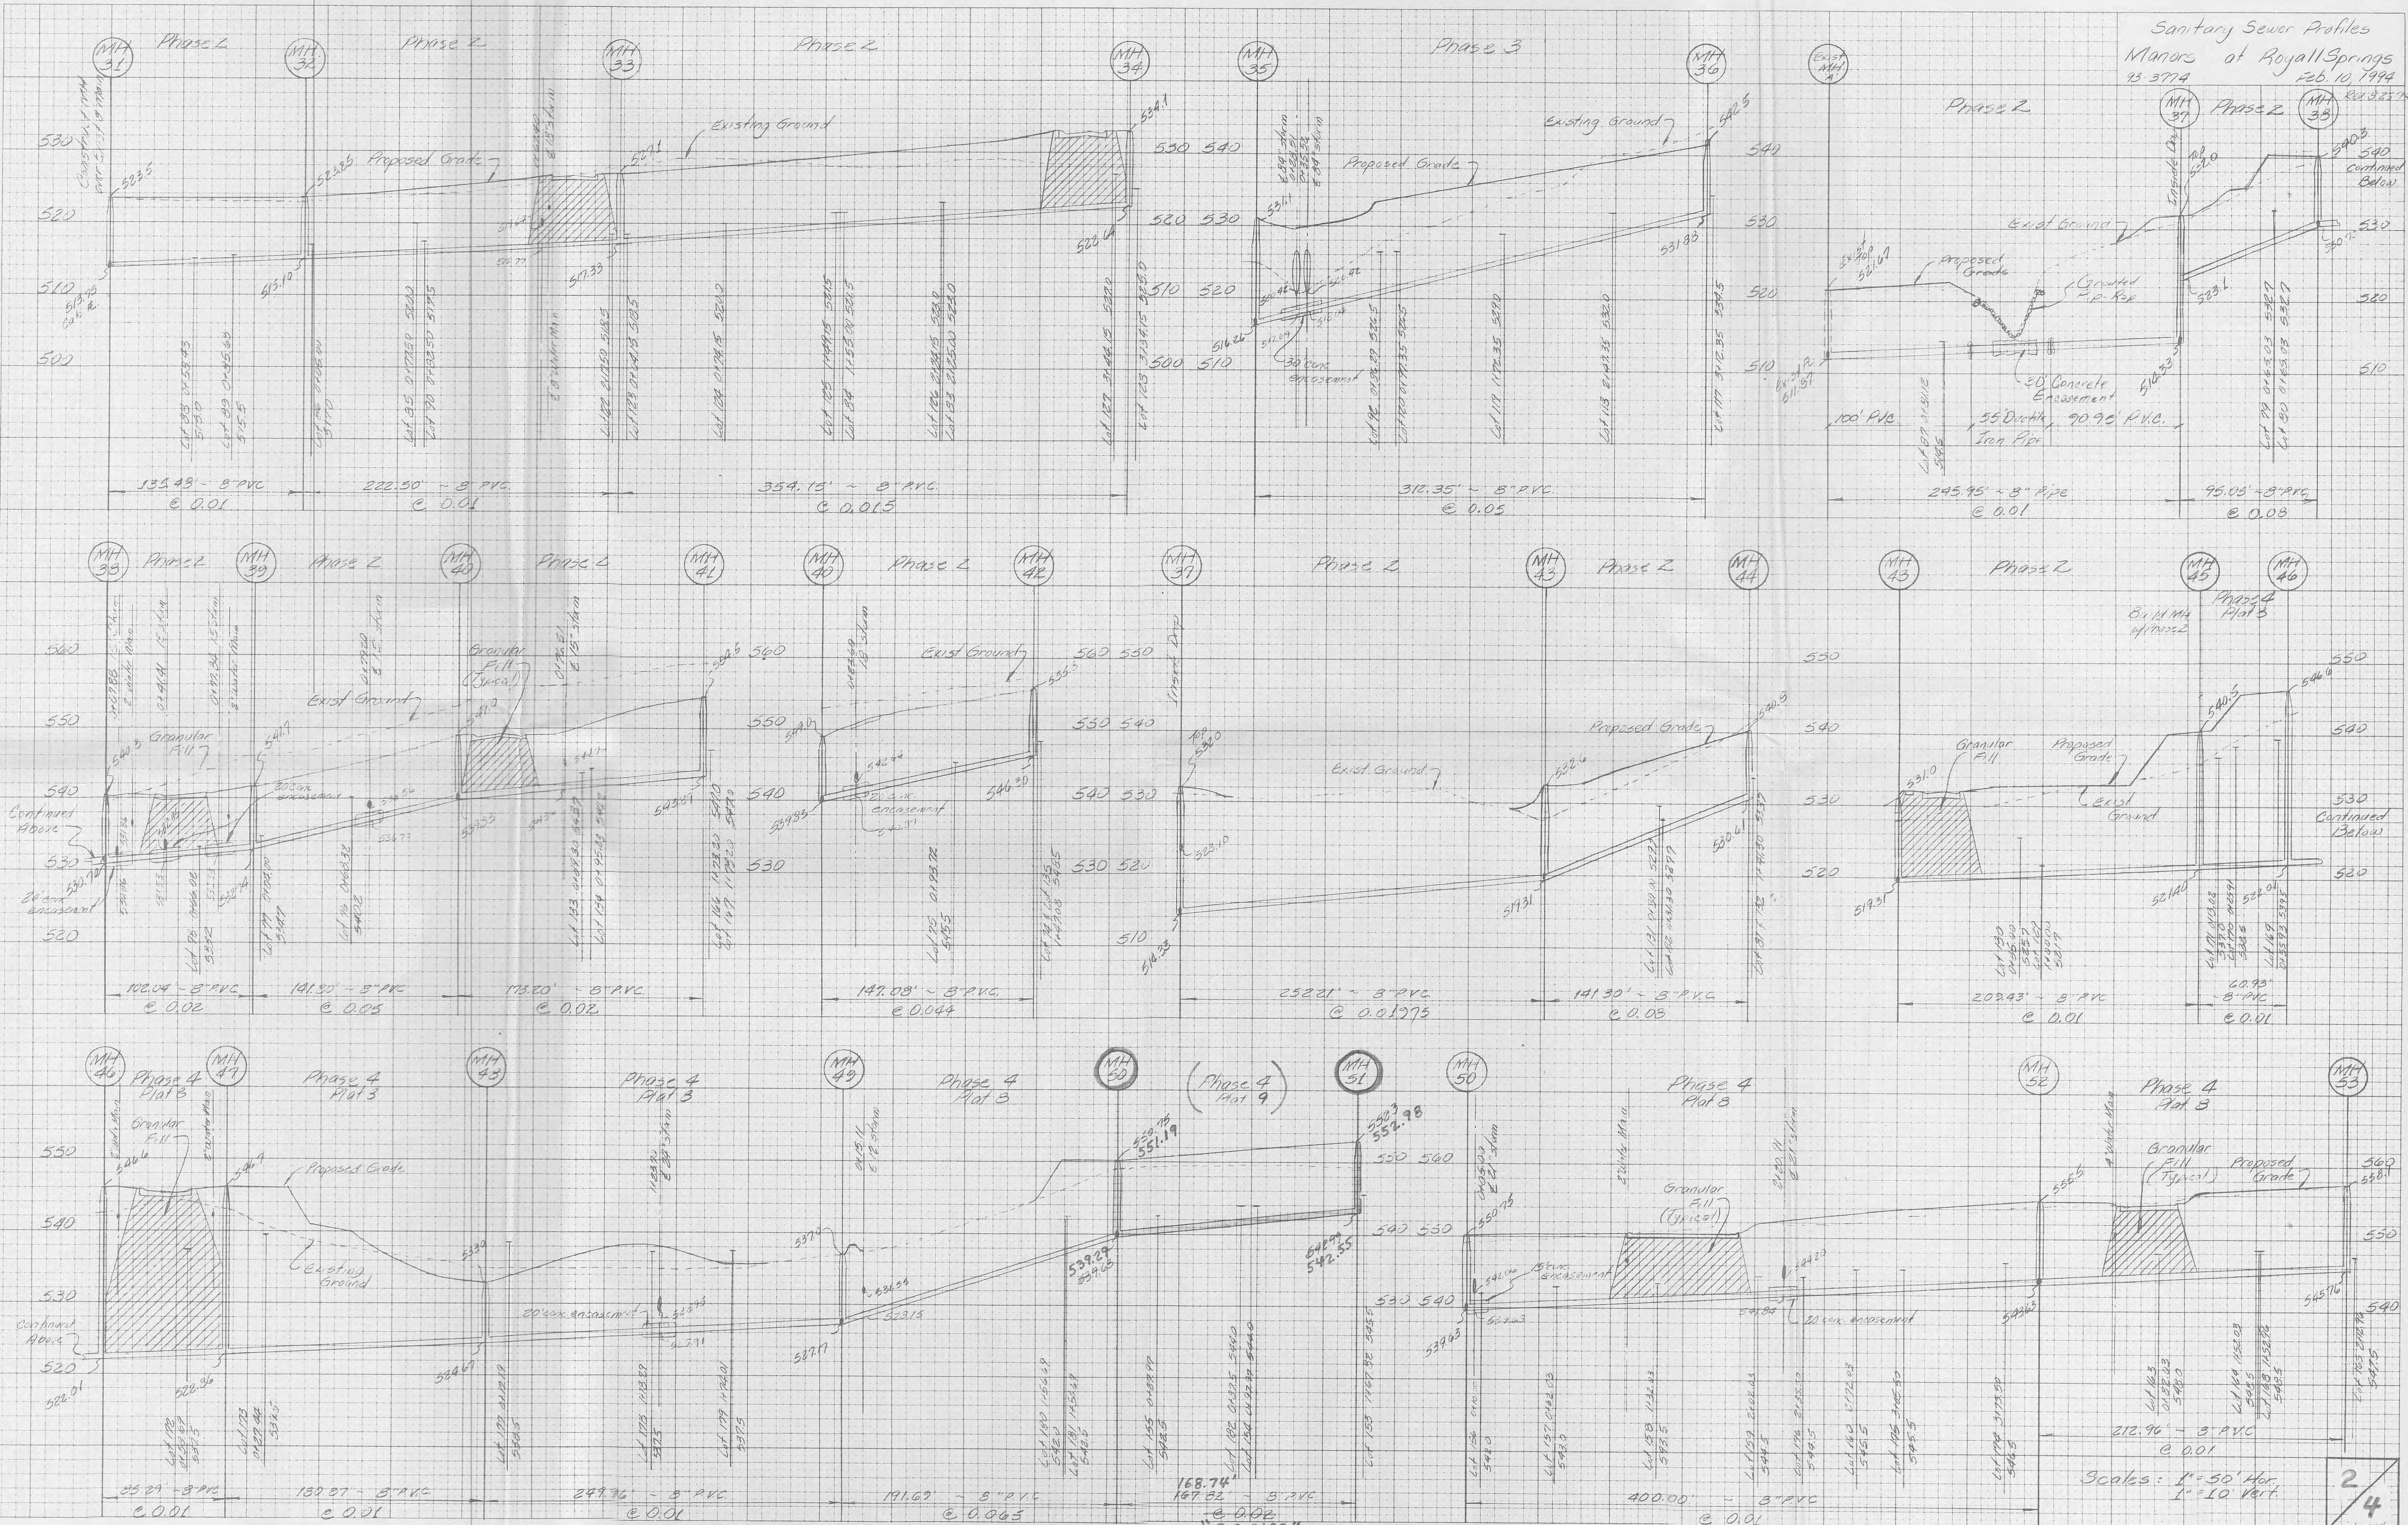


"AS-BUILTS ADDED DECEMBER, 1998"

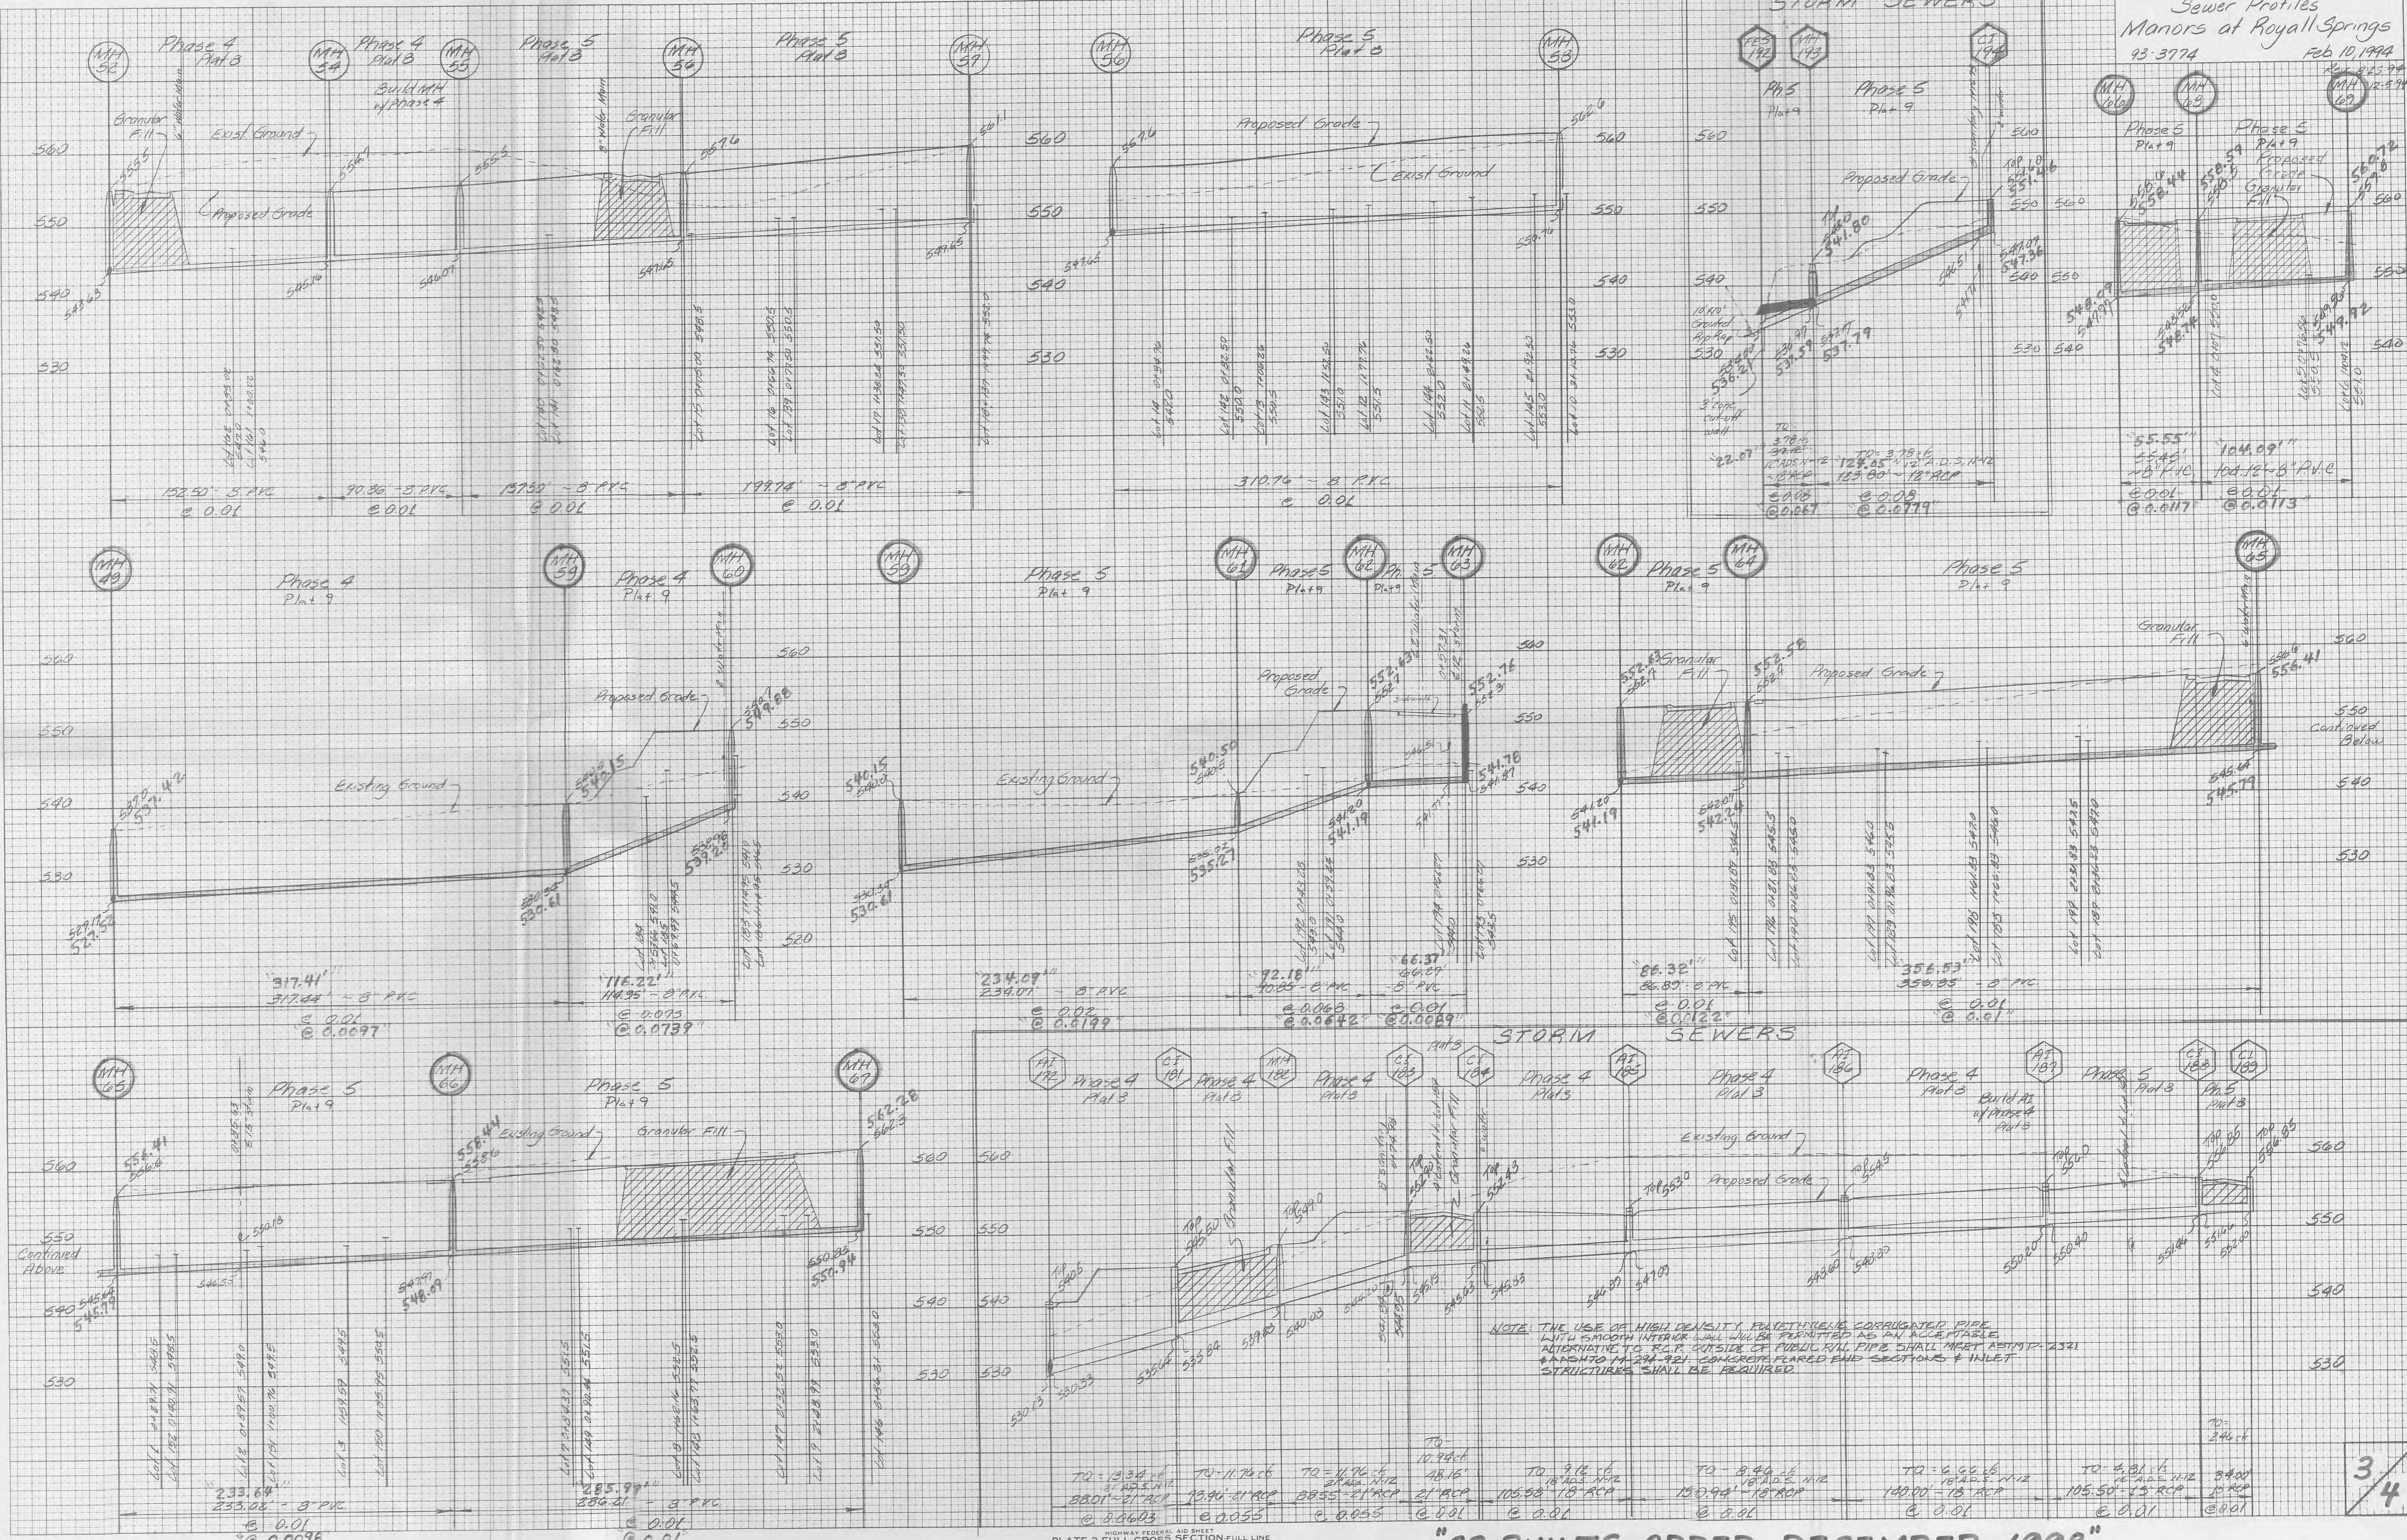

"AS-BUILTS ADDED DECEMBER, 1998"

Storm Sewer Profiles
Manors at Royal Springs
93-3774 Feb. 10, 1994

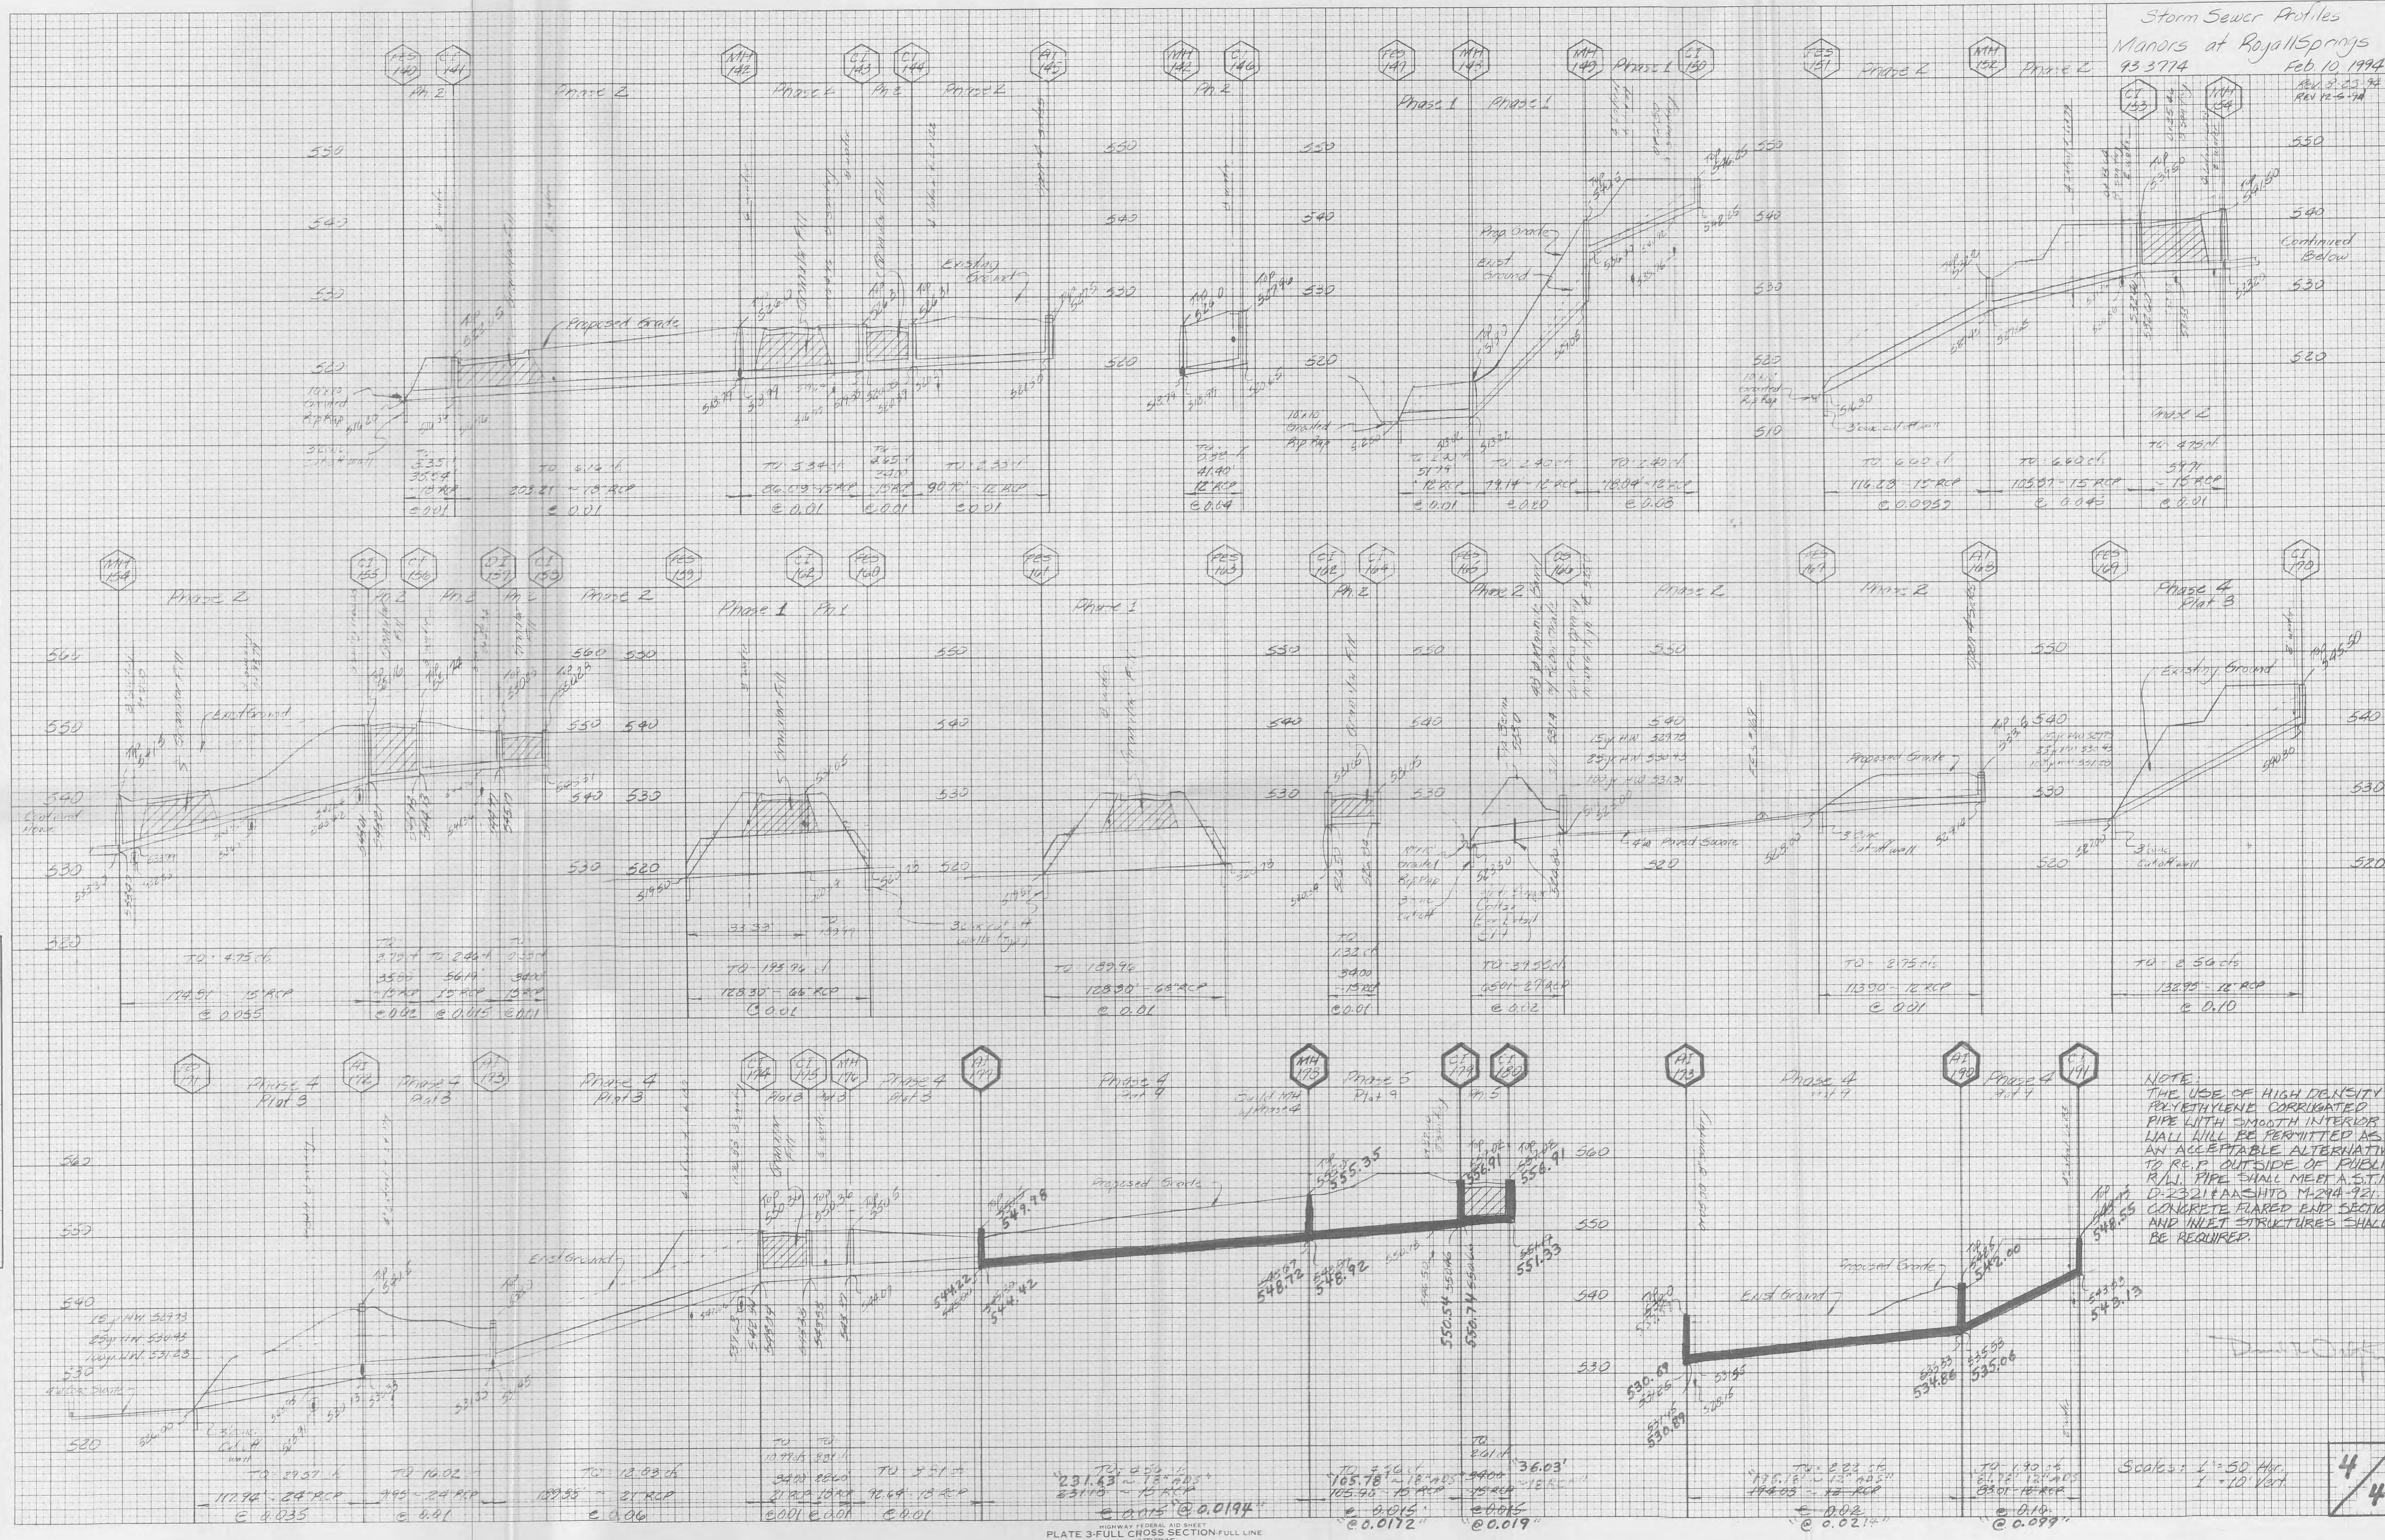

"AS-BUILTS ADDED DECEMBER, 1998"