


STORM WATER SEWER AS-BUILT RYDER VEHICLE SALES


A TRACT OF LAND BEING IN SECTION 25 & 26,
TOWNSHIP 47 NORTH, RANGE 2 EAST,
ST. CHARLES COUNTY, MISSOURI

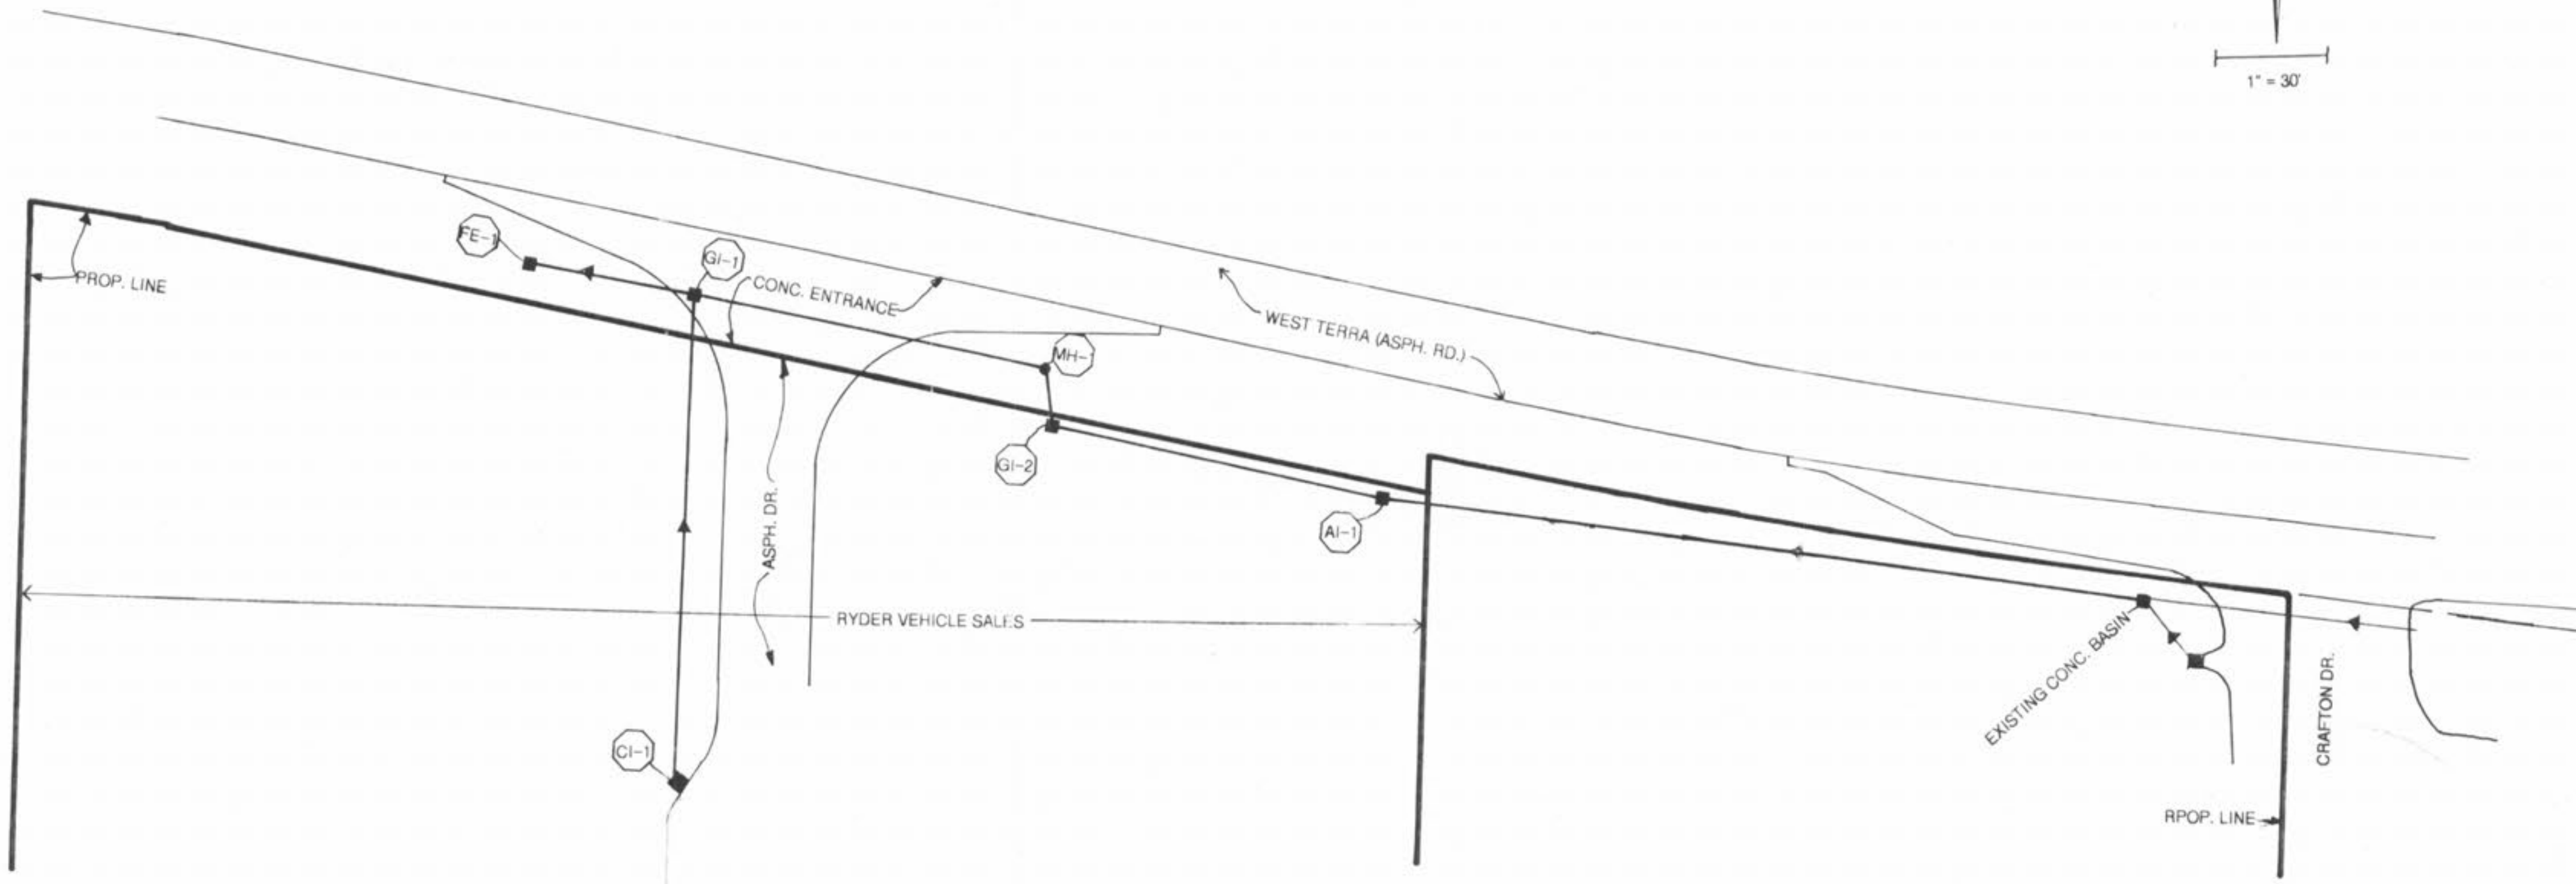

| | | | |
|------|------|----|---------|
| PLAN | DATE | BY | CHECKED |
| | | | |
| | | | |
| | | | |

STORM SEWER PROFILES STORM SEWER EXTENSION

THE STORM SEWERS SHOWN ARE EXISTING, AND ARE REPRESENTED AS THEY ARE CONSTRUCTED IN THE FIELD. THEY WERE NOT DESIGNED BY METTS & ASSOCIATES, INC.

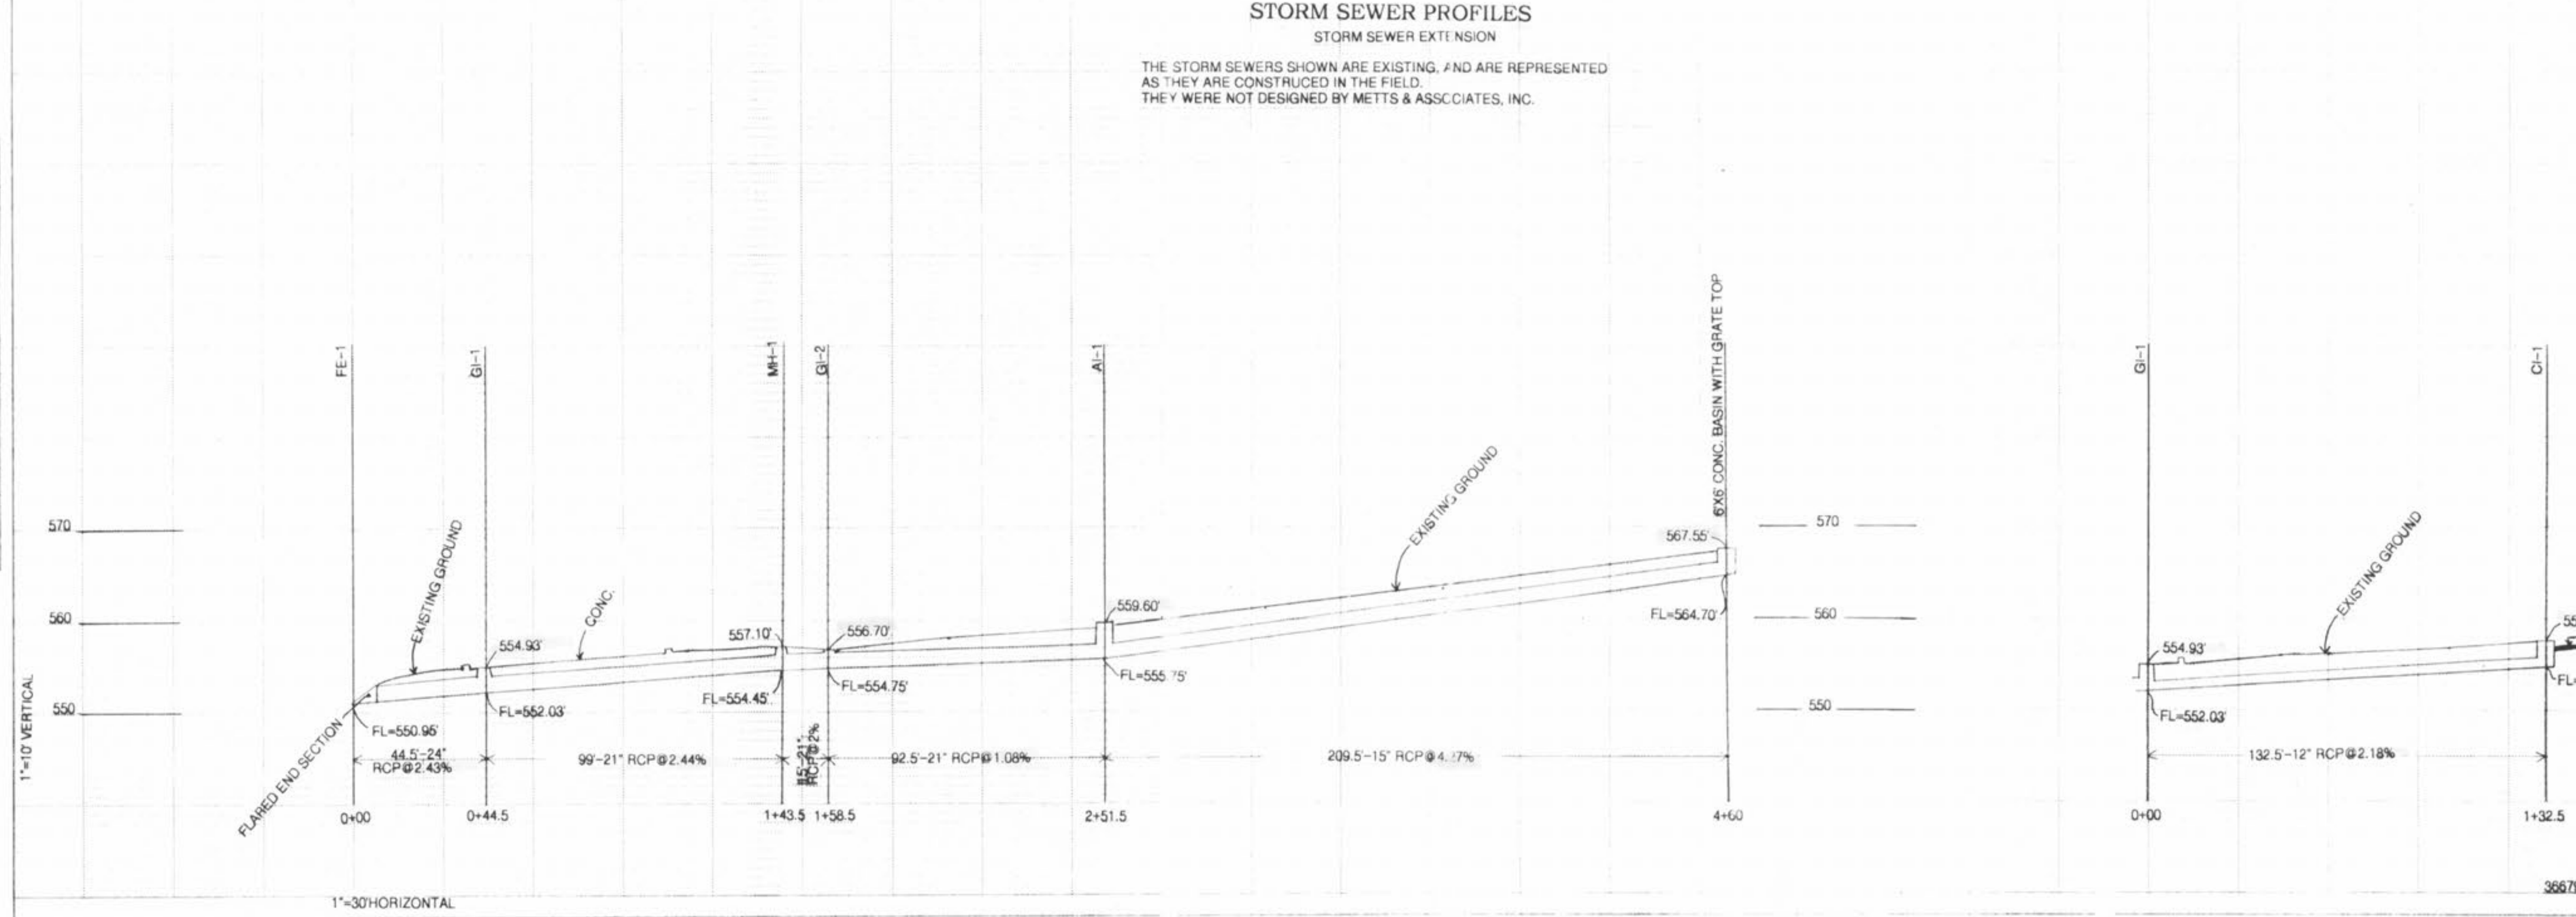

| | | | |
|---------|------|----|---------|
| PROFILE | DATE | BY | CHECKED |
| | | | |
| | | | |
| | | | |

OCTOBER 2000
PREPARED FOR CHARLIE GETTEMEIER/CRAFTON CONTRACTING
METTS & ASSOCIATES, INC.
LAND SURVEYORS & CIVIL ENGINEERS
P.O. BOX 593 O'FALLON, MO. 63366
(636) 978-5533 FAX: (636) 978-5534
366799-A

As-built 1/1
Reviewed & Approved 11/06/2000
RYDER VEHICLE SALES