

SSM HEALTHCARE IMPROVEMENT PLANS

CITY OF O'FALLON GENERAL NOTES

AS RECORDED IN PLAT BOOK 42, PAGE 45 AND ALSO BEING
PART OF U.S. SURVEY 55, TOWNSHIP 47 NORTH, RANGE 3 EAST
ST. CHARLES COUNTY, MISSOURI

DRAWING INDEX

Sheet	Description
1	COVER SHEET
2	DEMOLITION PLAN
3	SITE PLAN
4	GRADING PLAN
5	PREDEVELOPED DRAINAGE AREA MAP
6	POSTDEVELOPED DRAINAGE AREA MAP
7	EROSION AND SEDIMENT CONTROL PLAN
8	PROFILES SHEET
9	CONSTRUCTION DETAILS
10	EROSION AND SEDIMENT CONTROL DETAILS
11	MoDOT DETAILS
PHOTO-1	PHOTOMETRIC LIGHTING PLAN



LOCATION MAP

- Gas, water and other underground utilities shall not conflict with the depth or horizontal locations of existing and proposed sanitary and storm sewers, including house laterals.
- Underground utilities have been plotted from available information and, therefore, their locations must be considered approximate only. The verification of the location of all underground utilities, either shown or not shown on these plans, shall be the responsibility of the contractor and shall be located prior to grading or construction of improvements.
- Polyvinyl Chloride (PVC) shall conform to the requirements of ASTM D-3034 Standard Specifications for the PSM Polyvinyl Chloride (PVC) Sewer Pipe and Fittings, SDR-35.
- Storm sewers 18" in diameter or smaller shall be ASTM C-14.
- Storm sewers 21" in diameter or larger shall be ASTM C-76, Class II.
- All storm sewer pipe under pavement, regardless of size, shall be reinforced concrete pipe (ASTM C-76, Class II) unless noted otherwise in the plans.
- Corrugated metal pipe shall conform to the standard specifications for corrugated culvert pipe M-36, A.A.S.H.T.O. See plans for gauge.
- All filled places under proposed roads, proposed sanitary and storm sewer lines, and/or paved areas including trench backfills shall be compacted to 90% of maximum density as determined by the "Modified AASHTO T-180 Compaction Test" or 95% of maximum density as determined by the Standard Proctor Test AASHTO T-99. All fill placed in proposed roads shall be compacted from the bottom of the fill up. All tests shall be verified by a soils engineer concurrent with grading and backfilling operations. Ensure the moisture content of the soil in fill areas is to correspond to the compactive effort as defined by the Standard or Modified Proctor Test. Optimum moisture content shall be determined using the same test that was used for compaction. Soil compaction curves shall be submitted to the City of O'Fallon prior to the placement of fill. Proof rolling may be required to verify soil stability at the discretion of the City of O'Fallon.
- All earthen filled places within State, County, or City roads (Highways) shall be compacted to 95% of maximum density as determined by the "Standard Proctor Test A.A.S.H.T.O. T-99" (ASTM D-698) unless otherwise specified by local governing authority specifications. All tests will be verified by a soils engineer.
- All storm and sanitary trench backfills shall be water jetted. Granular fill will be used under paved areas.
- Easements shall be provided for storm sewers, sanitary sewers, and all utilities on the record plan. See record plot for location and size of easements. This does not apply to house laterals.
- No area shall be cleared without the permission of the developer.
- All grades shall be within 0.2 feet (more or less) of those shown on the grading plan.
- No slope shall be steeper than 3' (horizontal) to 1' (vertical) sodded or seeded and mulched.
- Hazard markers will consist of three (3) standard specification, "Manual on Uniform Traffic Control Devices", end of roadway markers mounted on two (2) pound "U" channel sign post. Each marker shall consist of an eighteen (18) inch diamond reflectorized red panel. The bottom of each panel shall be mounted a minimum of four (4) feet above the elevation of the pavement surface.
- All manhole and curb inlet tops built without elevations furnished by the Engineer will be the responsibility of the sewer contractor. At the time of construction stake-out of the sewer lines, all curb and grate inlets will be face staked. If normal face stakes fall in line with sewer construction, the Engineer will set these stakes on a double offset. It shall be the responsibility of the sewer contractor to preserve all face stakes from destruction.
- All standard street curb inlets to have front of inlet 2 feet behind curb.
- The minimum vertical distance from the low point of the basement to the flowline of a sanitary sewer at the corresponding house connection shall not be less than the diameter of the sanitary sewer plus a vertical distance not less than two and one-half feet (2-1/2').
- Water lines, valves, sleeves, meters and etc., shall meet all specifications and installation requirements of the local governing authority. Water mains shall have a minimum of 42" of cover.
- All cast iron pipe for water mains shall conform to A.W.W.A. specification C-106 and/or C-108. The cast iron fittings shall conform to A.W.W.A. specification C-110. All rubber gasket joints for water cast iron pressure pipe and fittings shall conform to A.W.W.A. specification C-111.
- All water hydrants and valves shall be cast iron and installed in accordance with plans and details.
- All sanitary and storm sewers shall meet all specifications and installation requirements of the local governing authority.
- All PVC water pipe shall have a minimum pressure rating of PR-200 or SDR-21. All new utilities under City streets shall be bored.
- All PVC sanitary sewer pipe shall be DR-35 or equal with crushed stone bedding uniformly graded between 1" and 1/4" size. This bedding shall extend from 6" below the pipe to 12" above the top of the pipe.
- All grading on Missouri State Highway Right-of-Way shall be seeded and mulched and all disturbed Right-of-Way markers shall be reset at the completion of grading.
- All streets must meet the specifications and installation requirements of the City of O'Fallon.
- All sanitary manholes top shall be set 0.2' higher than the proposed ground except in pavement areas.
- All sanitary manholes shall have a 31 mil thick coat of coal tar pitch waterproofing.
- All sanitary service lines shall have a 6" diameter.
- Manhole frame and cover shall be Clay and Boley No. 2008 or Neenah R-1736 or Deeter 1315 or approved equal.
- A drop of 0.2 feet is required through each sanitary manhole. Minimum cover of 42" is required on all sanitary sewer mains.
- The City of O'Fallon shall be notified at least 48 hours prior to construction of sanitary sewers for coordination and inspection.
- Brick shall not be used on in the construction of sanitary or storm sewer structures.
- 5/8" diameter trash bars shall be provided for all inlets.
- Waterproofing: Waterproofing will be required on the exterior of all manholes. The bitumen shall consist of two coats of asphalt, coal-tar pitch, or a coating meeting American Society for Testing and Materials (ASTM) D-41. Asphalt shall conform to the requirements of ASTM D 449. Coal-tar pitch shall conform to the requirements of ASTM D-450. Coating shall be 31 mils thickness.
- All concrete pipe or ADS N-12 pipe shall be installed with "O-Ring" Rubber type gaskets per M.S.D. standard construction specifications or manufacturer.
- The contractor shall assume complete responsibility for controlling all siltation and erosion of the project area. The contractor shall use whatever means necessary to control erosion and siltation including, but not limited to, staked straw bales and/or siltation fabric fences (possible methods of control are detailed in the plan). Control shall commence with grading and be maintained throughout the project until acceptance of the work by the Owner and/ or the City of O'Fallon and/ or MoDOT. The contractor's responsibilities include all design and implementation as required to prevent erosion and the depositing of silt. The Owner and/ or the City of O'Fallon and/ or MoDOT may at their option direct the Contractor in its methods as deemed fit to protect property and improvements. Any depositing of silts or mud on new or existing pavement or in new or existing storm sewers or swales shall be removed after each rain and affected areas cleaned to the satisfaction of the Owner and/ or the City of O'Fallon and/ or MoDOT.
- Developer must supply City construction inspectors with soils reports prior to or during site soil testing.
- All paving to be in accordance with St. Charles County standards and specifications except as modified by the City of O'Fallon ordinances.
- Owner shall provide a copy of the soils report to grading contractor. Contractor shall be responsible for adhering to all recommendations outlined in the soils report.
- All new utilities under City streets shall be bored.
- All sanitary laterals and sanitary mains crossing under roadways must have the proper rock backfill and to required compaction.
- HDPE pipe is to be N-12WT or equal and shall meet ASTM F1417 water tight field test.
- Trees, organic debris, rubble, foundations and other deleterious material shall be removed from the site and disposed of in compliance with all applicable laws and regulations. Landfill tickets for such disposal shall be maintained on file by the developer. Burning on site shall be allowed only by permit from the local fire district. If a burn pit is proposed the location and mitigation shall be shown on the grading plan and documented by the soils engineer.
- If intersecting roadway does not have a curb, then the curb on the new entrance shall begin 10' from the edge of the existing roadway line.
- Sidewalks, curb ramps, ramp and accessible parking spaces shall be constructed in accordance with the current approved "American with Disabilities Act Accessibility Guidelines" (ADAAG) along with the required grades, construction materials, specifications and signage. If any conflict occurs between the above information and the plans, the ADAAG guidelines shall take precedence and the contractor prior to any construction shall notify the Project Engineer.
- "Trees, organic debris, rubble, foundations and other deleterious material shall be removed from the site and disposed in compliance with all applicable laws and regulations. Landfill tickets for such disposal shall be maintained on file by the developer. Burning on site shall be allowed only by permit from the local fire district. If a burn pit is proposed the location and mitigation shall be shown on the grading plan and documented by the soils engineer.
- Developer must supply City construction inspectors with soils reports prior to or during site soil testing. The soil report will be required to include maximum dry density, optimum moisture content, maximum and minimum allowable moisture content, curve must be plotted to show density from a minimum of 90% compaction and above as determined by the "Modified AASHTO T-180 Compaction Test" (A.S.T.M.-D-1157) or above from a minimum of 95% as determined by the "Standard Proctor Test AASHTO T-99, Method C" (A.S.T.M.-D-698). Proctor type must be designated on document. Curve must have at least 5 density points with moisture content and sample locations listed on document, specific gravity, natural moisture content, liquid limit, and plastic limit.
- All requirements of the Planning and Zoning Commission have been addressed.
- All sign post and backs and bracket arms shall be painted black using Carboline Rustbond Penetrating Sealer 50 and Carboline 133 HB paint (or equivalent as approved by City and MoDOT. Signs designating street name shall be on the opposite side of the street from traffic control signs.
- All paving to be in accordance with St. Charles County standards and specifications except as modified by the City of O'Fallon ordinances.
- The City of O'Fallon shall also be contacted for utility located under its maintenance responsibility. This may include water, sanitary, storm, and traffic locates.
- Graded areas that are to remain bare for over 2 weeks are to be seeded and mulched (DNR requirement).
- Traffic control is to be per MoDOT or MUTCD, whichever is more stringent.

Symbol	Description	Material
—	Sanitary Sewer (Proposed)	R.C.P.
—○—	Sanitary Sewer (Existing)	C.M.P.
- - -	Storm Sewer (Proposed)	C.I.P.
- - -○-	Storm Sewer (Existing)	P.V.C.
— 6" —	Water Line & Size	V.C.P.
- - - W - - -	Existing water line	
— Tee & Valve		
— Hydrant		
— Cap		
18	Lot or Building Number	
- - -	Existing Fence Line	
—	Existing Tree Line	
—	Street Sign	
—	Existing Contour	
—	Proposed Contour	
—	Grouted Rip-Rap	
—	End of Lateral	
—	Asphalt Pavement	
—	Concrete Pavement	
⊙	Sanitary Structure	Reinforced Concrete Pipe
⊙	Storm Structure	Corrugated Metal Pipe
⊙	Test Hole	Cast Iron Pipe
⊙	Power Pole	Polyvinyl Chloride
⊙	Light Standard	Vitrified Clay Pipe
⊙	Double Water Meter Setting	Adjust To Grade
⊙	Single Water Meter Setting	Clean Out
C.I.	Curb Inlet	Vent Trap
S.C.I.	Skewed Curb Inlet	To Be Removed
D.C.I.	Double Curb Inlet	To Be Removed
G.I.	Grate Inlet	To Be Protected
A.I.	Area Inlet	To Be Abandoned
D.A.I.	Double Area Inlet	Base Of Curb
C.C.	Concrete Collar	Top Of Curb
F.E.	Flored End Section	Top Of Wall
E.P.	End Pipe	Base Of Wall
E.D.	Energy Dissipator	Typical
M.H.	Manhole	Unless Noted Otherwise
C.P.	Concrete Pipe	U.I.P.

LEGEND

These "AS-BUILT" storm and sanitary sewer plans are based on actual field observations conducted during June and November, 2007 and the results are shown hereon.

By: *Roger G. Allen*
ROGER G. ALLEN, P.L.S., #2185
STATE OF MISSOURI

PICKETT, RAY & SILVER'S CORPORATE
REGISTRATION NO. LS-54-D

BENCH MARKS

Project Benchmark RM66: A cross cut on the western bolt of a fire hydrant located at the northern corner of Mill Pond Drive and Spring Hill Drive. Elevation = 581.74 feet (NGVD1929).

TBM: "M" in Mueller on Fire Hydrant
52' west of the edge of asphalt to Highway K
and 21' North of the center of entrance to
1101 Highway "K"

ELEVATION = 565.73

MoDOT UTILITIES
(314) 340-4100
Fiber Optics are present



OWNER/DEVELOPER:
LILLIBRIDGE HEALTHCARE
REAL ESTATE TRUST
CONTACT: NOE MARTINEZ
5308 WEST PLANO PARKWAY
PLANO, TEXAS, 75093-4821
972-248-9100 EXT.4360
P&Z APPROVAL 10.05.06
FILE #2606.01

"AS-BUILTS" 12.17.07

PICKETT RAY & SILVER
CIVIL ENGINEERS
PLANNERS
LAND SURVEYORS
333 Mid Rivers Mall Drive
St. Peters, MO 63276
Phone (636) 397-1211
Fax (636) 397-1104

**SSM HEALTHCARE
IMPROVEMENT PLANS**
OF FALLON, MO
LILLIBRIDGE
Prepared For:
LILLIBRIDGE HEALTHCARE
CONTACT: NOE MARTINEZ
5308 WEST PLANO PARKWAY
PLANO, TEXAS, 75093-4821
972-248-9100 EXT.4360


NO.	DATE	REVISIONS
1	10.19.06	REVISED PER CITY COMMENTS
2	11.09.06	REVISED PER MoDOT COMMENTS
3	12.15.06	REVISED PER MoDOT COMMENTS
4	7.12.07	"AS-BUILTS"
5	7.31.07	REVISE SHEETS 3, 4, AND 11
6	12.17.07	"AS-BUILTS"

ENGINEERS AUTHENTICATION
The responsibility for professional engineering liability on this project is hereby limited to the set of plans authenticated by the seal, signature, and date hereunder attached. Responsibility is disclaimed for all other engineering plans involved in this project and specifically excludes revisions after this date unless reauthenticated.
PICKETT, RAY & SILVER, INC

DRAWN	DATE
J.M. WINTERS	10.11.06
CHECKED	DATE
S.D. MARION	10.11.06
PROJECT # 91090.LILB.02C	
TASK # 2	FIELD BOOK 450E

SSM HEALTHCARE
IMPROVEMENT PLANS
COVER SHEET
SHEET 1 OF 11
© Copyright 2006 by Pickett, Ray & Silver Inc.

OLD UTILITY NOTE
Underground facility structures and utilities have been plotted from available surveys and record information and, therefore, their locations must be considered approximate only. Verification of location of all underground structures and facilities either shown or not shown on these plans shall be the responsibility of the contractor.

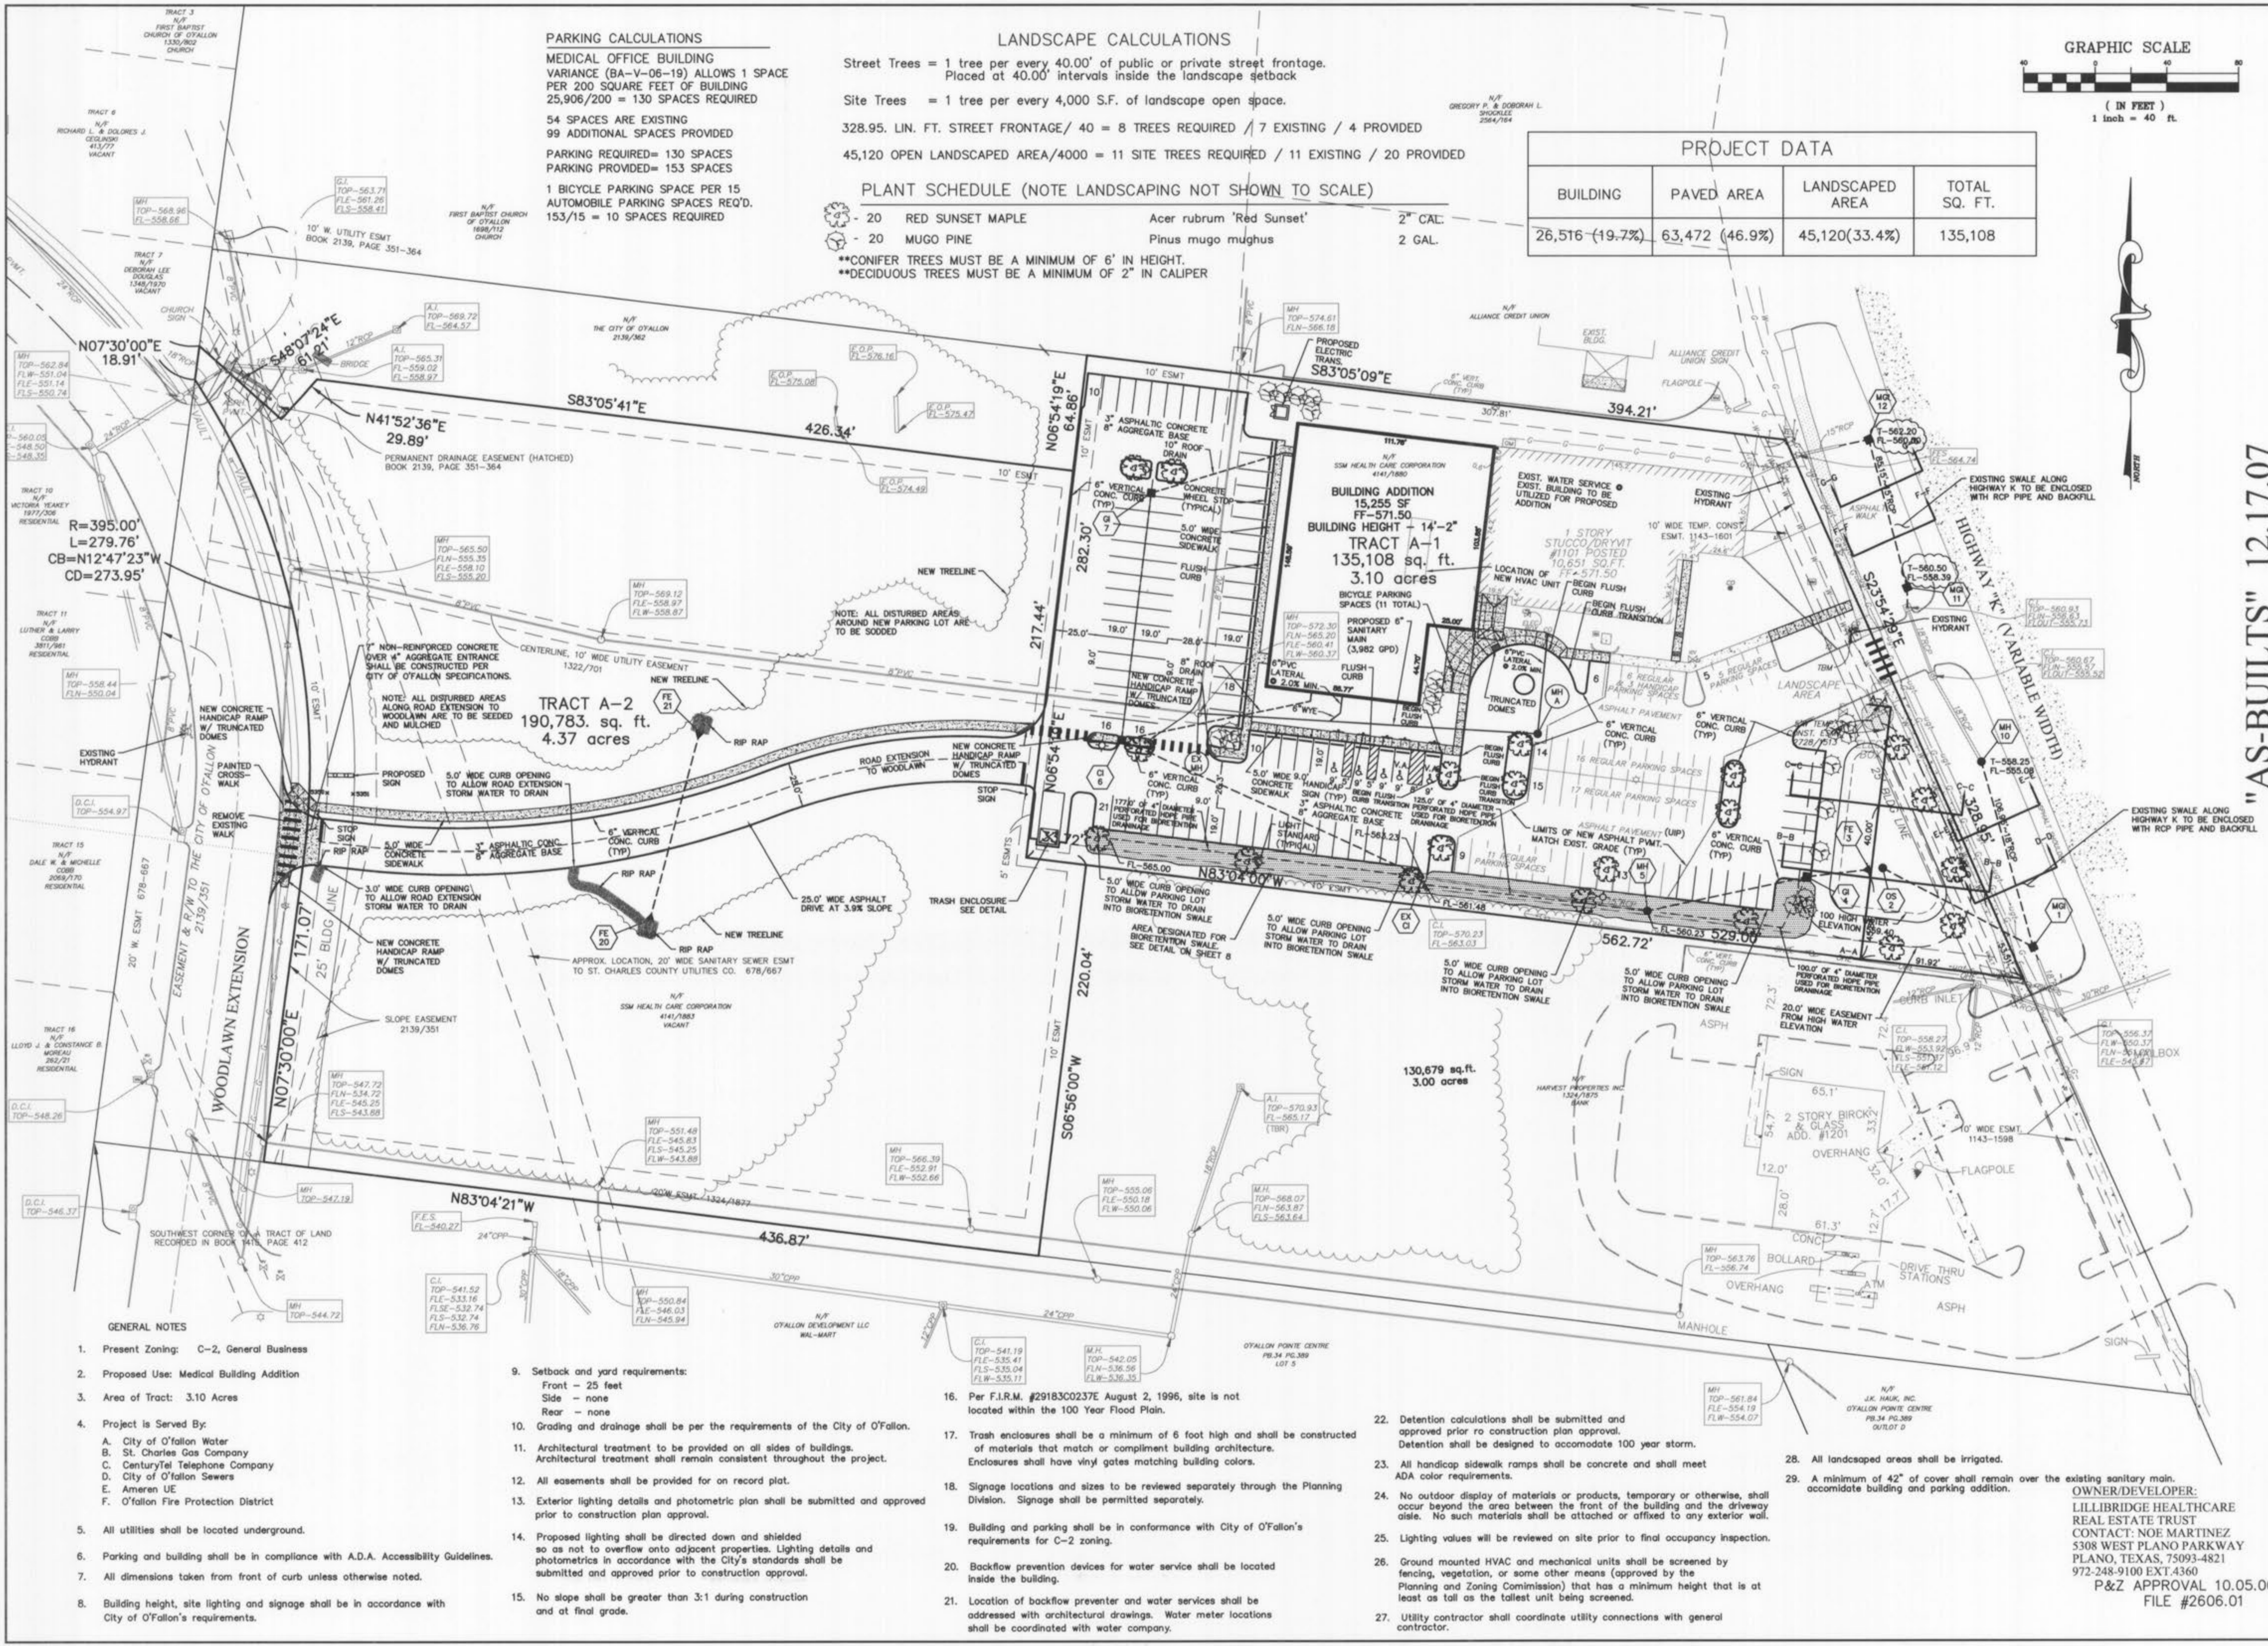


PARKING CALCULATIONS
 MEDICAL OFFICE BUILDING
 VARIANCE (BA-V-06-19) ALLOWS 1 SPACE
 PER 200 SQUARE FEET OF BUILDING
 25,906/200 = 130 SPACES REQUIRED
 54 SPACES ARE EXISTING
 99 ADDITIONAL SPACES PROVIDED
 PARKING REQUIRED= 130 SPACES
 PARKING PROVIDED= 153 SPACES
 1 BICYCLE PARKING SPACE PER 15
 AUTOMOBILE PARKING SPACES REQ'D.
 153/15 = 10 SPACES REQUIRED

LANDSCAPE CALCULATIONS
 Street Trees = 1 tree per every 40.00' of public or private street frontage.
 Placed at 40.00' intervals inside the landscape setback
 Site Trees = 1 tree per every 4,000 S.F. of landscape open space.
 328.95. LIN. FT. STREET FRONTAGE/ 40 = 8 TREES REQUIRED / 7 EXISTING / 4 PROVIDED
 45,120 OPEN LANDSCAPED AREA/4000 = 11 SITE TREES REQUIRED / 11 EXISTING / 20 PROVIDED

PLANT SCHEDULE (NOTE LANDSCAPING NOT SHOWN TO SCALE)

- 20 RED SUNSET MAPLE Acer rubrum 'Red Sunset' 2" CAL.
 - 20 MUGO PINE Pinus mugo mughus 2 GAL.
- ***CONIFER TREES MUST BE A MINIMUM OF 6' IN HEIGHT.
 ***DECIDUOUS TREES MUST BE A MINIMUM OF 2" IN CALIPER

PROJECT DATA			
BUILDING	PAVED AREA	LANDSCAPED AREA	TOTAL SQ. FT.
26,516 (-19.7%)	63,472 (46.9%)	45,120(33.4%)	135,108

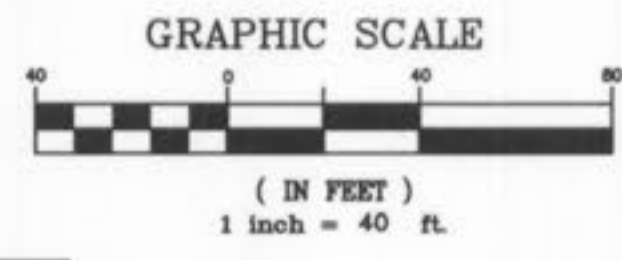

PICKETT RAY & SILVER
 CIVIL ENGINEERS
 PLANNERS
 LAND SURVEYORS
 333 Mid Rivers Mall Drive
 St. Peters, MO 63376
 Phone (636) 397-1211
 Fax (636) 397-1140

**SSM HEALTHCARE
 IMPROVEMENT PLANS**
 OF FALLON, MO
 Prepared For:
 LILLIBRIDGE

REVISIONS

NO.	DATE	REVISION
1	10.19.06	REVISED PER CITY COMMENTS
2	11.09.06	REVISED PER MCOOT COMMENTS
3	12.15.06	REVISED PER SITE VISIT
4	3.29.07	REVISED NEAR H.C.P. PARKING
5	4.03.07	RVSD. GRADE NEAR H.C.P. PARKING
6	7.12.07	"AS-BUILTS"
7	7.31.07	REVISED INLET TOP ELEVATION
8	10.02.07	TRUNC. DOMES AT ENTRANCE
9	12.17.07	"AS-BUILTS"

ENGINEERS AUTHENTICATION
 The responsibility for professional engineering liability on this project is hereby limited to the set of plans authorized by the seal, signature, and date hereunder attached. Responsibility is disclaimed for all other engineering plans involved in this project and specifically excludes revisions after this date unless reauthenticated.
 PICKETT, RAY & SILVER, INC.













DRAWN J.M. WINTERS **DATE** 10.11.06
CHECKED S.D. MARION **DATE** 10.11.06
PROJECT # 91090.LILB.02C
TASK # 2 **FIELD** 450E

**SSM HEALTHCARE
 IMPROVEMENT PLANS
 SITE PLAN**
SHEET 3 OF 11
 © Copyright 2008 by Pickett, Ray & Silver Inc.

"AS-BUILTS" 12.17.07

OWNER/DEVELOPER:
 LILLIBRIDGE HEALTHCARE
 REAL ESTATE TRUST
 CONTACT: NOE MARTINEZ
 5308 WEST PLANO PARKWAY
 PLANO, TEXAS, 75093-4821
 972-248-9100 EXT. 4360
 P&Z APPROVAL 10.05.06
 FILE #2606.01

- GENERAL NOTES**
- Present Zoning: C-2, General Business
 - Proposed Use: Medical Building Addition
 - Area of Tract: 3.10 Acres
 - Project is Served By:
 - A. City of O'Fallon Water
 - B. St. Charles Gas Company
 - C. CenturyTel Telephone Company
 - D. City of O'Fallon Sewers
 - E. Ameren UE
 - F. O'Fallon Fire Protection District
 - All utilities shall be located underground.
 - Parking and building shall be in compliance with A.D.A. Accessibility Guidelines.
 - All dimensions taken from front of curb unless otherwise noted.
 - Building height, site lighting and signage shall be in accordance with City of O'Fallon's requirements.
 - Setback and yard requirements:
 - Front - 25 feet
 - Side - none
 - Rear - none
 - Grading and drainage shall be per the requirements of the City of O'Fallon.
 - Architectural treatment to be provided on all sides of buildings. Architectural treatment shall remain consistent throughout the project.
 - All easements shall be provided for on record plat.
 - Exterior lighting details and photometric plan shall be submitted and approved prior to construction plan approval.
 - Proposed lighting shall be directed down and shielded so as not to overflow onto adjacent properties. Lighting details and photometrics in accordance with the City's standards shall be submitted and approved prior to construction approval.
 - No slope shall be greater than 3:1 during construction and at final grade.
 - Per F.I.R.M. #29183C0237E August 2, 1996, site is not located within the 100 Year Flood Plain.
 - Trash enclosures shall be a minimum of 6 foot high and shall be constructed of materials that match or complement building architecture. Enclosures shall have vinyl gates matching building colors.
 - Signage locations and sizes to be reviewed separately through the Planning Division. Signage shall be permitted separately.
 - Building and parking shall be in conformance with City of O'Fallon's requirements for C-2 zoning.
 - Backflow prevention devices for water service shall be located inside the building.
 - Location of backflow preventer and water services shall be addressed with architectural drawings. Water meter locations shall be coordinated with water company.
 - Detention calculations shall be submitted and approved prior to construction plan approval. Detention shall be designed to accommodate 100 year storm.
 - All handicap sidewalk ramps shall be concrete and shall meet ADA color requirements.
 - No outdoor display of materials or products, temporary or otherwise, shall occur beyond the area between the front of the building and the driveway aisle. No such materials shall be attached or affixed to any exterior wall.
 - Lighting values will be reviewed on site prior to final occupancy inspection.
 - Ground mounted HVAC and mechanical units shall be screened by fencing, vegetation, or some other means (approved by the Planning and Zoning Commission) that has a minimum height that is at least as tall as the tallest unit being screened.
 - Utility contractor shall coordinate utility connections with general contractor.
 - All landscaped areas shall be irrigated.
 - A minimum of 42" of cover shall remain over the existing sanitary main.

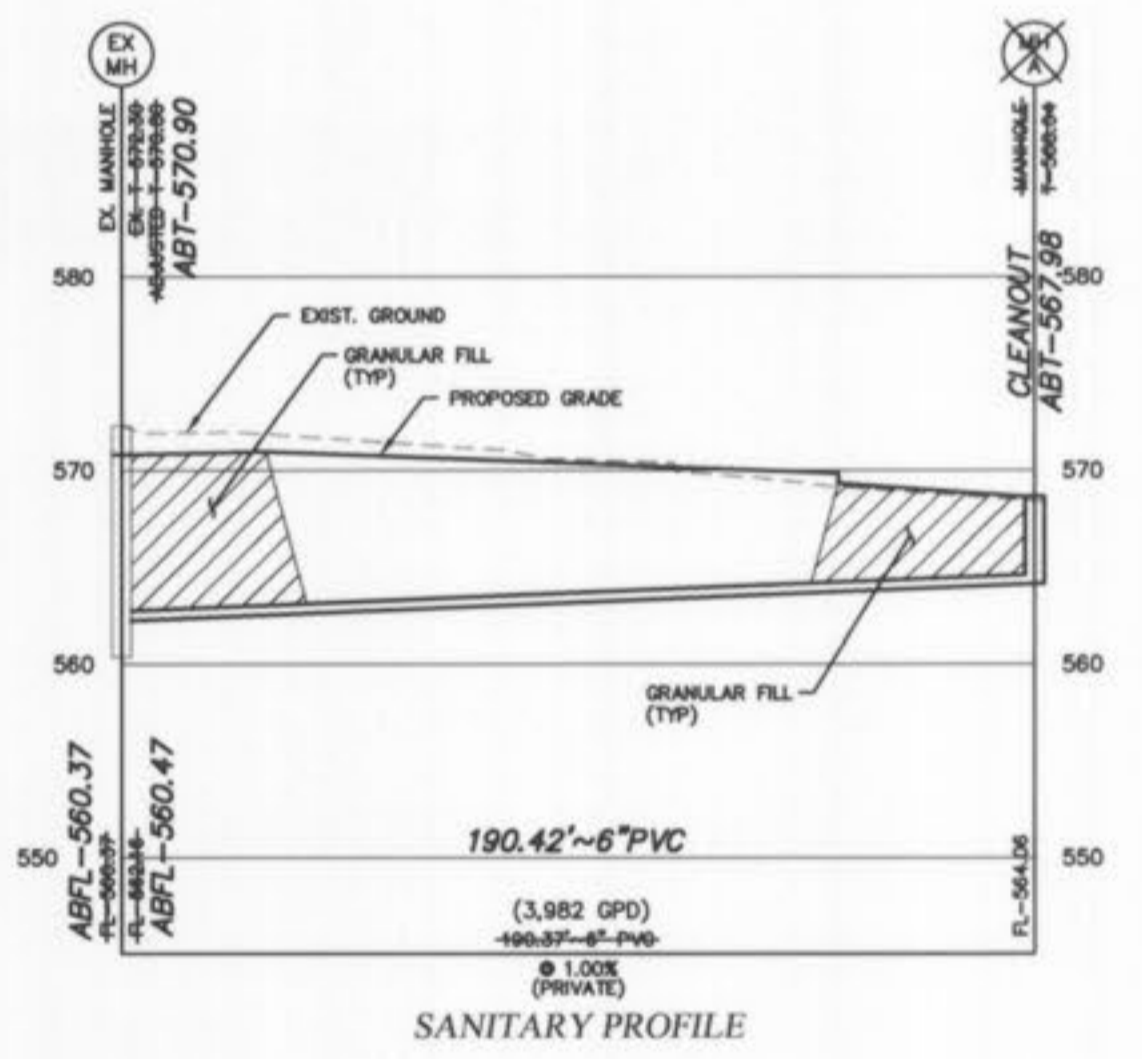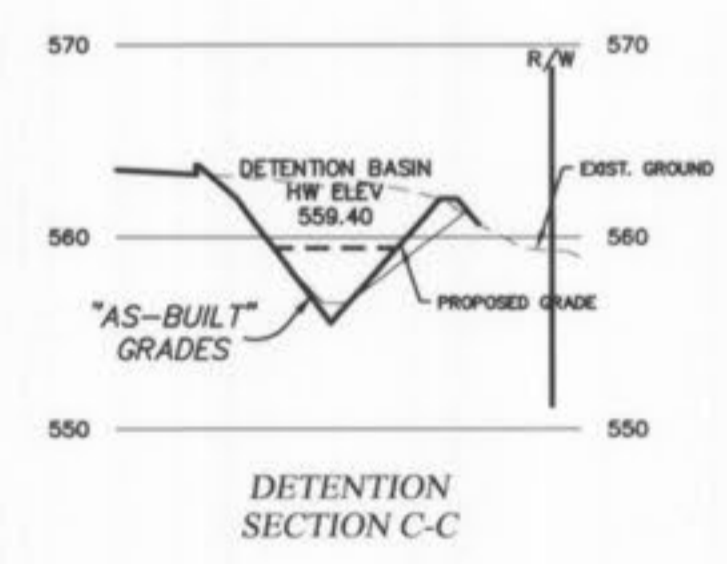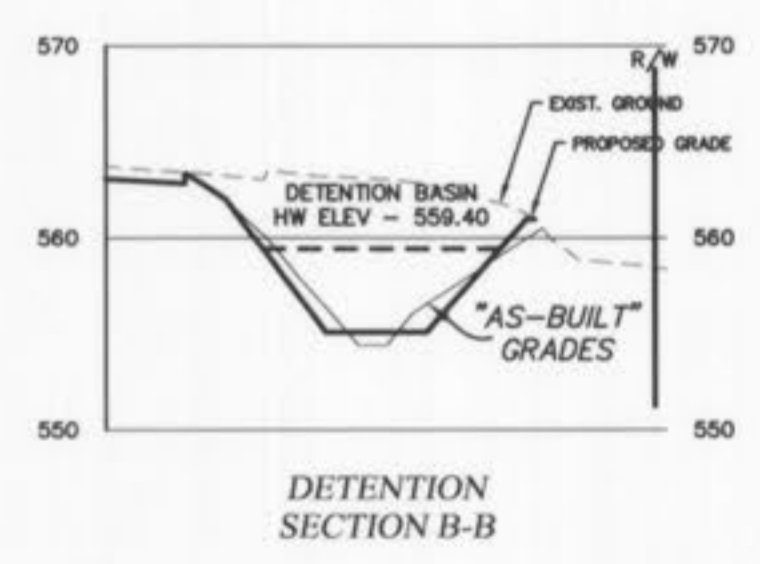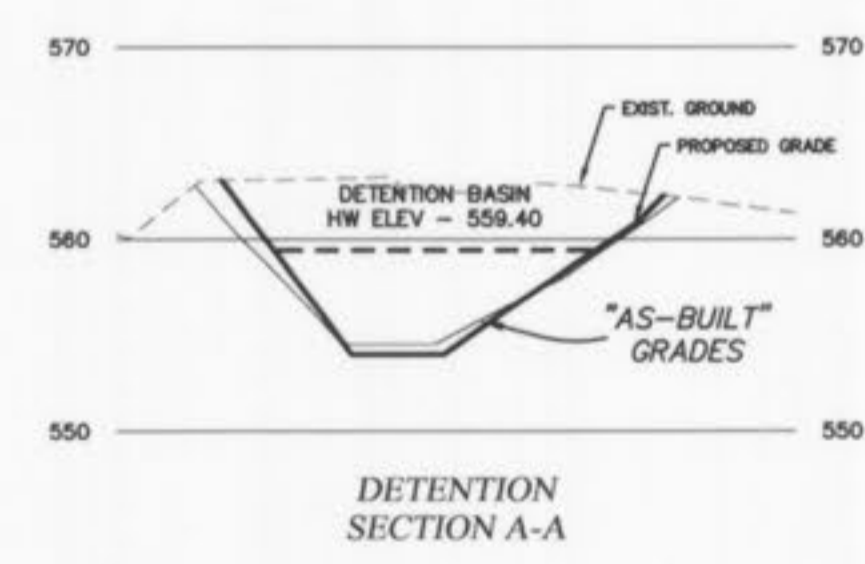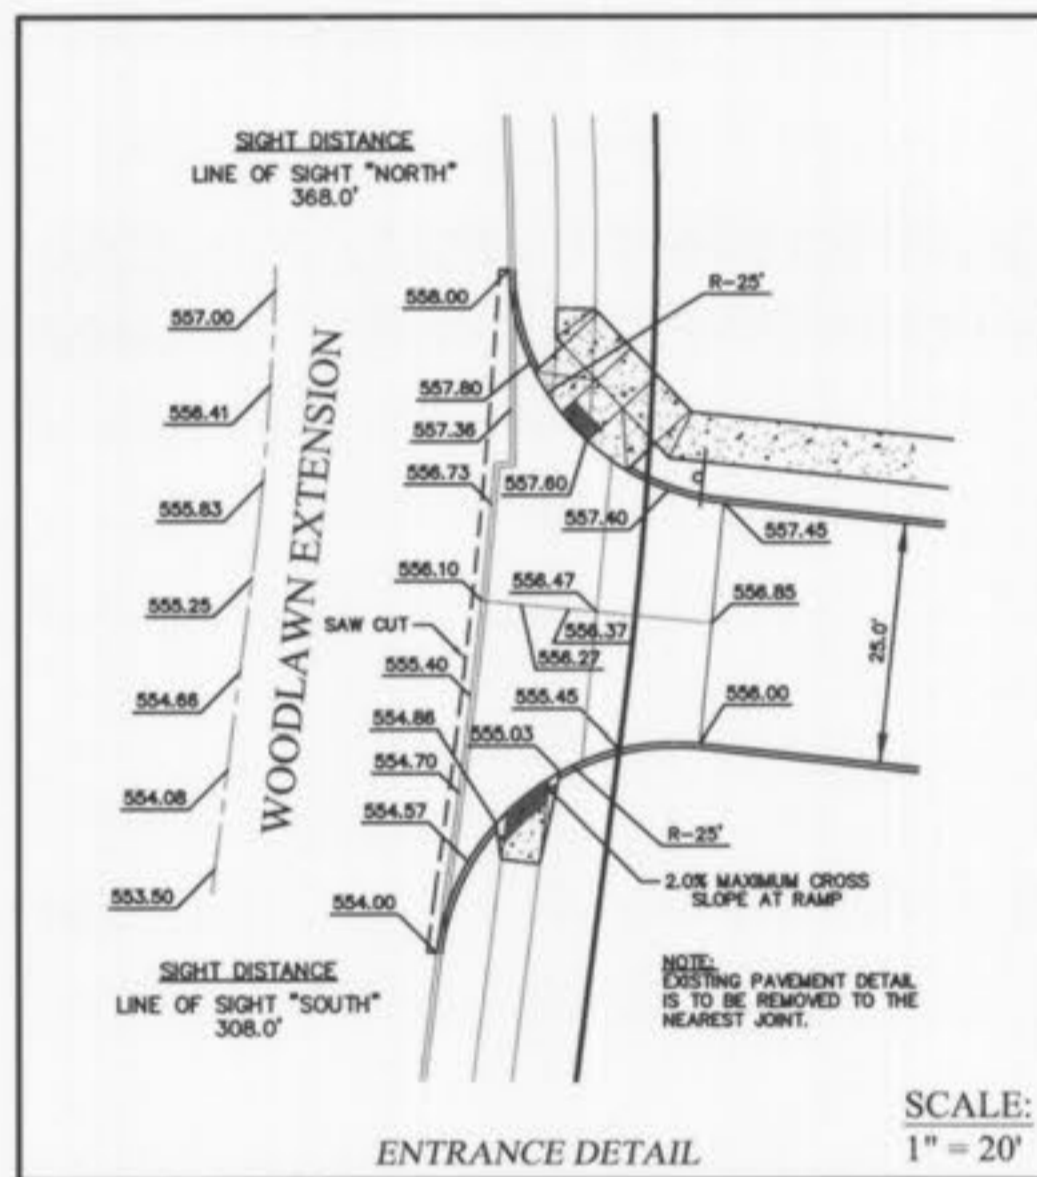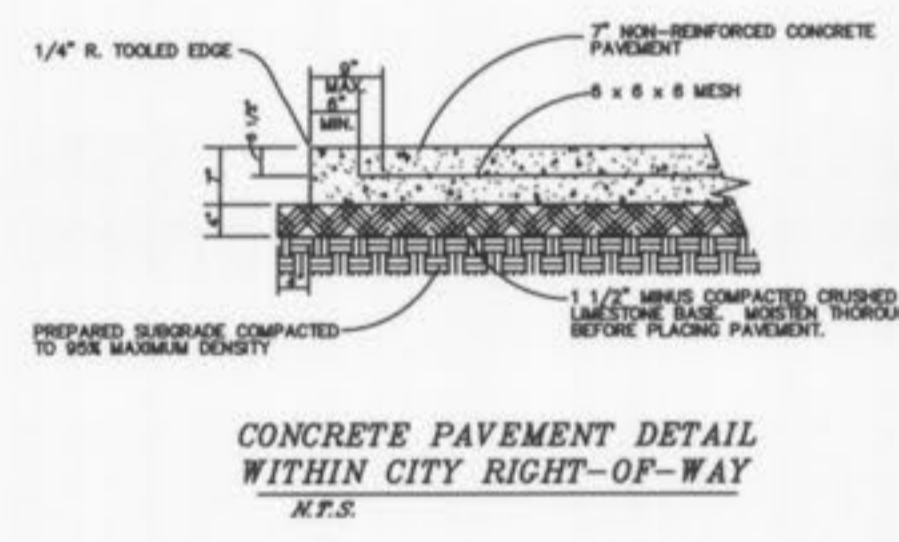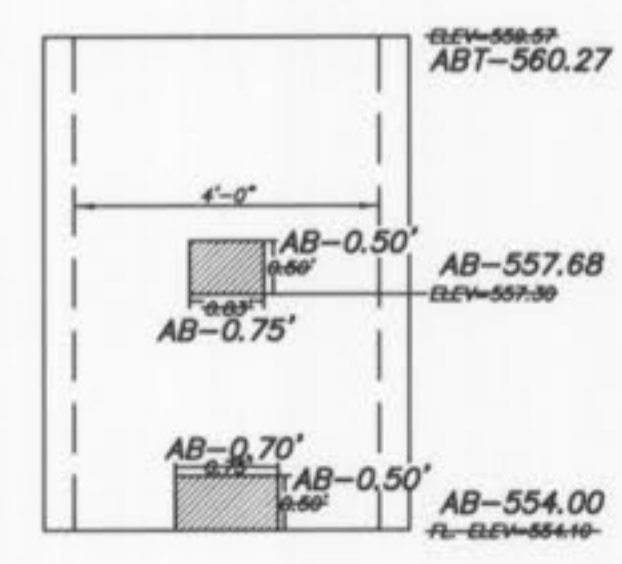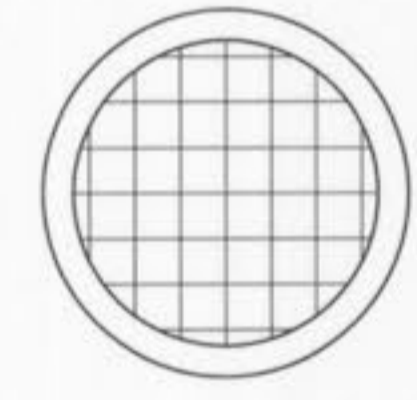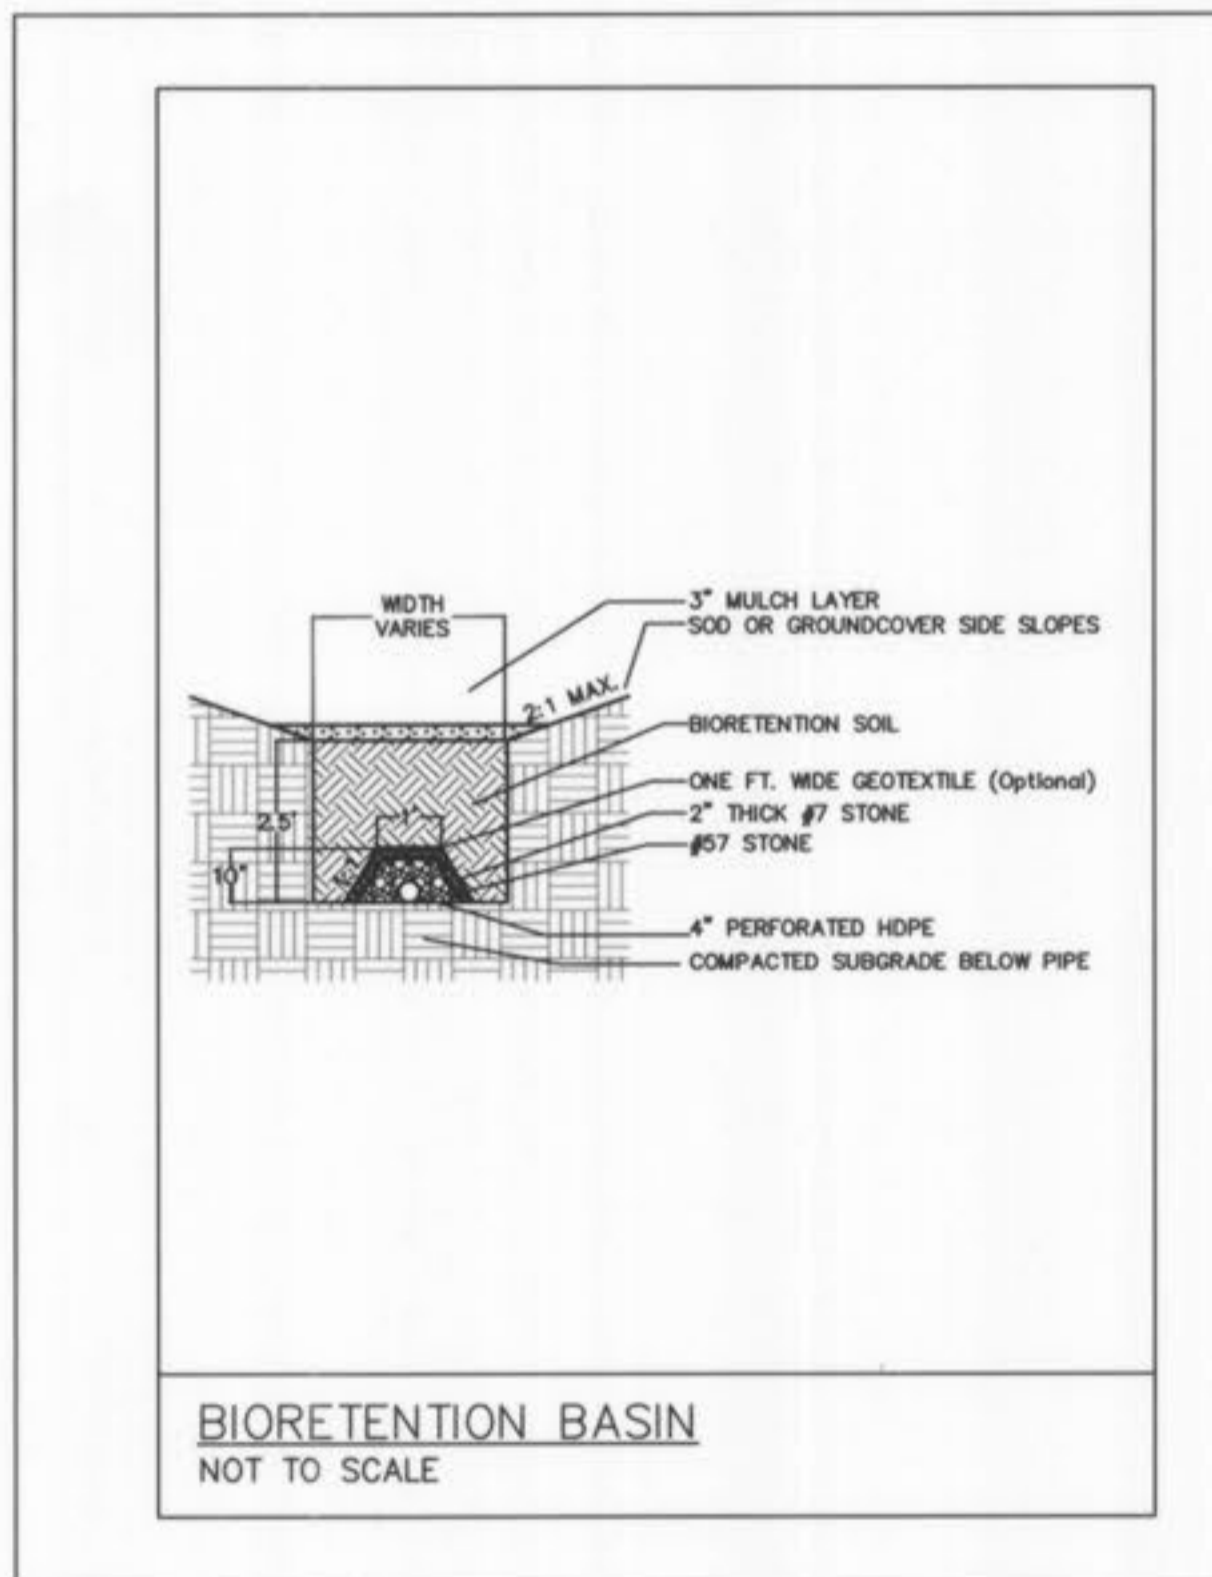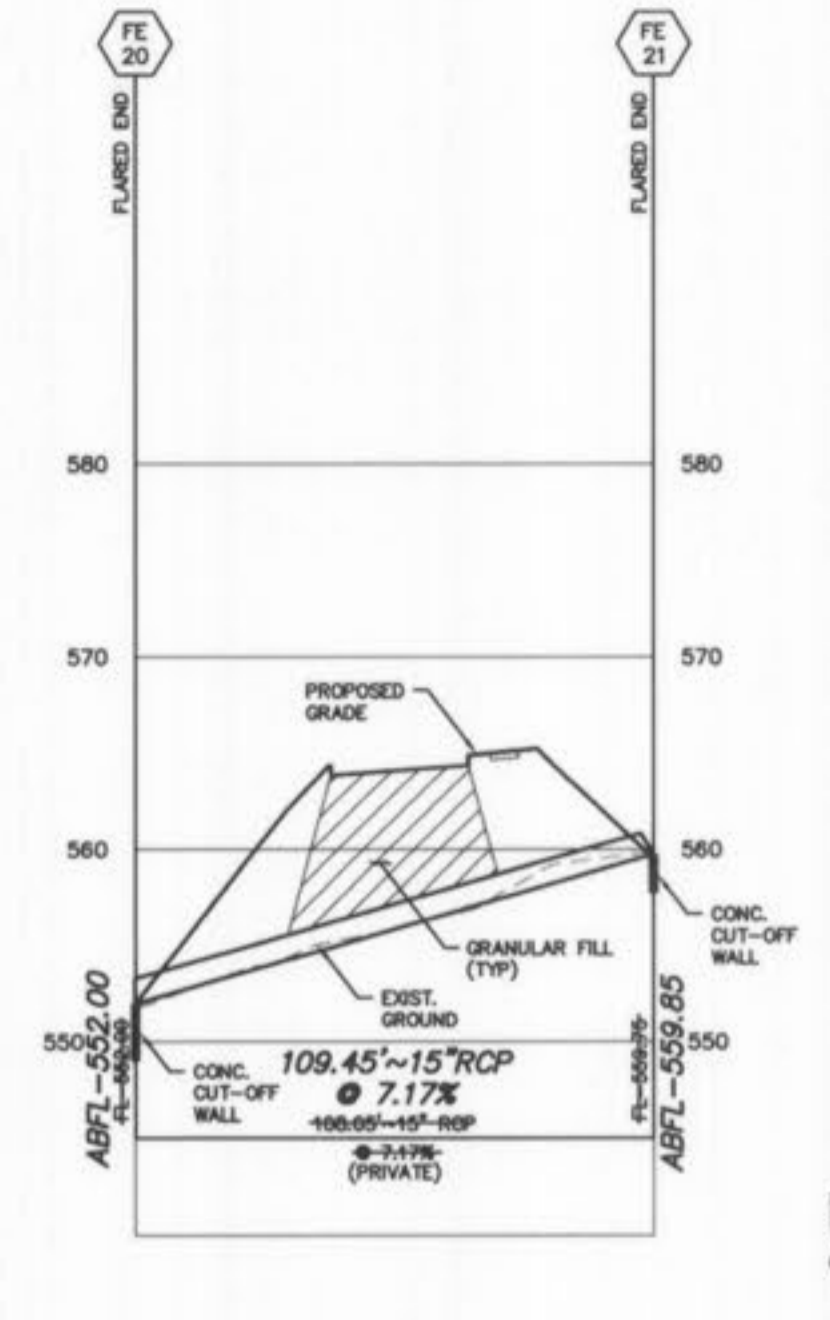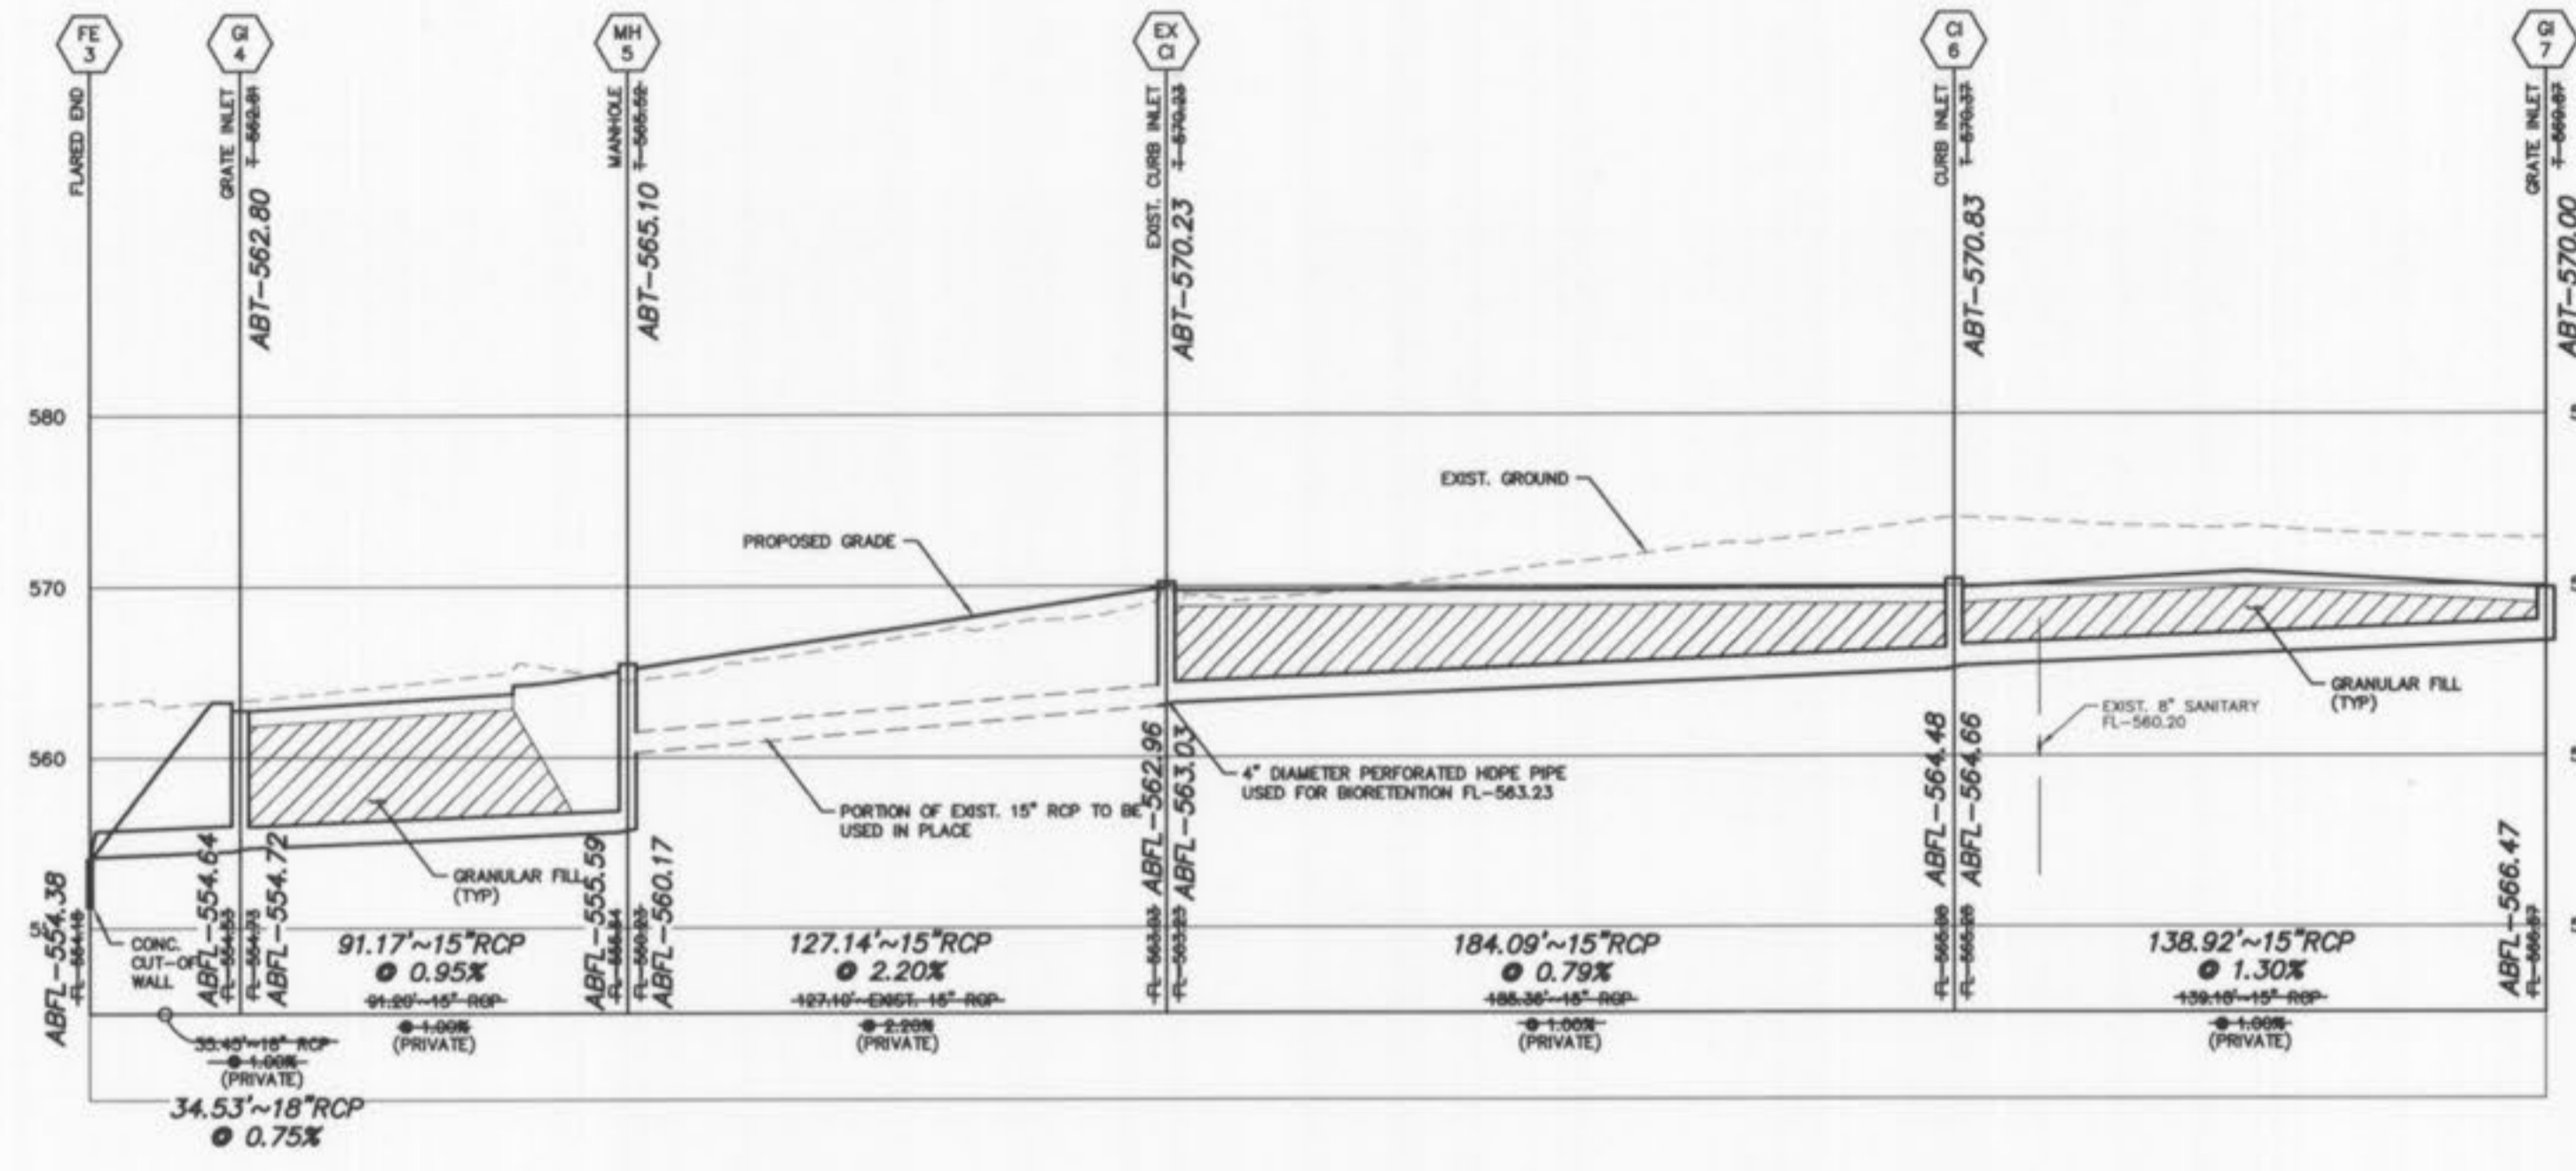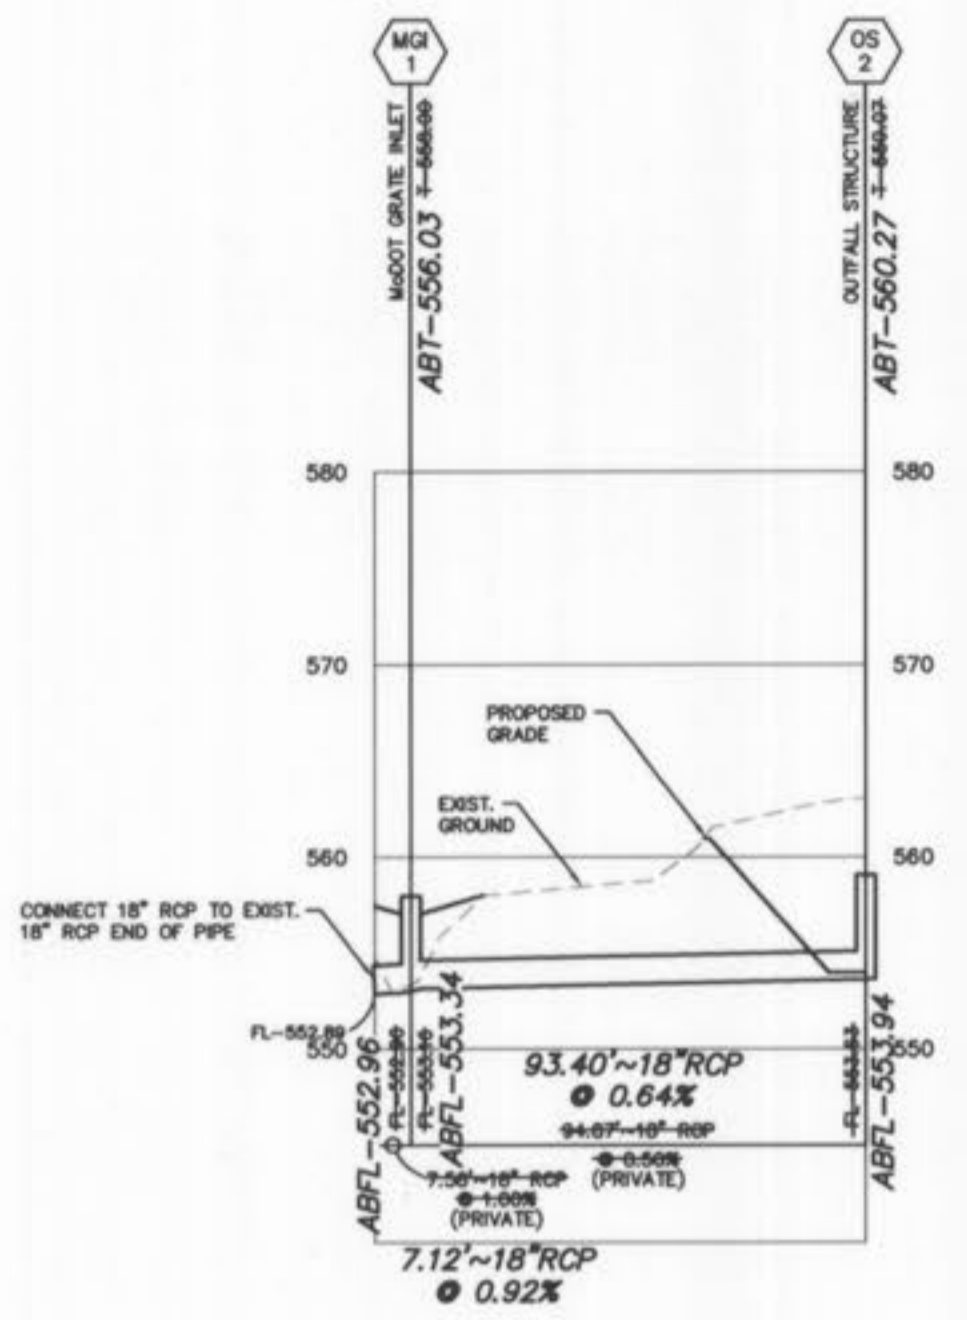

NOTE: Provide a marking on the storm sewer inlets. The City will allow the following markers and adhesive procedures only as shown in the table below or on approved equal by Almetel Industries. 'Pest and stick' adhesive paste will not be allowed.

Manufacturer	Size	Adhesive	Style	Message (Part #)	Website
ACP International	3 7/8"	Epoxy	Crystal Cap	No Dumping Drains To Waterways (SD- W-CO)	www.acpinternational.com
DAS Manufacturing, Inc.	4"	Epoxy	Standard Style	No Dumping Drains To Stream (#605)	www.dasmanufacturing.com

NOTE: R/R SHOWN AT FLARED ENDS WILL BE EVALUATED IN THE FIELD AFTER INSTALLATION FOR EFFECTIVENESS AND FIELD MODIFIED IF NECESSARY TO REDUCE EROSION ON AND OFF SITE. R/R SHALL BE CONCRETE.

SCALE:
HOR. - 1"=40'
VERT. - 1"=10'
P&Z APPROVAL 10.05.06
FILE #2606.01

"AS-BUILTS" 12-17-07

PICKETT RAY & SILVER
CIVIL ENGINEERS
PLANNERS
LAND SURVEYORS

333 Mid Rivers Mall Drive
St. Peters, MO 63276
Phone (636) 397-1211
Fax (636) 397-1104


SSM HEALTHCARE
IMPROVEMENT PLANS
OF FALLON, MO

Prepared For:
LILLIBRIDGE

LILLIBRIDGE
CONTACT: NOE MARTINEZ
PLANO, TEXAS 75093-4821
972-248-9100 EXT. 4360

REVISONS	NO.	DATE	REVISED PER CITY COMMENTS	REVISED PER MGDOT COMMENTS	REVISED PER MGDOT COMMENTS	"AS-BUILTS"
	1	10.19.06				
	2	11.09.06				
	3	12.15.06				
	4	12.17.07				

ENGINEERS AUTHENTICATION
The responsibility for professional engineering liability on this project is hereby limited to the set of plans authorized by the seal, signature, and date hereunder attached. Responsibility is disclaimed for all other engineering plans involved in this project and specifically excludes revisions after this date unless reauthorized.




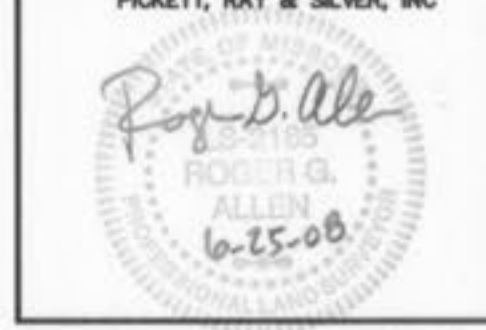


DRAWN J.M. WINTERS	DATE 10.11.06
CHECKED S.D. MARION	DATE 10.11.06
PROJECT # 91090.LILB.02C	
TASK # 2	FIELD BOOK 450E

SSM HEALTHCARE
IMPROVEMENT PLANS
PROFILES SHEET

SHEET 8 OF 11

© Copyright 2008 by Pickett, Ray & Silver Inc.

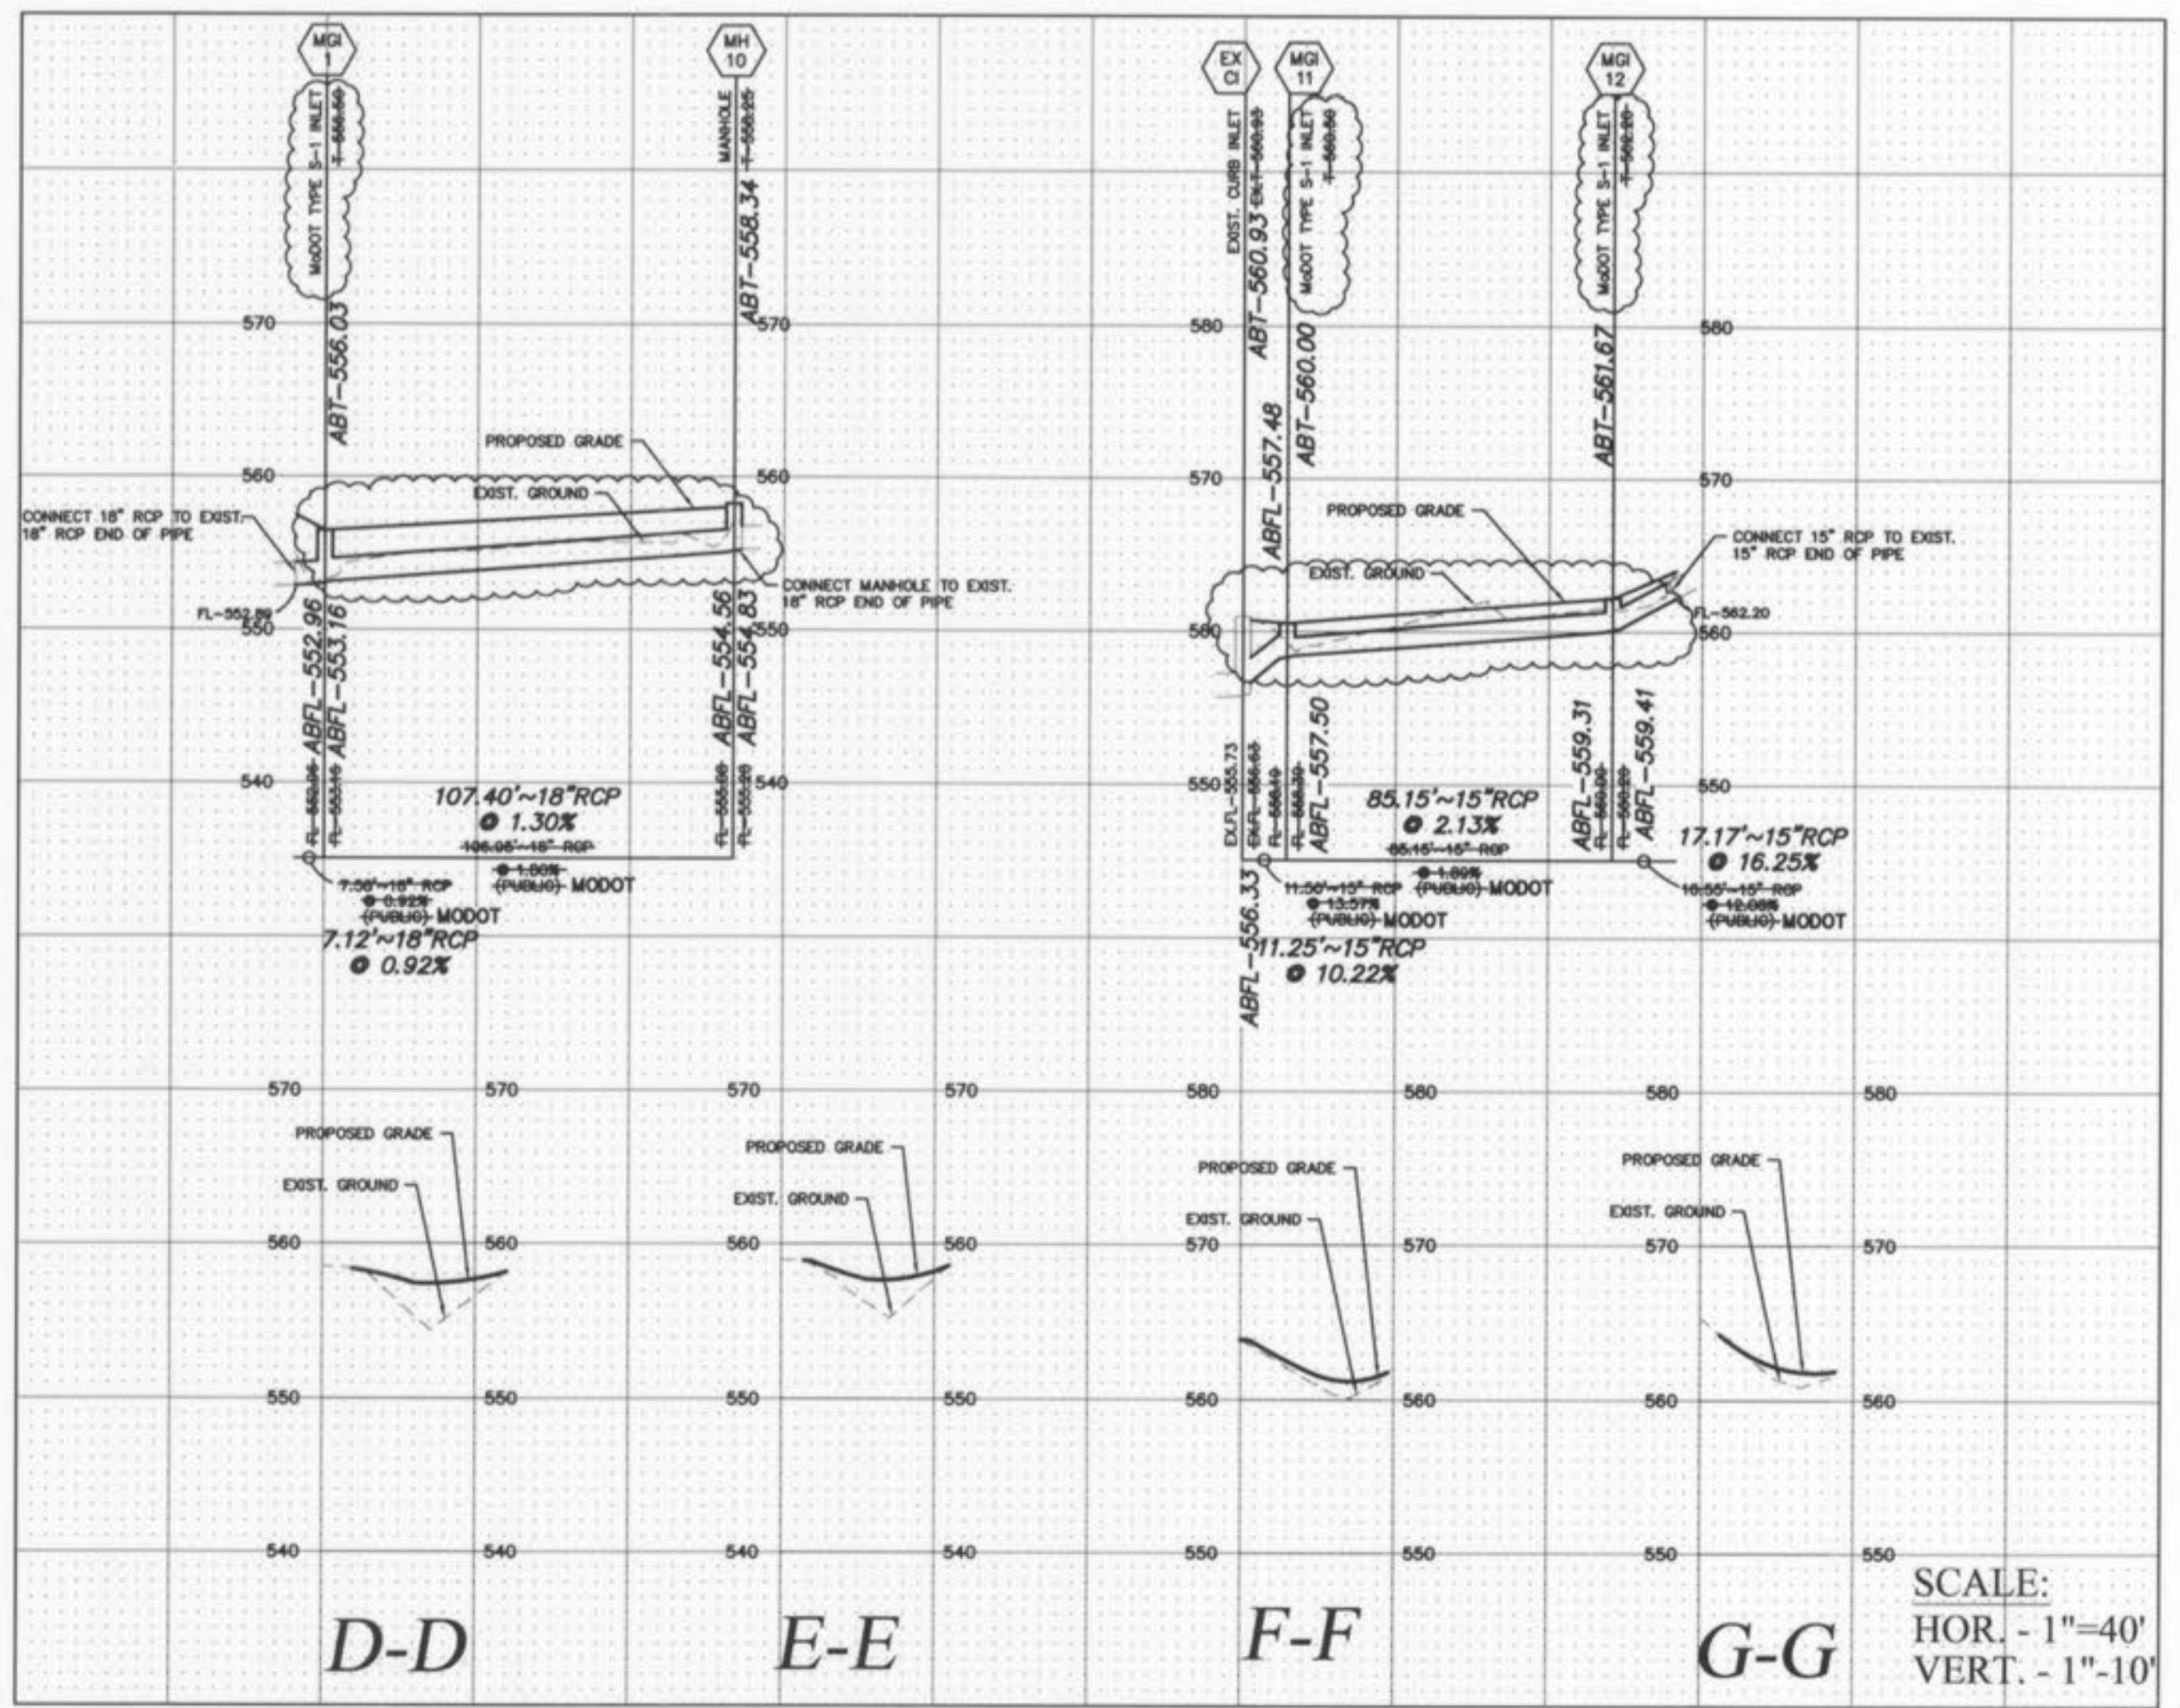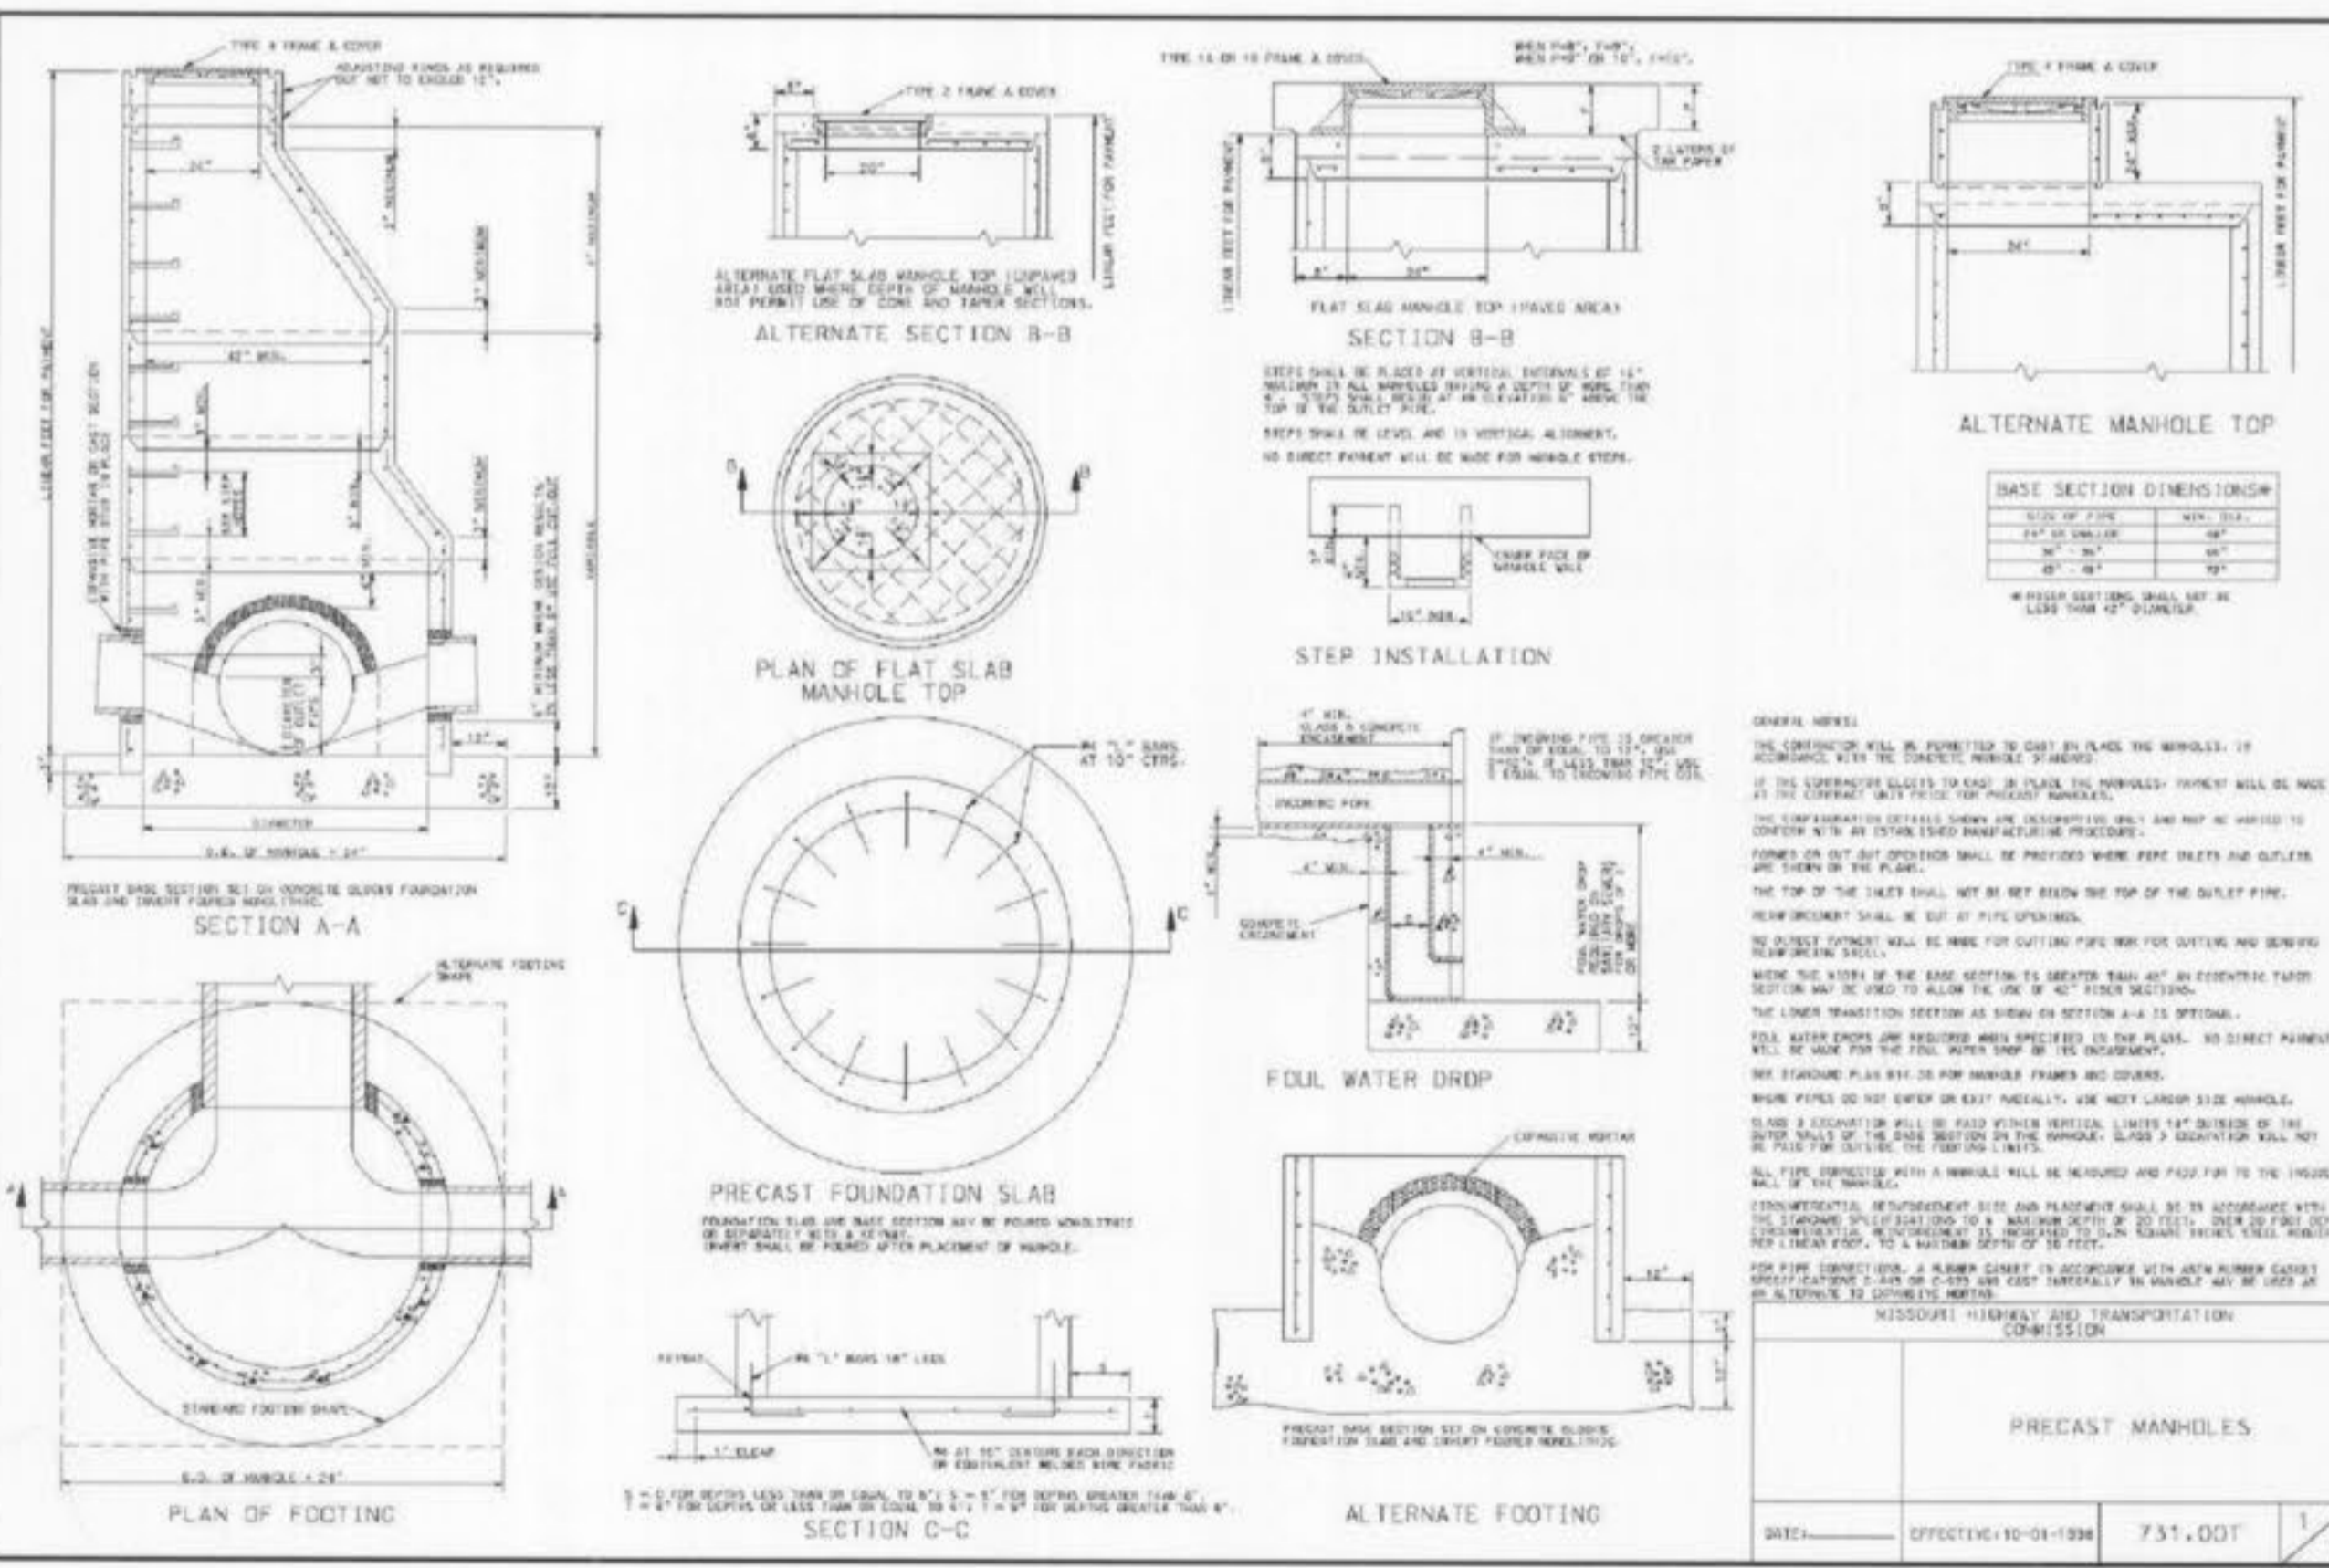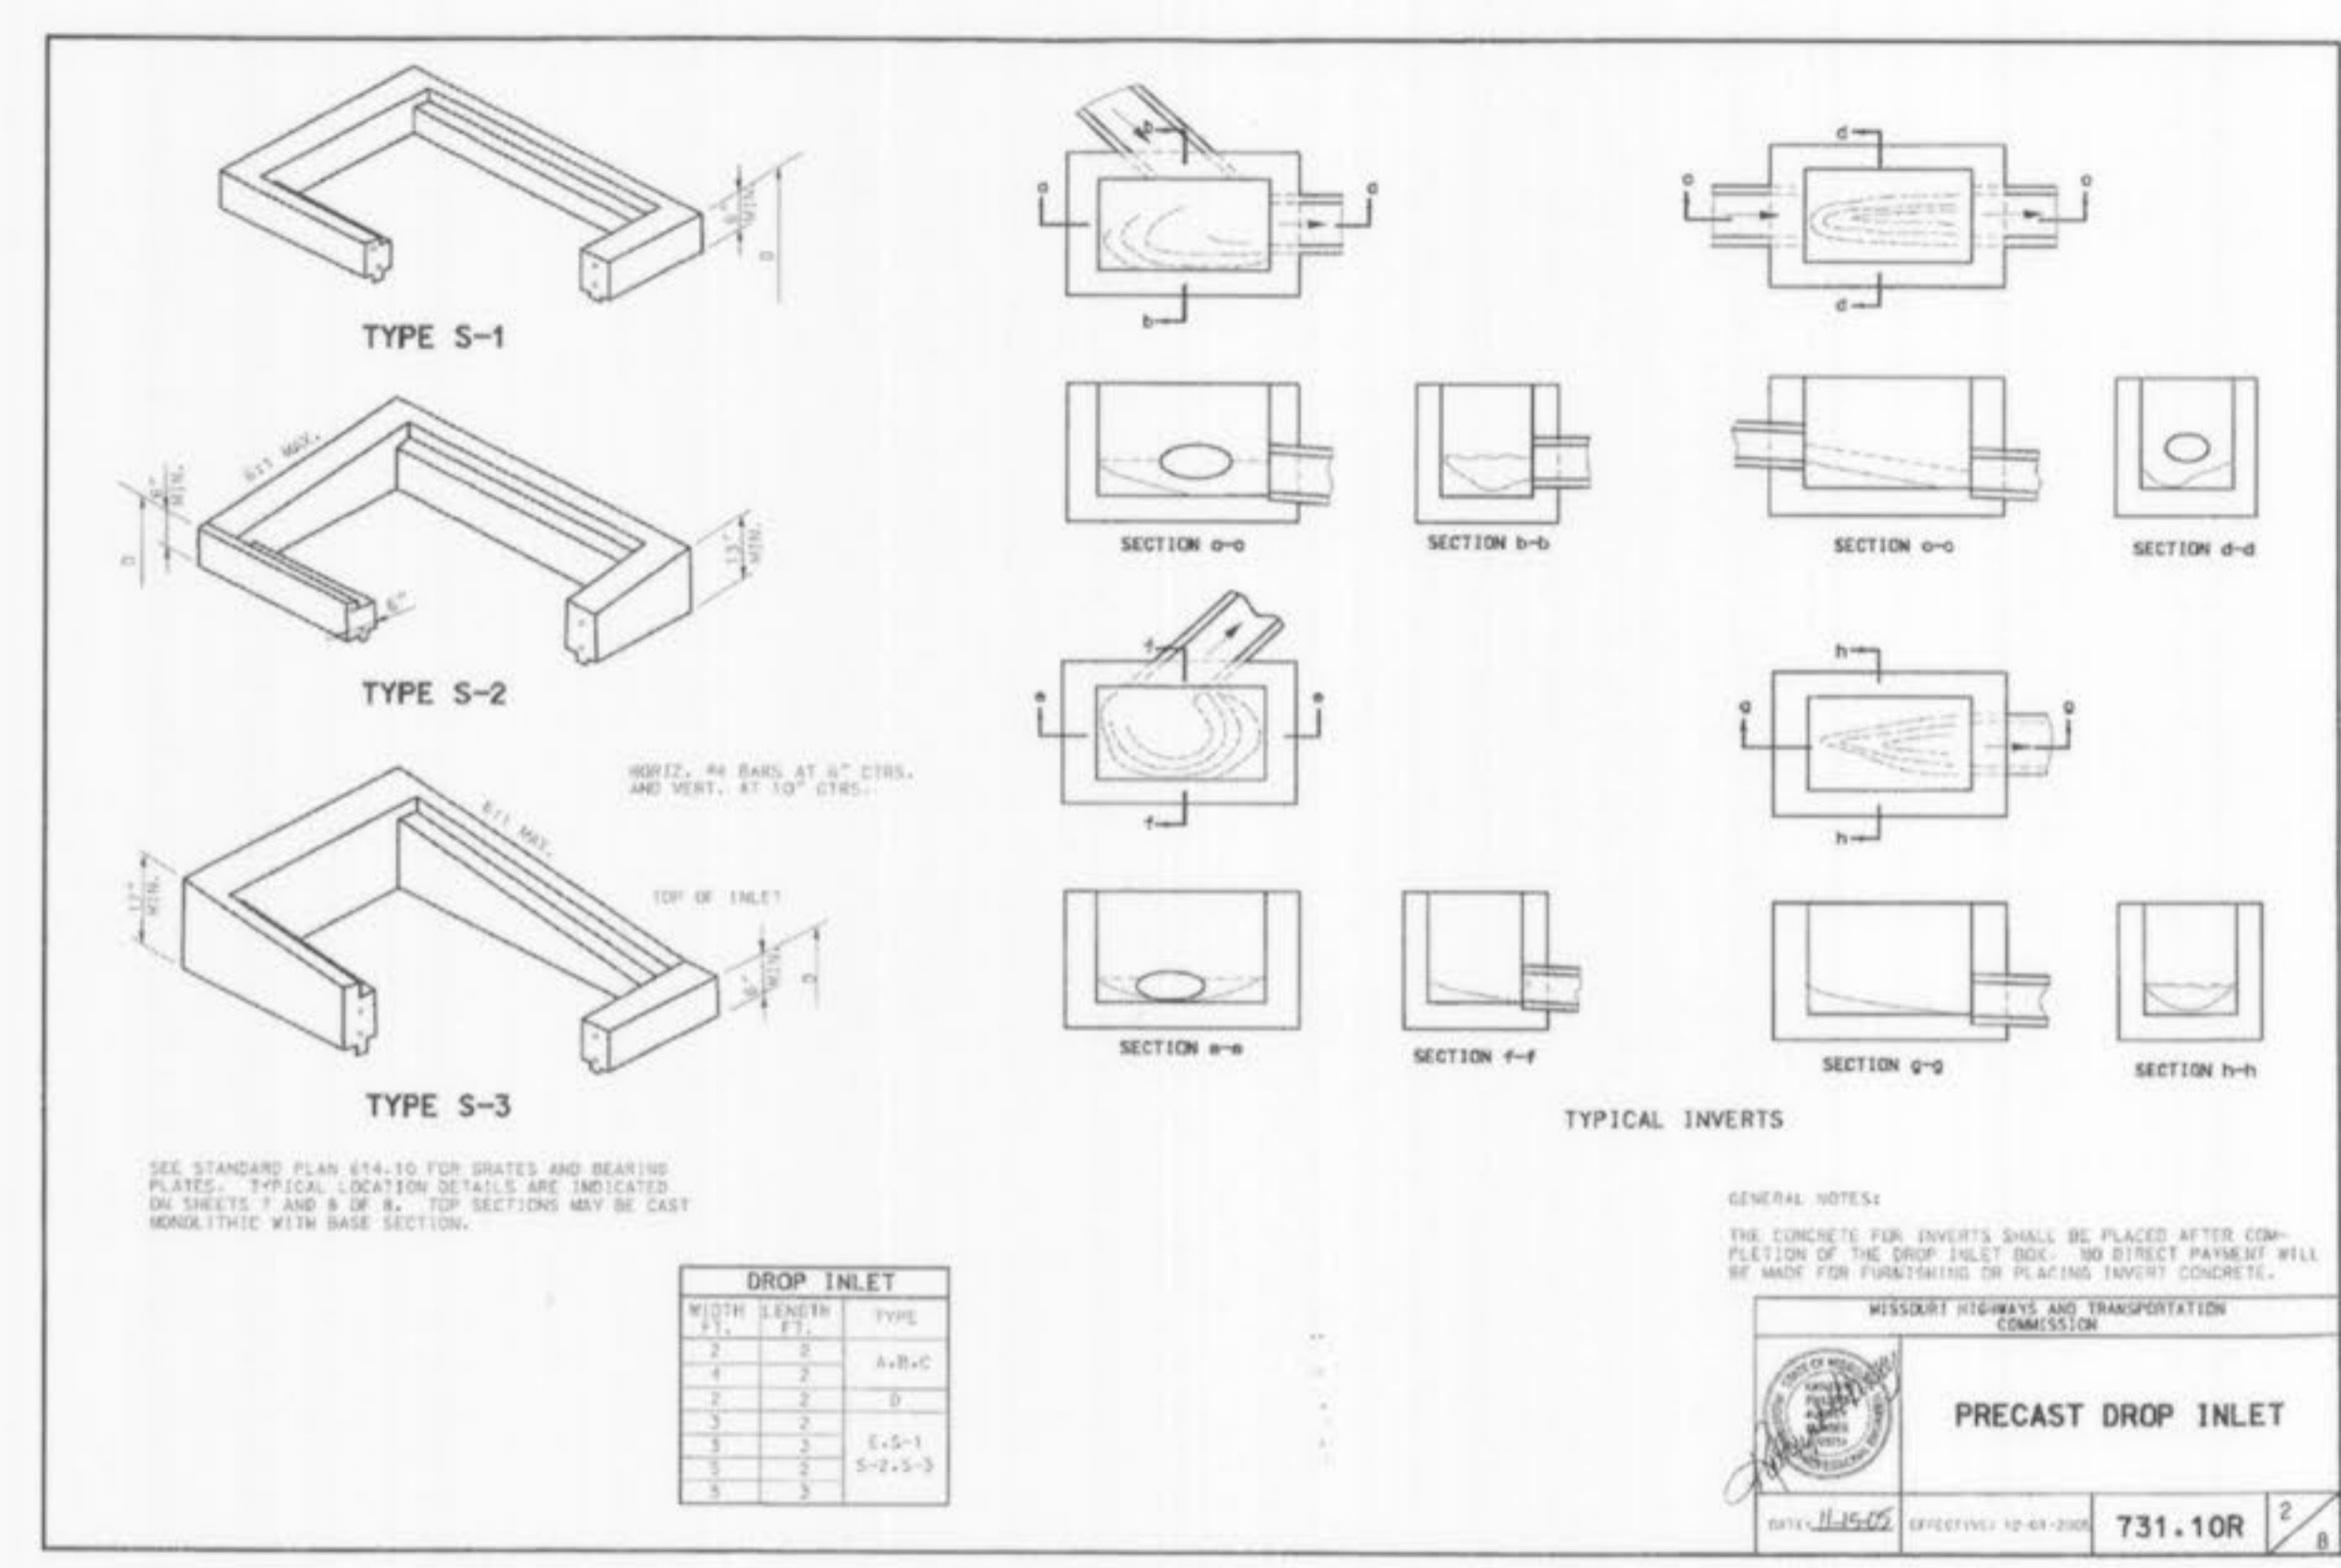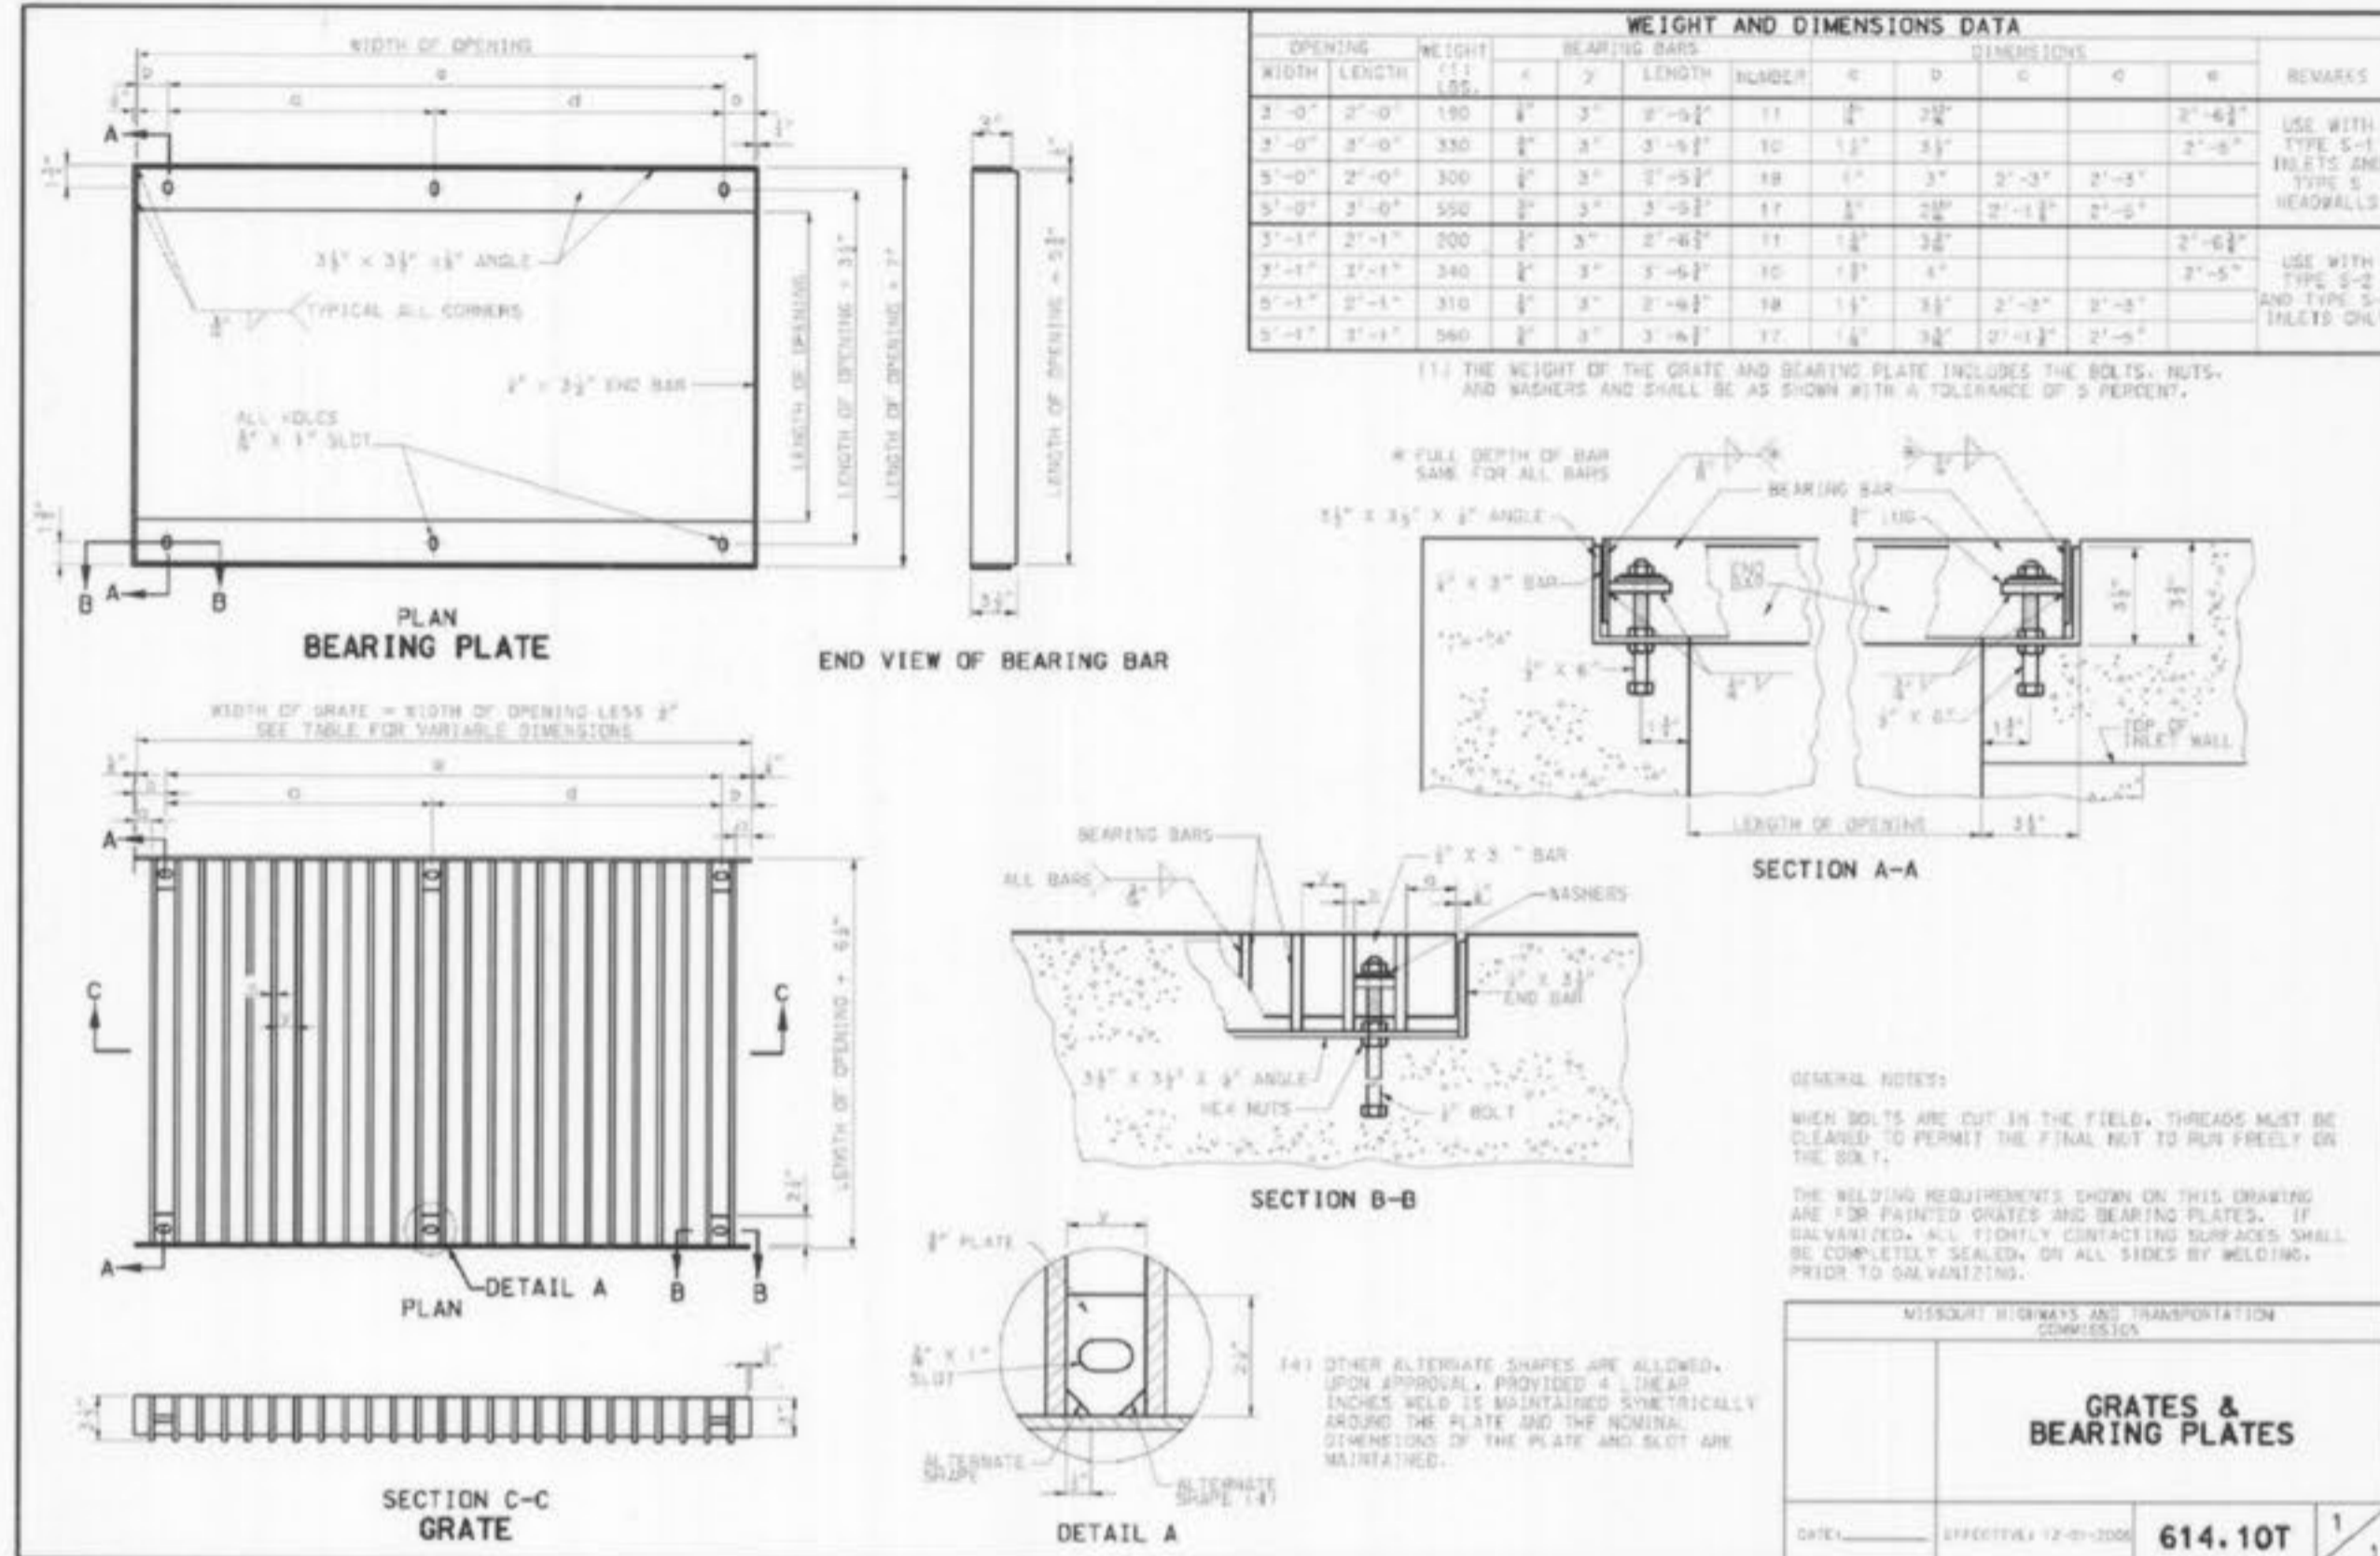

"AS-BUILTS" 12-17-07

SSM HEALTHCARE
IMPROVEMENT PLANS
OF FALLON, MO

PICKETT RAY & SILVER

CIVIL ENGINEERS
PLANNERS
LAND SURVEYORS

333 Mid Rivers Mall Drive
St. Peters, MO 63376
Phone (636) 397-1211
Fax (636) 397-1104

Prepared For:
LILLIBRIDGE

NO.	DATE	REVISIONS
1	10.19.06	REVISED PER CITY COMMENTS
2	11.09.06	REVISED PER MGDOT COMMENTS
3	12.15.06	REVISED PER MGDOT COMMENTS
4	7.31.07	REVISED PROFILE & INLET DETAIL
5	12.17.07	"AS-BUILTS"

ENGINEERS AUTHENTICATION
The responsibility for professional engineering liability on this project is hereby limited to the set of plans authenticated by the seal, signature, and date hereunder attached. Responsibility is disclaimed for all other engineering plans involved in this project and specifically excludes revisions other than those unless reauthenticated.

PICKETT, RAY & SILVER, INC.

DRAWN	DATE
J.M. WINTERS	10.11.06
CHECKED	DATE
S.D. MARION	10.11.06

PROJECT # 91090.LILB.02C
TASK # 2 FIELD BOOK 450E

SSM HEALTHCARE
IMPROVEMENT PLANS
MGDOT DETAILS

SHEET 11 OF 11
Copyright 2006 by Pickett, Ray & Silver Inc.

P&Z APPROVAL 10.05.06
FILE #2606.01

\\3server\Projects\91090.LILB\dwg\91090.DES 10-10-06.dwg, 1/28/2008 12:55:03 PM, MATT BEAVAN