


# AN AMENDED DRAINAGE PLAN FOR LOT 29 SUNSET HILL CAREFREE COMMUNITY LIVING

P.B. 41 ,PGS. 329-331


ST. CHARLES COUNTY, CITY OF O'FALLON, MISSOURI



- SITE NOTES:**
- 1) DRAINAGE AREAS AND FLOWS USED ARE PER THE APPROVED SET OF IMPROVEMENTS PLANS FOR THE SUNSET HILL CAREFREE COMMUNITY LIVING SUBDIVISION UNLESS SHOWN MODIFIED HEREON.
  - 2) ALL PERTINENT DETAILS SHALL BE PER THE APPROVED SET OF IMPROVEMENTS PLANS FOR THE SUNSET HILL CAREFREE COMMUNITY LIVING SUBDIVISION.
  - 3) ALL PERTINENT NOTES AND SPECIFICATIONS SHALL BE PER THE APPROVED SET OF IMPROVEMENT PLANS FOR THE SUNSET HILL CAREFREE COMMUNITY LIVING SUBDIVISION.

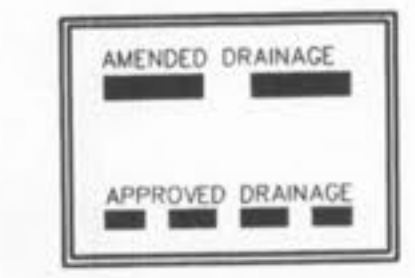

CITY OF O'FALLON  
COMMUNITY DEVELOPMENT DEPARTMENT  
ACCEPTED FOR CONSTRUCTION  
BY: *[Signature]* DATE: *10/2/07*  
PROFESSIONAL ENGINEER'S SEAL  
INDICATES RESPONSIBILITY FOR DESIGN

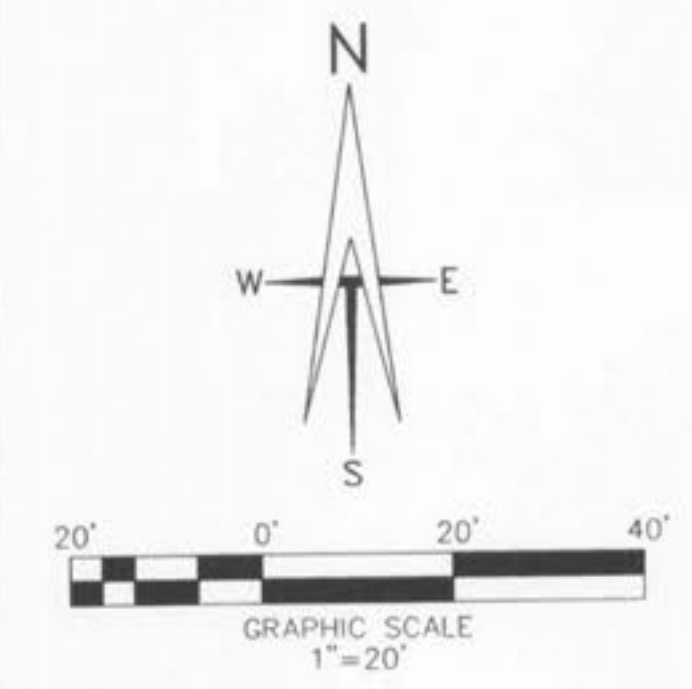

THE UNDERGROUND UTILITIES SHOWN HEREIN WERE PLOTTED FROM AVAILABLE INFORMATION AND DO NOT NECESSARILY REFLECT THE ACTUAL EXISTENCE OR NONEXISTENCE, SIZE, TYPE, NUMBER OR LOCATION OF THESE OR OTHER UTILITIES. THE GENERAL CONTRACTOR SHALL BE RESPONSIBLE FOR VERIFYING THE ACTUAL LOCATION OF ALL UNDERGROUND UTILITIES, SHOWN OR NOT SHOWN, AND SAID UTILITIES SHALL BE LOCATED IN THE FIELD PRIOR TO ANY GRADING, EXCAVATION OR CONSTRUCTION OF IMPROVEMENTS. THESE PROVISIONS SHALL IN NO WAY ABSOLVE ANY PARTY FROM COMPLYING WITH THE UNDERGROUND FACILITY SAFETY AND DAMAGE PREVENTION ACT, CHAPTER 319, RSMO.



**ENGINEERS AUTHENTICATION**  
The responsibility for the professional engineering liability on this project is hereby limited to the set of plans authenticated by the seal, signature and date hereunder attached. Responsibility is disclaimed for all other engineering plans involved in the project and specifically excludes revisions after this date unless reauthenticated.

SUNSET HILL CAREFREE  
COMMUNITY LIVING  
AMENDED DRAINAGE PLAN

ST. CHARLES ENGINEERING & SURVEYING, INC.  
801 S. FIFTH STREET, SUITE 202  
ST. CHARLES, MO 63301  
TEL: (636) 947-0607 FAX: (636) 947-2448



ORDER NO.  
070153  
DATE  
09-11-07  
1