



N / F
 PIEPER, ET AL
 BK. 893 PG. 1259
 ZONED A-1
 ST. CHARLES COUNTY

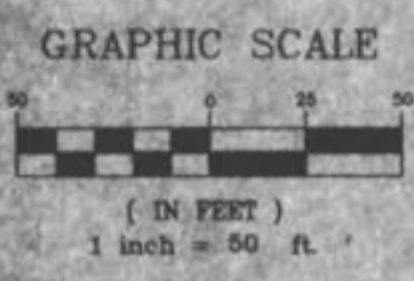

N / F
 PIEPER, ET AL
 BK. 893 PG. 1259
 ZONED A-1
 ST. CHARLES COUNTY






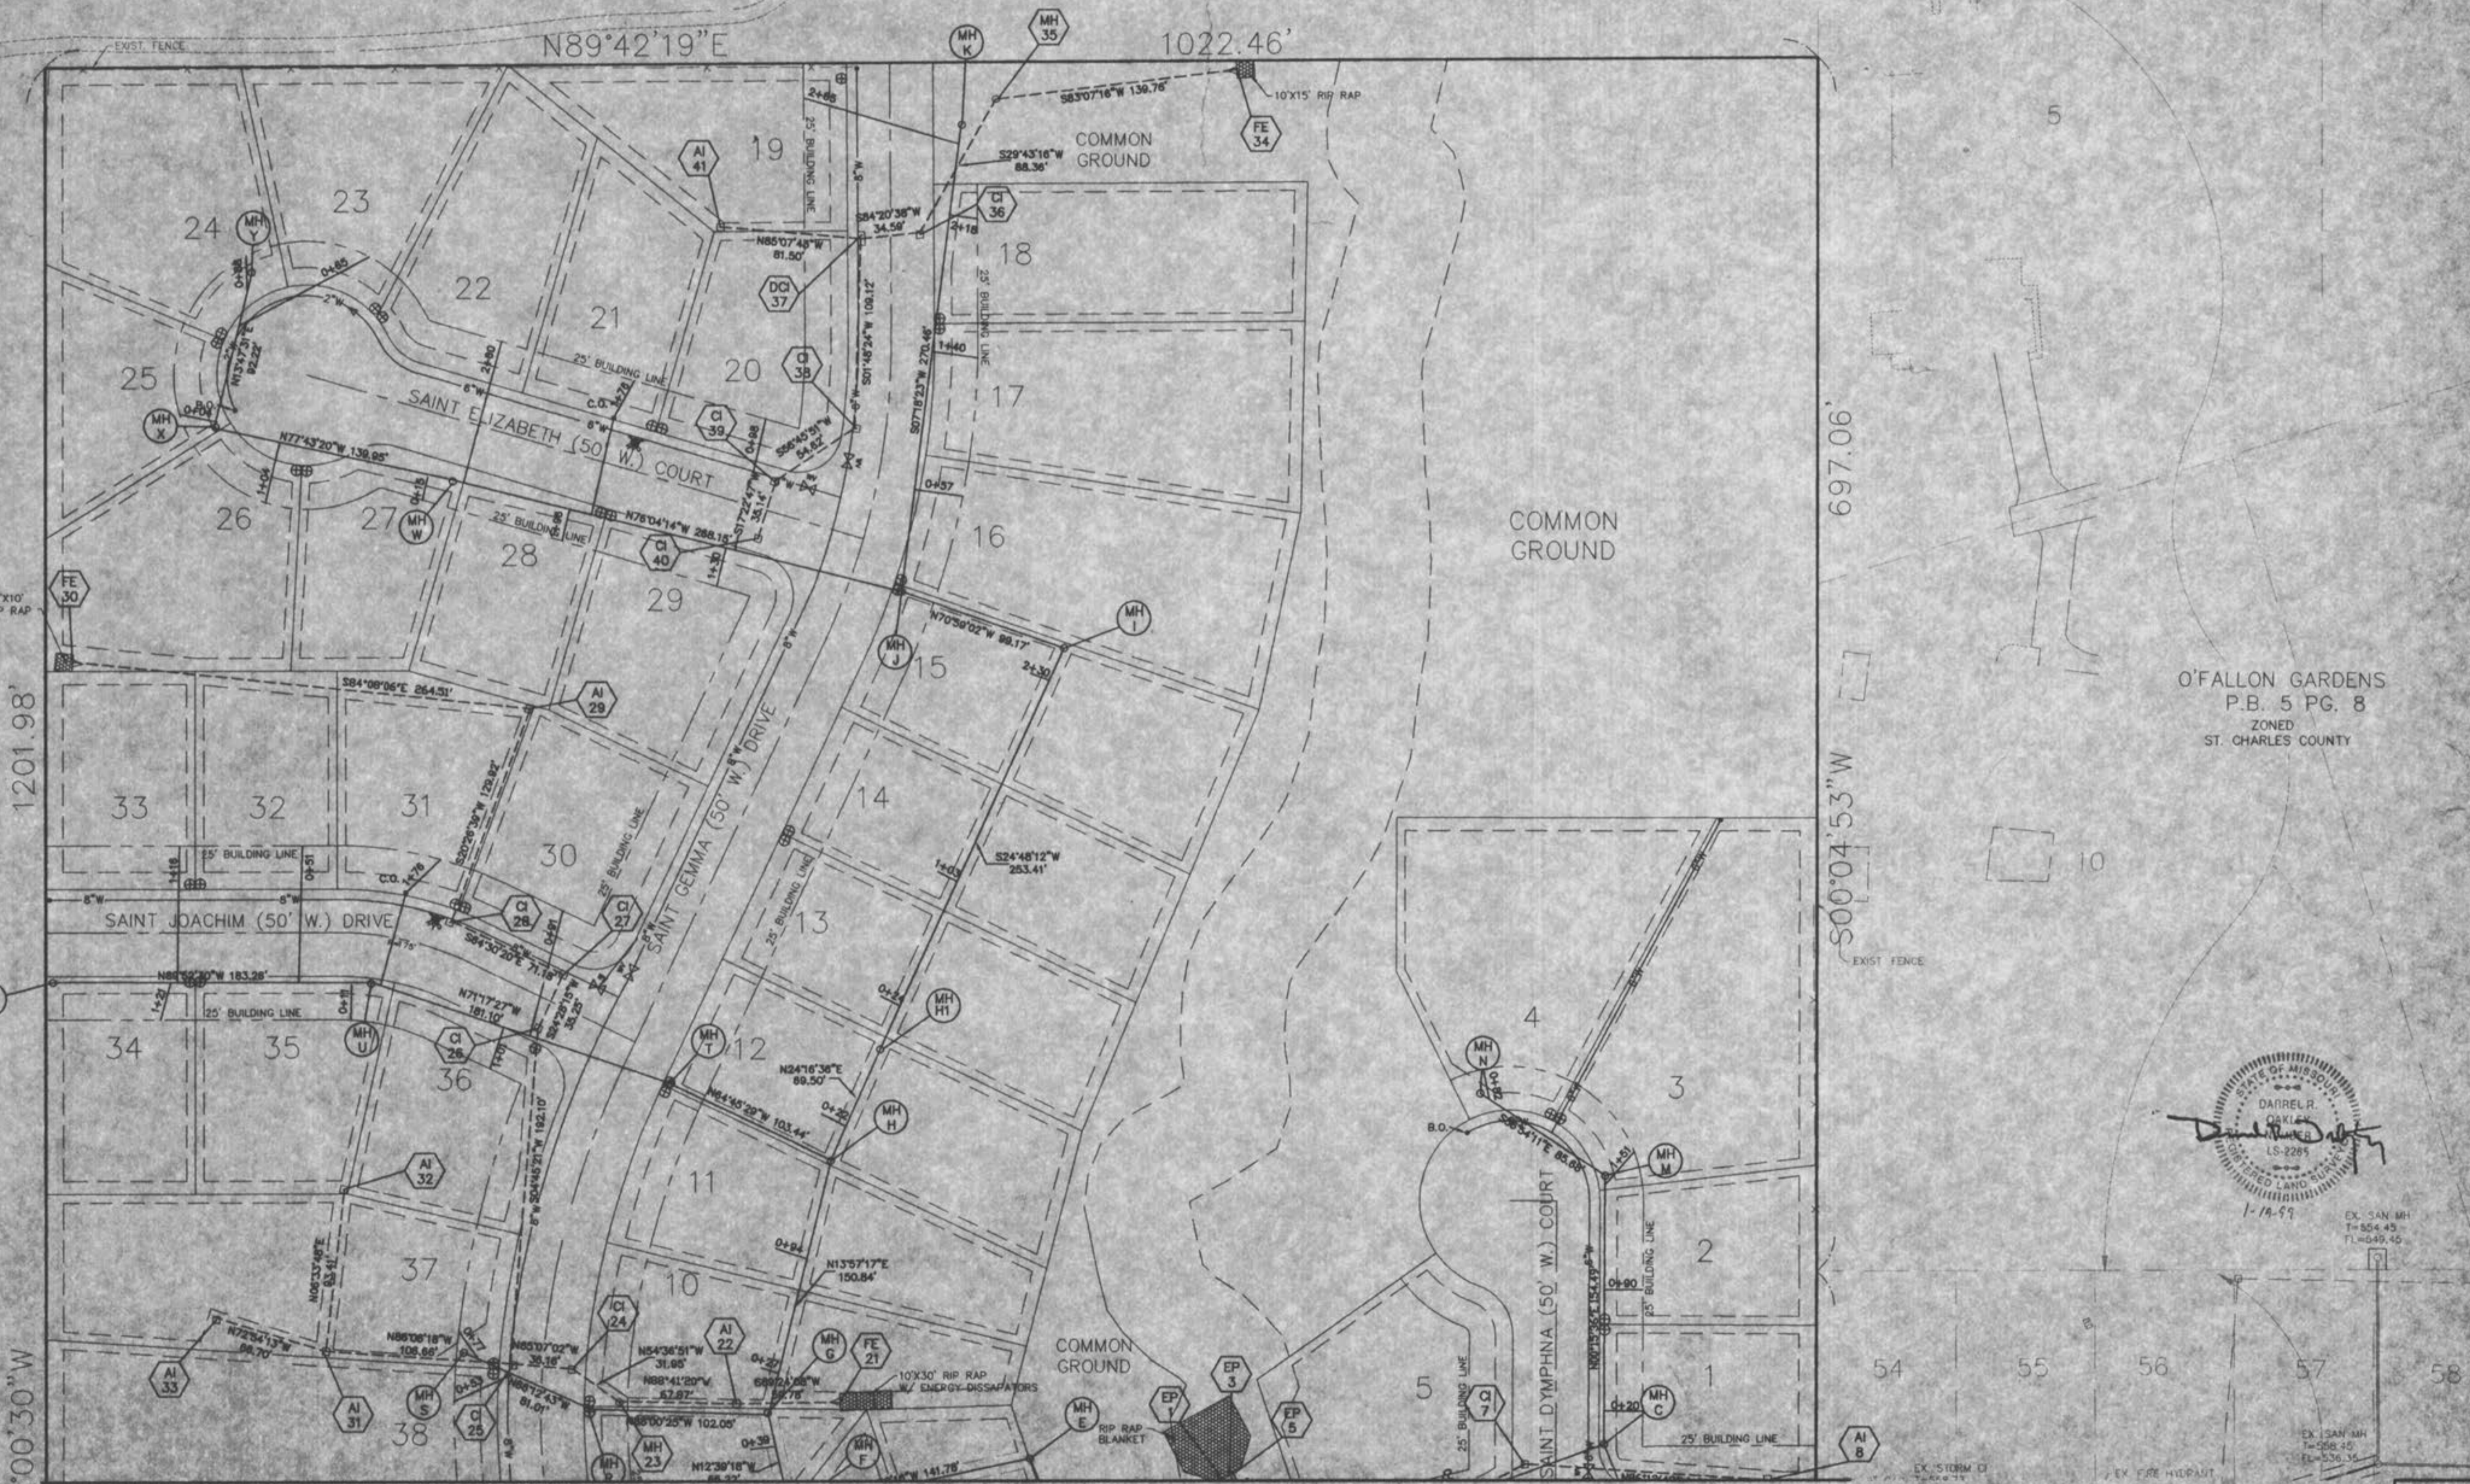


O'FALLON GARDENS
 P.B. 5 PG. 8
 ZONED
 ST. CHARLES COUNTY



MATCHLINE SHEET 2



AS-BUILTS ADDED JANUARY, 1999

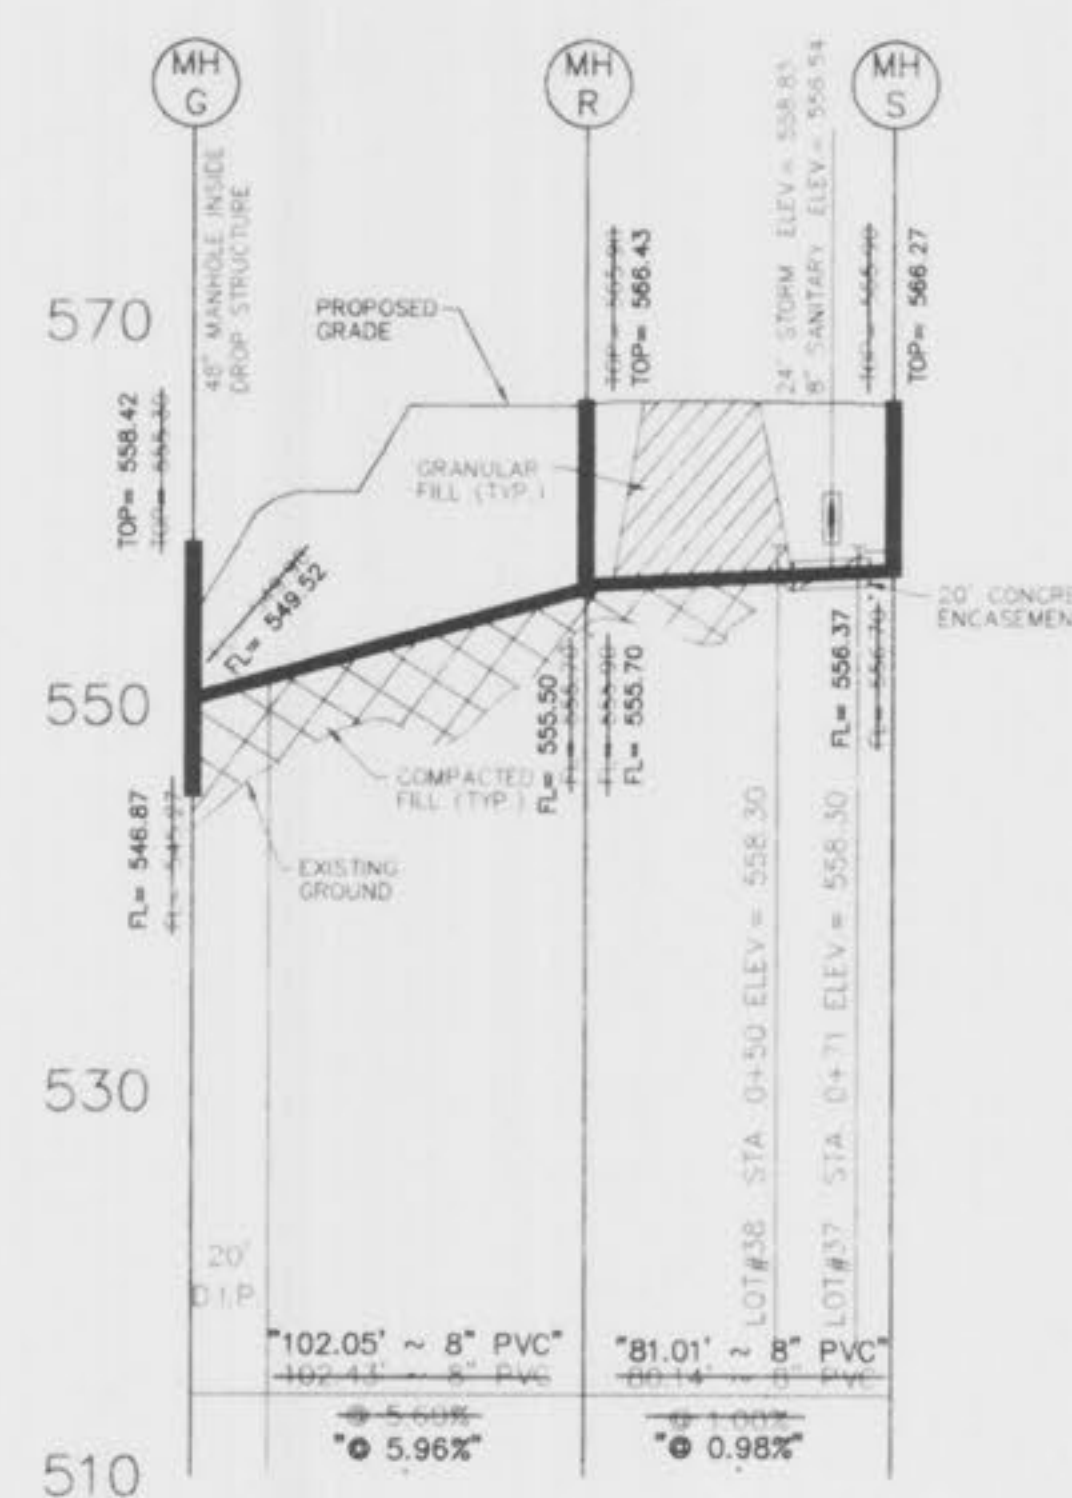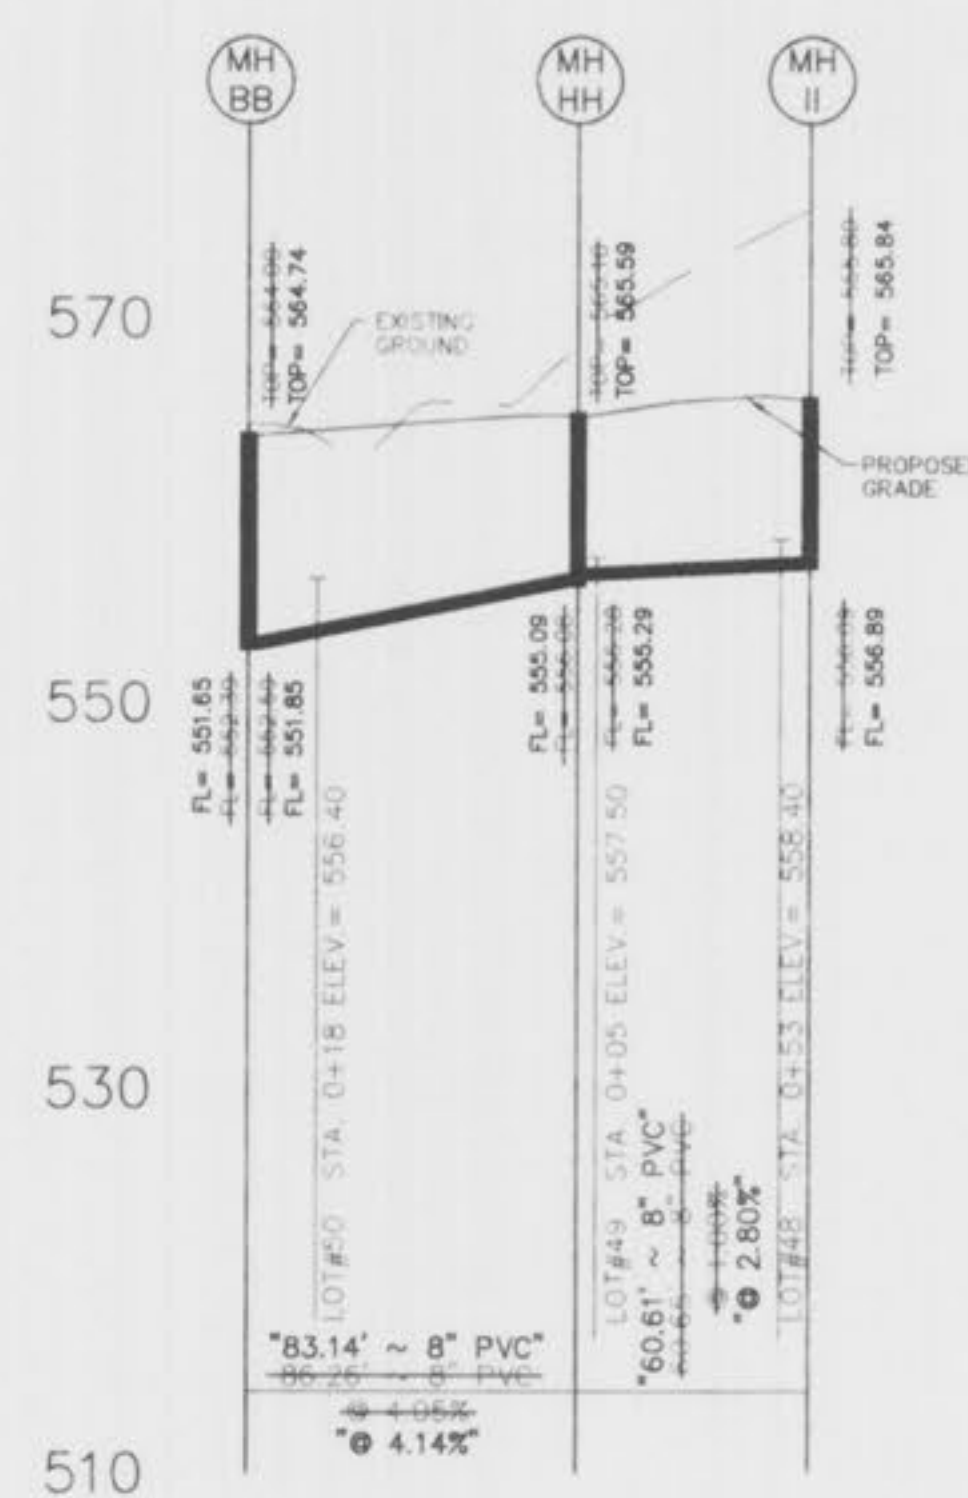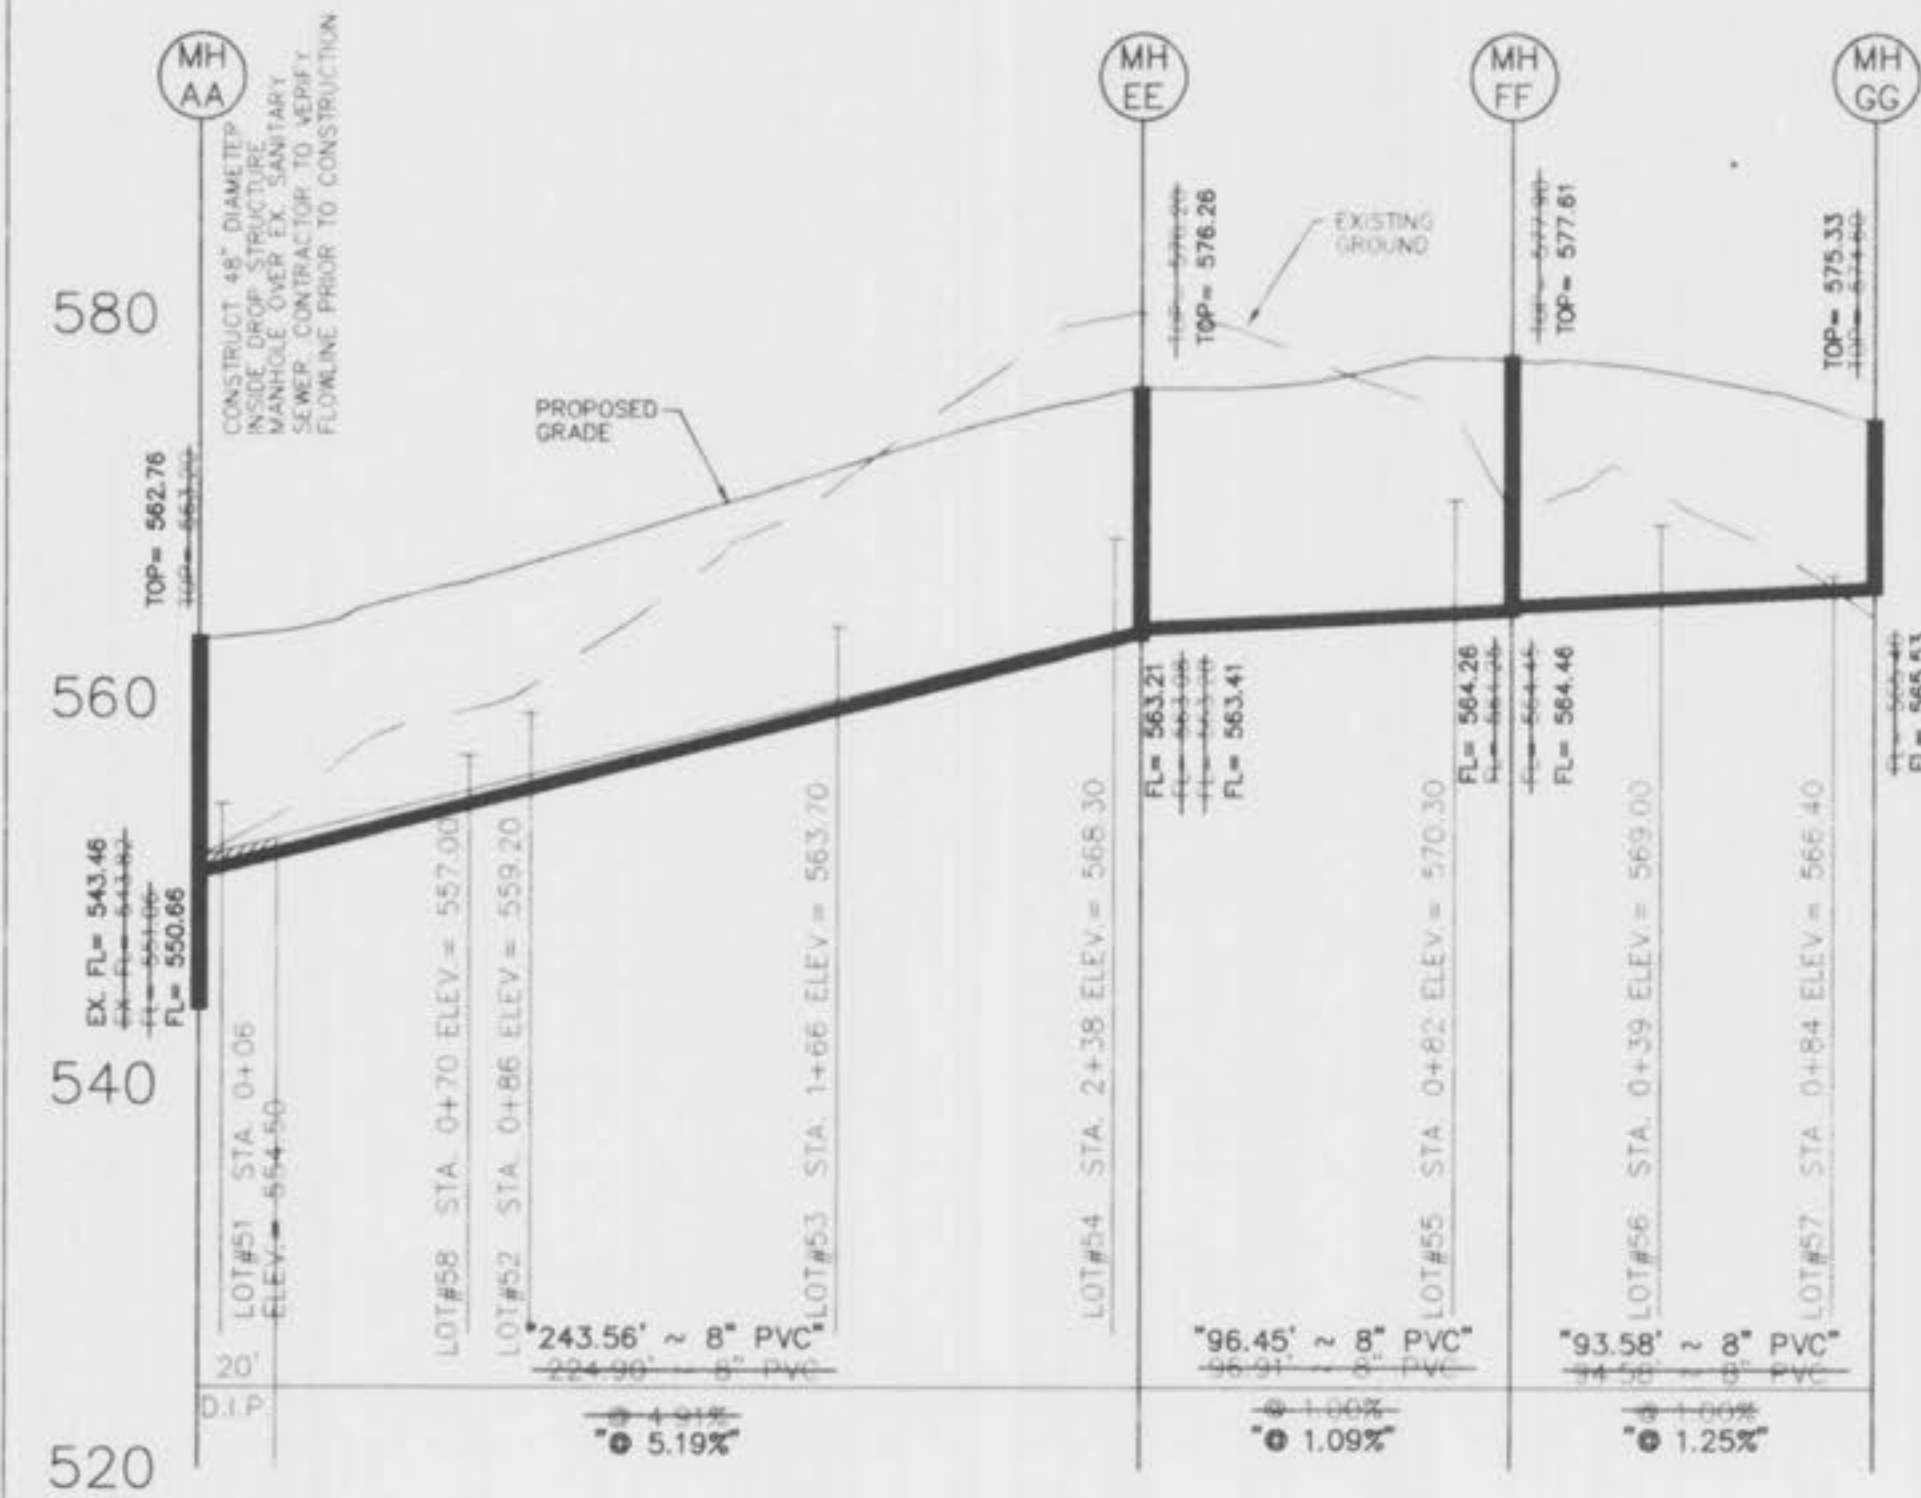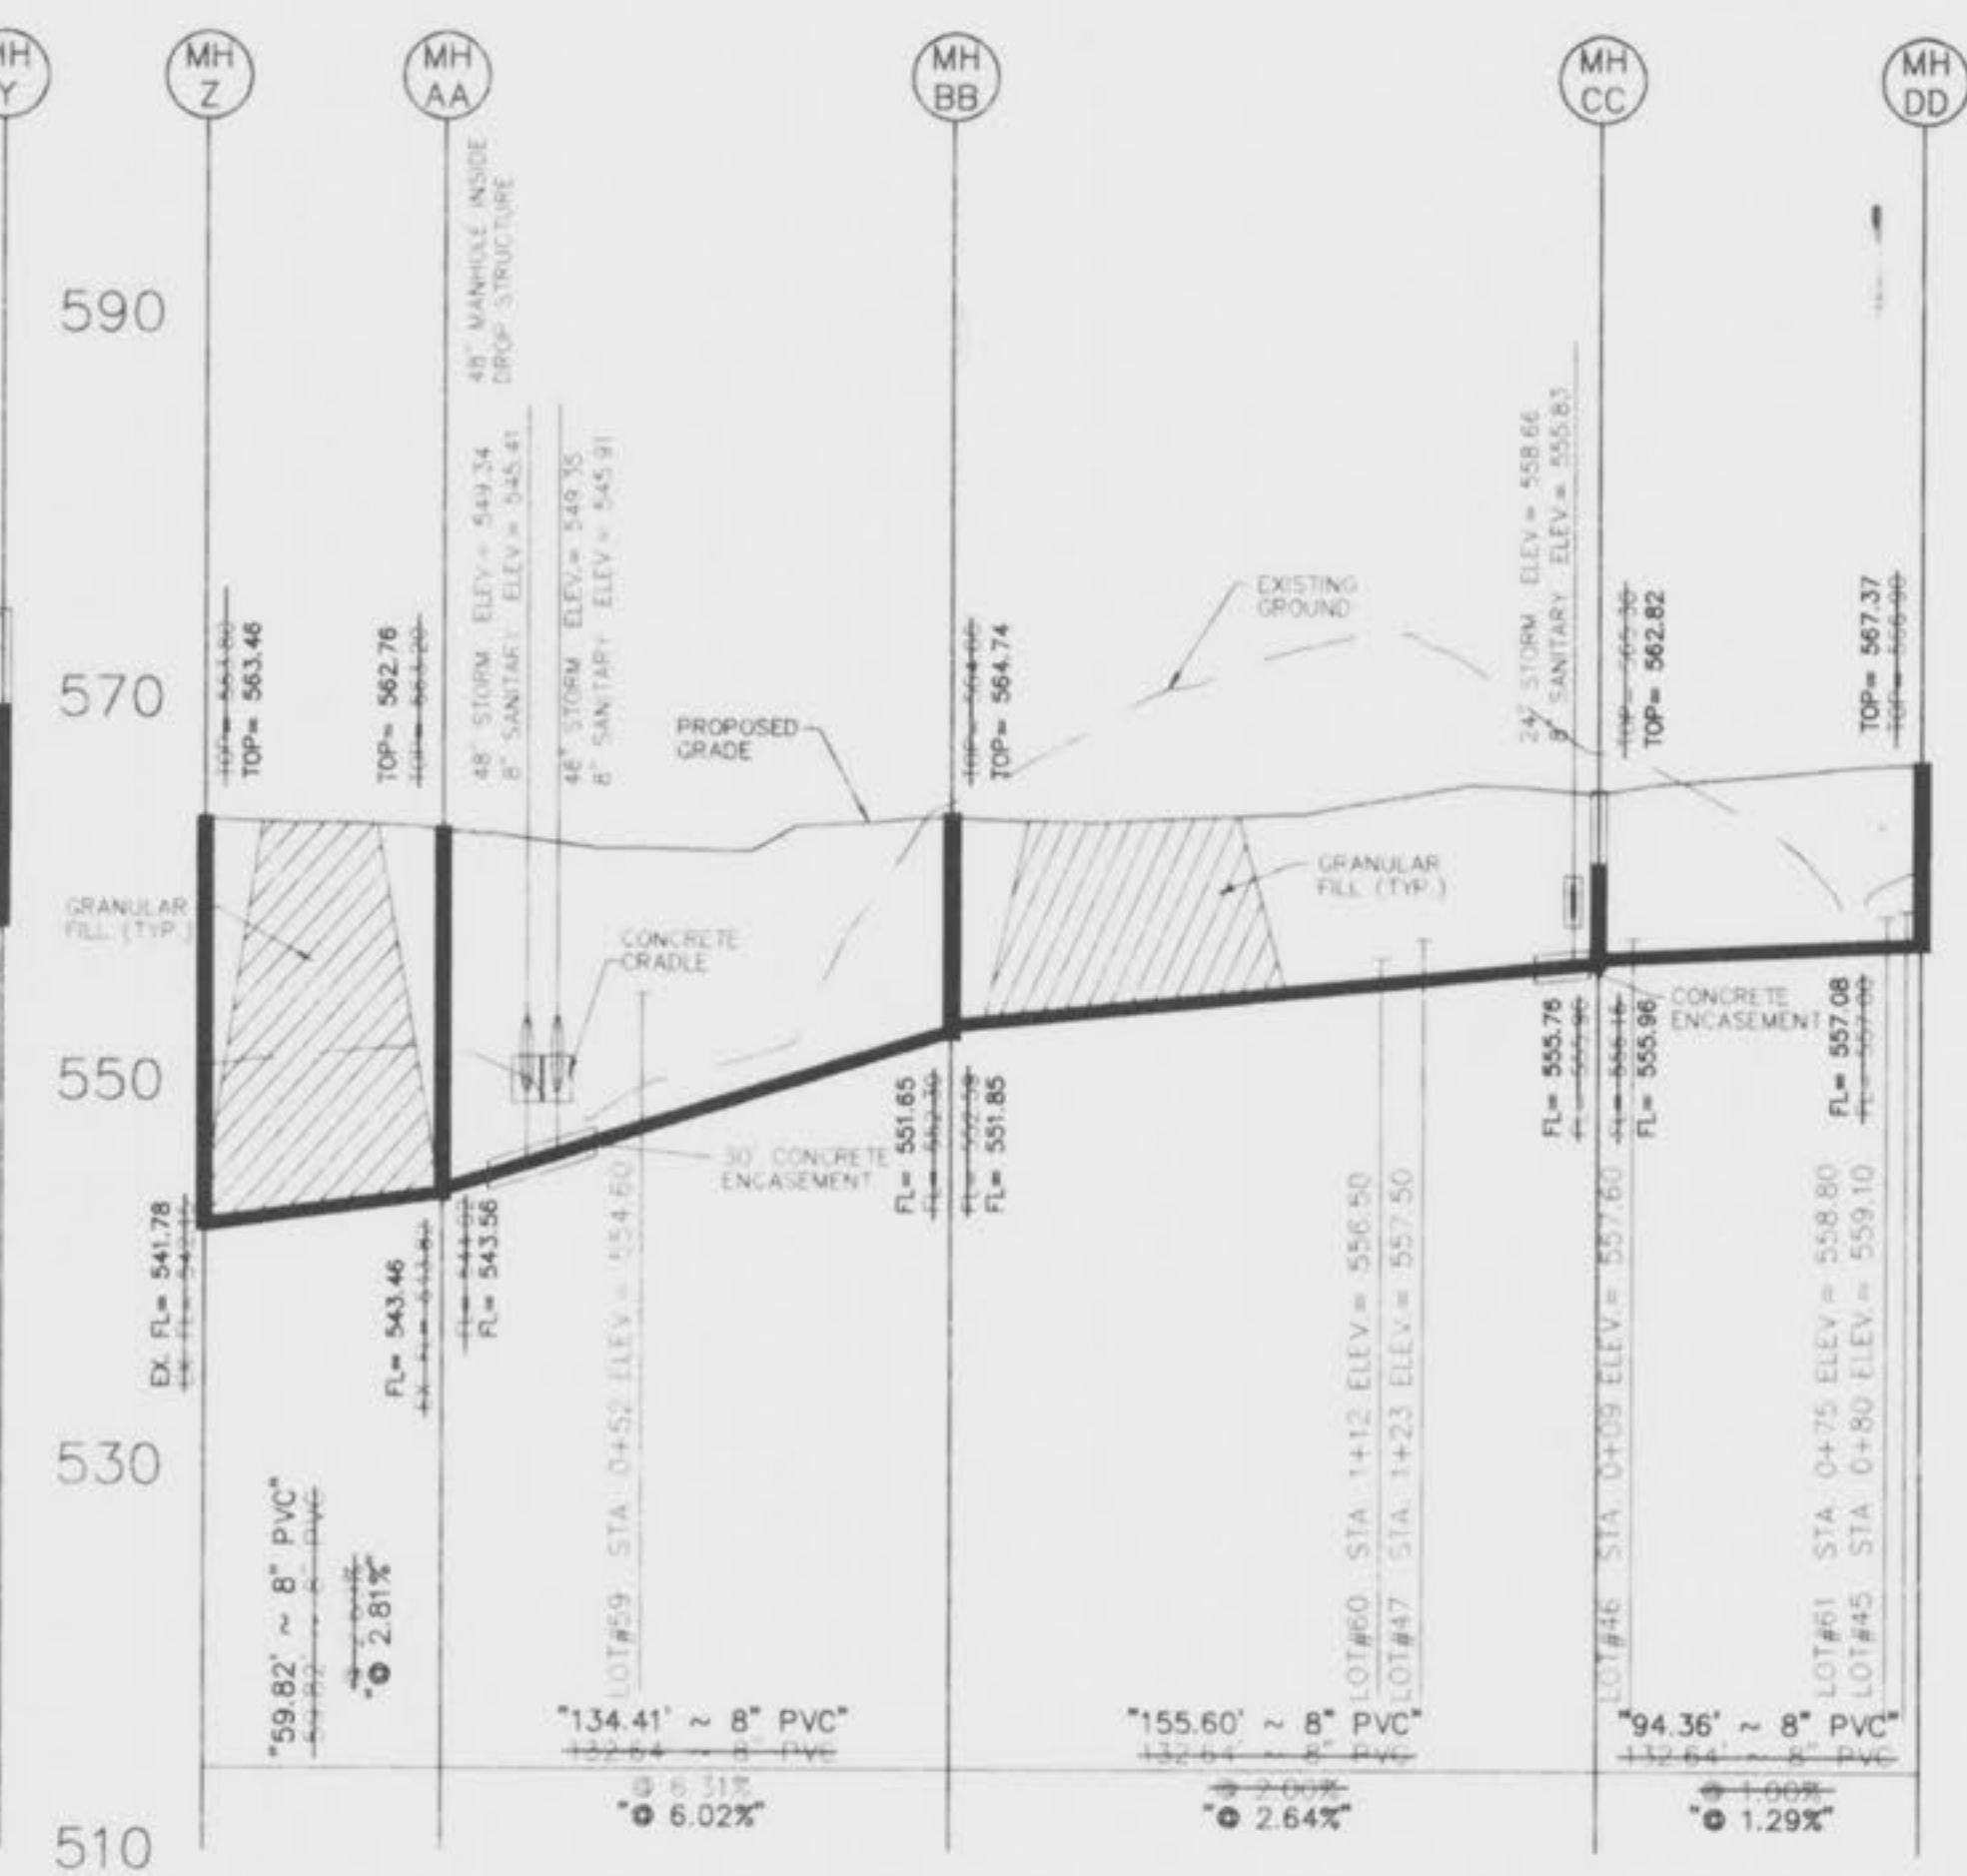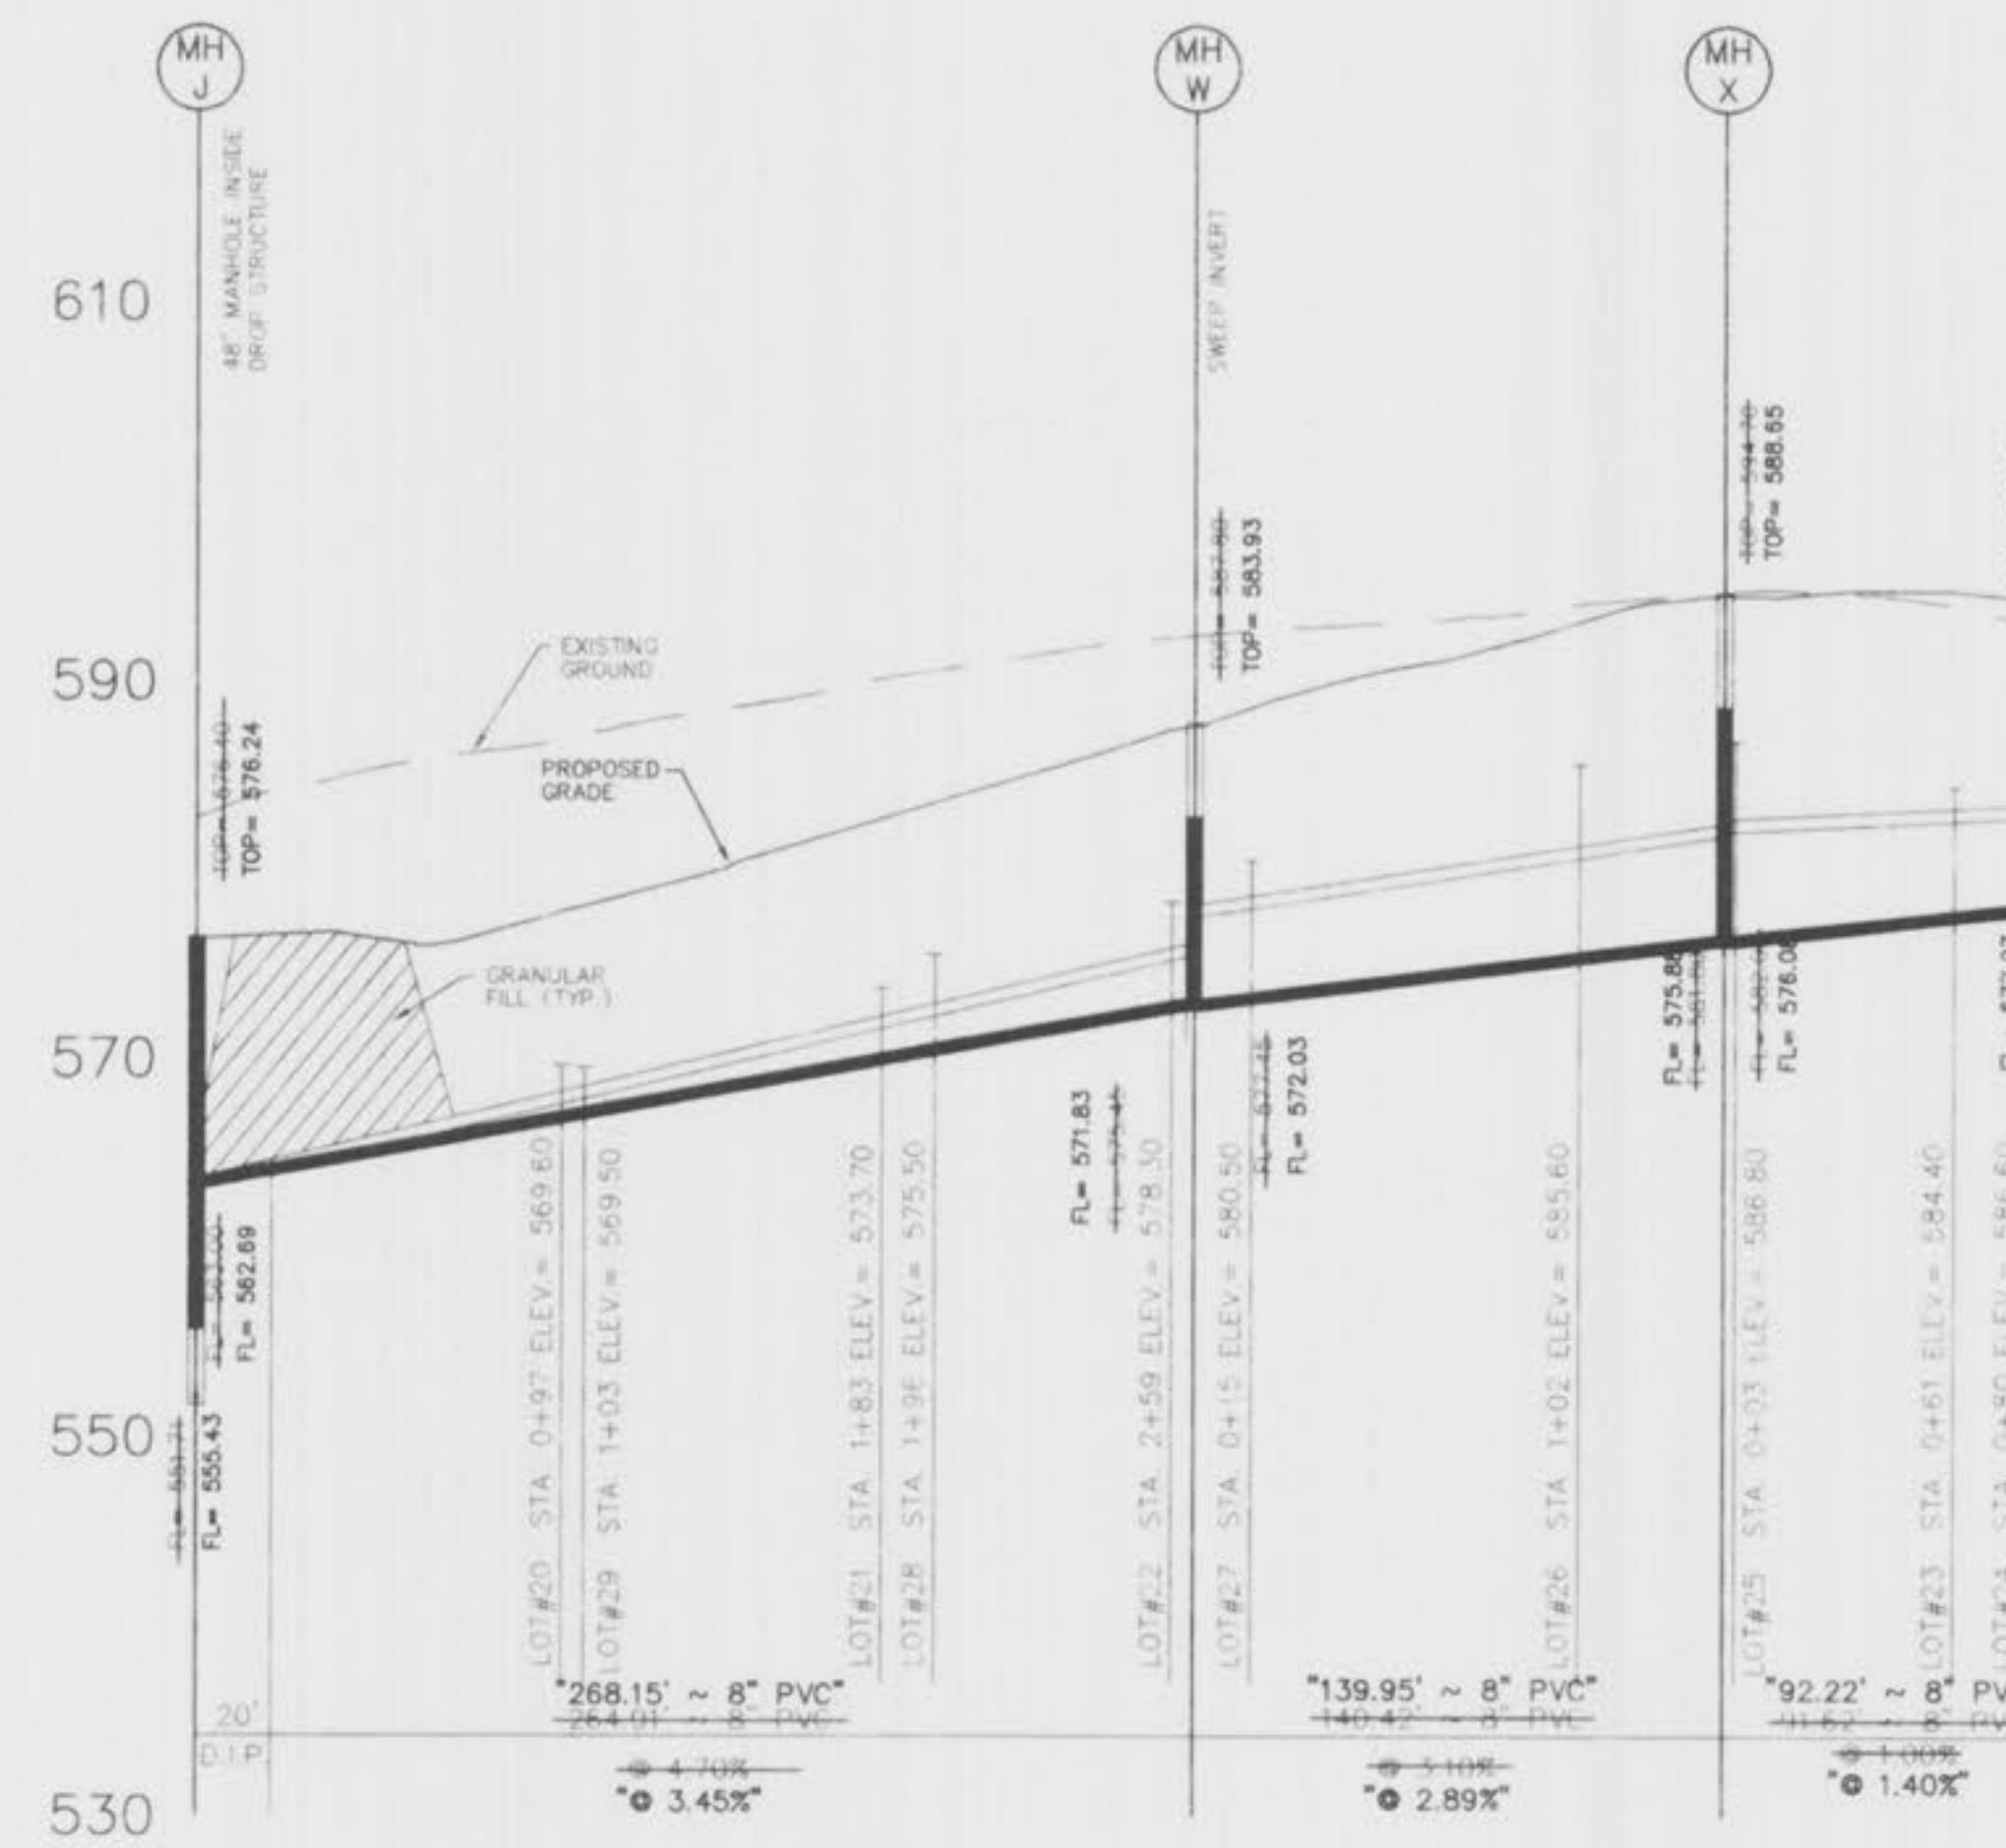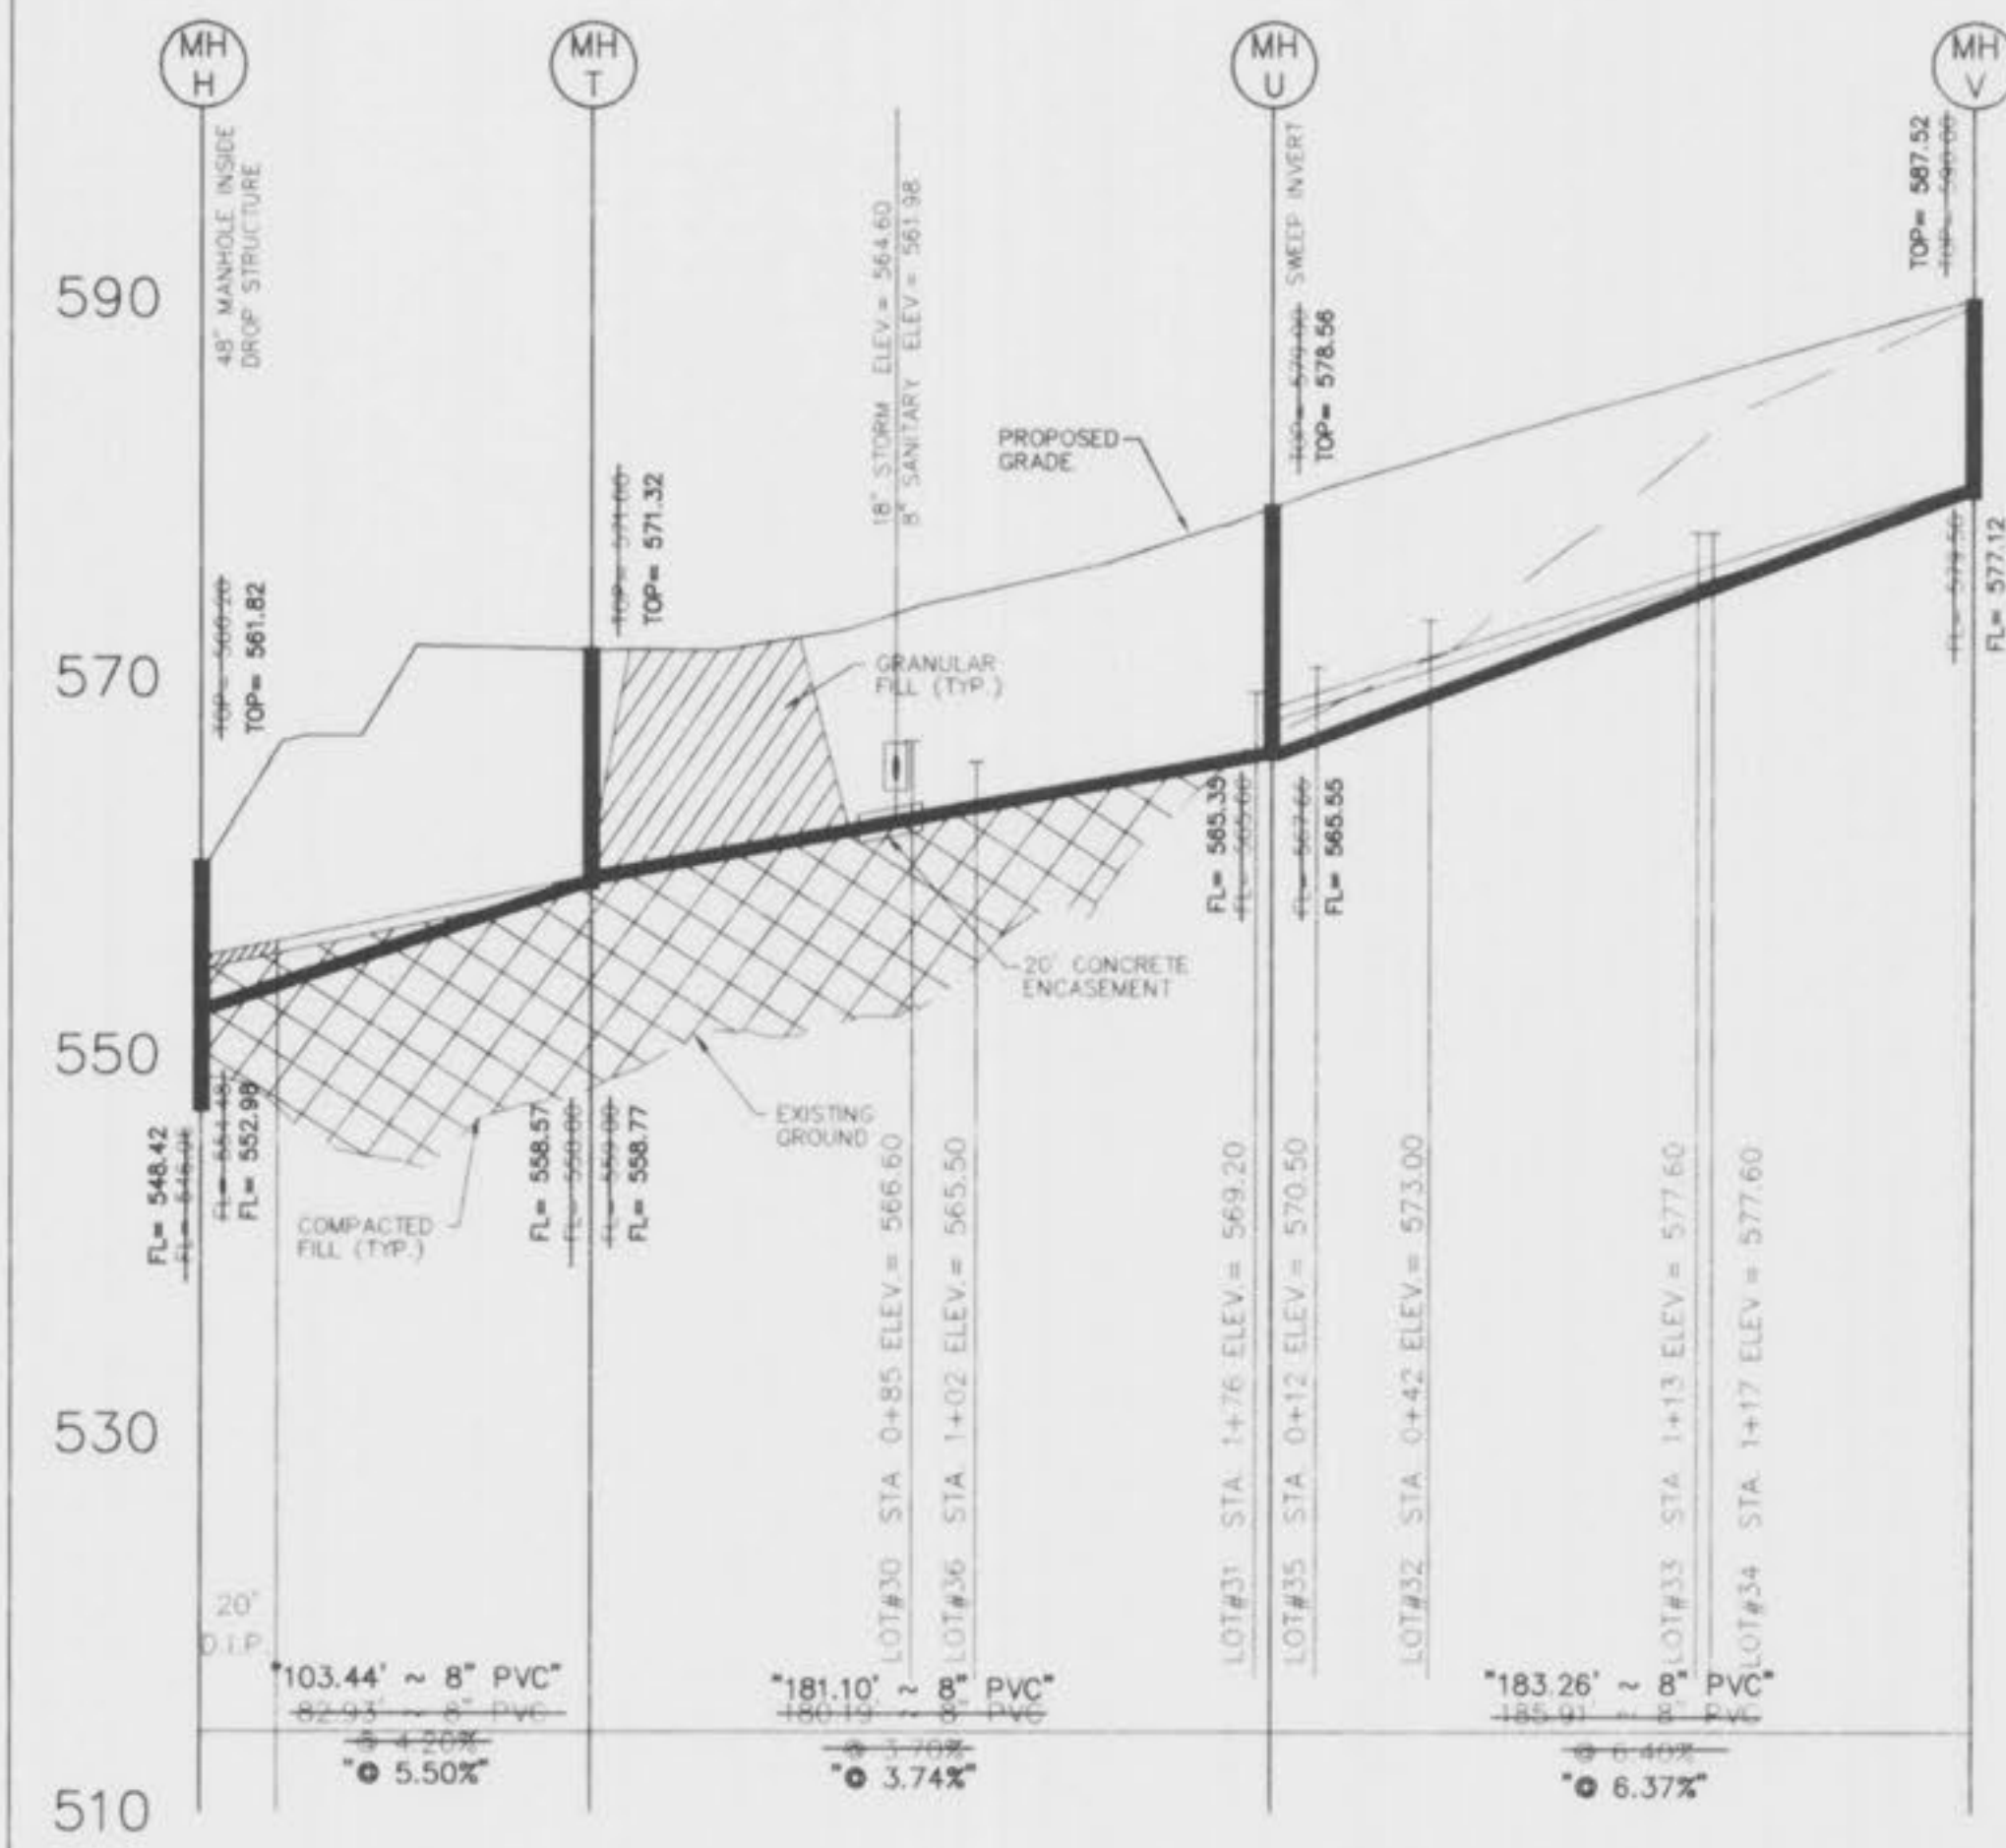

AS-BUILTS ADDED JANUARY, 1999

SCALE: 1"=10' VERTICAL
 1"=50' HORIZONTAL


Daniel J. [Signature]
 1-19-99

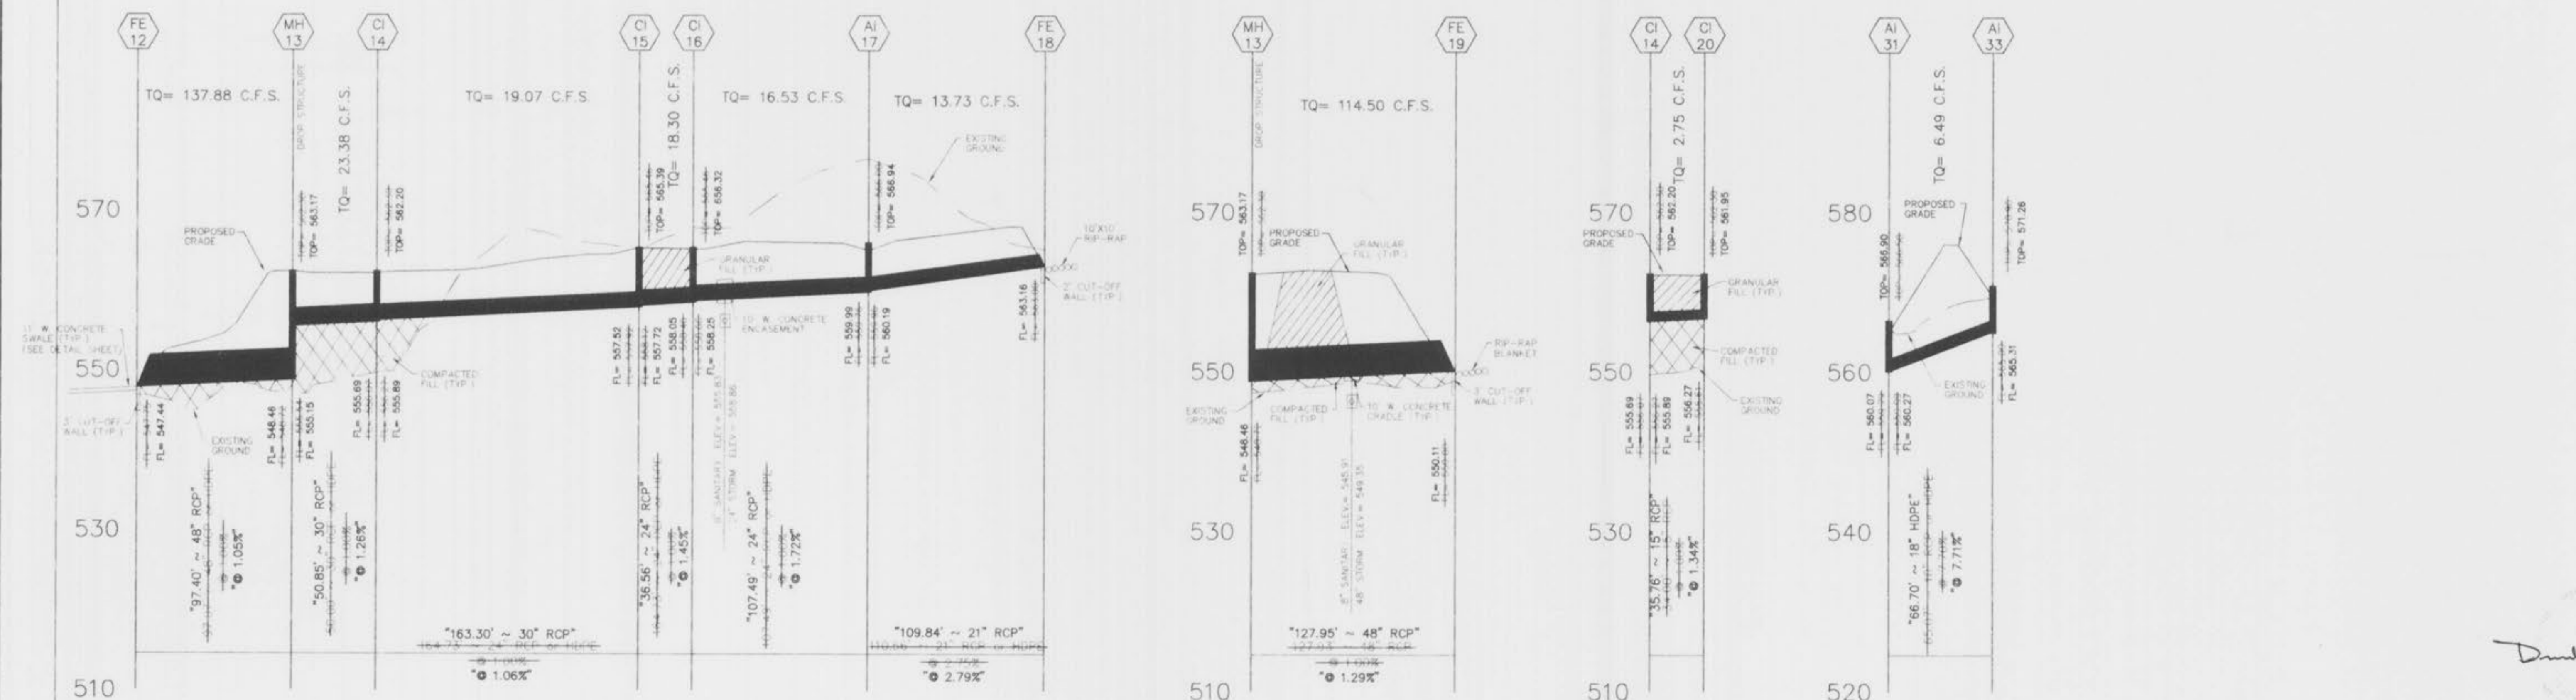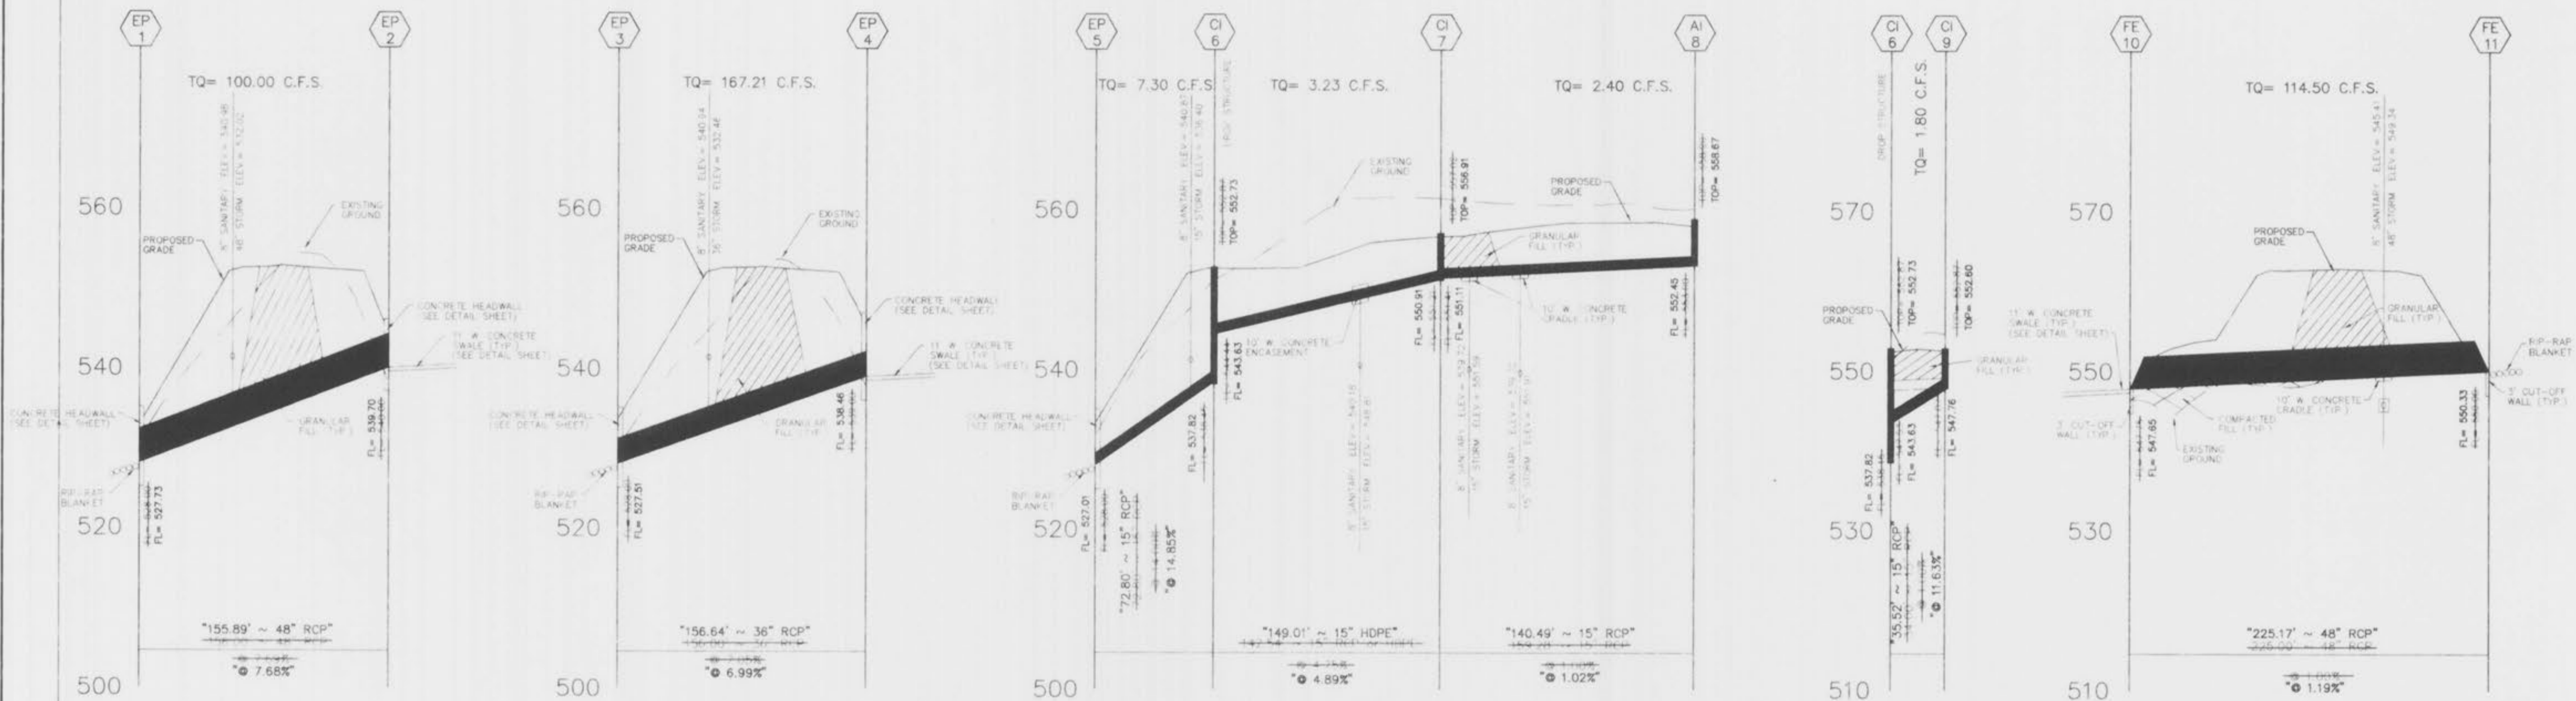

AS-BUILTS ADDED JANUARY, 1999

SCALE: 1"=10' VERTICAL
 1"=50' HORIZONTAL

David R. Duff
 1-15-99

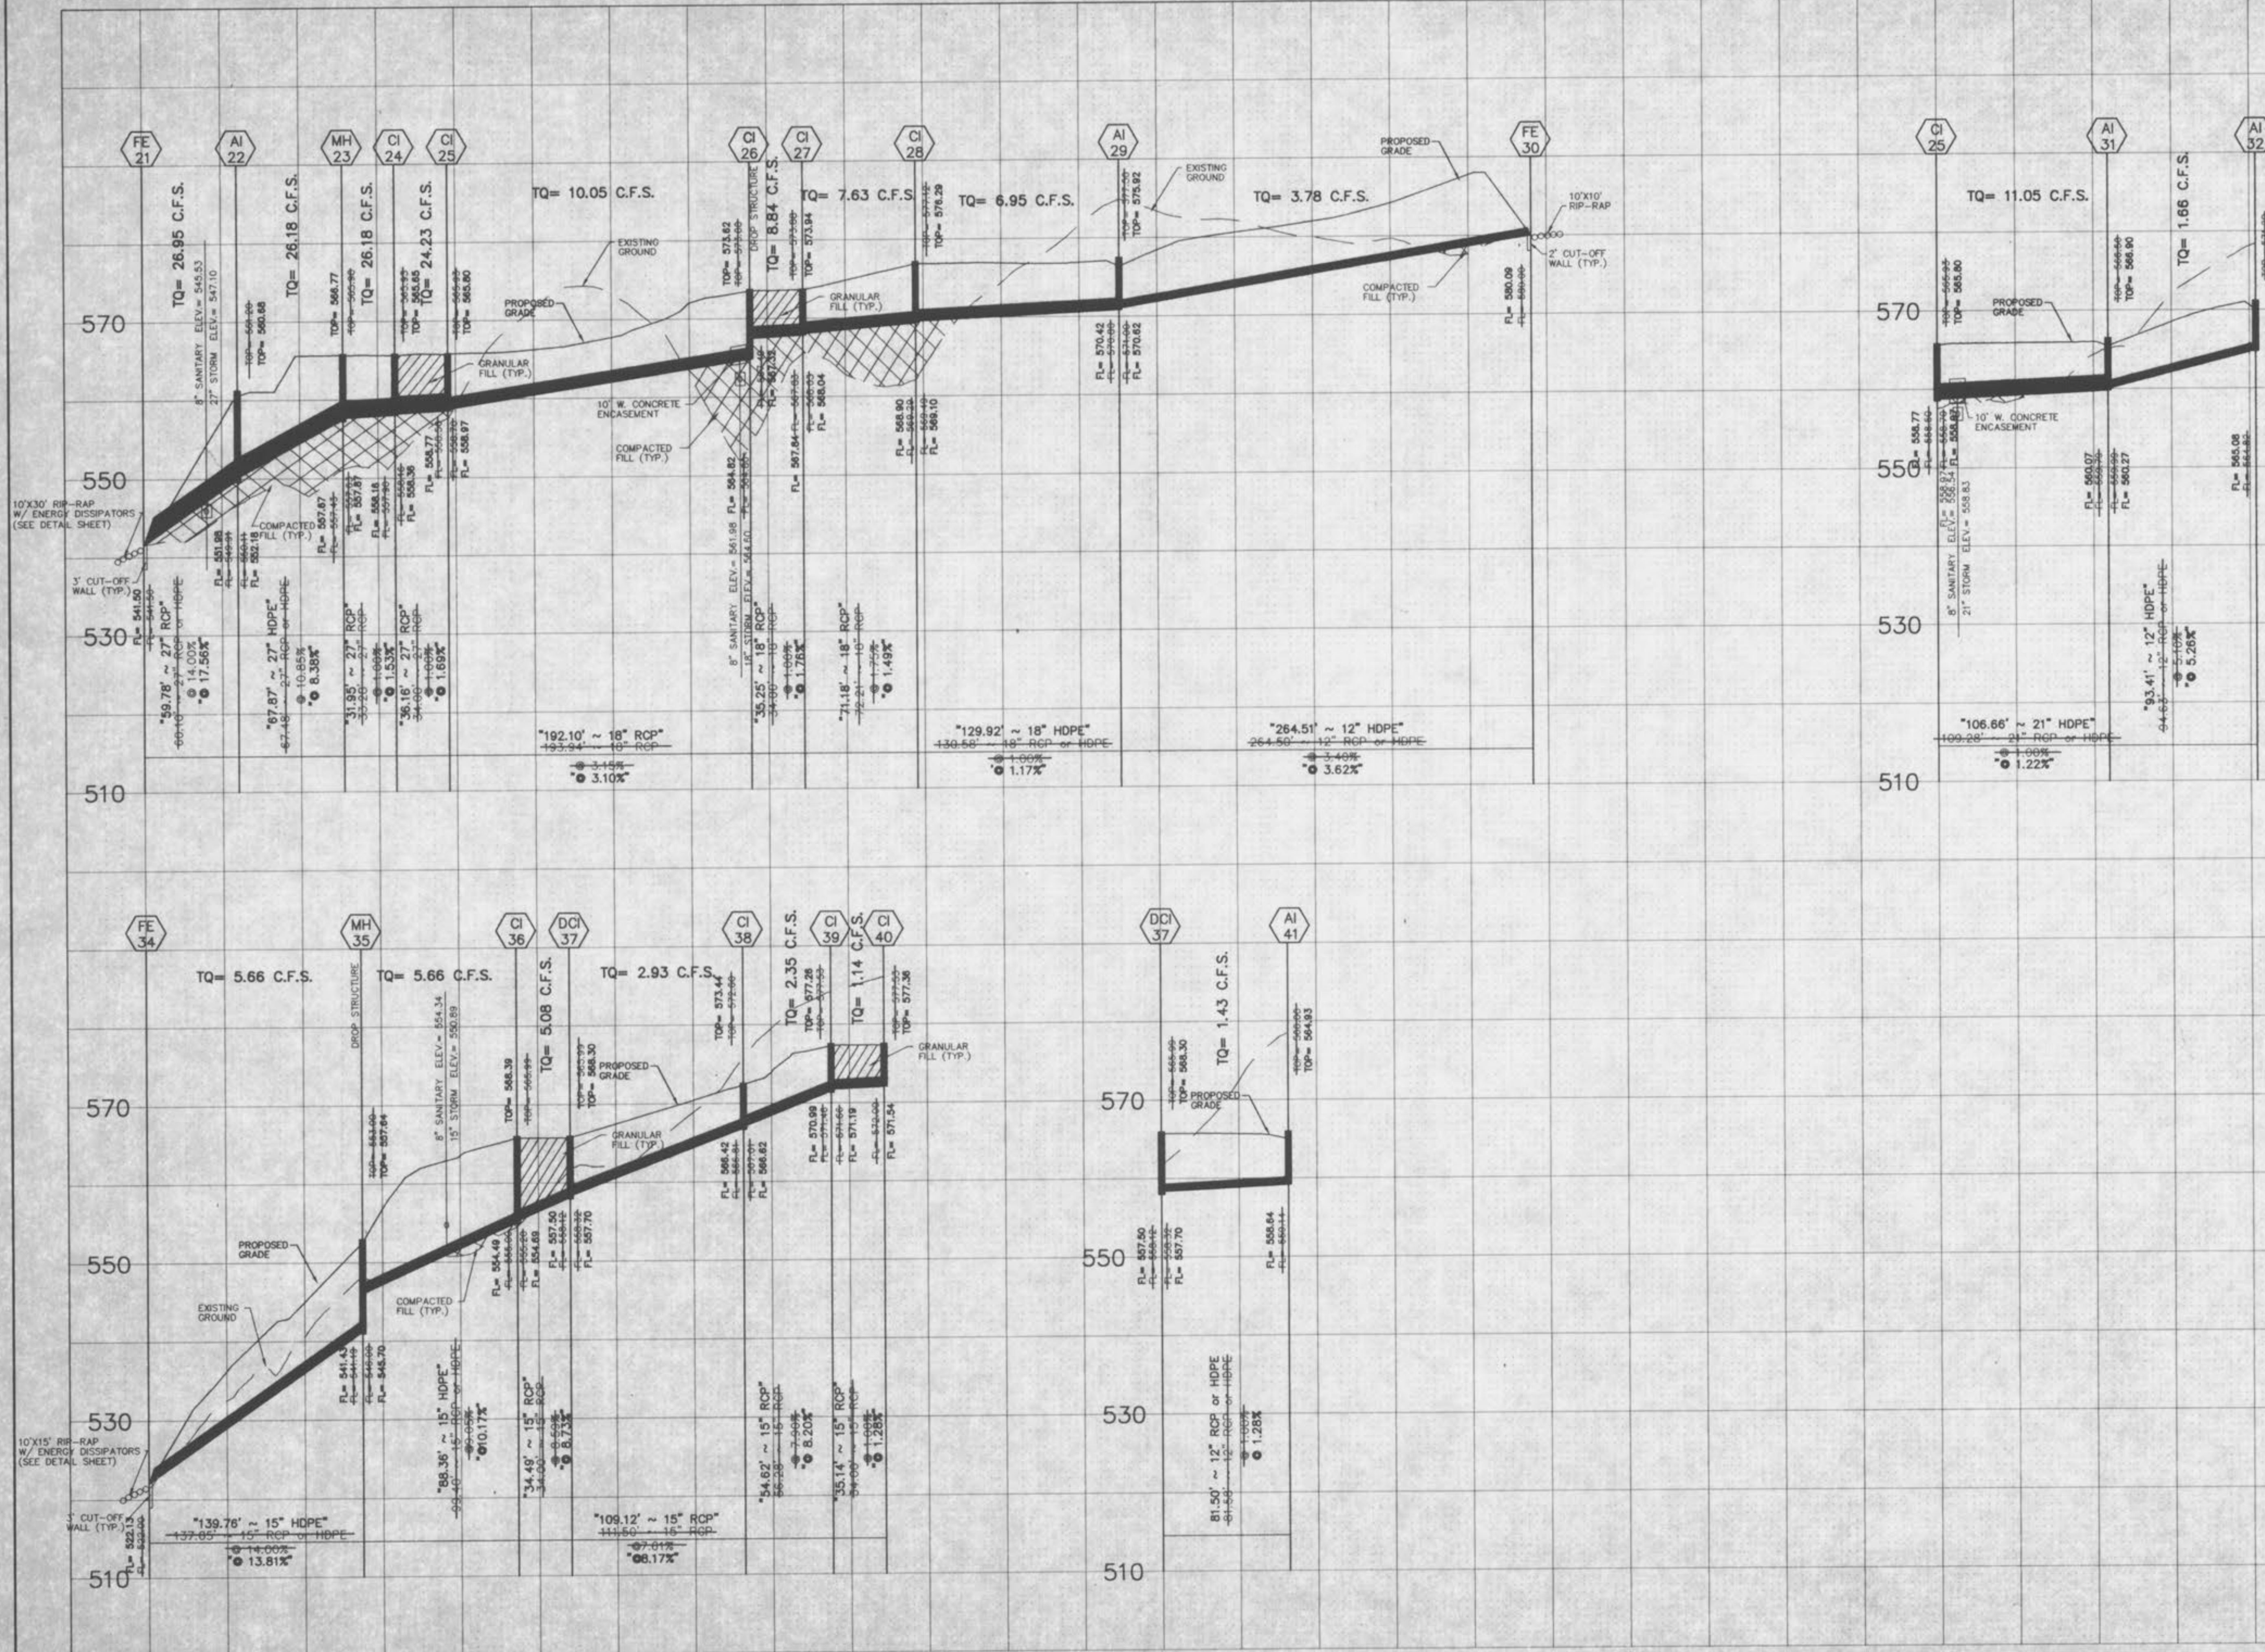

\\b3a\d-ar\lve\lnc\l5600\PLUS\8683\881.dwg Tue Mar 09 16:05:05 1999 STATION 35

D. J. [Signature]
 3-9-99

AS-BUILTS ADDED JANUARY, 1999

SCALE: 1"=10' VERTICAL
 1"=50' HORIZONTAL

7
 7