



PLAN  
 SURVEYED BY: [ ]  
 CHECKED BY: [ ]  
 DATE: [ ]

PROFILE  
 SURVEYED BY: [ ]  
 CHECKED BY: [ ]  
 DATE: [ ]

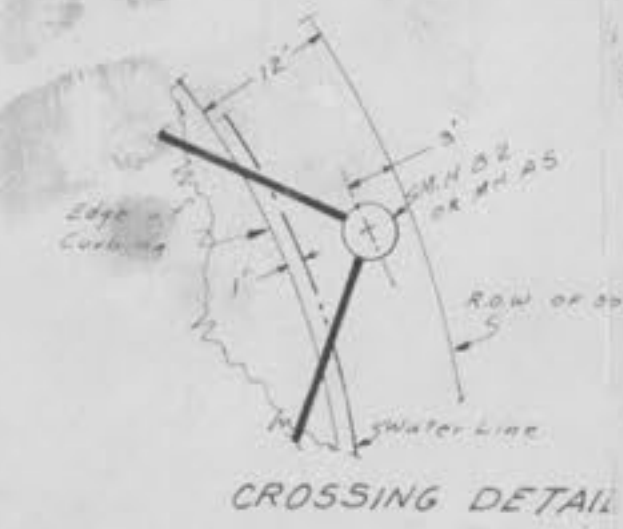

|  |  |  |
|--|--|--|
| REVISED:                                 | SAN JOSE MEADOWS<br>SANITARY SEWERS<br>& WATER LINES |  |
| DATE: June '61                           | SHEET: [ ] OF [ ]                                    | SCALE: 1" = 10' Horiz<br>1" = 10' Vert |
| <b>Engineering &amp; Surveying, Inc.</b> |  |  |
| ST. CHARLES, MISSOURI                    |  |  |

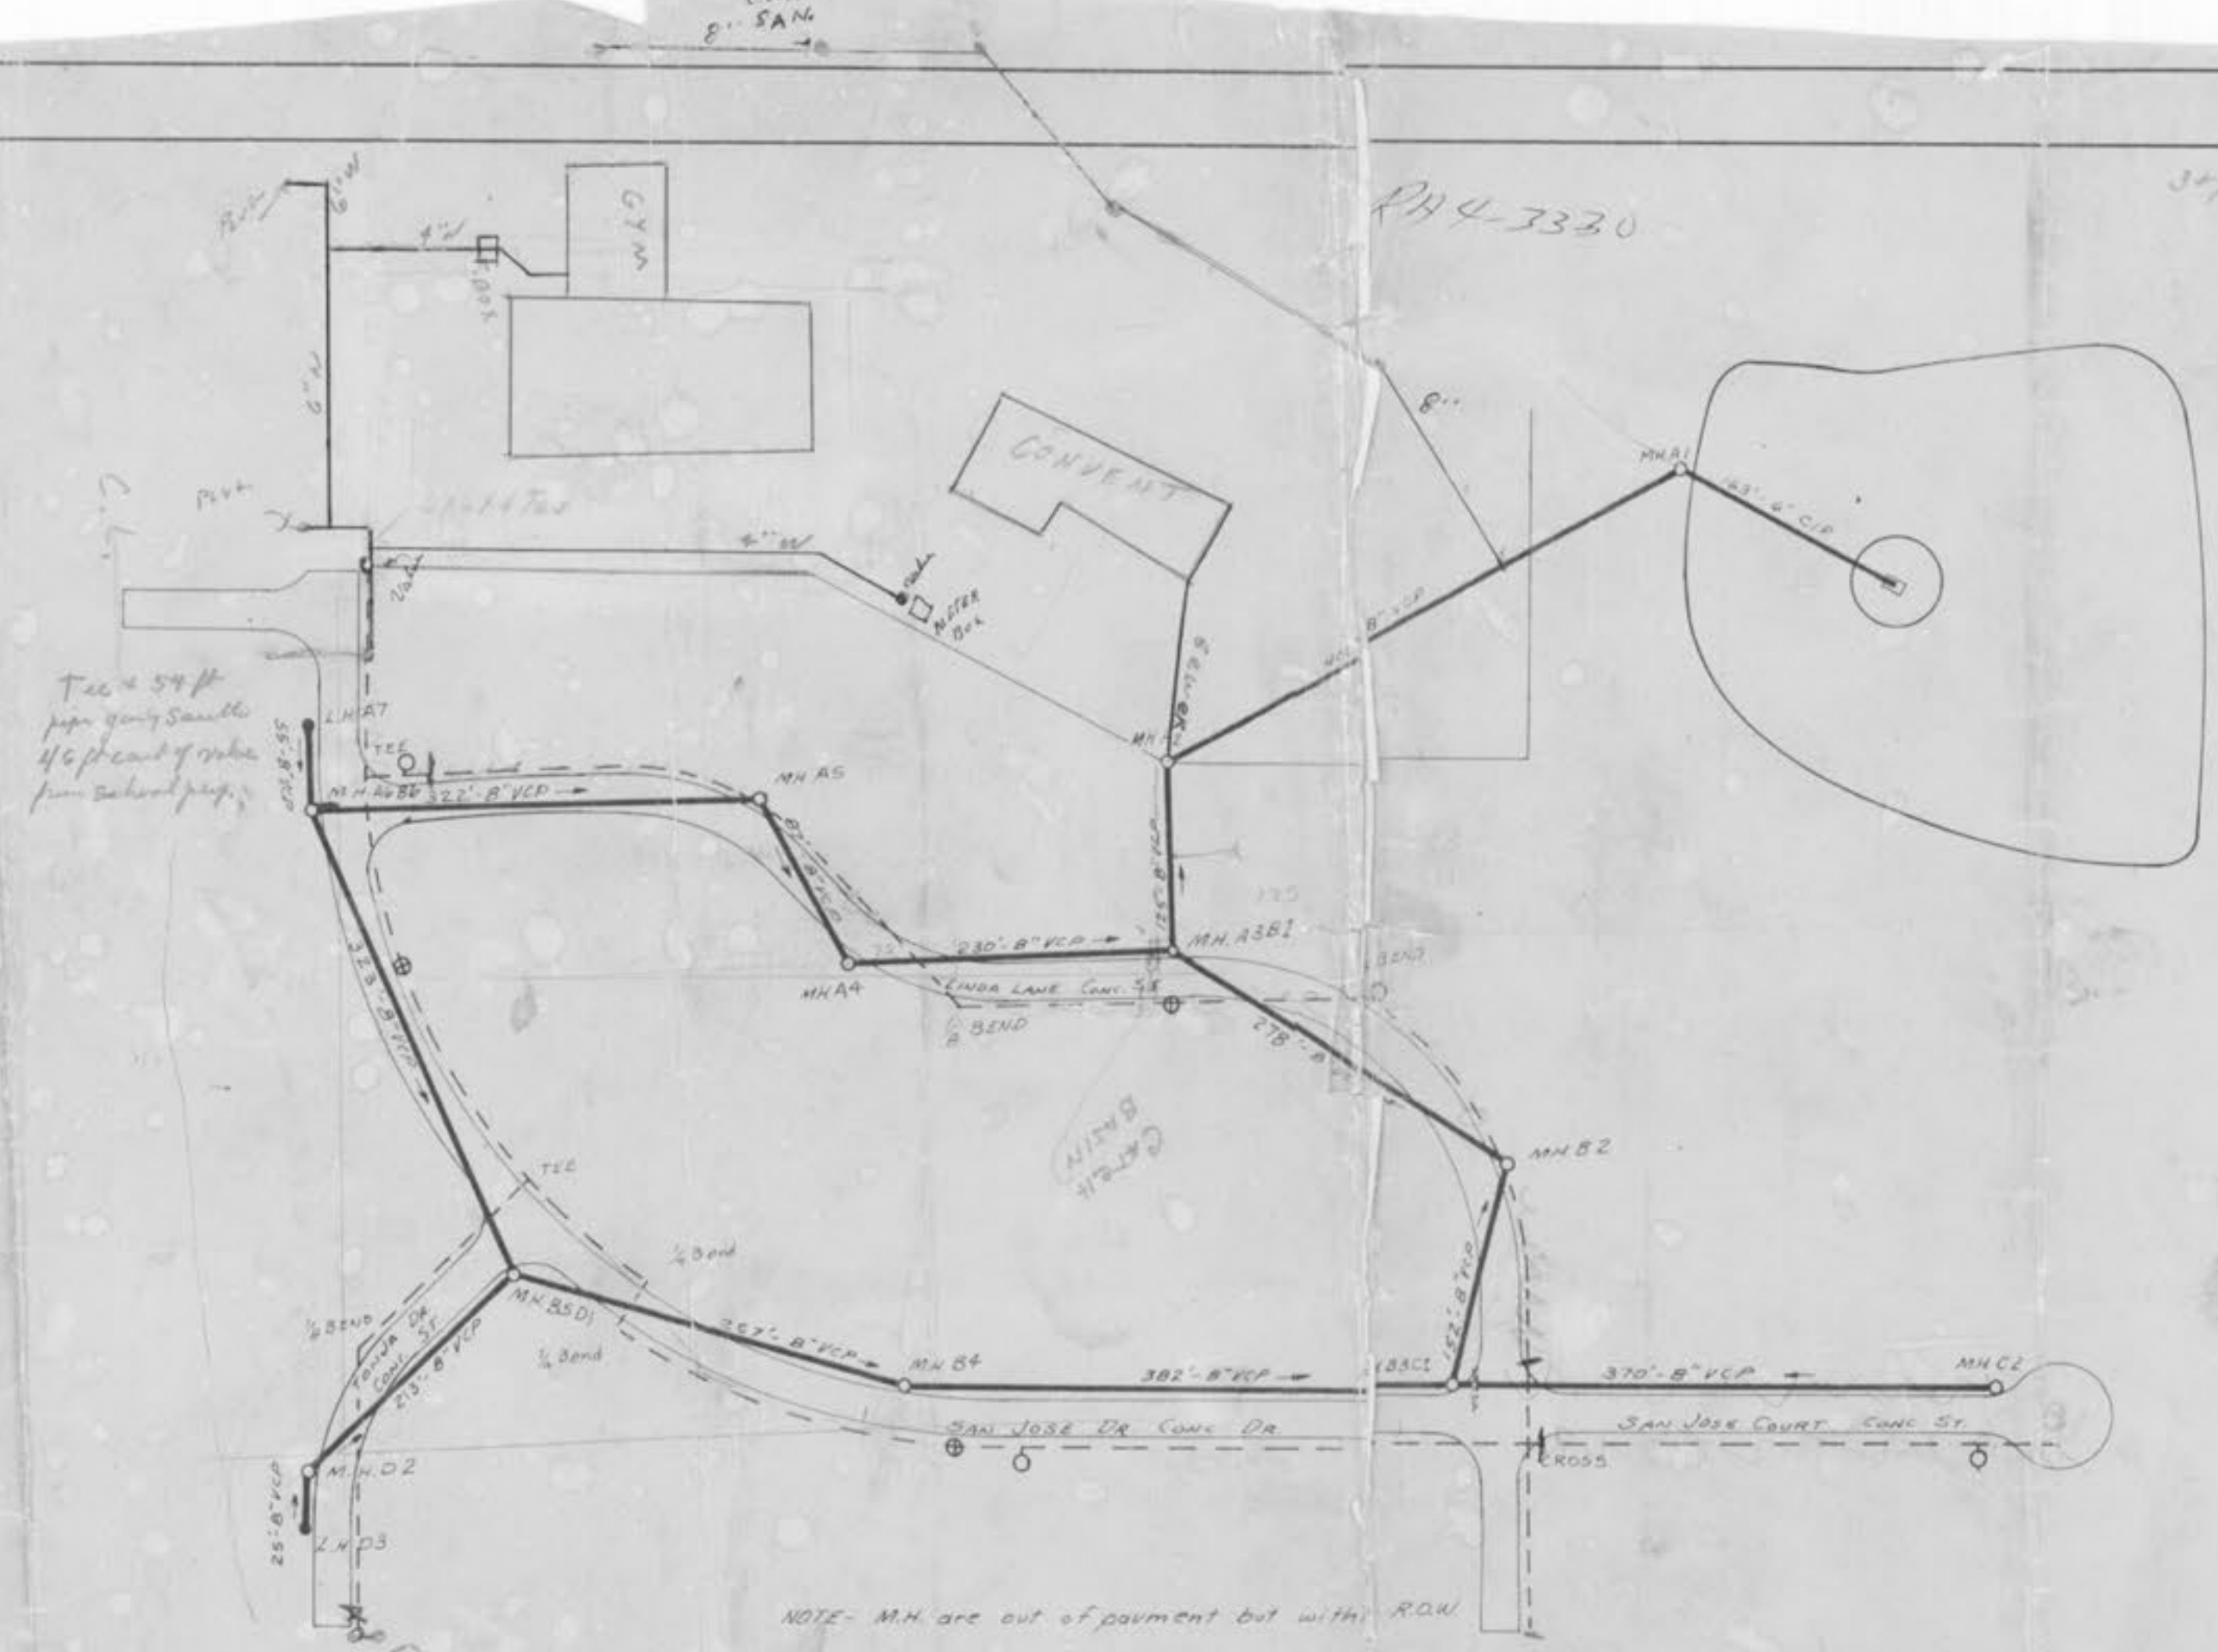