


REVISIONS: STREET PROF. WATER & SAN SEWERS FOR ST. BARNABAS PARK
 SHEET 1 OF 3
 SCALE 1"=100'

Engineering & Surveying, Inc.
 321 PIKE ST. CHARLES, MISSOURI RA 4-3330

PLANS AS BUILT.

CATCH BASIN	Q.IN	Q.OUT
CATCH BASIN No. 1	3.77	3.77
" " " 2	1.79	5.56
" " " 3	5.10	5.10
" " " 4	4.42	9.52

PLAN
 DATE _____ BY _____
 CHECKED BY _____
 NOTE BOOK NO. _____
 ALIGNMENT CHECKED BY _____
 RT. OF WAY CHECKED BY _____

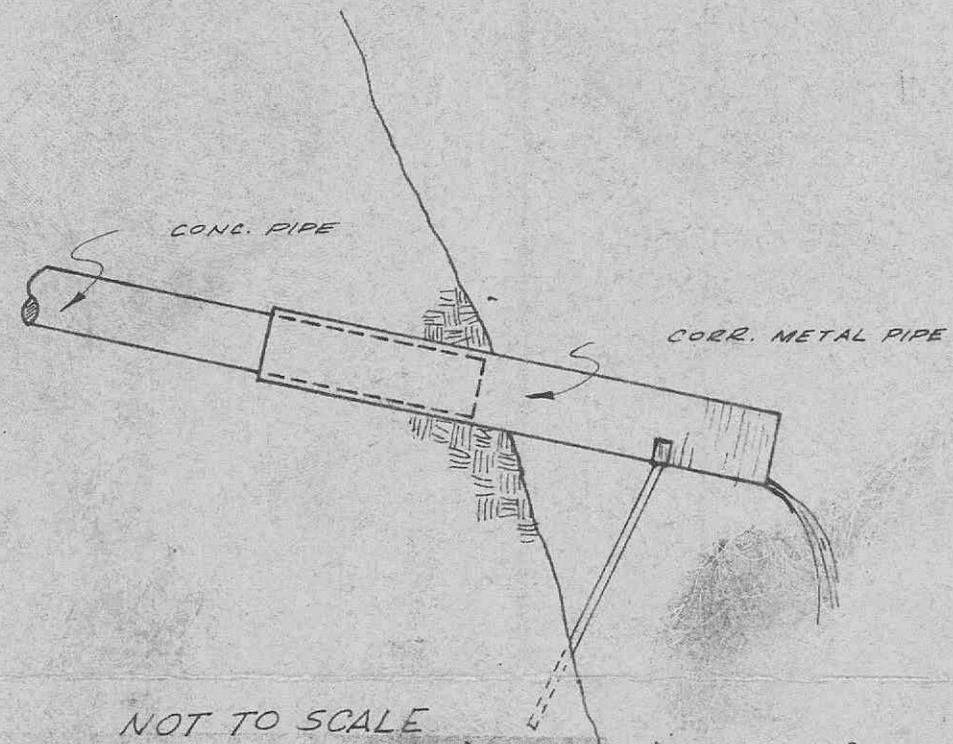

PROFILE
 DATE _____ BY _____
 CHECKED BY _____
 NOTE BOOK NO. _____
 GRADES CHECKED BY _____
 SLOPES NOTED BY _____

