


Sanitary Sewer Profiles
 SUNSET ACRES
 Nov. 1978
 77-02A

DATE	
BY	
PROJECT	
DESCRIPTION	
SCALE	
REVISIONS	

DATE	
BY	
PROJECT	
DESCRIPTION	
SCALE	
REVISIONS	

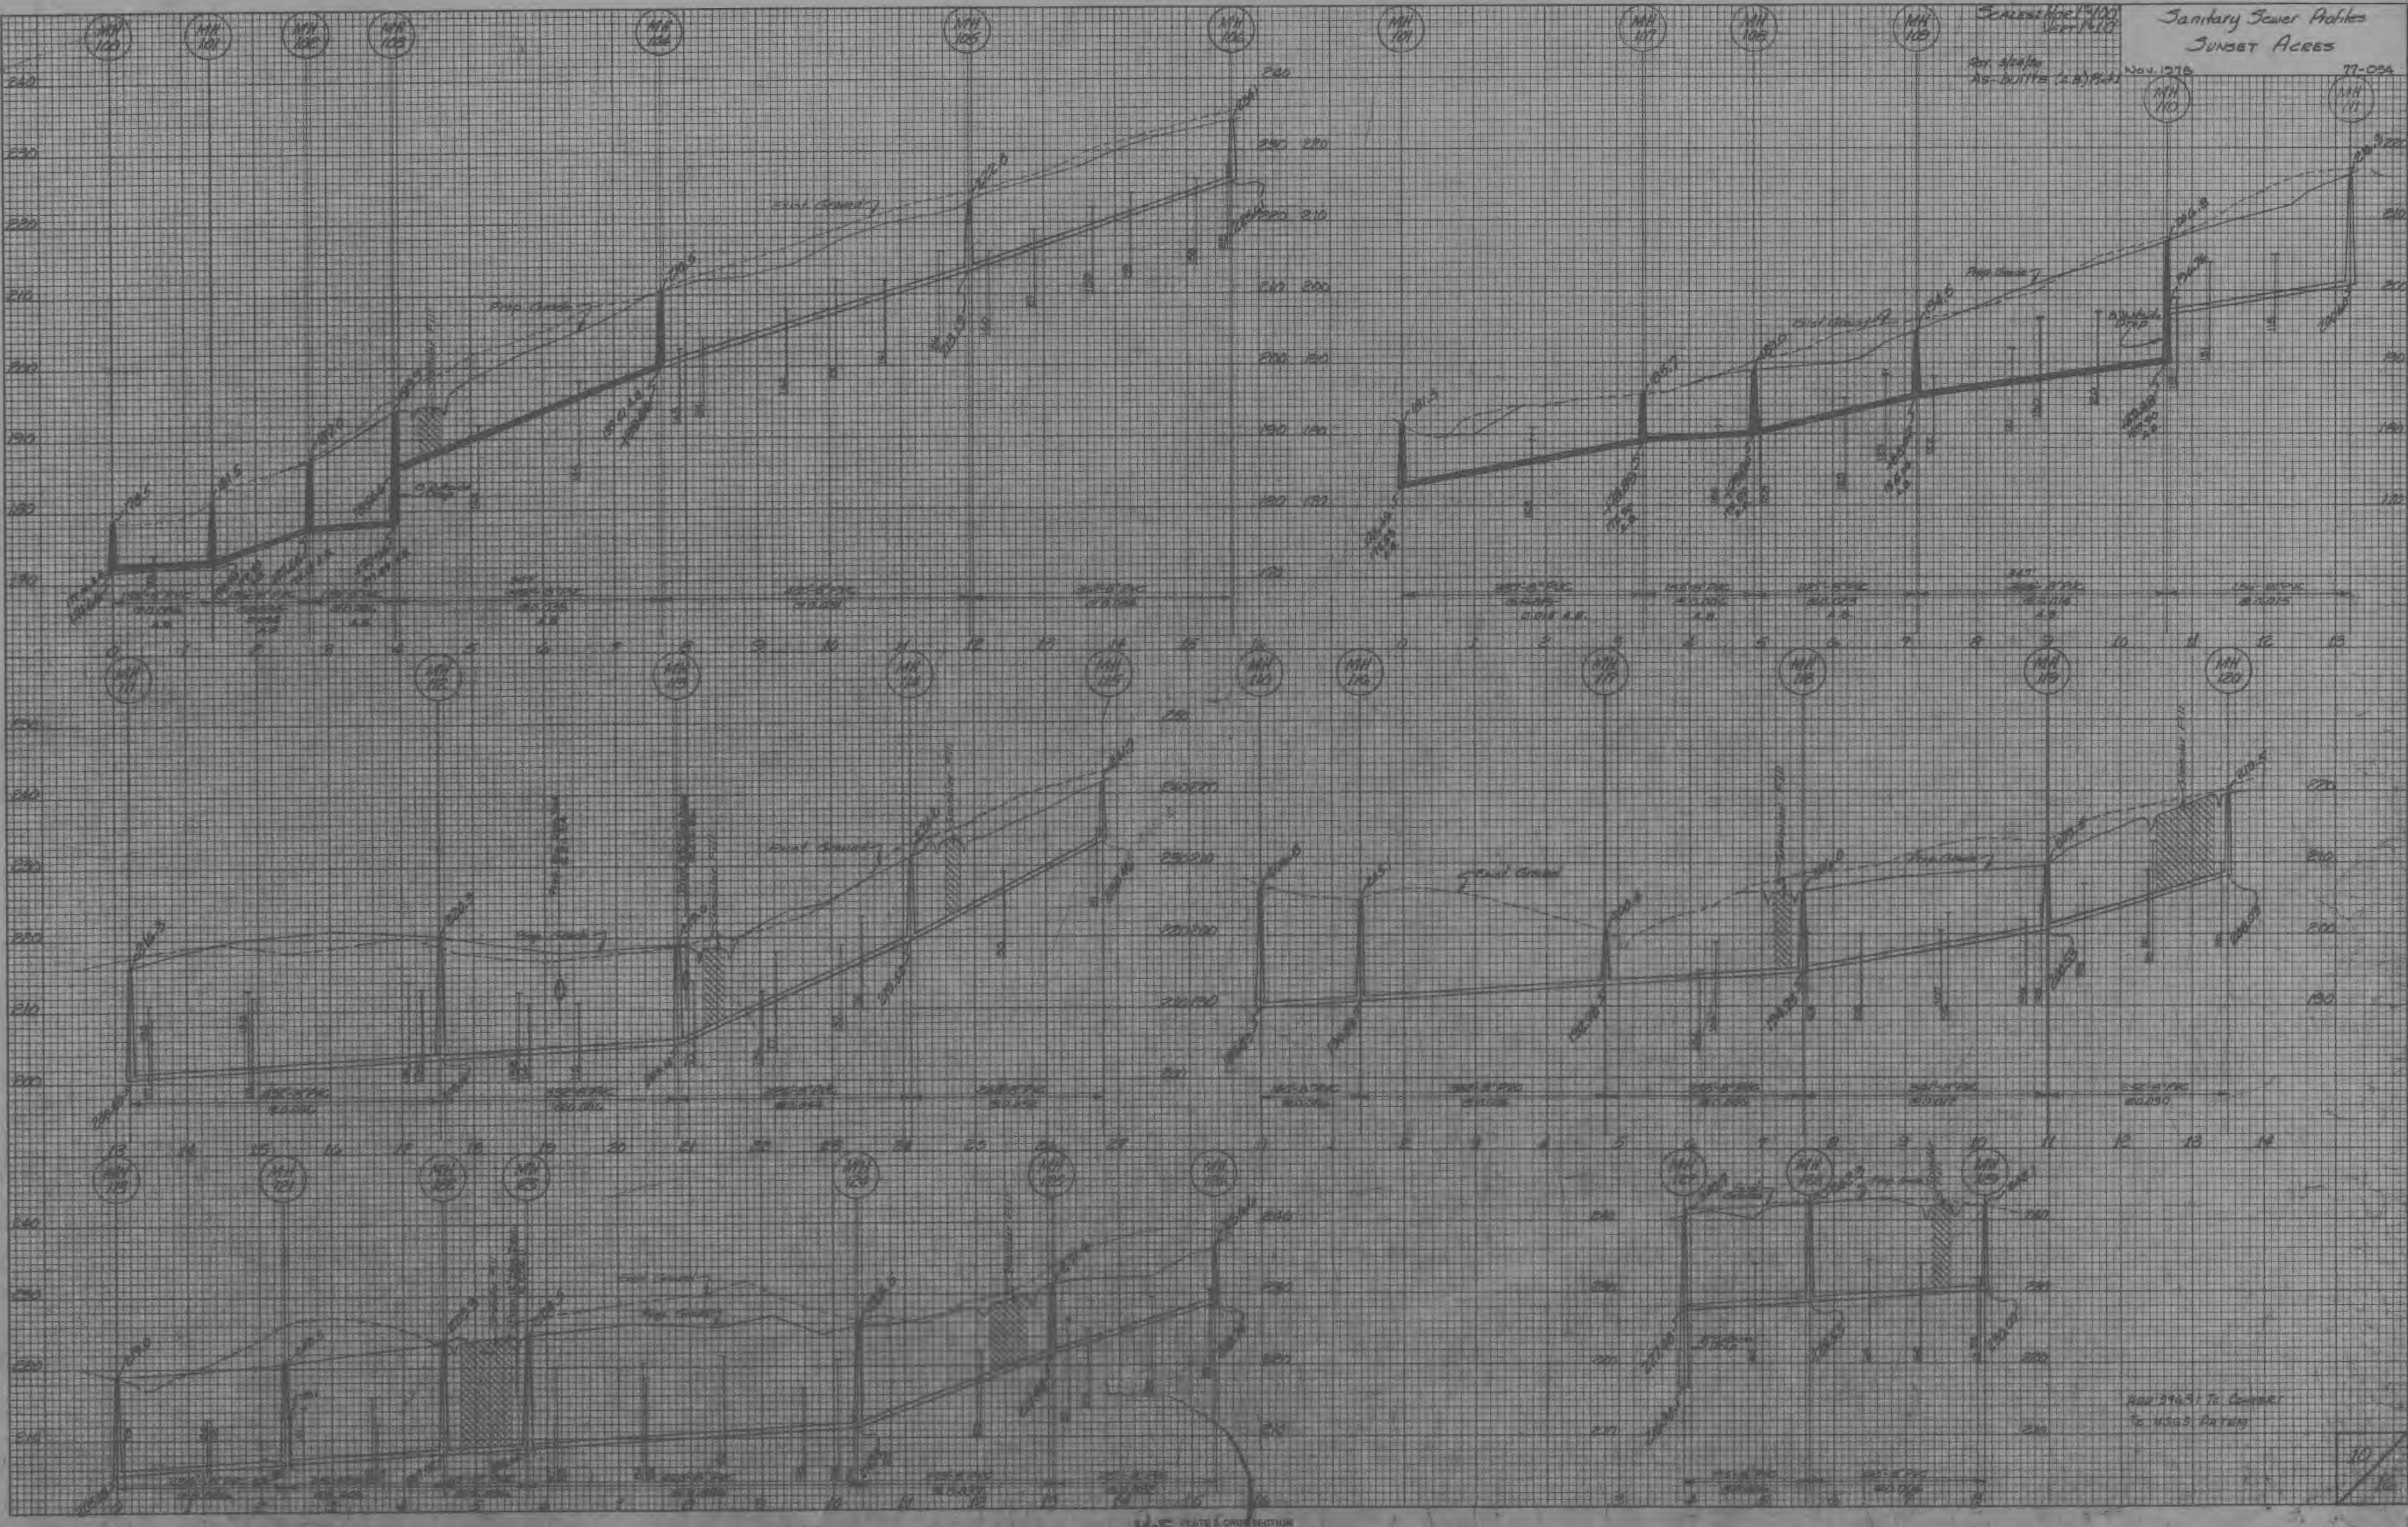

K&E PLATE 5, CHINA SECTION
 SHEET 02 OF 02
 1/2\"/>

NO. 396-91 To Connect
 To USGS Parity


Sheet 02 of 02
 1/2\"/>

Sanitary Sewer Profiles
SUNSET ACRES

NOV 1970
77054
GENERAL CONTRACTOR
1001 P.O.
CON. WORKING DRAWING
PLAT 1 (S.S.)

DATE	
BY	
ORIGINAL SURVEY	
PLATED	
NOTE BOOK	
AMALS CHECKED	
AMALS CHECKED	

DATE	
BY	
ORIGINAL SURVEY	
PLATED	
NOTE BOOK	
AMALS CHECKED	
AMALS CHECKED	

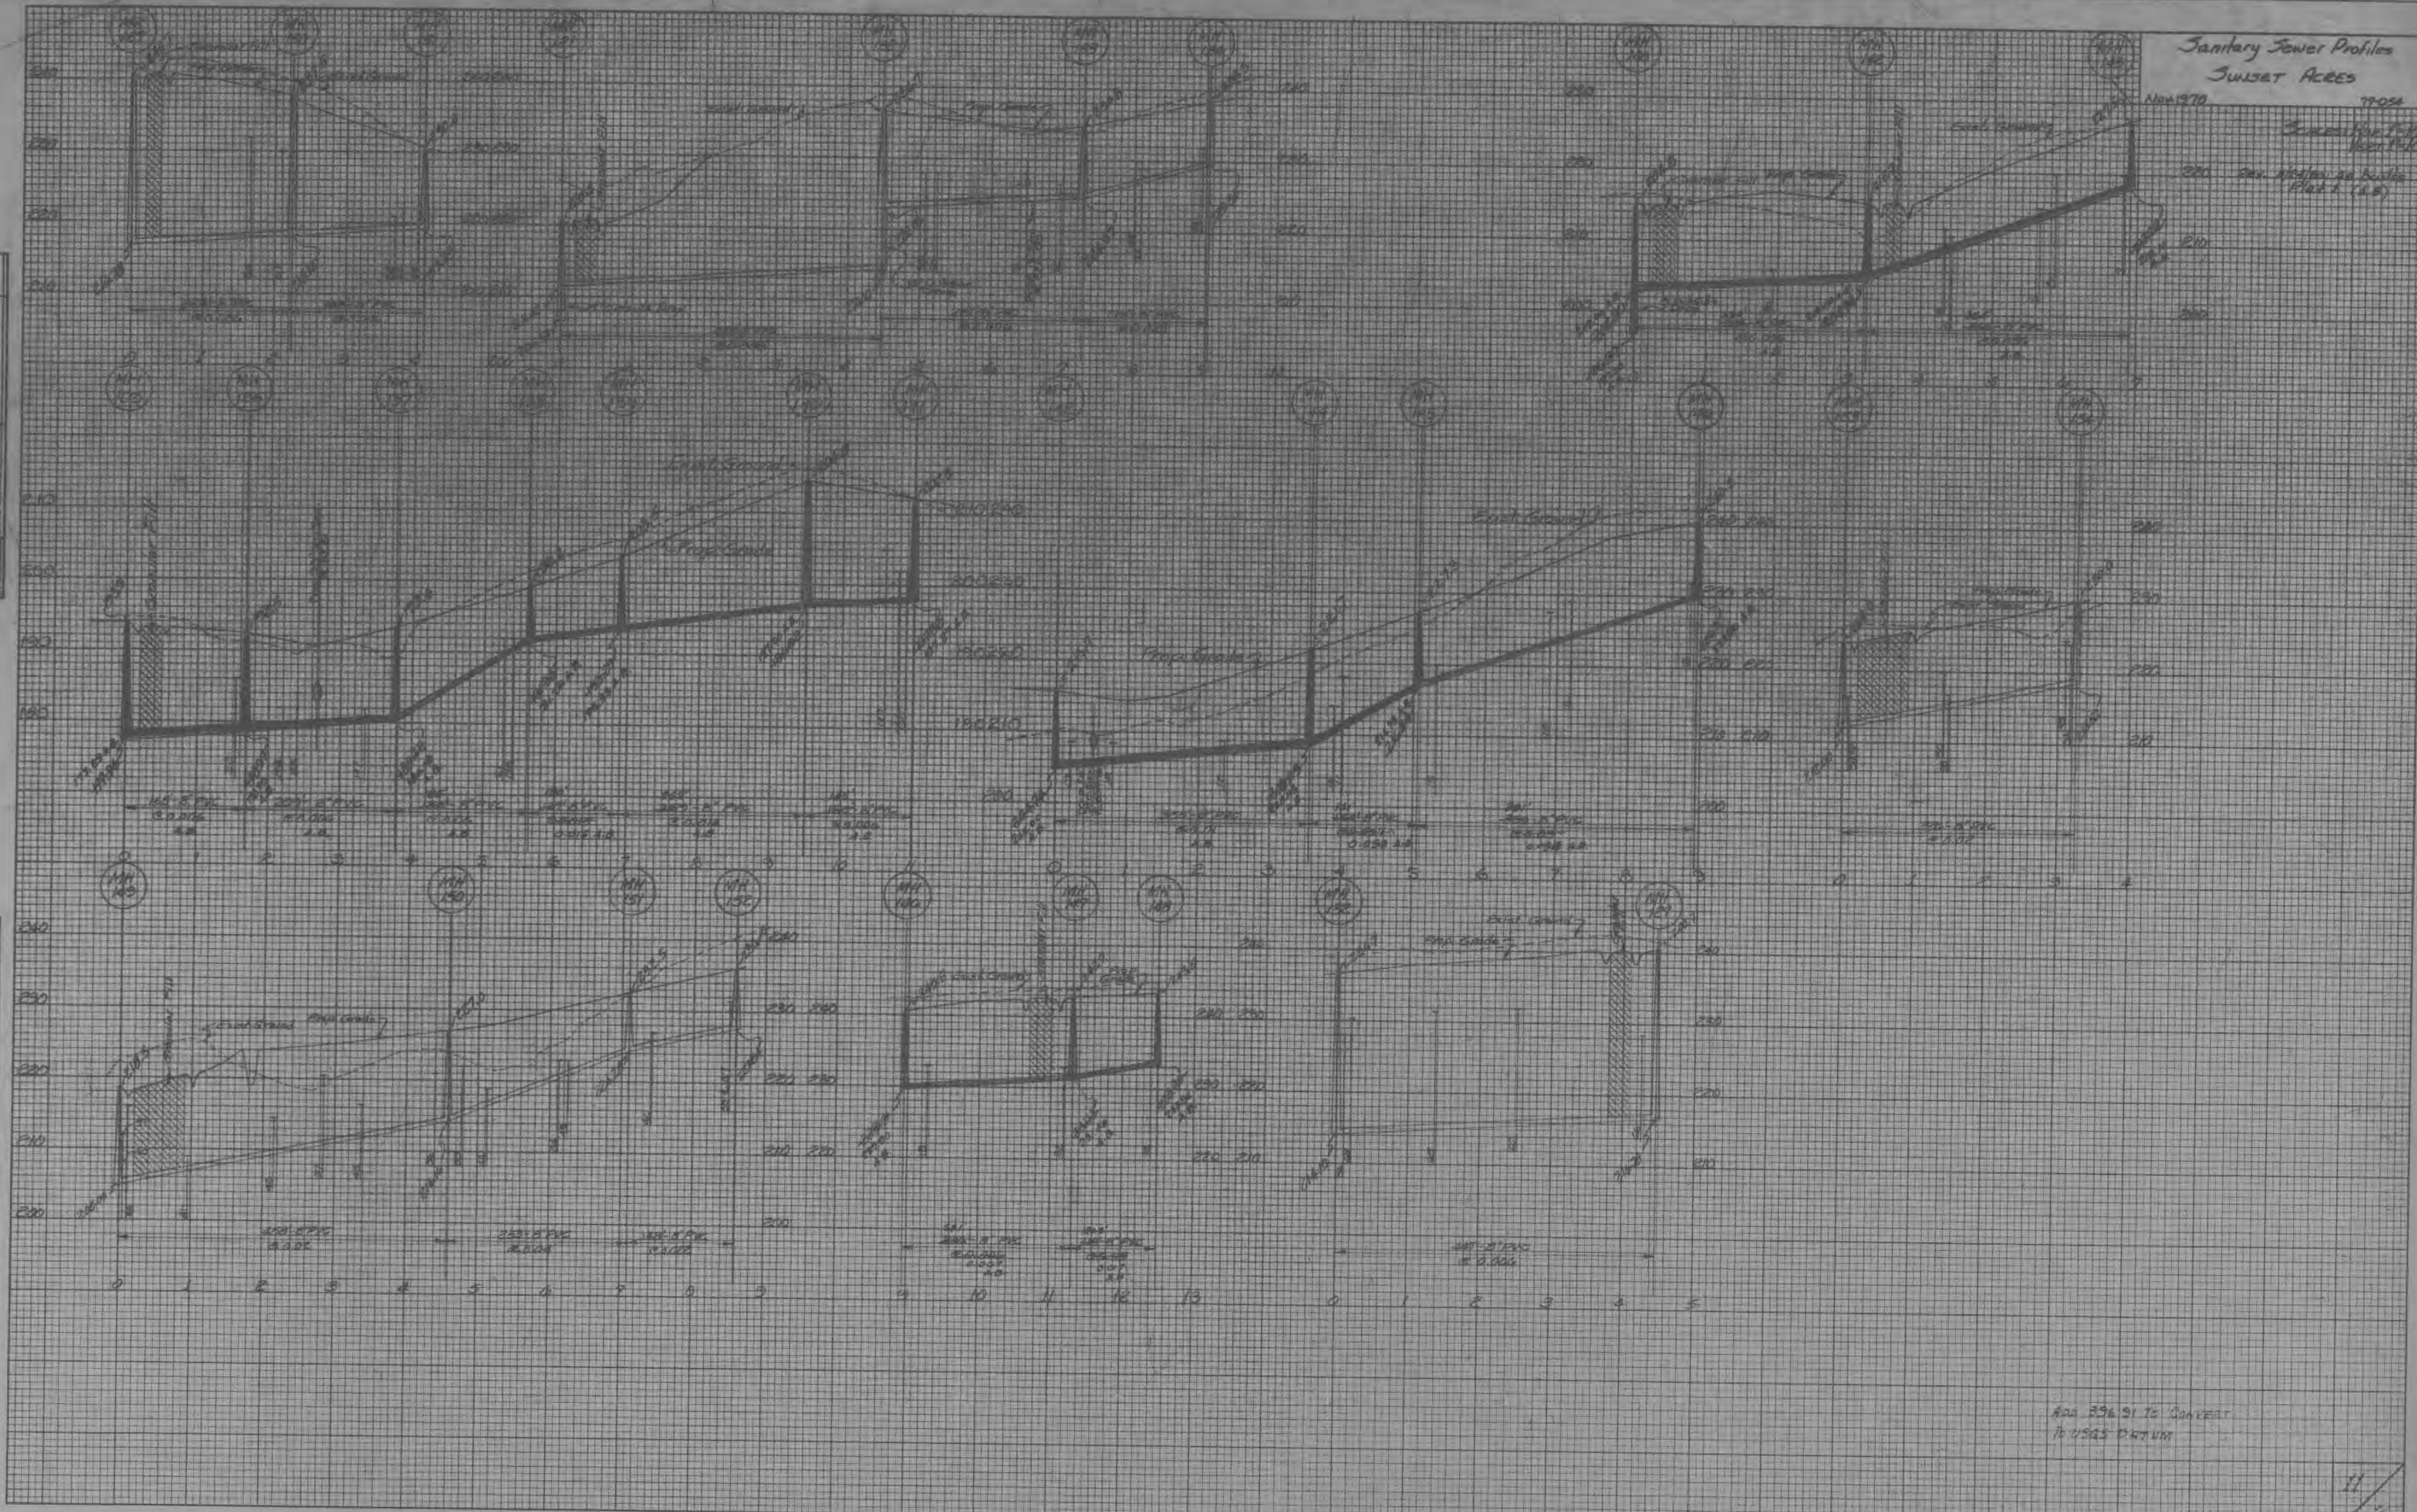

FOR 296.91 TO CONVERT
TO USGS DATUM

SUNSET ACRES
CONTRACT NO. 1001
1001 P.O.

11
164