



A SET OF AS-BUILT PLANS FOR TOMMY'S EXPRESS CAR WASH

A TRACT OF LAND BEING ALL OF LOT 5 OF "FALLON PARKWAY - PLAT TWO" PLAT BOOK 43 PAGE 311 TOWNSHIP 46 NORTH, RANGE 3 EAST CITY OF O'FALLON ST. CHARLES COUNTY, MISSOURI

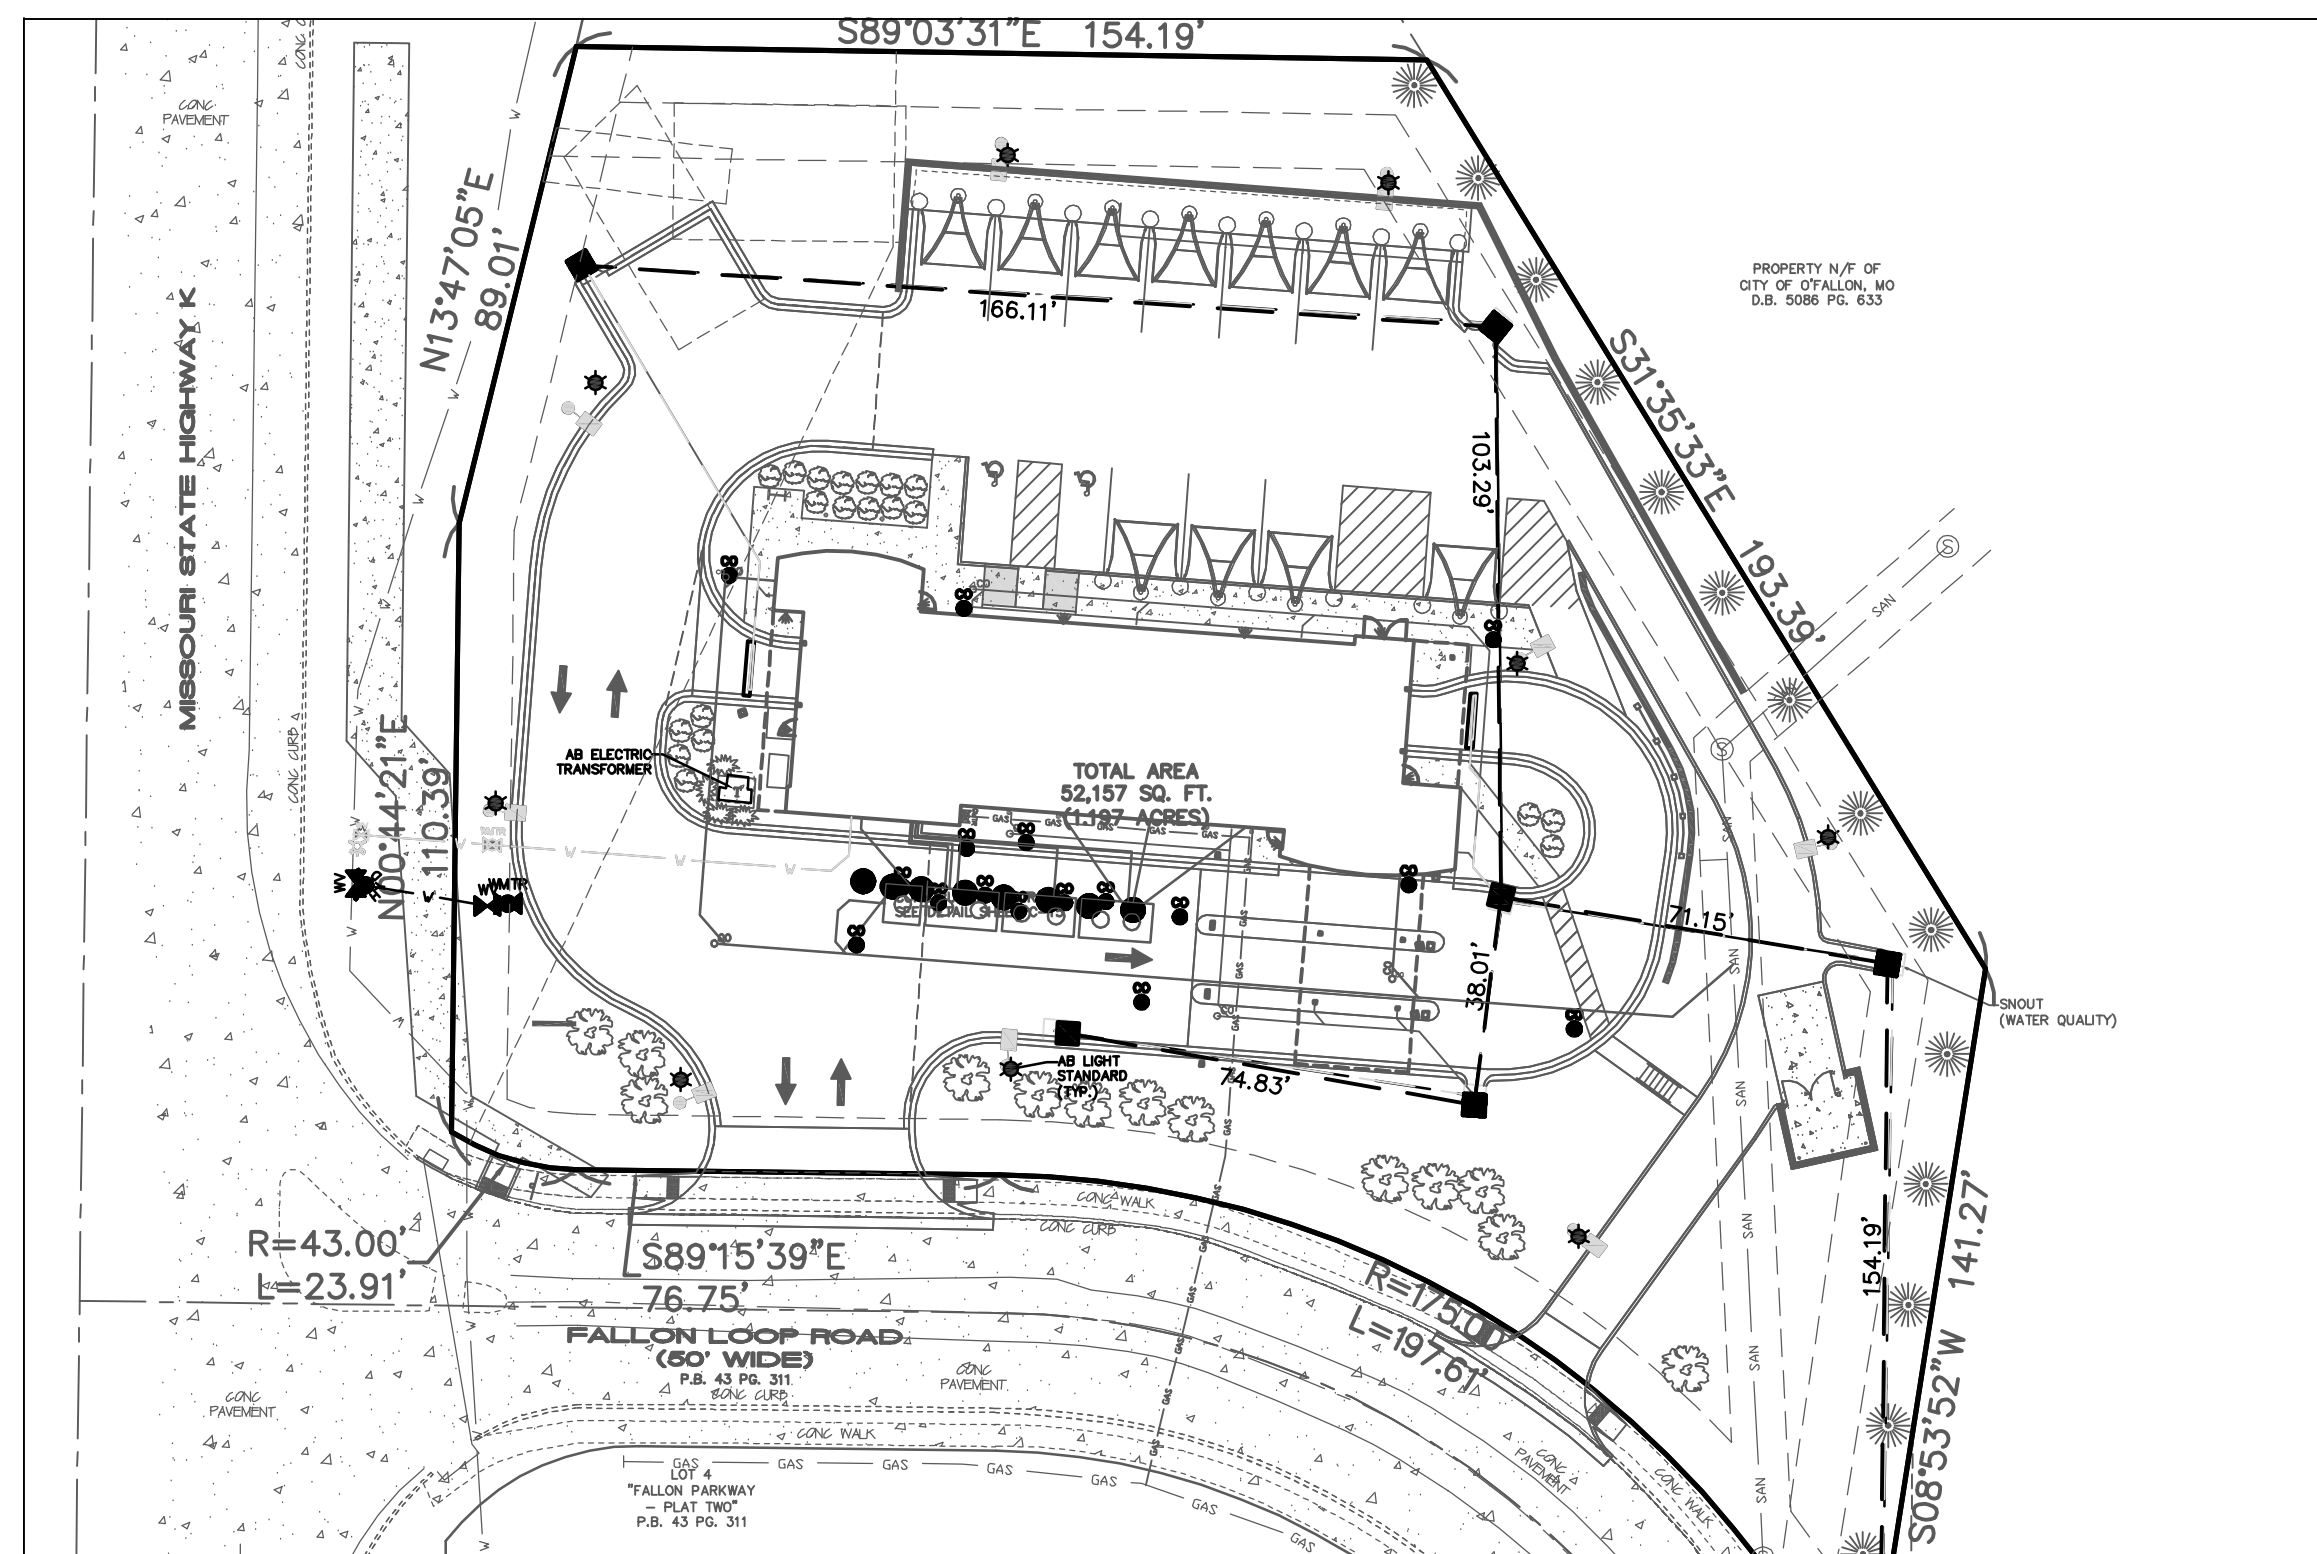

Plan View

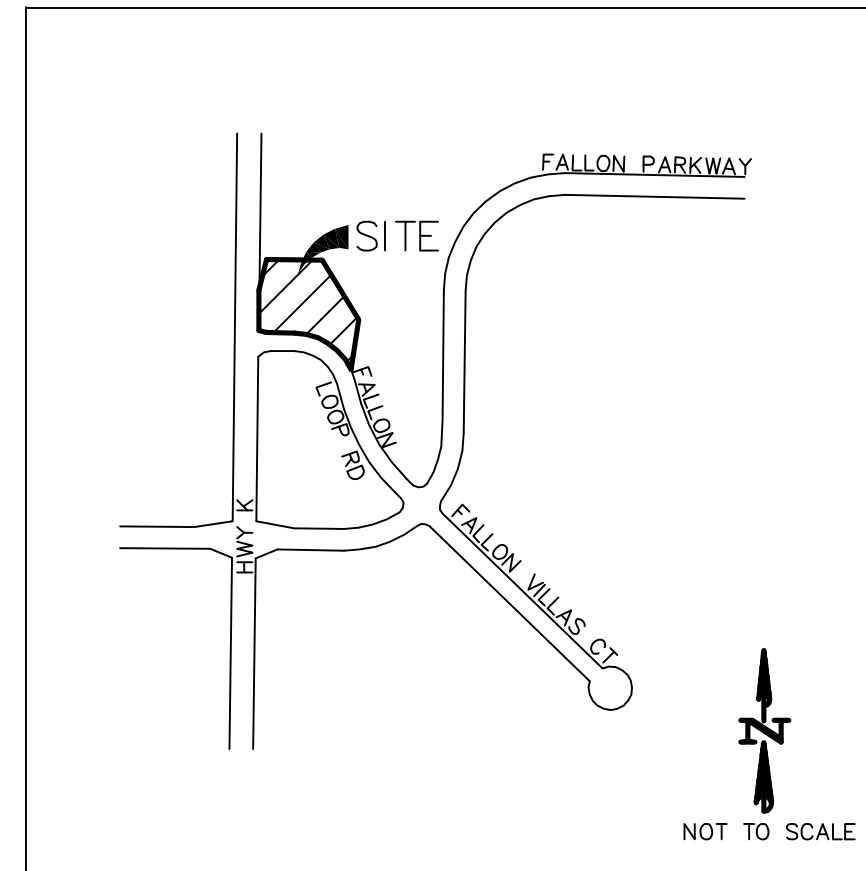

Locator Map

Conditions of Approval From Planning and Zoning

1. PROVIDE BILLBOARD MAINTENANCE AGREEMENT.
2. PROVIDE AN EXHIBIT THAT VERIFIES THE ITEM B: RIBBED PANEL: ATAS 7.2-SILVERSMITH ON THE EXTERIOR ELEVATION'S MATERIAL LIST MEETS CODE SECTION 400.523(A)(3). <https://ecode360.com/27636304>
3. PROVIDE ACCESS FROM THE BUILDING TO THE TRASH ENCLOSURE AREA AS REVIEWED AND APPROVED ON THE CONSTRUCTION SITE PLANS.

DUCKETT CREEK SANITARY DISTRICT CONSTRUCTION NOTES

1. Underground utilities have been plotted from available information and therefore location shall be considered approximate only. The verification of the location of all underground utilities, either shown or not shown on these plans, shall be the responsibility of the contractor and shall be located prior to any grading or construction of improvements.
2. Gas, water and other underground utilities shall not conflict with the depth or horizontal location of existing or proposed sanitary and storm sewers, including house laterals.
3. All existing site improvements disturbed, damaged or destroyed shall be repaired or replaced to closely match preconstruction conditions.
4. All fill including places under proposed storm and sanitary sewer lines and paved areas including trench backfills within and off the road right-of-way shall be compacted to 90 percent of maximum density as determined by the Modified AASHTO T-190 Compaction Test (ASTM 015577). All tests shall be verified by a Soils Engineer concurrent with grading and backfilling operations. The compacted fill shall be free of rutting and shall be non-suspending and non-pumping during proofrolling and compaction.
5. The contractor shall prevent all storm, surface water, mud and construction debris from entering the existing sanitary sewer system. The contractor will be required to install a brick bulkhead on the downstream side of the first new manhole constructed when connecting into existing sewers.
6. All sanitary sewer flowlines and tops built without elevations furnished by the engineer will be the responsibility of the sewer contractor.
7. It is the responsibility of the contractor to adjust all sanitary sewer manholes (that are affected by the development) to finish grade.
8. Easements shall be provided for all sanitary sewers, storm sewers and all utilities on the record plat.
9. All sanitary sewer construction and materials shall conform to the current construction standards of the Duckett Creek Sanitary District.
10. The Duckett Creek Sanitary District shall be notified at least 48 hours prior to construction for coordination of inspection.
11. All sanitary sewer building connections shall be designed so that the minimum vertical distance from the low point of the basement to the line of a sanitary sewer at the corresponding building connection shall not be less than the diameter of the pipe plus the vertical distance of 2' feet.
12. All sanitary sewer manholes shall be watertight in accordance with Missouri Dept. of Natural Resources specification 10 CSR 208.1200(F) 1.
13. All PVC sanitary sewer pipe shall conform to the requirements of ASTM D-3034 Standard Specification for PSM Polyvinyl Chloride Sewer Pipes, SDR-35 or equal, with "clean" 1/2 inch to 1 inch granular stone bedding uniformly graded. This bedding shall extend from 4 inches below the pipe to springline of pipe. Irregular backfill over pipe shall consist of same size "clean" or "rip-rap" stone from springline of pipe to 6 inches above the top of pipe. Final backfill material shall be of suitable material removed from excavation except as other material is specified. Debris, frozen material, large rocks or stones, or other unstable materials shall not be used within 2 feet from top of pipe.
14. All sanitary and storm sewer trench backfills shall be water jetted. Granular backfill will be used under pavement areas.
15. All pipes shall have positive drainage through manholes. Flat invert structures not allowed.
16. Epoxy Coating shall be used on all sanitary sewer manholes that receive pressurized mains.
17. All creek crossings shall be lined with rip-rap as directed by District inspectors.
18. Brick shall not be used on sanitary sewer manholes.
19. Existing sanitary sewer service shall not be interrupted.
20. Maintain access to existing residential driveways and streets.
21. Pre-manufactured adapters shall be used at all PVC to DIP connections. Rubber boot / Mission-type couplings will not be allowed.
22. Any permits, licenses, assessments, or approvals required to work on public or private properties or roadways are the responsibility of the developer.
23. Type N Lock-Type Cover and Locking Device (Lock-Lug) shall be used where lock-type covers are required.
24. All sanitary sewer system work shall be conducted under the inspection of a representative of the District. All work may not require inspection but the District representative may designate specific areas that must be inspected before the work is backfilled. All testing must be witnessed by the District's Inspector and the Contractor shall furnish all testing equipment as approved by the District. Testing shall include:
 - A mandrel test of all gravity sewers using a mandrel with a diameter that has a diameter 95% of the inside pipe diameter. If the mandrel test fails on any section of pipe, that section of pipe shall be uncoupled and replaced. No expansion devices will be allowed to be used to "force" the pipe that is deformed back into round. Any string lines used in mandrel testing shall be removed after testing is completed. Deflection testing cannot be conducted prior to 30 days after final backfill.
 - An air pressure test of all gravity sewers to a pressure of 5 PSI with no observed drop in pressure during a test period of 5 minutes.
 - A vacuum test of all manholes for a period of 1 minute and the vacuum shall be 10 of mercury and may not drop below 9" of mercury at the end of the 1 minute test.

Utility Contacts

Sanitary Sewers

Duckett Creek Sanitary District
3550 Highway K
O'Fallon, MO. 63368
636-441-1244

Water

Public Water Supply District No. 2
P.O. Box 967
O'Fallon, MO. 63366
636-561-3737

Storm Sewer

City of O'Fallon
100 N. Main St.
O'Fallon, MO. 63366
636-240-2000

Electric

Ameren Missouri
200 Callahan Road
Wentzville, MO. 63385
636-639-8312

Gas

Spire Gas
6400 Graham Road
St. Louis, MO. 63134
314-522-2297

Telephone

CenturyLink
1151 Century Tel Dr.
Wentzville, MO. 63385
636-332-7261

Fire District

O'Fallon Fire Protection District
111 Laura K Dr.
O'Fallon, MO. 63366
636-272-3493

Drawing Index

- 1 COVER SHEET
- 2 DEVELOPMENT NOTES
- 3 DEMOLITION PLAN
- 4 FLAT PLAN
- 5 GRADING PLAN
- 6 PRE-DEVELOPED DRAINAGE AREA MAP
- 7 POST-DEVELOPED DRAINAGE AREA MAP
- 8 STORM PROFILES, ENTRANCE DETAILS AND WATER QUALITY DETAILS
- 9 RETAINING WALL DETAILS
- 10 DOWNSPOUT PLAN
- 11 EROSION CONTROL DETAILS
- 12 STORM AND SANITARY DETAILS
- 13 SANITARY AND STORM DETAILS
- 14 WATER DETAILS
- 15 PWSD#2 WATER DETAILS
- 16 CONSTRUCTION DETAILS
- 17 SWPPP
- 18 MODOT PLAN
- 19 PHOTOMETRIC LIGHTING

LANDSCAPING REQUIREMENTS:

- STREET TREE REQUIREMENTS:**
- 1 TREE FOR EVERY 40' OF FRONTAGE
FALLON LOOP ROAD - 298.27' OF RIGHT-OF-WAY FRONTAGE = 298.27/40=7.46 ~ 8 STREET TREES REQUIRED
- HIGHWAY K - 199.4' OF RIGHT-OF-WAY FRONTAGE = 199.4/40=4.99 ~ 5 STREET TREES REQUIRED. DUE TO UNRECORDED BILLBOARD SIGHT DISTANCE EASEMENT THESE TREES HAVE BEEN MOVED TO FALLON LOOP ROAD.
- 13 STREET TREES PROVIDED
- INTERIOR LANDSCAPING REQUIRED:**
- NOT LESS THAN 5% OF INTERIOR PARKING LOT SHALL BE LANDSCAPED.
5 SPACES X 270 = 1,350 X 6% = 81 SQ.FT. LANDSCAPING REQUIRED
425 SQ.FT. LANDSCAPING PROVIDED INCLUDING 20 SHRUBS
- * BUFFER YARD REQUIREMENT ELIMINATED PER VARIANCE 18-003343 DATED JUNE 14, 2018.

- * City of O'Fallon Construction work hours per City Ordinance 3429 as shown in Section 500.420 of the Municipal Code of the City of O'Fallon are as follows:
- October 1 through May 31
7:00 A.M. To 7:00 P.M. Monday Through Sunday
June 1 Through September 30
6:00 A.M. To 8:00 P.M. Monday Through Friday
7:00 A.M. To 8:00 P.M. Saturday and Sunday

- * The area of this phase of development is 1.20 ACRES.
The area of land disturbance is 1.14 ACRES
Number of proposed lots is 1
Building setback information. Front 25 FEET
Side 0 FEET
Rear 0 FEET

- * The estimated sanitary flow in gallons per day is 90 g.p.d.
* Tree preservation calculations - NO TREES ARE BEING CLEARED

BENCHMARKS

THE HORIZONTAL COORDINATES WERE ESTABLISHED AND VERIFIED BY GPS OBSERVATIONS USING A CELLULAR EQUIPPED TRIMBLE R8 GNSS ROVER AND TRIMBLE TSC3 DATA COLLECTOR AND BASED ON THE MISSOURI HIGHWAYS AND TRANSPORTATION COMMISSION GLOBAL NAVIGATION SATELLITE REAL TIME NETWORK FOR CONTINUOUS OPERATING REFERENCE STATIONS, WHICH UTILIZES THE NAD83(2011) EPOCH 2010.00 GPS NETWORK.

THE OBSERVED HORIZONTAL CHECK STATION UTILIZED IS LISTED ON WWW.NGS.NOAA.GOV AS DESIGNATION "SC 06" WITH A PID OF A48597 AND A PUBLISHED VALUE OF N: 330208.467M, E: 237061.492M AND A CHECK VALUE OF N: 330208.482M, E: 237061.522M.

A SITE GRID AZIMUTH AND COMBINED GRID FACTOR WAS CALCULATED UTILIZING THE TRIMBLE TSC3 DATA COLLECTOR SURVEY CONTROLLER SOFTWARE ON FIELD CONTROL POINT 1.

PROJECT COORDINATES ARE MODIFIED "MISSOURI COORDINATE SYSTEM OF 1983, EAST ZONE" COORDINATES AND WERE GENERATED BY SCALING THE COORDINATES BY THE INVERSE OF SAID COMBINED GRID FACTOR (1.0000834538) ABOUT ON-SITE POINT 1. THE COORDINATES WERE THEN CONVERTED TO FEET BY MULTIPLYING THE METRIC VALUES BY 3.280833333 (39.37 INCHES PER METER/12 INCHES PER FOOT).

THE GEOID UTILIZED TO OBTAIN PROJECT COORDINATES IS G12BUS.

TO THE BEST OF OUR KNOWLEDGE, THE MODIFIED MISSOURI STATE PLANE, EAST ZONE, COORDINATES MEET THE ACCURACY STANDARDS OF THE CURRENT MISSOURI STANDARDS FOR PROPERTY BOUNDARY SURVEYS (2 CSR 90-60) AS AN URBAN CLASS SURVEY.

PROJECT ELEVATIONS UTILIZE THE NAVD 88 VERTICAL DATUM AND WERE GENERATED BY GPS OBSERVATIONS USING A CELLULAR EQUIPPED TRIMBLE R8 GNSS ROVER AND TRIMBLE TSC3 DATA COLLECTOR AND ARE BASED ON THE MISSOURI HIGHWAYS AND TRANSPORTATION COMMISSION GLOBAL NAVIGATION SATELLITE REAL TIME NETWORK FOR CONTINUOUS OPERATING REFERENCE STATIONS.

Site

BENCHMARK:
SITE BENCHMARK (NAVD 88)- CHISELED SQUARE IN SOUTHWEST PART OF CONCRETE ISLAND AT THE INTERSECTION OF FALLON LOOP ROAD AND MISSOURI HIGHWAY K. (ELEVATION=535.77) AND IS LOCATED AS SHOWN HEREON.

AS-BUILT PUBLIC UTILITY FINAL MEASUREMENTS

THE FOLLOWING UTILITIES HAVE BEEN LOCATED AND MEASURED AND THE RESULTS OF THOSE MEASUREMENTS ARE SHOWN ON THIS SET OF FINAL MEASUREMENT PLANS:

- STORM SEWERS, STORM SEWER LENGTHS, STORM SEWER PIPE SIZES, STORM SEWER FLOWLINES AND DEPTHS OF STORM SEWER STRUCTURES.
- SANITARY SEWERS, SANITARY SEWER LENGTHS, SANITARY SEWER PIPE SIZES, SANITARY SEWER FLOWLINES AND DEPTHS OF SANITARY SEWER STRUCTURES.
- FIRE HYDRANTS
- WATER VALVES
- LIGHT STANDARDS

ALL PUBLIC UTILITIES SHOWN HEREON AS BEING AS-BUILT ARE LOCATED WITHIN DESIGNATED EXISTING OR PROPOSED EASEMENTS.

SIGNED: _____
P.E./L.S. _____

DATE _____



City approval of any construction site plan does not mean that any building can be constructed on the lots without meeting the building setbacks as required by the zoning codes.

All installations and construction shall conform to the approved engineering drawings. However, if the developer chooses to make minor modifications in design and/or specifications during construction, they shall make such changes at their own risk, without any assurance that the City Engineer will approve the completed installation or construction. It shall be the responsibility of the developer to notify the City Engineer of any changes from the approved drawings. The developer may be required to correct the installed improvements so as to conform to the approved engineering drawings. The developer may request a letter from the Construction Inspection Division regarding any field changes approved by the City Inspector.

Lighting values will be reviewed on site prior to the final occupancy inspection.

Legend

400.00	EXISTING LABELS	EXIST. SINGLE CURB INLET
600.00	PROPOSED LABELS	EXIST. AREA INLET
CI	SINGLE CURB INLET	PROPOSED SINGLE CURB INLET
DCI	DOUBLE CURB INLET	PROPOSED AREA INLET
AI	AREA INLET	PROPOSED GRATE INLET
DAI	DOUBLE AREA INLET	EXIST. SANITARY MANHOLE
GI	GRATE INLET	EXIST. STORM MANHOLE
DGI	DOUBLE GRATE INLET	PROPOSED MANHOLE
MH	MANHOLE	POWER POLE
FE	FLARED END SECTION	GUY WIRE
EP	END PIPE	LIGHT STANDARD
CP	CONCRETE PIPE	FIRE HYDRANT
RCP	REINFORCED CONCRETE PIPE	WATER METER
CMP	CORRUGATED METAL PIPE	WATER VALVE
CPP	CORRUGATED PLASTIC PIPE	GAS VALVE
PVC	POLY VINYL CHLORIDE (PLASTIC)	TELEPHONE PEDESTAL
CO	CLEAN OUT	SIGN
	SLOPE LIMITS	TREE
---	DRAINAGE SWALE	
---	EXISTING STORM SEWER	
---	EXISTING SANITARY SEWER	
---	EXISTING WATER LINE	
---	EXISTING FIBER OPTIC LINE	
---	EXISTING GAS LINE	
---	EXISTING UNDERGROUND ELECTRIC	
---	EXISTING OVERHEAD ELECTRIC	
---	EXISTING CABLE TV LINE	
---	EXISTING TELEPHONE LINE	
---	PROPOSED STORM SEWER	
---	PROPOSED SANITARY SEWER	
-X-X-	FENCE LINE	
---	SAWTOOTH LINE	

AS-BUILT LEGEND

- AS-BUILT STORM MANHOLE
- AS-BUILT CURB/GRATE INLET
- DENOTES AS-BUILT
- AS-BUILT SANITARY MANHOLE
- AS-BUILT FIRE HYDRANT
- AS-BUILT WATER VALVE
- AS-BUILT FIRE HOSE CONNECTION
- AS-BUILT LIGHT STANDARD
- AS-BUILT CLEANOUT

GRADING QUANTITIES:

1,585 C.Y. CUT (INCLUDES SUBGRADES)
2,345 C.Y. FILL (INCLUDES 8% SHRINKAGE)
760 C.Y. SHORT

THE ABOVE GRADING QUANTITY IS APPROXIMATE ONLY, NOT FOR BIDDING PURPOSES. CONTRACTOR SHALL VERIFY QUANTITIES PRIOR TO CONSTRUCTION.

VEGETATION ESTABLISHMENT For Urban Development Sites
APPENDIX A

SEEDING RATES:

PERMANENT:
Tall Fescue - 150 lbs./ac.
Smooth Bromes - 100 lbs./ac.
Combined - Fescue @ 75 lbs./ac. AND Bromes @ 50 lbs./ac.

TEMPORARY:
Wheat or Rye - 150 lbs./ac. (3.5 lbs. per 1,000 s.f.)
Oats - 120 lbs./ac. (2.75 lbs. per 1,000 s.f.)

SEEDING PERIODS:
Fescue or Bromes - March 1 to June 1
Wheat or Rye - August 1 to October 1
Oats - March 15 to November 1

MULCH RATES:
100 lbs. per 1000 sq. ft. (4,356 lbs. per ac.)

FERTILIZER RATES:
Nitrogen 30 lbs./ac.
Phosphate 30 lbs./ac.
Potassium 30 lbs./ac.
Lime 600 lbs./ac. ENM*

* ENM = effective neutralizing material as per State evaluation of quarried rock.




CALL BEFORE YOU DIG!
1-800-DIG-RITE
*FIBER OPTICS ARE PRESENT

CITY OF O'FALLON
ENGINEERING DEPARTMENT
ACCEPTED FOR CONSTRUCTION
BY: Jami Greenlee DATE: 01/11/2021
PROFESSIONAL ENGINEER'S SEAL
INDICATES RESPONSIBILITY FOR DESIGN

PROJECT TITLE:
TOMMY'S EXPRESS CAR WASH
101 FALLON LOOP RD.
O'FALLON MISSOURI 63368

ENGINEERING FIRM:
DOWLING ENTERPRISES LLC
5 BRIDLE LANE
FRONTENAC, MISSOURI 63181
314-614-4294

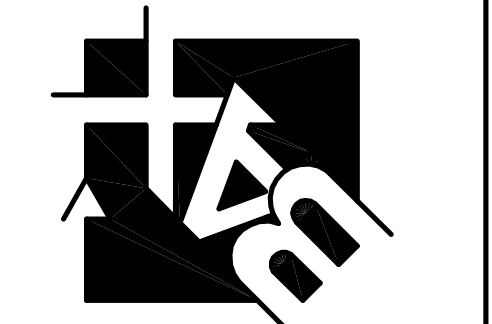

DISCLAIMER OF RESPONSIBILITY:
I hereby specify that the documents intended to be authorized by my seal are limited to this sheet, and I hereby disclaim any responsibility for all other drawings, specifications, estimates, reports or other documents or instruments relating to or intended to be used for any part or parts of the architectural or engineering project or survey.


REVISIONS	
01/04/21	COMMENTS PER CITY

Developer / Owner:
DOWLING ENTERPRISES LLC - BILL DOWLING
5 BRIDLE LANE
FRONTENAC, MISSOURI 63181
314-614-4294

COVER SHEET

P+Z No. #19-009654
Approval Date: 11-7-19
City No. #
Page No. 1 of 16


LANDSCAPE LEGEND	
	QTY. (13) ~ INDICATES EASTERN REDBUD (MATURE HEIGHT = 20-30 FT TALL) (MIN. 4" CALIPER & 8" IN HEIGHT)
	QTY. (20) ~ INDICATES WATERGREEN BOXWOOD (MATURE HEIGHT = 2-4 FT TALL)
	QTY. (14) ~ INDICATES WHITEPINE (MINIMUM HEIGHT = 6 FT TALL)
	QTY. (4) ~ INDICATES MORNING LIGHT TALL GRASS (MATURE HEIGHT = 4-6 FT TALL)

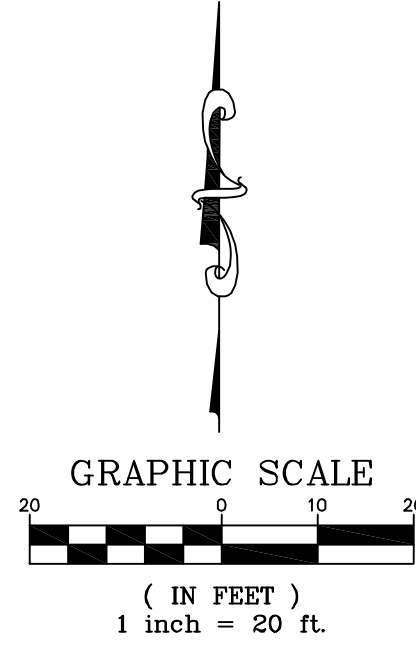

P.W.S.D. #2 NOTES

- IT'S THE CONTRACTORS RESPONSIBILITY TO OBTAIN ANY CITY OR MODOT PERMITS REQUIRED TO WORK ALONG THE ROADWAYS
- THE WATER DISTRICT REQUIRES ONE (1) WEEK NOTICE BEFORE THE START OF CONSTRUCTION.
- THE PROPOSED FIRE HYDRANT ASSEMBLY MUST BE TESTED PER THE WATER DISTRICTS SPECIFICATIONS BEFORE IT WILL BE ALLOWED INTO SERVICE.
- THE DEVELOPER WILL BE REQUIRED TO DEDICATE THE PROPOSED FIRE HYDRANT BY WAY OF BILL OF SALE AFTER THE TESTING IS COMPLETE.

ANY DAMAGED AREAS OF THE EXISTING SIDEWALK ALONG FALLON LOOP ROAD ARE REQUIRED TO BE UPGRADED/REPLACED INCLUDING EXISTING ACCESSIBLE RAMPS.

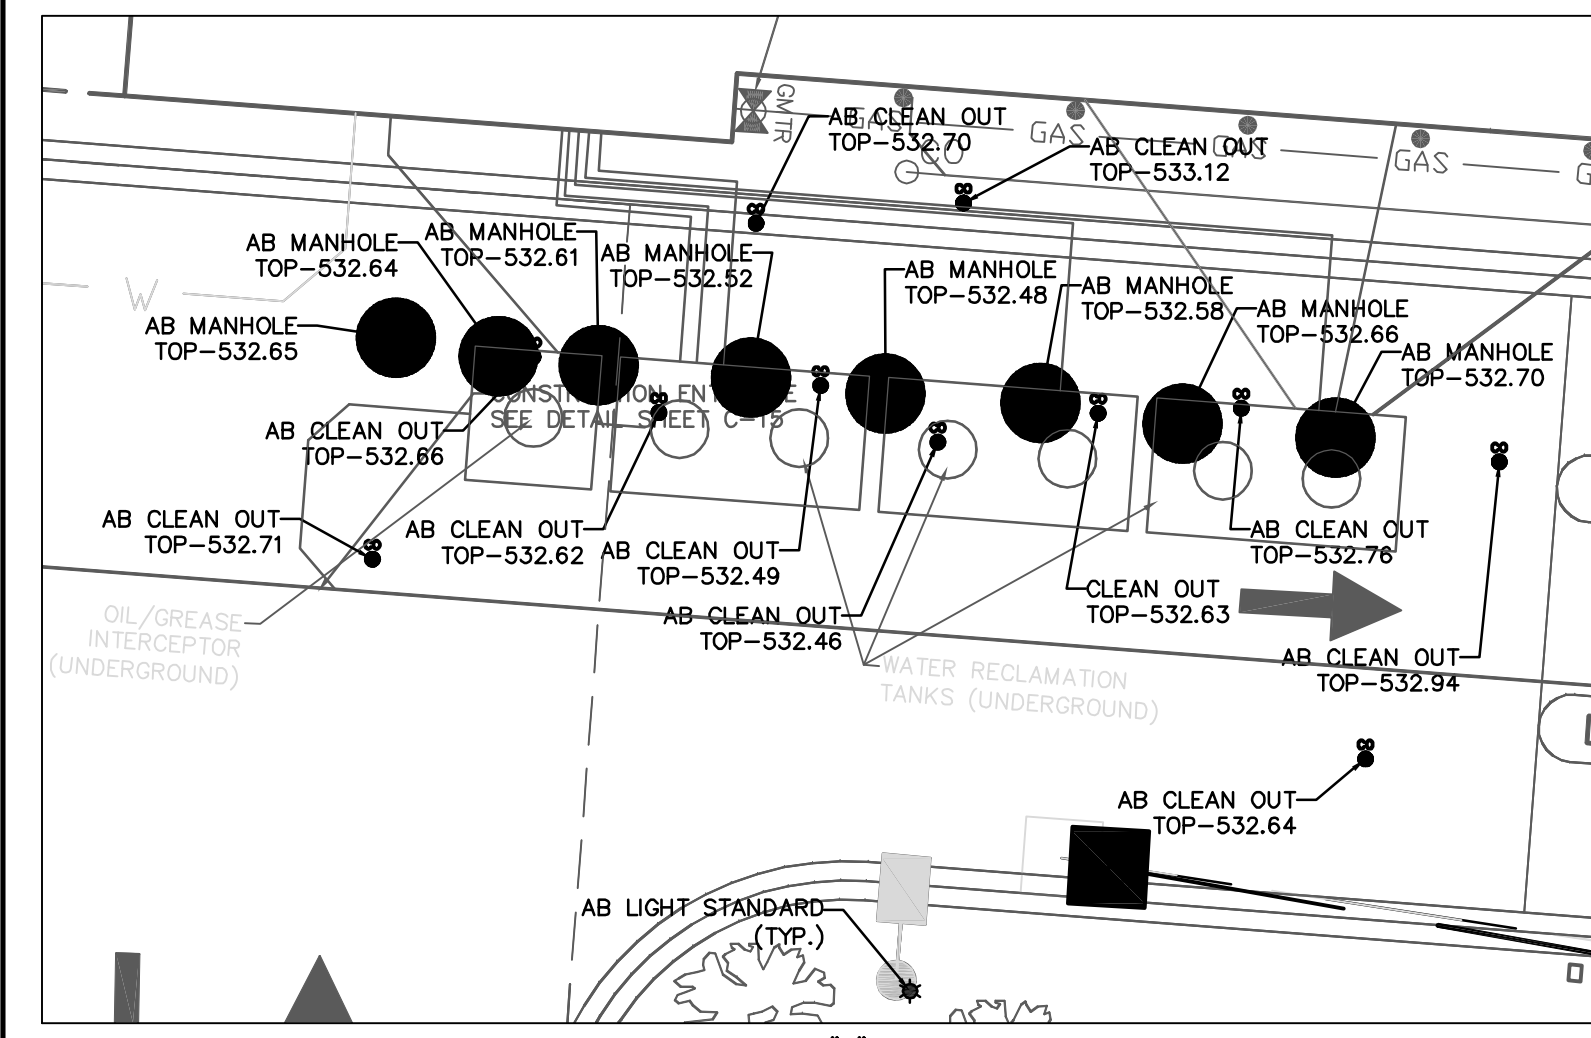

AS-BUILT PUBLIC UTILITY FINAL MEASUREMENTS

THE FOLLOWING UTILITIES HAVE BEEN LOCATED AND MEASURED AND THE RESULTS OF THOSE MEASUREMENTS ARE SHOWN ON THIS SET OF FINAL MEASUREMENT PLANS:

- STORM SEWERS, STORM SEWER LENGTHS, STORM SEWER PIPE SIZES, STORM SEWER FLOWLINES AND DEPTHS OF STORM SEWER STRUCTURES.
- SANITARY SEWERS, SANITARY SEWER LENGTHS, SANITARY SEWER PIPE SIZES, SANITARY SEWER FLOWLINES AND DEPTHS OF SANITARY SEWER STRUCTURES.
- FIRE HYDRANTS
- WATER VALVES
- LIGHT STANDARDS


ALL PUBLIC UTILITIES SHOWN HEREON AS BEING AS-BUILT ARE LOCATED WITHIN DESIGNATED EXISTING OR PROPOSED EASEMENTS.

SIGNED: _____ DATE: _____
P.E./L.S.



LEGEND		DATE
	FLARED END SECTION	
	CURB/AREA INLET	
	SANITARY SEWER MANHOLE	
	ELECTRIC BOX	
	TELEPHONE CABLE PEDESTAL	
	TELEPHONE BOX	
	ELECTRIC METER	
	WATER METER	
	FIRE HYDRANT	
	SIGN	
	POWER POLE	
	LIGHT STANDARD	
	TREE	
	BUSH	
	ROW MARKER	
	BENCHMARK	
	FOUND MONUMENT	
	SET MONUMENT	
	CONCRETE	
	OHW - OVERHEAD UTILITIES	
	GAS - BURIED GAS	
	W - BURIED WATER	
	SAN - SANITARY SEWER	
	TEL - TELEPHONE VAULT	

UNDERGROUND UTILITIES HAVE BEEN PLOTTED FROM AVAILABLE INFORMATION AND THEREFORE THEIR LOCATIONS SHALL BE CONSIDERED APPROXIMATE ONLY. THE VERIFICATION OF THE LOCATION OF ALL UNDERGROUND UTILITIES, EITHER SHOWN OR NOT SHOWN ON THESE PLANS SHALL BE THE RESPONSIBILITY OF THE CONTRACTOR, AND SHALL BE LOCATED PRIOR TO ANY GRADING OR CONSTRUCTION OF THE IMPROVEMENTS.

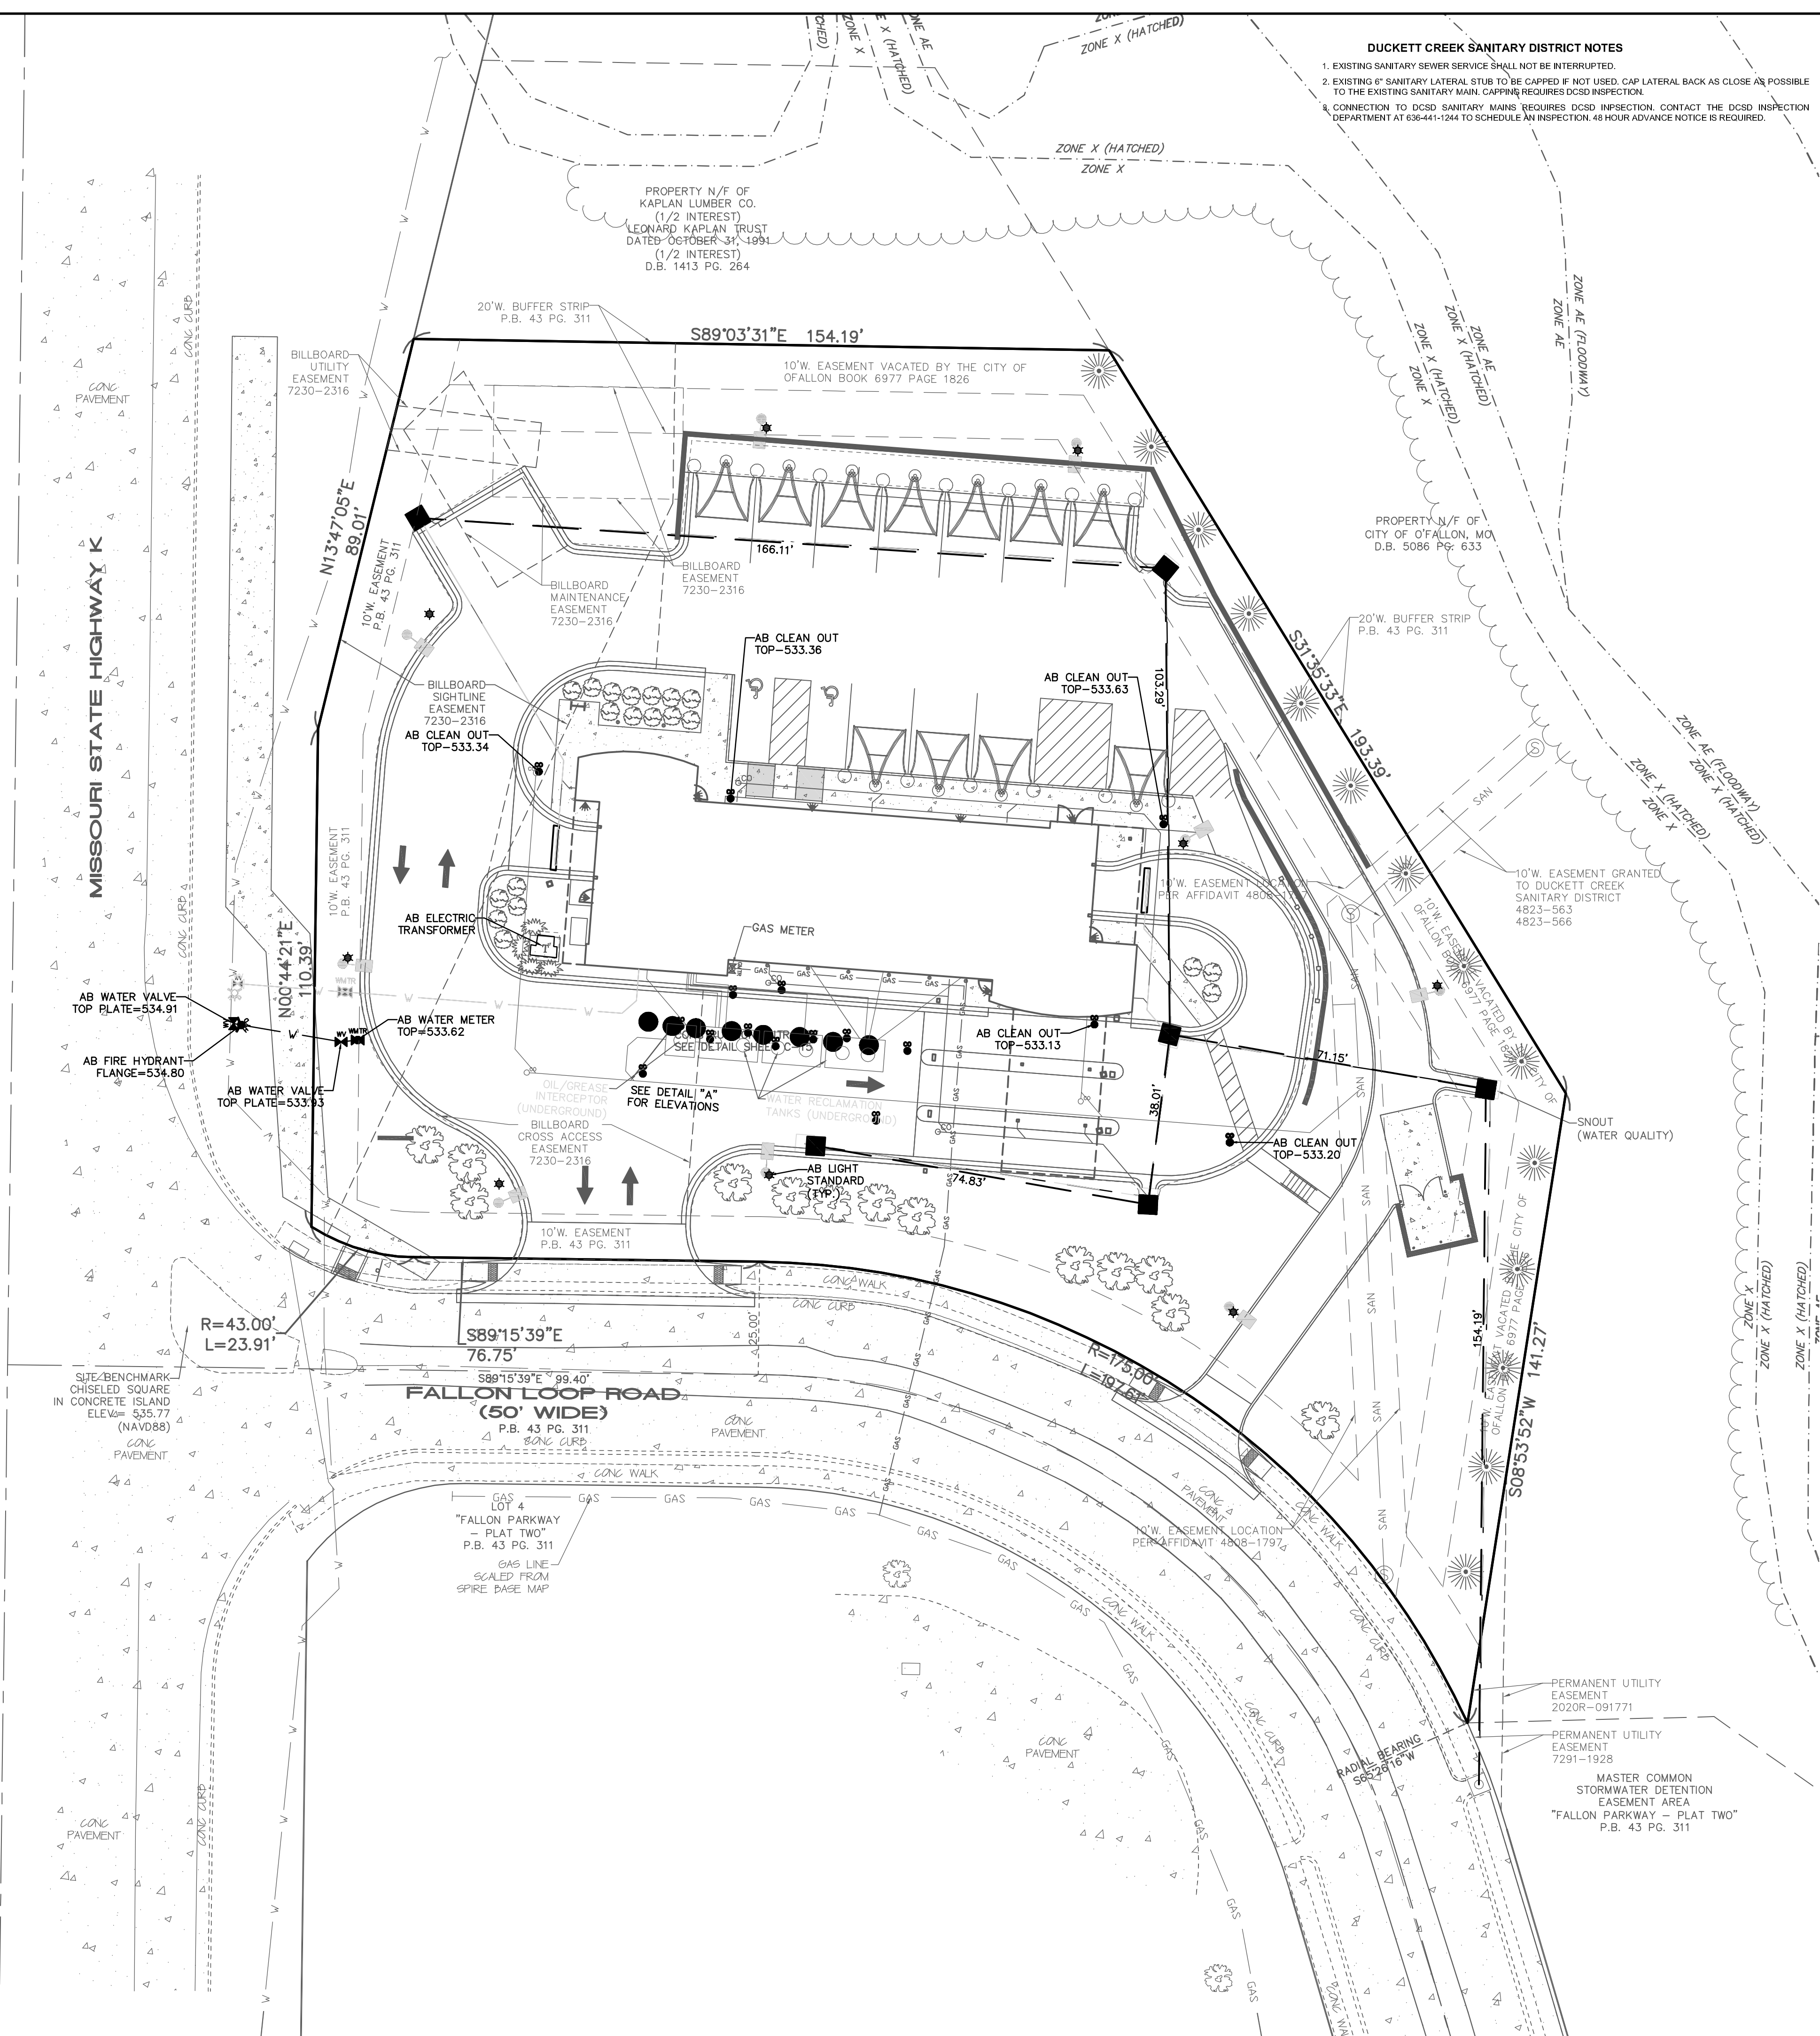

- #### DUCKETT CREEK SANITARY DISTRICT NOTES
- EXISTING SANITARY SEWER SERVICE SHALL NOT BE INTERRUPTED.
 - EXISTING 6" SANITARY LATERAL STUB TO BE CAPPED IF NOT USED. CAP LATERAL BACK AS CLOSE AS POSSIBLE TO THE EXISTING SANITARY MAIN. CAPPING REQUIRES DCSD INSPECTION.
 - CONNECTION TO DCSD SANITARY MAINS REQUIRES DCSD INSPECTION. CONTACT THE DCSD INSPECTION DEPARTMENT AT 636-441-044 TO SCHEDULE AN INSPECTION. 48 HOUR ADVANCE NOTICE IS REQUIRED.

PROJECT TITLE:
TOMMY'S EXPRESS CAR WASH
101 FALLON LOOP RD.
O'FALLON MISSOURI 63368

ENGINEERING
PLANNING
SURVEYING

221 Point View Blvd.
St. Charles, MO 63001
636-928-5562
FAX 928-1718

DISCLAIMER OF RESPONSIBILITY
I hereby specify that the documents intended to be authorized by my seal are limited to this sheet, and I hereby disclaim any responsibility for all other drawings, Specifications, Estimates, Reports or other documents or instruments relating to or intended to be used for any part or parts of the architectural or engineering project or survey.


REVISIONS	
01/04/21	COMMENTS PER CITY

Developer / Owner:
DOWLING ENTERPRISES LLC - BILL DOWLING
5 BRIDLE LANE
FRONTENAC, MISSOURI 63181
314-614-4294


FLAT PLAN

P+Z No. #19-009654
Approval Date: 11-7-19
City No. #
Page No. 4 of 16

Box Project # 96-879H[A] Issue Date: 12/11/2020

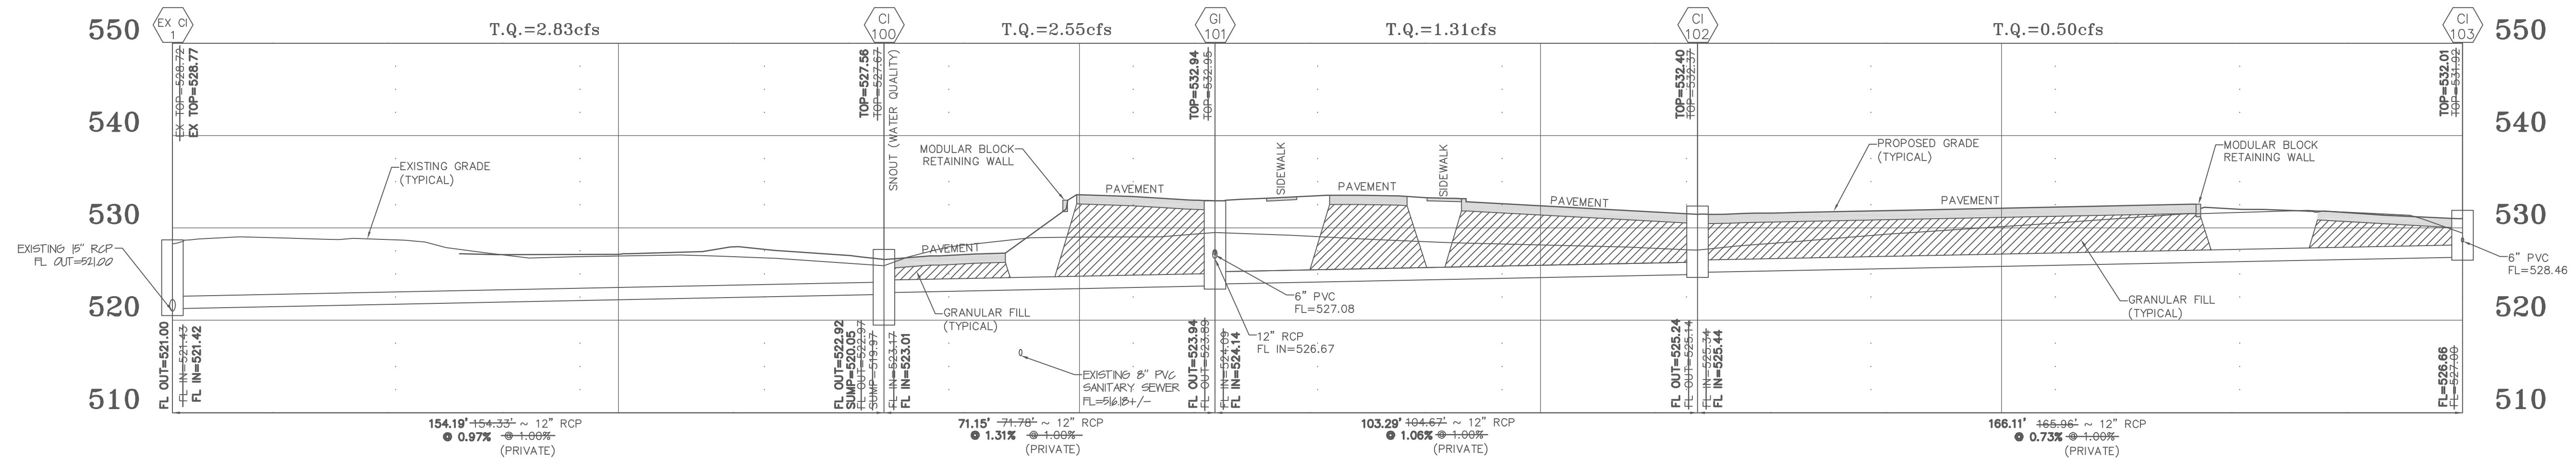


STORM SEWER PROFILE
 HORIZONTAL SCALE: 1"=20'
 VERTICAL SCALE: 1"=10'

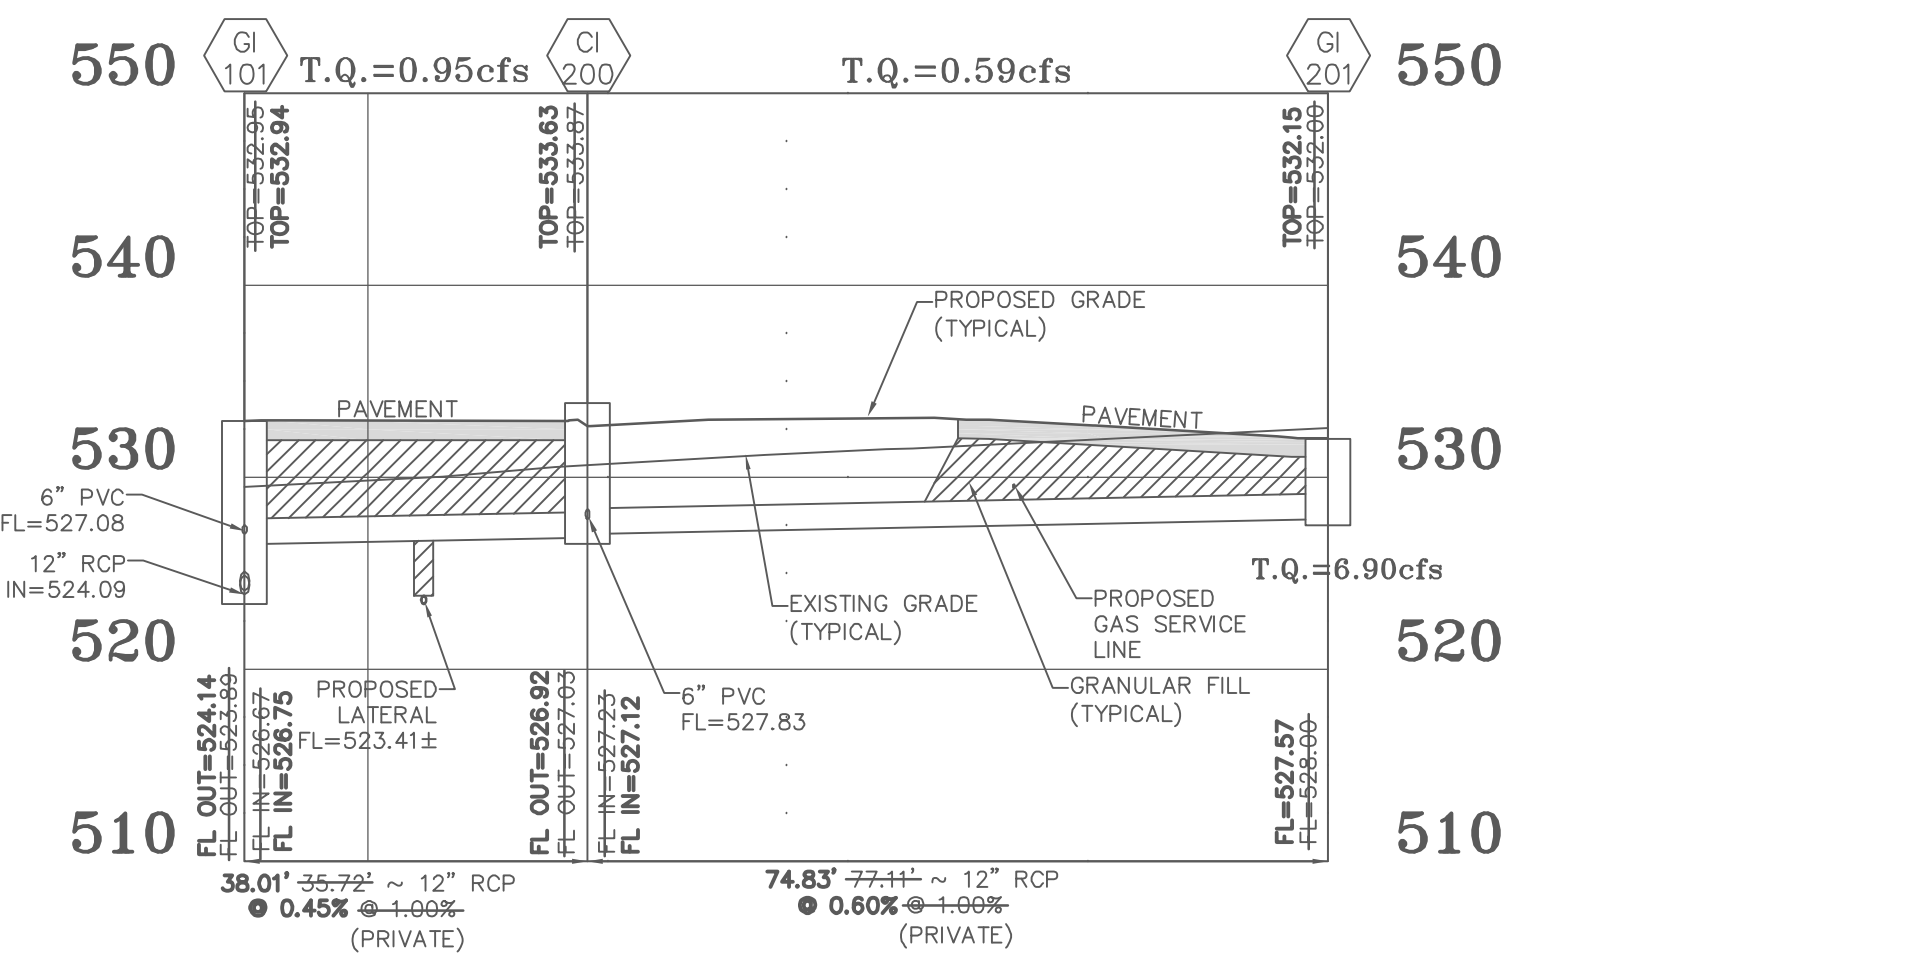


STORM SEWER PROFILE
 HORIZONTAL SCALE: 1"=20'
 VERTICAL SCALE: 1"=10'


- Snout Maintenance Recommendations:**
- 1) Monthly monitoring for the first year of a new installation after the site has been stabilized is a recommended practice.
 - 2) Measurements should be taken after each rain event of 0.5 inches or more, or monthly, as determined by local weather conditions.
 - 3) Checking sediment depth and noting the surface pollutants in the structure will be helpful in planning maintenance.
 - 4) The pollutants collected in SNOUT equipped structures will consist of floatable debris and oils on the surface of the captured water, and grit and sediment on the bottom of the structure.
 - 5) It is best to schedule maintenance based on the solids collected in the sump.
 - 6) Optimally, the structure should be cleaned when the sump is half full (e.g. when 2 feet of material collects in a 4 foot sump, clean it out).
 - 7) Structures should also be cleaned if a spill or other incident causes a larger than normal accumulation of pollutants in a structure.
 - 8) Maintenance is best done with a vacuum truck.
 - 9) If Bio-Skirts are being used in the structure to enhance hydrocarbon capture, they should be checked on a monthly basis for the first year, and serviced or replaced when more than 2/3 of the boom is submerged, indicating a nearly saturated state. Assuming a typical pollutant-loading environment exists, Bio-Skirts should be serviced annually or replaced as necessary.
 - 10) In the case of an oil spill, the structure should be checked and serviced and Bio-Skirts (if present) replaced or serviced immediately.
 - 11) All collected wastes must be handled and disposed of according to local environmental requirements.
 - 12) To maintain the SNOUT hoods and access hatch are recommended. A simple flushing of the vent, or a gentle rodding with a flexible wire are all that's typically needed to maintain the anti-siphon properties. Opening and closing the access hatch once a year ensures a lifetime of trouble-free service.

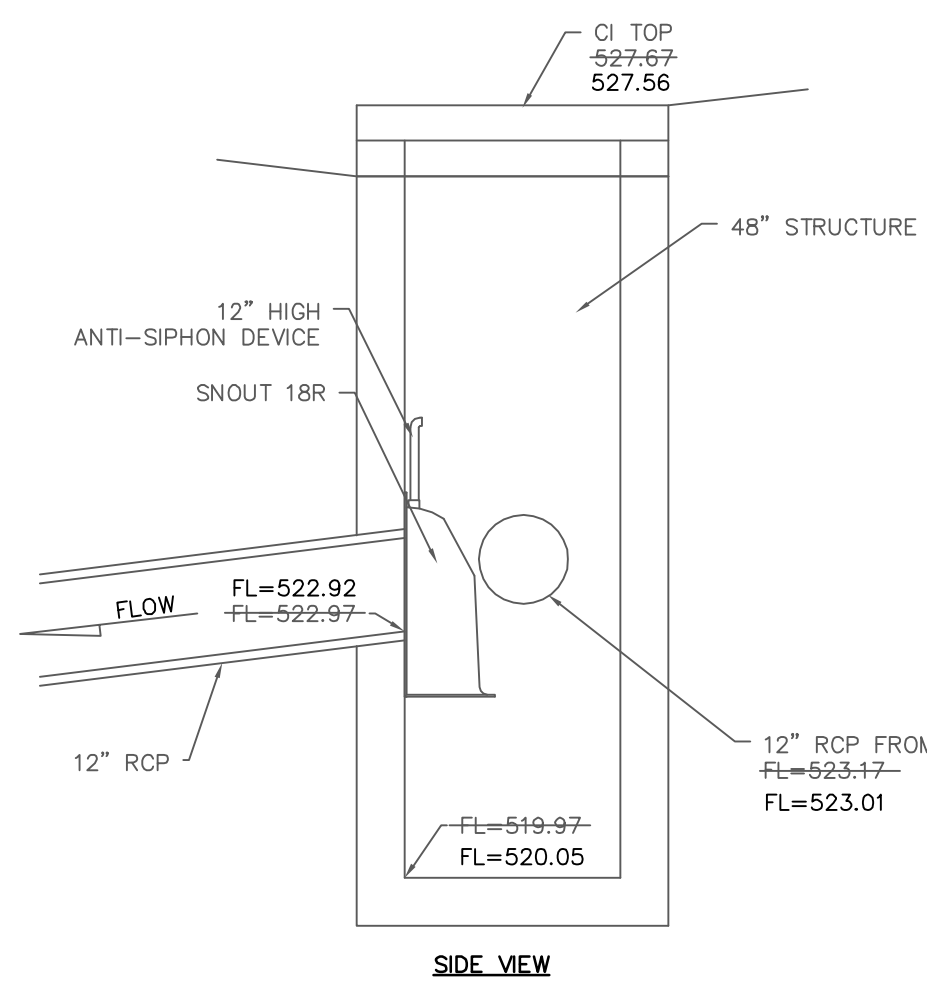

SNOUT DETAIL CI 100
 NOT TO SCALE

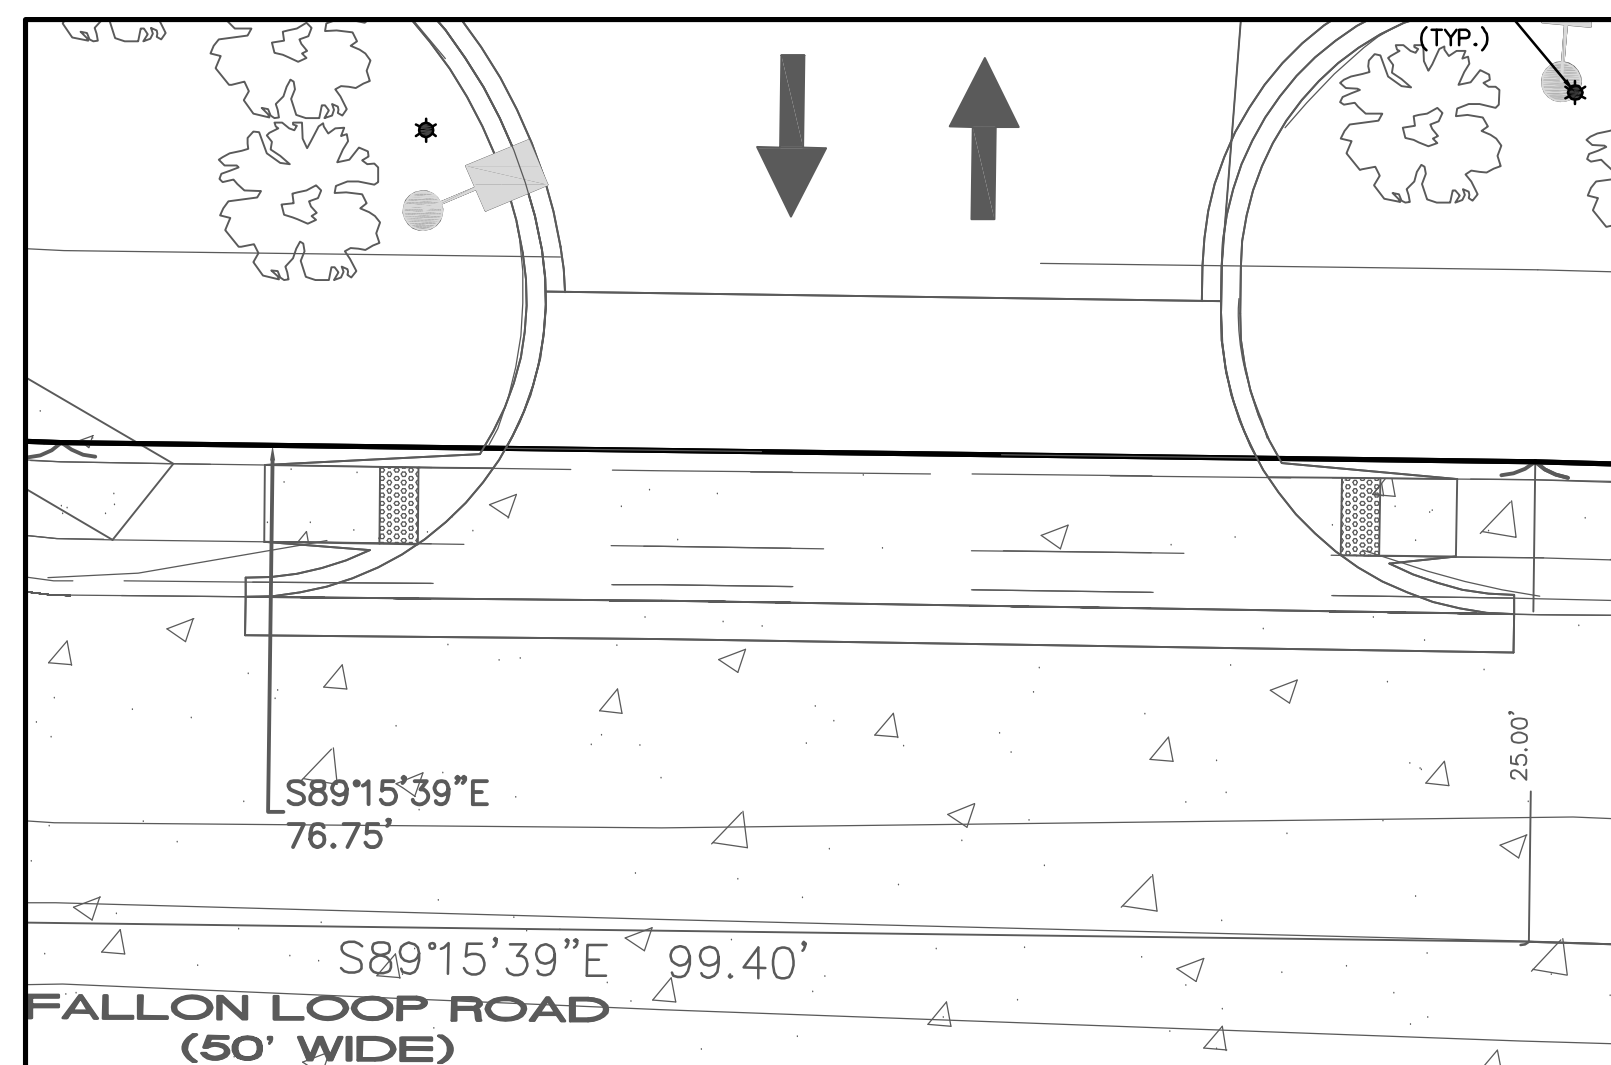

MAIN ENTRANCE DETAIL
 HORIZONTAL SCALE: 1"=10'

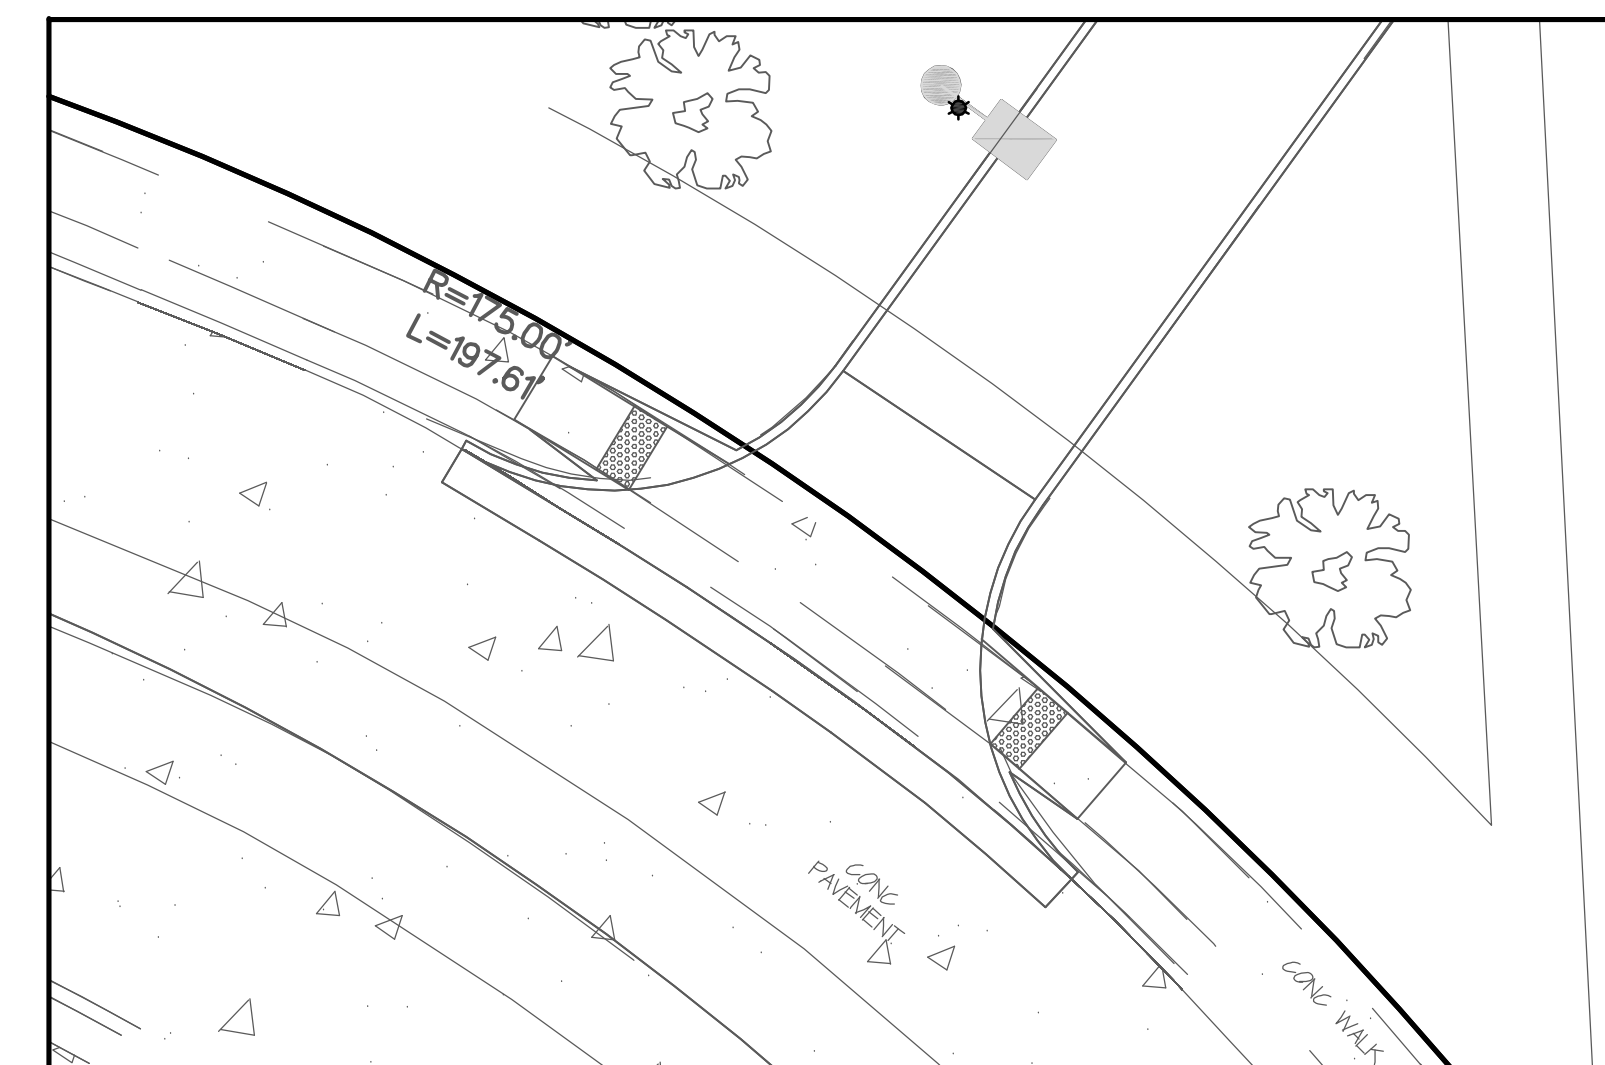

EXIT LANE ENTRANCE DETAIL
 HORIZONTAL SCALE: 1"=10'

CONFIGURATION DETAIL

TYPICAL INSTALLATION

INSTALLATION DETAIL

HOOD SPECIFICATION FOR CATCH BASINS AND WATER QUALITY STRUCTURES

DESCRIPTION	DATE	SCALE
OIL-DEBRIS HOOD SPECIFICATION AND INSTALLATION (TYPICAL)	09/08/18	NONE
DRAWING NUMBER	SP-SN	

NOTES:

1. ALL HOODS AND TRAPS FOR CATCH BASINS AND WATER QUALITY STRUCTURES SHALL BE AS MANUFACTURED BY BEST MANAGEMENT PRODUCTS, INC. 9 MATHEWS DRIVE, UNIT A-42, EAST HADDAM, CT 06423. TOLL FREE: (800) 534-9008 OR (860) 434-2277, FAX: (877) 434-5187. WEB SITE: www.bmpinc.com OR PRE-APPROVED EQUAL.
2. ALL HOODS SHALL BE CONSTRUCTED OF A GLASS REINFORCED RESIN COMPOSITE WITH 180 GEL COAT EXTERIOR FINISH WITH A MINIMUM 1/16\"/>
- 3. ALL HOODS SHALL BE EQUIPPED WITH A WATER-TIGHT ACCESS PORT, MOUNTING FLANGE, AND AN ANTI-SIPHON VENT PIPE AND ELBOW AS DRAWN. (SEE CONFIGURATION DETAIL).
- 4. THE SIZE AND POSITION OF THE HOOD SHALL BE DETERMINED BY OUTLET PIPE SIZE AS PER MANUFACTURER'S RECOMMENDATION. (SNOUT SIDE ALWAYS LARGER THAN PIPE SIZE).
- 5. THE BOTTOM OF THE HOOD SHALL EXTEND DOWNWARD A MINIMUM DISTANCE EQUAL TO 1/2 THE OUTLET PIPE DIAMETER WITH A MINIMUM DISTANCE OF 8\"/>
- 6. THE ANTI-SIPHON VENT SHALL EXTEND ABOVE HOOD BY MINIMUM OF 3\"/>
- 7. THE SURFACE OF THE STRUCTURE WHERE THE HOOD IS MOUNTED SHALL BE FINISHED SMOOTH AND FREE OF LOOSE MATERIAL AND PIPE SHALL BE FINISHED FLUSH TO WALL.
- 8. ALL STRUCTURE JOINTS SHALL BE WATER-TIGHT.
- 9. THE HOOD SHALL BE SECURELY ATTACHED TO STRUCTURE WALL WITH 3\"/>
- 10. INSTALLATION INSTRUCTIONS SHALL BE FURNISHED WITH MANUFACTURER SUPPLIED INSTALLATION KIT. INSTALLATION KIT SHALL INCLUDE:
 - A. INSTALLATION INSTRUCTIONS
 - B. PVC ANTI-SIPHON VENT PIPE AND ADAPTER
 - C. OIL-RESISTANT CRUSHED CELL FOAM GASKET WITH PSA BACKING
 - D. 3/8\"/>
 - E. ANCHOR SHIELDS

US Patent # 6126817, 7651204, 7857986, 8512856
 Canada Patent # 2285146, 2690155, 2690156 others pending

AS-BUILT PUBLIC UTILITY FINAL MEASUREMENTS

THE FOLLOWING UTILITIES HAVE BEEN LOCATED AND MEASURED AND THE RESULTS OF THOSE MEASUREMENTS ARE SHOWN ON THIS SET OF FINAL MEASUREMENT PLANS:

- STORM SEWERS, STORM SEWER LENGTHS, STORM SEWER PIPE SIZES, STORM SEWER FLOWLINES AND DEPTHS OF STORM SEWER STRUCTURES.
- SANITARY SEWERS, SANITARY SEWER LENGTHS, SANITARY SEWER PIPE SIZES, SANITARY SEWER FLOWLINES AND DEPTHS OF SANITARY SEWER STRUCTURES.
- FIRE HYDRANTS
- WATER VALVES
- LIGHT STANDARDS


ALL PUBLIC UTILITIES SHOWN HEREON AS BEING AS-BUILT ARE LOCATED WITHIN DESIGNATED EXISTING OR PROPOSED EASEMENTS.

SIGNED: _____ DATE: _____
 P.E./L.S.



PROJECT TITLE:
 TOMMY'S EXPRESS CAR WASH
 101 FALLON LOOP RD.
 O'FALLON MISSOURI 63368

ENGINEERING FIRM:
 PLANNING SURVEYING
 22 Point View Blvd.
 St. Charles, MO 63301
 636-928-5562
 FAX 928-1718

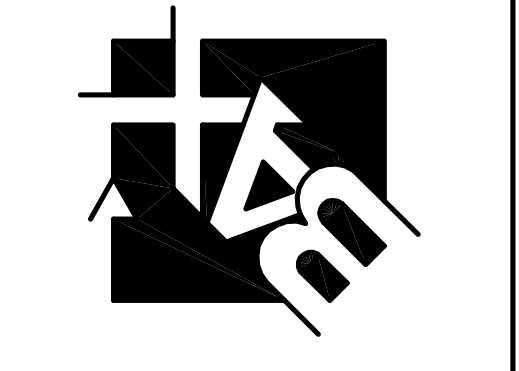

DISCLAIMER OF RESPONSIBILITY:
 I hereby specify that the documents intended to be authorized by my seal are limited to this sheet, and I hereby disclaim any responsibility for all other drawings, Specifications, Estimates, Reports or other documents or instruments relating to or intended to be used for any part or parts of the architectural or engineering project or survey.

REVISIONS

01/04/21	COMMENTS	PER CITY


Developer / Owner:
 DOWLING ENTERPRISES LLC - BILL DOWLING
 5 BRIDLE LANE
 FRONTENAC, MISSOURI 63181
 314-614-4294

STORM PROFILES, ENTRANCE DETAIL AND WATER QUALITY DETAILS



P+Z No. #19-009654
Approval Date: 11-7-19
City No. #

Page No.
 8 of 16

Box Project # 96-879HJA Issue Date: 12/11/2020

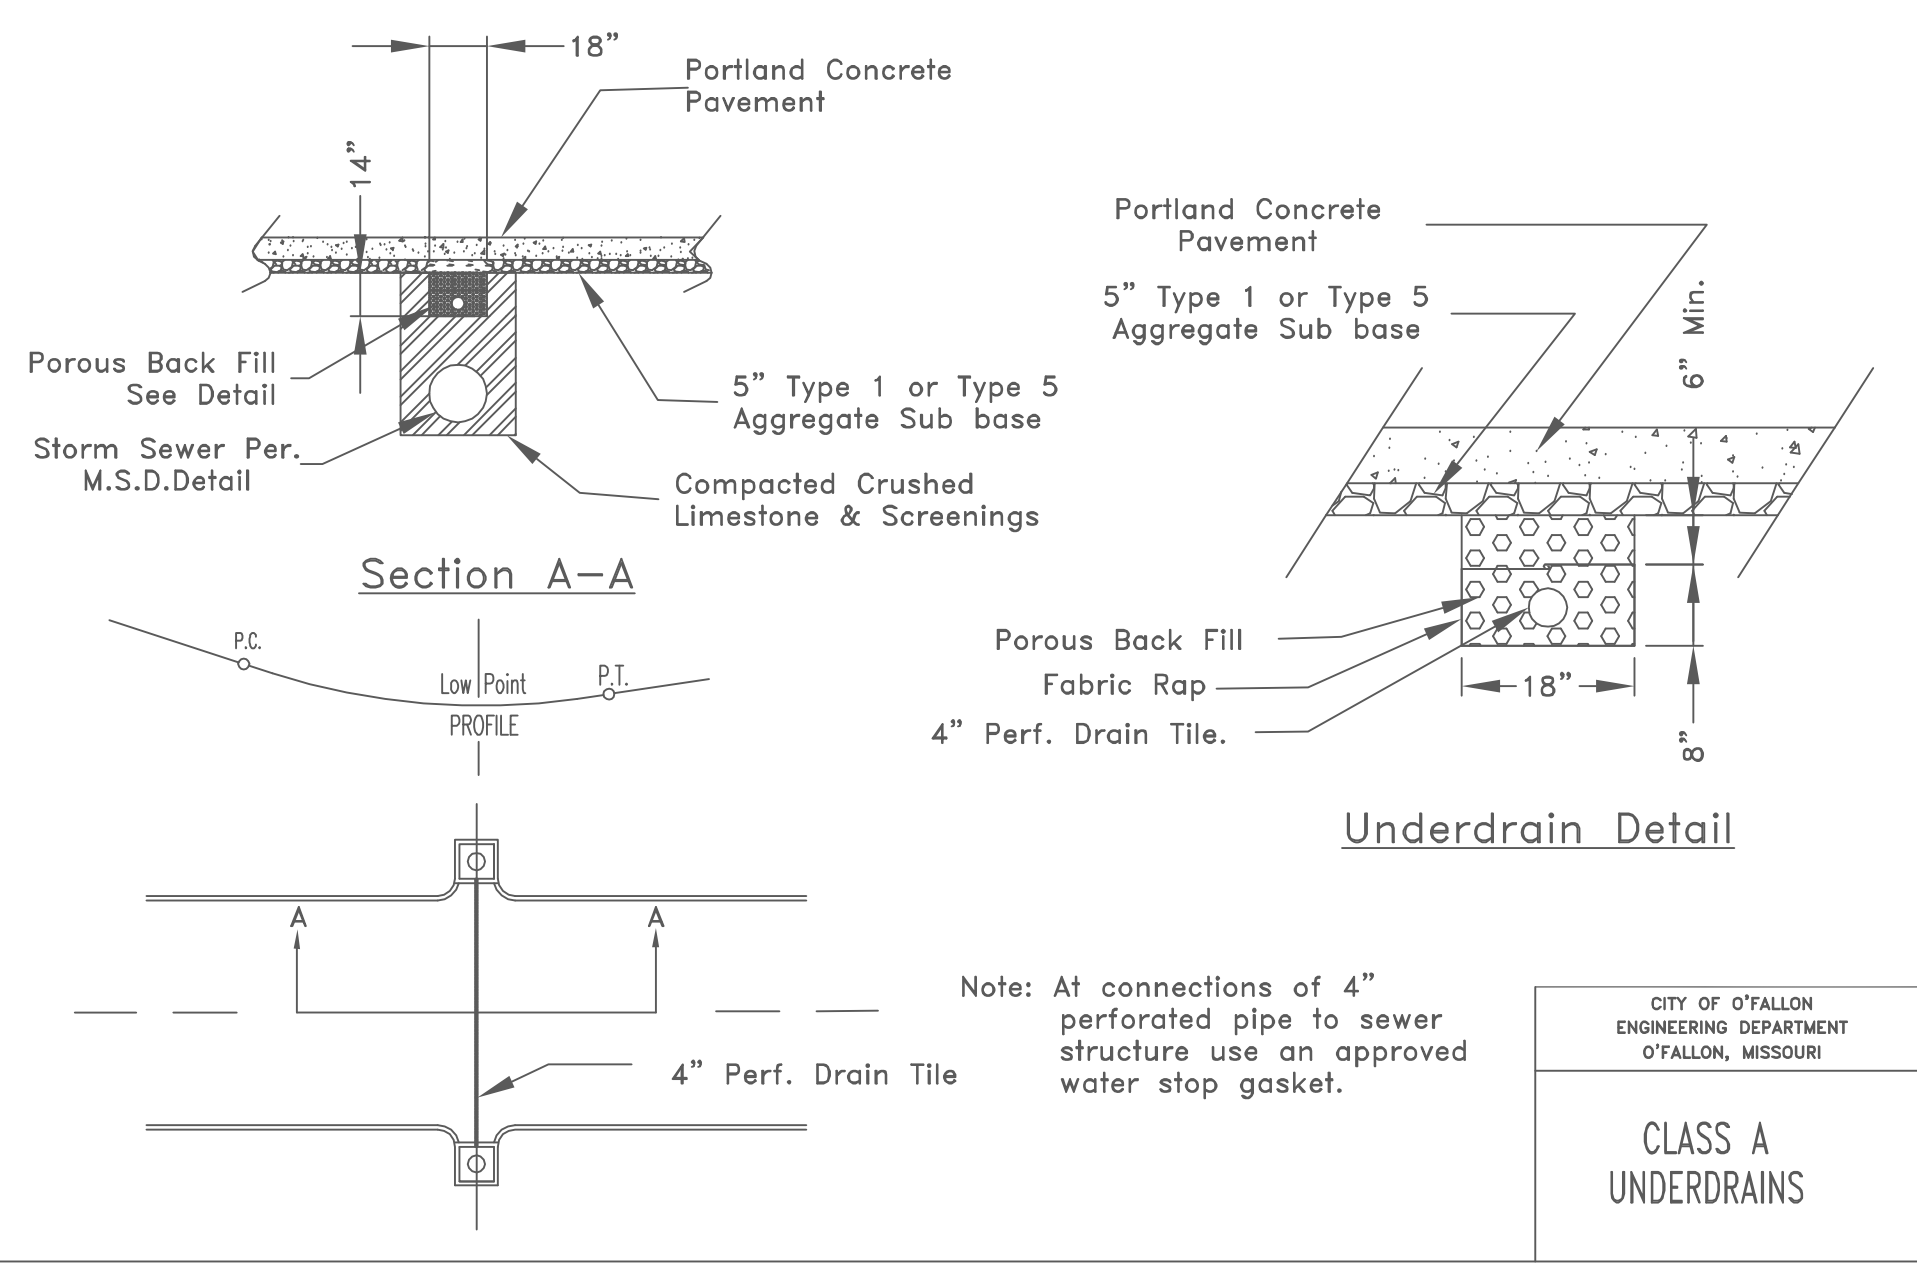


* All other Storm or Sanitary Sewer Details will be by M.S.D. Standards and Specifications.
 ** All inlets shall have 5/8" trash bar centered with the opening(s).

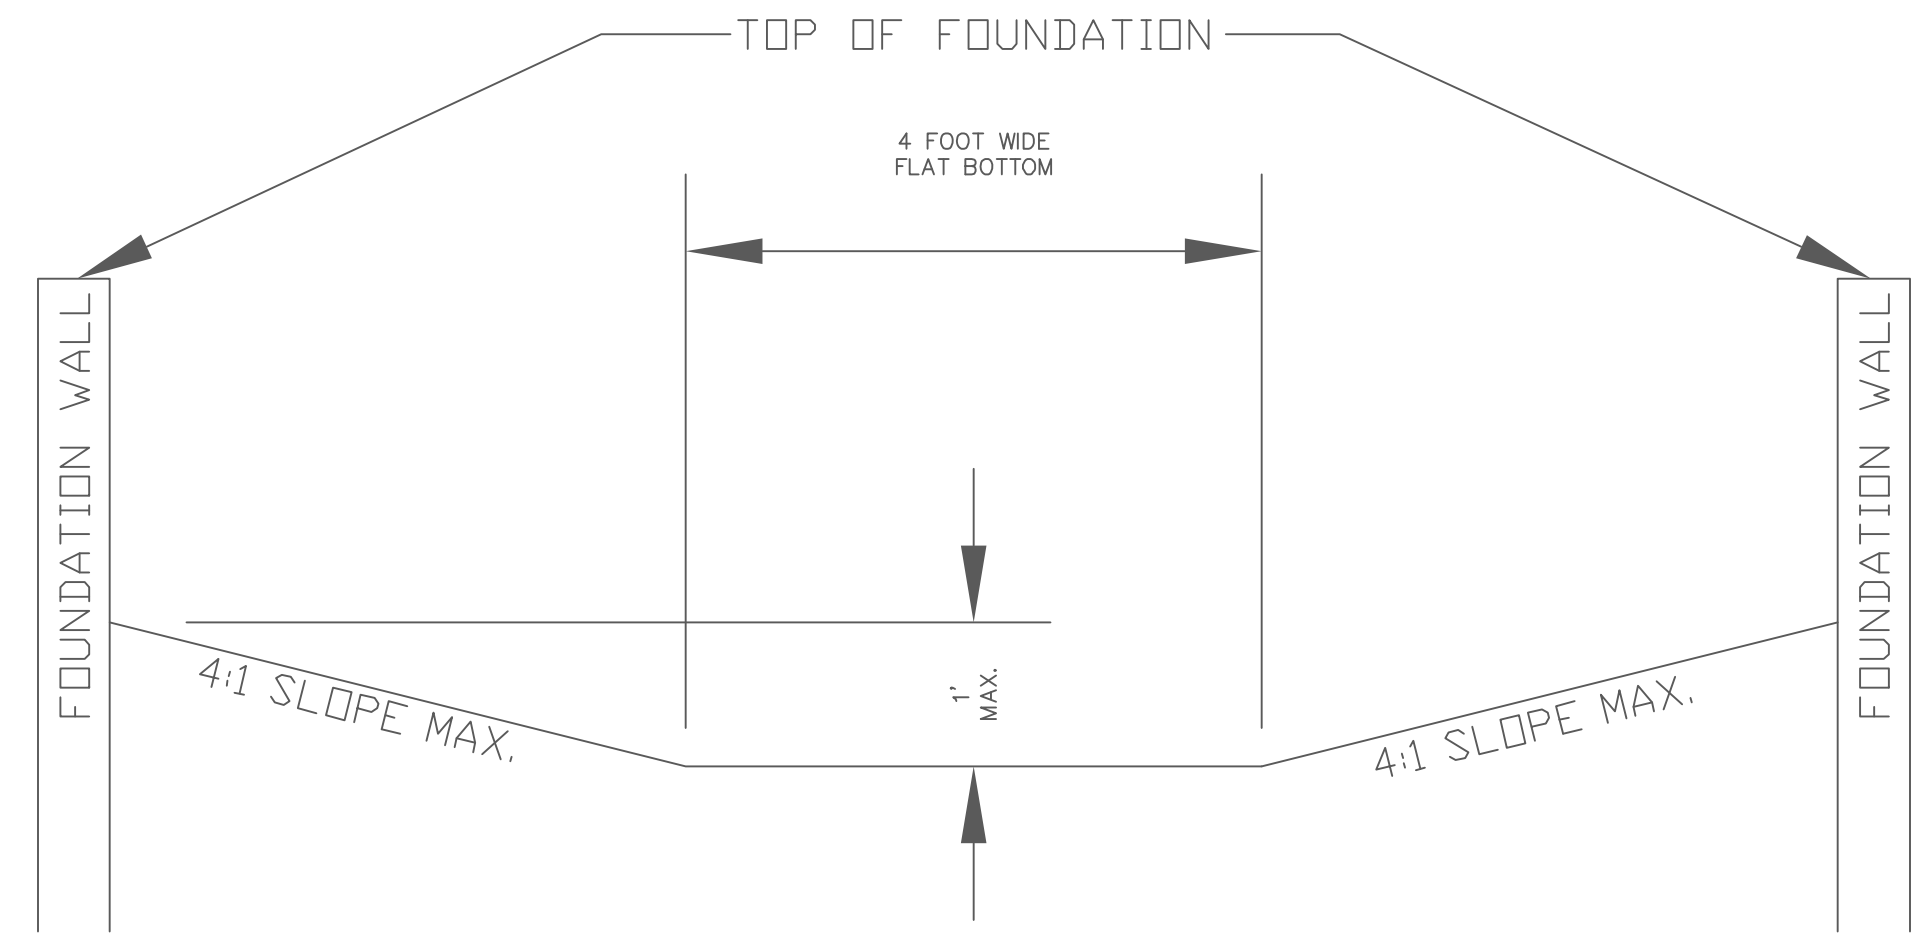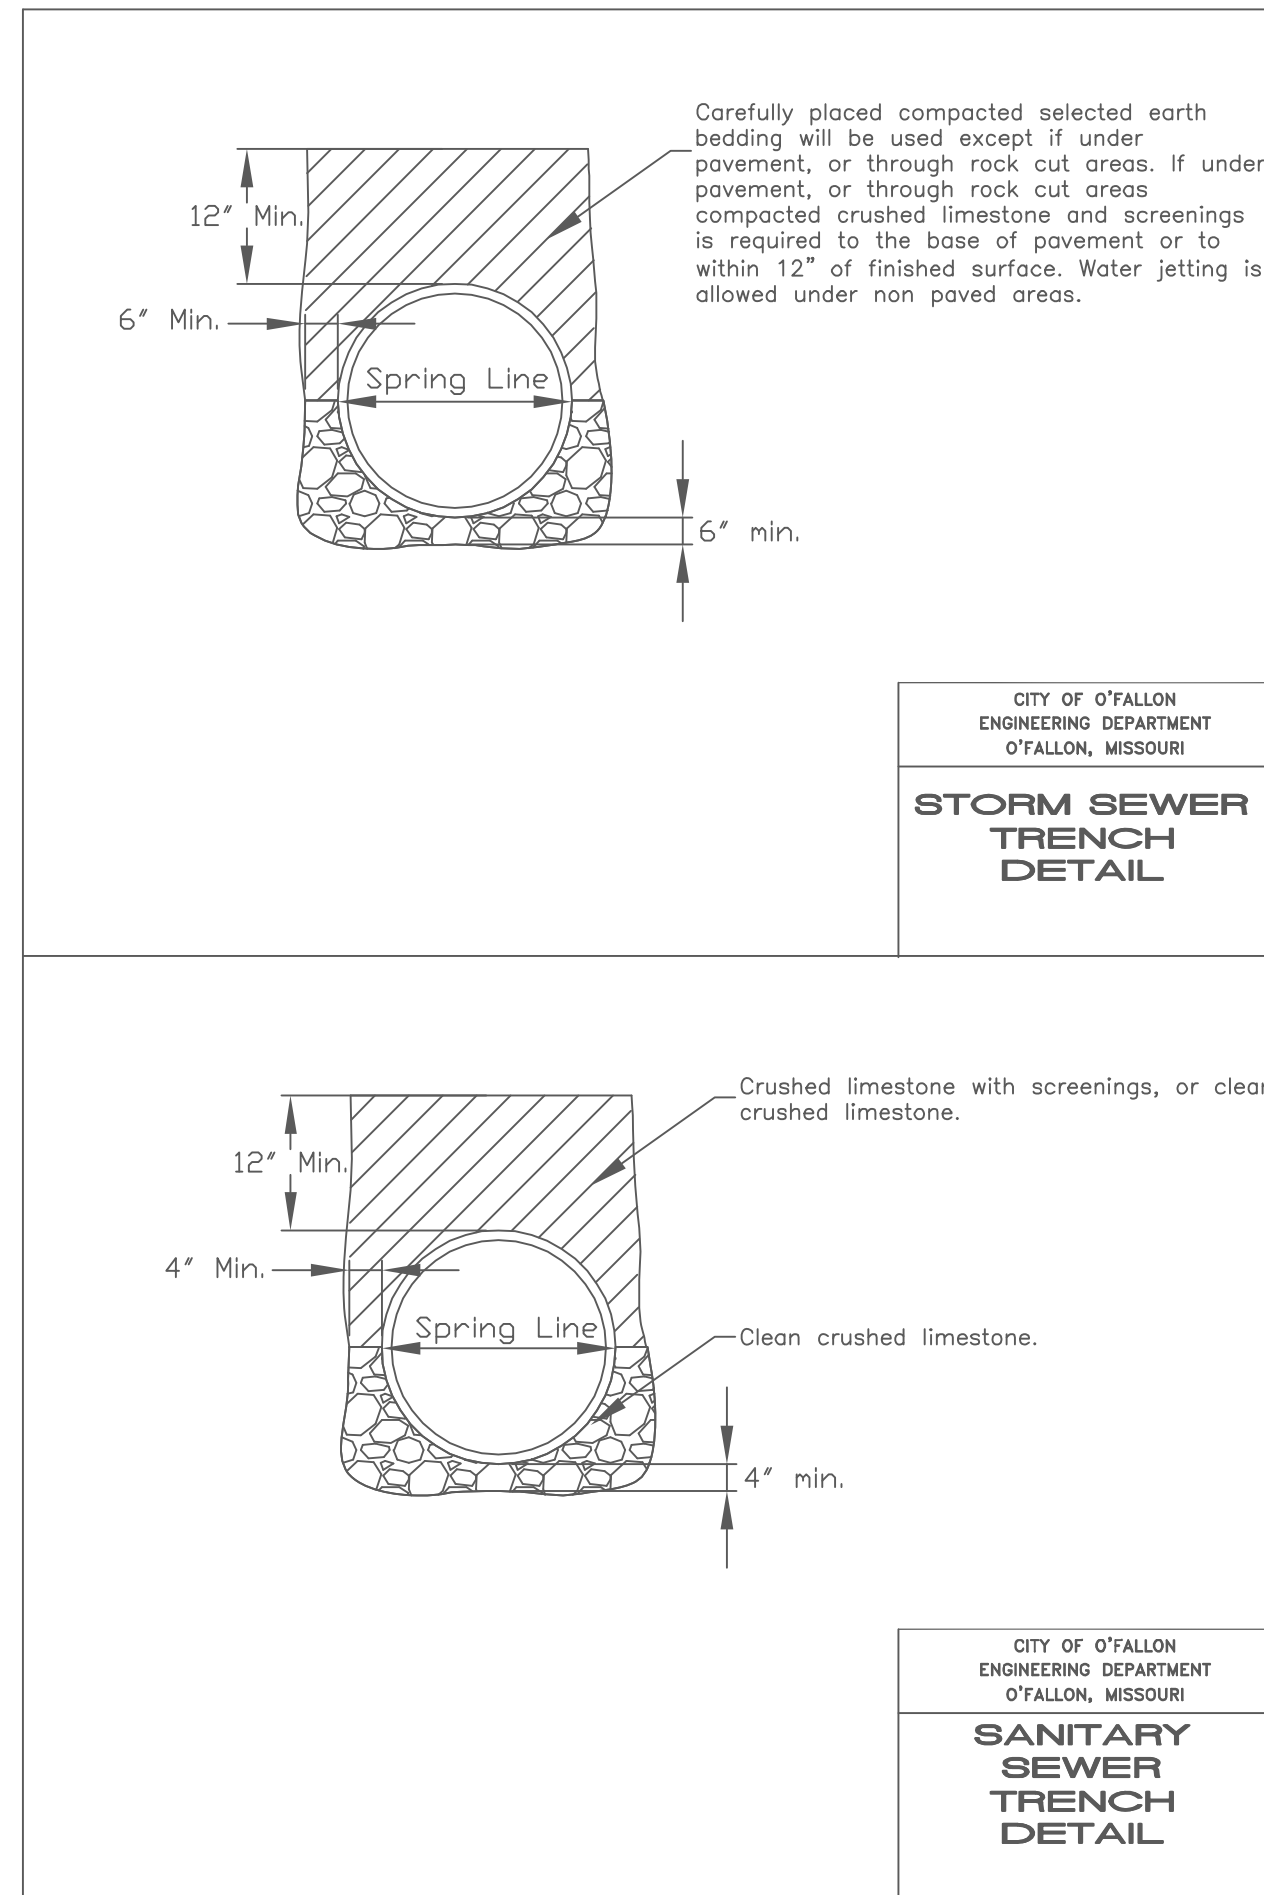

TYPICAL EMERGENCY RELIEF PATH SECTION
N.T.S.

NOTE:
THE 100 YEAR STORM WATER FLOW SHALL NOT EXCEED THE LOW SILL ELEVATION OF THE HOUSE OR WINDOW WELLS WILL BE REQUIRED.

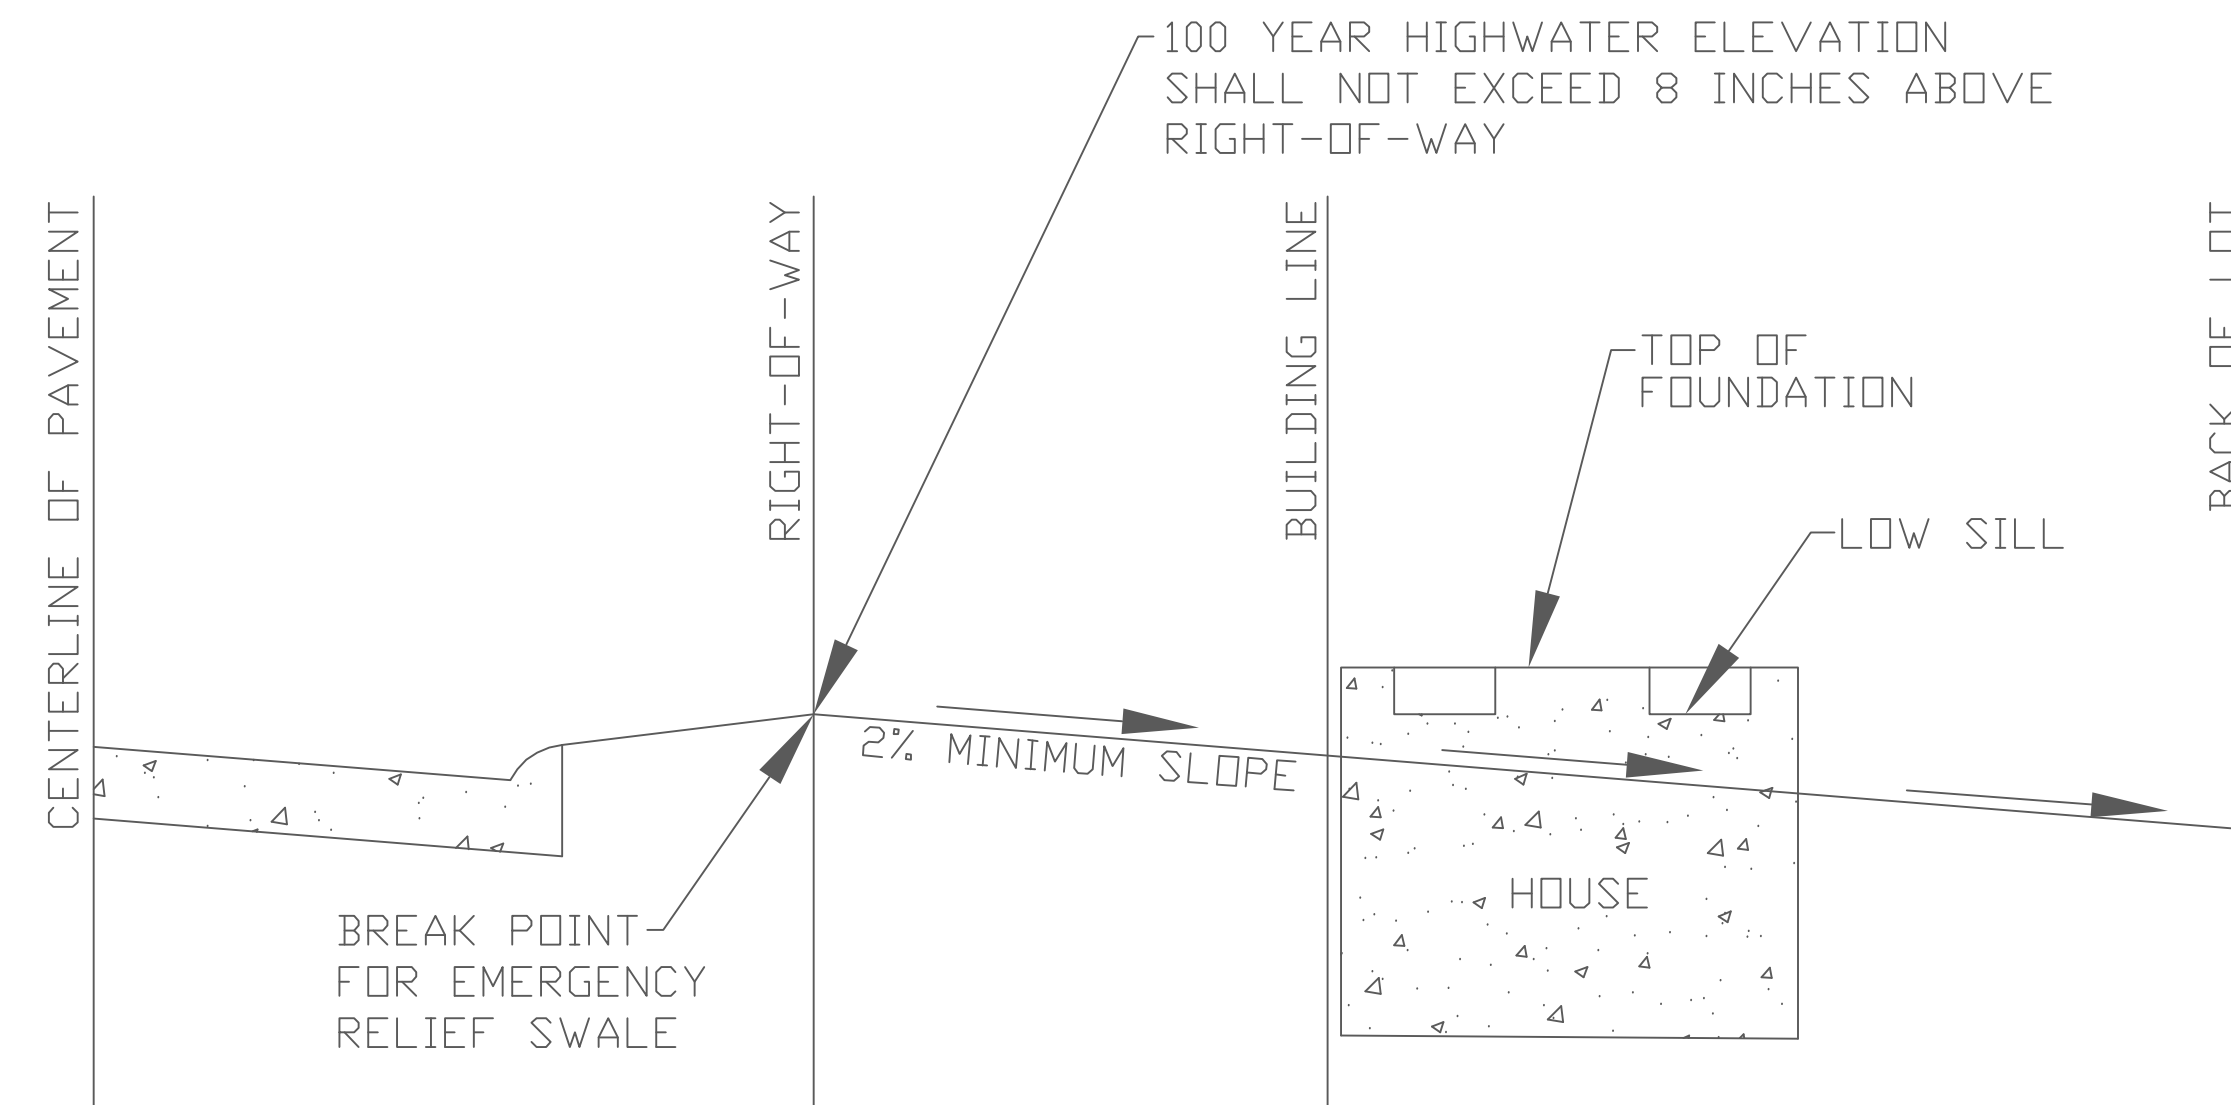

TYPICAL EMERGENCY RELIEF PATH PROFILE
N.T.S.


AS-BUILT PUBLIC UTILITY FINAL MEASUREMENTS

THE FOLLOWING UTILITIES HAVE BEEN LOCATED AND MEASURED AND THE RESULTS OF THOSE MEASUREMENTS ARE SHOWN ON THIS SET OF FINAL MEASUREMENT PLANS:

- STORM SEWERS, STORM SEWER LENGTHS, STORM SEWER PIPE SIZES, STORM SEWER FLOWLINES AND DEPTHS OF STORM SEWER STRUCTURES.
- SANITARY SEWERS, SANITARY SEWER LENGTHS, SANITARY SEWER PIPE SIZES, SANITARY SEWER FLOWLINES AND DEPTHS OF SANITARY SEWER STRUCTURES.
- FIRE HYDRANTS
- WATER VALVES
- LIGHT STANDARDS


ALL PUBLIC UTILITIES SHOWN HEREON AS BEING AS-BUILT ARE LOCATED WITHIN DESIGNATED EXISTING OR PROPOSED EASEMENTS.

SIGNED: _____
P.E./L.S. _____
DATE _____

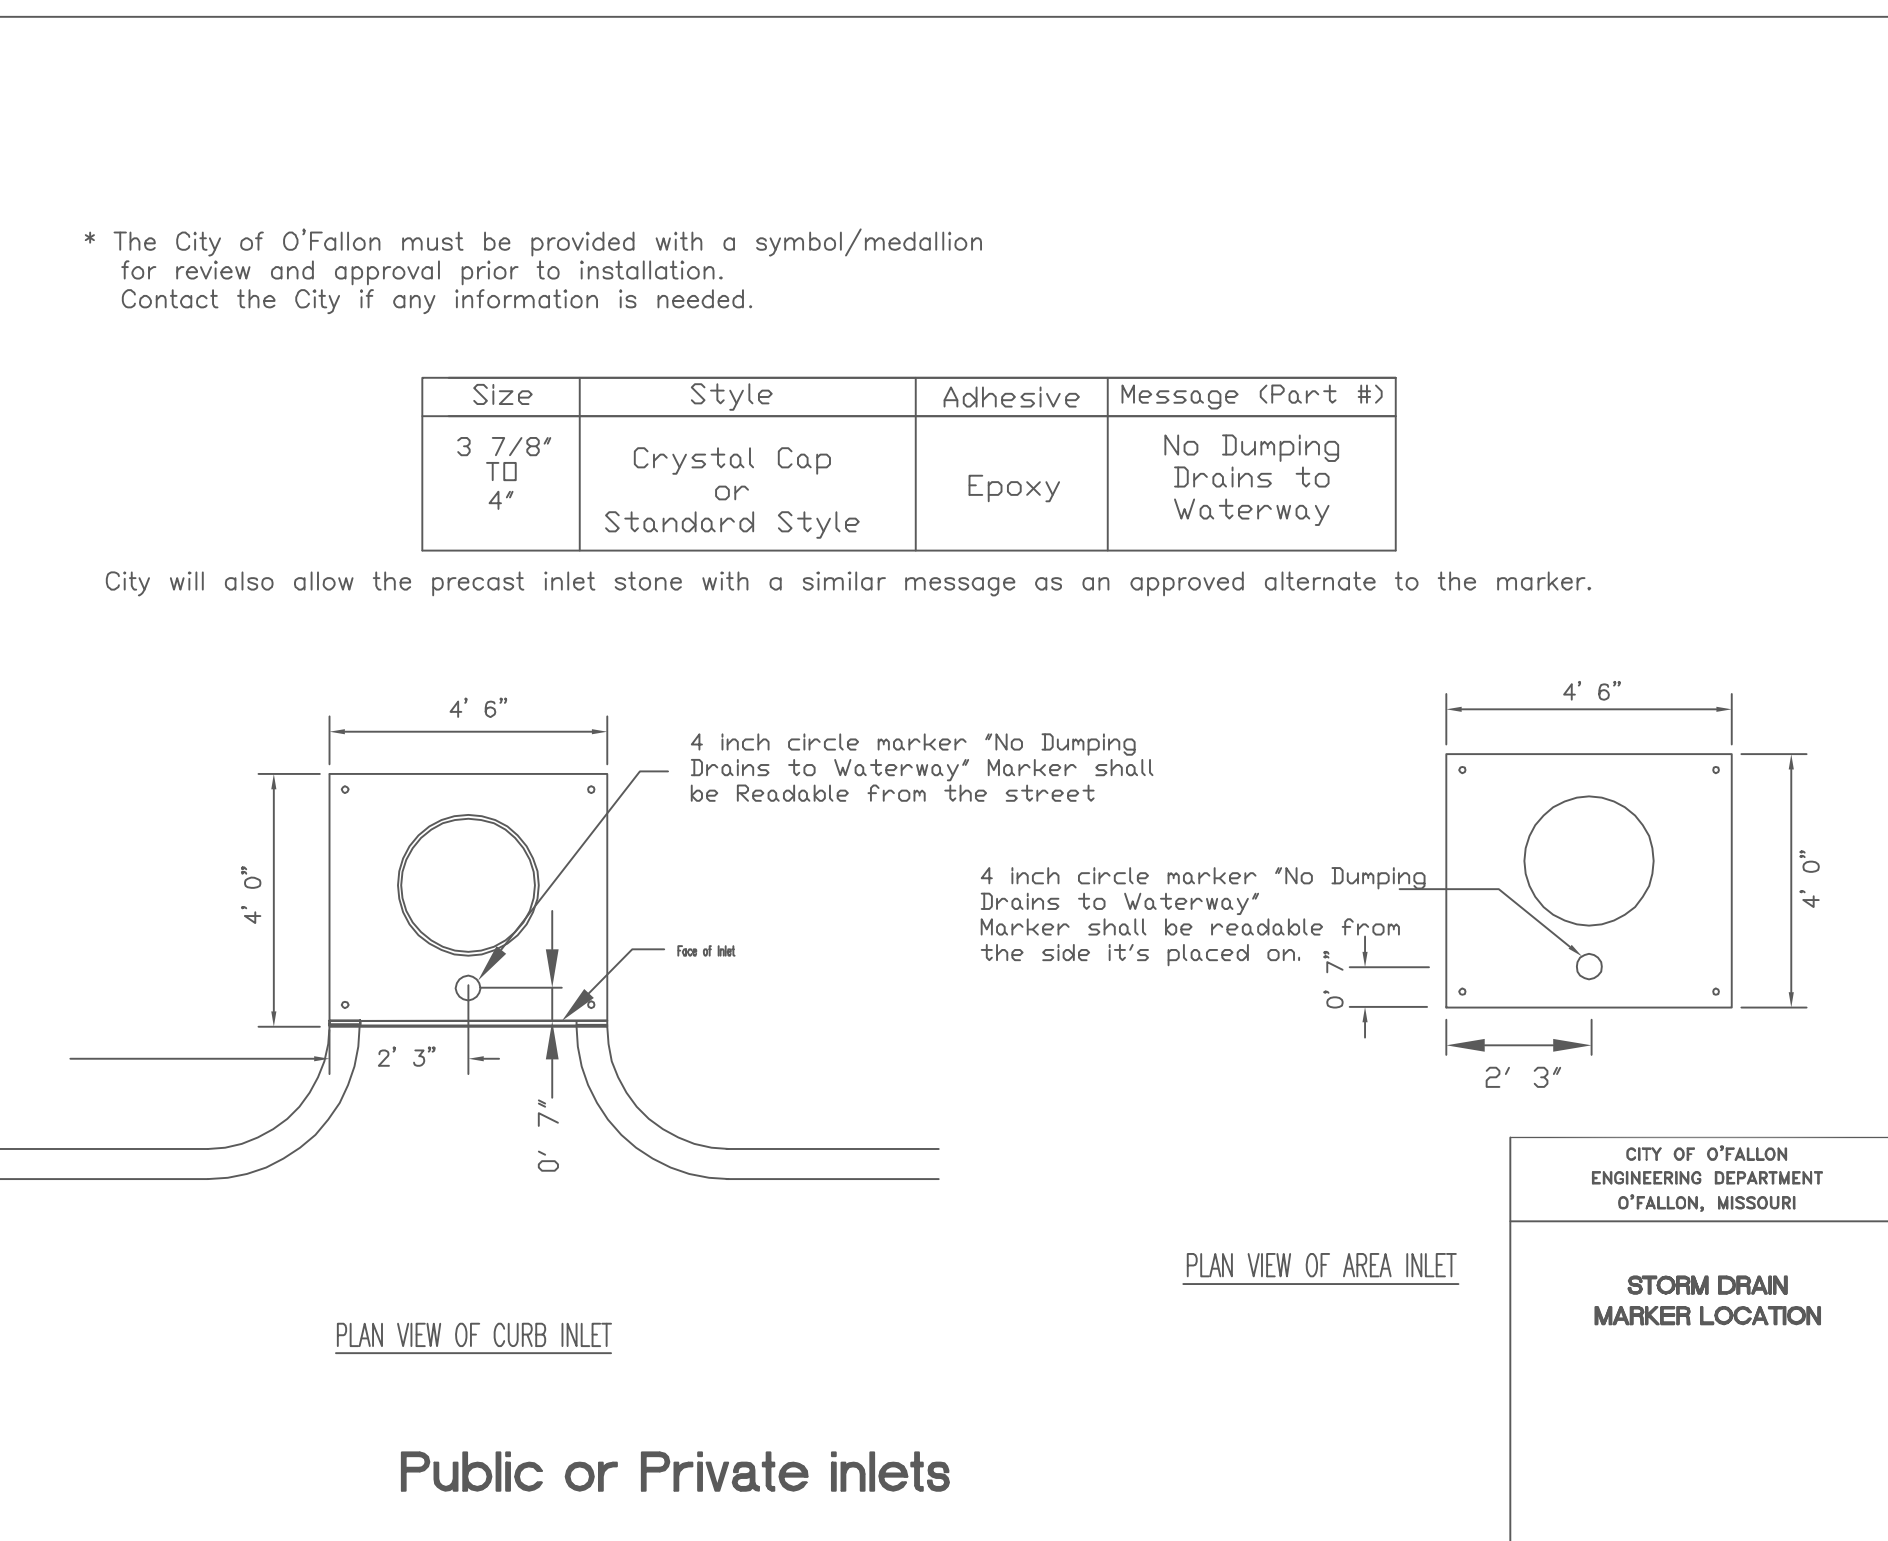

PROJECT TITLE:
TOMMY'S EXPRESS CAR WASH
101 FALLON LOOP RD.
O'FALLON MISSOURI 63368

ENGINEERING
PLANNING
SURVEYING
221 Point West Blvd.
St. Charles, MO 63301
636-928-5552
FAX 636-928-1718

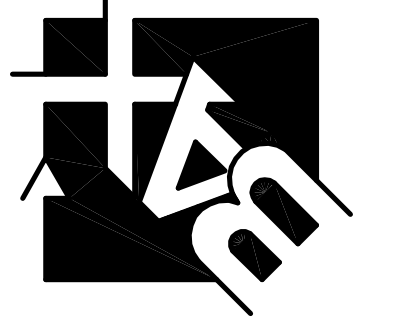

REFERENCE DRAWINGS ONLY, LAND SURVEYORS SEAL DOES NOT APPLY TO THESE DETAILS

REVISIONS

01/04/21	COMMENTS	PER CITY


Developer / Owner:
DOWLING ENTERPRISES LLC - BILL DOWLING
5 BRIDLE LANE
FRONTENAC, MISSOURI 63131
314-614-4294

STORM AND SANITARY DETAILS

P+Z No. #19-009654
Approval Date: 11-7-19
City No. #


NOTE: THIS DETAIL IS FROM PWS#2

Buffalo box is an acceptable product to use. Tyler 562-S and 564-S are acceptable products.

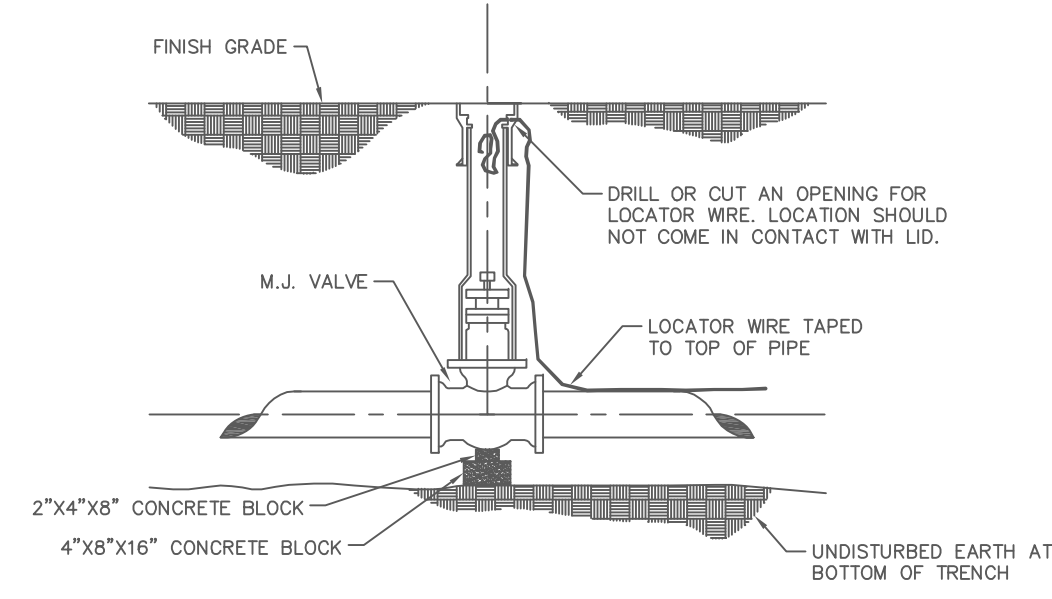

GATE VALVE DETAIL
NOT TO SCALE
DETAIL "D"


NOTE: THIS DETAIL IS FROM PWS#2

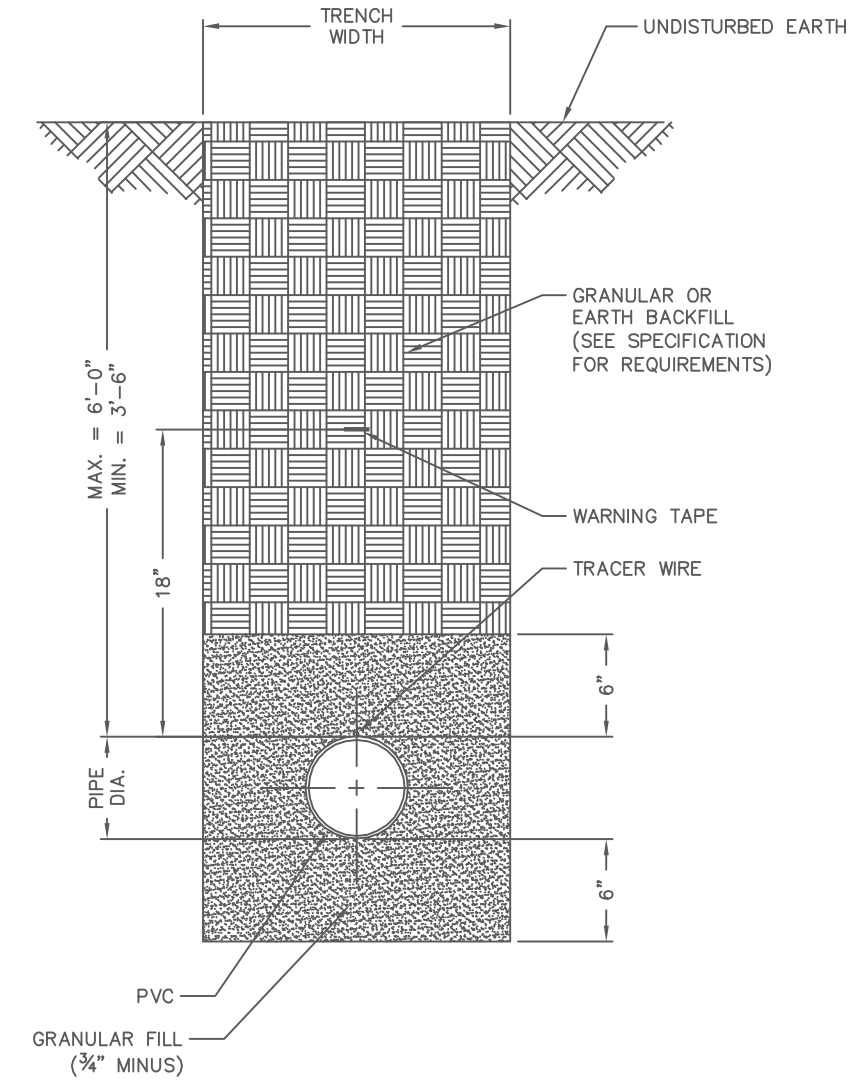

NOTES
1) SEE SPECIFICATIONS FOR ADDITIONAL DETAILS FOR BEDDING AND BACKFILL.


TYPICAL TRENCH SECTION FOR PVC PIPE
NOT TO SCALE
DETAIL "A"
PAGE 1 OF 2

NOTE: THIS DETAIL IS FROM PWS#2

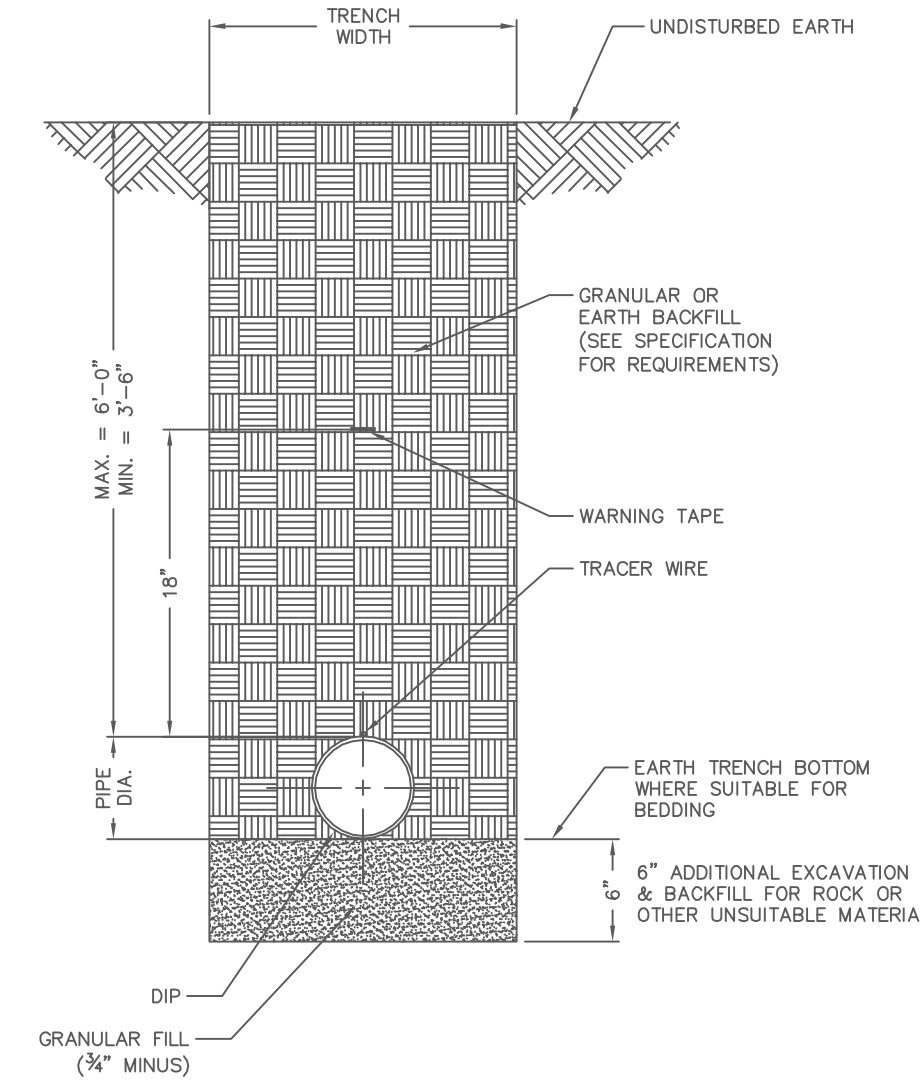

NOTES
1) POLYWRAP REQUIRED FOR DUCTILE IRON PIPE
2) SEE SPECIFICATIONS FOR ADDITIONAL DETAILS FOR BEDDING AND BACKFILL.

TYPICAL TRENCH SECTION FOR DUCTILE IRON PIPE
NOT TO SCALE
DETAIL "A"
PAGE 2 OF 2

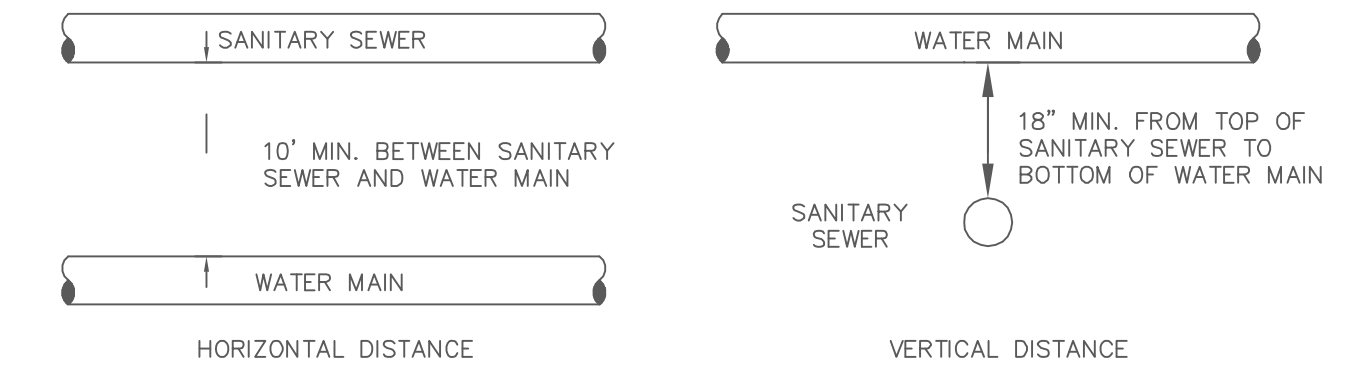

TYPICAL WATER AND SEWER SEPARATION
NOT TO SCALE

CITY OF O'FALLON
ENGINEERING DEPARTMENT
O'FALLON, MISSOURI
WATER AND SEWER SEPARATION DETAIL

Ductile Iron Pipe installation shall follow the Ductile Iron Research Association (DIPRA) guide line.
The Installation of PVC Pipe shall follow the Uni-Bell PVC Pipe Association Handbook of PVC Design and Construction.

PROJECT TITLE:
TOMMY'S EXPRESS CAR WASH
101 FALLON LOOP RD.
O'FALLON MISSOURI 63368

ENGINEERING
PLANNING
SURVEYING
221 Point View Blvd.
St. Charles, MO 63301
636-928-5552
FAX 928-1718



REFERENCE DRAWINGS ONLY, LAND SURVEYORS SEAL DOES NOT APPLY TO THESE DETAILS

REVISIONS

01/04/21	COMMENTS PER CITY


Developer / Owner:
DOWLING ENTERPRISES LLC - BILL DOWLING
5 BRIDLE LANE
FRONTENAC, MISSOURI 63181
314-614-4294

WATER DETAILS

P+Z No. #19-009654
Approval Date: 11-7-19
City No. #

Page No.
13 of 16


NOTE: THIS DETAIL IS FROM PWS#2

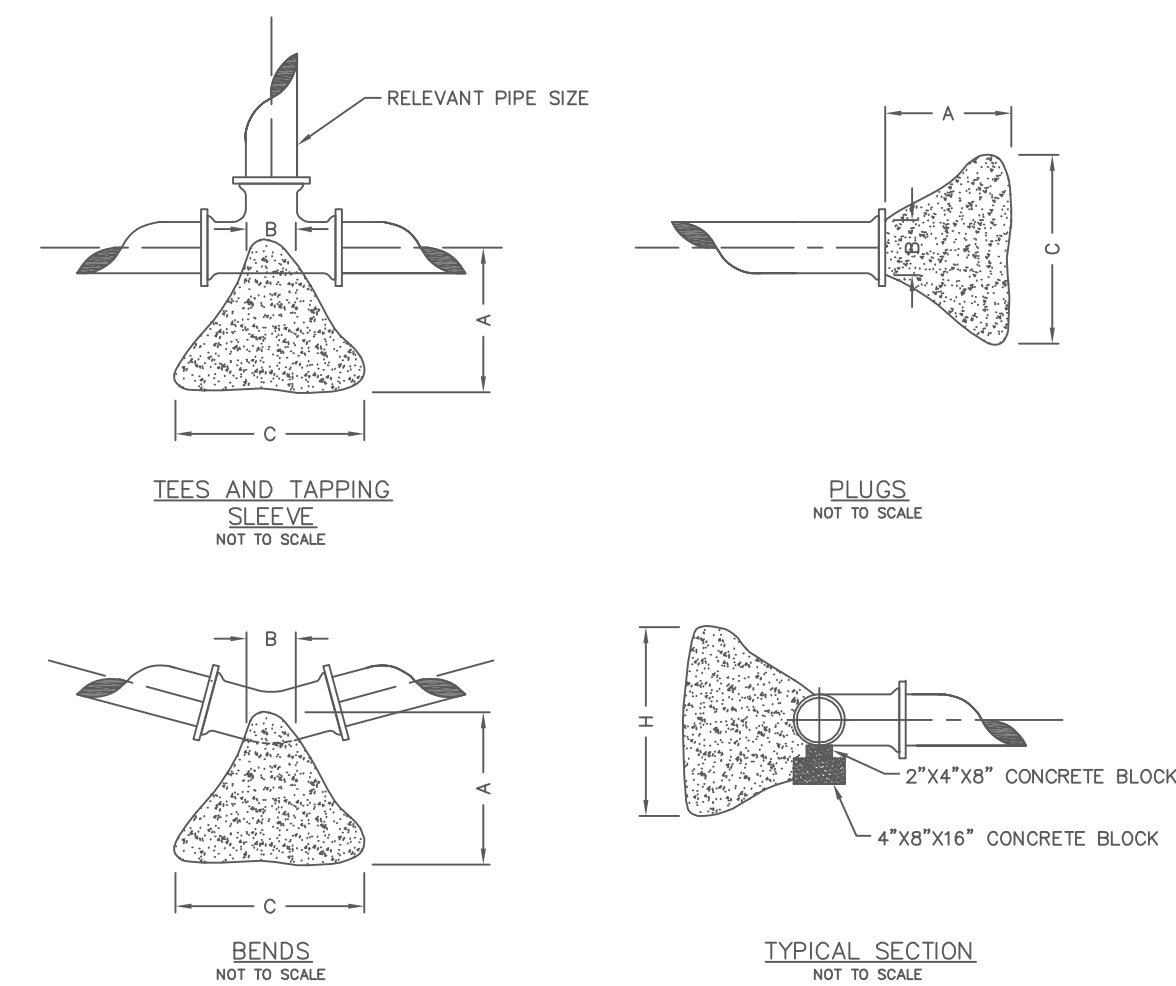

PIPE DIA.	THRUST BLOCK DIMENSIONS - INCHES											
	ALL FTGS.			TEE PLUG TAPPING		90 DEGREE BEND		45 DEGREE BEND		22-1/2 BEND		11-1/4 BEND
	A	B	C	H	C	H	C	H	C	H	C	H
4	14	4	24	12	26	15	18	12	12	12	12	12
6	16	6	36	18	36	24	30	18	24	12	12	12
8	20	8	36	30	42	36	36	24	24	18	18	12
10	20	10	48	36	66	36	36	36	28	24	18	18
12	24	12	68	36	82	42	52	36	40	24	28	18


NOTE
FOR FITTINGS LARGER THAN 12", SPECIAL RESTRAINT DESIGNS ARE REQUIRED.
HORIZONTAL THRUST BLOCKING
DETAIL "C"

NOTE: THIS DETAIL IS FROM PWS#2

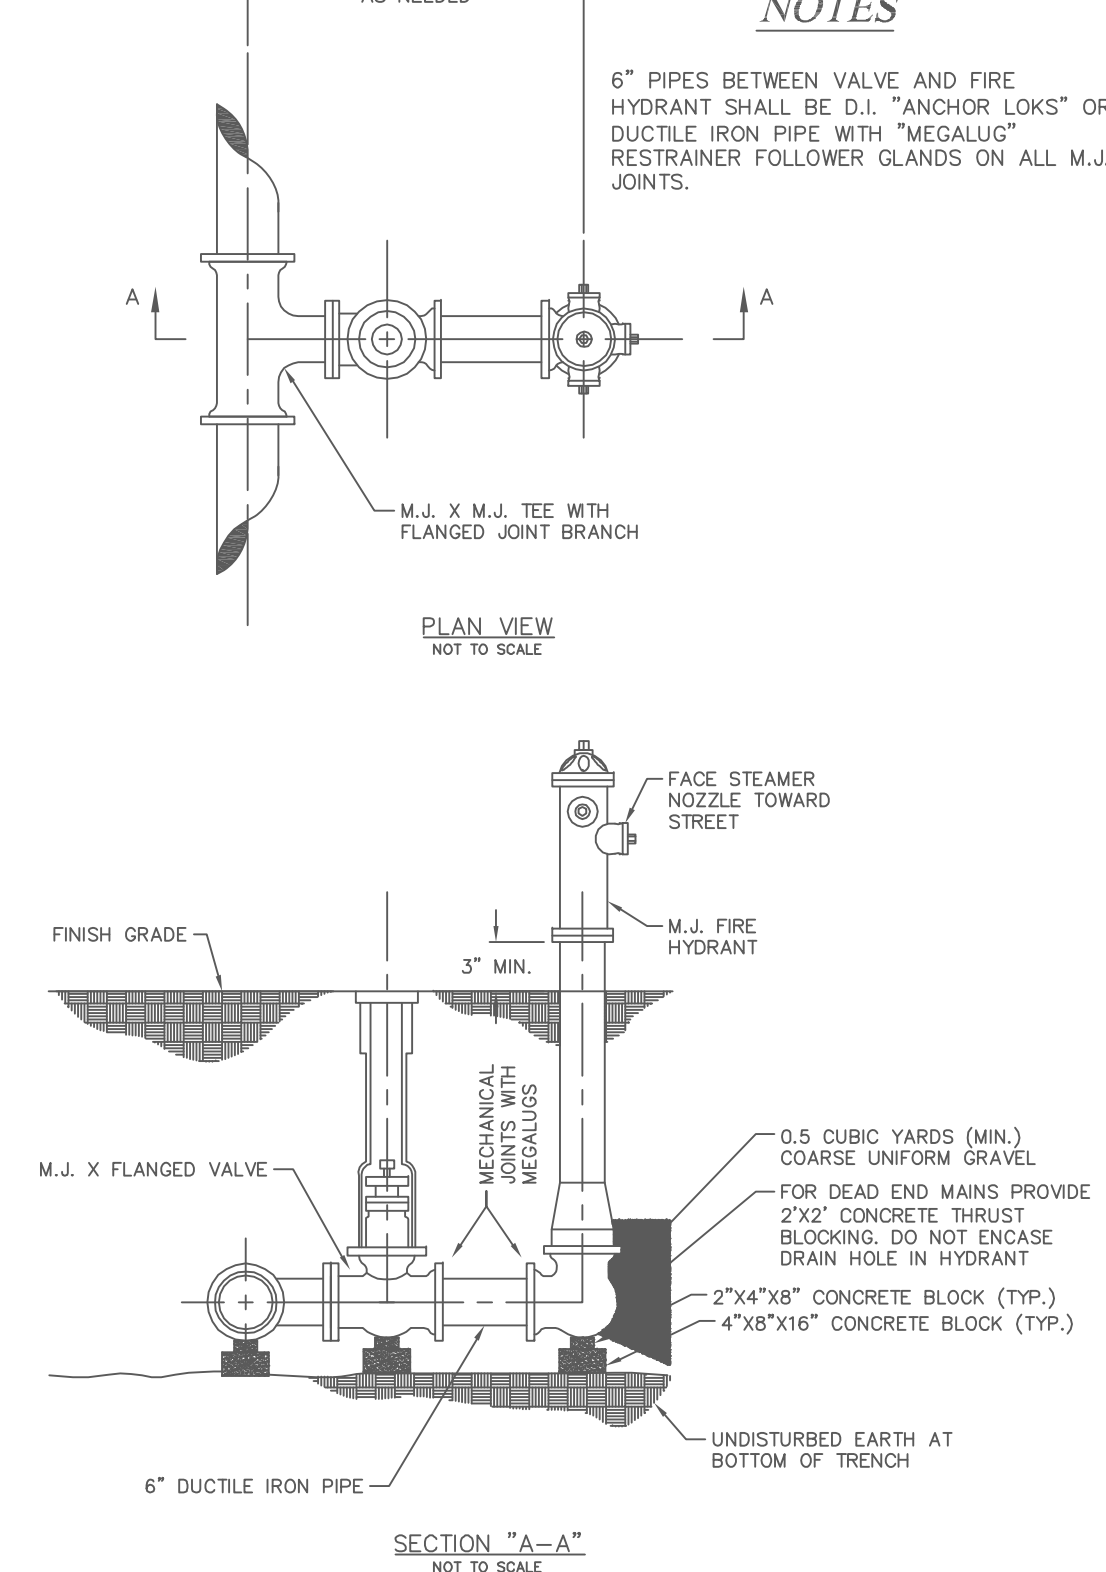


FIRE HYDRANT DETAIL
DETAIL "B"
PAGE 1 OF 3

NOTE: THIS DETAIL IS FROM PWS#2

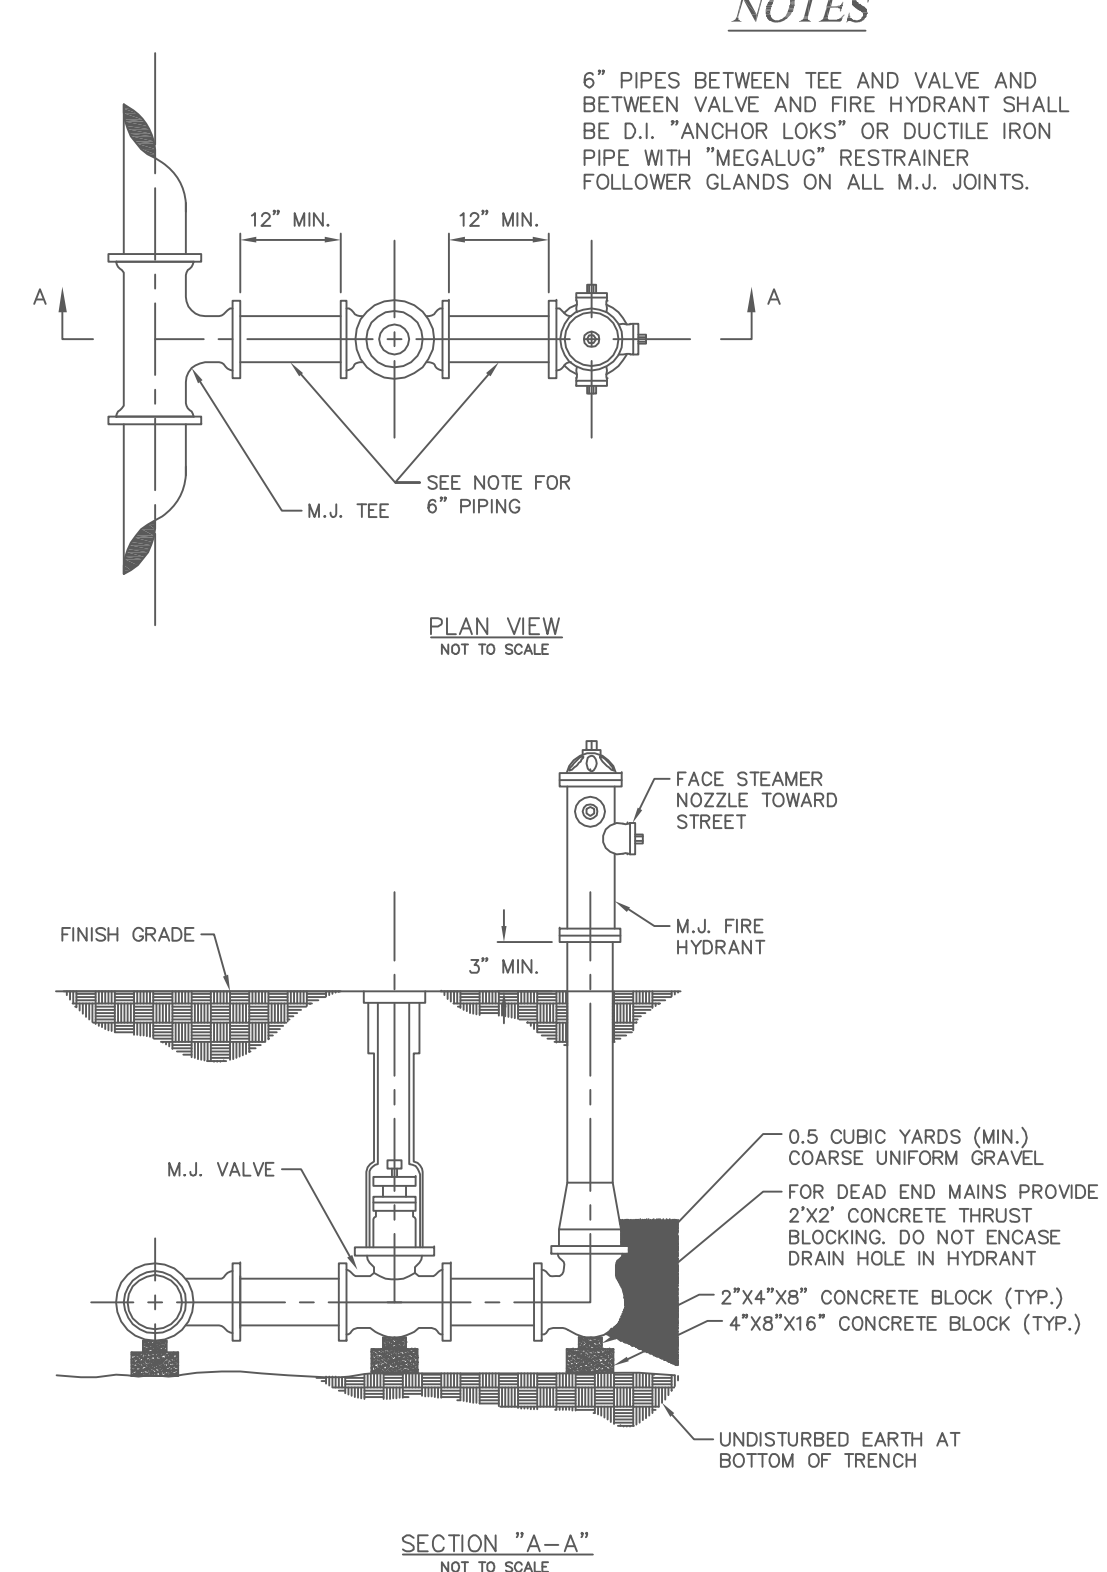

FIRE HYDRANT DETAIL
DETAIL "B"
PAGE 2 OF 3

NOTE: MODIFIED DETAIL FROM PWS#2

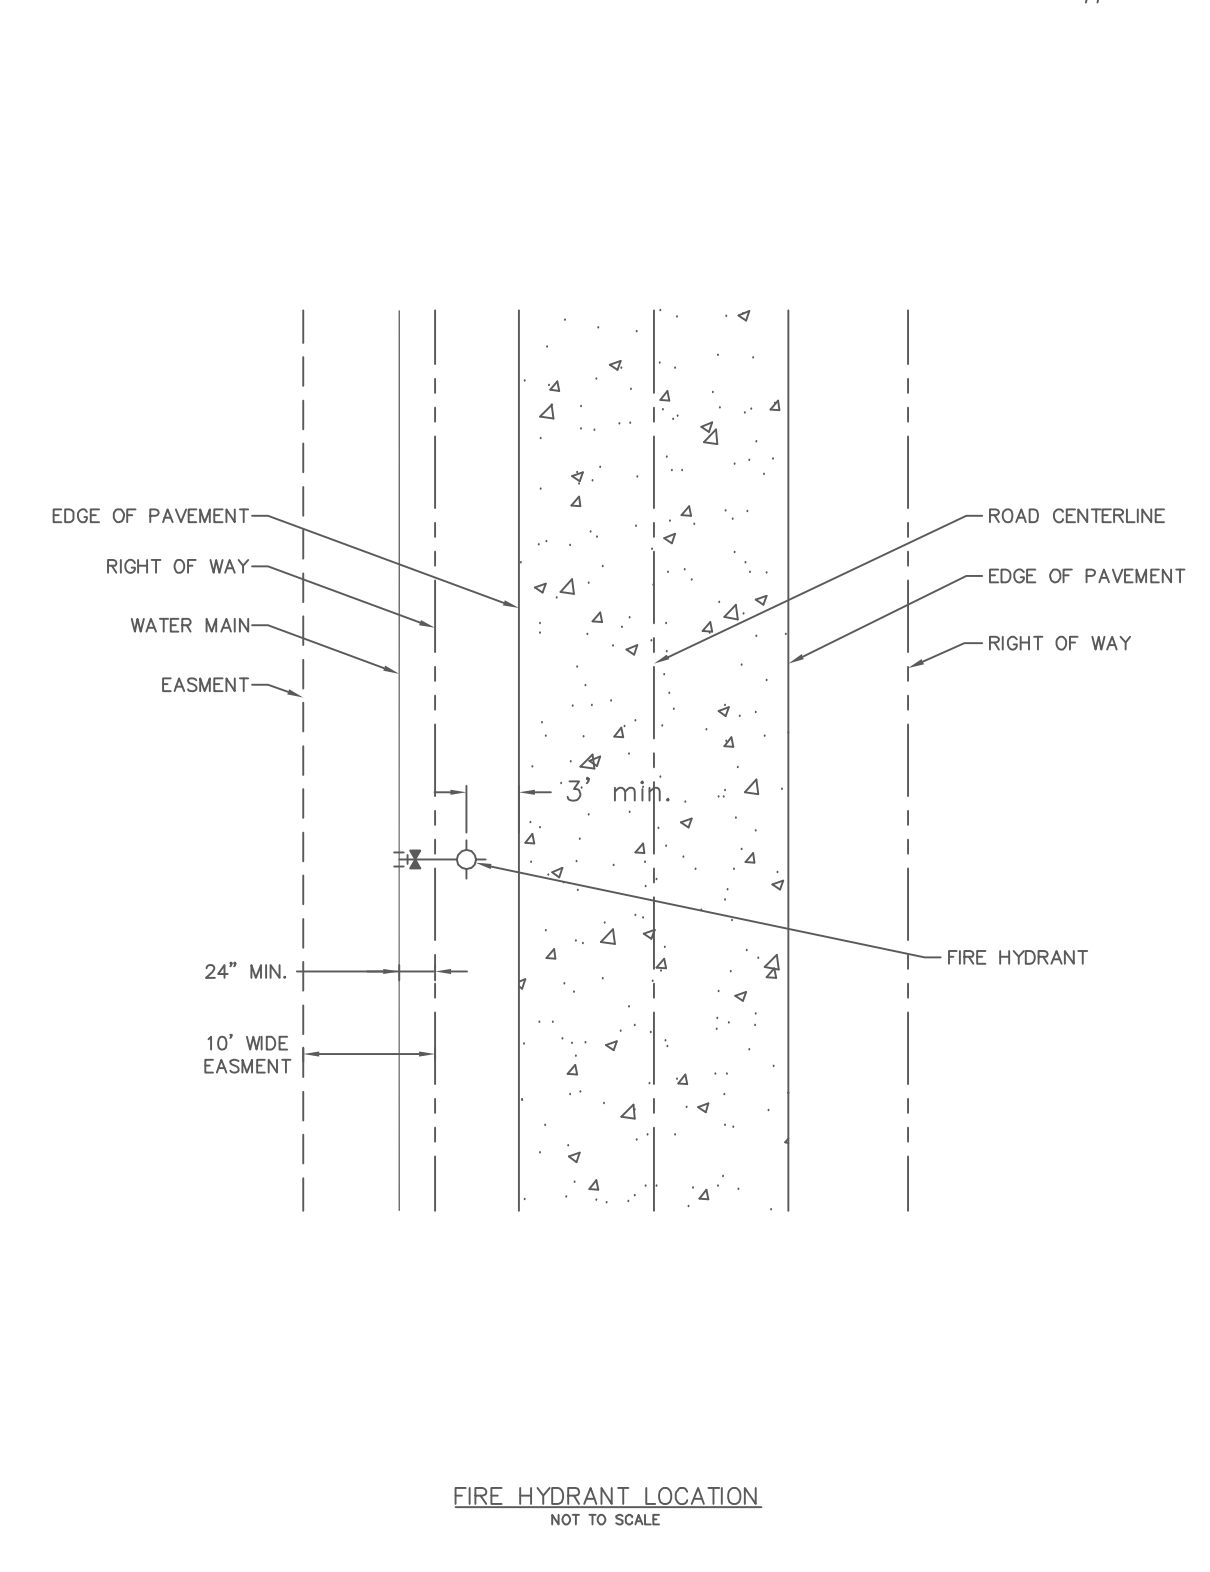

FIRE HYDRANT DETAIL
DETAIL "B"
PAGE 3 OF 3