

CITY OF O'FALLON
GENERAL NOTES


1. Gas, water and other underground utilities shall not conflict with the depth or horizontal location of existing and proposed sanitary and storm sewers including house laterals.
2. Underground utilities have been plotted from available information and therefore their locations must be considered approximate only. The verification of the location of all underground utilities, either shown or not shown on these plans shall be the responsibility of the contractor, and shall be located prior to grading or construction of improvements.
3. Polyvinyl Chloride (PVC) shall conform to the requirements of ASTM D-3034 Standard Specifications for the PSM Polyvinyl Chloride (PVC) Sewer Pipe and Fittings, SDR35.
4. Storm sewers 18" diameter or smaller shall be A.S.T.M. C-14.
5. Storm sewers 21" diameter or larger shall be A.S.T.M. C-76, Class III.
6. All storm sewer pipe under pavement, regardless of size, shall be reinforced concrete pipe (A.S.T.M. C-76, Class III) unless noted otherwise on the plans.
7. Corrugated metal pipe shall conform to the standard specifications for corrugated culvert pipe M-36, A.A.S.H.O. See plans for gauge.
8. All filled places under buildings, under proposed storm and sanitary sewer lines, and trench backfills under paved areas shall be compacted to 90% of maximum density as determined by the "Modified A.A.S.H.O. T-180 Compaction Test" (A.S.T.M. D-1557) unless otherwise specified by local governing authority specifications. All tests shall be verified by a Soils Engineer.
9. All filled places in paved State, County or City roads (Highways) shall be compacted to 90% of maximum density as determined by the "Standard Proctor Test A.A.S.H.O. T-99" (A.S.T.M. D-698) unless otherwise specified by local governing authority specifications. All tests shall be verified by a Soils Engineer.
10. All storm and sanitary trench backfills will be water jetted. Granular backfill will be used under pavement areas.
11. Easements shall be provided for storm sewers, sanitary sewers and all utilities on the record plat. See record plat for location and size of easements. This does not apply to house laterals.
12. No area shall be cleared without permission of the developer.
13. All grade shall be within 0.2 feet more or less of those shown on the grading plan.
14. No slope shall be greater than 3:1 and shall be either sodded or seeded and mulched.
15. Hazard markers will consist of three (3) standard specification "Manual on Uniform Traffic Control Devices", end of roadway markers mounted on two (2) pound "U" channel sign post. Each marker shall consist of an eighteen (18) inch diamond reflectorized red panel. The bottom of each panel shall be mounted a minimum of four (4) feet above the elevation of the pavement surface.
16. All manhole and curb inlet tops built without elevations furnished by the Engineer will be the responsibility of the sewer contractor. At the time of construction stake-out of the sewer lines, all curb and grate inlets will be face staked. If normal face stakes fall in line with sewer construction the Engineer will set these stakes on a double offset. It shall be the responsibility of the sewer contractor to preserve all face stakes from destruction.
17. All standard street curb inlets to have front of inlet 2 feet behind curb.
18. The minimum vertical distance from the low point of the basement to the flowline of a sanitary sewer at the corresponding house connection shall not be less than the diameter of the sanitary sewer plus a vertical distance not less than two and one half feet (2-1/2').
19. Water lines, valves, sleeves, meters and etc. shall meet all specifications and installation requirements of the local governing authority.
20. All cast iron pipe for water mains shall conform to A.W.W.A. specification C-106 and/or C-108. The cast iron fittings shall conform to A.W.W.A. specification C-110. All rubber gasket joints for water cast iron pressure pipe and fittings shall conform to A.W.W.A. specification C-111.
21. All water hydrants and valves shall be cast iron and installed in accordance with plans and details.
22. All sanitary and storm sewers shall meet all specifications and installation requirements of the local governing authority.
23. All PVC water pipe shall have a minimum pressure rating of PR-200 or SDR-21.
24. All PVC sanitary sewer pipe to be DR-35 or equal with crushed stone bedding uniformly graded between 1" and 1/4" size. This bedding shall extend from 6" below the pipe to twelve (12) inches above the top of the pipe.
25. All grading on Missouri State Highway Right-of-Way shall be seeded and mulched and all disturbed Right-of-Way Markers shall be reset at the completion of grading.
26. All streets must meet the specifications and installation requirements of the City of O'Fallon.
27. All sanitary manhole tops shall be set 0.2' higher than the proposed ground except in pavement areas.
28. All sanitary manholes shall have a 31 mil. thick coat of coal tar pitch waterproofing.
29. All sanitary service lines shall be 6" for Multi-family and 4" for Single family developments.
30. Manhole frame and cover shall be Clay and Bailey No. 2008 or Neenah R-1736 or Deeter I-315 or approved equal.
31. A drop of 0.2 feet is required through each sanitary manhole.
32. George Butler Assoc., Inc. shall be notified at least 48 hours prior to construction of sanitary sewers for coordination and inspection.

TOWERWOOD PLACE
Formerly
ST. MARY'S WOODS
Part of the SW 1/4 of the NW 1/4
of Section 21, T. 47 N., R. 3 E.,
St. Charles County, Missouri
IN THE CITY OF O'FALLON

INDEX

SHEET	DESCRIPTION
1	COVER SHEET
2	FLAT PLAN
3	GRADING PLAN
4	STREET PROFILES
5-3	SANITARY SEWER PROFILES
6-4	STORM SEWER PROFILES
7	DRAINAGE AREA MAP
8-10	CONSTRUCTION DETAILS

AS-BUILTS

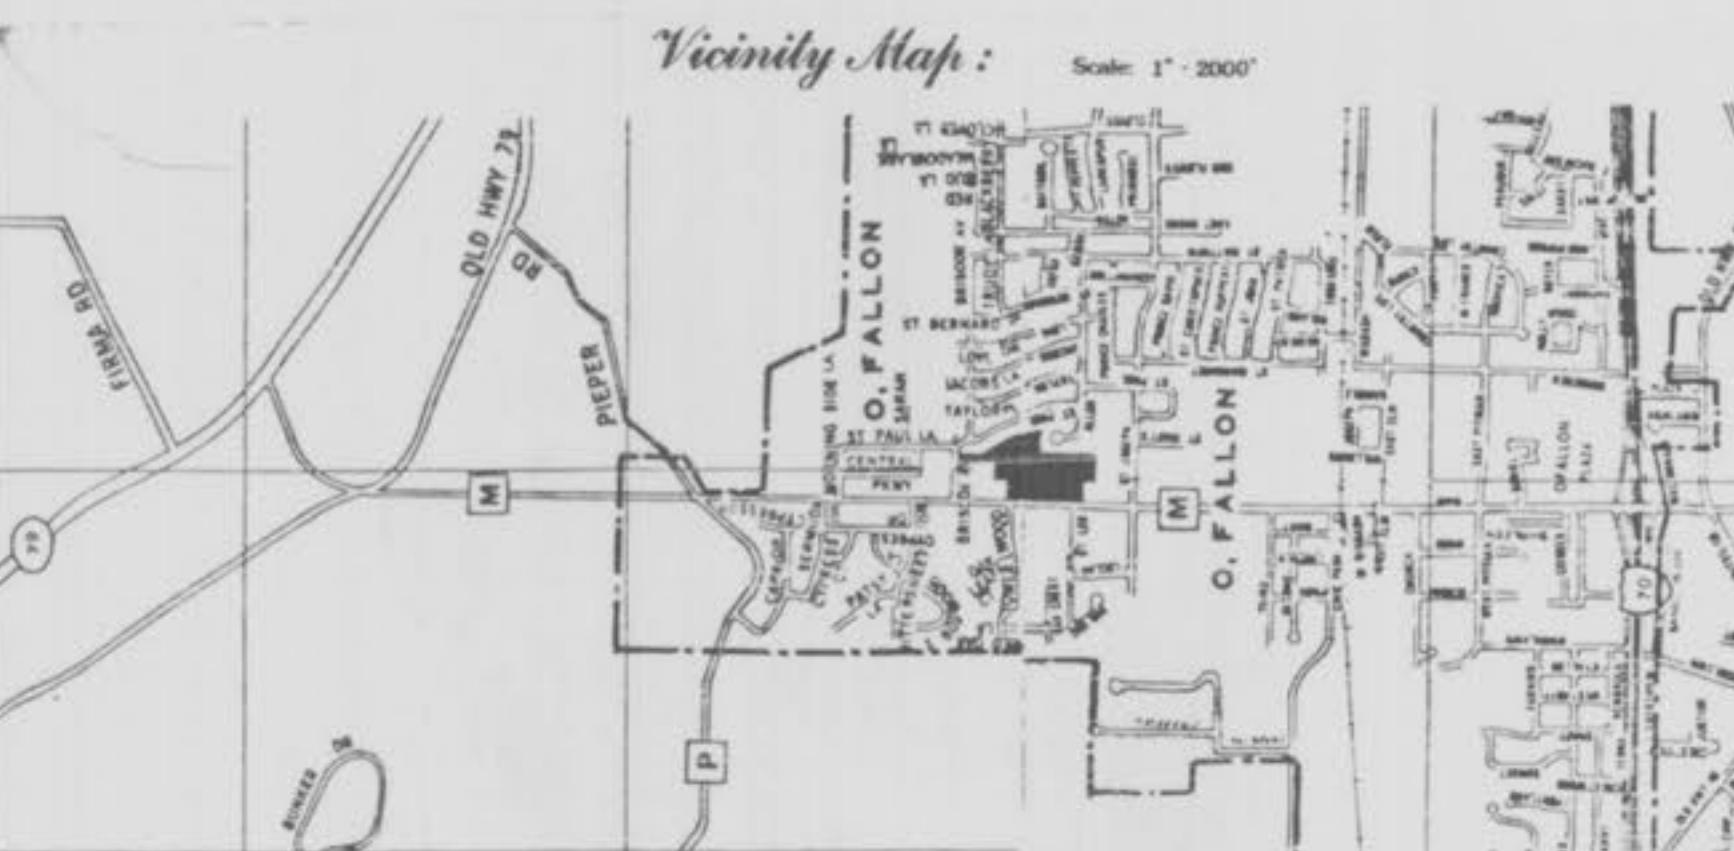

LOCATION MAP



PROJECT BENCHMARK

CENTER OF EAST HEADWALL
OVER BOX CULVERT AT HWY. "M"
U.S.G.S. ELEV. 495.29

LEGEND

C.I.	Curb inlet
D.C.I.	Double Curb Inlet
A.I.	Area Inlet
G.I.	Grate Inlet
M.H.	Manhole
F.E.	Flared end section
E.P.	End pipe
C.P.	Concrete pipe
R.C.P.	Reinforced concrete pipe
C.M.P.	Corrugated metal pipe
C.I.P.	Cast iron pipe
P.V.C.	Polyvinyl chloride pipe
V.C.P.	Vitrified clay pipe
C.O.	Clean out
V.T.	Vent trap
■ →	Storm sewer (proposed)
— →	Sanitary sewer (proposed)
- - 530 -	Existing contour
- - 550 -	Proposed contour
— Street sign —	Street sign
— End of lateral —	End of lateral
Lateral	Lateral
5	Lot or building number
○	Test Hole
— Existing fence line —	Existing fence line
— Existing tree line —	Existing tree line
— Storm sewer (existing) —	Storm sewer (existing)
— Sanitary sewer (existing) —	Sanitary sewer (existing)
— Water line —	Water line
— Tee and valve —	Tee and valve
— Cap —	Cap
— Hydrant —	Hydrant
► Thrust block	Thrust block

PROPERTY OF
CITY OF O'FALLON
BUILDING DEPARTMENT

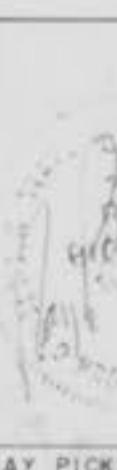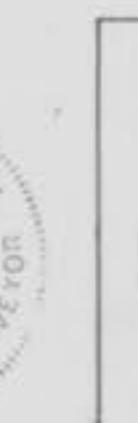

Oct 80 1987	As-Builts	10
RECEIVED	RECORDED	SEARCHED
1988	EX-101	INDEXED
1988	EX-102	FILED
1988	PER CITY OF O'FALLON	
12-17-85	PER CITY OF O'FALLON	
REV:	DATE	DESCRIPTION
		BY CHKD.


Developer/Oncers:
TOM GLOSIER et al.
3 OTIS HENRY DRIVE ST. CHARLES, MO. 63376

DRAWN BY F.Fry DATE Nov 1985
CHECKED BY DATE B4-008
RAY PICKETT, PE-E-14395 ST. PETERS, MO 63376 441-1211

This is to certify that the as-constructed elevations, locations and distances shown hereon are correct and were taken in the field during July, 1987.

Mo. Reg. L.S. #1505


AS-BUILTS Towerwood Place R.P.

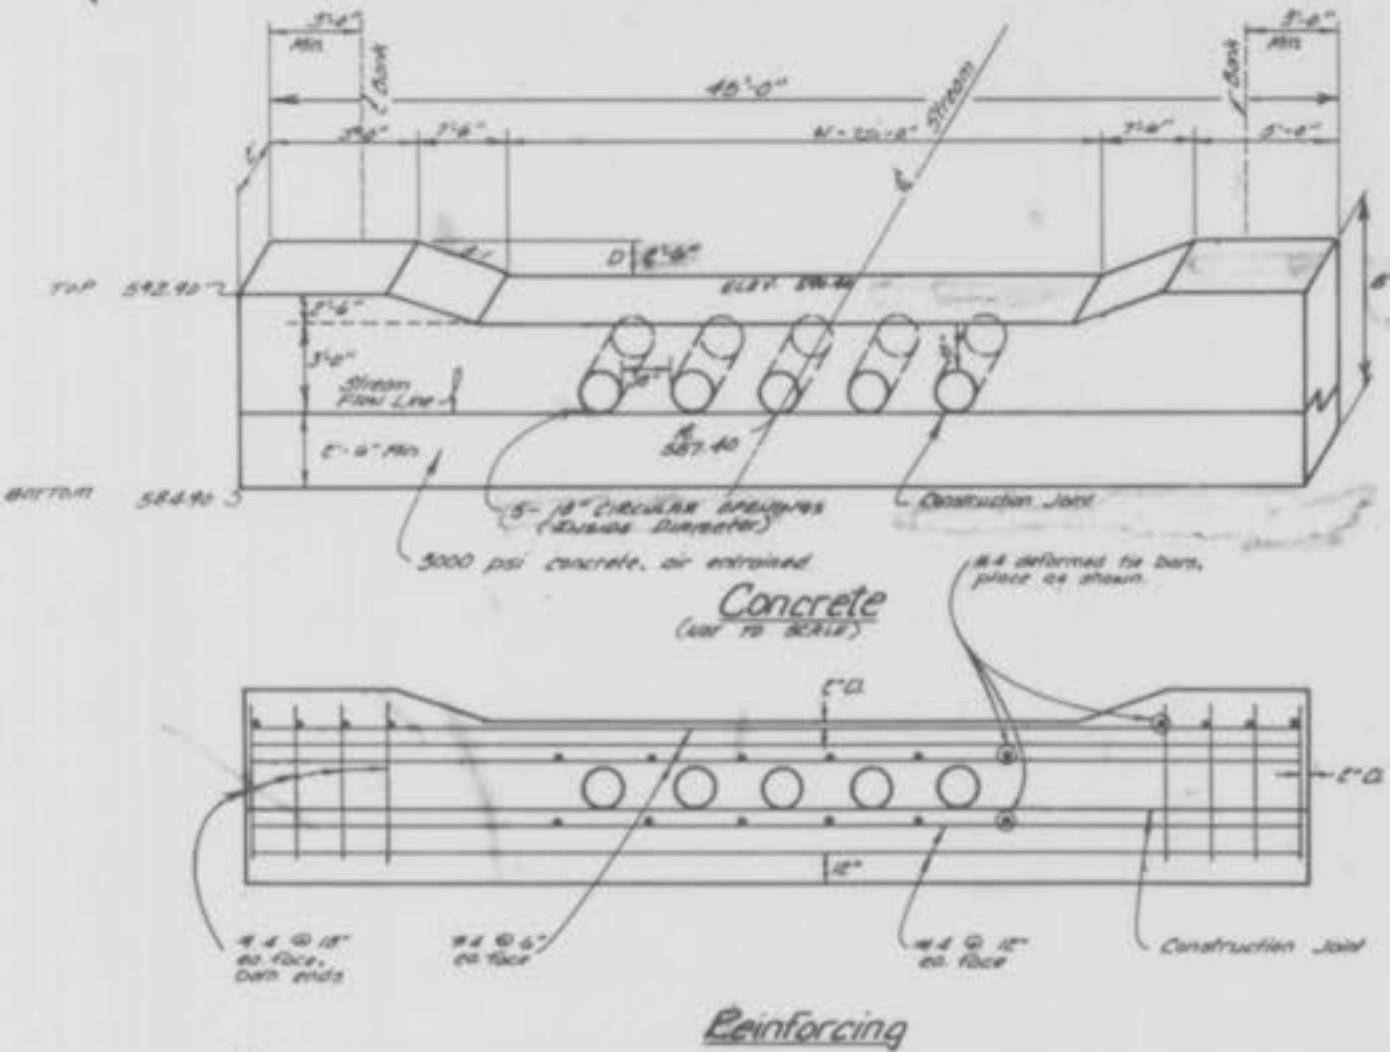


WEIR DETAIL

WEIRD

REVISED 6

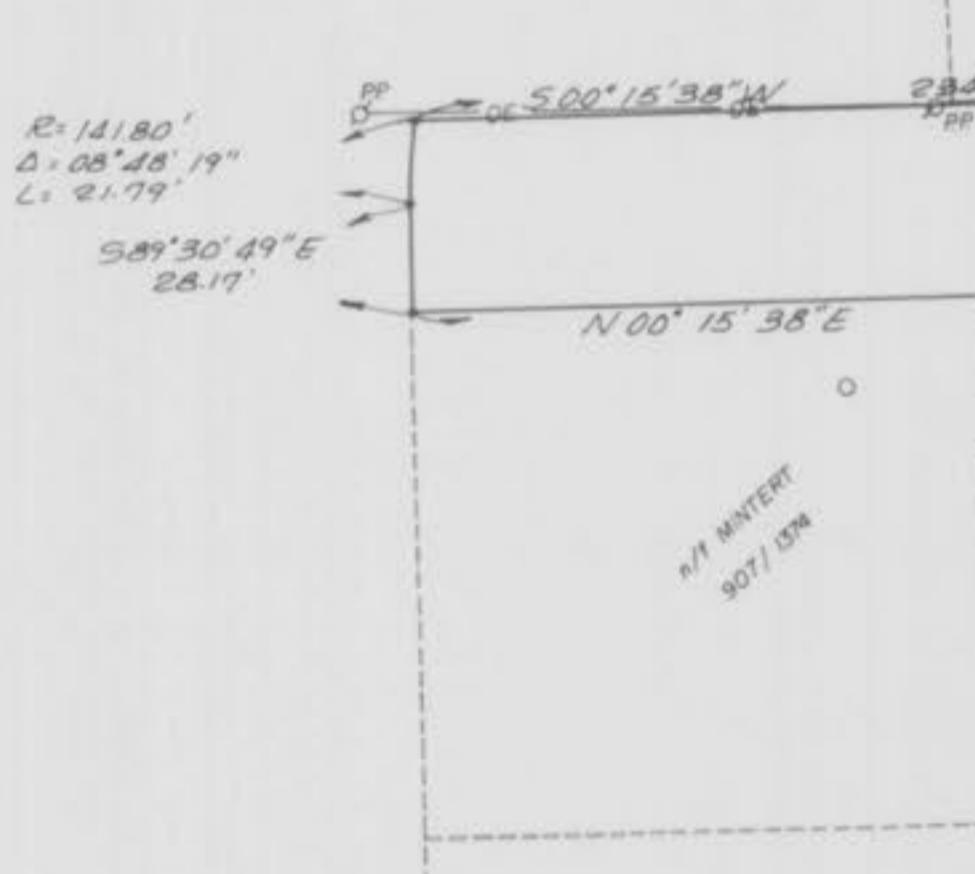

2/4 CONNER, STEWART,
56/1976 99

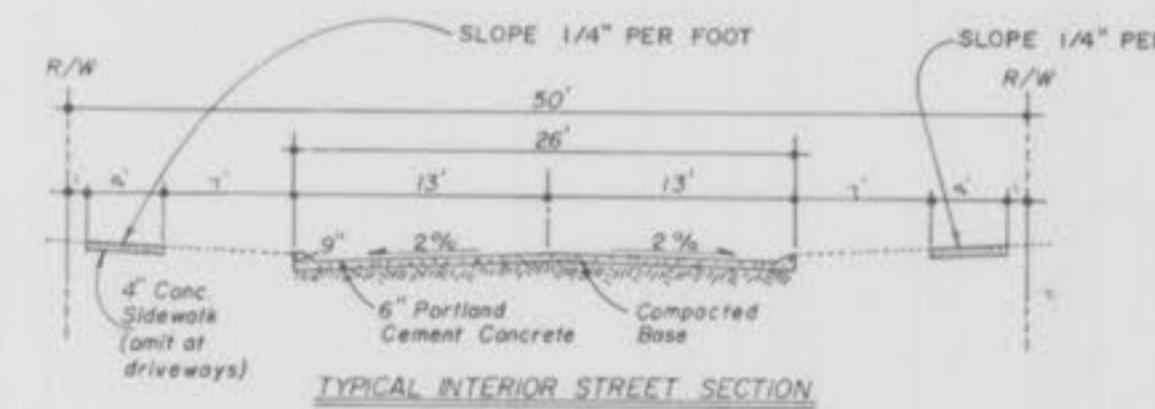


MATERIALS TO BE USED ON STATE RIGHT OF WAY

CONCRETE SURFACE

- 6 Sack Mix
8" Concrete
6 x 6 x 6 Steel Mesh (3" below finished grade)
4" Rolled Stone Base
Integral Concrete Curb (6" Vertical) (5/8" Steel Dowels at 2' C C)

All entrances shall meet the specifications and installation requirements of the City of O'Fallon and the Missouri Highway & Transportation Department.

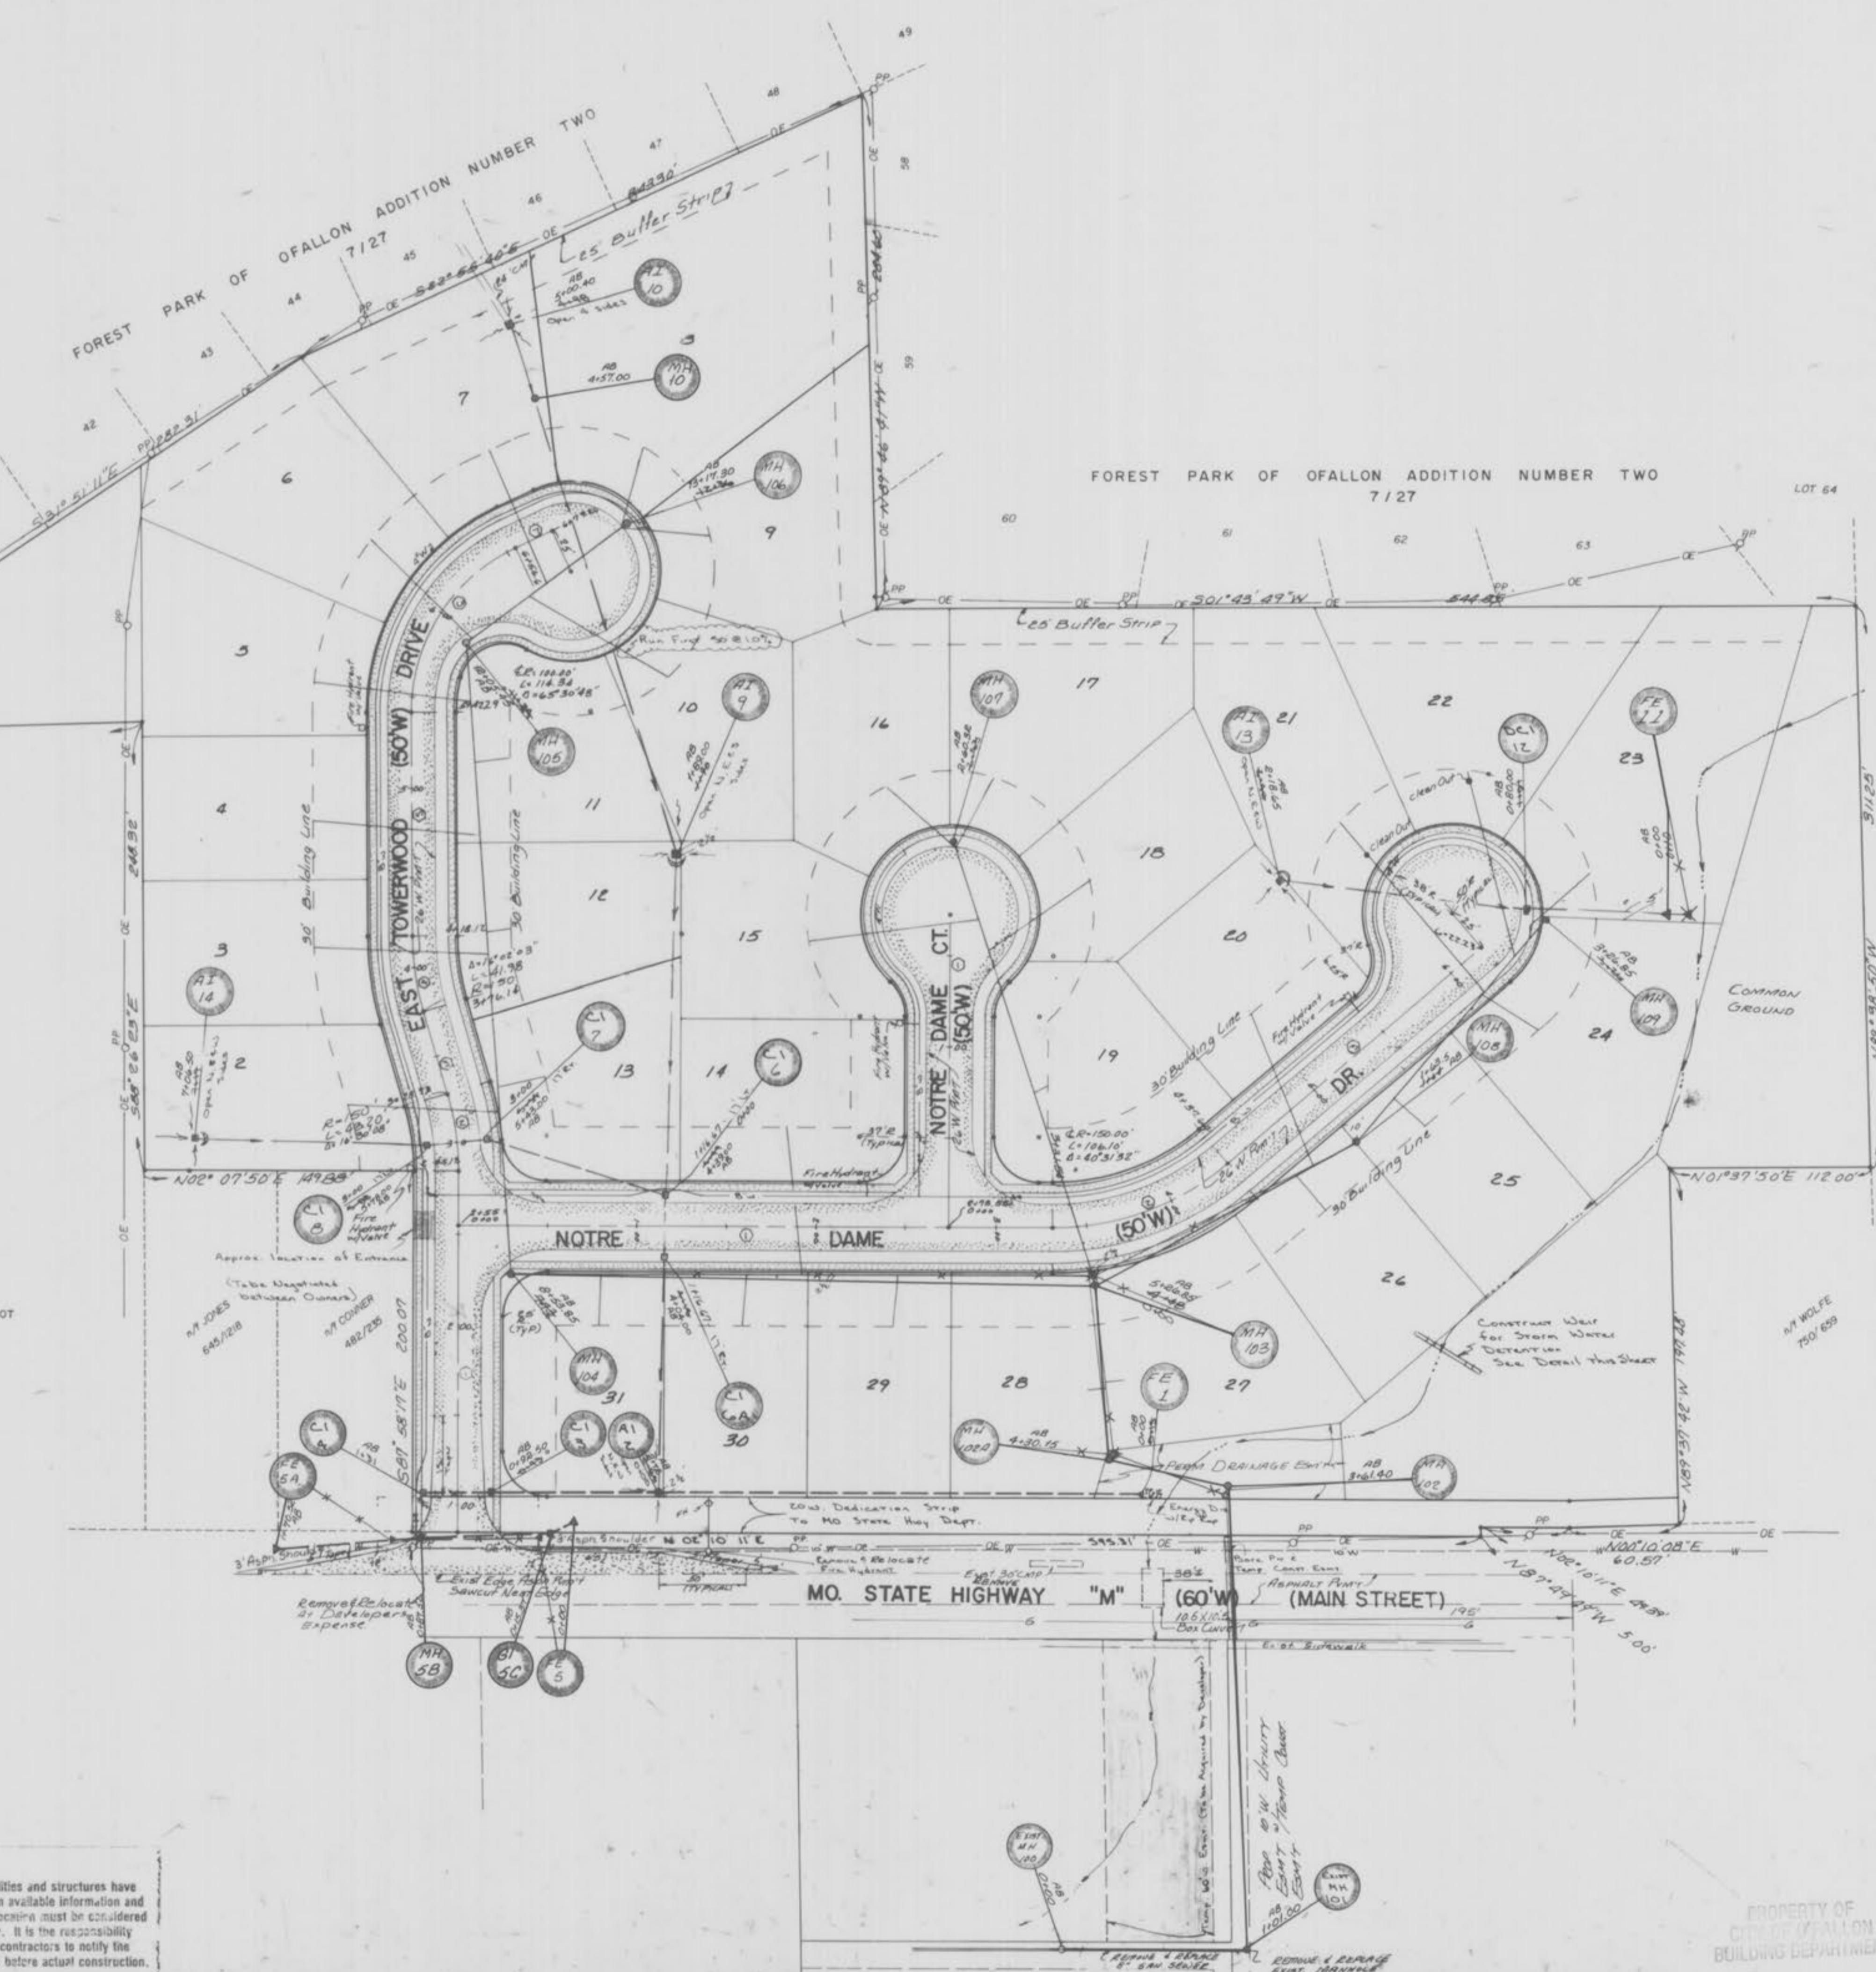

ENTERLINE CURVE DATA

- Notre Dame Drive


- SEARCHED FEB 1 1973 321

oakwood Drive

- | | | | |
|----------|---------------------|---------------------|-------------|
| S | $87^{\circ}58'17''$ | E | L = 200.13° |
| R = 150° | = | $16^{\circ}30'08''$ | L = 43.20° |
| N | $75^{\circ}31'34''$ | E | L = 47.81° |
| R = 150° | = | $16^{\circ}02'03''$ | L = 41.98° |
| S | $88^{\circ}26'23''$ | E | L = 124.17° |
| R = 100° | = | $65^{\circ}30'43''$ | L = 114.34° |
| S | $22^{\circ}55'40''$ | E | L = 22.57° |

AS-BUILTS

Revised Exist. MH 101 - MH 107
Towerwood Place R.D.

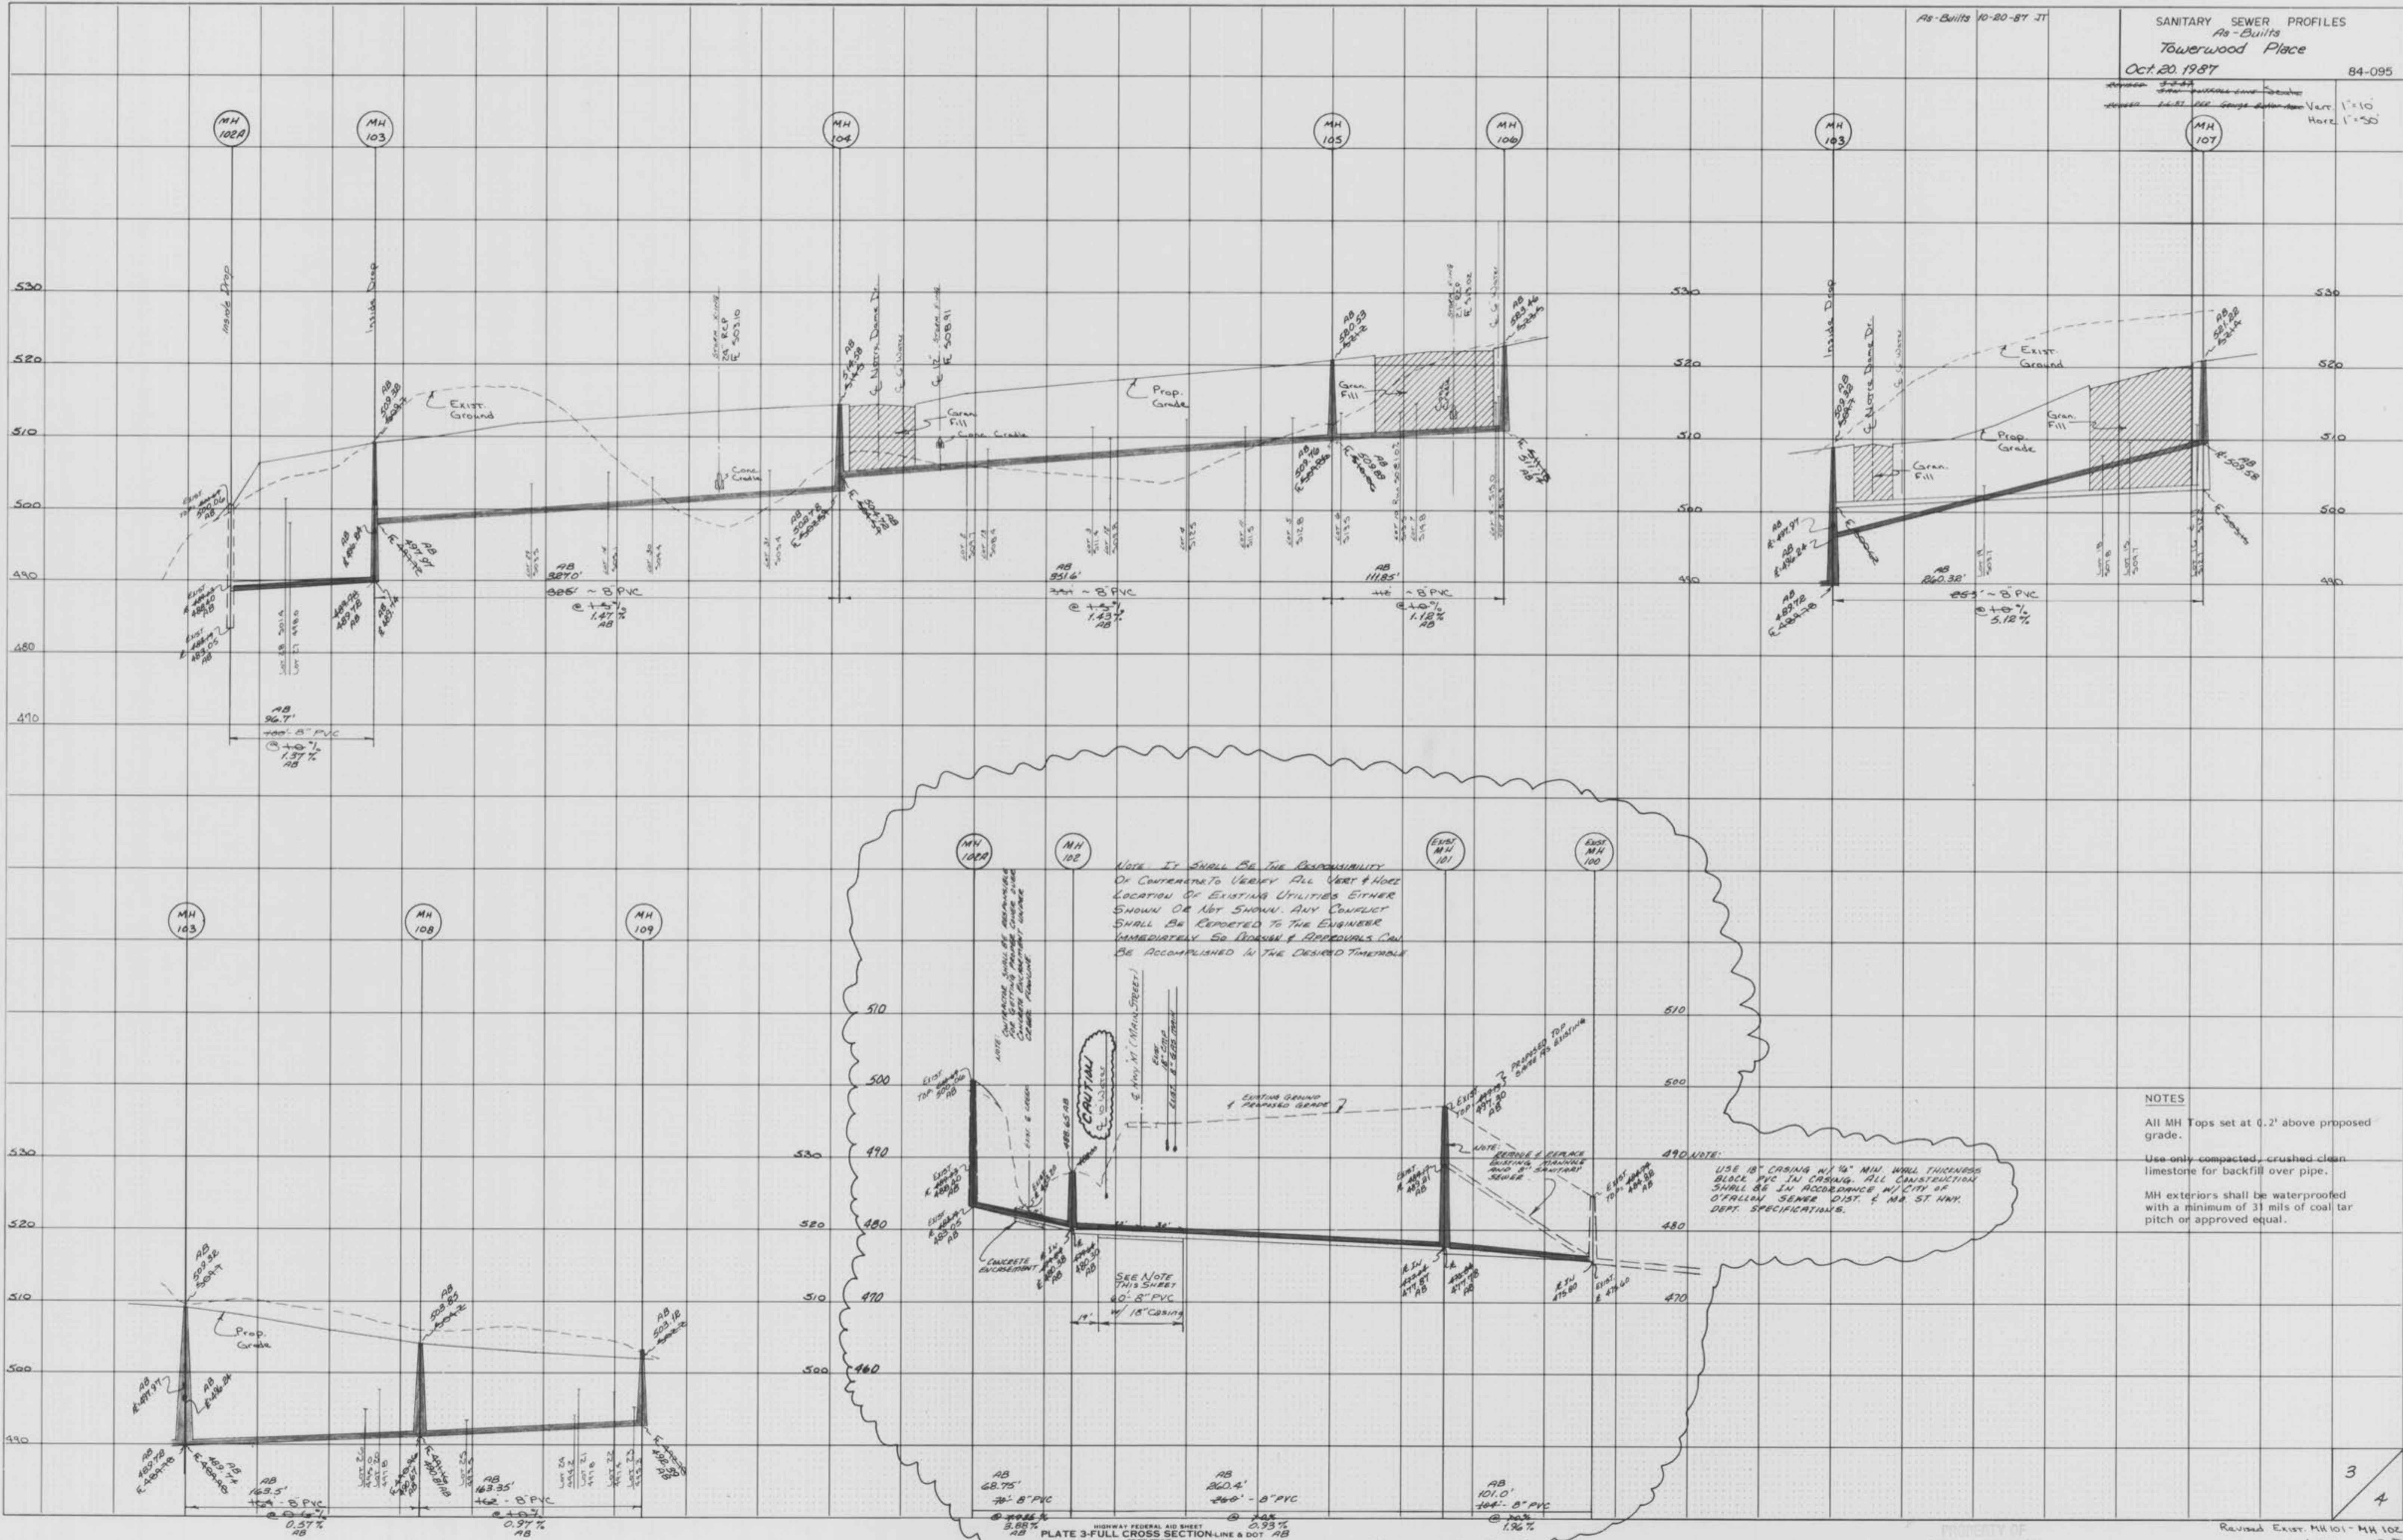

used EXIST. MH 101 - MH 102

STORM SEWER PROFILES
AS-BUILTS
Towerwood Place
Oct 20, 1987

84-095

Scale:
Vert. 1'=10'
Horiz. 1'=50'

AB-BUILTS 10-80-87 JT

FINAL SURVEY	SUBMITTED
BY	DATE
ORIGINAL SURVEY	PLOTTED
NOTE BOOK NO.	TEMPATE AREA CHECKED

ORIGINAL SURVEY	SUBMITTED
BY	DATE
NOTE BOOK NO.	TEMPATE AREA CHECKED

