

**OWNER/DEVELOPER:** O'Fallon True Value Hardware  
513 South Main Street  
O'Fallon, Mo. 63366  
Attn: Mr. Don Schappe & Mr. Fred Pund




**BENCHMARKS:** Chisled on SW cor. sidewalk at South entrance Commerce Bank Elev. 568.77  
Chisled "T" on edge walk South of the SE cor. of building (O'Fallon Health Center) Elev. 571.85



**Curve Data**  
R=100.00'  
Δ=11°00'00"  
L=19.19'

**NOTE:** Existing underground and overhead utilities and drainage structures have been plotted from available information and their locations must be considered approximate only. It is the responsibility of the contractor to notify the utility companies and to verify the locations of existing utilities before actual construction begins. Any discrepancies notes must be reported to the Engineer immediately.

**STRAW BALE DETAIL N.T.S.**  
Siltation Control shall be Bales of Straw placed end to end, counterdrunk, and anchored to ground with 4' long reinforcing rods.  
Note: Siltation control is to be placed in all areas where a potential exists for silt to leave the construction site.  
Note: Straw Bale Erosion Control to be used until vegetation is established.

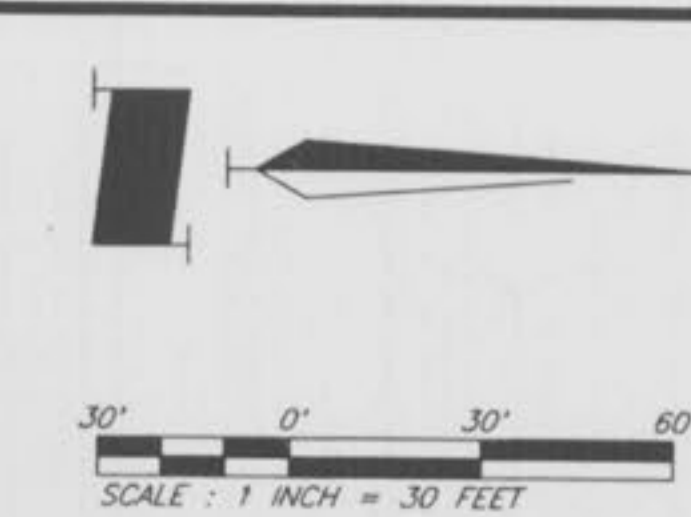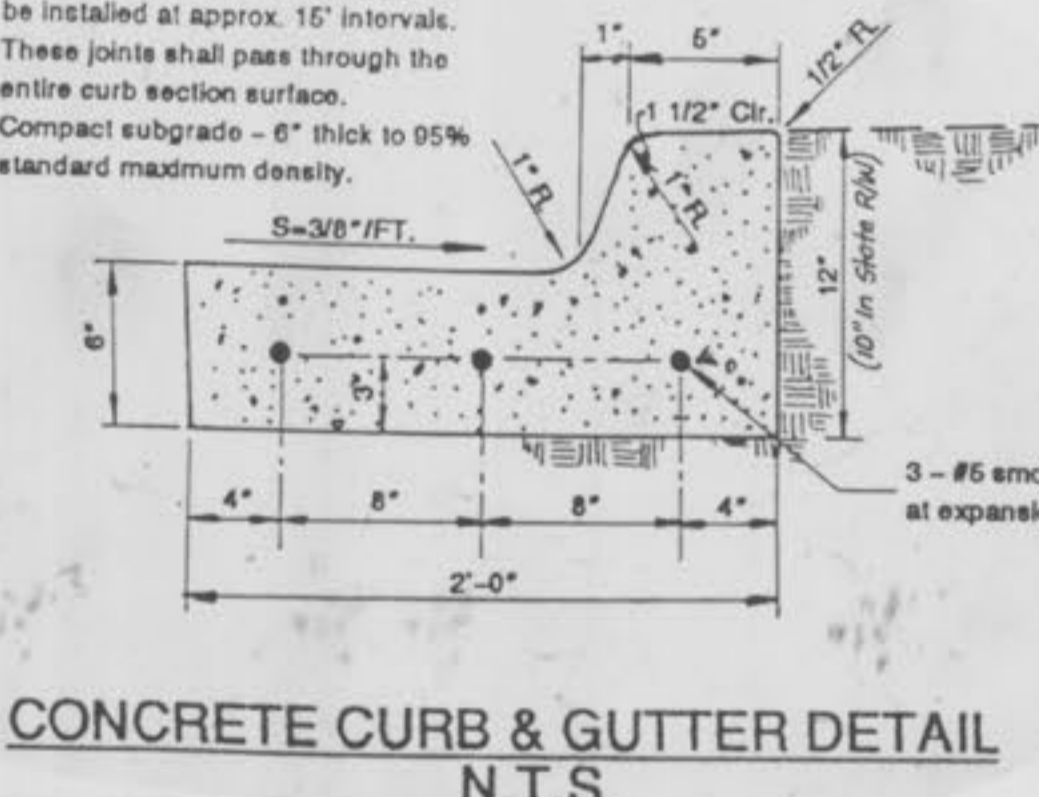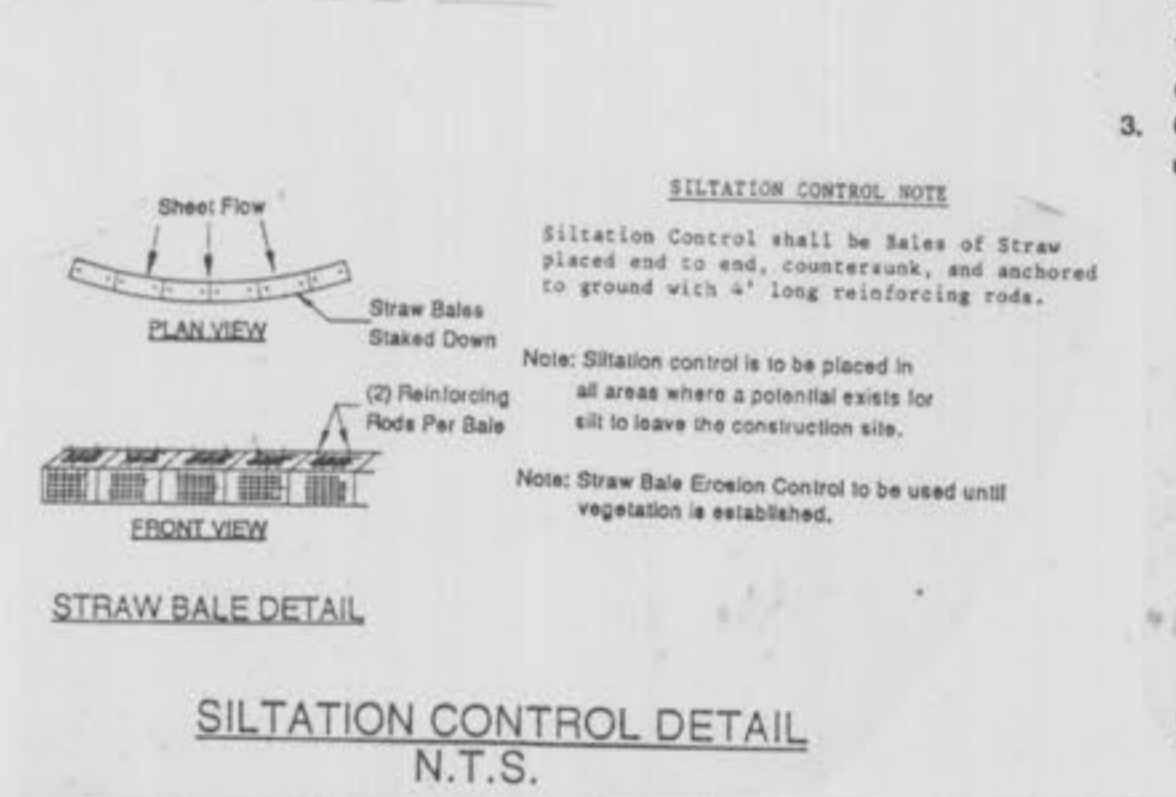

<b>GBA</b> GEORGE BUTLER ASSOCIATES, INC. Engineers / Architects / Landscape Architects / Planners Kansas City, Mo. / Lenexa, Mo. / O'Fallon, Mo. / Anna, Mo. / O'Fallon City, Ill.		DATE: 3/19/92 DESIGN BY: PLL/MCV DRAWN BY: MCV PROJECT NO.: 6491
<b>TRUE VALUE HARDWARE SITE PLAN O'FALLON, MO.</b>		SHEET NO. <b>G1</b> TOTAL SHEETS <b>6</b>
REVISIONS		BY DATE
Revised per MHTD & City of O'Fallon Comments		MCV 4/3/92
Revised per MHTD Comments		MCV 4/22/92
AS-BUILT (DET AREA, STORM, 16" BLOCK WALL, PROPANE PAD)		JG 2/5/93
GENERAL NOTES		4/12/93

- Total area of property = 2.893 Acres
- Present Zoning C-2, General Business
- Temporary Facilities: Light, Power, Water, and Toilet Facilities shall be provided by the General Contractor.
- Protection: Each contractor shall protect his excavations: All excavations shall be kept free of water and lighted barricades shall be maintained.
- Clean-Up: The General Contractor shall remove all debris from site. Tools, equipment, and scaffolding not in active use shall be removed.
- Topsoil, sod, and drible is to be removed from area of new construction. This includes existing concrete foundation and walks.
- Excavate to produce an undisturbed soil bearing surface at required levels. Remove all soft spots in subgrade and fill with compacted granular fill.
- Fill soils shall not contain organic material, vegetation, rubbish, clinders or frozen materials. Horizontal fills may be clay or granular fill. Remove all unacceptable or excess excavated material from site.
- All existing underground utilities and existing that are in remain are to be protected throughout construction.
- Clayey Material: Deposit fill in 8" lifts, broadcast approved lime and mix to secure a uniform moisture content and compaction. After each lift has been spread and sprinkled if required, roll or tamp that lift uniformly over its entire area. Compact clayey fill to not less than 95% of maximum density at optimum moisture as determined by compaction tests.
- Granular Material: Deposit fill in 3" lifts and compact as specified for clayey materials. Pudding of granular material will not be permitted. Compact granular fill to not less than 95% of maximum density as determined by compaction tests.
- All top, flooding and invert elevations shown have been established from the grading plan and/or topographic survey. The General Contractor shall verify all elevations upon grading completion to insure continuity with proposed and existing utilities.
- All construction and materials required shall conform to the City of O'Fallon standards.
- All reinforced concrete pipe to be Class III in unpaved areas. Class III shall be used under pavement.
- All corrugated steel pipe shall be asphalt polymer, or galvanized coated, 16 gauge shall be installed in unpaved areas, 14 gauge under pavement up to 42". 48" and above shall be 14 gauge in unpaved areas and 12 gauge under pavement. Corrugations shall be 2 1/2" x 1/2" up to 32" and 3" x 1" for 48" and above or equivalent for arch pipe.
- All storm and sanitary trench backfills shall be water jetted. Granular fill, compacted will be used under paved areas.
- A 48" tall picket fence shall be constructed along the top of all retaining walls.
- Gas, water and other underground utilities shall not conflict with the depth or horizontal location of existing and proposed sanitary and storm sewers, including laterals.
- All filled places under buildings, proposed sanitary and storm sewer lines, and/or paved areas including trench backfills shall be compacted to 98% of maximum density as determined by the "Modified A.A.S.H.O. 1400 Compaction Test" (ASTM D-1557). All tests will be verified by a Soils Engineer.
- All grade shall be within 0.2 feet (more or less) of those shown on the grading plan.
- No slope shall be greater than 3:1 and shall be either seeded or sodded and mulched.
- All PVC water pipe shall have a minimum pressure rating of PR-200 or 208-21.
- All PVC sanitary sewer pipe shall be SDR-35 or equal with crushed stone bedding uniformly graded between 1" and 1 1/2" size. This bedding shall extend from 6" below the pipe to 12" inches above the top of the pipe.
- Brick shall not be used on manholes.
- The City of O'Fallon shall be notified at least 48 hours prior to construction of sanitary sewers for coordination and inspection.
- All trees to be saved shall be protected during construction. Extreme care shall be taken to prevent soil compaction around the roots of existing trees, and no equipment or materials shall be stored within the dripline of trees to be saved.
- Extreme care shall be taken when excavating near trees to be saved. Root damage shall be kept to a minimum, but when it does occur, roots shall be sawcut.

**NOTES**

- #5 smooth dowels at expansion joints (tangent points on curve radius).
- 1 1/2" deep contraction joints shall be installed at approx. 15' intervals. These joints shall pass through the entire curb section surface.
- Compact subgrade - 8" thick to 95% standard maximum density.

**CONCRETE CURB & GUTTER DETAIL N.T.S.**

HALLOWARE  
TRUE VALUE 15  
AS-BUILTS




GEORGE BUTLER ASSOCIATES, INC.  
Engineers / Architects / Landscape Architects / Planners

PROJECT	SHEET NO.	TOTAL SHEETS
TRUE VALUE HARDWARE STORM SEWERS O'FALLON, MO.	G2	6
PROJECT NO.: 6491	DATE: 3/19/92	

REVISIONS:  
AS-BUILT 2/5/93 J.G.


Scale: 1" = 10' Horizontal  
1" = 10' Vertical

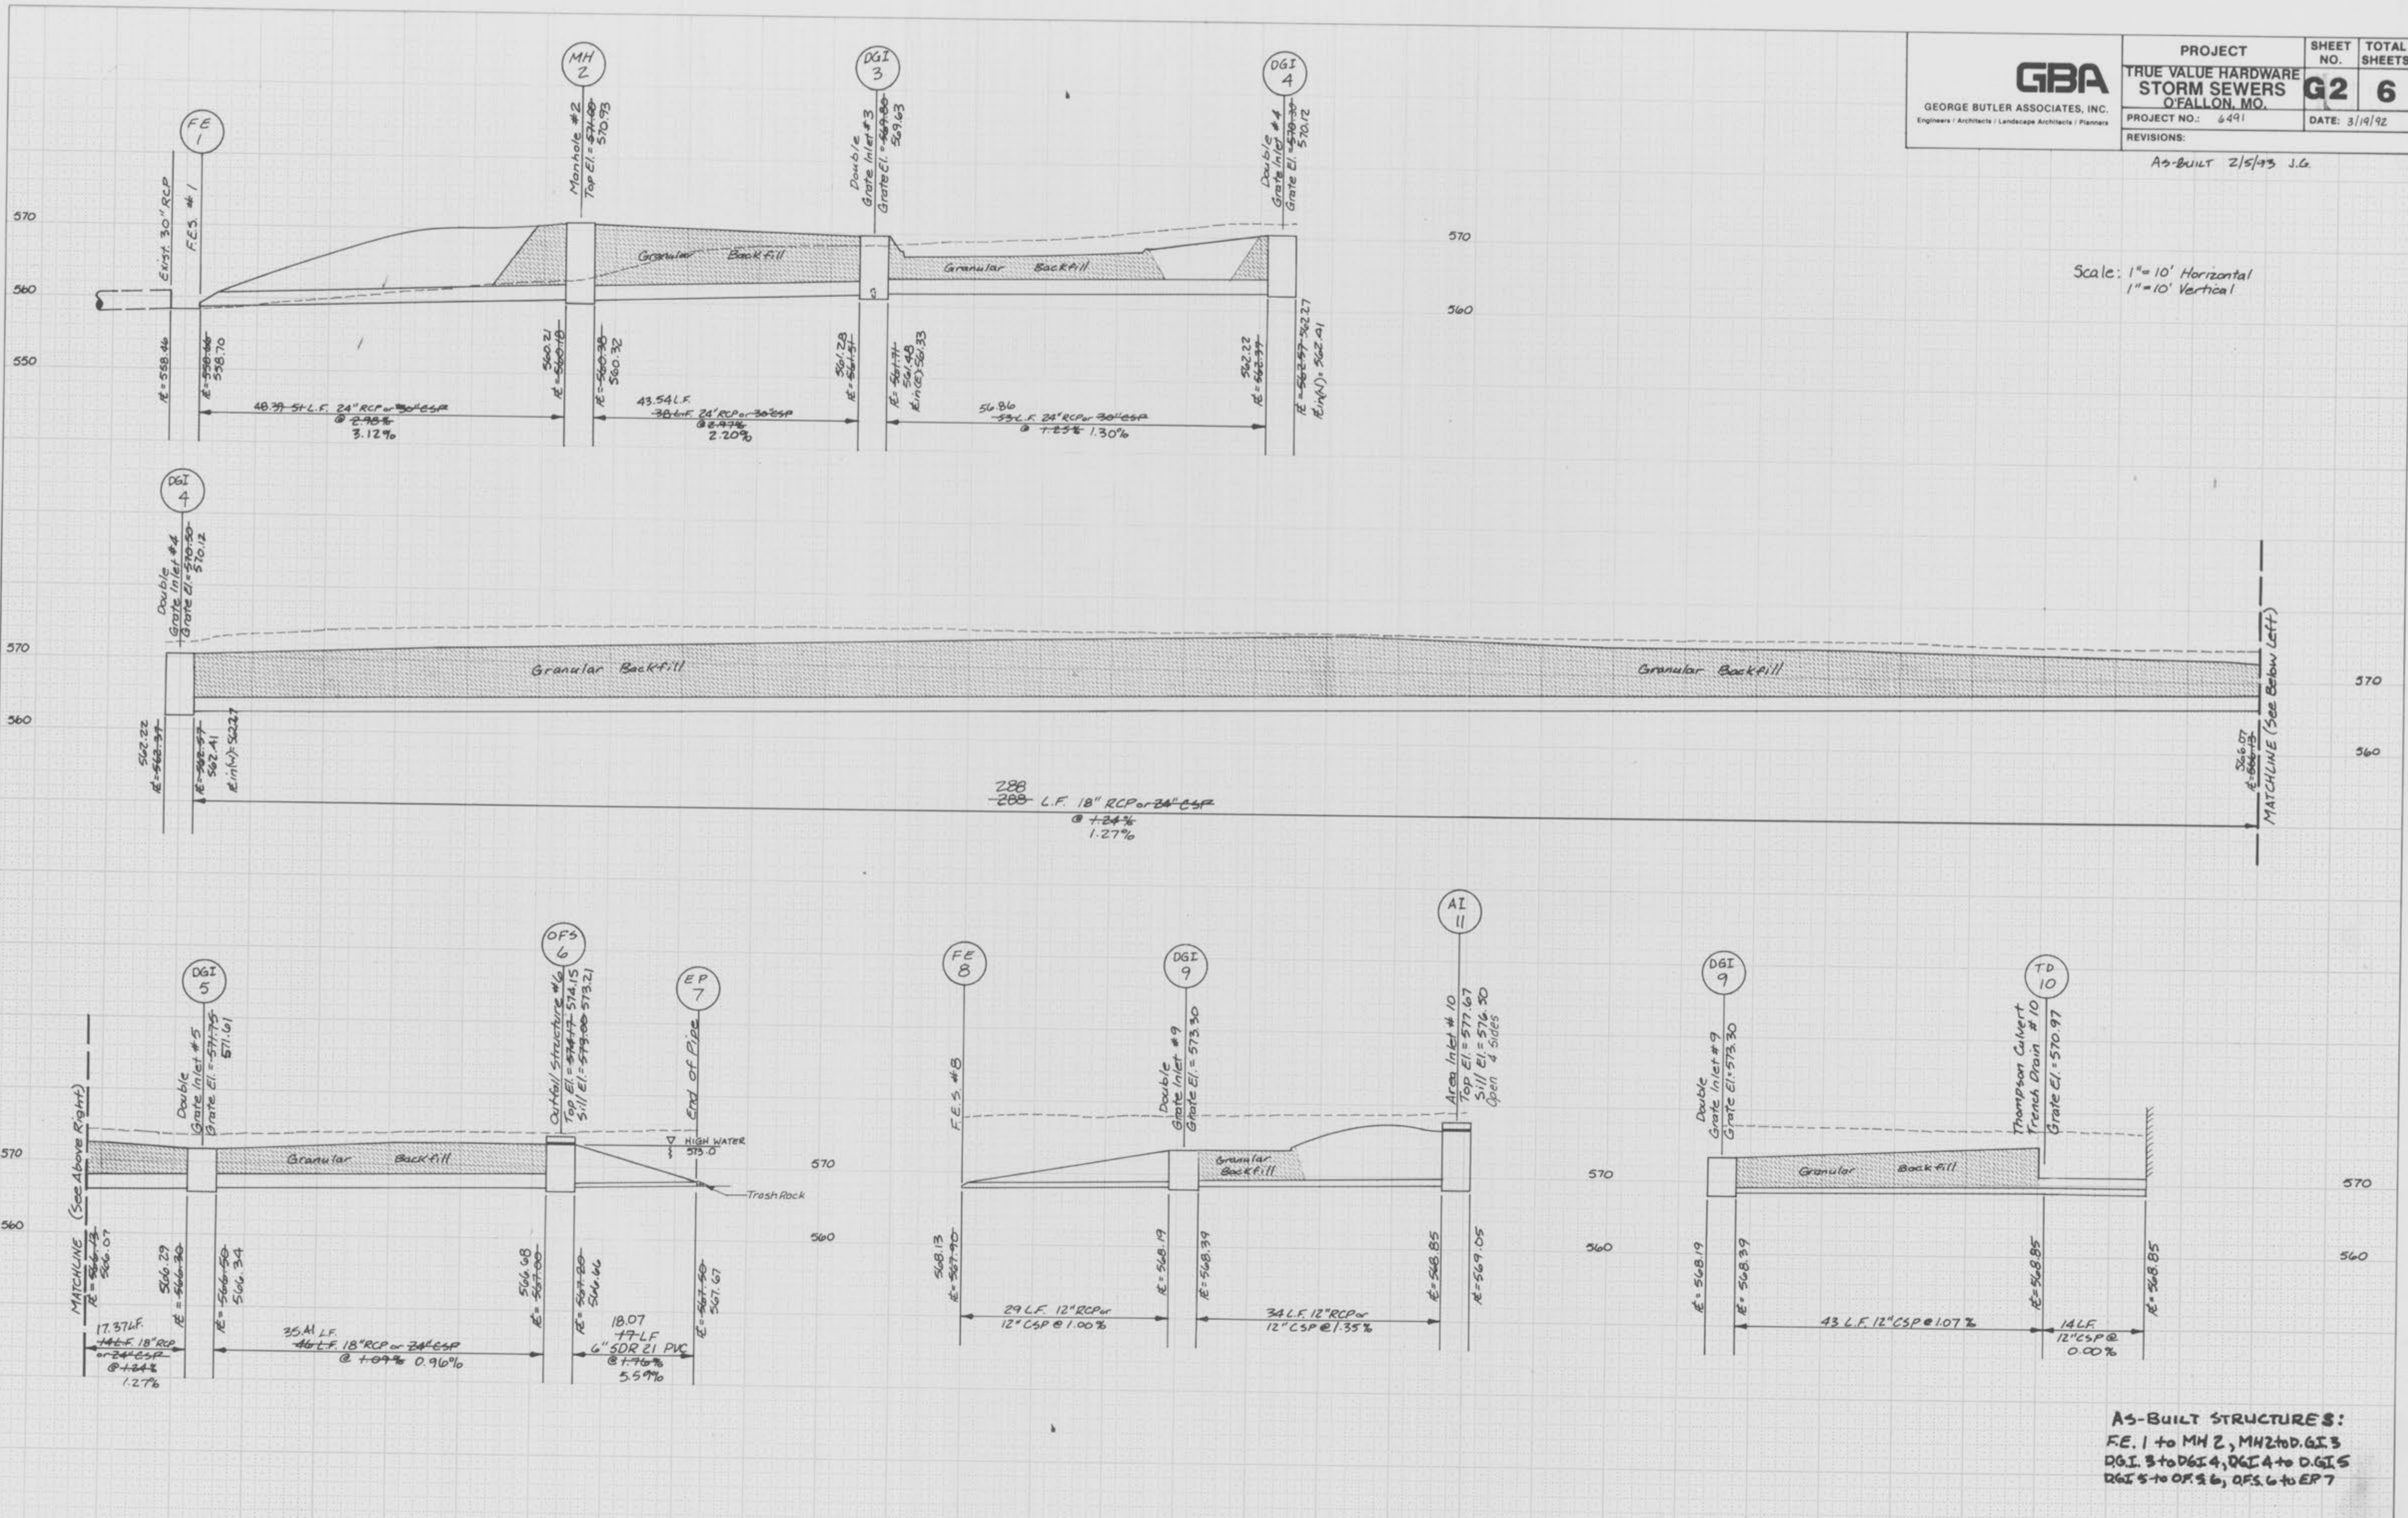



AS-BUILT STRUCTURES:  
FE 1 to MH 2, MH 2 to DGI 3  
DGI 3 to DGI 4, DGI 4 to DGI 5  
DGI 5 to OFS 6, OFS 6 to EP 7

AS-BUILT-2/5/93-J.G.


<b>GBA</b> GEORGE BUTLER ASSOCIATES, INC. <small>Engineers / Architects / Landscape Architects / Planners</small>	PROJECT	SHEET NO.	TOTAL SHEETS
	TRUE VALUE HARDWARE STORM SEWERS O'FALLON, MO.	<b>G36</b>	
	PROJECT NO.: 6491	DATE: 3/19/92	
REVISIONS: MHTD Comments		4/22/92	
AS-BUILT 2/5/93 JG		4/12/93 JG	

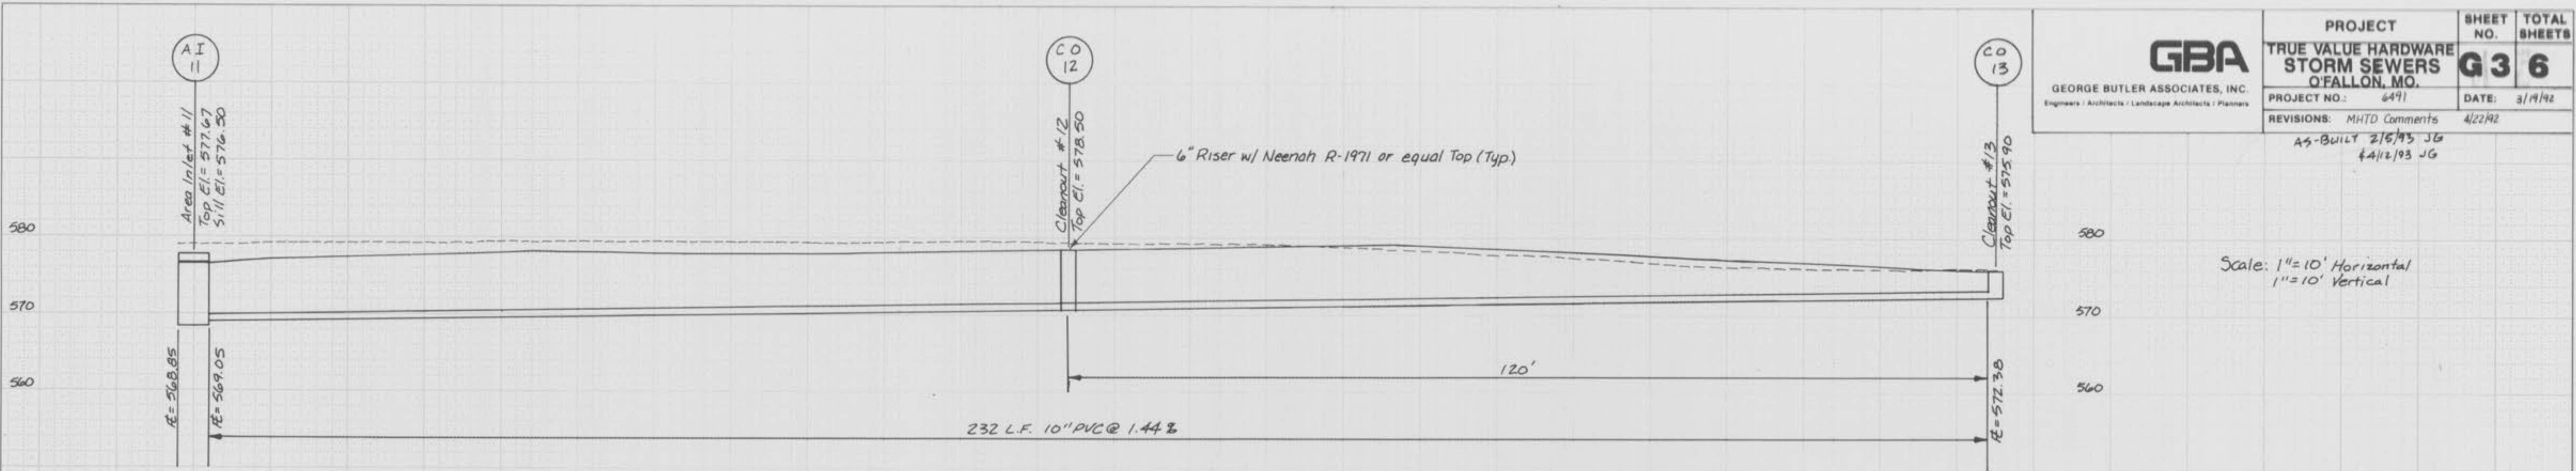

Scale: 1" = 10' Horizontal  
1" = 10' Vertical

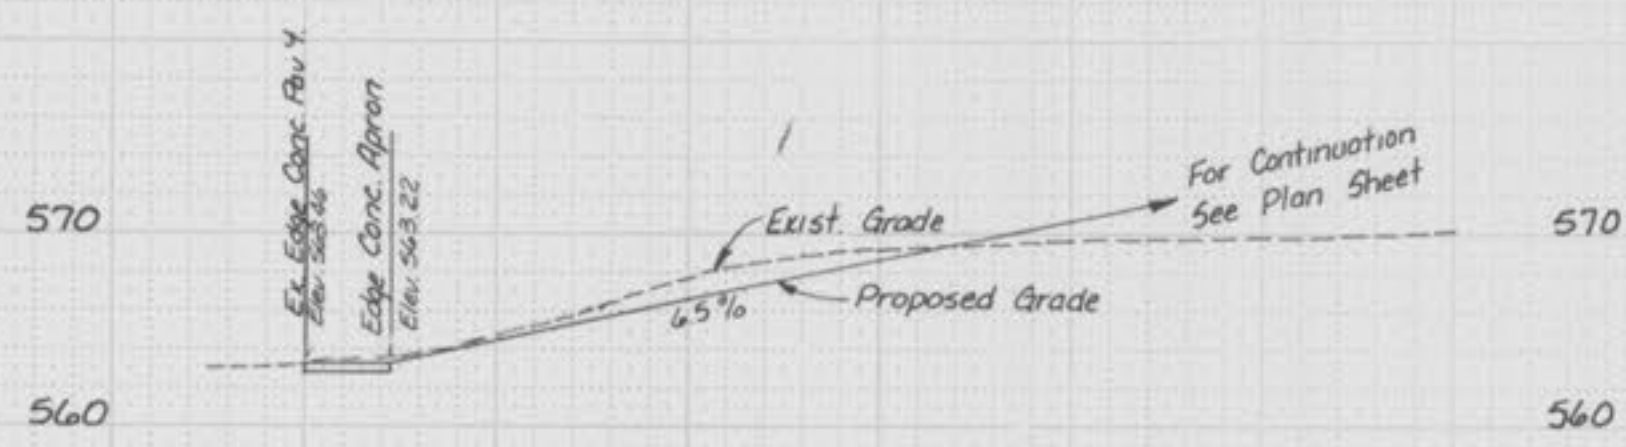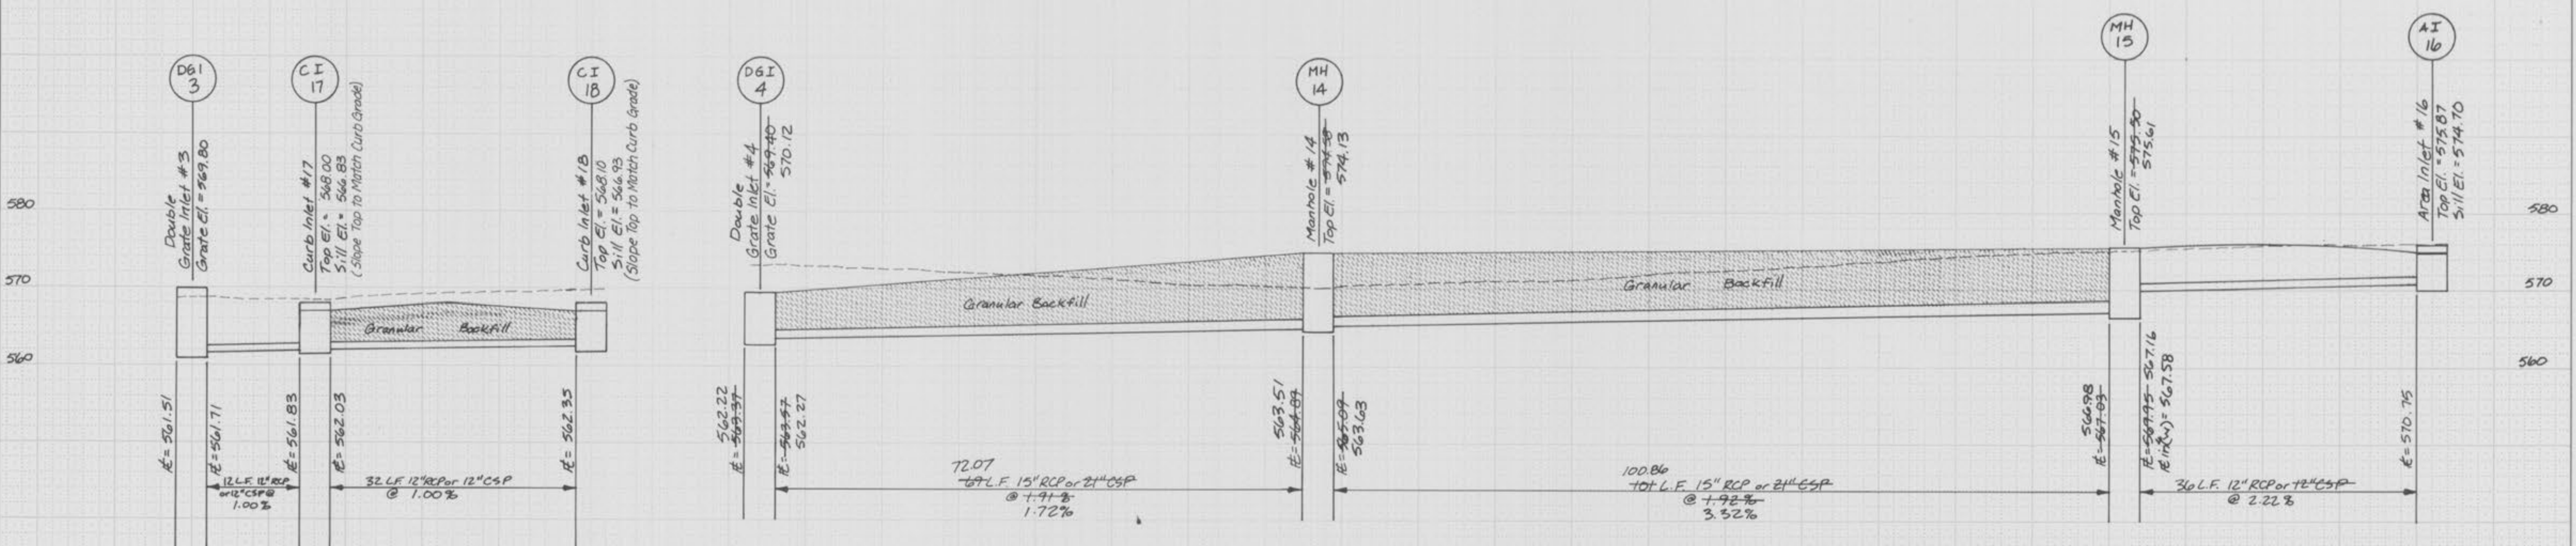


Scale: Horiz 1" = 30'  
Vert 1" = 10'  
Entrance Drive Profile

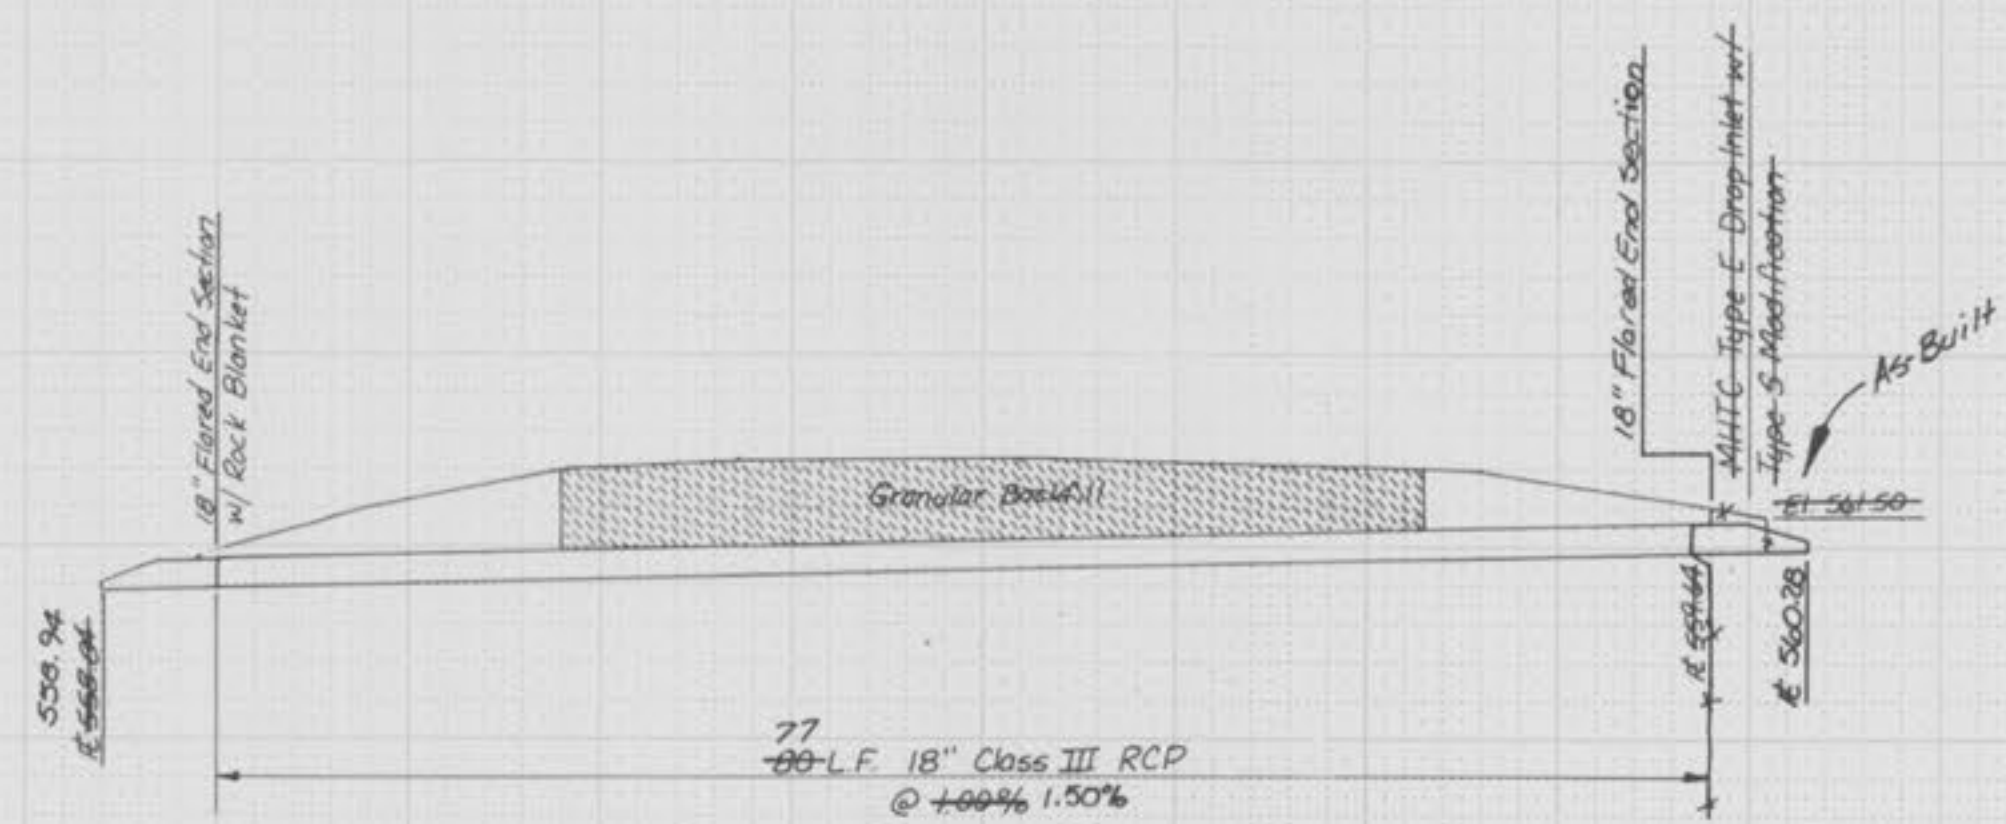


Scale: Horiz 1" = 10'  
Vert 1" = 10'  
Entrance Drive Culvert

**AS BUILT STRUCTURES:**  
 DBI 4 to MH 14  
 MH 14 to MH 15  
 Entrance Drive Culvert  
 4/12/93 JG  
 AS-BUILT-2/5/93-JG

<b>GBA</b> GEORGE BUTLER ASSOCIATES, INC. Engineers / Architects / Landscape Architects / Planners Kansas City, Mo. / Lenexa, Ka. / O'Fallon, Mo. / Ames, Ia. / Oklahoma City, Ok.		DATE: 3/1/94
DESIGN BY: MCV		SHEET NO. TOTAL SHEETS
DRAWN BY: JMG		PROJECT NO. 4491
<b>DETAILS</b>		<b>G 4 6</b>
REVISIONS		BY DATE
Revised Per MHTD Comments		MCV 4/3/92

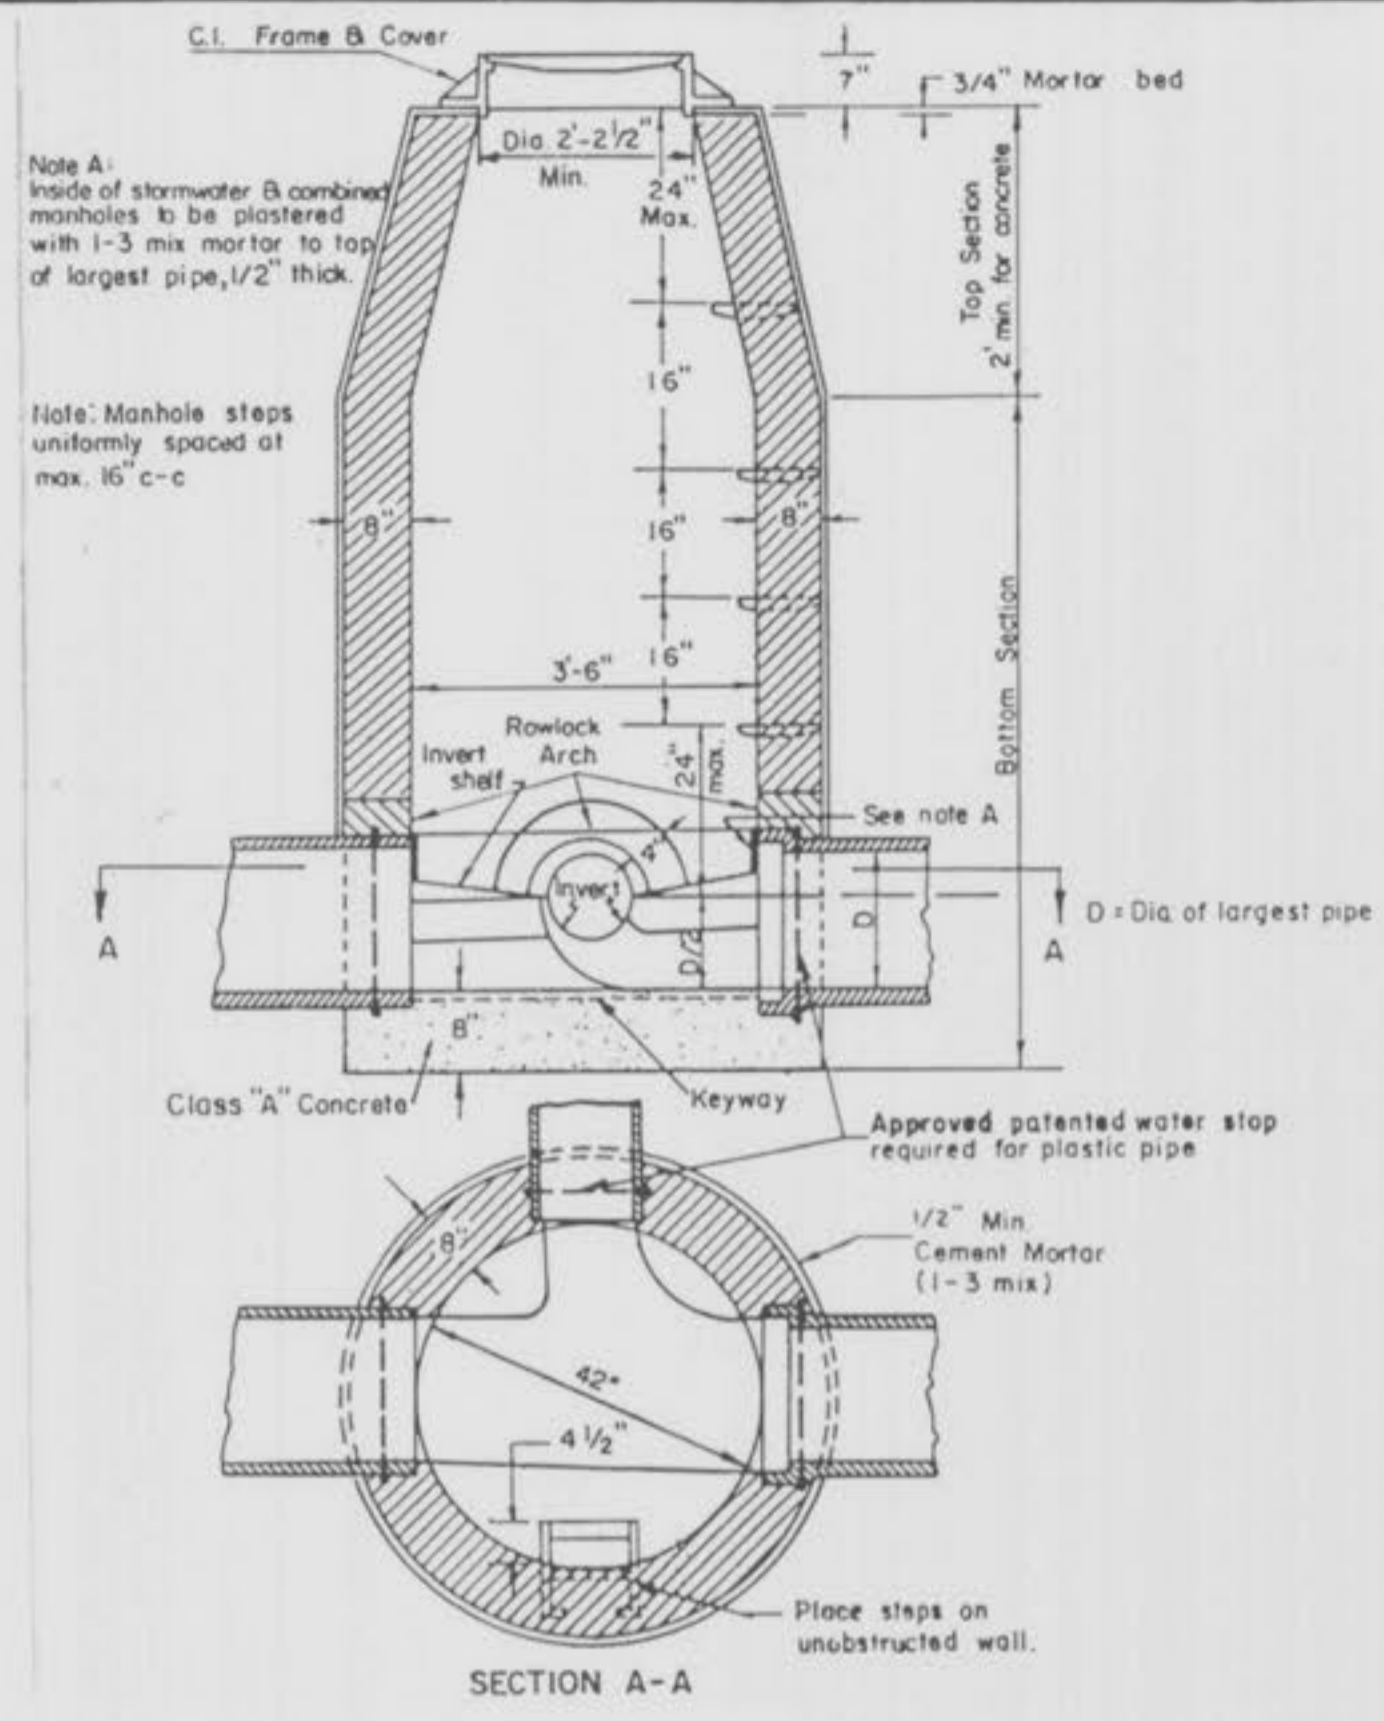


**MANHOLE DETAIL**  
N.T.S.

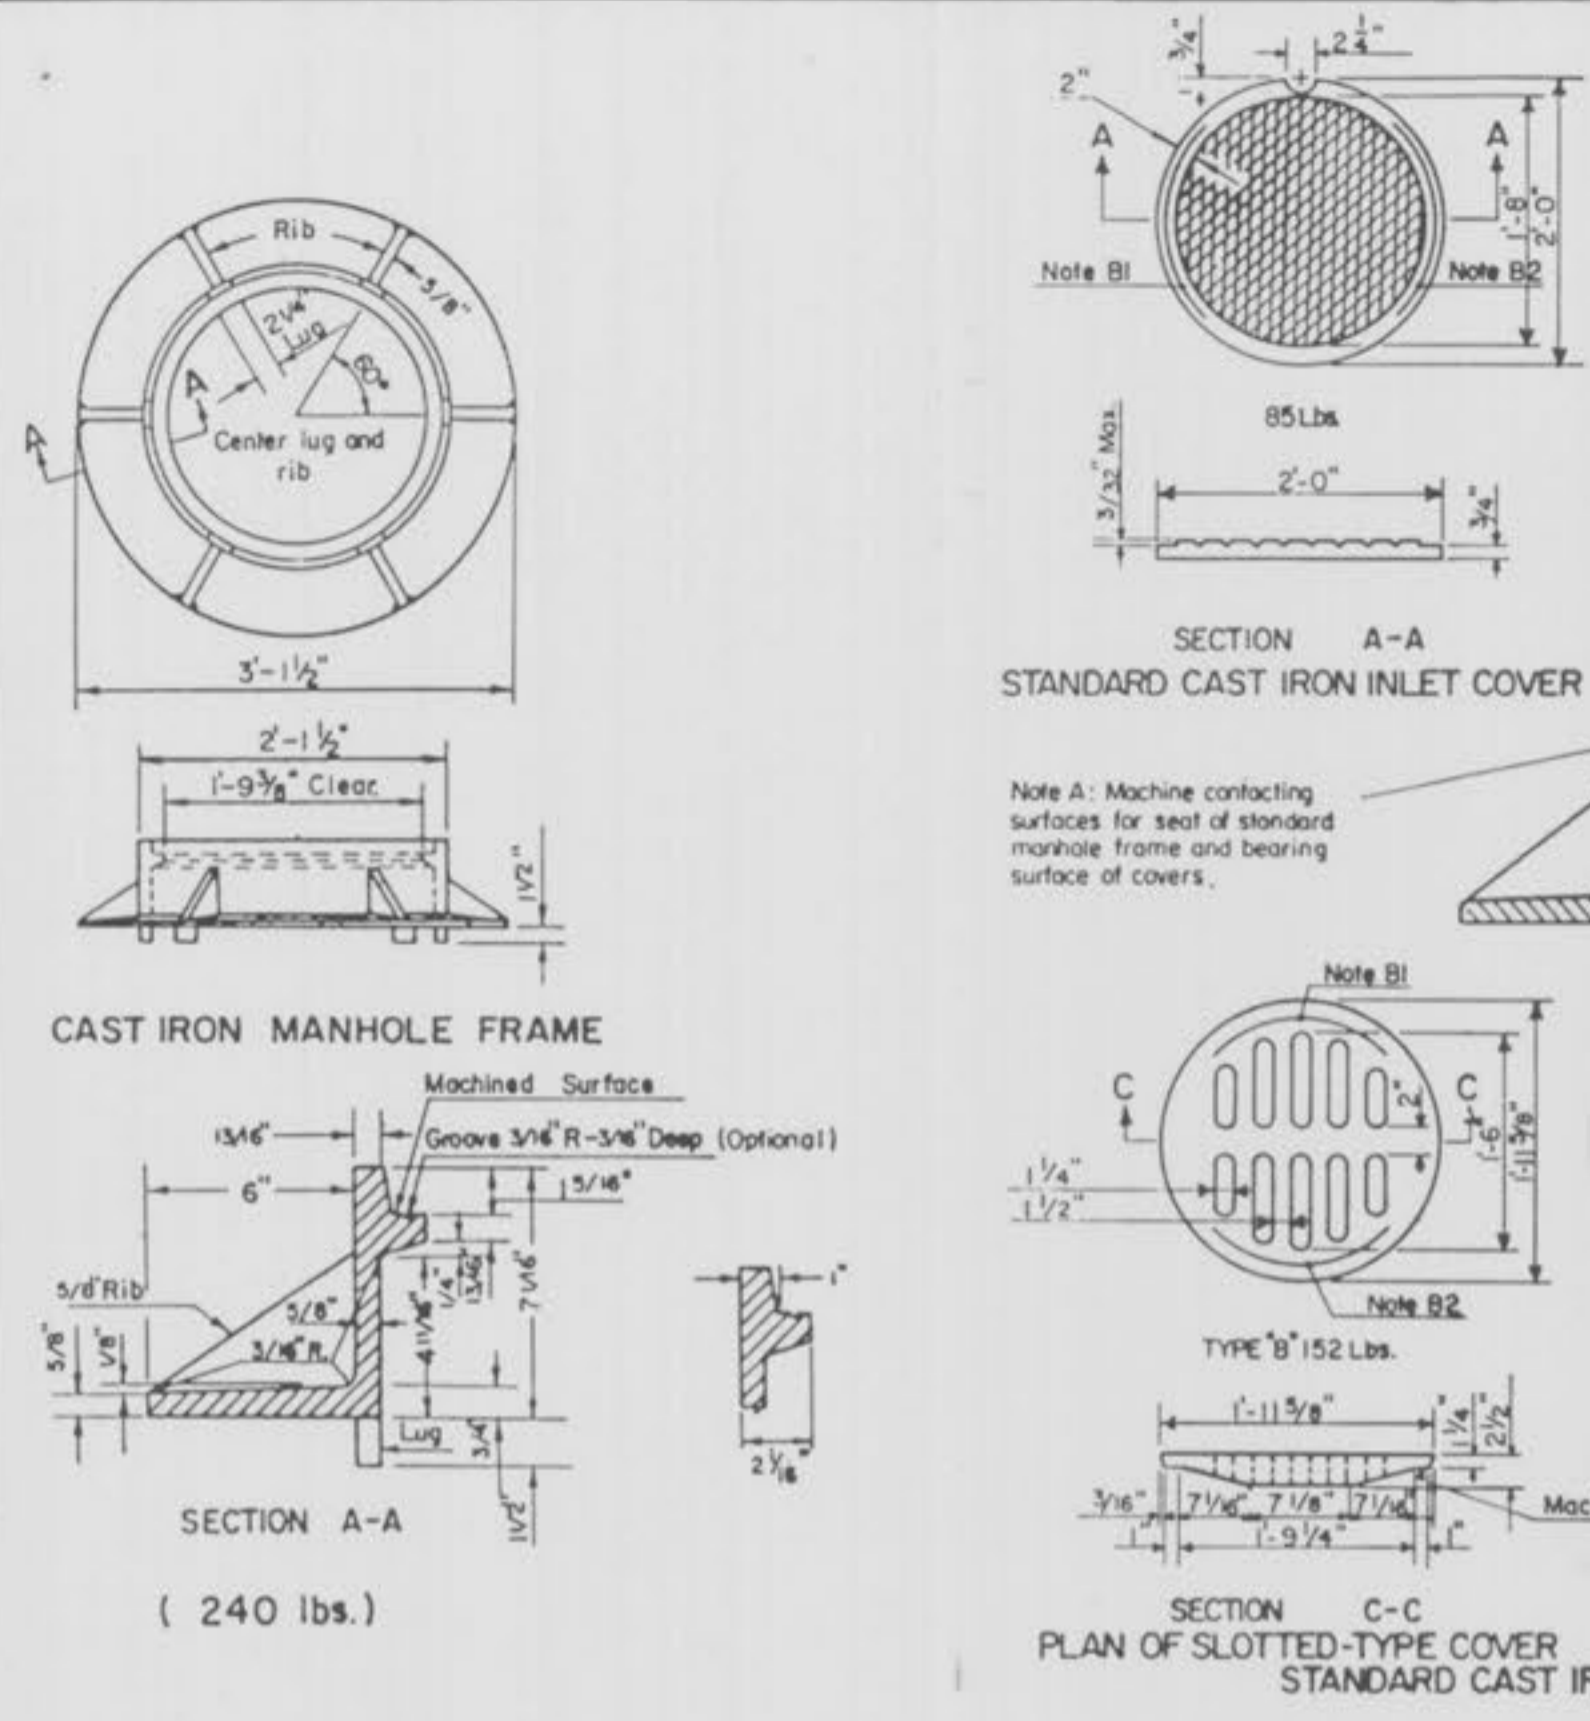


**CAST IRON MANHOLE FRAME**  
N.T.S.

**CAST IRON COVERS**  
**MANHOLES AND INLETS**  
N.T.S.

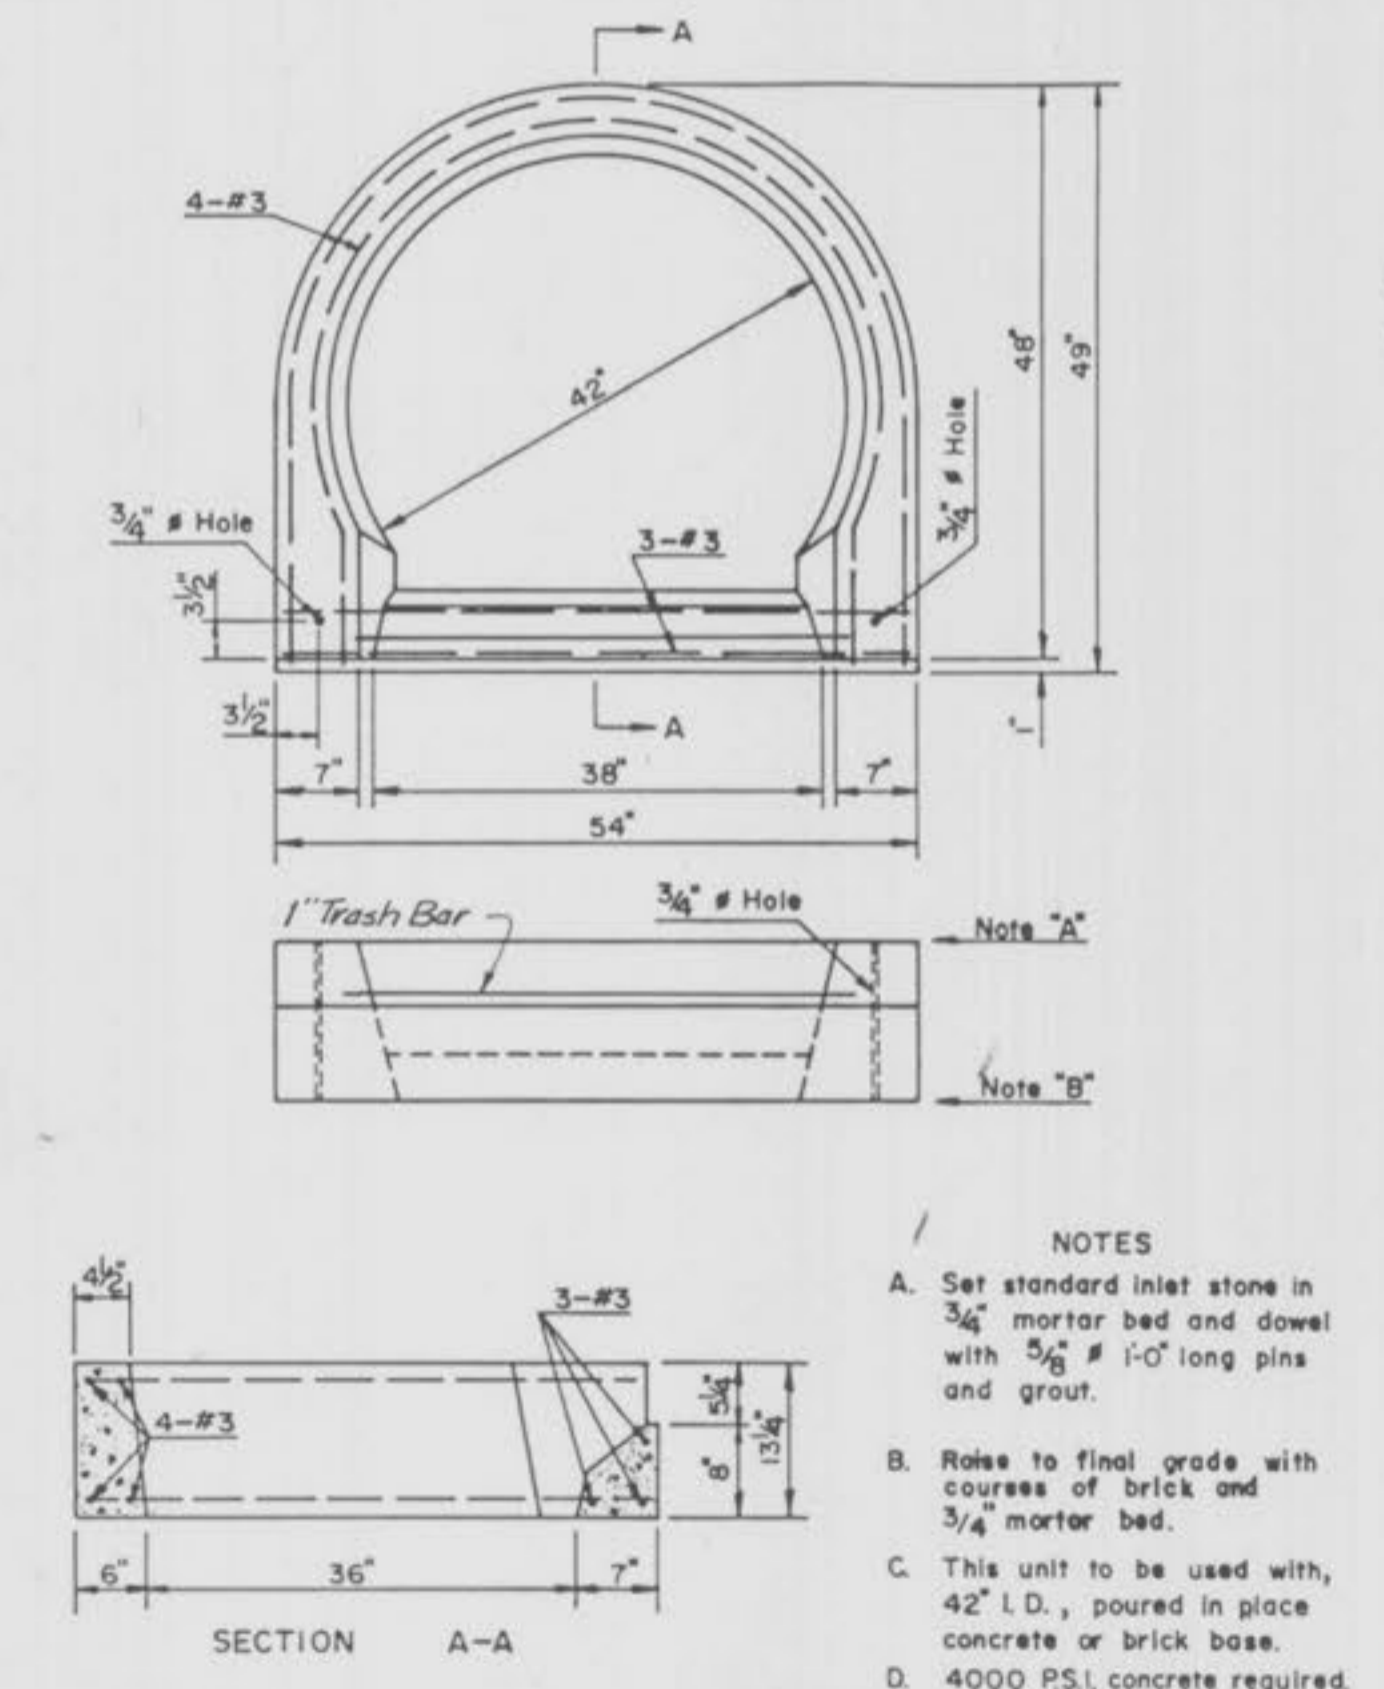


**PRE-CAST CONCRETE UNIT**  
**FOR SINGLE CURB INLET**  
N.T.S.


- NOTES**
- Set standard inlet stone in 3/4" mortar bed and dowel with 3/8" # 1-0" long pins and grout.
  - Roll to final grade with course of brick and 3/4" mortar bed.
  - This unit to be used with, 42" I.D., poured in place concrete or brick base.
  - 4000 P.S.I. concrete required.

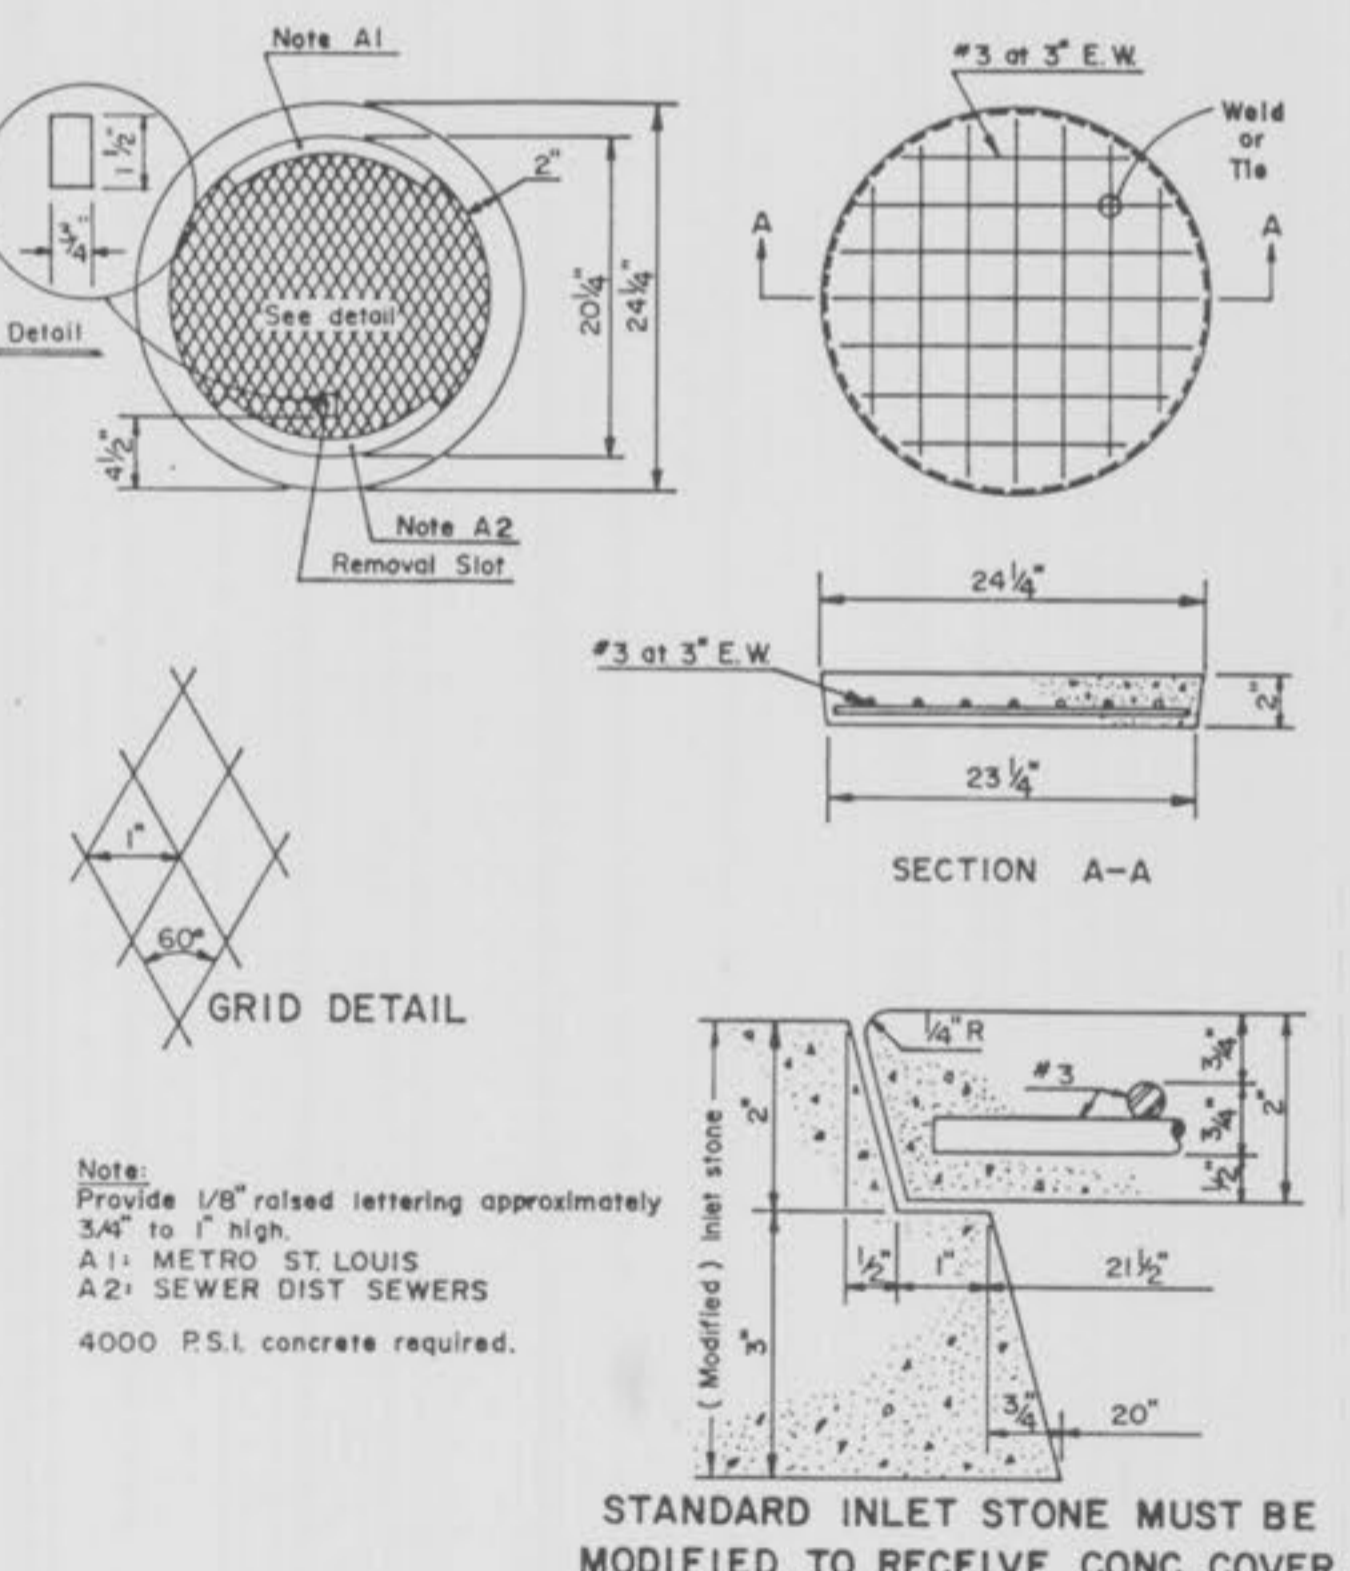


**PRE-CAST CONCRETE INLET COVER**  
N.T.S.

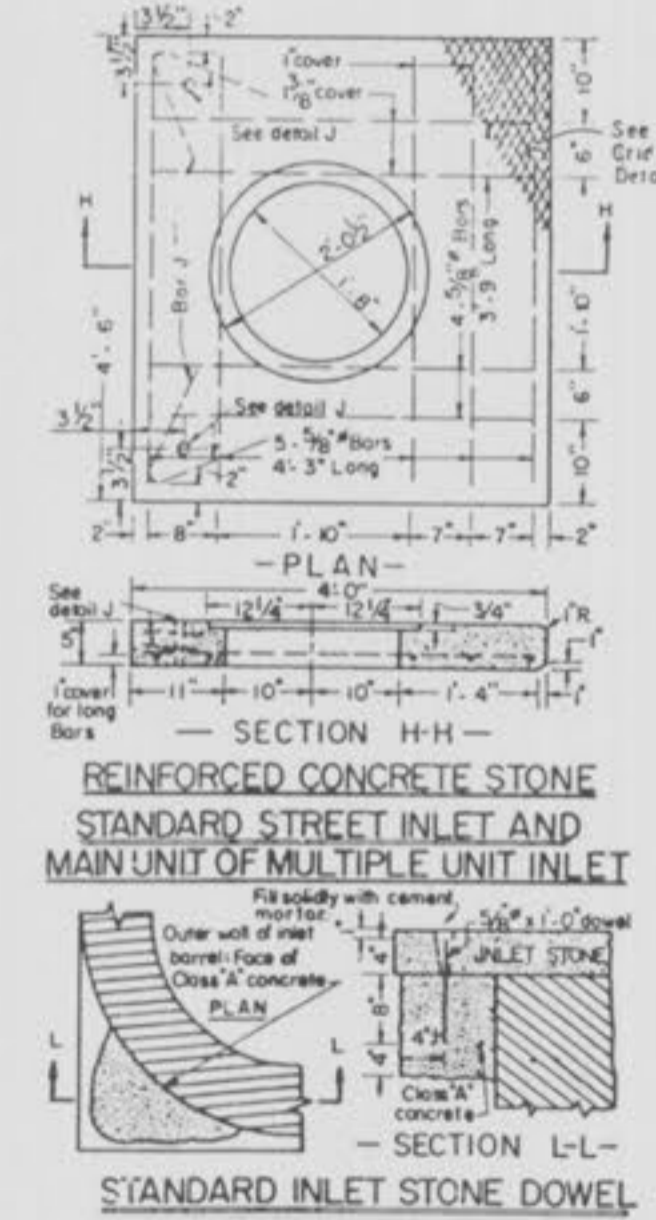


**INLET DETAILS**  
N.T.S.

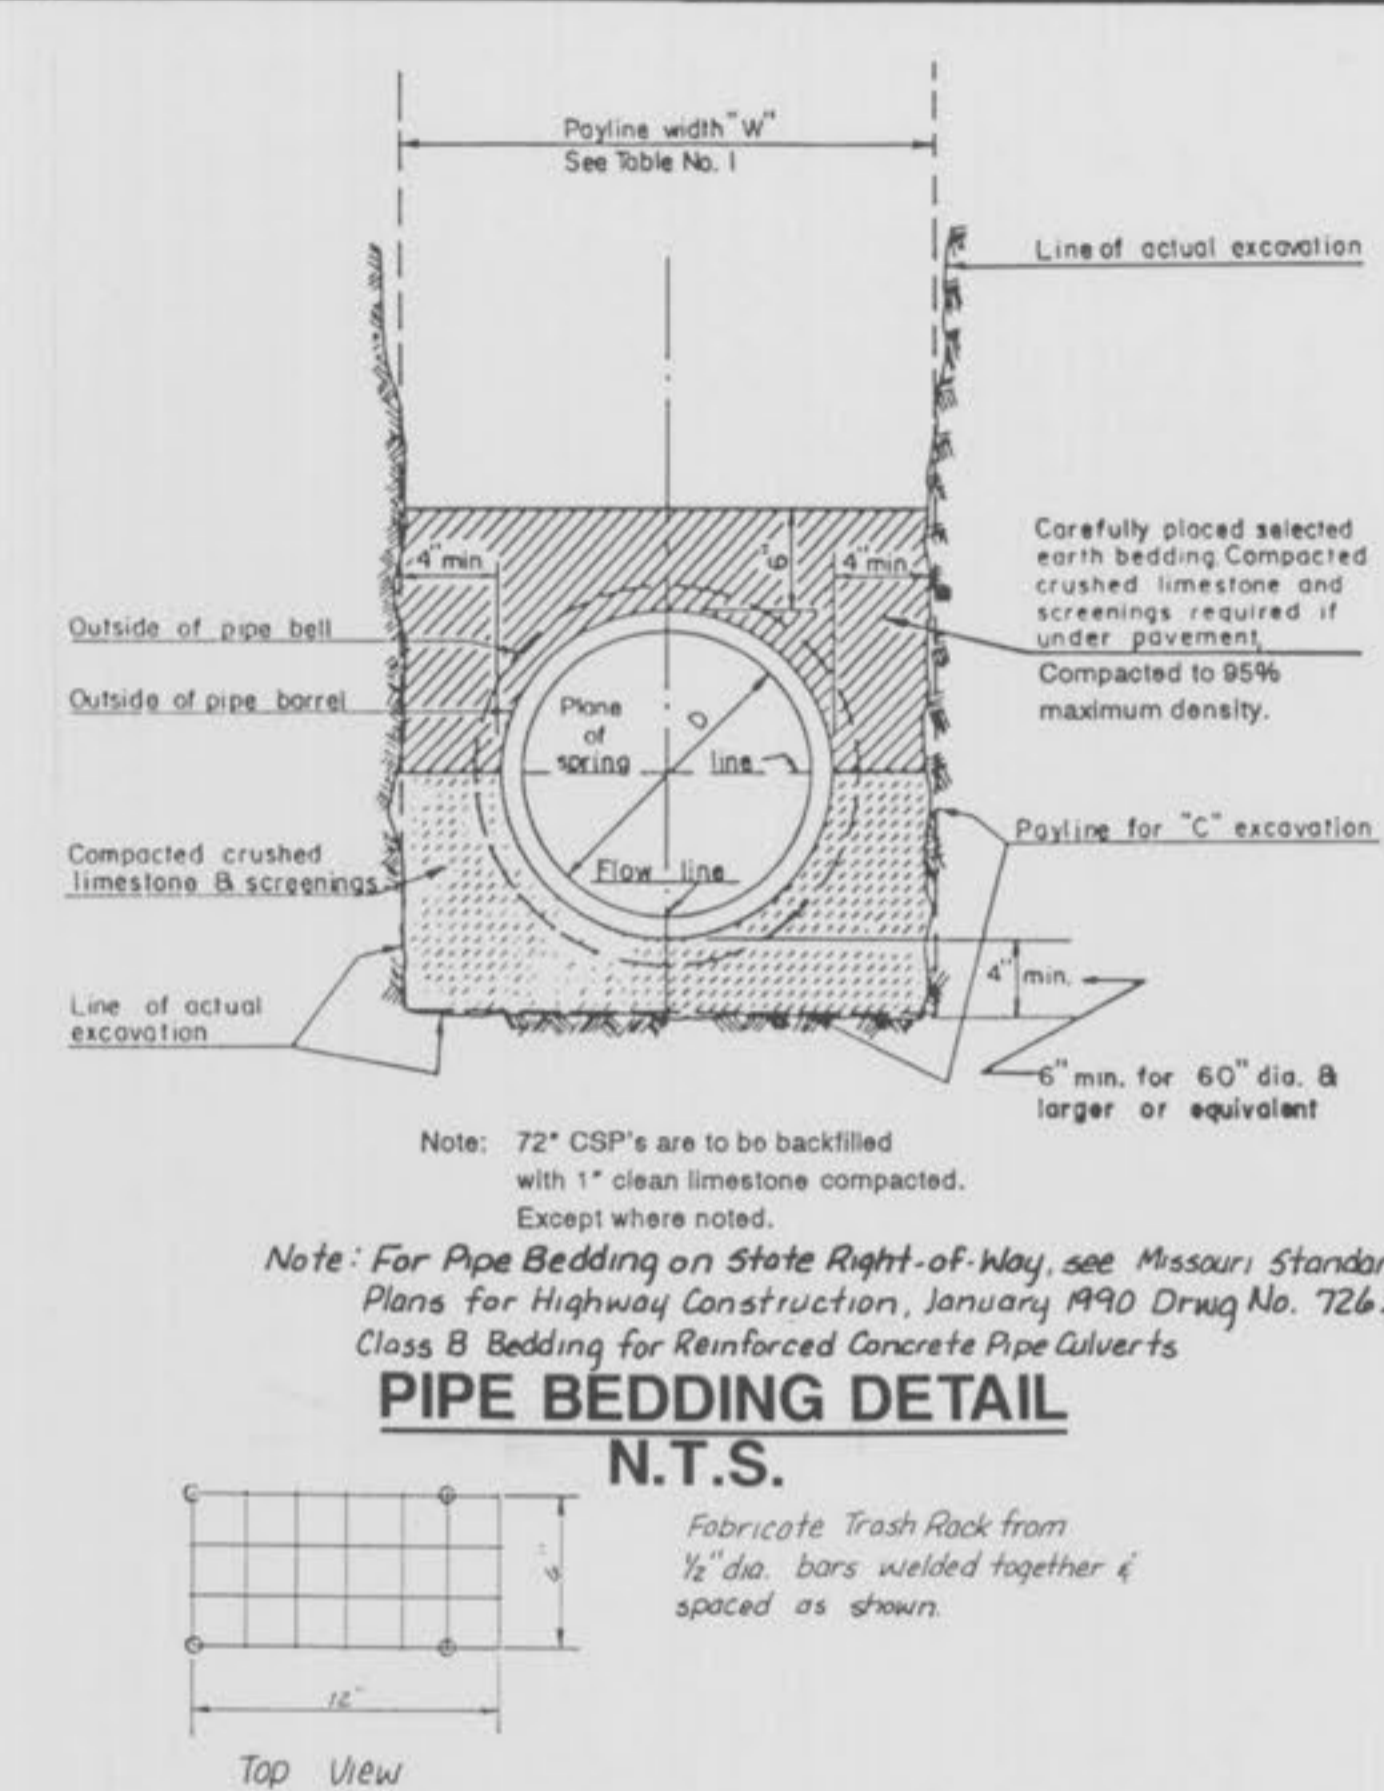

**FLAIED END SECTION DETAIL**  
N.T.S.


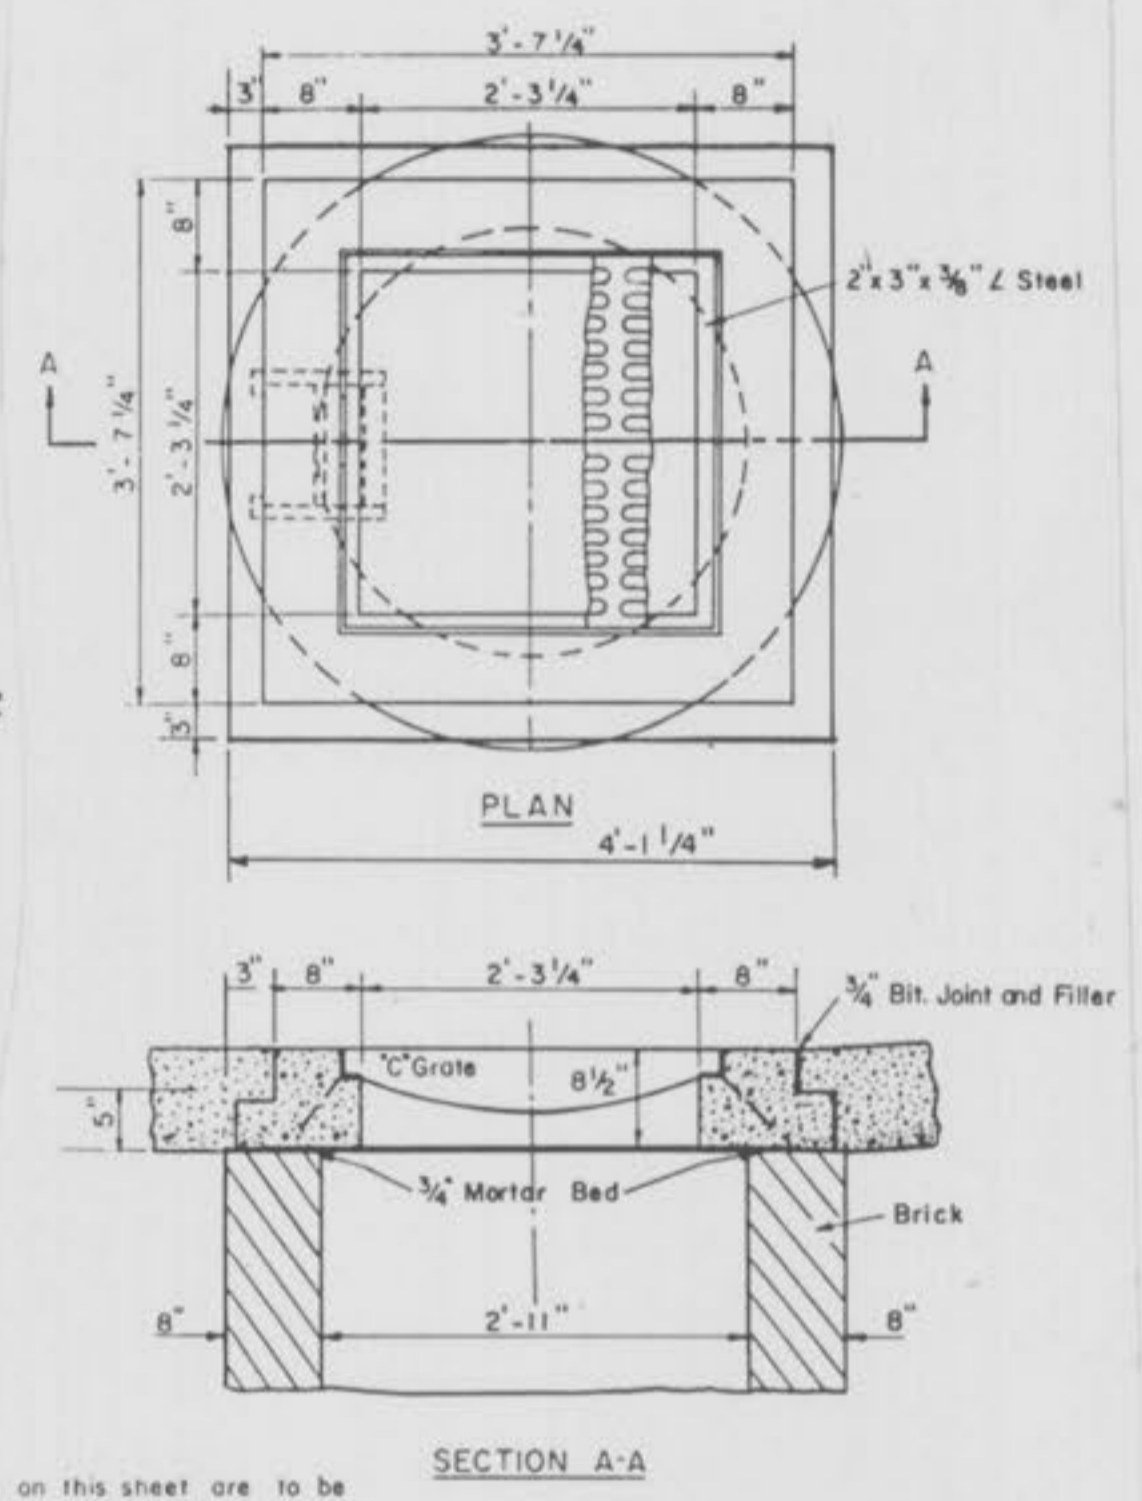


**2 - GRATE INLET**  
N.T.S.

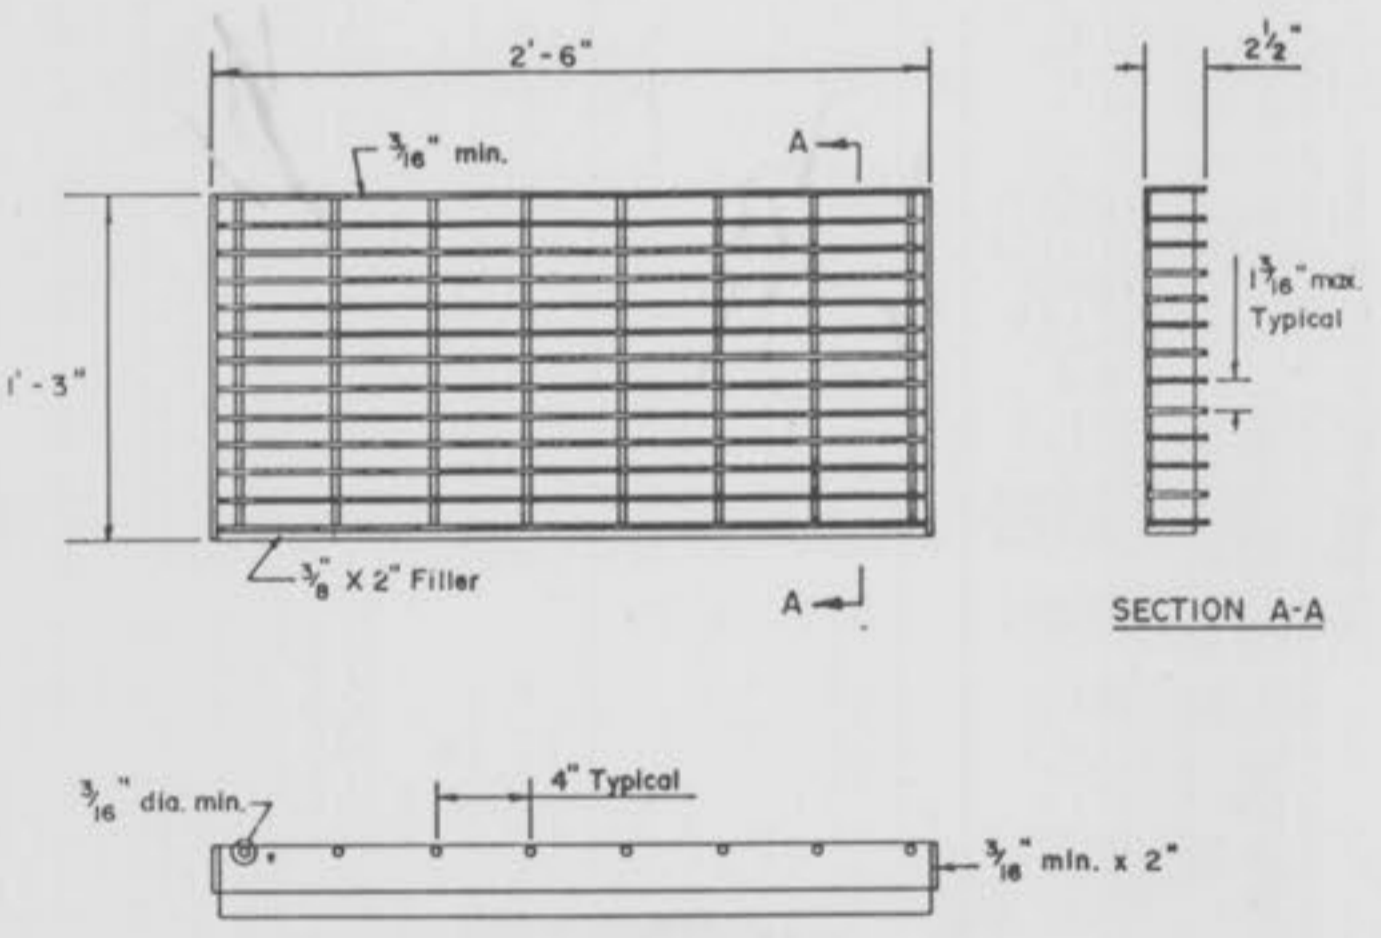

**STEEL GRATE DETAIL**  
N.T.S.

- Finish** - Asphaltic 10 mil. coating  
**Material** - Mild carbon steel - ASTM A569  
**Capacity** - H-20 loading  
**Weight** - 65 lb. min.  
**Tolerances** - All dimensions ± 1/8"  
**Identification** - The manufacturer must place his name or mark on each unit for the purpose of identification

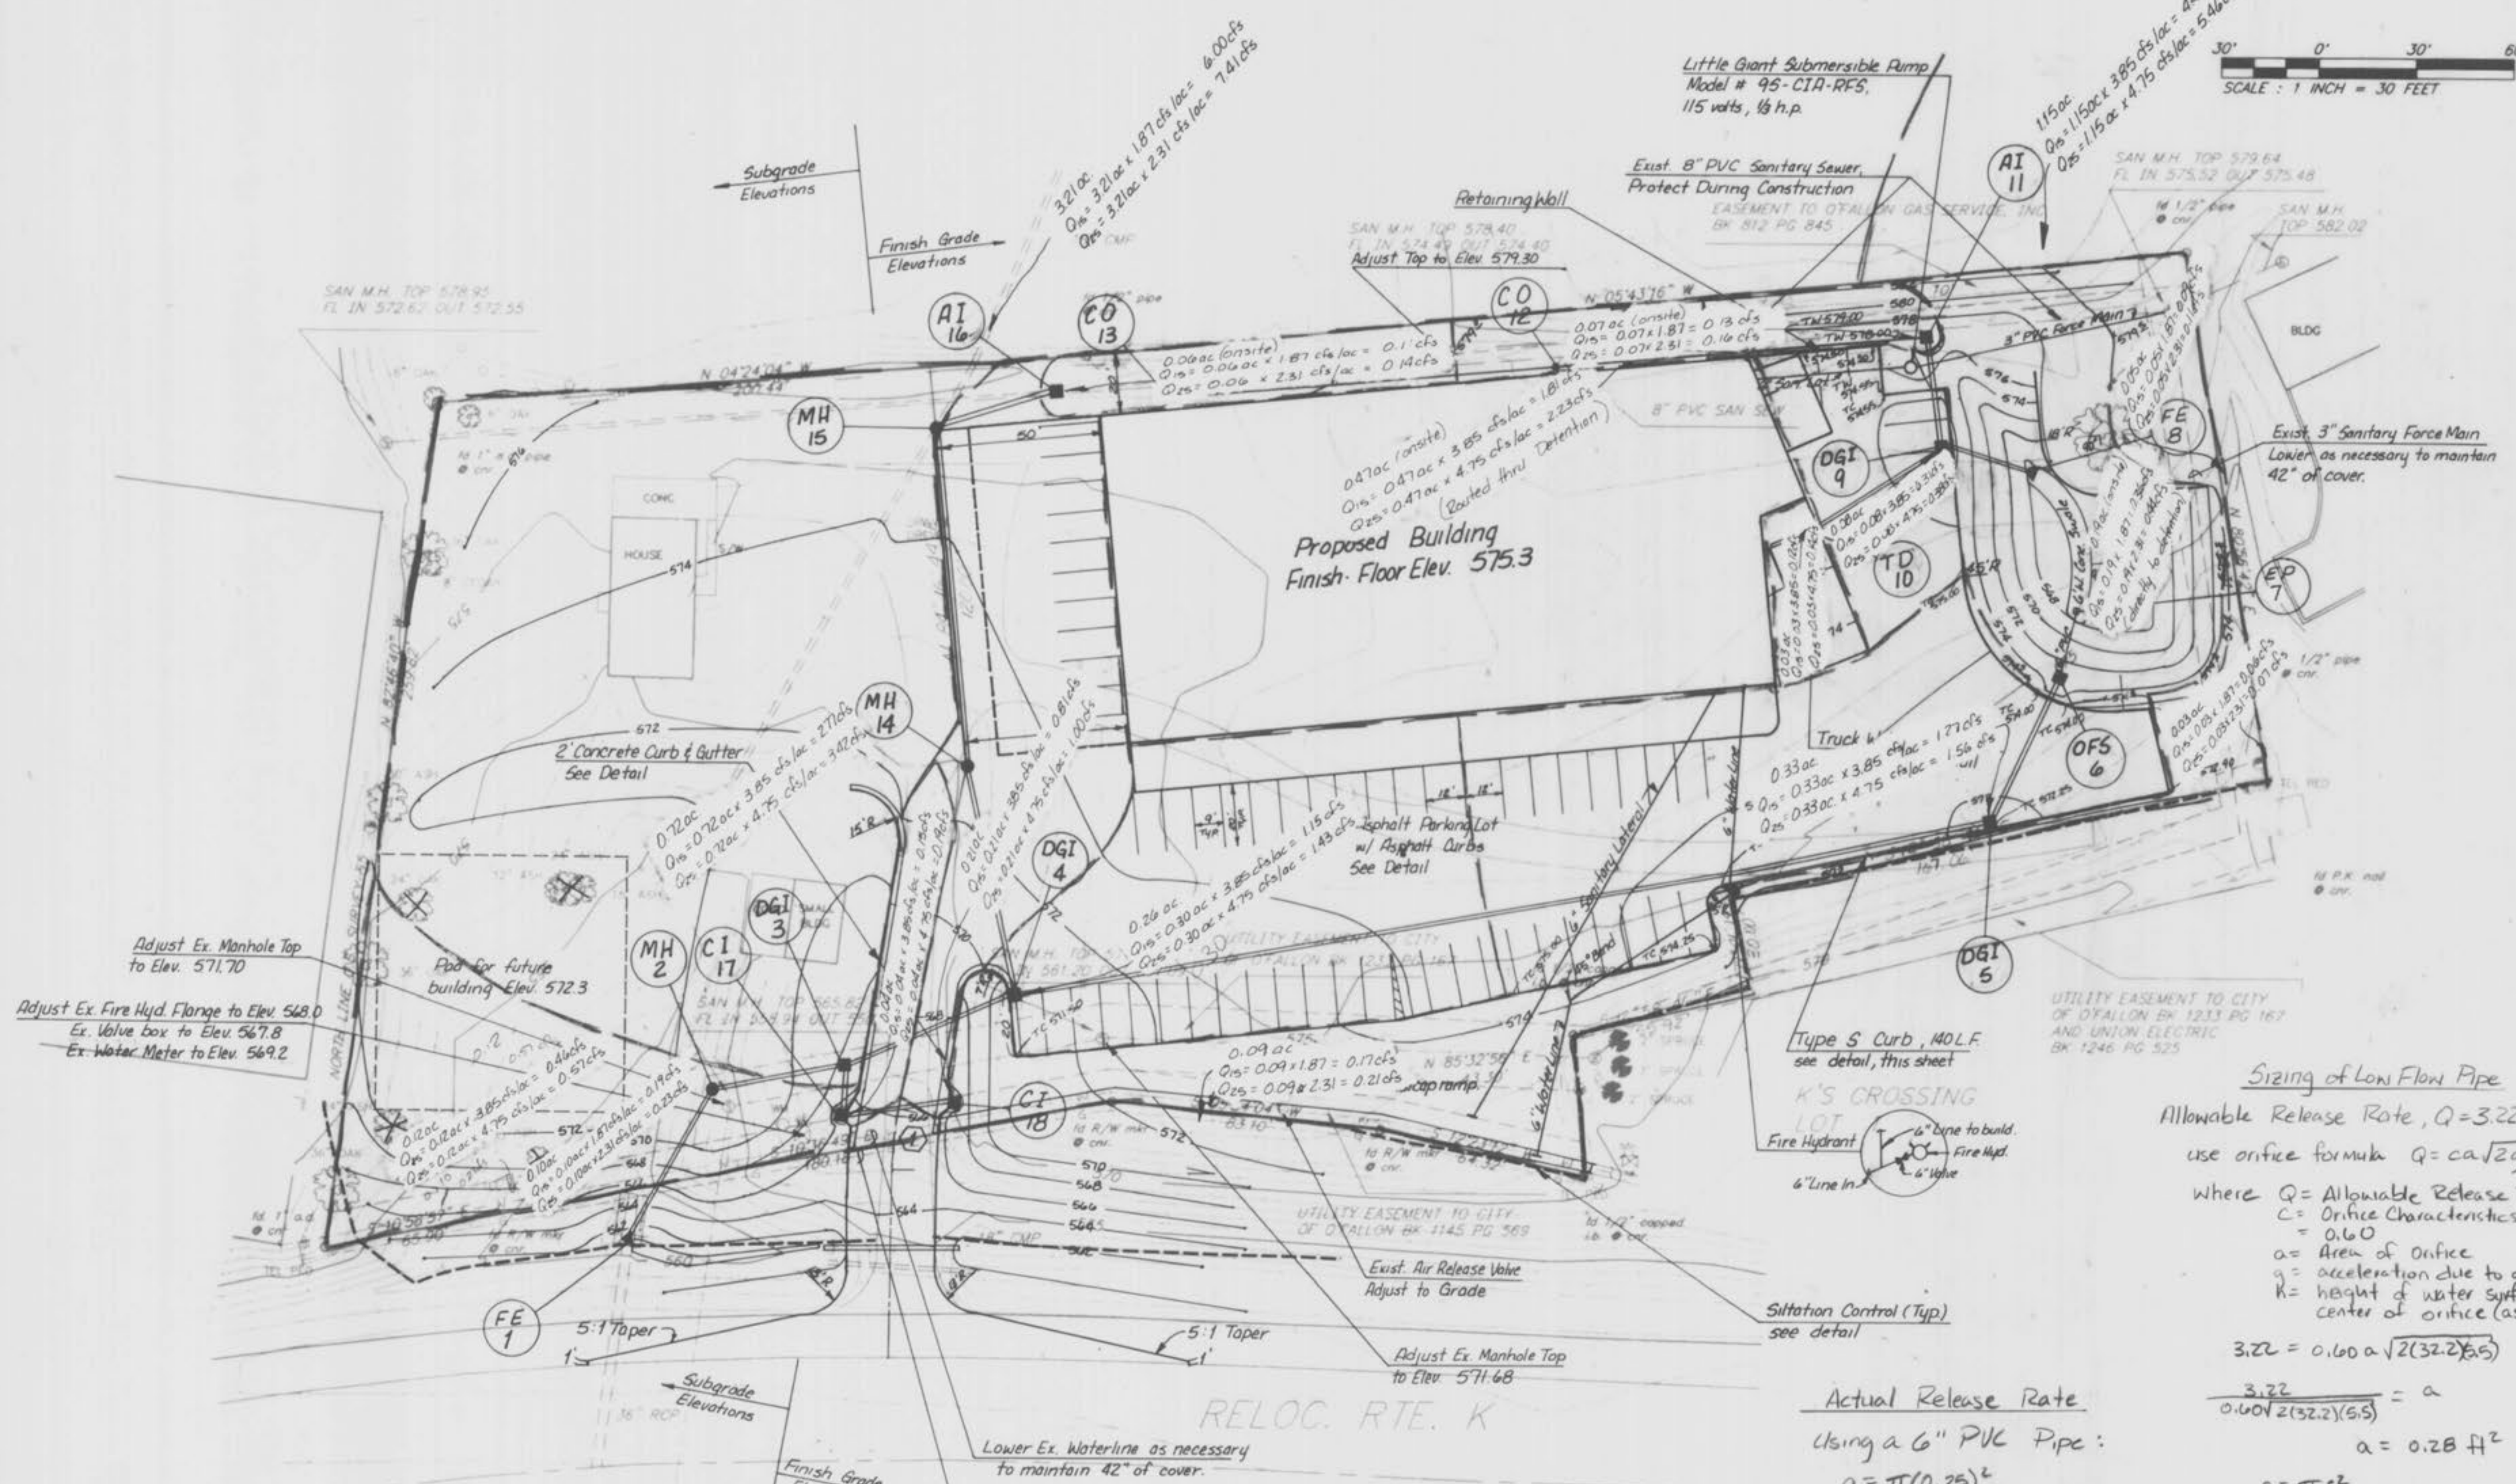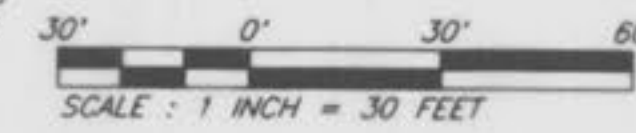

Detention Calculations

Impervious Area = 2.894 ac - 0.54 ac (Green Space)  
 = 2.354 ac

Runoff Rate Factors; per O'Fallon Subdivision Ordinance

25yr - 30 min Storm  
 Parks/GreenSpace 2.31 cfs/ac  
 Industrial/Commercial 4.75 cfs/ac

15yr - 30 min Storm  
 Parks/GreenSpace 1.87 cfs/ac  
 Industrial/Commercial 3.85 cfs/ac

Prior to Development Site is Parks/GreenSpace  
 $\therefore 2.354 \text{ ac} \times (4.75 - 2.31) \text{ cfs/ac} = 5.74 \text{ cfs}$  increase in flow for a 25yr. event.

Storage Required:  
 $5.74 \text{ cfs} \times 30 \text{ min} \times 60 \frac{\text{sec}}{\text{min}} = 10,332 \text{ cu ft}$

Sizing of Low Flow Pipe

Allowable Release Rate,  $Q = 3.22 \text{ cfs}$   
 use orifice formula  $Q = ca\sqrt{2gh}$   
 where  $Q$  = Allowable Release Rate  
 $C$  = Orifice Characteristics Coef. = 0.60  
 $a$  = Area of Orifice  
 $g$  = acceleration due to gravity  
 $h$  = height of water surface above center of orifice (assume 5.5')

$3.22 = 0.60 a \sqrt{2(32.2)(5.5)}$   
 $\frac{3.22}{0.60 \sqrt{2(32.2)(5.5)}} = a$   
 $a = 0.28 \text{ ft}^2$   
 $0.28 = \pi r^2$   
 $r = \frac{0.28}{\pi}$   
 $r = 0.091$   
 $d = 0.60'$   
 $d = 0.60' \times \frac{12''}{1'} = 7.23''$   
 $\therefore$  use 6" SDR 21 PVC Pipe

Actual Storage Capacity =

Post Development Flow to the Basin:

offsite building	1.15 ac x 4.75 cfs/ac =	5.46 cfs
parking lot	0.47 ac x 4.75 cfs/ac =	2.23 cfs
greenspace	0.11 ac x 4.75 cfs/ac =	0.52 cfs
basin	0.07 ac x 2.31 cfs/ac =	0.16 cfs
	0.19 ac x 2.31 cfs/ac =	0.44 cfs
		<b>8.81 cfs</b>

Post Development Flow Bypassing the Basin:

offsite	3.21 ac x 2.31 cfs/ac =	7.41 cfs
greenspace	0.33 ac x 2.31 cfs/ac =	0.76 cfs
parking lot	1.12 ac x 4.75 cfs/ac =	5.33 cfs
		<b>13.50 cfs</b>

Allowable Release Rate = 2.894 ac x 2.31 cfs/ac = 6.69 cfs  
 + 1.15 ac x 4.75 cfs/ac = 5.46 cfs  
 + 3.21 ac x 2.31 cfs/ac = 7.41 cfs  
**19.56 cfs**

Allowable Release Rate From Detention:  
 19.56 cfs - 16.34 cfs = 3.22 cfs

Actual Release Rate

Using a 6" PVC Pipe:

$a = \pi(0.25)^2 = 0.20 \text{ ft}^2$   
 $h = 573 - 567.75 = 5.25'$   
 $Q = 0.60(0.20)\sqrt{2(32.2)(5.25)}$   
 $Q = 2.21 \text{ cfs}$

Actual Basin Storage Capacity

Storage Volume = 15,580 cu. ft.

Curve (1)  
 $R = 100'$   
 $\Delta = 11^\circ 00' 00''$   
 $L = 19.19'$

Gas and Telephone lines are to be adjusted as necessary, Contractor should coordinate with the respective utilities.

**THIS SHEET IS TO BE USED FOR DRAINAGE AREA PURPOSES ONLY, AND IS NOT TO BE USED FOR CONSTRUCTION**