

GLEN EAGLE

MUNICIPAL GOLF COURSE
O'FALLON, MISSOURI
IMPROVEMENT PLANS
NORTH OF MEXICO ROAD
344 LOTS

CITY OF O'FALLON GENERAL NOTES

1. Gas, water and other underground utilities shall not conflict with the depth or horizontal locations of existing and proposed sanitary and storm sewers, including house laterals.
2. Underground utilities have been plotted from available information and, therefore, their locations must be considered approximate only. The verification of the location of all underground utilities, either shown or not shown on these plans, shall be the responsibility of the contractor and shall be located prior to grading or construction of improvements.
3. Polyvinyl Chloride (PVC) shall conform to the requirements of ASTM D-3034 Standard Specifications for the PSM Polyvinyl Chloride (PVC) Sewer Pipe and Fittings, SDR-35.
4. Storm sewers 18" in diameter or smaller shall be ASTM C-76.
5. Storm sewers 21" in diameter or larger shall be ASTM C-76, Class II.
6. All storm sewer pipe under pavement, regardless of size, shall be reinforced concrete pipe (ASTM C-76, Class II), unless noted otherwise in the plans.
7. Corrugated metal pipe shall conform to the standard specifications for corrugated culvert pipe M-36, A.A.S.H.O. See plans for gauge.
8. All filled areas under buildings, proposed sanitary and storm sewer lines, and/or paved areas including trench backfill shall be compacted to 95% of maximum dry density determined by the Standard Proctor Test (ASTM D-1557) unless otherwise specified by the local governing authority specifications. All tests will be verified by a soils engineer.
9. All earthen filled areas within State, County, or City roads (highways) shall be compacted to 95% of maximum dry density determined by the Standard Proctor Test (ASTM D-1557) unless otherwise specified by the local governing authority specifications. All tests will be verified by a soils engineer.
10. All storm and sanitary trench backfills shall be water jetted. Granular fill will be used under paved areas.
11. Easements shall be provided for storm sewers, sanitary sewers, and oil utilities on the record plat. See record plat for location and size of easements. This does not apply to house laterals.
12. No area shall be cleared without the permission of the developer.
13. All grades shall be within 0.2 feet (more or less) of those shown on the grading plan.
14. No slope shall be greater than 3:1 and shall be either sodded or seeded and mulched.
15. Hazard markers will consist of three (3) standard specification, "Mount on Uniform Traffic Control Devices," end of roadway markers mounted on two (2) pound "U" channel sign post. Each marker shall consist of an eighteen (18) inch diamond reflectorized red panel. The bottom of each panel shall be mounted a minimum of four (4) feet above the elevation of the pavement surface.
16. All manhole and curb inlet tops built without elevations furnished by the engineer shall be the responsibility of the sewer contractor. At the time of construction stake-out of the sewer lines, all curb and grade inlets shall be fully staked. If normal face stakes fail in line with sewer construction, the Engineer will set these stakes on a double offset. It shall be the responsibility of the sewer contractor to preserve all face stakes from destruction.
17. All standard street curb inlets to have front of inlet 2 feet behind curb.
18. The minimum vertical distance from the low point of the basement to the heading of a sanitary sewer of the corresponding house connection shall not be less than the diameter of the sanitary sewer plus a vertical distance not less than two and one-half feet (2-1/2').
19. Water lines, valves, sleeves, meters and etc., shall meet all specifications and installation requirements of the local governing authority.
20. All cast iron pipe for water mains shall conform to A.W.W.A. specification C-106 and/or C-108. The cast iron fittings shall conform to A.W.W.A. specification C-110. All rubber gasket joints for water cast iron pressure pipe and fittings shall conform to A.W.W.A. specification C-111.
21. All water hydrants and valves shall be cast iron and installed in accordance with plans and details.
22. All sanitary and storm sewers shall meet all specifications and installation requirements of the local governing authority.
23. All PVC water pipe shall have a minimum pressure rating of PR-200 or SDR-21.
24. All cast sanitary sewer pipe shall be DR-35 or equal with crushed stone bedding uniformly graded between 1" and 1/4" size. This bedding shall extend from 6" below the pipe to 12" above the top of the pipe.
25. All grading on Missouri State Highway Right-of-Way shall be seeded and mulched and of disturbed Right-of-Way markers shall be re-set at the completion of grading.
26. All streets must meet the specifications and installation requirements of the City of O'Fallon.
27. All sanitary manhole top shall be set 0.2' higher than the proposed ground except in pavement areas.
28. All sanitary manholes shall have a 31 mil thick coat of coal tar pitch waterproofing.
29. All sanitary service lines shall have a 6" diameter for Multi-family and a 4" diameter for Single-family developments.
30. Manhole frame and cover shall be Clay and Bolley No. 2008 or Heinz R-4736 or Dealer 1315 or approved equal.
31. A drop of 0.2 feet is required through each sanitary manhole.
32. The City of O'Fallon shall be notified of least 48 hours prior to construction of sanitary sewers for coordination and inspection.
33. Brick shall not be used on manholes.
34. ~~Sewer contractor shall maintain 24'-vertical separation--between all storm sewers and the sewage force main--contractor shall be responsible for verifying separation--prior to storm sewer installation.~~
35. Waterproofing: Waterproofing will be required on the exterior of all manholes. The bitumen shall consist of ten coats of asphalt, coal-tar pitch, or a coating meeting American Society for Testing and Materials (ASTM) D-41 specification. Coats shall conform to the requirements of ASTM D-448. Coal-tar pitch shall conform to the requirements of ASTM D-450. Coating shall be 31 mils thickness.
36. The grading and elevations shown on the grading plans are for construction purposes only. Finished grades and slopes will vary from those shown on the plans depending upon the location, site and type of house built on the lot. However, care should be taken to insure that finished grading conforms to drainage area maps.
37. THIS TRACT IS SERVED BY
 - UNION ELECTRIC
 - O'FALLON
 - ST. CHARLES GAS
 - CITY OF O'FALLON SEWERS
 - ST. CHARLES COUNTY WATER DISTRICT #2
 - O'FALLON FIRE DISTRICT
38. The collector road has been approved by the City of O'Fallon (8-80-83).
39. Per the City of O'Fallon, if a sanitary sewer line can not be installed on a lot line, a 10' wide basement shall be required.
40. All lots within the floodplain are required to have a basement finished floor elevation 1 foot above Floodplain elevation.
41. All sanitary and storm sewers shall be completed and in place by Phase 2.

This is to certify to [Signature] that these "As-Built" improvement plans are based on actual field surveys conducted during [Date] and the results are shown herein.

DANIEL EICHMANN, R.L.S. #2028
STATE OF MISSOURI
PIKETT, RAY & SILVER'S CORPORATE
REGISTRATION NO. LE-54-D

By [Signature]

PIKETT, RAY & SILVER, INC.

STATE OF MISSOURI
HAROLD J. BARTCH
NUMBER E-17751
PICKETT, RAY & SILVER, INC.
REGISTERED PROFESSIONAL ENGINEERS

PICKETT, RAY & SILVER, INC.

STATE OF MISSOURI
HAROLD J. BARTCH
NUMBER E-17751
PICKETT, RAY & SILVER, INC.
REGISTERED PROFESSIONAL ENGINEERS

PICKETT, RAY & SILVER, INC.

SEE SHEET 4

GENERAL NOTES

- Unless noted otherwise, all pavement is 26' wide concrete and all right-of-way is 50' wide.
- Typical street intersections: 37' pavement radius, 25' right-of-way radius.
- Typical cul-de-sacs: 40' pavement radius, 52' right-of-way radius.

NOTE:

Underground utilities and structures have been plotted from available information and therefore, their location must be considered approximate only. It is the responsibility of the individual contractors to notify the utility companies before actual construction.




GLEN EAGLE
FLAT PLAN

89-204

REV. 12-6-94, Job (Rev.)
REV. G-2-95 (86) PER CITY OF O'FALLOON CAMMENTS

PROP. N/E
FORT ZUMWALT SCHOOL DIST.

SEE PREVIOUSLY APPROVED COLLECTOR ROAD PLANS

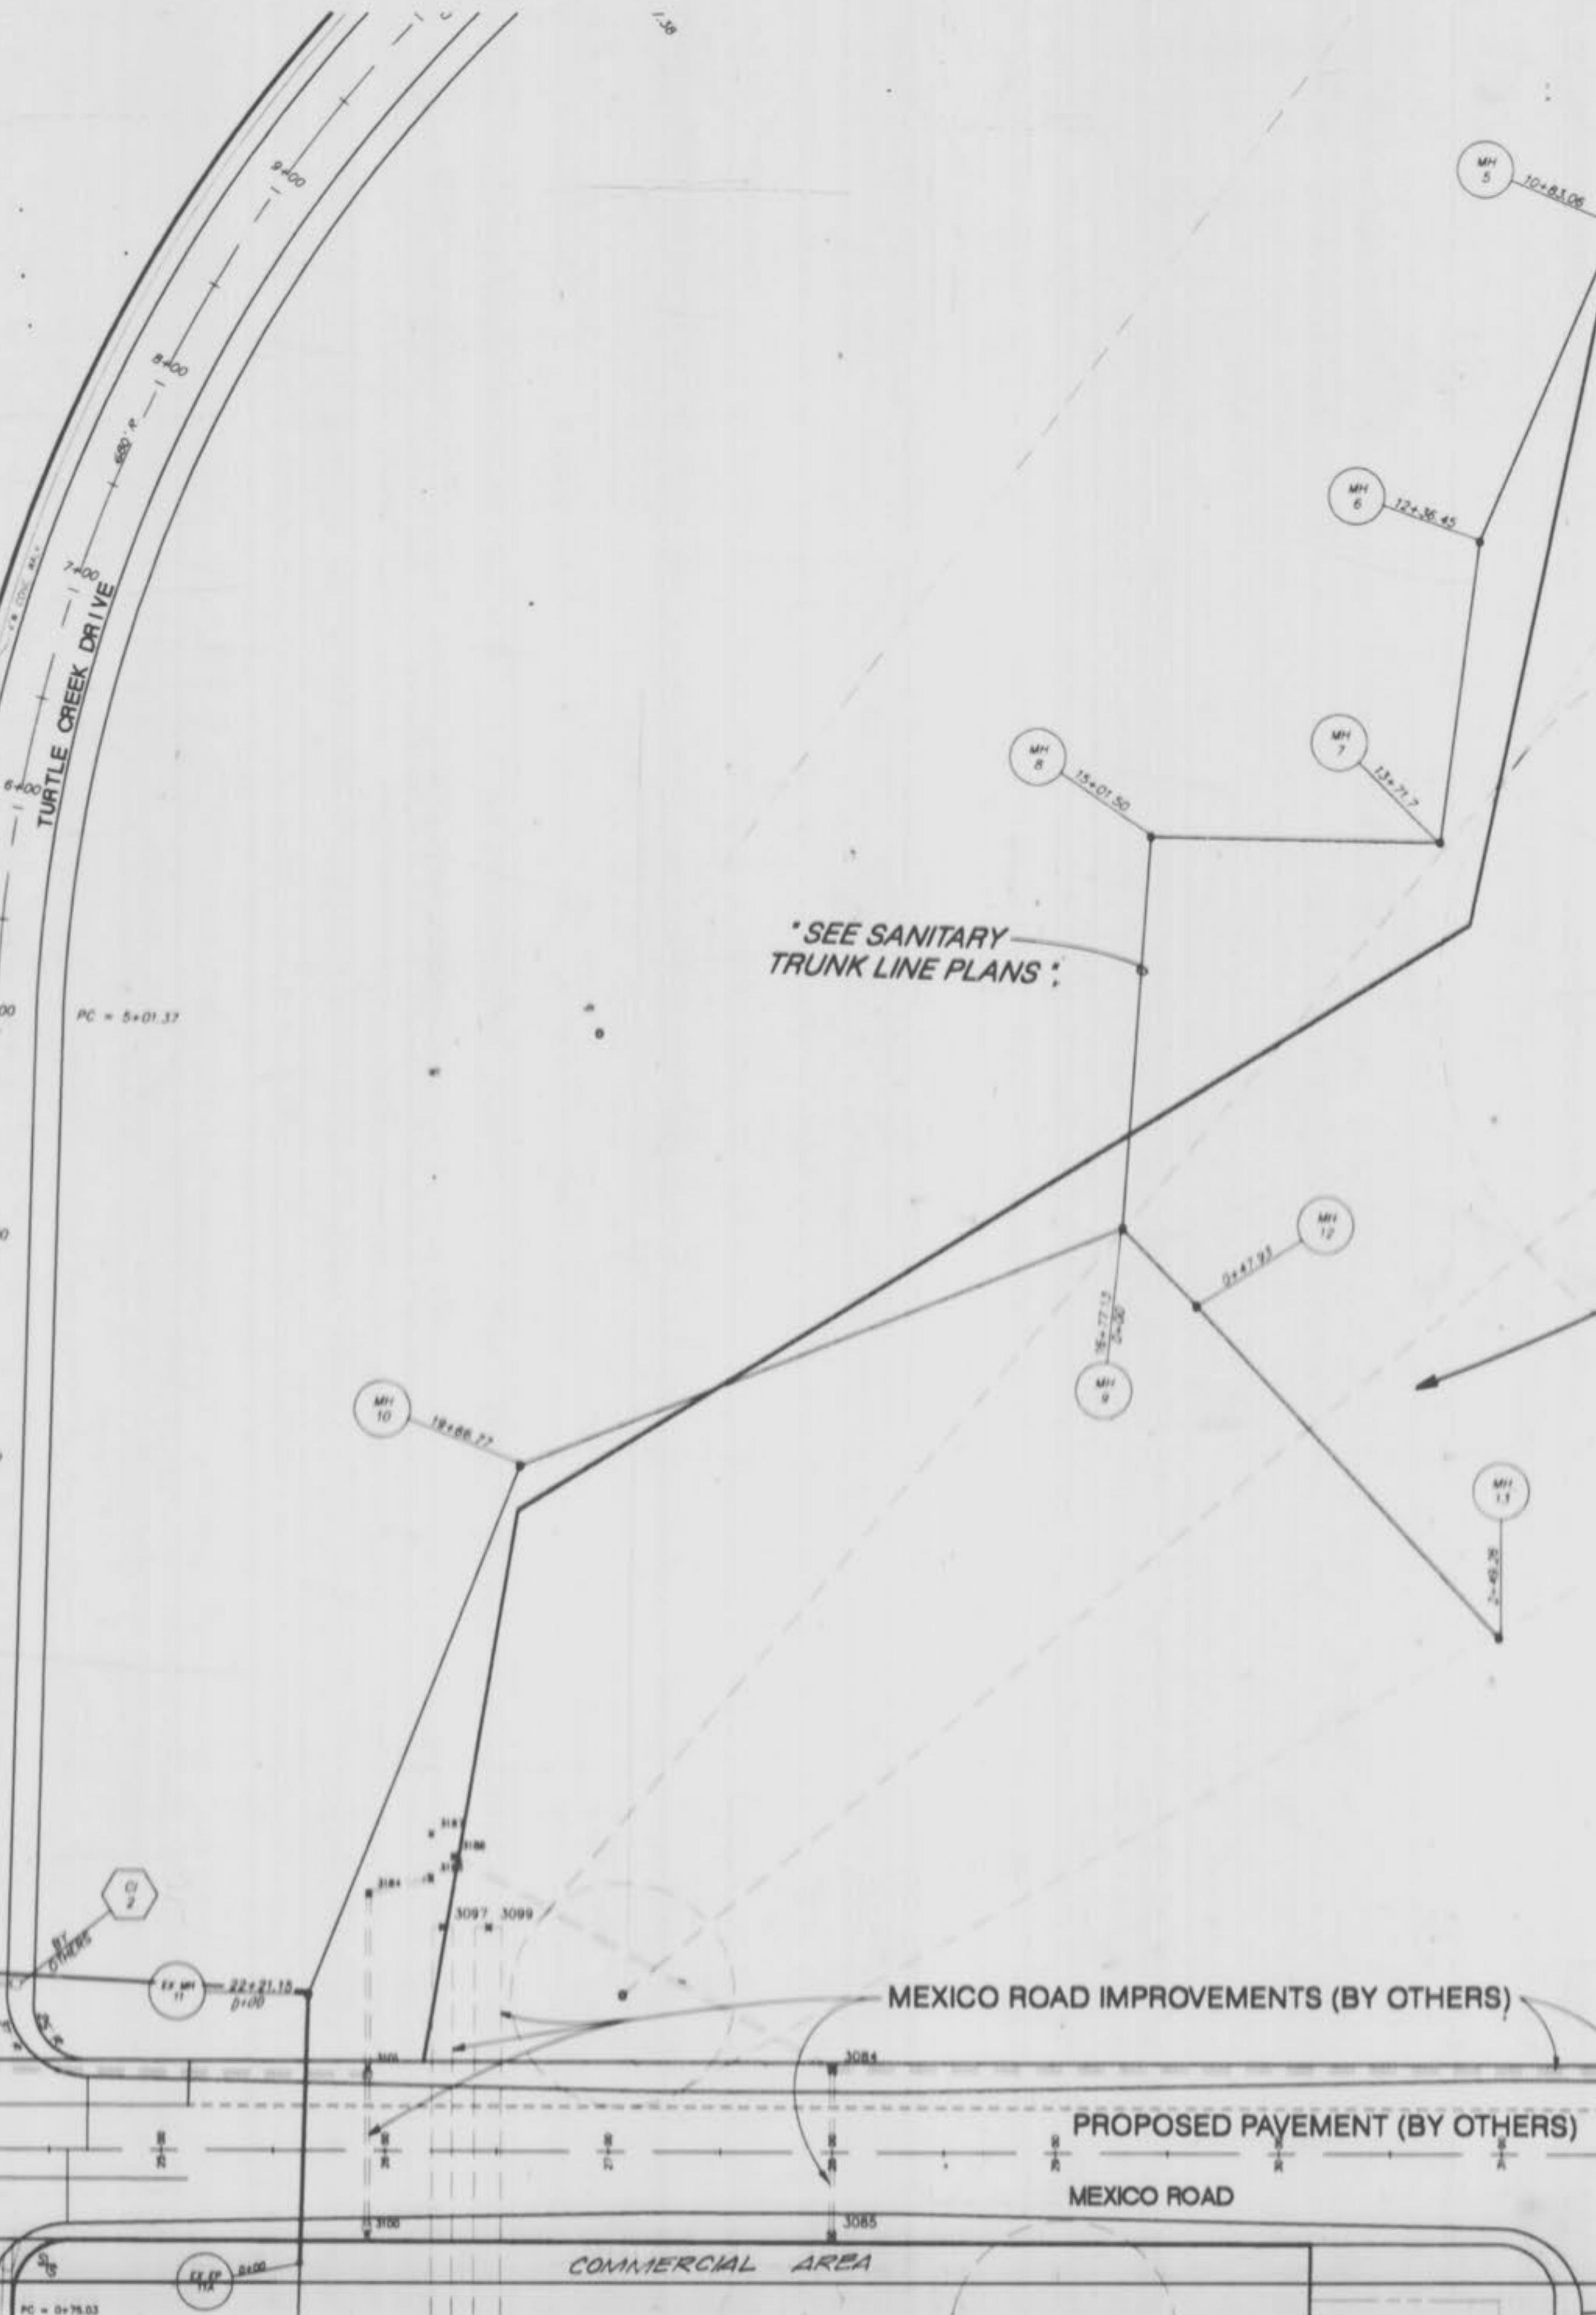

MEXICO ROAD IMPROVEMENTS (BY OTHERS)

PROPOSED PAVEMENT (BY OTHERS)

COMMERCIAL AREA

600000

500000

400000

300000

200000

100000

0

100000

200000


9900000

10000000

18

12

SEE GOLF COURSE PLANS
(BY OTHERS)

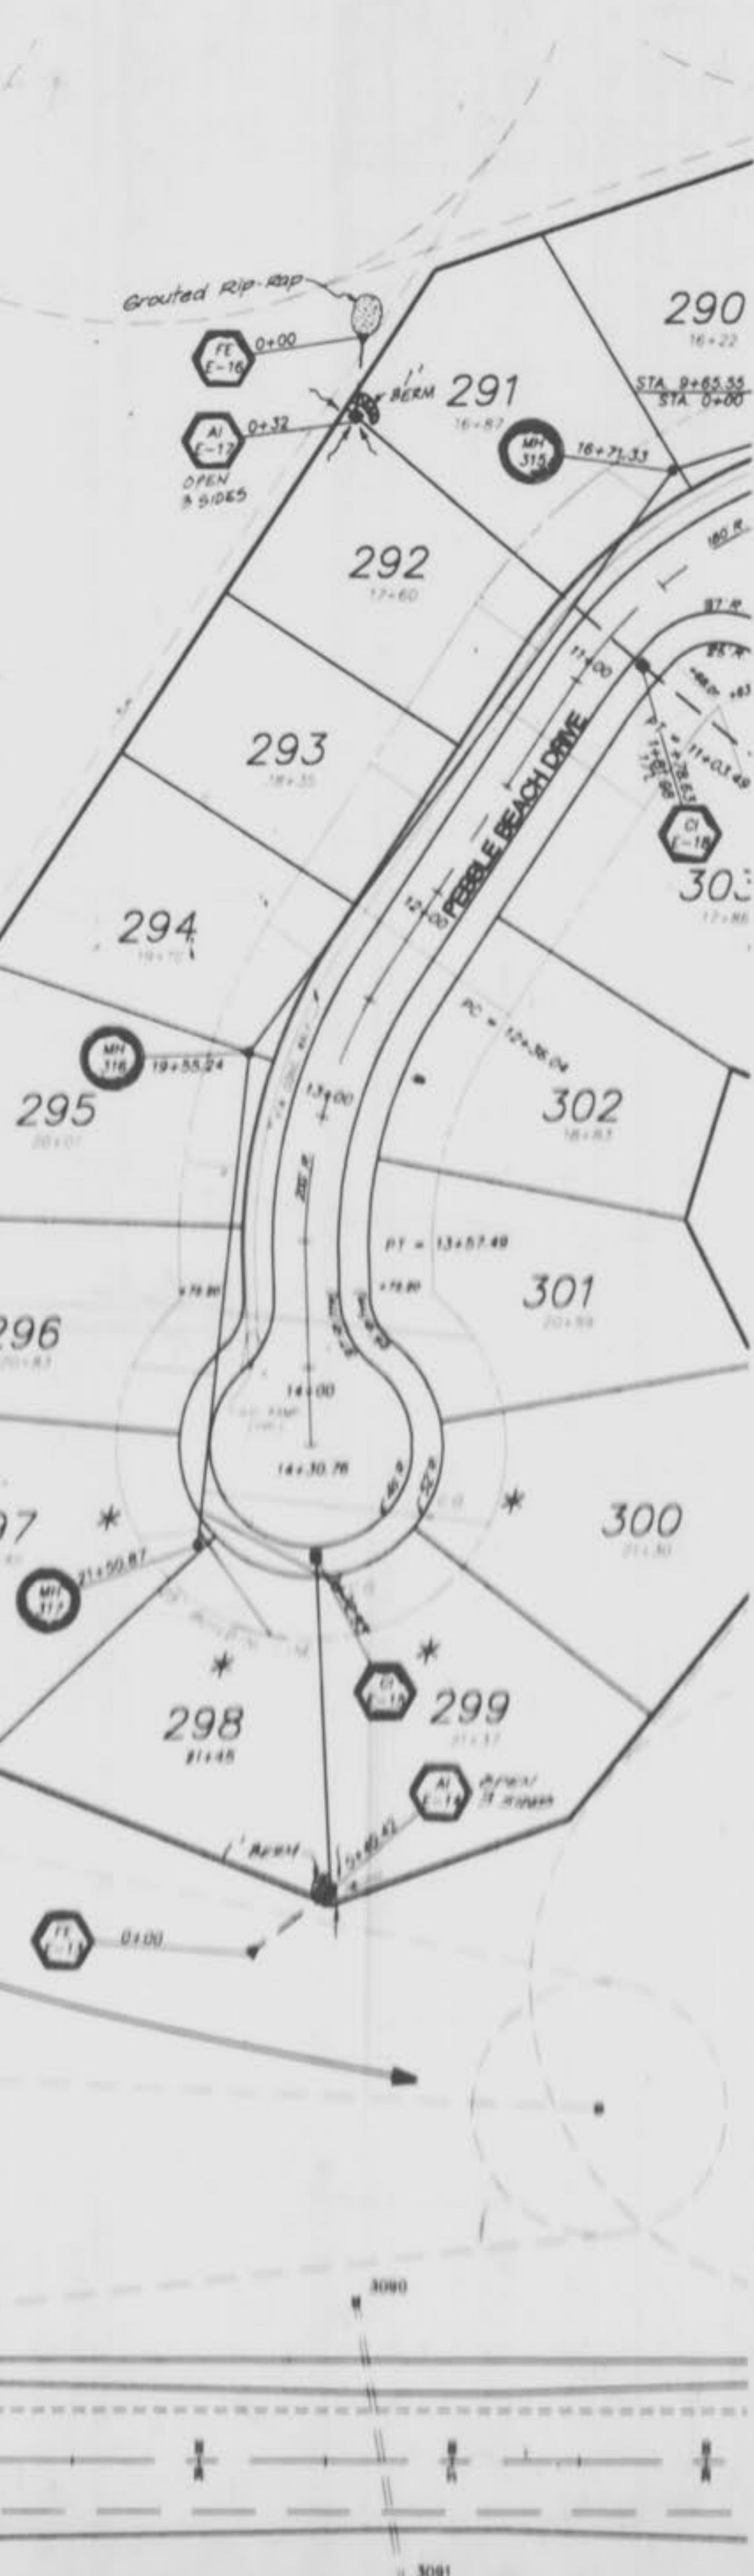

2
66

AS-BUILT TURTLE CREEK
PLAT 6 Glen Eagle

SEE SHEET 3

SEE SHEET 5

GENERAL NOTES

- Unless noted otherwise, all pavement is 26' wide concrete and all right-of-way is 50' wide.
- Typical street intersections: 37' pavement radius, 25' right-of-way radius.
- Typical cul-de-sacs: 40' pavement radius, 52' right-of-way radius.

GRAPHIC SCALE

(IN FEET)

1 inch = 50 ft.

GLEN EAGLE
FLAT PLAN


AUG. 1984

89-204

Rev. 126 94 (Pub.)

Rev. 2-10-95 L.S./J.L.

Rev. G-2-95 L.S./S. PER CITY OF O'FALLON COMMENTS

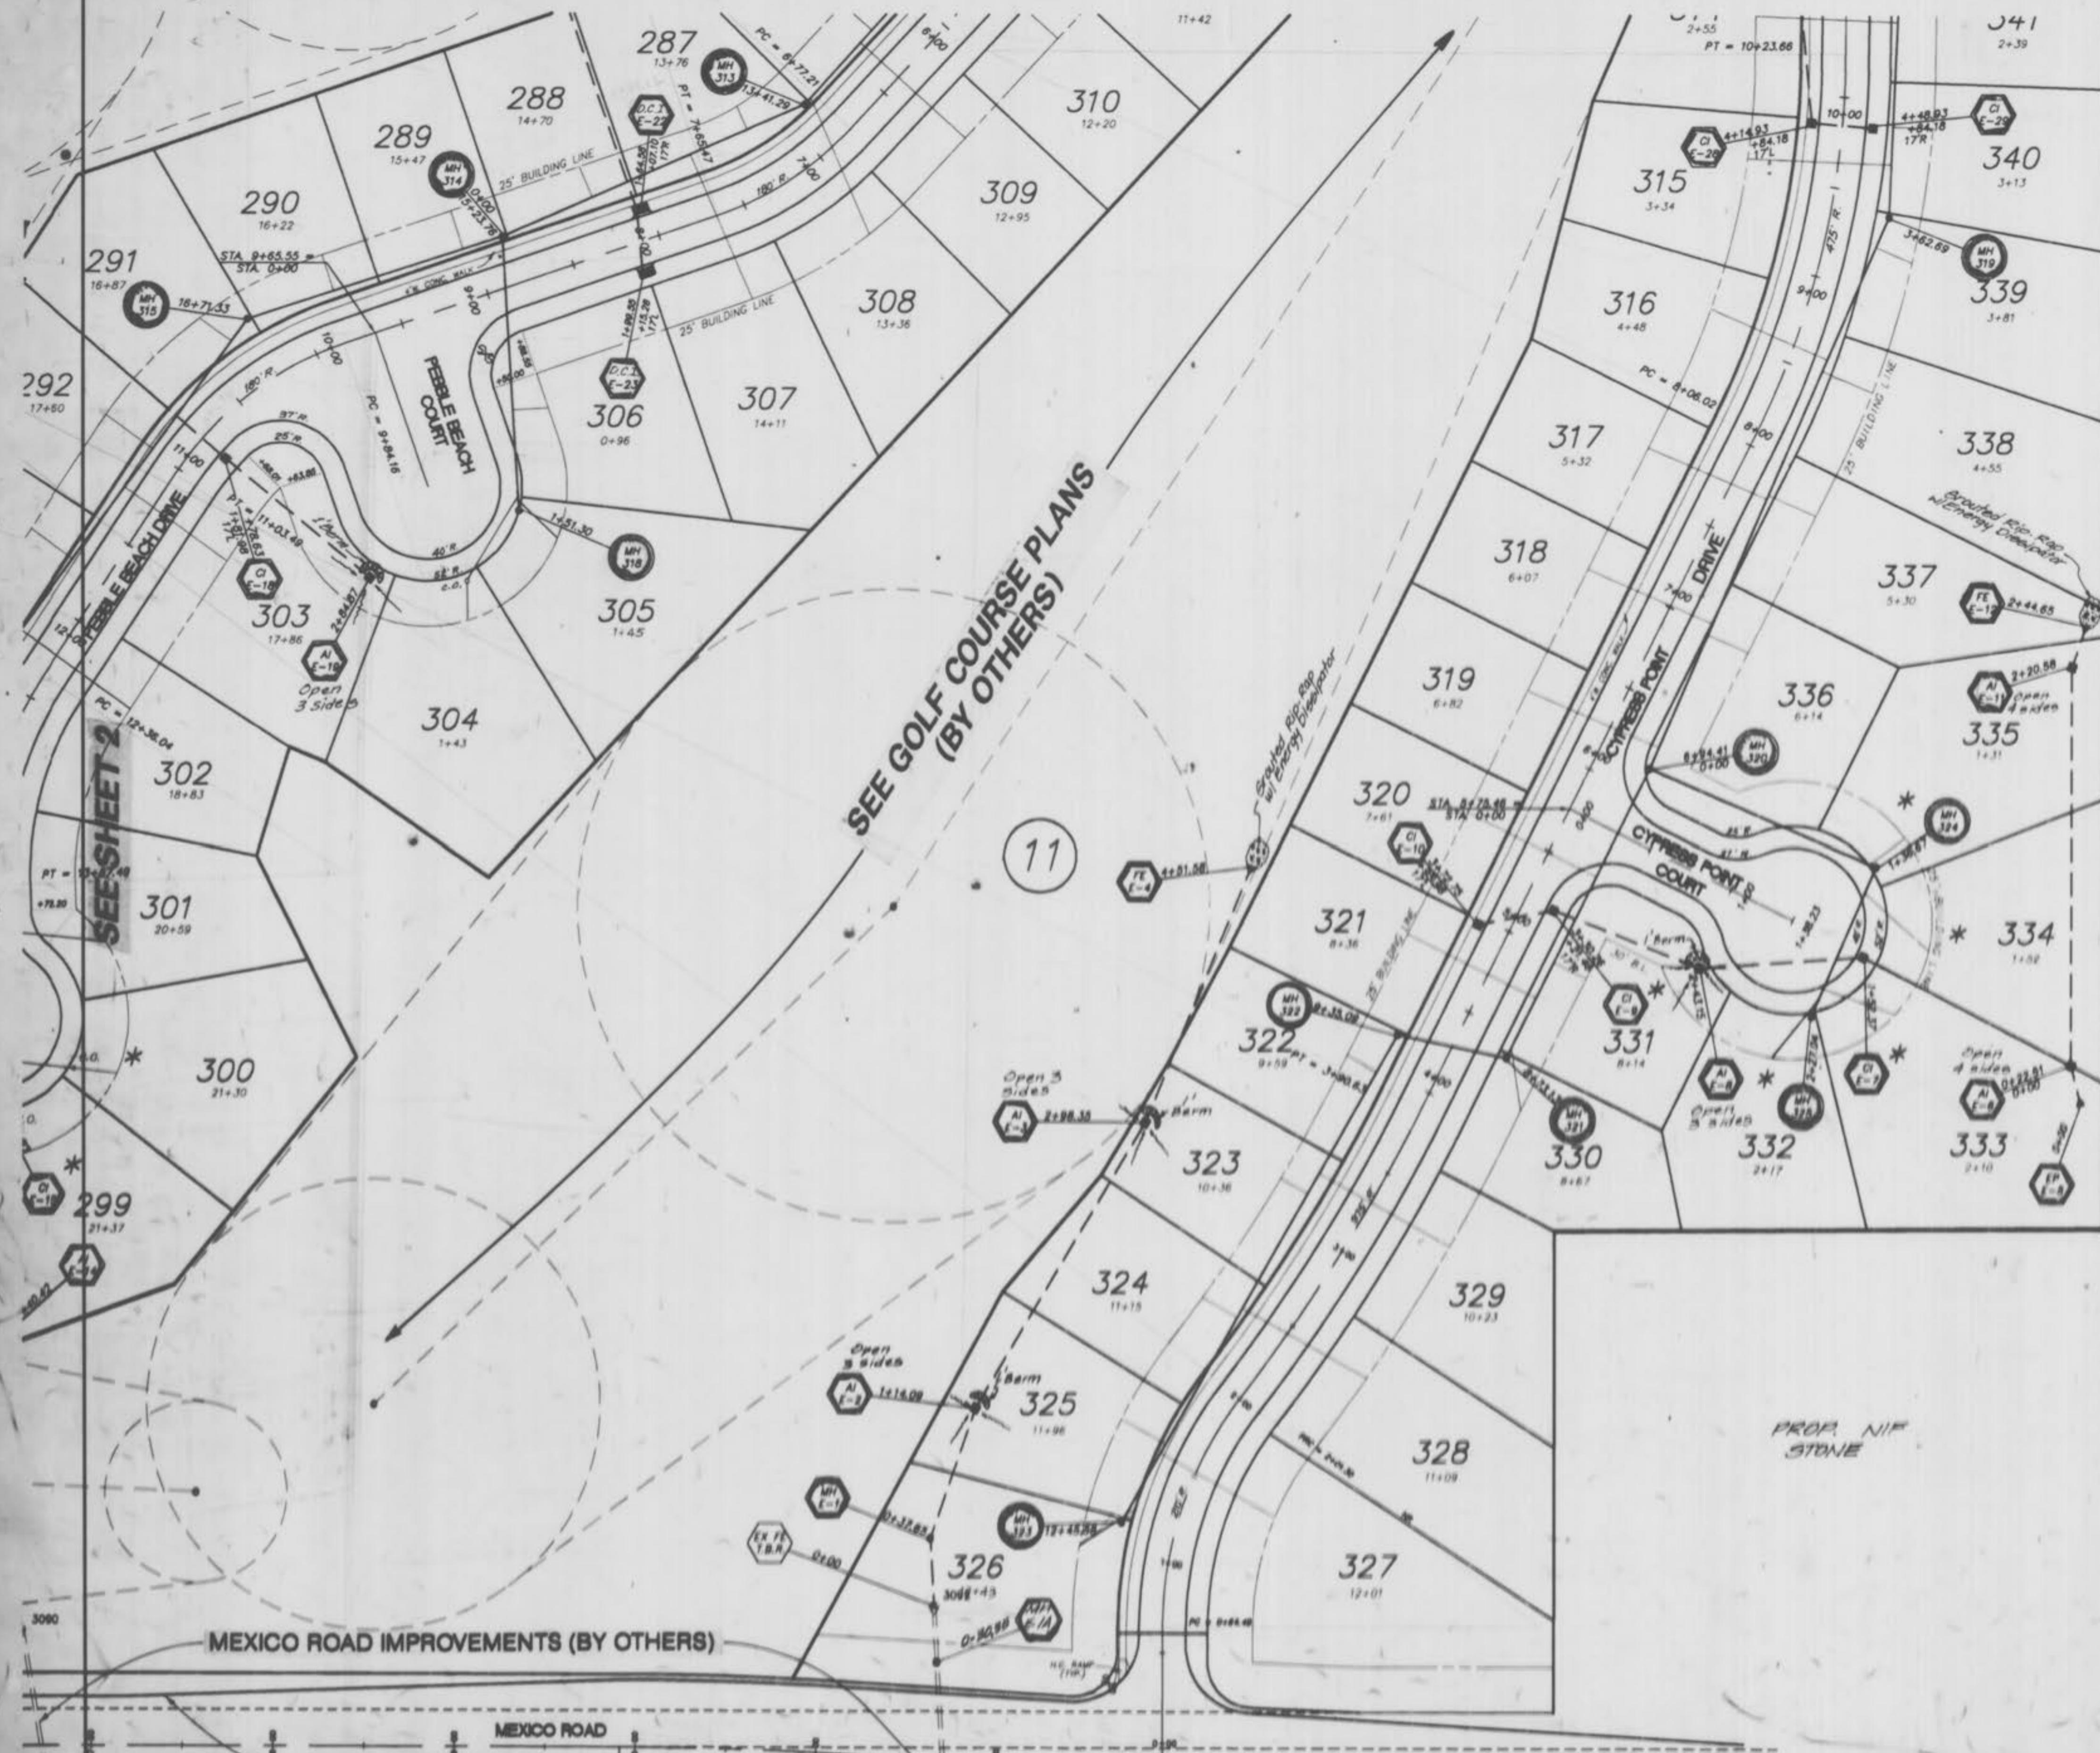PROP. N/F
STONEPROP. N/F
HEPPERMANN

NOTE:
Underground utilities and structures have been plotted from available information and therefore, their location must be considered approximate only. It is the responsibility of the individual contractors to notify the utility companies before actual construction.

AS-BUILT DRAWING CHECKED
Glen Eagle

PROP. NJF
FORT ZUMWALT SCHOOL DIST.

SEE SHEET 8

GENERAL NOTES
1. Unless noted otherwise, all pavement is 26' wide concrete
and all right-of-way is 50' wide.
2. Typical street intersections: 37' pavement radius, 25'
right-of-way radius.
3. Typical cul-de-sacs: 40' pavement radius, 52' right-of-
way radius.

NOTE:
Underground utilities and structures have
been plotted from available information and
therefore, their location must be considered
approximate only. It is the responsibility
of the individual contractors to notify the
utility companies before actual construction.

GRAPHIC SCALE
50 0 50 100
(IN FEET)
1 inch = 50 ft

GLEN EAGLE
FLAT PLAN
89-204
AUG. 1984
Rev. 126 94-108

50

0

50

100

SEE SHEET 5

SEE SHEET 2

SEE PREVIOUSLY APPROVED COLLECTOR ROAD PLANS
TURTLE CREEK DRIVE

SEE SANITARY
TRUNK LINE PLANS

SEE GOLF COURSE PLANS
(BY OTHERS)

66
AS-BUILT
Glen Eagle
Turtle Creek
Plat 6

SEE SHEET 9

GRAPHIC SCALE
(IN FEET)
1 inch = 50 ft.

**GLEN EAGLE
FLAT PLAN**

AUG. 1994

89-204

Rev. 12-6-94 Th
Rev. 2-10-95 LSS/Th
Rev. 7-27-95 LSS
Rev. 9-13-95 LSS, per City of O'Fallon
Comments:

GENERAL NOTES

- Unless noted otherwise, all pavement is 26' wide concrete and all right-of-way is 50' wide.
- Typical street intersections: 37' pavement radius, 25' right-of-way radius.
- Typical cul-de-sacs: 40' pavement radius, 52' right-of-way radius.


SEE SHEET 4

**SEE GOLF COURSE PLANS
(BY OTHERS)**

10

**SEE GOLF COURSE PLANS
(BY OTHERS)**

SEE SHEET 3

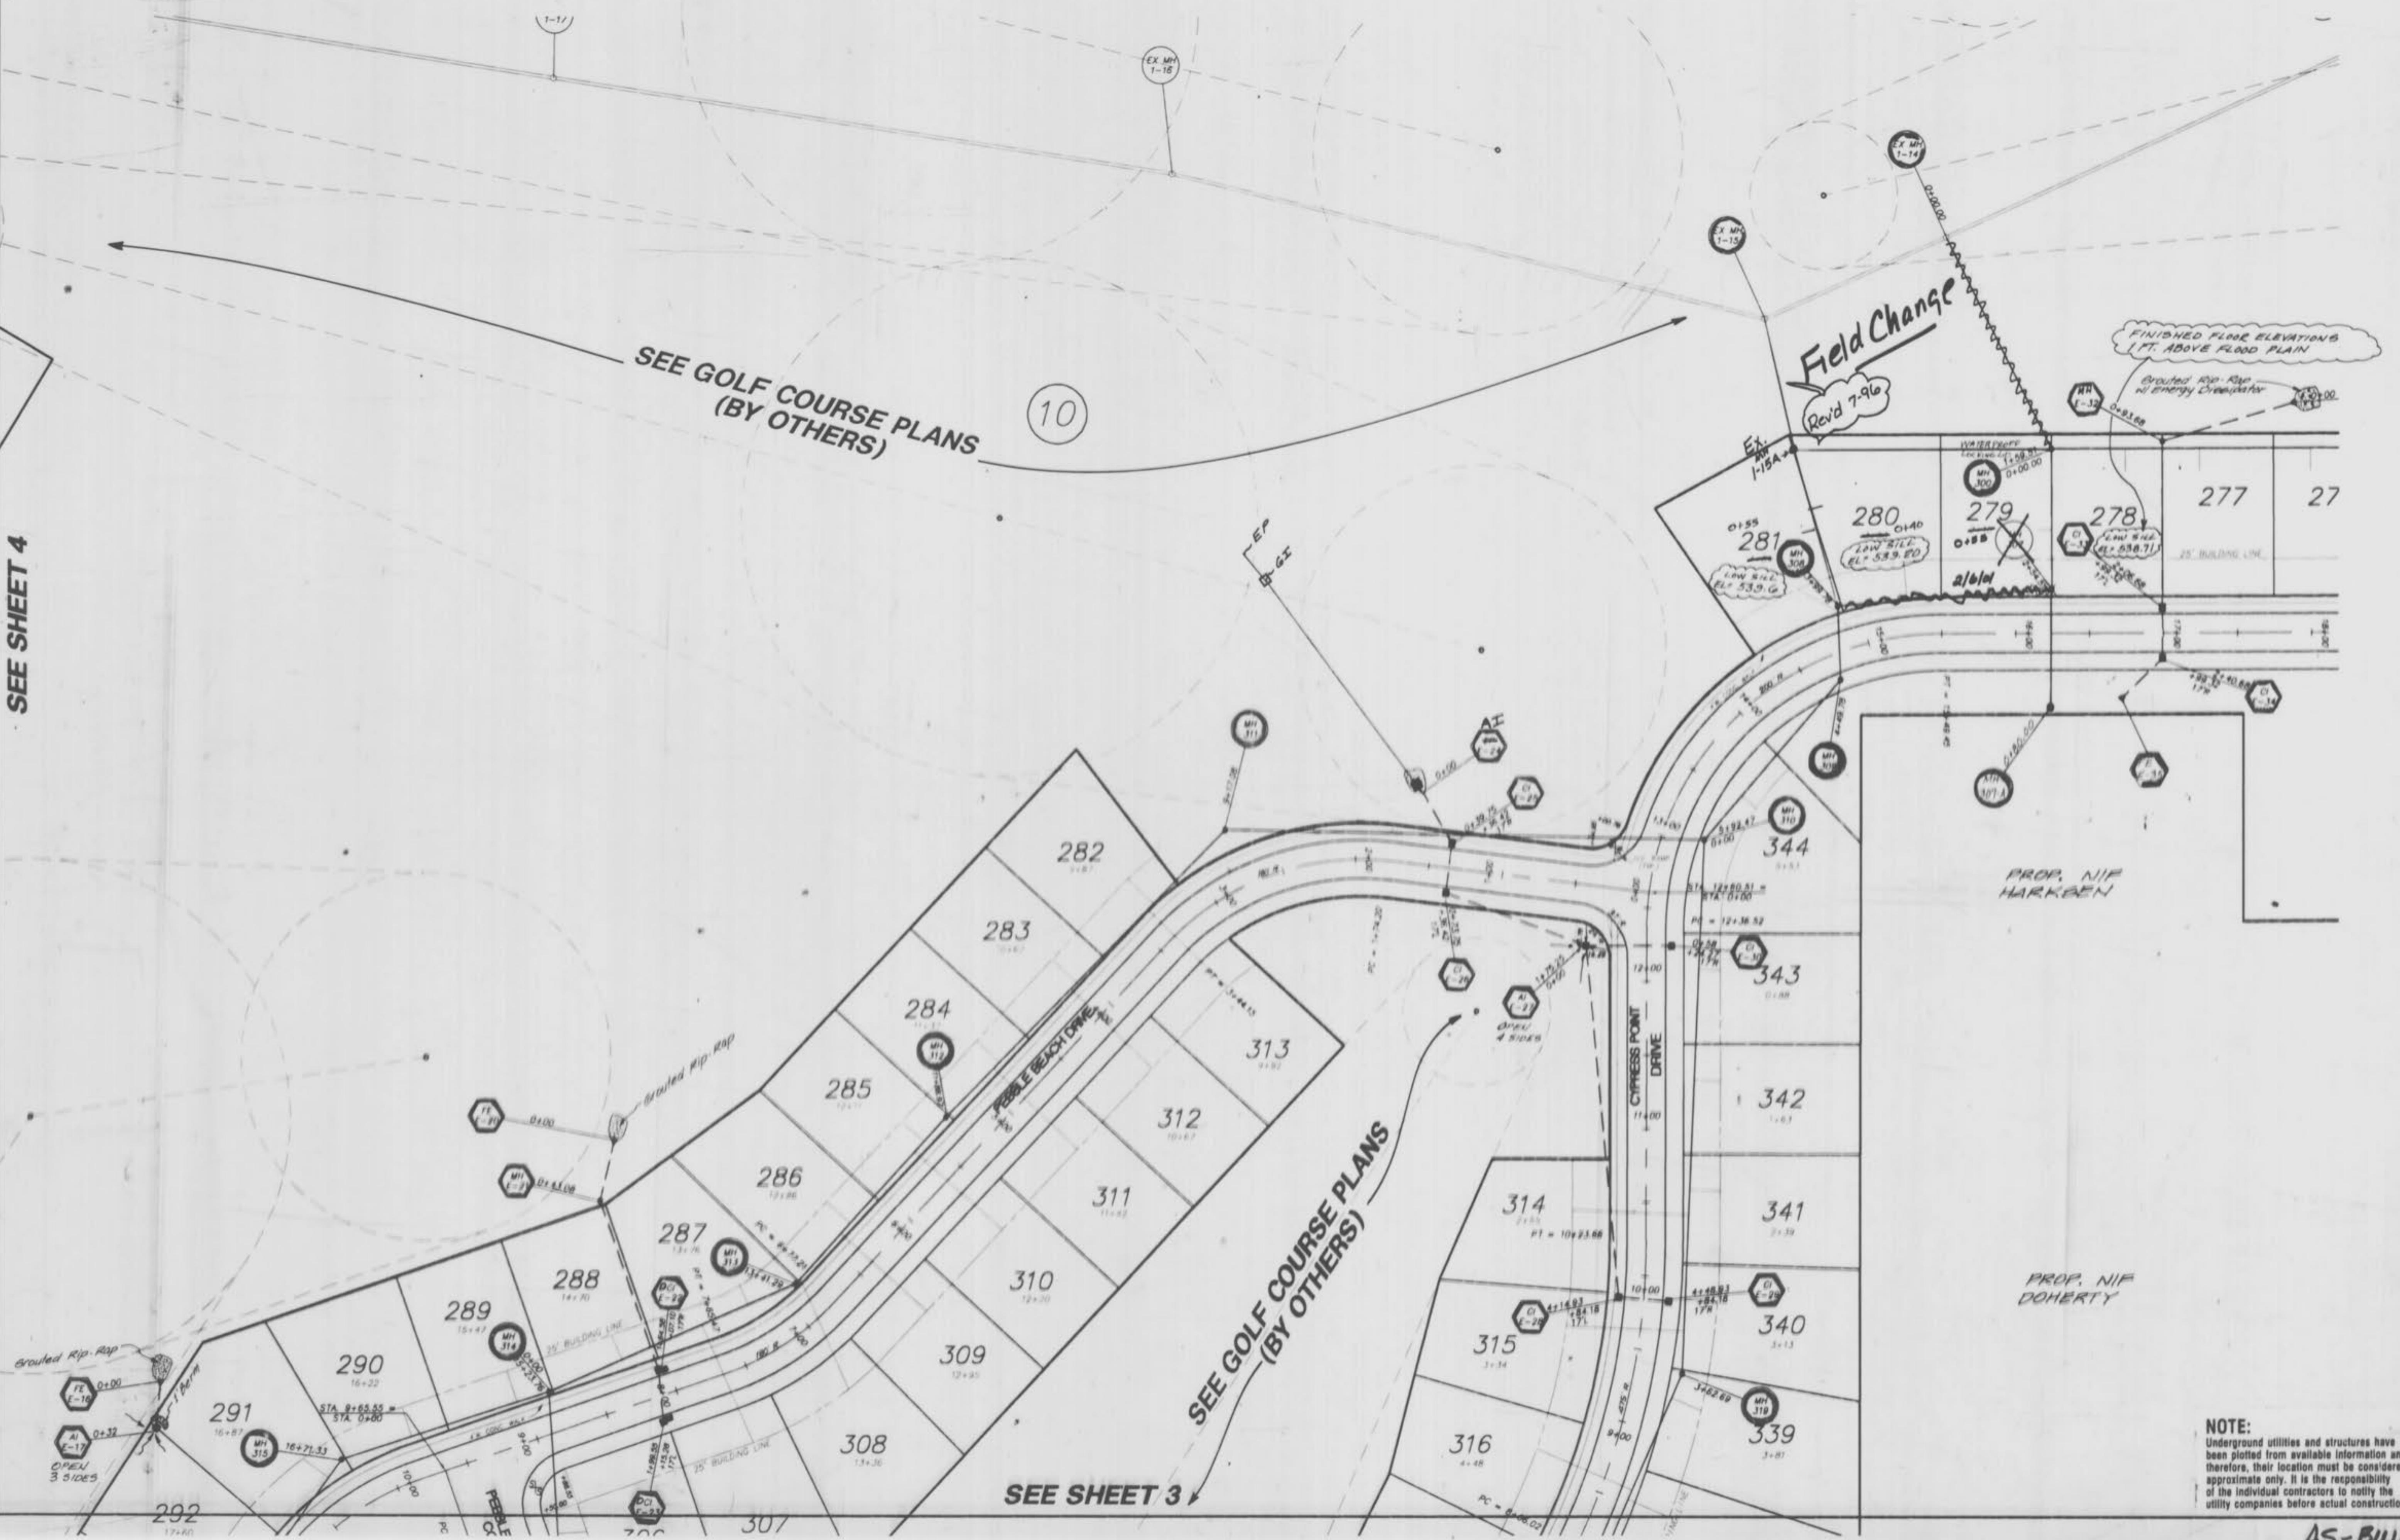

SEE SHEET 10

GRAPHIC SCALE
(IN FEET)
1 inch = 50 ft.

GLEN EAGLE
FLAT PLAN

AUG. 1994.


89-204

Rev. 9-26-94 L.S.S.
Rev. 12-6-94 T.D.
Rev. 6-2-95 L.S.S. per city of O'Fallon comments
Rev. 7-27-95 L.S.S.
Rev. 8-25-95 K.D.
Rev. 9-13-95 L.S.S. per city of O'Fallon comments

GENERAL NOTES

- Unless noted otherwise, all pavement is 26' wide concrete and all right-of-way is 50' wide.
- Typical street intersections: 37' pavement radius, 25' right-of-way radius.
- Typical cul-de-sacs: 40' pavement radius, 52' right-of-way radius.

**SEE GOLF COURSE PLANS
(BY OTHERS)**

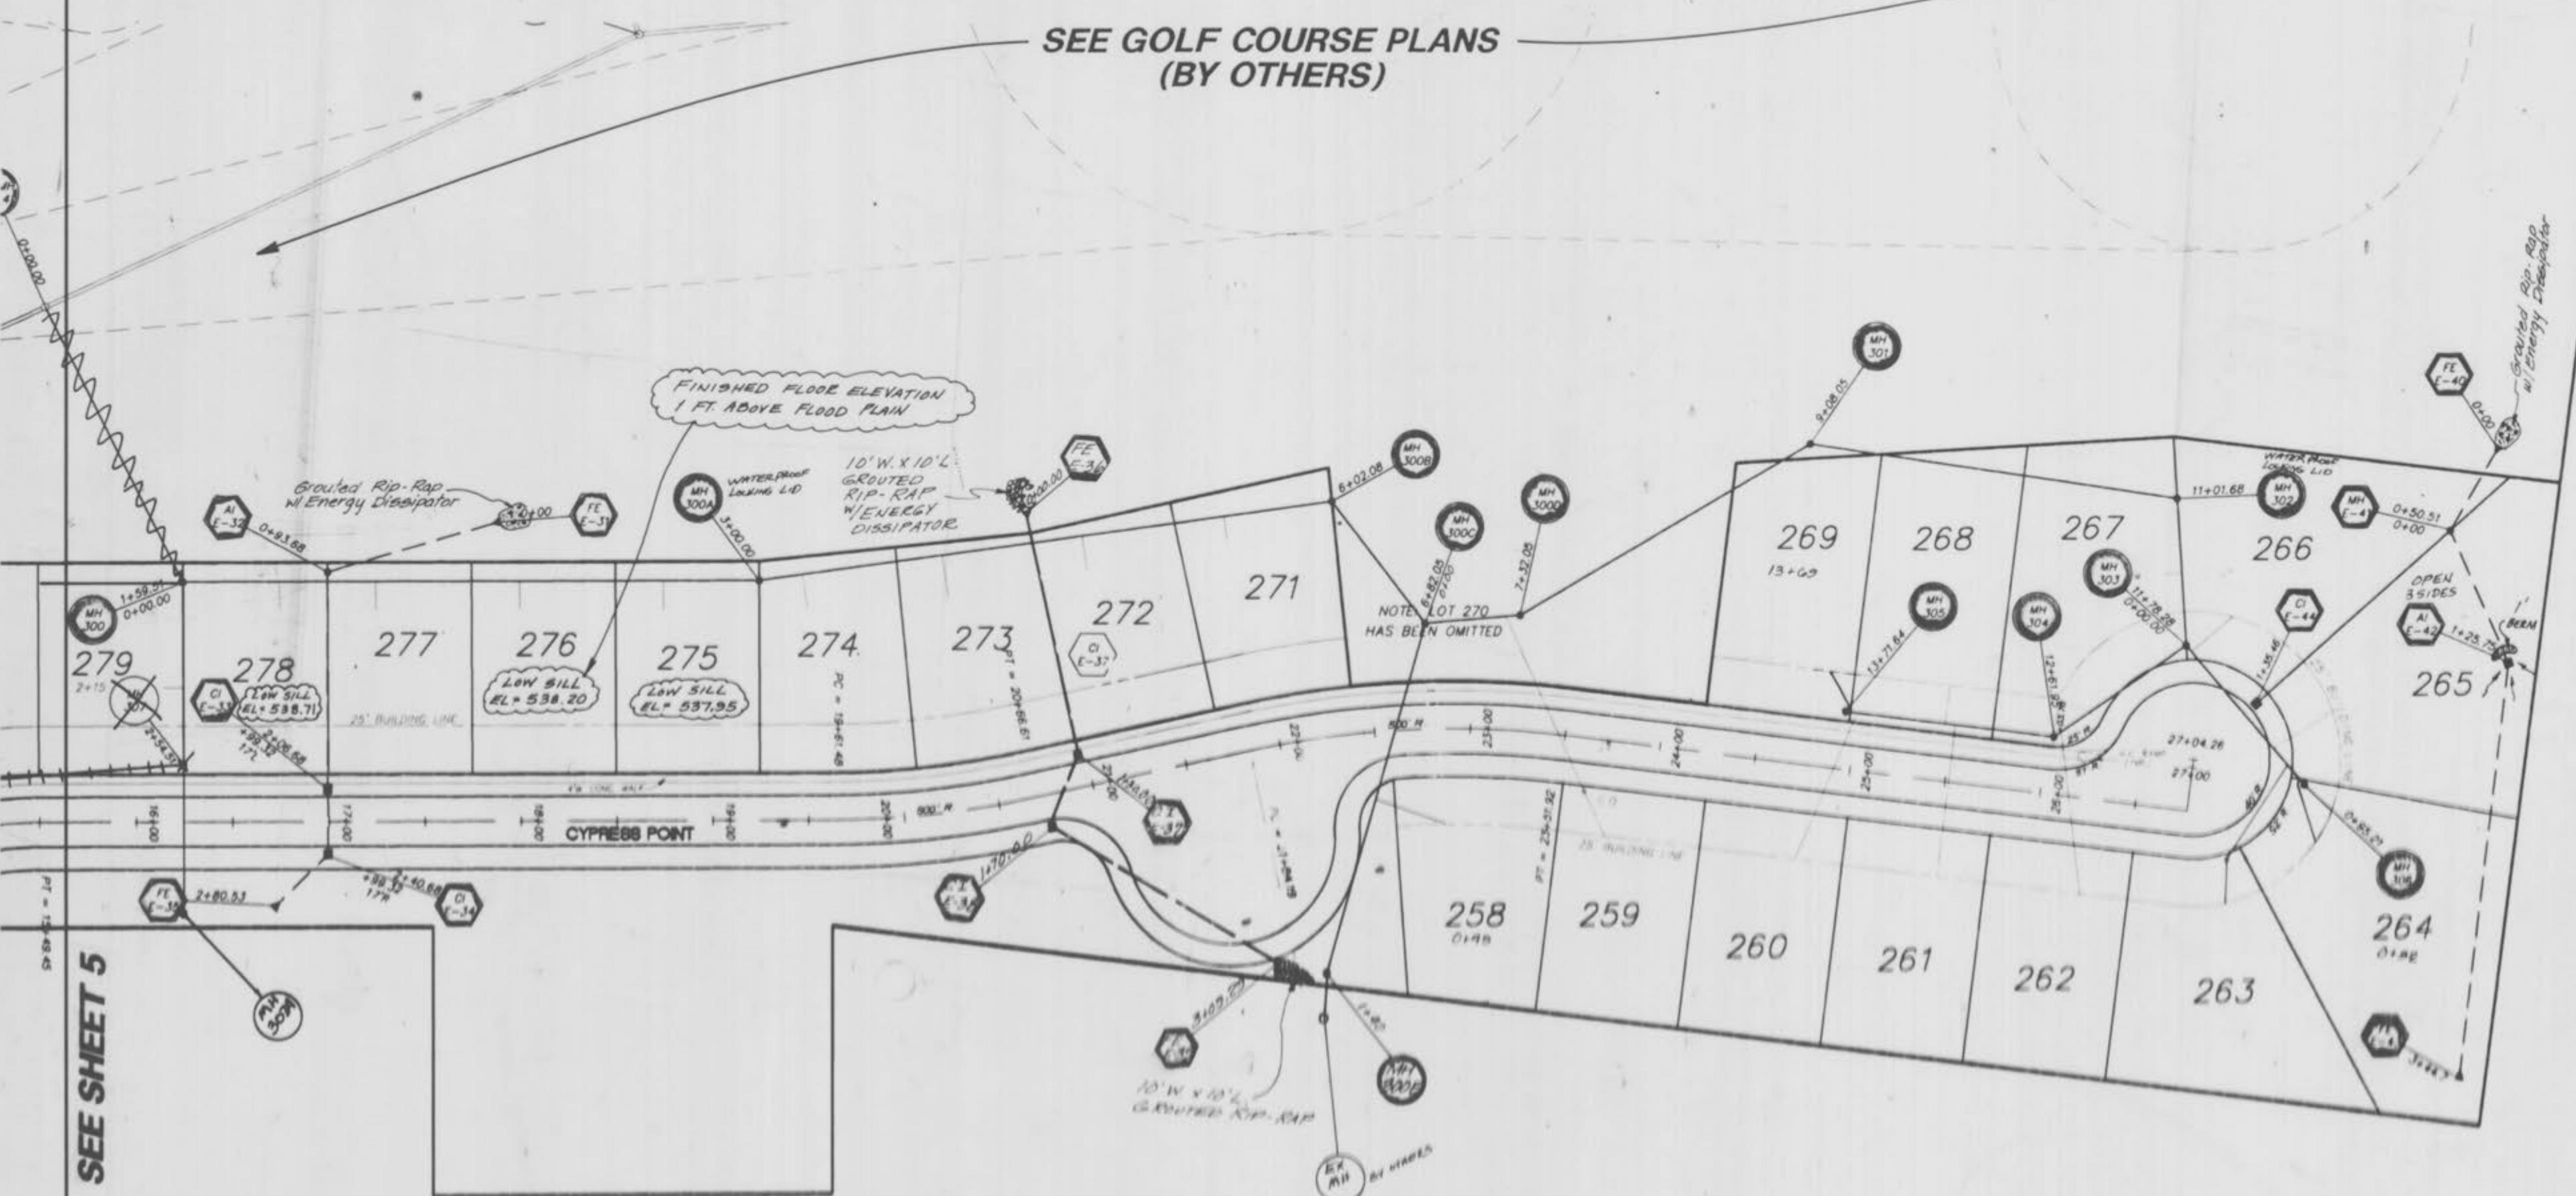

NOTE:

Underground utilities and structures have been plotted from available information and therefore, their location must be considered approximate only. It is the responsibility of the individual contractors to notify the utility companies before actual construction.



68

GLEN EAGLE
SANITARY SEWER PROFILES

AUG. 1994


89-204

SCALE
HORIZ: 1" = 50'
VERT: 1" = 10'

Rev. 12/6/92 TDS Sanit Est 261MB
Rev. 6/2/95 L-55 PER CITY OF
OAKLAND OWNERS
Rev. 6/14/95 TDS
Rev. 9/13/95 TDS
per City of OAKLAND comments

FINAL SURVEYED
SURVEY
NOTE BOOK PLOTTED
AREA CHECKED

ORIGINAL SURVEY
NOTICE BROKEN
NOTES CHECKED

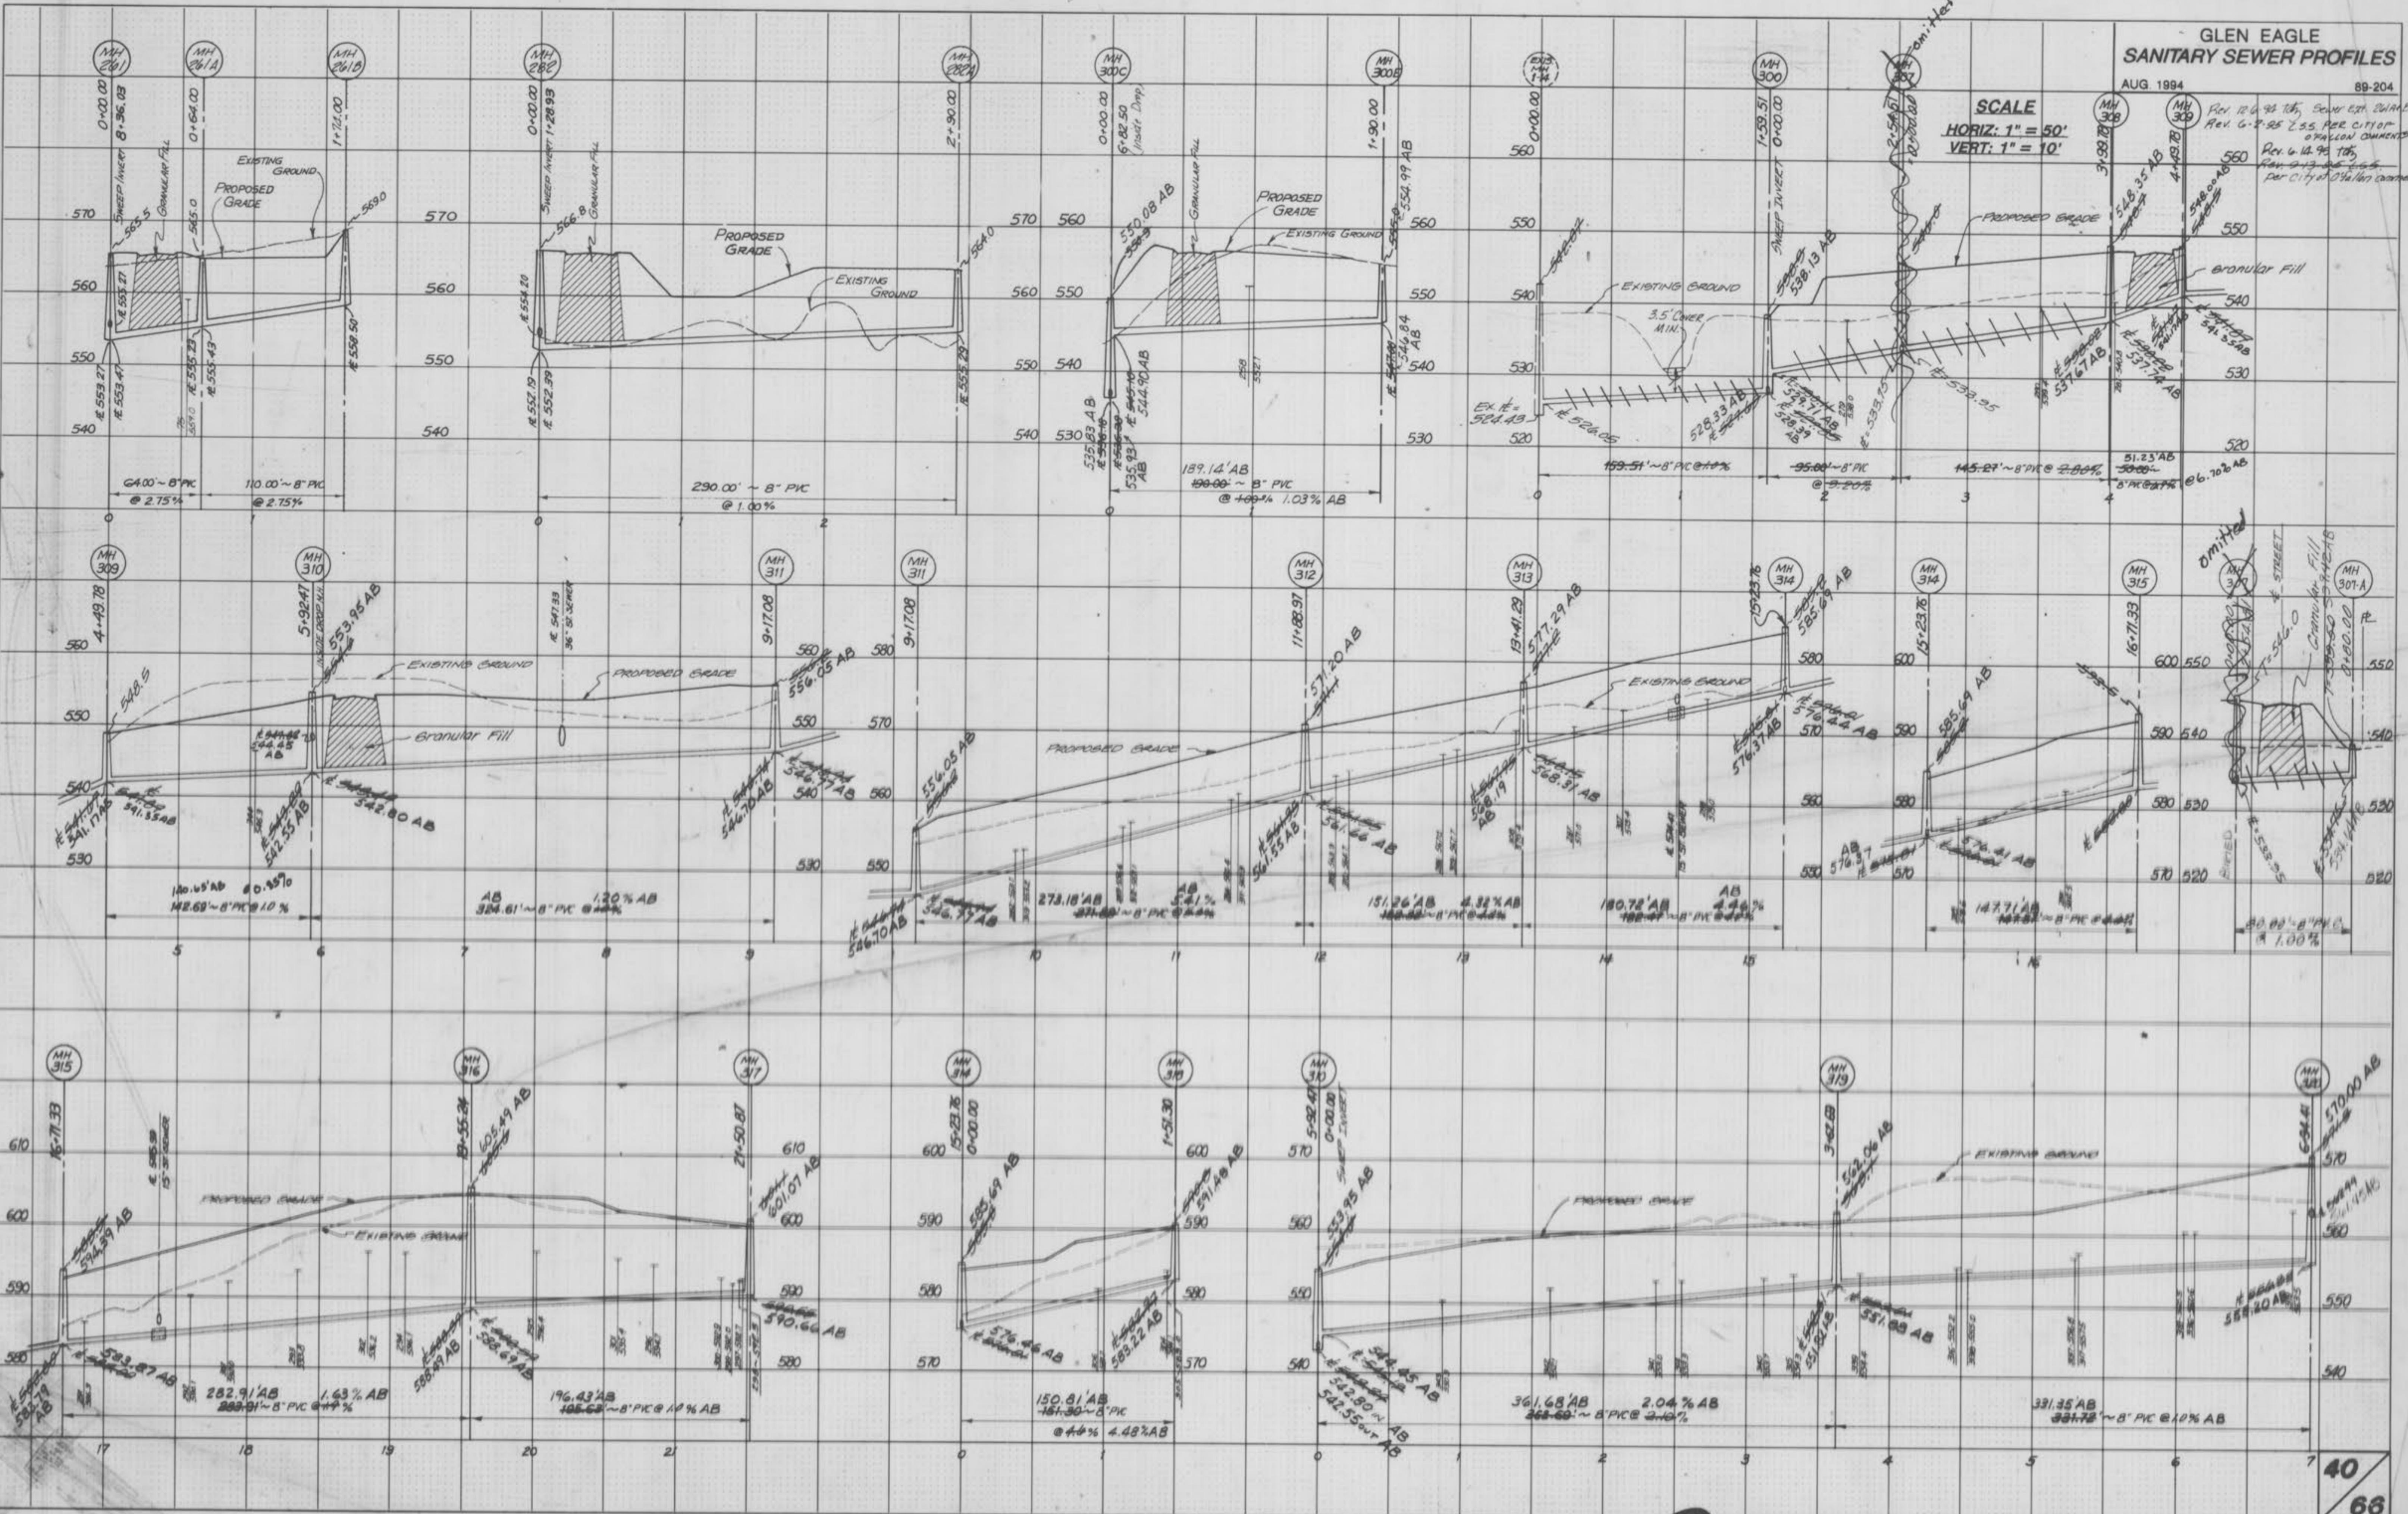


GLEN EAGLE
SANITARY SEWER PROFILES

AUG. 1994

89-204

REV. G-2 95 L.S.B. PER CITY OF O'FALLON COMMENTS

SCALE
HORIZ: 1" = 50'
VERT: 1" = 10'

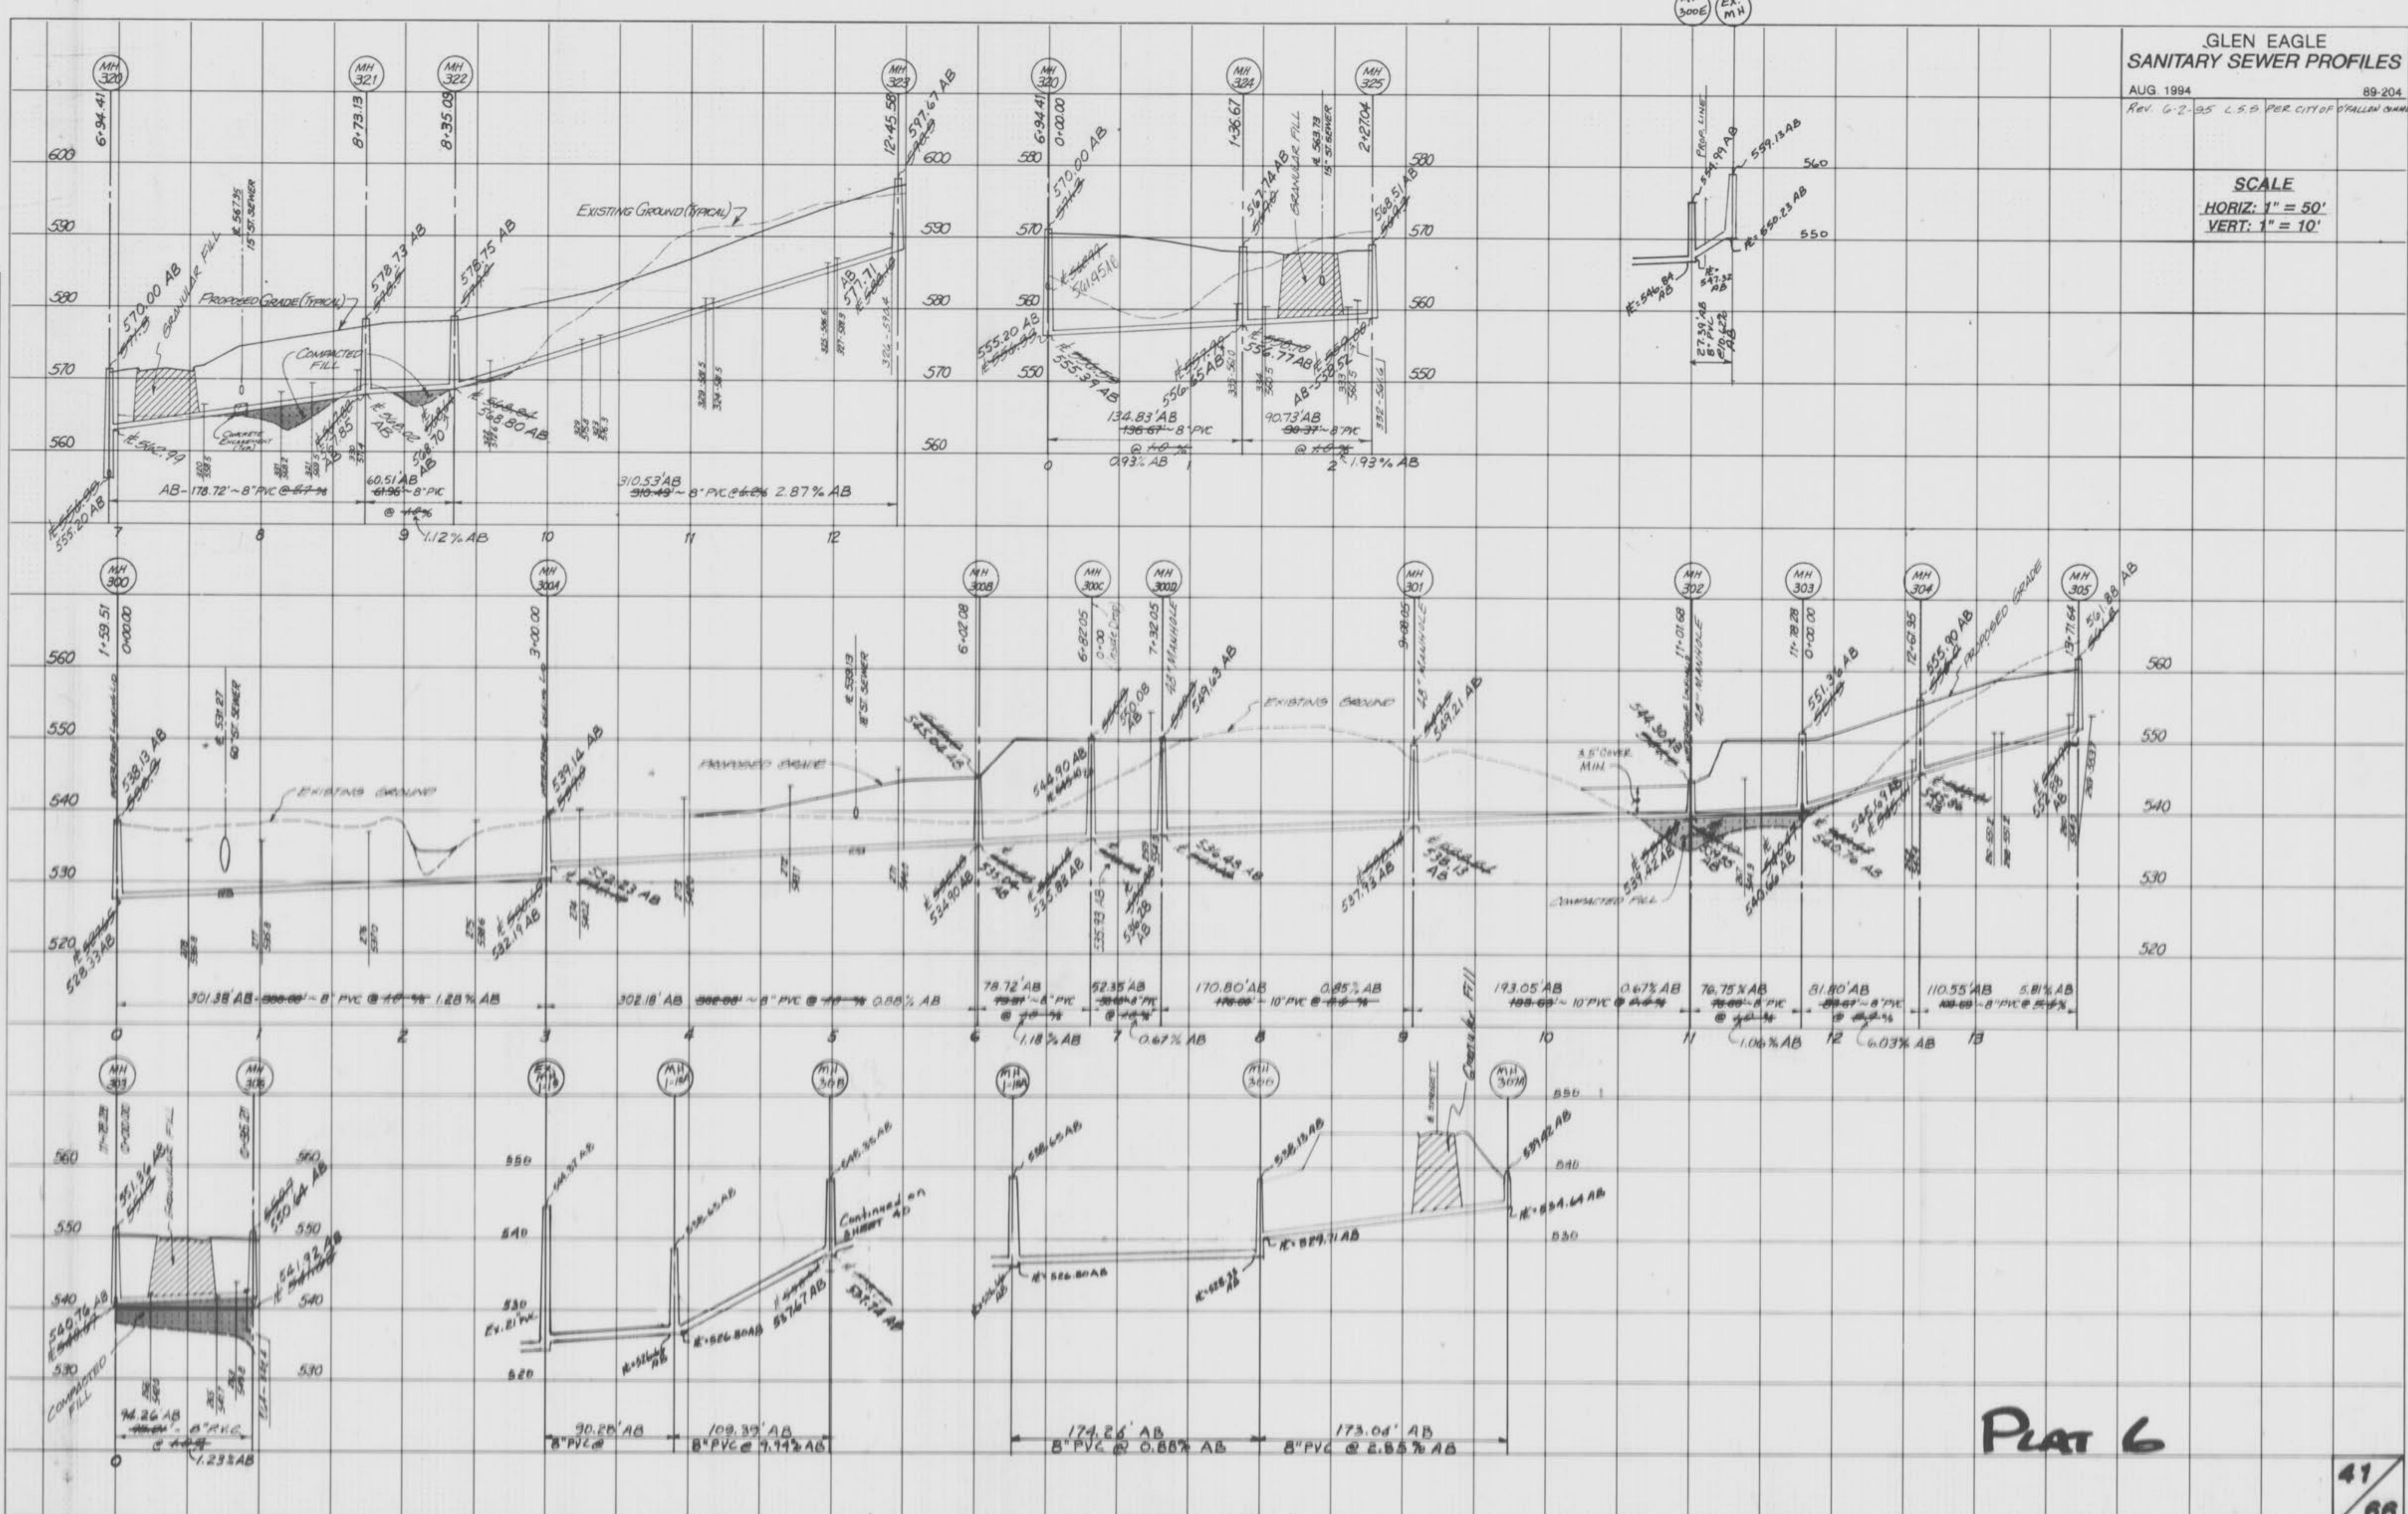

PLAT 6

41
68

"AB" - DENOTES AS-BUILT
ELEVATIONS & DISTANCES

GlenEagle

TURTLE CREEK
PLAT 6

AS-BUILT

GLEN EAGLE
STORM SEWER PROFILES

AUG. 1994


89-204

REV. 1-3-95 65
REV. 6-2-95 L65
REV. 9-13-95 L55 per City of O'Fallon comments

SCALE

HORIZ: 1" = 50'

VERT: 1" = 10'

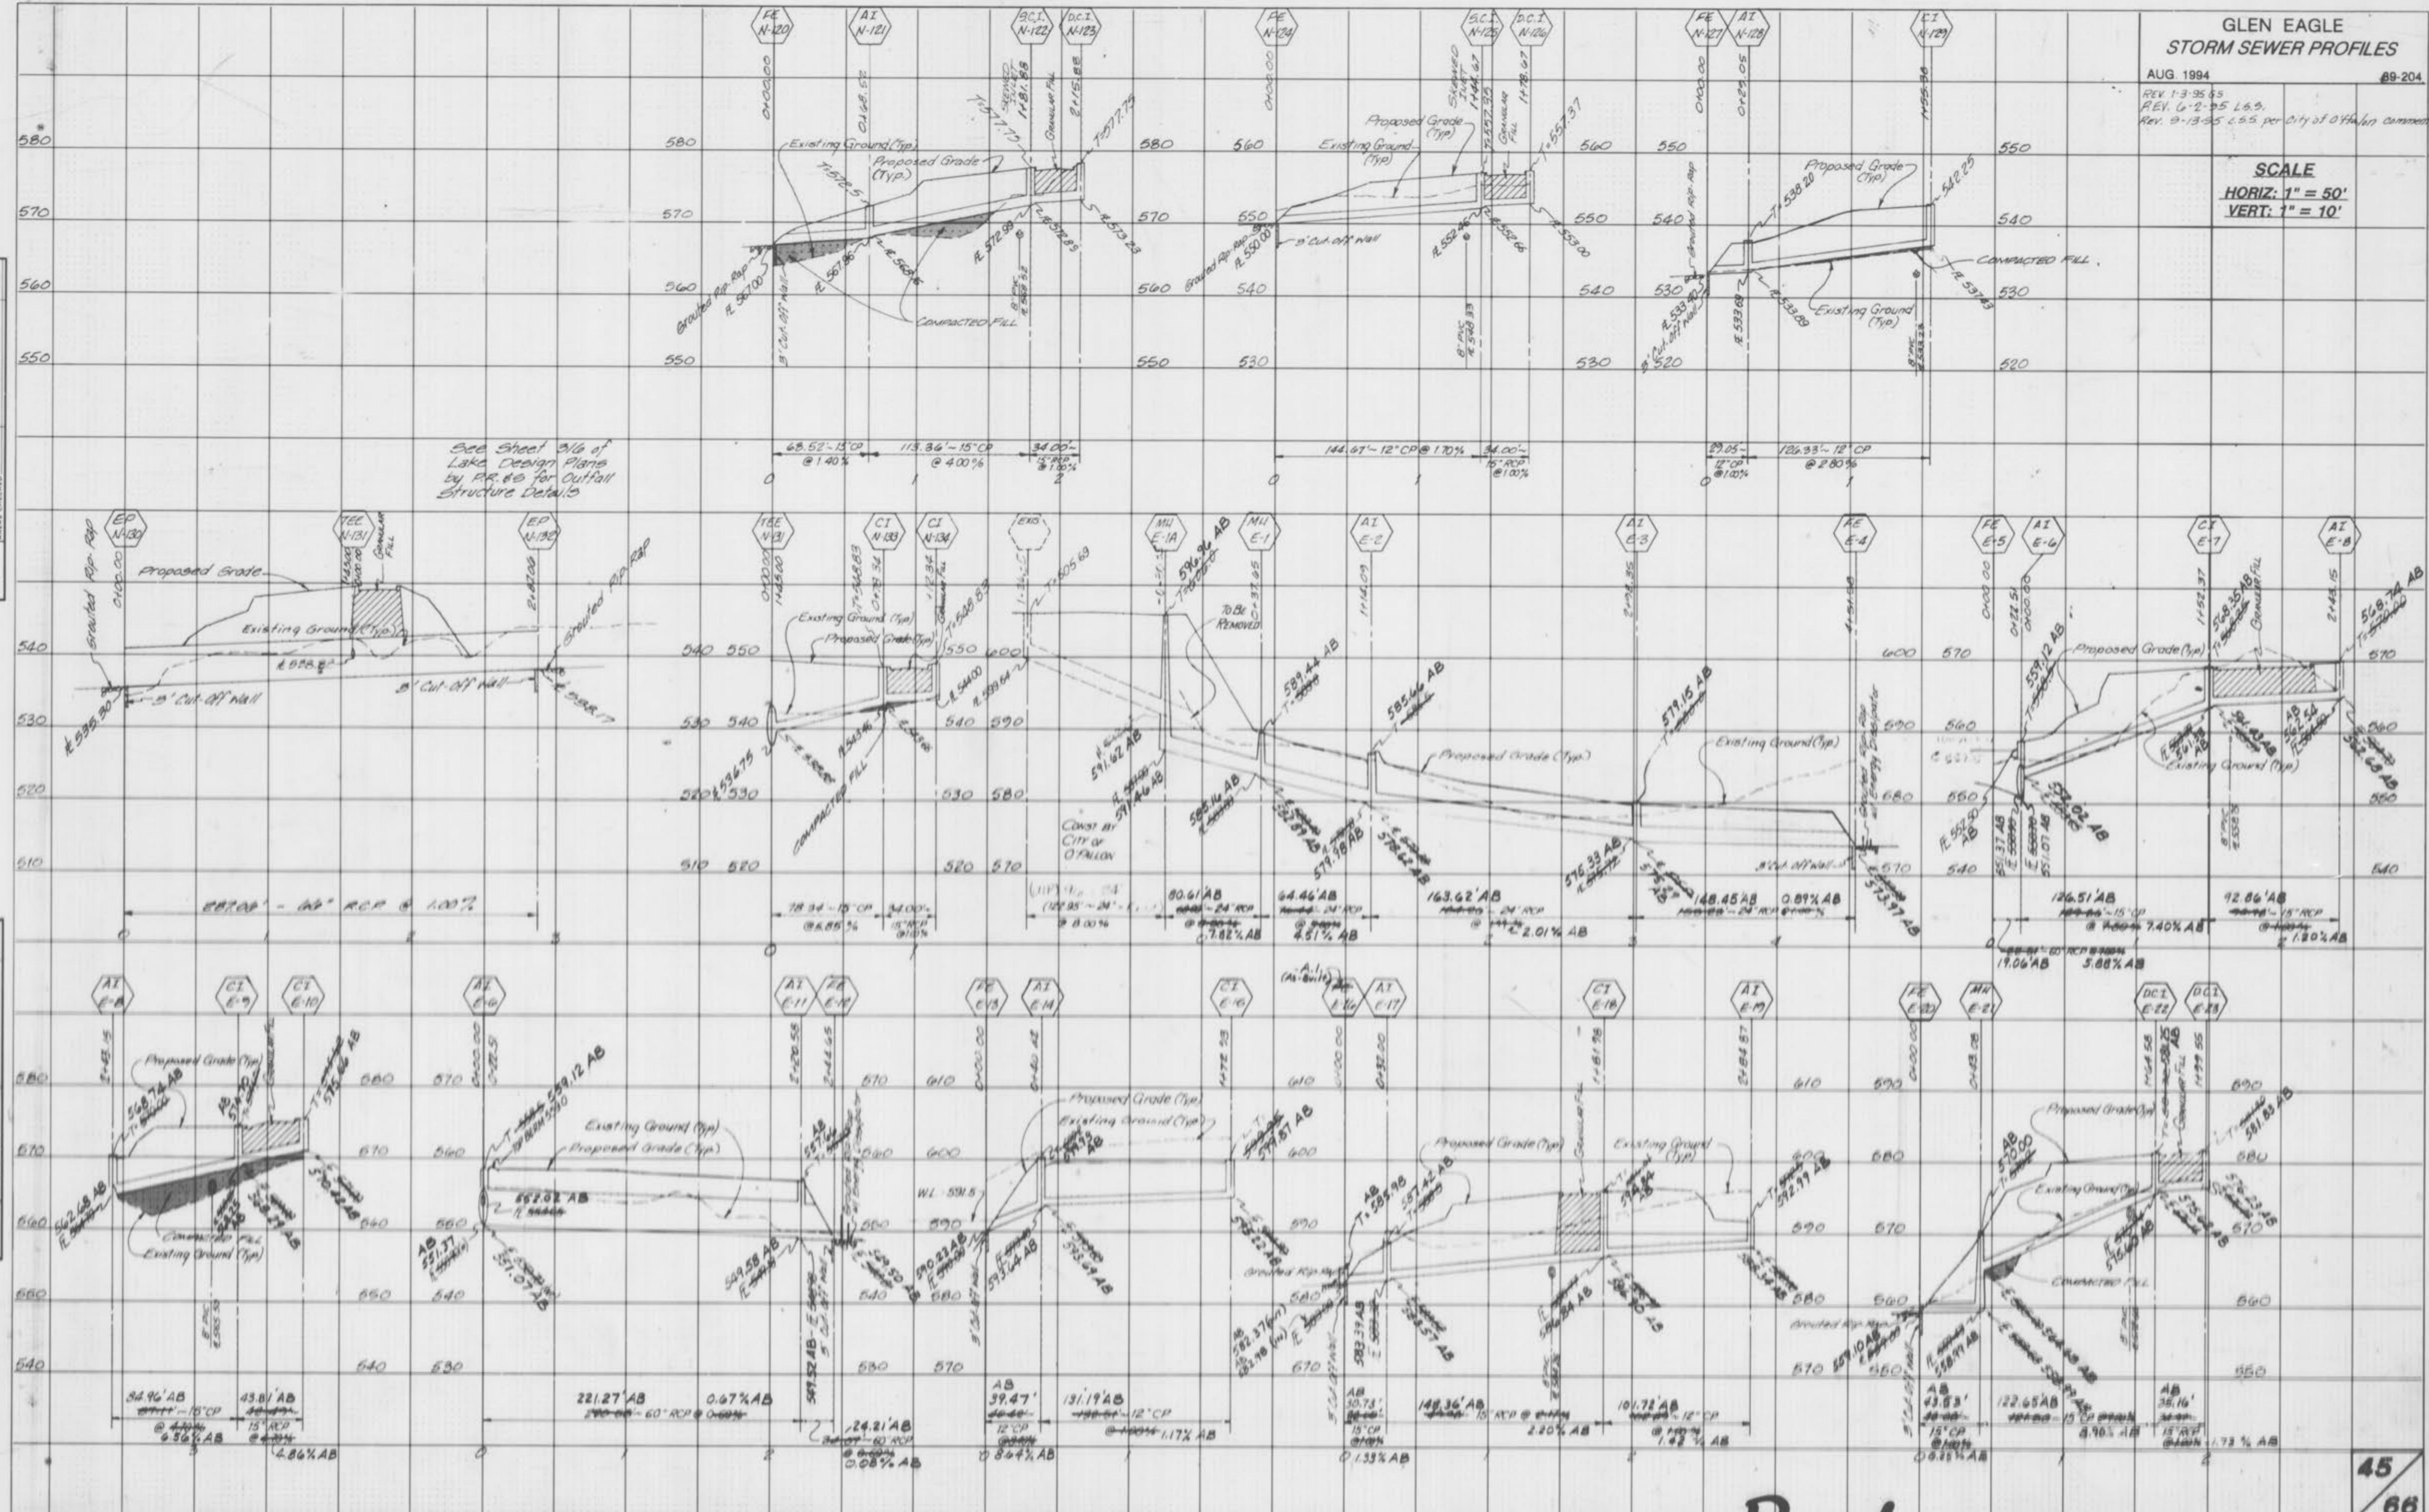

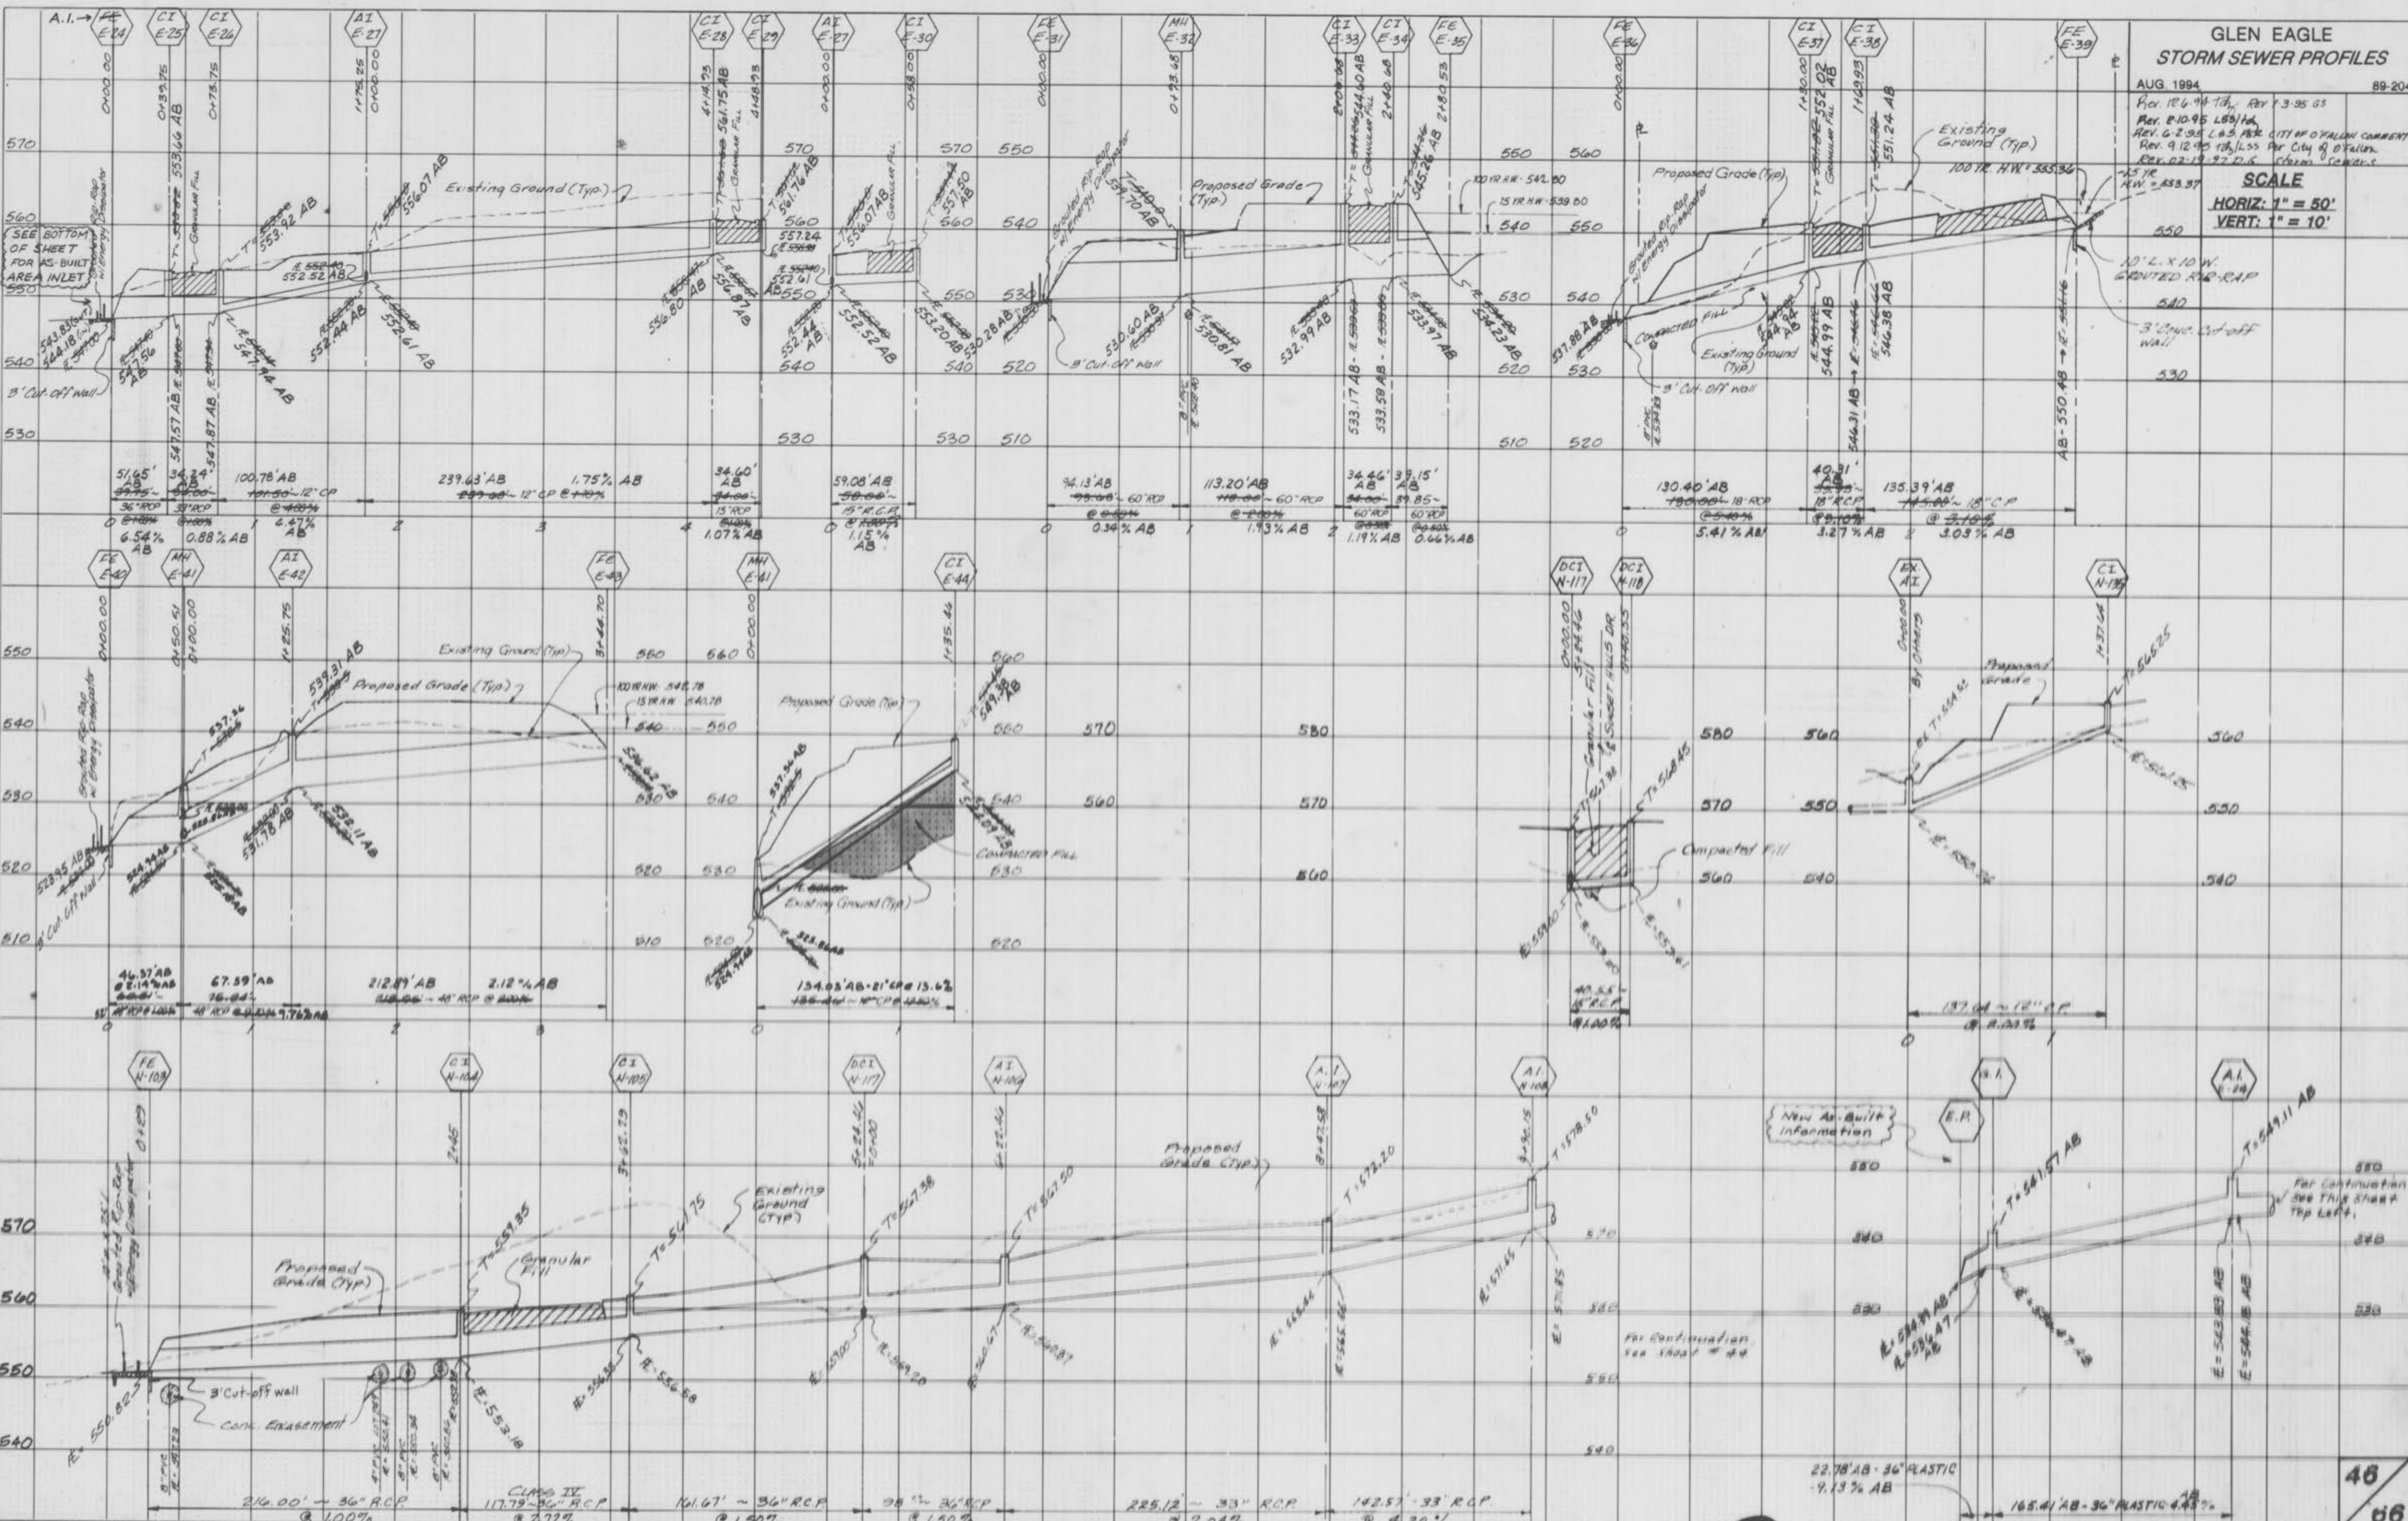


PLATE 6

**"AB" - DENOTES AS-BUILT
ELEVATIONS & DISTANCES**

MARBLE CREEK AS-BUILT