

IMPROVEMENT PLANS

VILLAGES AT DARDEENNE - PRAIRIE VILLAGE

*A TRACT OF LAND BEING PART OF
LOTS 1, 2 AND 3 OF THE JAMES CAMPBELL
ESTATE AS RECORDED IN PLAT BOOK 3, PAGE 51,
WITHIN U.S. SURVEY 3225, TOWNSHIP 46 NORTH, RANGE 3 EAST
ST. CHARLES COUNTY, MISSOURI*

CITY OF O'FALLON GENERAL NOTES



1. Gas, water and other underground utilities shall not conflict with the depth or horizontal locations of existing and proposed sanitary and storm sewers, including house laterals.
2. Underground utilities have been plotted from available information and, therefore, their locations must be considered approximate only. The verification of the location of existing and proposed utilities, either shown or not shown on these plans, shall be the responsibility of the contractor and shall be located prior to grading or construction of improvements.
3. Polyvinyl Chloride (PVC) shall conform to the requirements of ASTM D-3034 Standard Specification for the PSM Polyvinyl Chloride (PVC) Sewer Pipe and Fittings, SDR-35.
4. All storm sewer pipe under pavement, regardless of size, shall be reinforced concrete pipe (ASTM C-76, Class III) unless noted otherwise in the plans.
5. Property is located within the Flood Plain boundaries per FIR Map No. 2918300239E and 291830450E, revised on August 2, 1996.
6. All filled places under buildings, proposed sanitary and storm sewer lines, and/or paved areas including trench backfills shall be compacted to 90% of maximum density as determined by the "Modified A.A.S.H.T.O. T-180 Compaction Test" (ASTM D-1557) unless otherwise specified by the local governing authority specifications. All tests will be verified by a soils engineer.
7. All earth-filled places within State, County, or City roads (highways) shall be compacted to 95% of maximum density determined by the "Standard Proctor Test" A.A.S.H.T.O. T-99" (ASTM D-698) unless otherwise specified by local governing authority specifications. All tests will be verified by a soils engineer.
8. All storm and sanitary trench backfills shall be water jettied. Granular fill will be used under paved areas.
9. Easements shall be provided for storm sewers, sanitary sewers, and all utilities on the record plat. See record plat for location and size of easements. This does not apply to house laterals.
10. No area shall be cleared without the permission of the developer.
11. All grades shall be within 0.2 feet (more or less) of those shown on the grading plan.
12. No slope shall be greater than 3:1 and shall be either sodded or seeded and mulched.
13. Hazard markers will consist of three (3) standard specification "Manual on Uniform Traffic Control Devices," end of roadway markers mounted on two (2) pound "U" channel sign post. Each marker shall consist of an eighteen (18) inch diamond reflectorized red panel. The bottom of each panel shall be mounted a minimum of four (4) feet above the elevation of the pavement surface.
14. All manhole and curb inlet tops built without elevations furnished by the Engineer will be the responsibility of the sewer contractor. At the time of construction stake-out of the sewer lines, all curb and grade inlets will be face staked. If normal face stakes fall in line with sewer construction, the Engineer will set these stakes on a double offset. It shall be the responsibility of the sewer contractor to preserve all face stakes from destruction.
15. All standard street curb inlets to have front of inlet 2 feet behind curb.
16. The minimum vertical distance from the low point of the basement to the flowline of a sanitary sewer at the corresponding house connection shall not be less than the diameter of the sanitary sewer plus a vertical distance not less than two and one-half feet (2-1/2').
17. Water lines, valves, sleeves, meters and etc., shall meet all requirements and installation requirements of the local governing authority.
18. All cast iron pipe for water mains shall conform to A.W.W.A. specification C-108 and/or C-108. The cast iron fittings shall conform to A.W.W.A. specification C-110. All rubber gasket joints for water cost iron pressure pipe and fittings shall conform to A.W.W.A. specification C-111.

19. All water hydrants and valves shall be cast iron and installed in accordance with plans and details.
20. All sanitary and storm sewers shall meet all specifications and installation requirements of the local governing authority.
21. All PVC water pipe shall have a minimum pressure rating of PR-200 or SDR-21.
22. All PVC sanitary sewer pipe shall be SDR-35 or equal with "clean" 1/2" to 1" granular stone bedding uniformly graded. This bedding shall extend from 4" below the pipe to springline of pipe. Immediate backfill over pipe shall consist of some size "clean" or "minus" stone from springline of pipe to 6" above the top of pipe.
23. All grading on Missouri State Highway Right-of-Way shall be seeded and mulched and no disturbed Right-of-Way markers shall be reest at the completion of grading.
24. All streets must meet the specifications and installation requirements of the City of O'Fallon.
25. All sanitary manholes top shall be set 0.2' higher than the proposed ground except in pavement areas.
26. All sanitary manholes shall have a .31 mil thick coat of coal tar pitch waterproofing. See note #32 nd #42.
27. All sanitary service lines shall have a 6" diameter for Villas and a 4" diameter for single family developments.
28. Manhole frame and cover shall be Clay and Bailey No. 2008 or Neenah R-1736 or Deeter 1315 or approved equal.
29. A drop of 0.2 feet is required through each sanitary manhole. SEE NOTE #45.
30. The City of O'Fallon shall be notified at least 48 hours prior to construction of sanitary sewers for coordination and inspection.
31. Brick shall not be used on manholes.
32. Waterproofing: Waterproofing will be required on the exterior of all manholes. The bitumen shall consist of two coats of asphalt, coal-tar pitch, or a coating meeting American Society for Testing and Materials (ASTM) D-449. Asphalt shall conform to the requirements of ASTM D-450. Coating shall be .31 mils thickness.
33. NOTE: The grading and elevations shown on the grading plans are for construction purposes only. Finished grades and slopes will vary from those shown on the plans depending upon the location, size and type of foundation required. However, care should be taken to insure that finished grading conforms to drainage area maps.
34. As needed, sitution fence shall be installed as a protective barrier for trees to remain.
35. This tract is in or served by:
 - A. Water - St. Charles County P.W.S.D. No. 2
 - B. Electric - Union Electric
 - C. Telephone - G.T.E. Missouri
 - D. Sanitary Sewers - Duckett Creek Sanitary District
 - E. Gas - St. Charles Gas
 - F. Fire Protection - O'Fallon Fire Protection District
 - G. School District - Fort Zumwalt
 - H. Mail Service - O'Fallon
36. Lot Data: A. Total Number of Lots - 337
B. Minimum Lot Size - 9,000 Sq. Ft.
C. Minimum Lot Depth of Building Line - 75 ft.
37. Yard and Setback Requirements:
A. Front - 25 Feet
B. Side - 6 Feet
C. Rear - 25 Feet
38. Villa Data: A. Total Number of Villas - 115
39. Distance between Villa buildings:
A. Front to Front - 50 feet
B. Back to Back - 50 feet
C. Side to Side - 20 feet
D. Front to Side - 35 feet
E. Back to Side - 35 feet
F. Corner to Corner - 15 feet

ST. CHAS CO. PWS.D. NO. 2,
CITY OF O'FALLON,
DUCKETT CREEK SAN. DIST.
This is to certify to Dickens that these "As-Built" SEWER & WATER plans are based on actual field surveys conducted during Sept. 1998 and the results are shown hereon.

By: Daniel Ehlmann 10-08-98
DANIEL EHLMANN, R.L.S., #2215
STATE OF MISSOURI

PICKETT, RAY & SILVER'S CORPORATE
REGISTRATION NO. LS-54-D

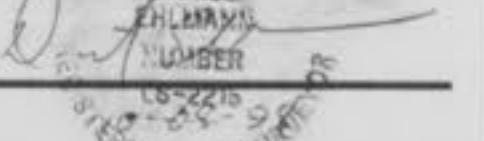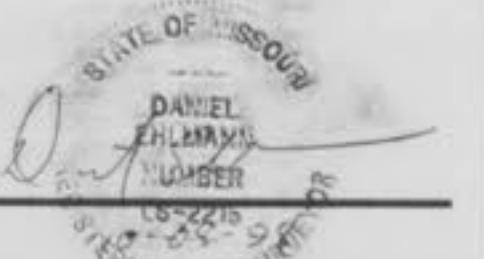

ENGINEERS AUTHENTICATION

The responsibility for professional engineering liability on this project is hereby limited to the set of plans so authenticated by the engineer. The engineer shall not be liable for any damage or loss incurred by the owner or any other party resulting from any disturbance of the project or any other engineering plans involved in the project subsequent to this date unless reauthenticated.

PICKETT, RAY & SILVER, INC.

Signature
Date

Civil Engineers
Planners
Land Surveyors

333 Mid Rivers Mall Dr.
St. Peters, MO 63376
397-1211 FAX 397-1104

PICKETT RAY & SILVER


DRAWING INDEX

Sheet	Description
1	COVER SHEET
2-10-8	SITE PLANS
#10	GRADING PLANS
20-20	STREET PROFILES
20a	MULLER ROAD ENTRANCE
20-27	SANITARY SEWER PROFILES
20-40	STORM SEWER PROFILES
17-55	DRAINAGE AREA MAPS
50-00	CONSTRUCTION DETAILS
60a-60b	WATER LAYOUT PLANS
60c-60f	OUTFALL SEWERS [LINKS GOLF]

9-12
13-15
14-17

PHASE ONE RESIDENTIAL AS-BUILT PLANS

LOCATION MAP

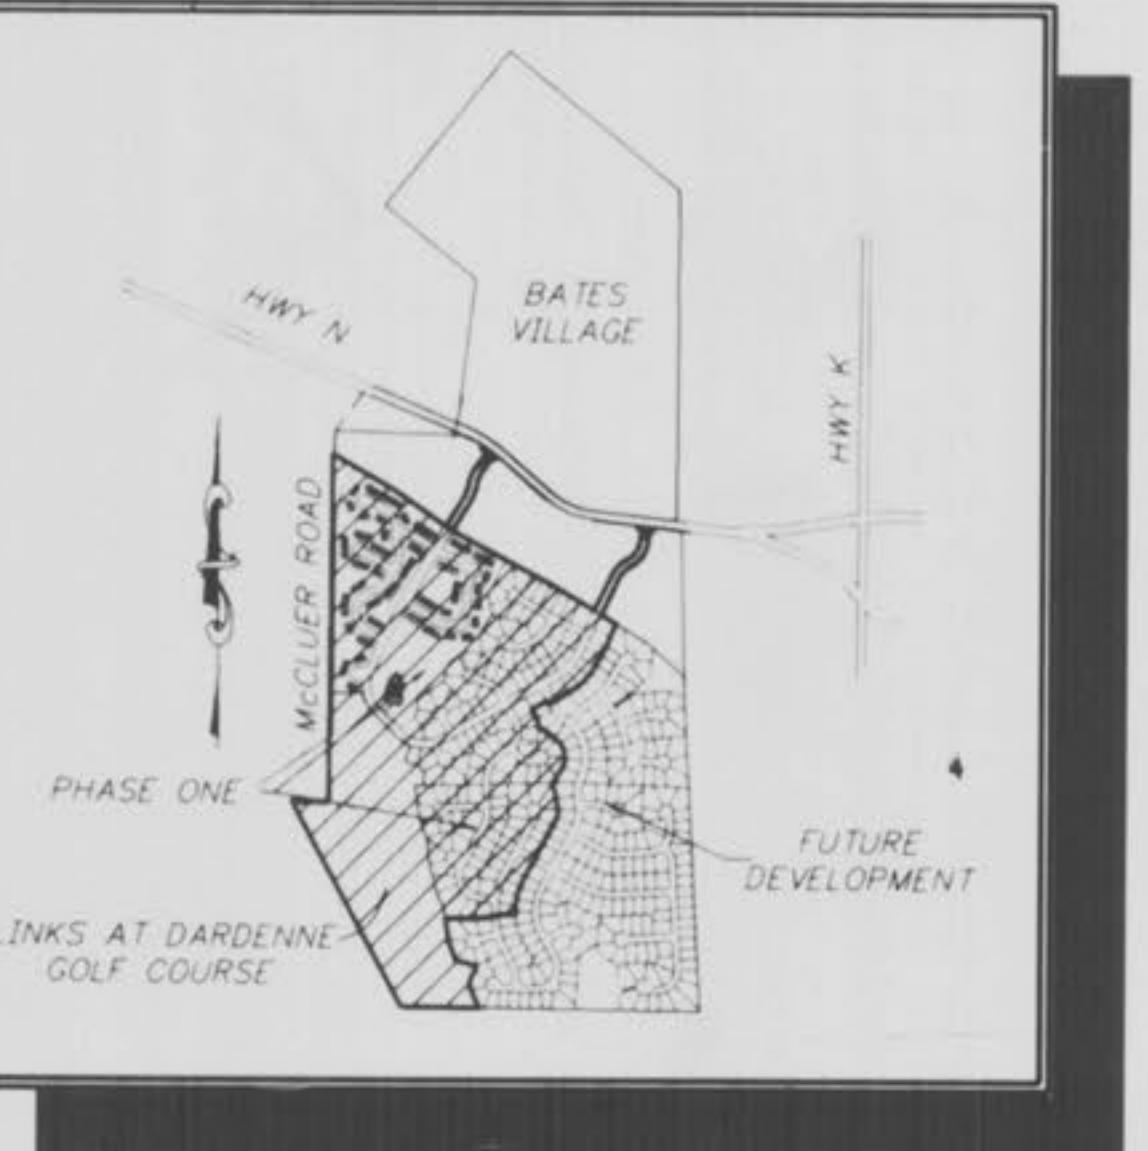

LEGEND

● Sanitary Sewer (Proposed)	○ Sanitary Sewer (Existing)	R.C.P. Reinforced Concrete Pipe
- - - Storm Sewer (Proposed)	- - - Storm Sewer (Existing)	C.M.P. Corrugated Metal Pipe
- - - - - Power Pole	- - - - - Power Pole	C.I.P. Cast Iron Pipe
- - - Water Line & Size	- - - Water Line & Size	P.V.C. Polyvinyl Chloride
- - - Existing water line	- - - Existing water line	V.C.P. Vitified Clay Pipe
■ Tee & Valve	■ Tee & Valve	C.O. Clean Out
Hydrant	Hydrant	V.T. Vent Trap
Cap	Cap	T.B.R. To Be Removed
18 Lot or Building Number	D.C.I. Double Curb Inlet	T.B.R.&R. To Be Removed & Relocated
- - - Existing Fence Line	G.I. Grate Inlet	T.B.P. To Be Protected
- - - Existing Tree Line	A.I. Area Inlet	T.B.A. To Be Abandoned
Street Sign	D.A.I. Double Area Inlet	B.C. Base Of Curb
Existing Contour	C.C. Concrete Curb	T.C. Top Of Curb
Proposed Contour	F.E. Flared End Section	T.W. Top Of Wall
Grouted Rip-Rap	E.P. End Pipe	B.W. Base Of Wall
End of Lateral	E.D. Energy Dissipator	(TYP.) Typical
Asphalt Pavement	M.H. Manhole	U.N.O. Unless Noted Otherwise
Concrete Pavement	C.P. Concrete Pipe	U.P. Use In Place

SITE BENCHMARK

BM. #1

"O" IN OPEN ON FIRE HYDRANT ON
WEST SIDE OF HENNING ROAD AT
250' NORTH OF S.E. CORNER OF
RAUP TRACT. ELEV.= 501.32
(BASED ON F.I.R.M. B.M. RM. #57 ELEV.= 486.44)

REVISIONS

REVISED SHTB. 10-19-28, 46, 56 6-19-98 AND 1/98
REVISED SHTB. 29, 30, 34-36 PER DUCKETT 8-8-97
REVISED SHTB. 21, 24, 28 OF 60 8-1-97
REVISED PER O'FALLON COMMENTS 7-18-97
REVISED PER D.C.S.D. COMMENTS; 7-15-97 E.J.S.
REVISED PER D.C.S.D. COMMENTS; 7-15-97 E.J.S.

DEVELOPER

WHITTAKER
CONSTRUCTION, INCORPORATED
355A MID RIVERS MALL DRIVE
ST. PETERS, MO. 63376
(314)970-1511

(C) Copyright 1997 by Pickett, Ray & Silver Inc.
CONFIDENTIAL PROPRIETARY MATERIAL
The use, reproduction and sales rights of this
drawing are reserved by Pickett, Ray & Silver Inc.
DRAWN E.J.S. DATE JUNE, 1997
CHECKED _____ DATE _____
FIELD BOOK 595 PROJECT # 95-080C
JOB ORDER # 35968

1
60

SEE SHEET 2

SEE SHEET 4



SEE SHEET 10

SEE SHEET 9

四三

VILLAGES AI DARDENNE
PRAIRIE VILLAGE
SITE PLAN

REVISED 7-15-97, E.J.S. JUNE 1997 SITE PLAN 95-080C

SEE SHEET 3

MC CLUER REAL
ESTATE PLAT



GRAPHIC SCALE
(IN FEET)
1 inch = 50 ft.



THE VILLAGES AT DARDENNE
PRAIRIE VILLAGE
SITE PLAN

JUNE 1997


REVISED 7-15-97, E&L

SEE SHEET 7

NOTE:
This map shows proposed utility locations and dimensions. These locations must be considered preliminary and subject to change. Actual utility locations and dimensions may differ from those shown on this map.

85
17

SEE SHEET 5

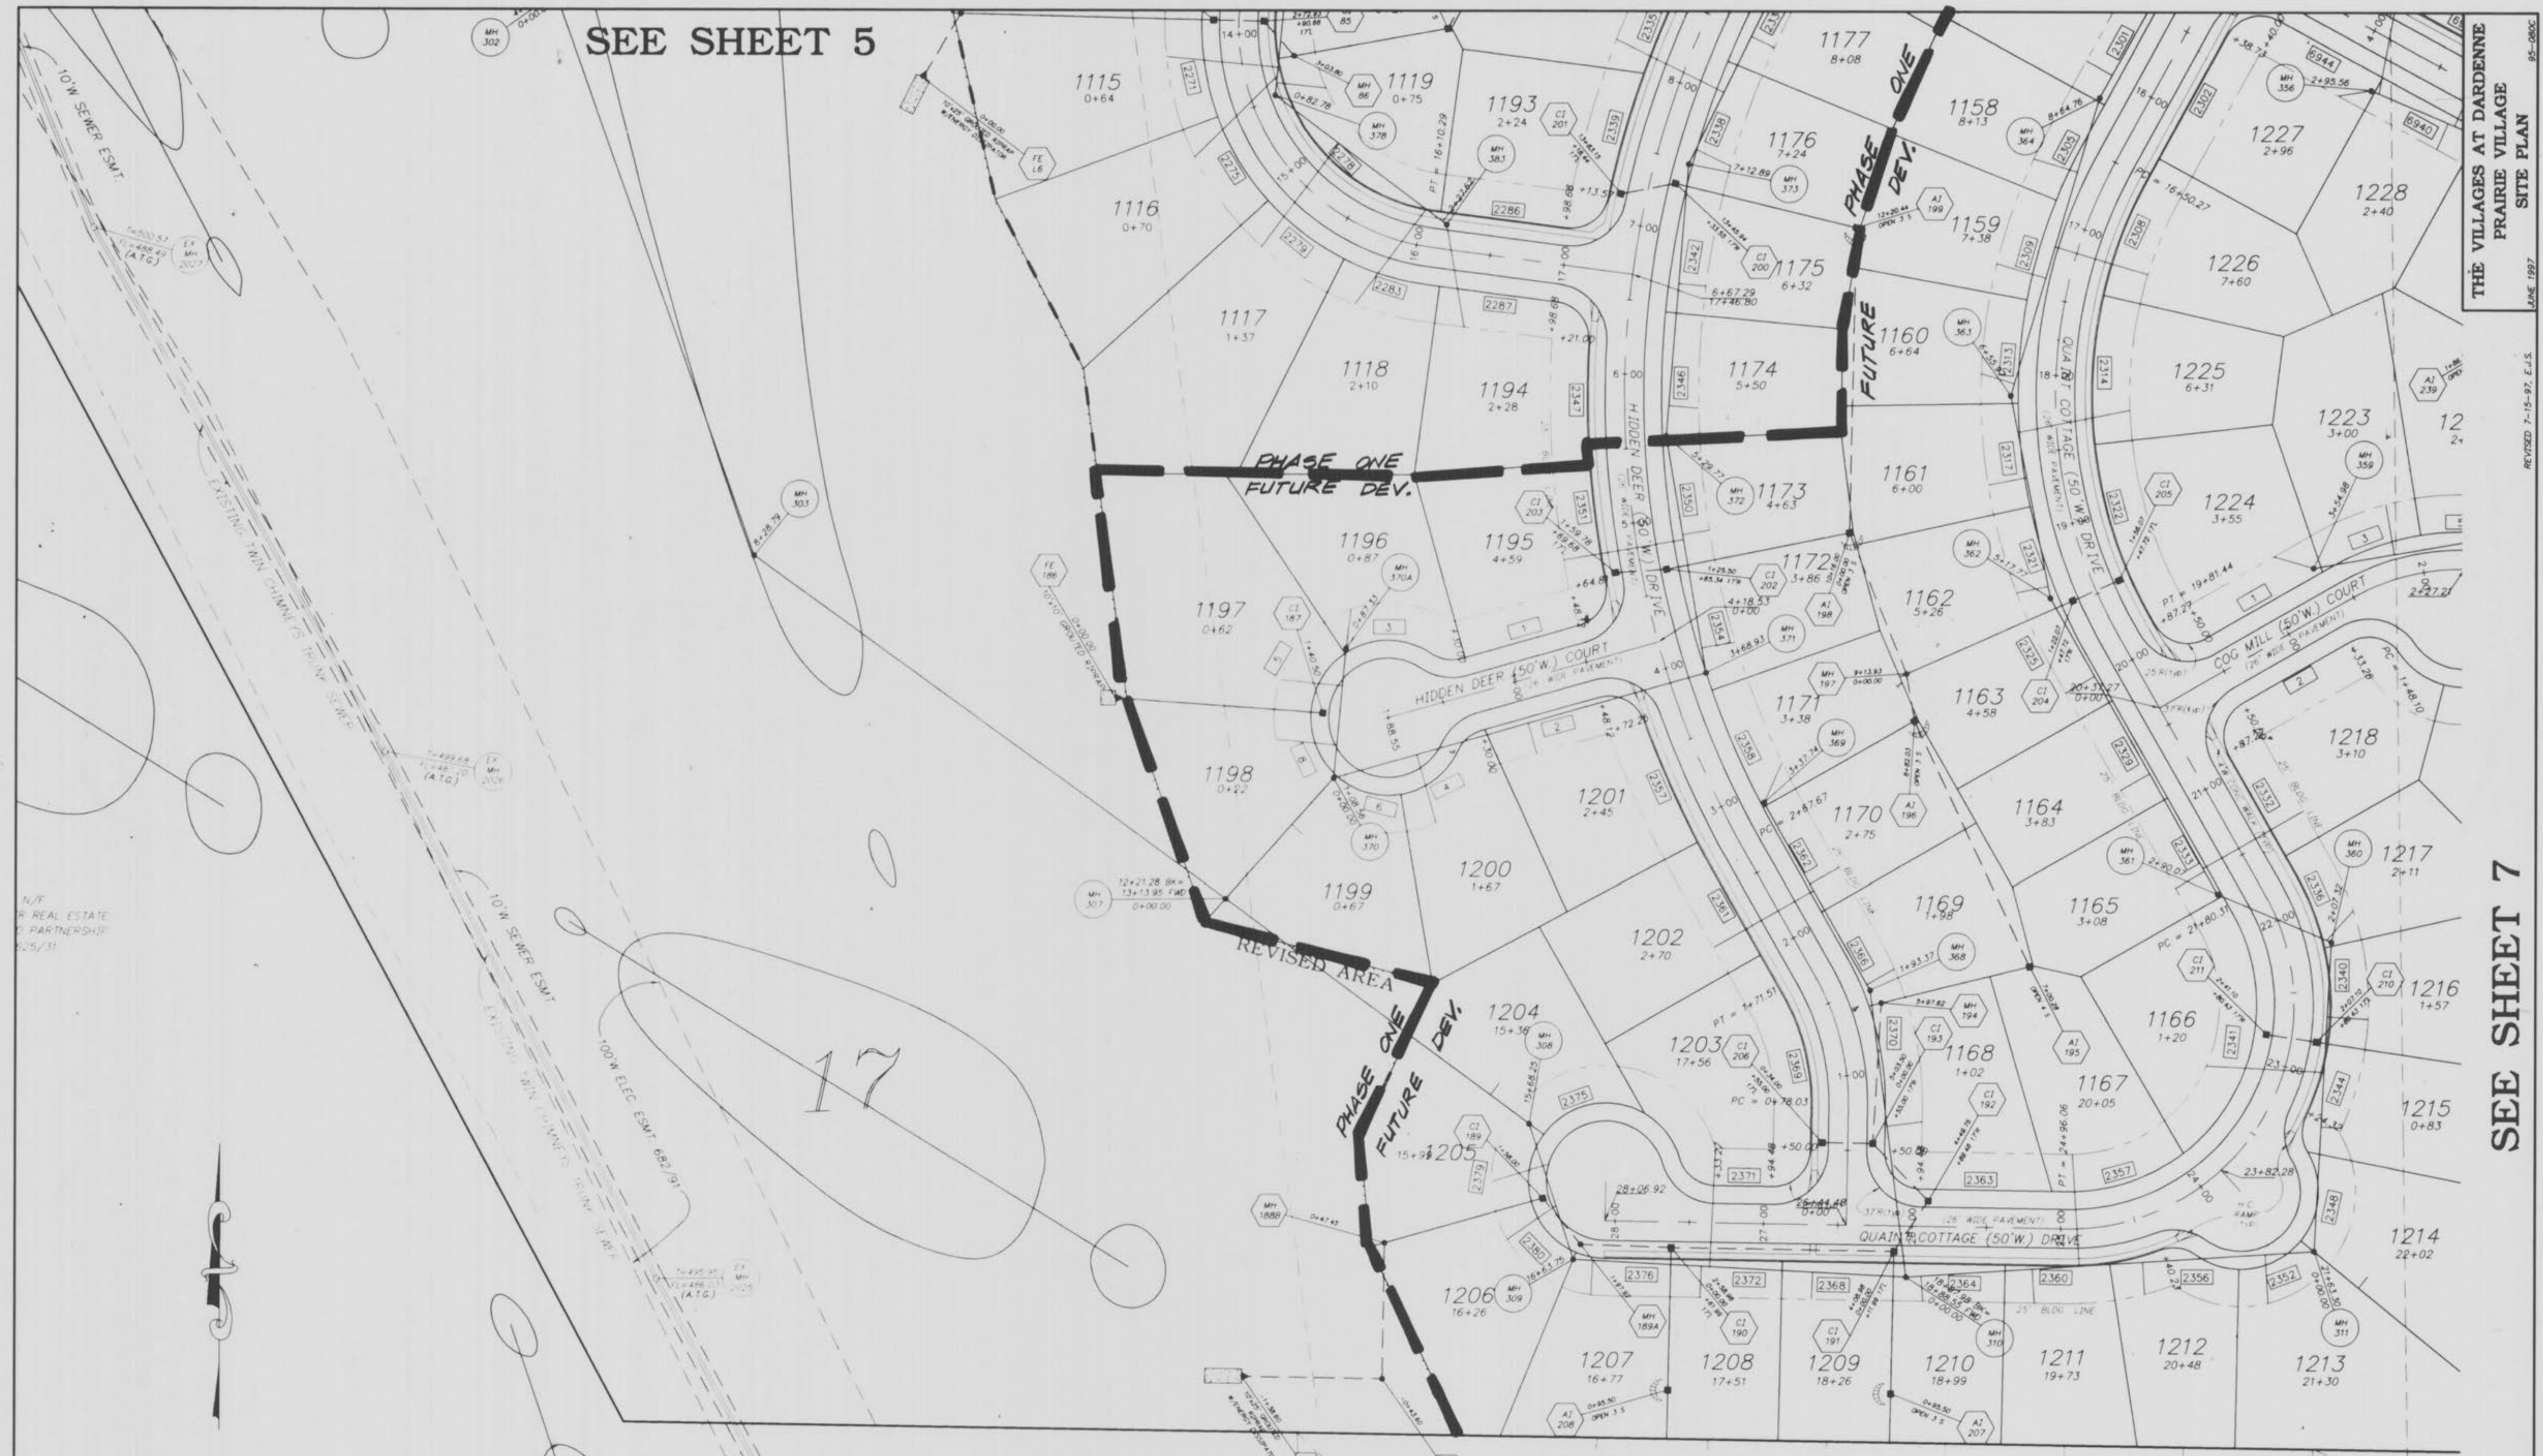

GRAPHIC SCALE
50 0 50 100
(IN FEET)
1 inch = 50 ft.

COMMON GROUND

EXISTING WATERFORD CROSSING SUBDIVISION

SEE SHEET 9

N/F
DICKHERBER,
DENNIS TRUST
ET AL
1372/1094
ZONED R-1A

THE VILLAGES AT DARDENN
PRAIRIE VILLAGE
SITE PLAN

3

104

A graphic scale consisting of a horizontal line with tick marks at 0, 50, and 100. The distance between 0 and 50 is filled with black squares, while the distance between 50 and 100 is filled with white squares. Below the scale, the text '(IN FEET)' is centered, and below that, '1 inch = 50 ft' is written.

SEE SHEET 5

SEE SHEET 7

NOTE: Under ground utilities and structures have been plotted from available information and therefore their location must be considered approximate only. It is the responsibility of the individual contractors to modify the utility companies before actual construction.

8
17
~~60~~

SEE SHEET 10

PROPOSED RTE. D
PAGE AVE. EXTENSION

SEE SHEET 4

1094

1

2220

SEE SHEET 8

N/F
DICKHERBER,
DENNIS TRUS-
ET AL
1372/1094
ZONED R-1A

NOTE: underground utilities and structures have been plotted from available information and where necessary, their location must be considered approximate only. It is the responsibility of the individual contractor to notify the utility companies before actual construction.

NOT
Under
been
therefore
appro-
of the
utility

A graphic scale bar consisting of a horizontal line with tick marks and numerical labels. The word "GRAPHIC SCALE" is printed above the line. The line has major tick marks at 0 and 50, with minor tick marks between them. Below the line, the text "(IN FEET)" is centered, and below that, "1 inch = 50 ft." is written.

THE VILLAGES AT DARDENNE PRAIRIE VILLAGE SITE PLAN

REvised 7-15-97 EJS
SHEET 1007

SEE SHEET 2

PROPOSED RTE. D.
AGE AVE. EXTENSION)

SEE SHEET 3

1424.20

STA. 183⁺⁸⁴

574 18743141

A diagram showing a corner lot with a curved easement. The property line is a straight line from the bottom left to the top right. A curved line extends from the top right towards the center-left. An arrow points along the curve. The text "MONUMENT EASEMENT" is written vertically along the curve.

Detailed description of the figure: This is a site plan or survey map. It features several property boundaries represented by solid lines. Two major roads are shown as dashed lines: one running diagonally from the bottom right towards the top left, labeled 'BRASSEL (60'W) DRIVE', and another horizontal dashed line at the bottom. Utility poles are marked with hexagonal symbols containing letters and numbers: 'CL 270' and 'CL 269' are on the left; 'FE 271' and 'FE 268' are on the right. Specific points along the roads are marked with black dots and labeled with distances: '51+42.80' and '51+00' are on the main road; '0+00' and '0+44.00' are on the bottom road; and '30+00' is further down the bottom road. A dashed line labeled 'P.C. = 51+42.80' originates from a point near CL 270 and extends towards the top left corner. There are also some smaller labels like '55.77 (177R)' and '1+21.00'.

PROPOSED RTE. D
(PAGE AVE. EXTENSION)

SEE SHEET 9

Villages @ Dardane - Prairie Village Ph I AS-BUILTS

NOTE: Underground utility and structures have been plotted from available information and therefore, their location must be considered approximate only. It is the responsibility of the individual contractors to notify the utility companies before actual construction.

**THE VILLAGES AT DARDENNE
PRAIRIE VILLAGE
SITE PLAN**

REVISED 06-19-98 PER CITY OF O'FALLON, D.W.D.
REVISED 7-18-97 PER CITY OF O'FALLON, E.J.S.
REVISED 7-15-97, E.J.S.

JUNE 1997

95-0090

P-1 = PHASE ONE SEWERS

FINAL SURVEYED
SURVEY
PLOTTED
TEMPATE
NOTE BOOK
AREA
NO.
AREAS CHECKED

ORIGINAL SURVEYED
SURVEY
PLOTTED
TEMPATE
NOTE BOOK
AREA
NO.
AREAS CHECKED

THE VILLAGES AT DARDENNE
PRAIRIE VILLAGE
SANITARY SEWER PROFILES
JAN. 1997

95-080C

REVISED 7/16/97

MA
38B

520

510

490

490

540

520

510

500

HORIZ 1" = 50'
VERT 1" = 10'

500

520

530

520

510

500

510

500

540

510

490


510

520

500

490


500

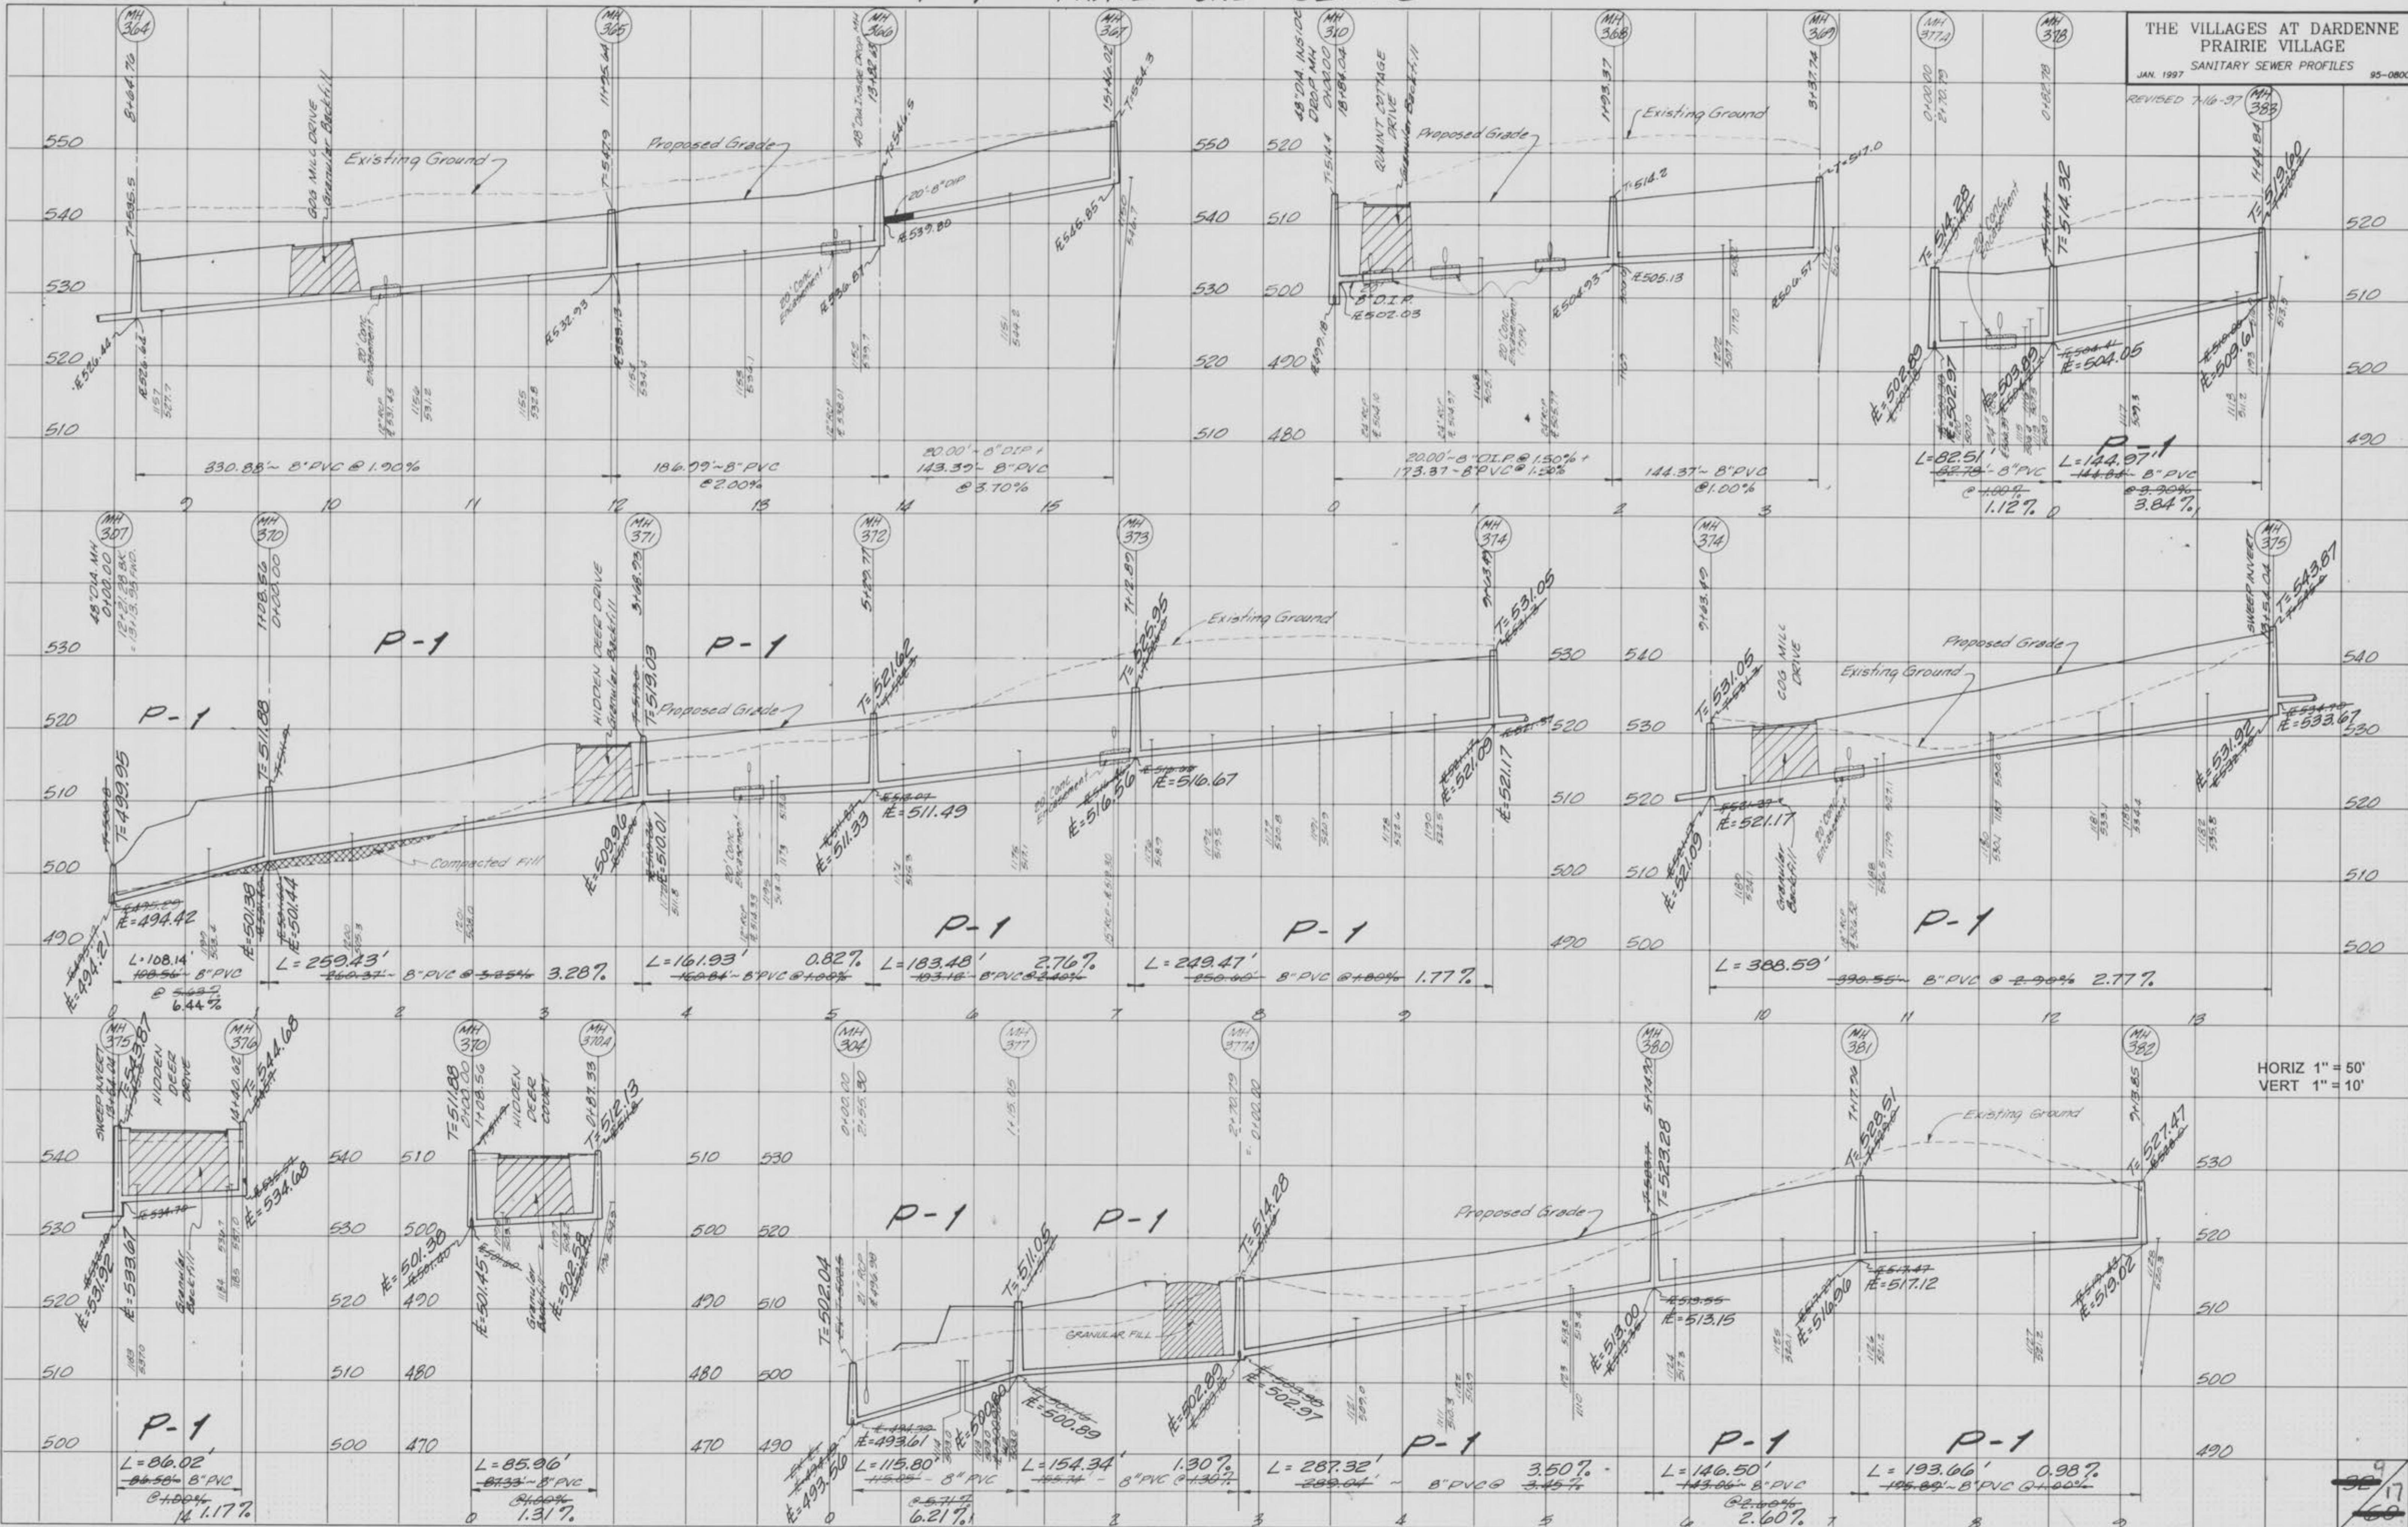

AS-BUILTS

Villages@Dardene - Prairie Village Ph1


P-1 = PHASE ONE SEWERS

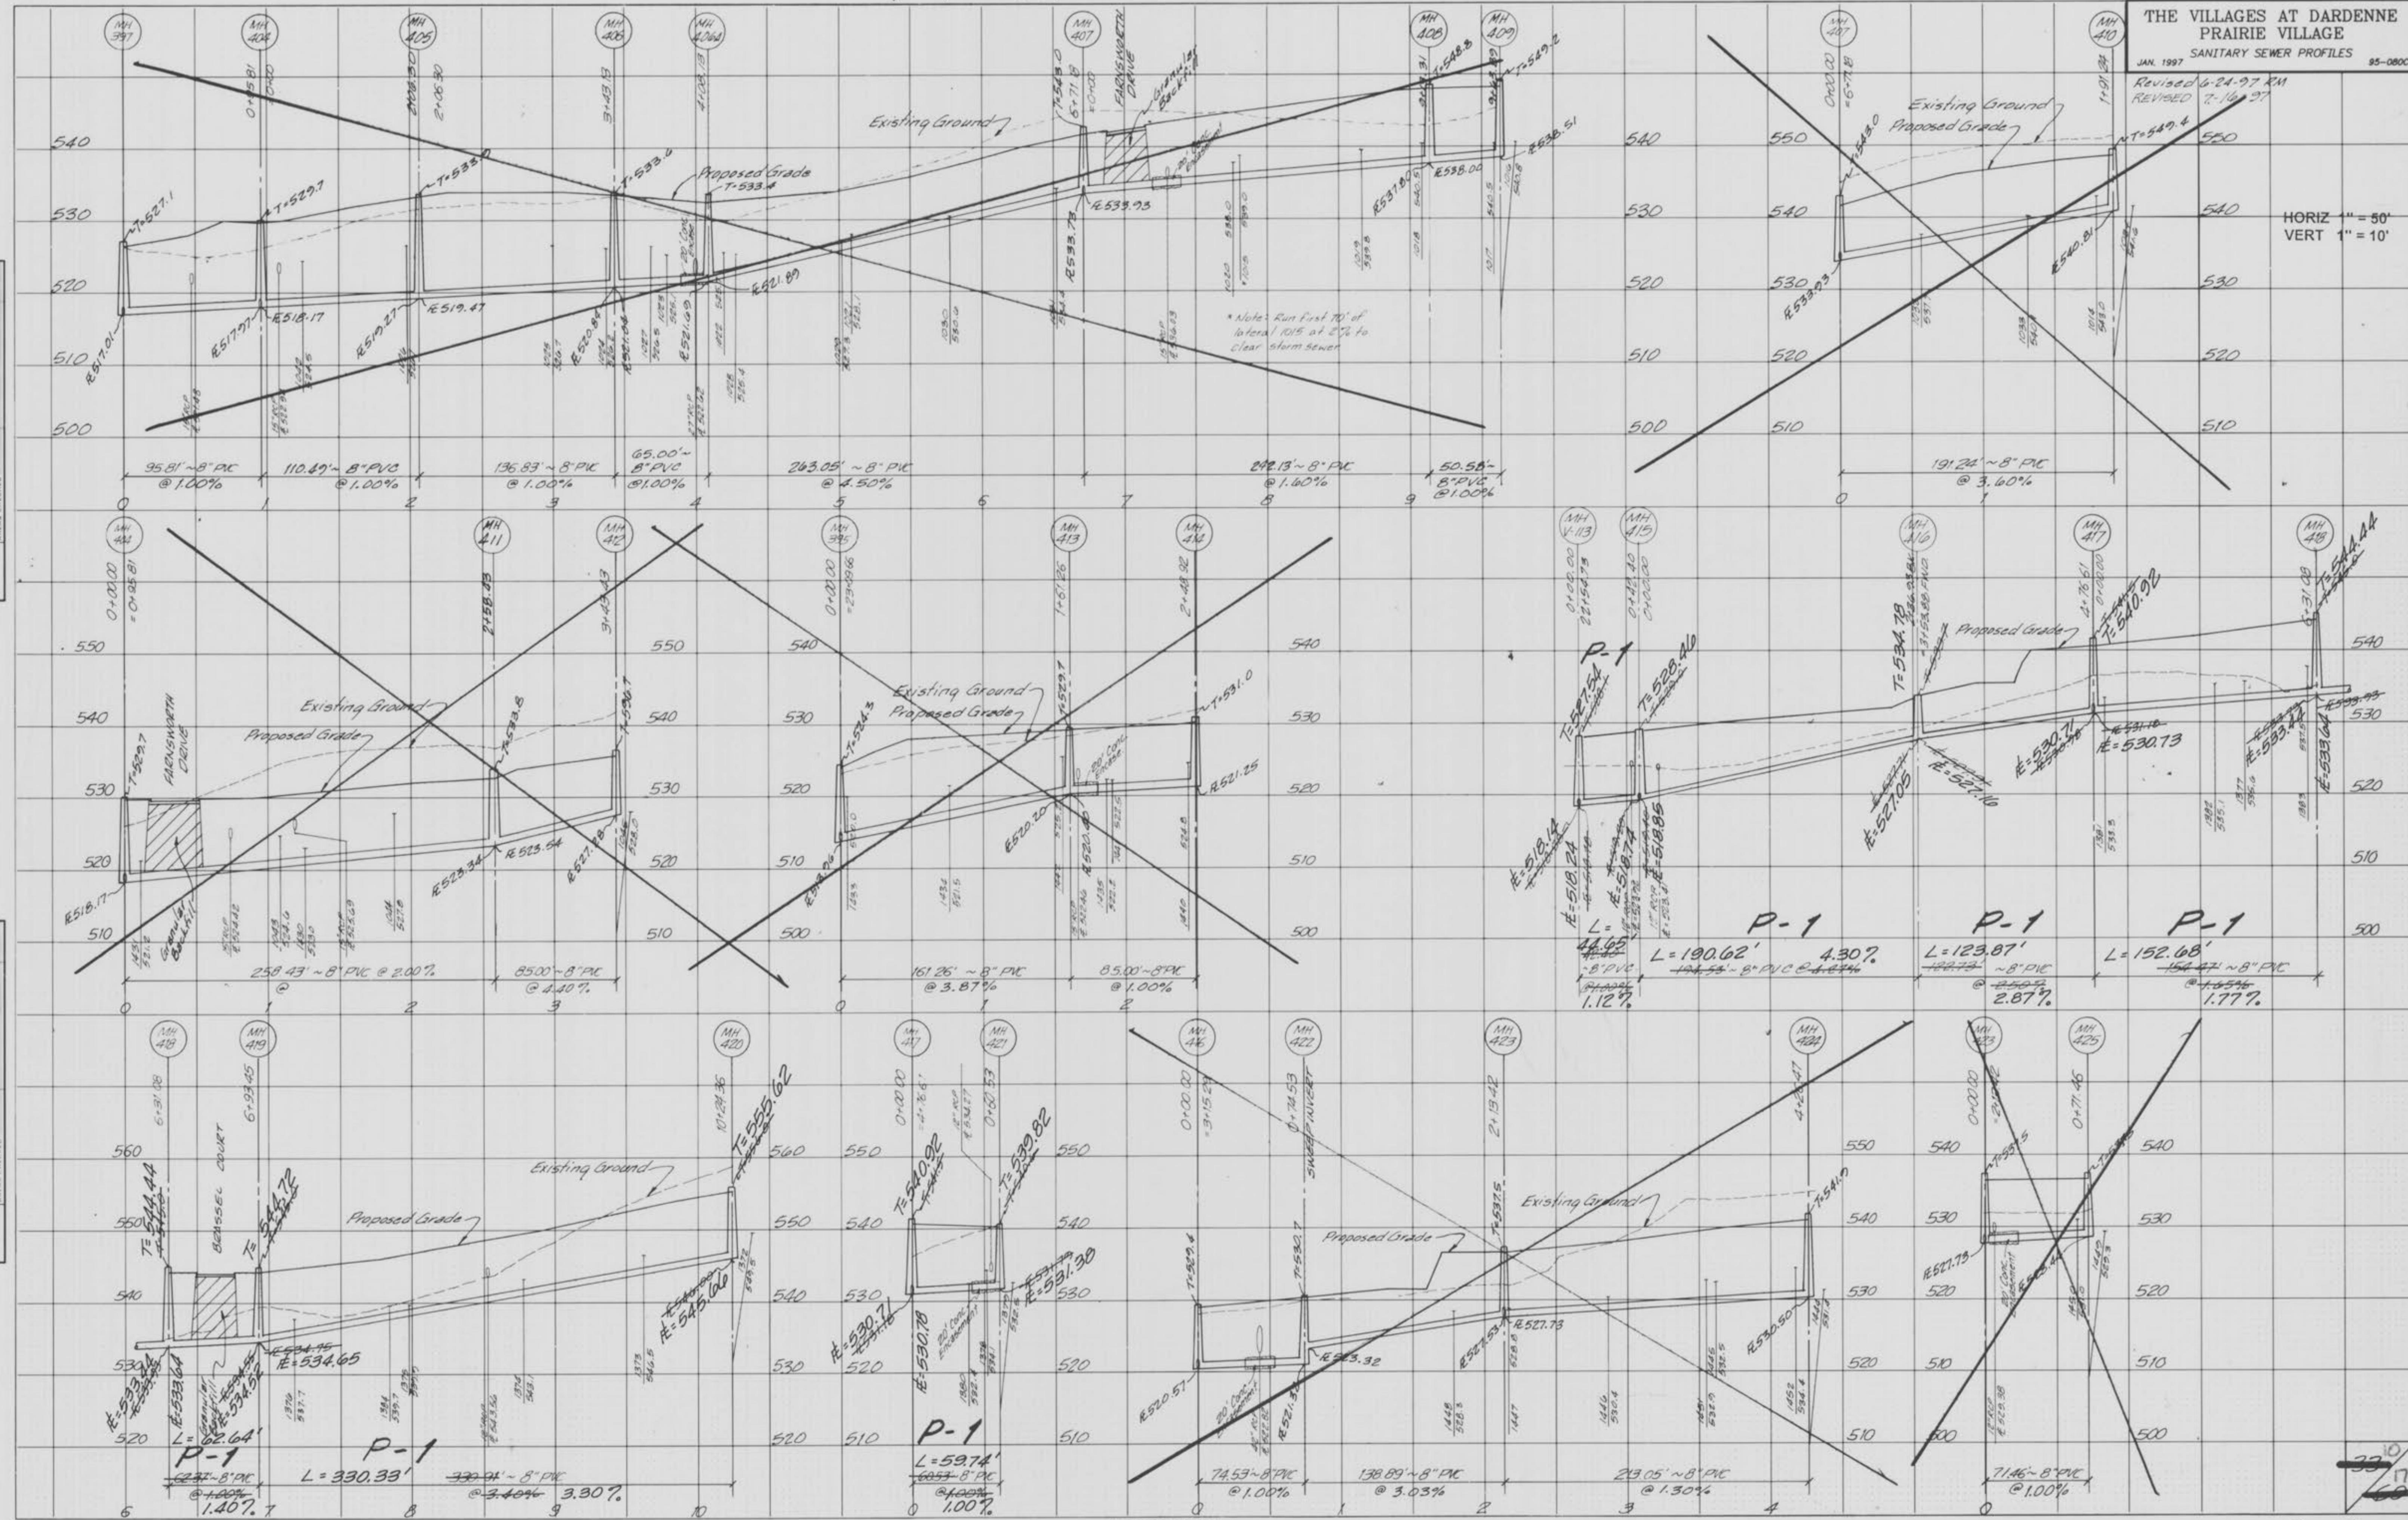

AS-BUILTS

Villages@Dardenne-PrairieVillagePh1

P-1 = PHASE ONE SEWERS

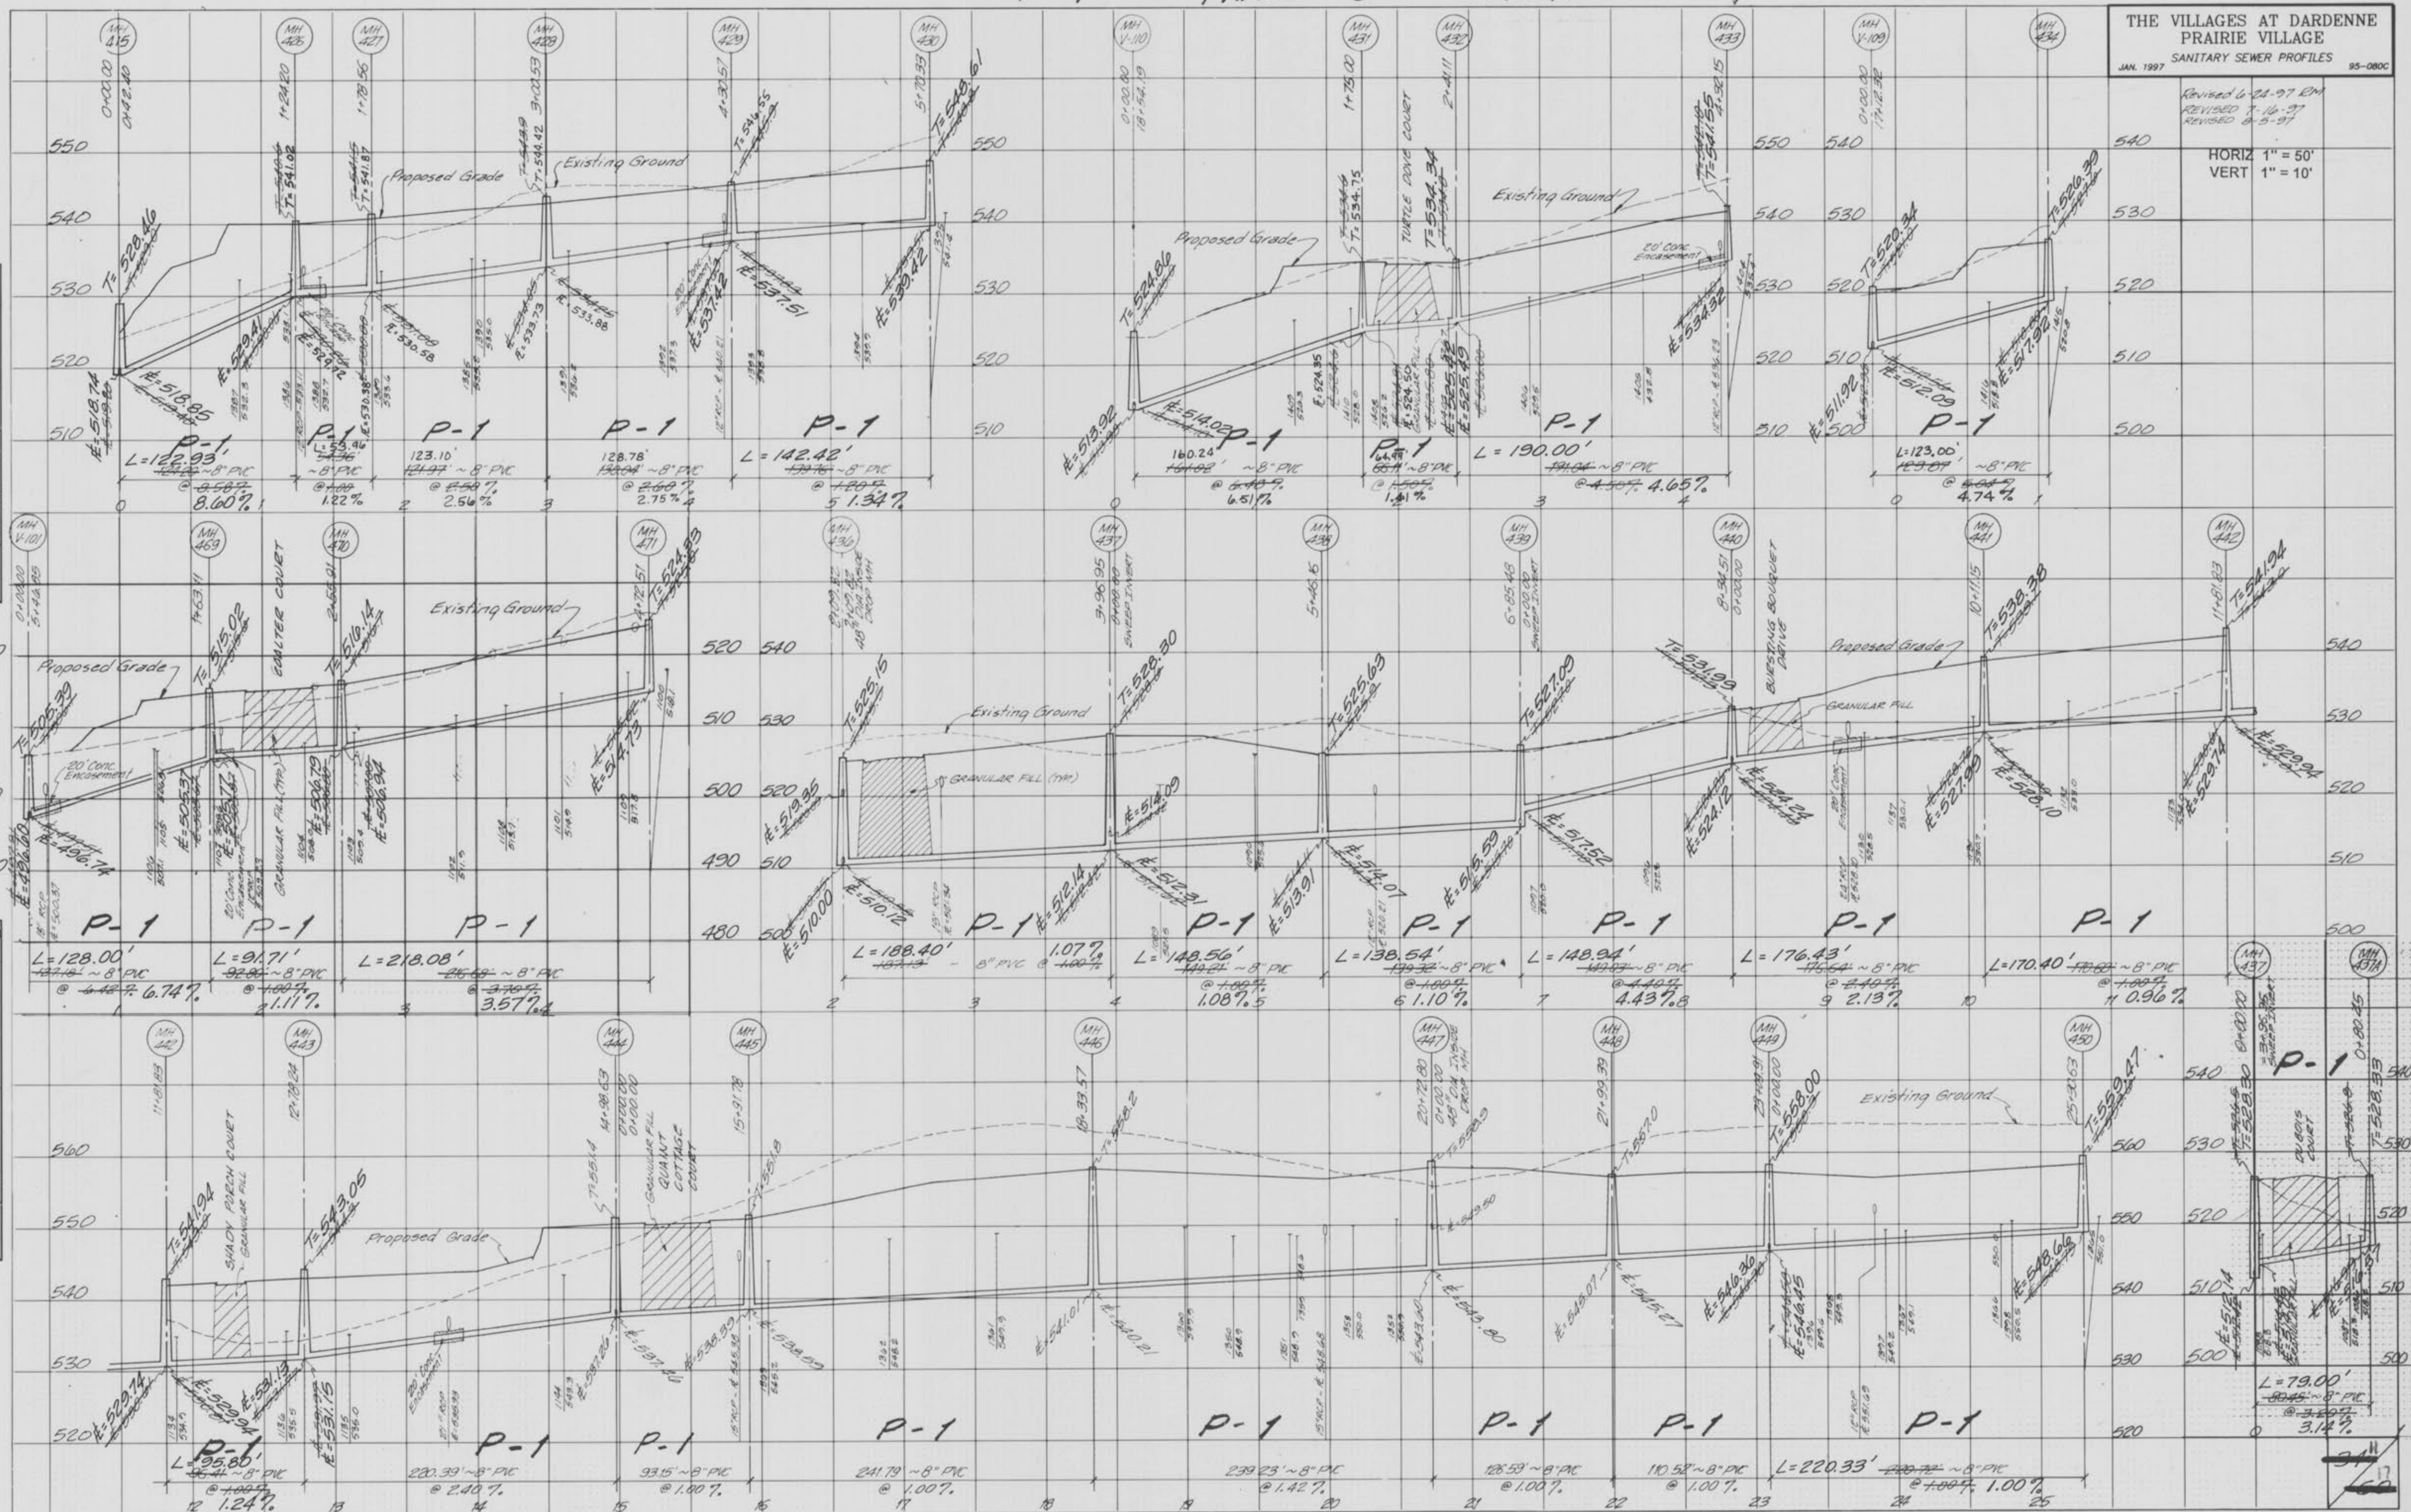

AS-BUILT

THE VILLAGES AT DARDENNE
PRAIRIE VILLAGE
STORM SEWER PROFILES

JAN 1997

85-080C


FINAL SURVEY
SURVEYED
PLOTTED
NOTE BOOK
TEMPLATE
AREAS
APPROVED

BY DATE

ORIGINAL SURVEY
SURVEYED
PLOTTED
NOTE BOOK
TEMPLATE
AREAS
APPROVED

BY DATE

AS-BUILTS

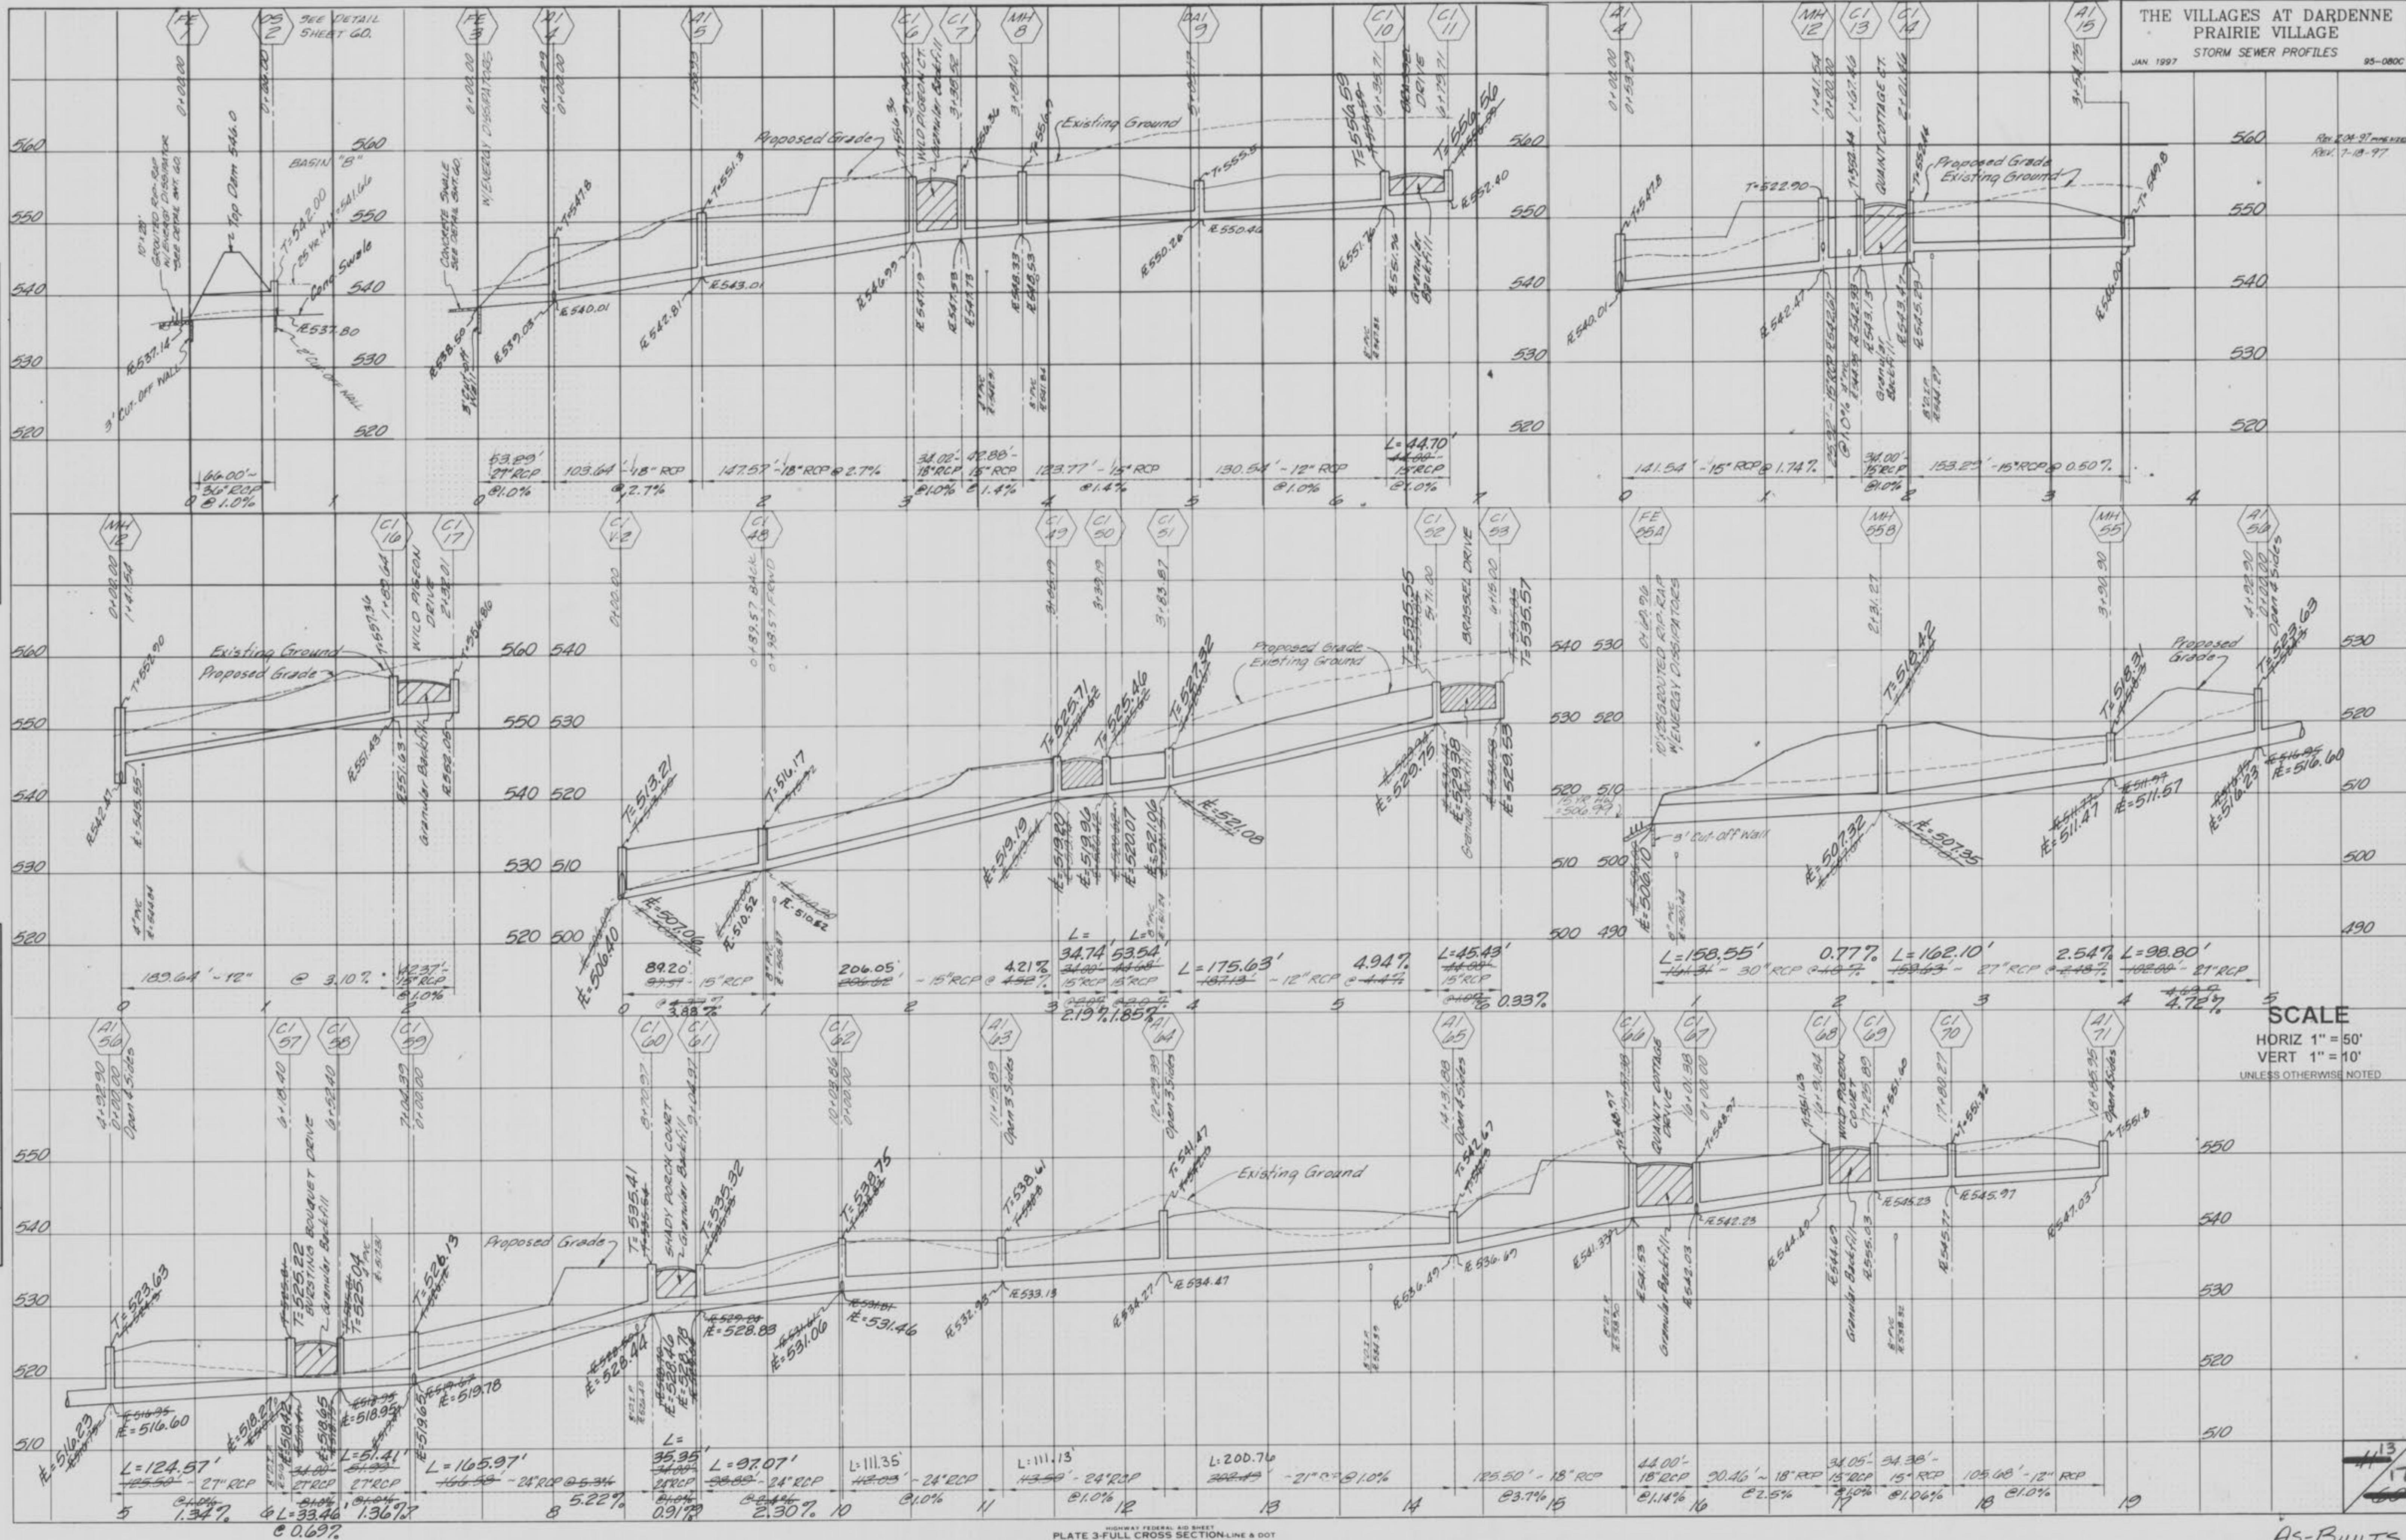

SCALE
HORIZ 1" = 50'
VERT 1" = 10'
UNLESS OTHERWISE NOTED

THE VILLAGES AT DARDENNE
PRAIRIE VILLAGE
STORM SEWER PROFILES


JAN. 1997

95-080C

REV. 2-14-97 4-10-97
Rev. 7-18-97

FINAL SURVEY
RECORDS
TEMPLATES
NOTE BOOK
AREAS CHECKED

ORIGINAL SURVEY
RECORDS
TEMPLATES
NOTE BOOK
AREAS CHECKED

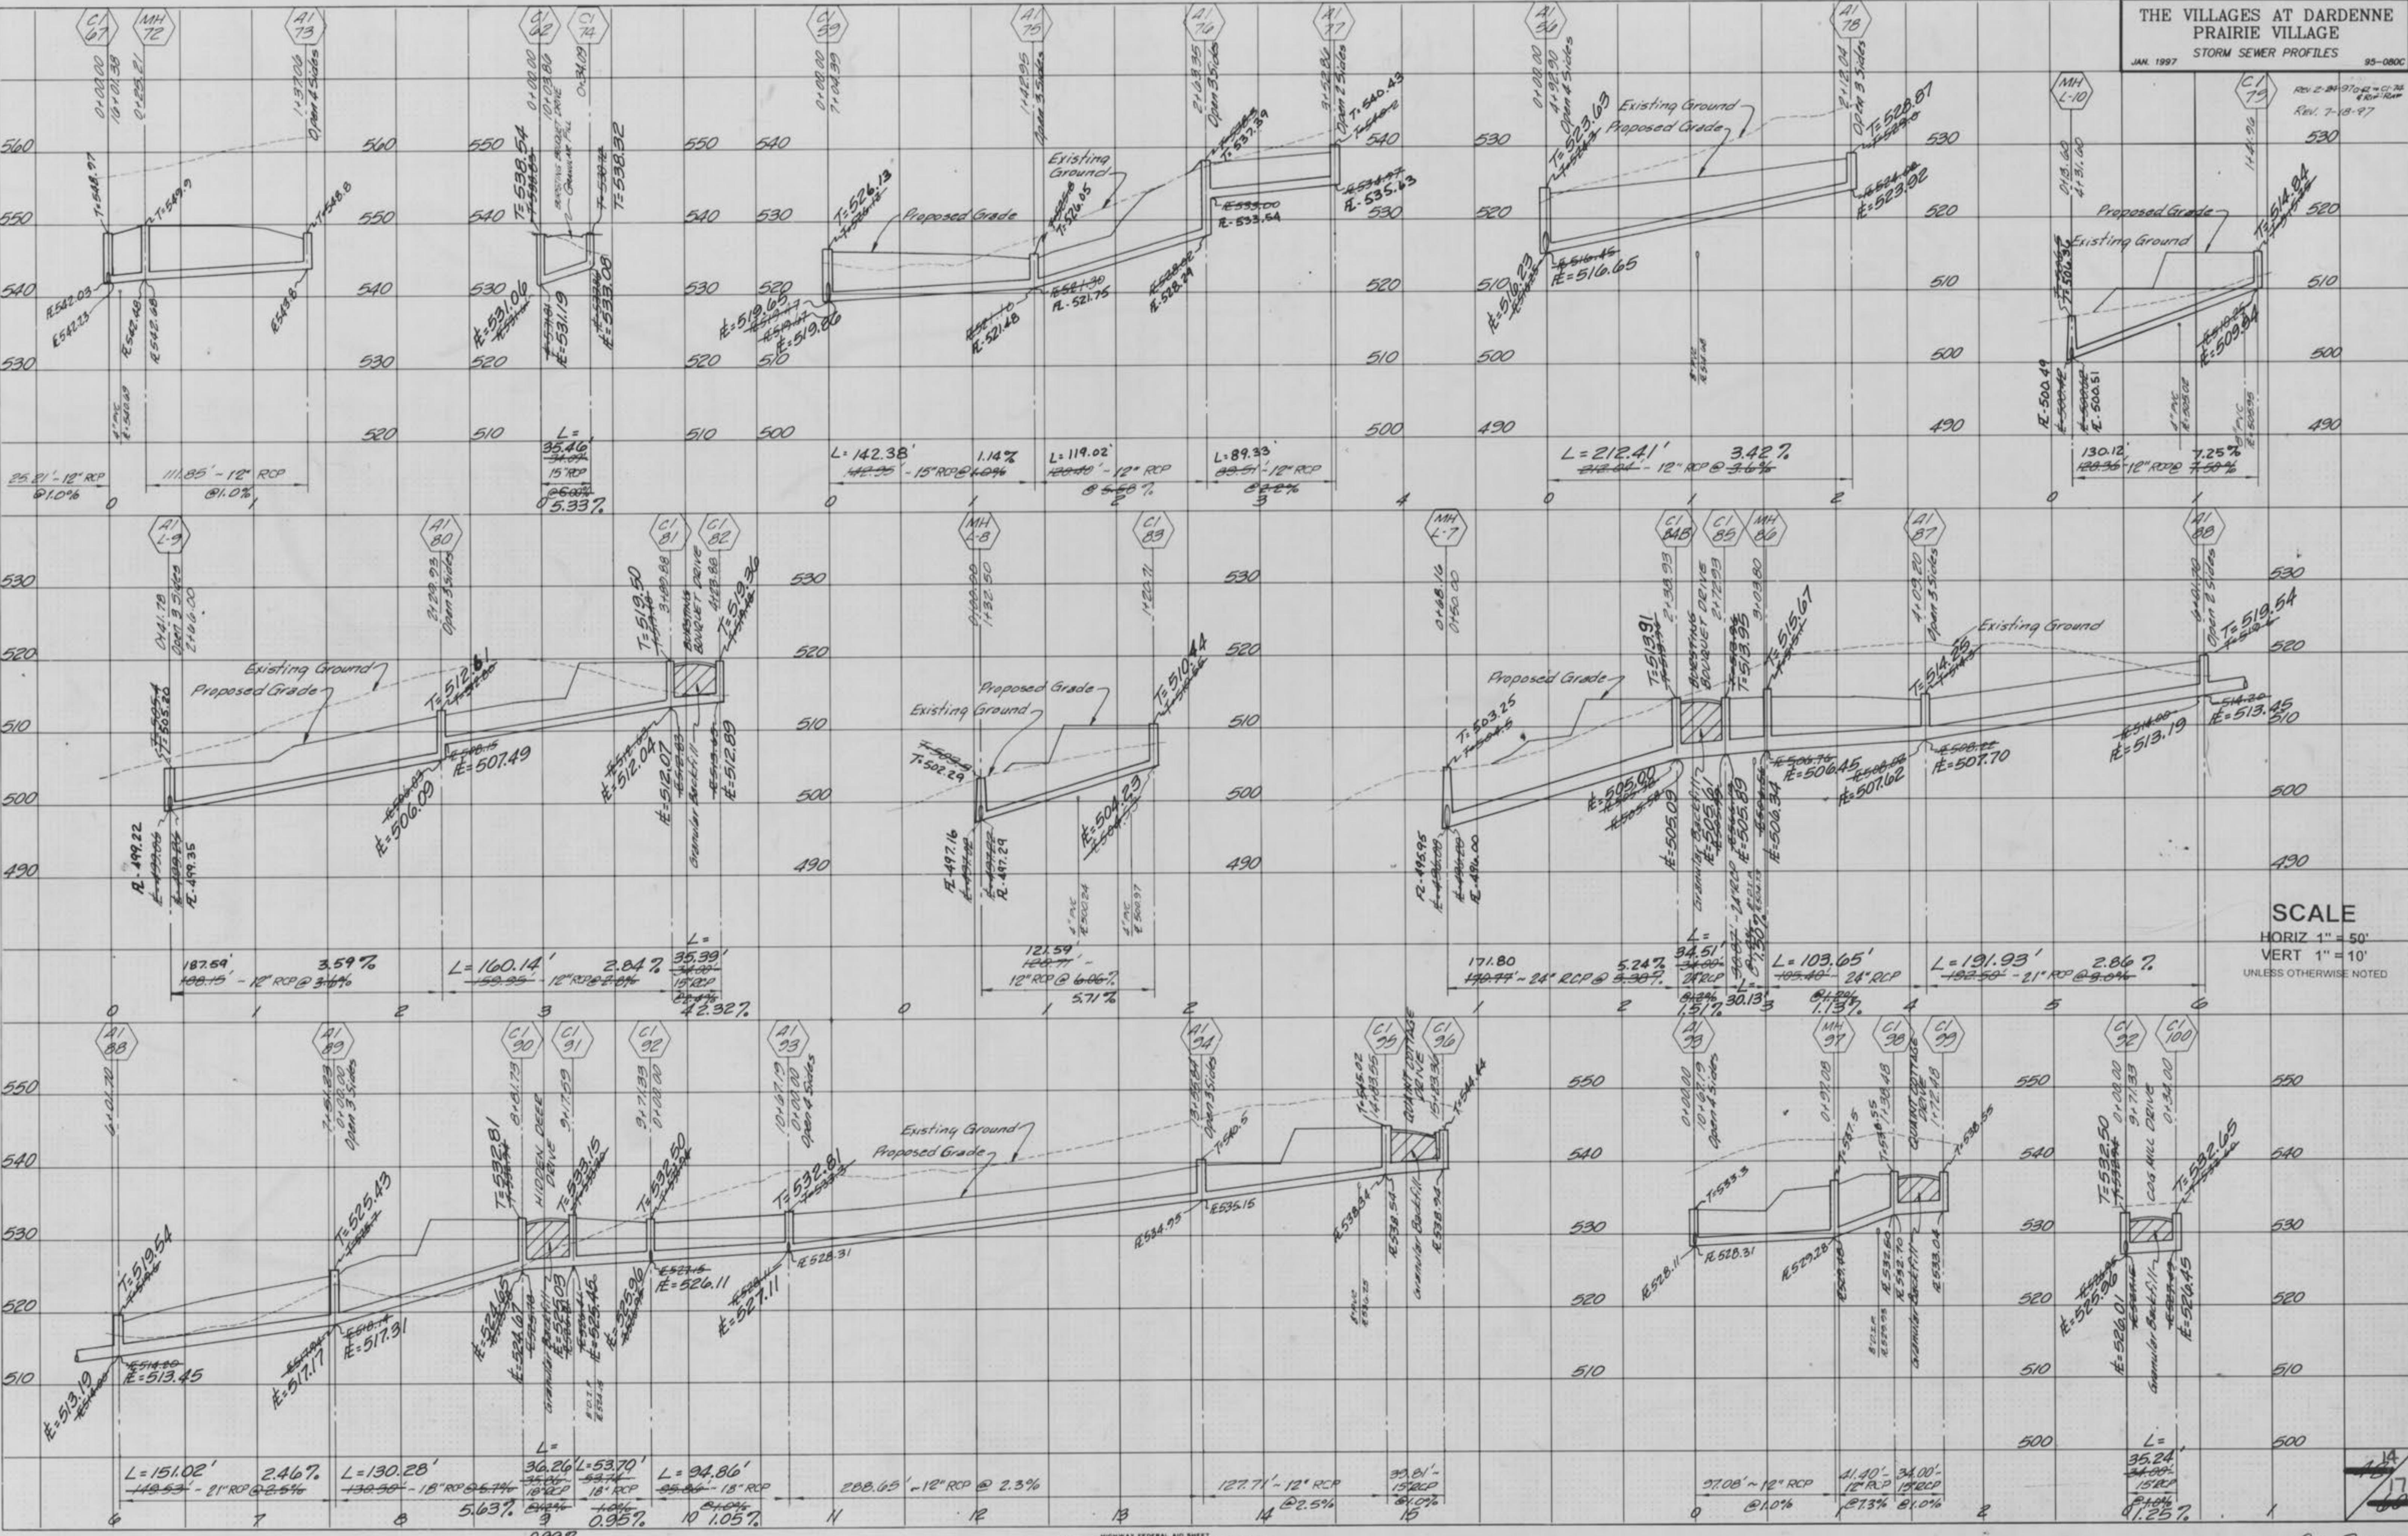

THE VILLAGES AT DARDENNE
PRAIRIE VILLAGE
STORM SEWER PROFILES

JAN 1997

95-080C


REV 2-18-97
200-080C
REV 7-18-97

SCALE

HORIZ 1" = 50'

VERT 1" = 10'

UNLESS OTHERWISE NOTED

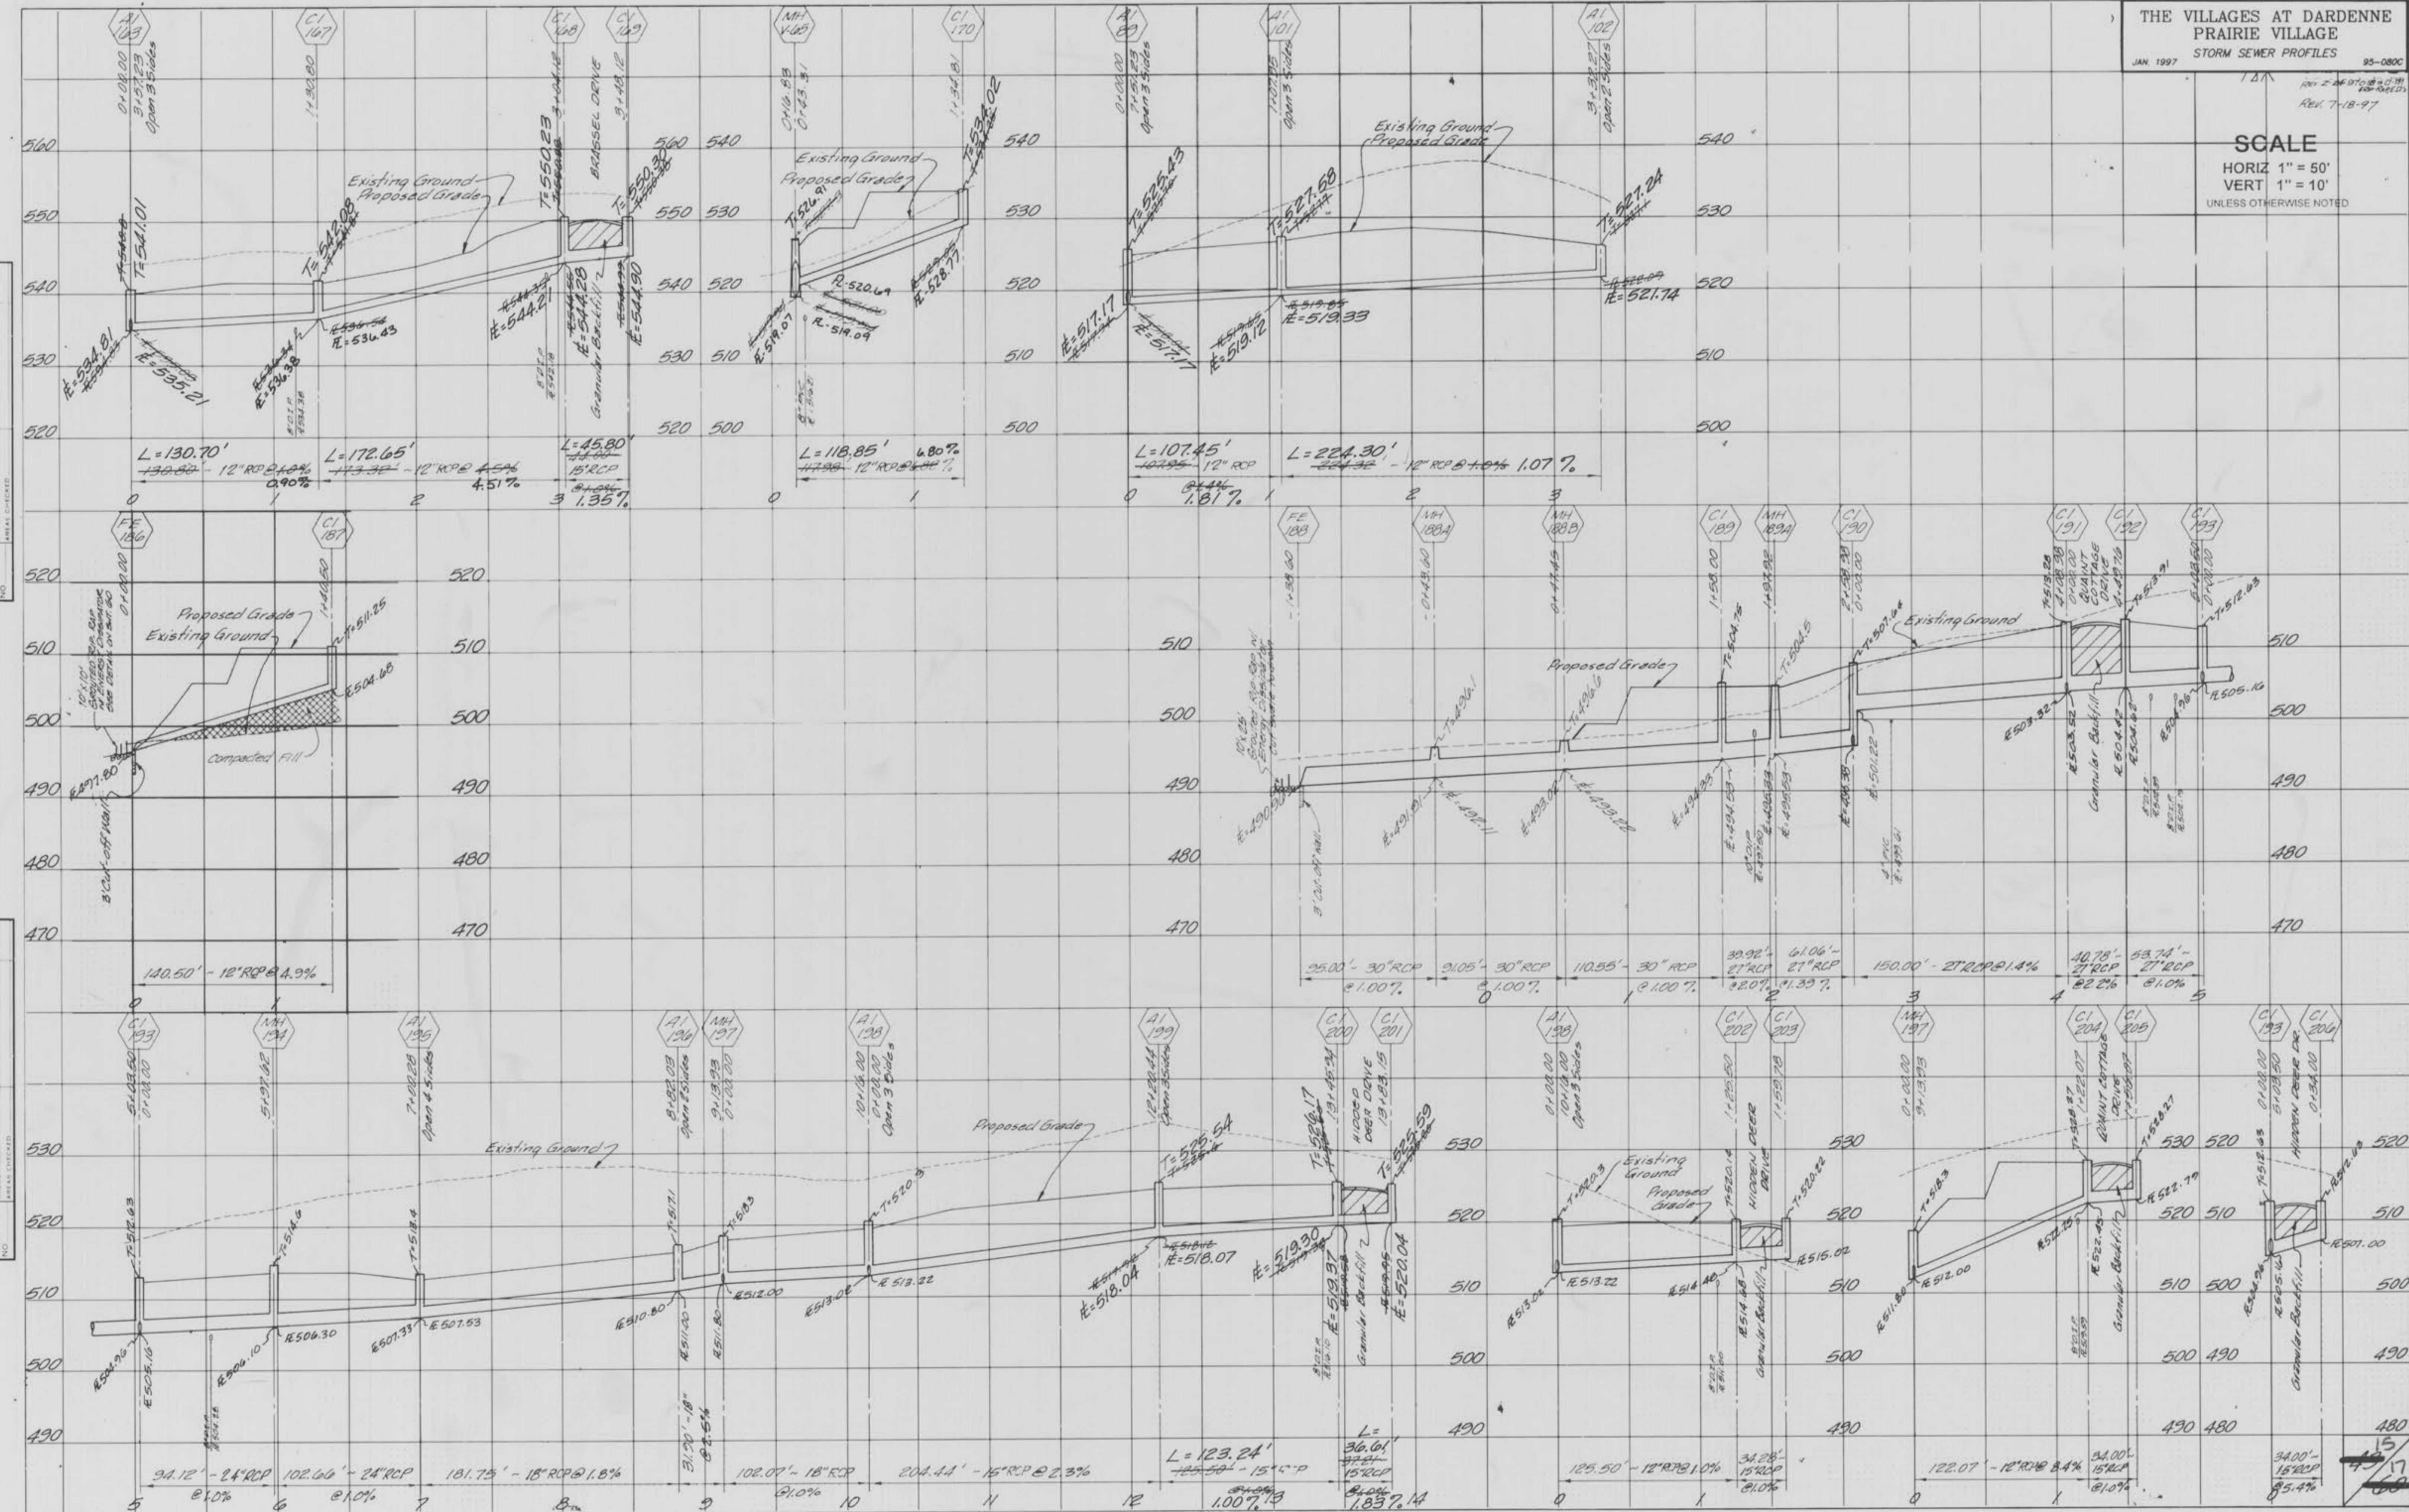


JULY, 1997

95080-C

REVISED 7-15-97 PER ST. CHARLES COUNTY P.M.S.D. NO. 2, E.J.S.

NOTES:

1. ALL WATER MAINS WILL HAVE A MINIMUM OF 42" (3.5') OF COVER OVER PIPE.
2. ALL WATER MAINS WILL BE CLASS 200 P.V.C. PIPE.
3. ALL FIRE HYDRANTS WILL BE LOCATED 5 FEET FROM BACK OF CURB.
4. BLOW-OFF ASSEMBLY'S TO BE LOCATED 3'4" PAST LAST PROPERTY LINE.
5. ALL FIRE HYDRANT HOSE CONNECTIONS MUST FACE STREET.
6. ALL FIRE HYDRANTS MUST BE INSTALLED WITH AN AUXILIARY VALVE.

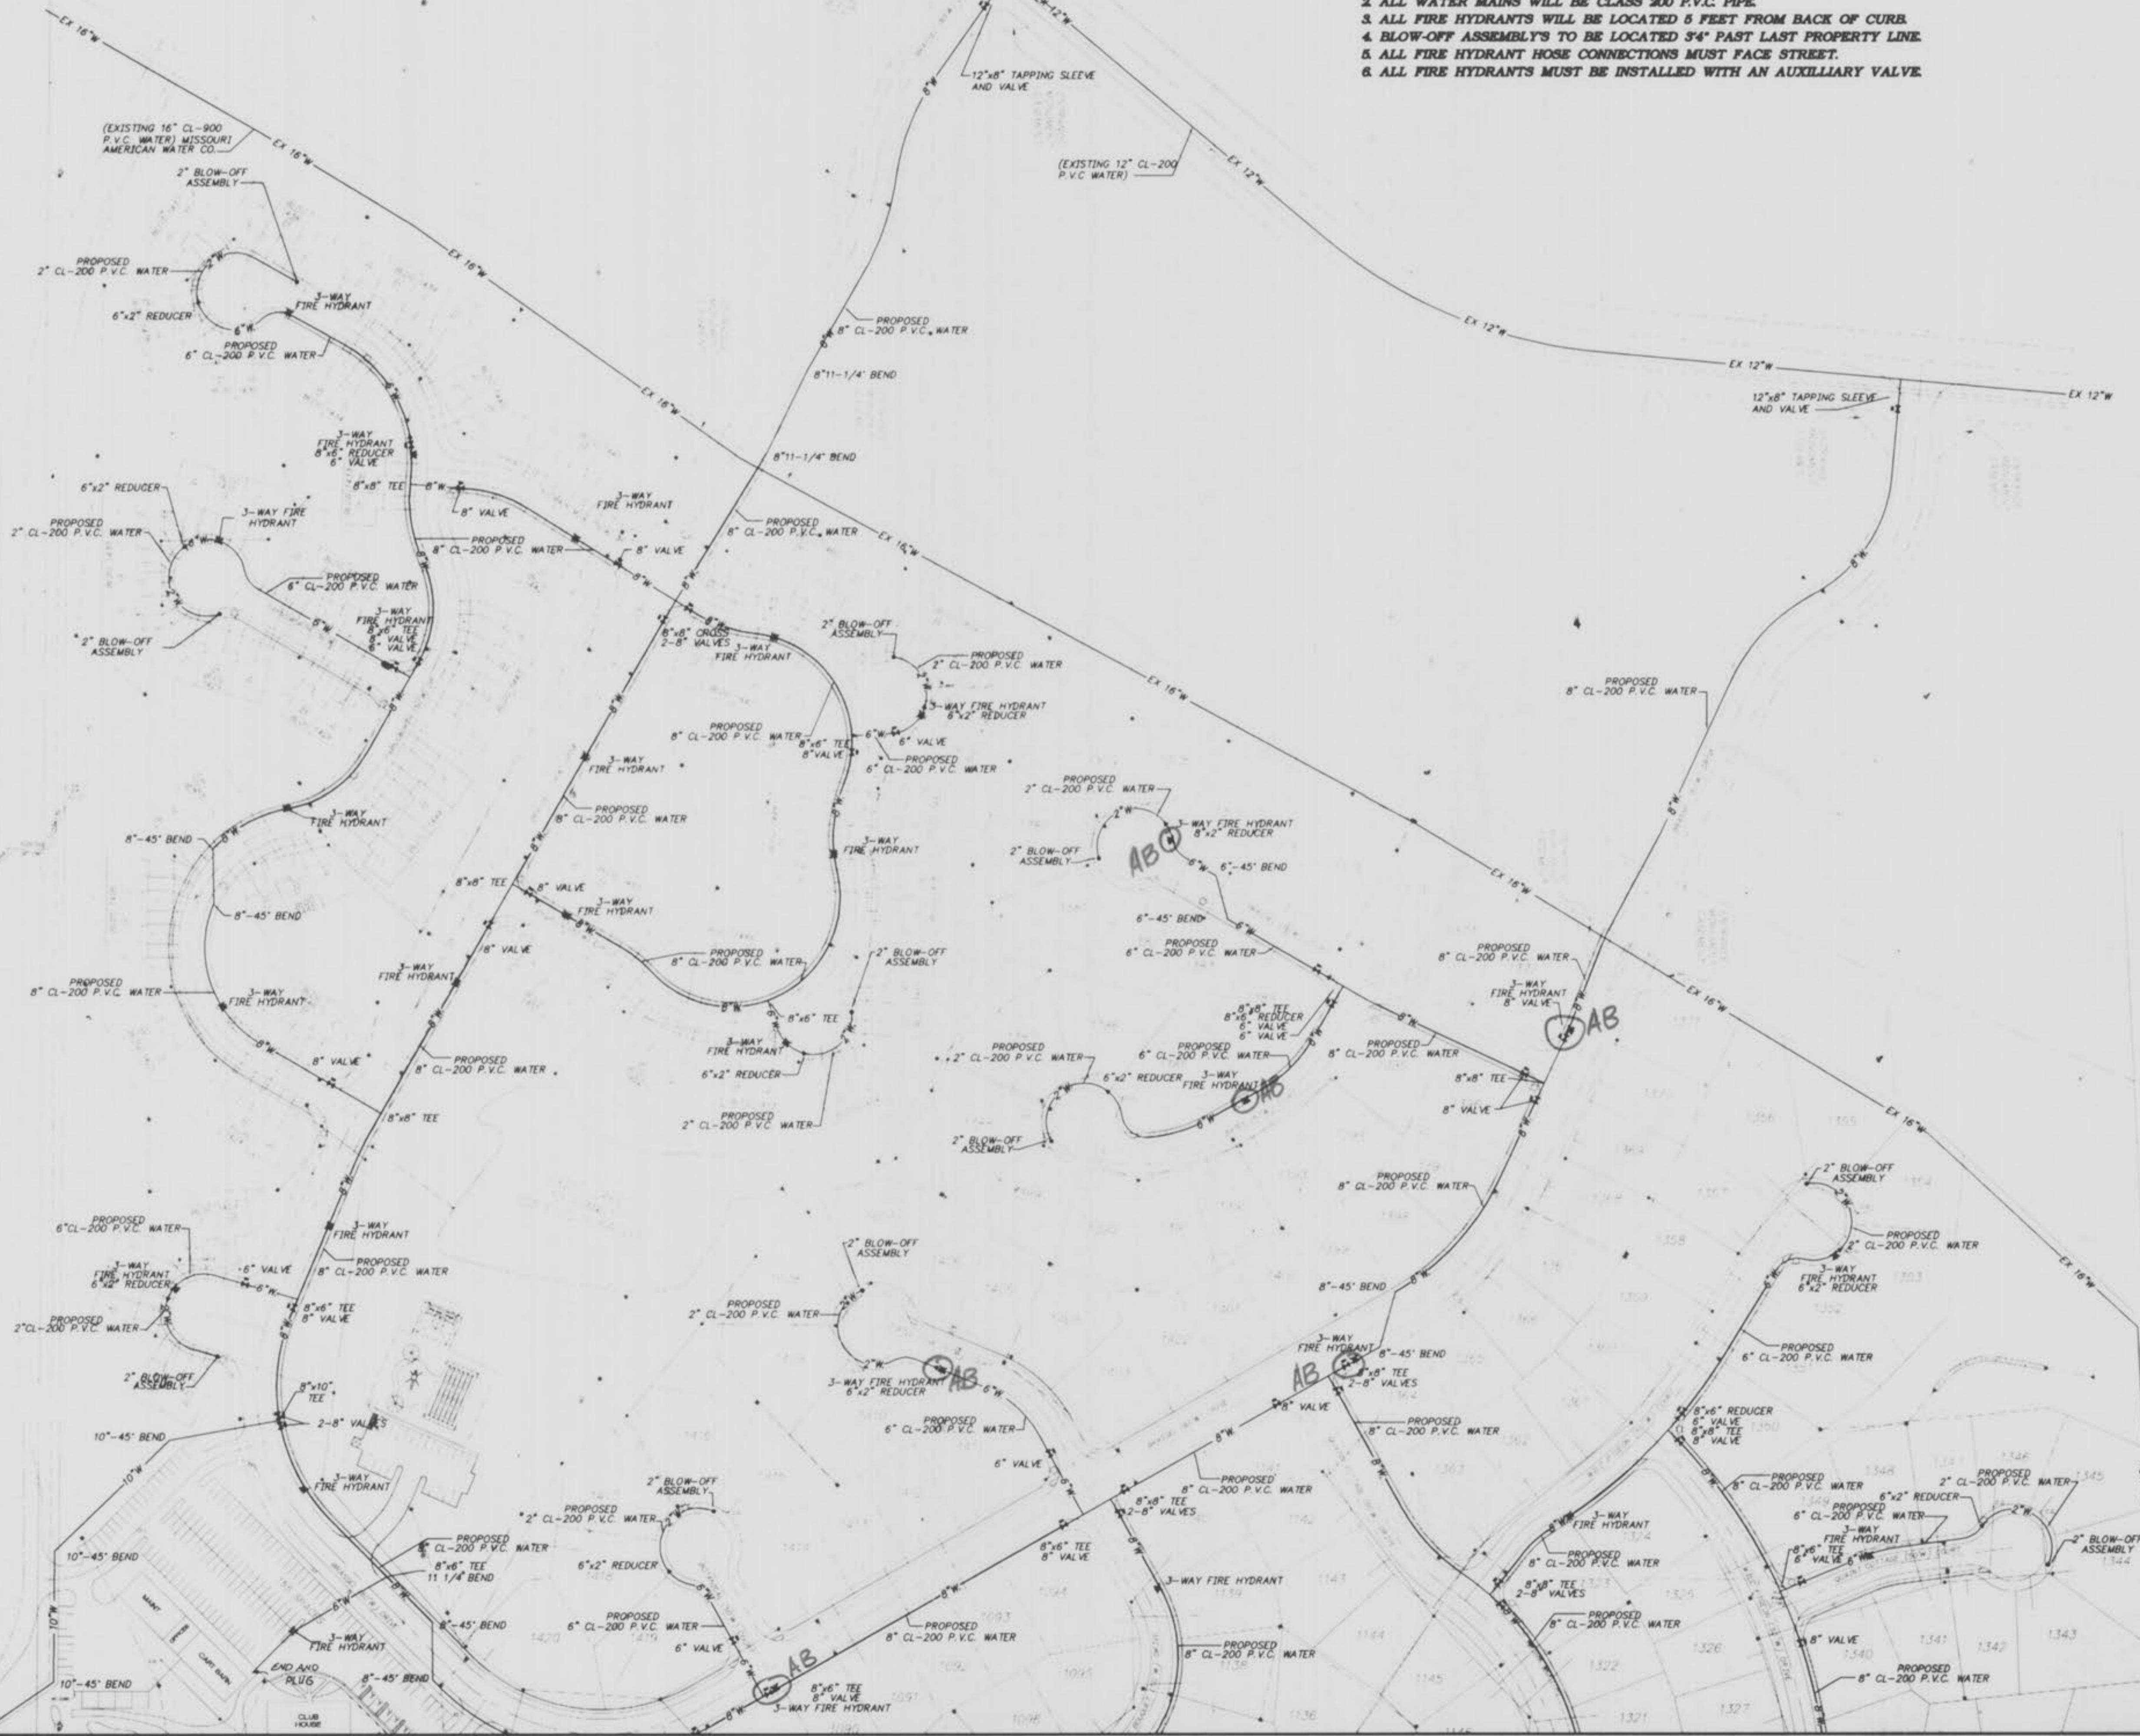


SEE SHEET 60B

SEE SHEET 60A

THE VILLAGES AT DARDENNE
PRAIRIE VILLAGE
WATER LAYOUT PLAN

JULY, 1997
REVISED 7-15-97 PER ST. CHARLES COUNTY P.W.S.D. NO. 2, E.J.S.
95080-C

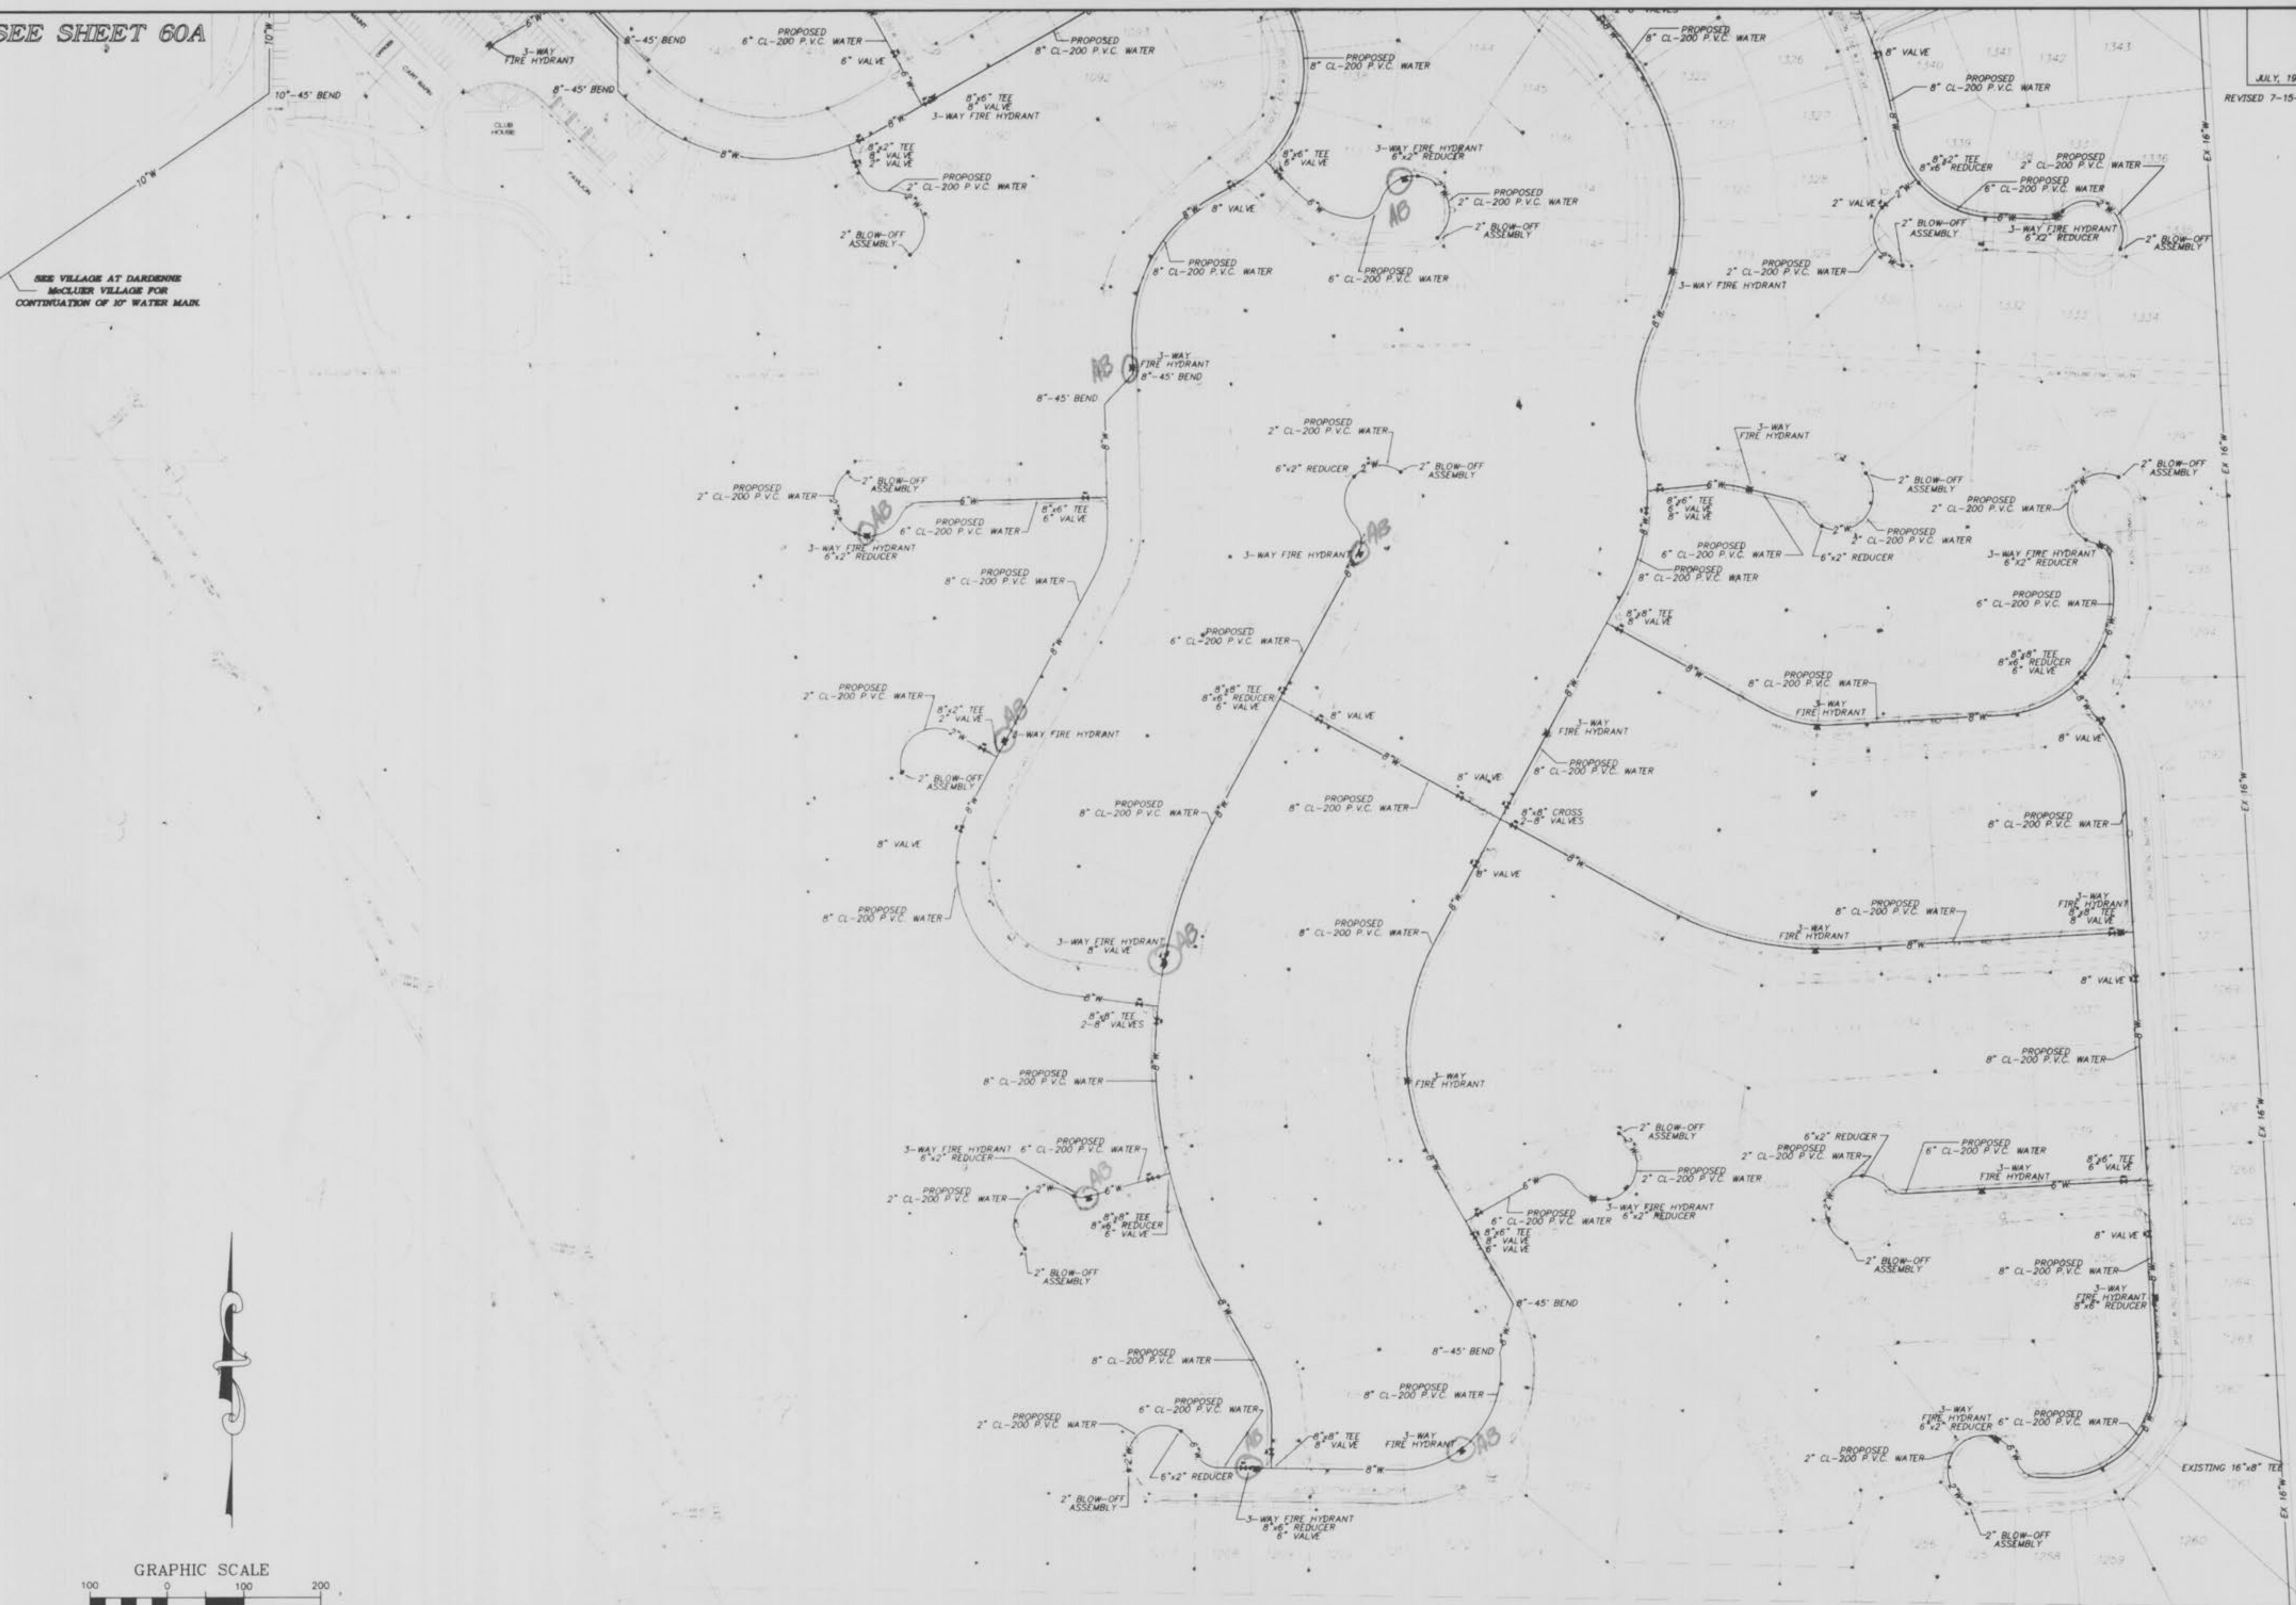

NOTES:

1. ALL WATER MAINS WILL HAVE A MINIMUM OF 42" (3.5') OF COVER OVER PIPE.
2. ALL WATER MAINS WILL BE CLASS 200 PVC PIPE.
3. ALL FIRE HYDRANTS WILL BE LOCATED 5 FEET FROM BACK OF CURB.
4. BLOW-OFF ASSEMBLIES TO BE LOCATED 34' PAST LAST PROPERTY LINE.
5. ALL FIRE HYDRANT HOSE CONNECTIONS MUST FACE STREET.
6. ALL FIRE HYDRANTS MUST BE INSTALLED WITH AN AUXILIARY VALVE.

