

THE VILLAGES OF HUTCHINGS FARM

PHASE TWO "AS-BUILTS"

CITY OF O'FALLON GENERAL NOTES


1. Gas, water and other underground utilities shall not conflict with the depth or horizontal locations of existing and proposed sanitary and storm sewers, including house laterals.
2. Underground utilities have been plotted from available information and, therefore, their locations must be considered approximate only. The location of the location of all underground utilities, either shown or not shown on these plans, shall be the responsibility of the contractor and shall be located prior to grading or construction of improvements.
3. Polyvinyl Chloride (PVC) shall conform to the requirements of ASTM D-3034 Standard Specifications for the PSM Polyvinyl Chloride (PVC) Sewer Pipe and Fittings, SDR-35.
4. All storm sewer pipe under pavement, regardless of size, shall be reinforced concrete pipe (ASTM C-76, Class III) unless noted otherwise in the plans.
5. All storm sewer pipe shall be Class III reinforced concrete pipe.
6. All filled places under buildings, proposed sanitary and storm sewer lines, and/or paved areas including trench backfills shall be compacted to 90% of maximum density as determined by the "Modified A.S.T.M. T.O. T-160 Compaction Test" (ASTM D-1557) unless otherwise specified by the local governing authority specifications. All tests will be verified by a soils engineer.
7. All earthen filled places within State, County, or City roads (Highways) shall be compacted to 95% of maximum density as determined by the "Standard Proctor Test A.A.S.H.T.O. T-99" (ASTM D-698) unless otherwise specified by local governing authority specifications. All tests will be verified by a soils engineer.
8. All storm and sanitary trench backfills shall be water jetted. Granular fill will be used under paved areas.
9. Easements shall be provided for storm sewers, sanitary sewers, and all utilities on the record plat. See record plat for location and size of easements. This does not apply to house laterals.
10. No area shall be cleared without the permission of the developer.
11. All grades shall be within 0.2 feet (more or less) of those shown on the grading plan.
12. No slope shall be greater than 3:1 and shall be either sodded or seeded and mulched.
13. Hazard markers will consist of three (3) standard specification, "Manual on Uniform Traffic Control Devices," end of roadway markers mounted on two (2) pound "U" channel sign post. Each marker shall consist of an eighteen (18) inch diamond reflectorized red panel. The bottom of each panel shall be mounted a minimum of four (4) feet above the elevation of the pavement surface.
14. All manhole and curb inlet tops built without elevations furnished by the Engineer will be the responsibility of the sewer contractor. At the time of construction staking of the sewer lines, all curb and grate inlets will be face staked. If normal face stakes fall in line with sewer construction, the Engineer will set these stakes on a double offset. It shall be the responsibility of the sewer contractor to preserve all face stakes from destruction.
15. All standard street curb inlets to have front of inlet 2 feet behind curb.
16. The minimum vertical distance from the low point of the basement to the flowline of a sanitary sewer at the corresponding house connection shall not be less than the diameter of the sanitary sewer plus a vertical distance not less than two and one-half feet (2-1/2').
17. Water lines, valves, sleeves, meters and etc., shall meet all specifications and installation requirements of the local governing authority.
18. All cast iron pipe for water mains shall conform to A.W.W.A. specification C-106 and/or C-108. The cast iron fittings shall conform to A.W.W.A. specification C-110. All rubber gasket joints for water cast iron pressure pipe and fittings shall conform to A.W.W.A. specification C-111.
19. All water hydrants and valves shall be cast iron and installed in accordance with plans and details.
20. All sanitary and storm sewers shall meet all specifications and installation requirements of the local governing authority.
21. All PVC water pipe shall have a minimum pressure rating of PR-200 or SDR-21.
22. All streets must meet the specifications and installation requirements of the City of O'Fallon.
23. All sanitary manholes top shall be set 0.2' higher than the proposed ground except in pavement areas.
24. All sanitary manholes shall have a .31 mil thick coat of coal tar pitch waterproofing.
25. All sanitary service lines shall have a 6" diameter for multi-family and a 4" diameter for single-family developments.
26. Manhole frame and cover shall be Clay and Bailey No. 2008 or Neenah R-1736 or Deeter 1315 or approved equal.
27. A drop of 0.2 feet is required through each sanitary manhole.
28. The City of O'Fallon shall be notified of least 48 hours prior to construction of sanitary sewers for coordination and inspection.
29. Brick shall not be used on manholes.
30. NOTE: The grading and elevations shown on the grading plans are for construction purposes only. Finished grades, swales and slopes will vary from those shown on the plans depending upon the location and type of house built on the lot. However, care should be taken to insure that finished grading conforms to drainage area maps.
31. As needed, siteline fence shall be installed as a protective barrier for trees to remain.
32. This tract is or is served by:
 - A - Electric - Union Electric Company
 - B - Telephone - GTE Missouri
 - C - Sewers - Duckett Creek Sanitary District - St. Charles County P.W.S.D. No. 2
 - D - Gas - St. Charles Gas Company
 - E - Fire Protection - O'Fallon Fire Protection District
 - F - School District - Fort Zumwalt
 - G - Mail Service - O'Fallon
 - H - Water - St. Charles County P.W.S.D. No. 2
33. Lot Data: A - Total Number of Lots = 406
B - Minimum Lot Size = 8,250 Sq. Ft.
C - Minimum Lot Width at Building Line = 75 ft.
34. Yard and Setback Requirements:
A - Front = 25 feet
B - Side = 6 feet
C - Rear = 25 feet
35. The contractor will be responsible to insure that all areas within the project limits that have been disturbed by the grading process shall be seeded and mulched within ninety (90) days of completion.
36. The contractor will be responsible for the removal and disposal of all existing improvements, except those designated to be left in place, from within the limits of the construction area.
37. The existing structures to be removed from the site will be recycled for future use in accordance with applicable laws.
38. Property is not located within the flood plain boundaries as per FIRM map No. 29183C0239E, revised on August 2, 1996.
39. All existing improvements to be demolished will be transported and disposed of offsite in an authorized landfill.
40. The contractor shall prevent all storm, surface water, mud, and construction debris from entering the existing sanitary sewer system.
41. All sanitary sewer flowlines and tops built without elevations furnished by the engineer will be the responsibility of the sewer contractor.
42. The Duckett Creek Sanitary District shall be notified of least 48 hours prior to construction for coordination and inspection.
43. All exterior sanitary sewer manholes shall be waterproofed on the exterior in accordance Missouri Dept. of Natural Resources specification 10 CSR-8 120(7)(E).
44. All PVC sanitary sewer pipe is to be SDR-35 or equal with "clean" 1/2 inch to 1 inch granular stone bedding uniformly graded. This bedding shall extend from 4 inches below the pipe to springline of pipe. Immediate backfill and pipe shall consist of some size "clean" or "minus" stone from springline of pipe to 6 inches above the top of pipe.
45. All pipes shall have positive drainage through manholes. No flat base structures are allowed.
46. All creek crossings shall be grouted rip-rap as directed by Duckett Creek Sanitary District Inspectors. (All grout shall be high slump ready-mix concrete).
47. Trees required to be replaced per "Tree Preservation Ordinance":
15 Trees / .4 acres of clearing
Trees Required = 33.47 acres x 15 Trees / acre = 502 Trees
48. Landscaping to be installed per the approved Planning & Zoning plans.
49. All internal intersections meet sight distance requirements.
50. Blow-off hydrants and water meters shall not be located in walkways or driveways.
51. All fire hydrants must be installed with an auxiliary valve.
52. Pre-Manufactured adapters shall be used at all PVC to DIP connections. Rubber boot/mission-type couplings will not be allowed.

SANITARY SEWER EXTENSION

A TRACT OF LAND BEING PART OF SECTION 4
TOWNSHIP 46 NORTH, RANGE 3 EAST
ST. CHARLES COUNTY, MISSOURI

195 FUTURE LOTS

(45 Lots to St. Charles County P.W.S.D. No. 2
Lots 129-133, 280-283, 288-323)

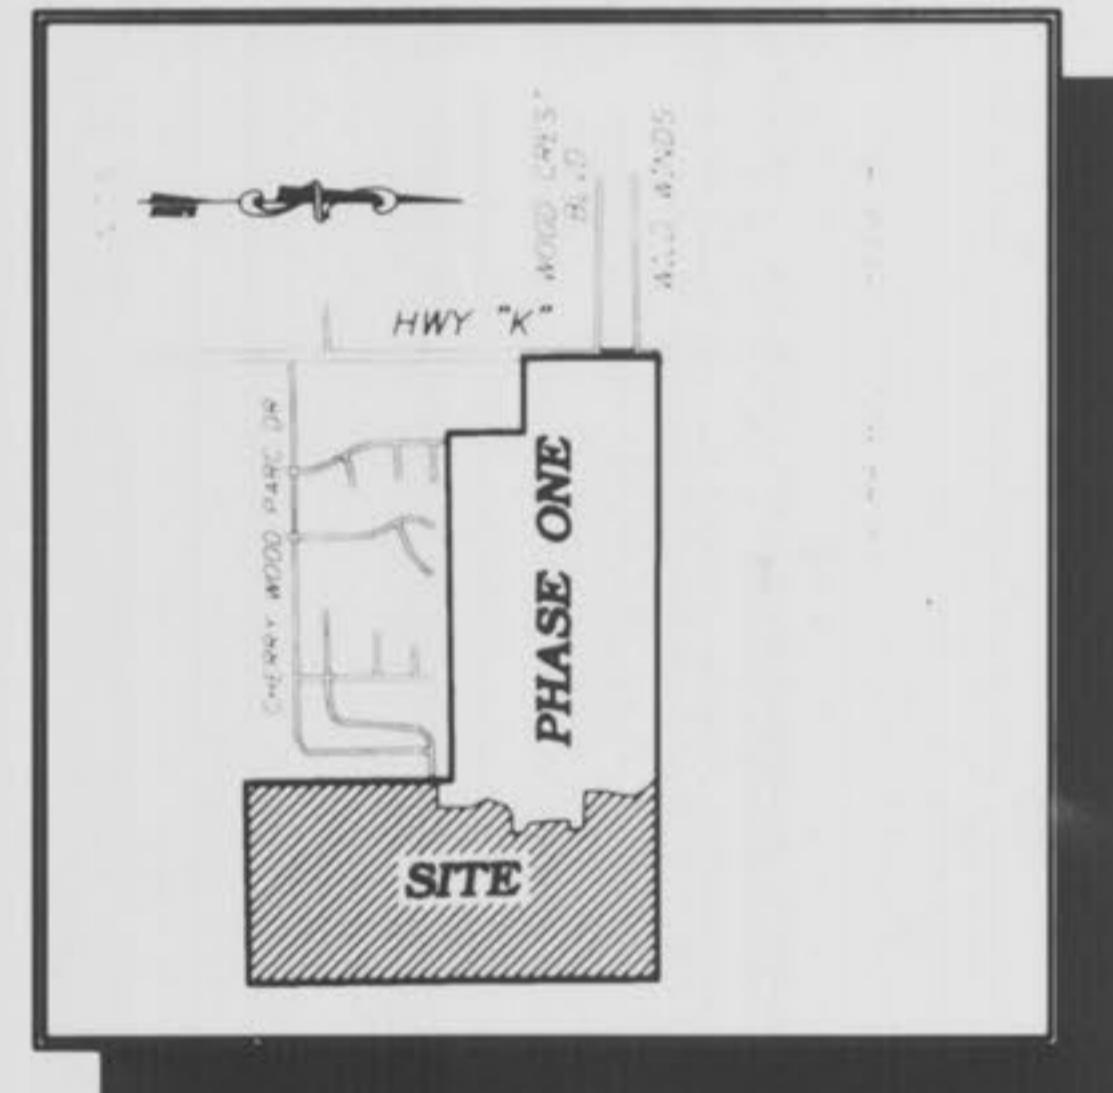

LOCATION MAP

BENCHMARK :

B.M. (U.S.G.S.) ELEVATION = 462.06
CHISELED "□" SQUARE ON NORTH WING WALL @ EAST END OF MEXICO ROAD BRIDGE OVER DARDENNE CREEK.
(BASED ON FIRM B.M. RM#727)

SITE BENCHMARK :

B.M. No.2 (U.S.G.S.) ELEVATION = 568.69
CHISELED "□" ON WEST SIDE OF 2' DIA CONC. BASE OF FLASHING YELLOW LIGHT WITH PEDESTRIAN CROSSING SIGN,
EAST SIDE OF HWY "K" ± 106' NORTH OF BABBLE CREEK.

This is to certify to _____ that these "As-Built" _____ plans are based on actual field surveys conducted during _____, 19_____, and the results are shown herein.

REVISIONS

By _____
DANIEL EHLMANN, R.L.S., #2215
STATE OF MISSOURI
PICKETT, RAY & SILVER'S CORPORATE
REGISTRATION NO. LS-54-D

AS-BUILTS 2-24-99

ENGINEERS AUTHENTICATION

The responsibility for professional engineering design of this project rests with the engineer whose signature appears on the seal. Signature and date hereunder attached, respectively, is designated for all other engineering work involved in the project and is valid for a period of one year from the date hereunder reauthenticated.

PICKETT, RAY & SILVER, INC.

[Signature]



HARDESTY DEVELOPMENT COMPANY LLC
232 Chesterfield Ind. Blvd.
Chesterfield, MO. 63005
(314) 530-9777

DEVELOPER

"AS-BUILTS"

© Copyright 1998 by Pickett, Ray & Silver Inc.

CONFIDENTIAL PROPRIETARY MATERIAL
The use, reproduction and sales rights of this drawing are reserved by Pickett, Ray & Silver Inc.

DRAWN	E.J.S.	DATE	JAN 1998
CHECKED	J.C.	DATE	JAN 1998
FIELD	617	PROJECT #	95-234
BOOK		JOH ORDER #	35536

1
83

PHASE TWO

PICKETT RAY & SILVER

Civil Engineers
Planners
Land Surveyors

333 Mid Rivers Mall Dr.
St. Peters, MO 63376
397-1211 FAX 397-1104

GRAPHIC SCALE
(IN FEET)
1 inch = 50 ft.

PROPOSED SANITARY SEWER EXTENSION

N01°27'28"W

1341.60'(S) 1342.96'(R1)

