


LOCATION MAP

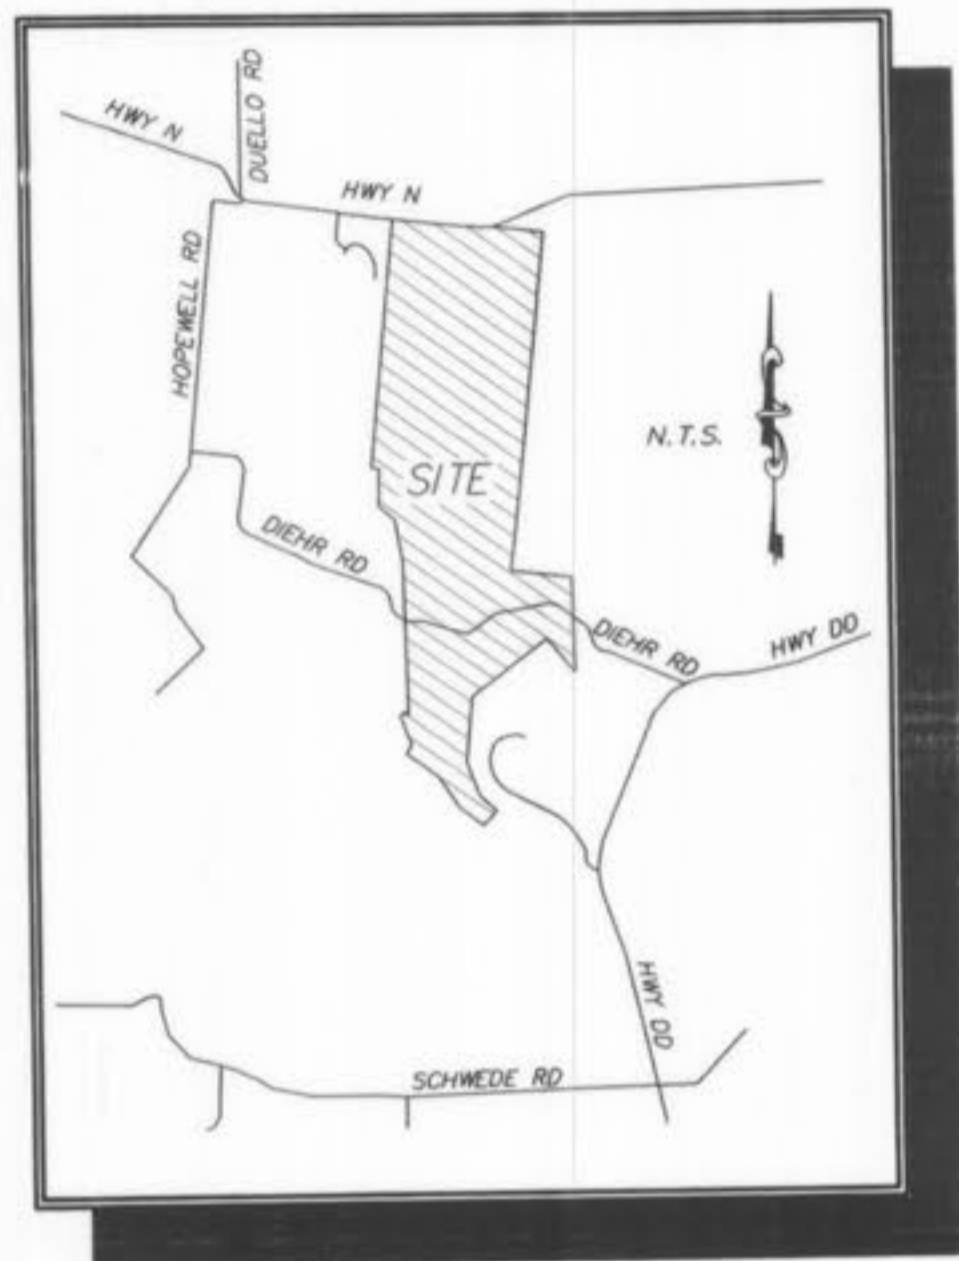

WYNDGATE DETENTION BASINS 2, 3, & 4 AS-BUILT PLANS

TRACTS OF LAND BEING PART OF FRACTIONAL
SECTIONS 16 & 17, AND U.S. SURVEYS 61 & 417,
TOWNSHIP 46 NORTH, RANGE 2 EAST,
ST. CHARLES COUNTY, MISSOURI

LEGEND

—○— Sanitary Sewer (Proposed)	⊕ Sanitary Structure	R.C.P. Reinforced Concrete Pipe
—○— Sanitary Sewer (Existing)	⊕ Storm Structure	C.M.P. Corrugated Metal Pipe
--- Storm Sewer (Proposed)	⊕ Test Hole	C.I.P. Cast Iron Pipe
--- Storm Sewer (Existing)	⊕ Power Pole	P.V.C. Polyvinyl Chloride
— Water Line & Size	⊕ Light Standard	V.C.P. Vitrified Clay Pipe
— Existing water line	⊕ Double Water Meter Setting	C.O. Clean Out
⊕ Tee & Valve	⊕ Single Water Meter Setting	V.T. Vent Trap
⊕ Hydrant	C.I. Curb Inlet	T.B.R. To Be Removed
⊕ Cap	S.C.I. Skewed Curb Inlet	T.B.R.&R. To Be Removed & Relocated
18 Lot or Building Number	D.C.I. Double Curb Inlet	T.B.P. To Be Protected
— Existing Fence Line	G.I. Grate Inlet	T.B.A. To Be Abandoned
— Existing Tree Line	A.I. Area Inlet	B.C. Base Of Curb
⊕ Street Sign	D.A.I. Double Area Inlet	T.C. Top Of Curb
— Existing Contour	C.C. Concrete Collar	T.W. Top Of Wall
— Proposed Contour	F.E.S. Flared End Section	B.W. Base Of Wall
⊕ Rip-Rap	E.P. End Pipe	(TYP) Typical
— End of Lateral	E.D. Energy Dissipator	U.N.O. Unless Noted Otherwise
⊕ Asphalt Pavement	M.H. Manhole	U.I.P. Use in Place
⊕ Concrete Pavement	C.P. Concrete Pipe	Yield Sign
— Proposed Swale	S.A.S. Siskhole Access Structure	

LAKE/BASIN 1

See separate Lake As-Built
Plans submitted 12/21/06.

BASIN 3

BASIN 4

BASIN 2

BASIN 5

Previously approved with
Village F-2 As-Built.

Call BEFORE you DIG
TOLL FREE
1-800-344-7483
MISSOURI ONE-CALL SYSTEM, INC.

MoDOT LOCATOR: 314-340-4100

PROJECT BENCH MARK

U.S.G.S BENCH MARK
At Dardenne T.46N., R.2E. Near Approx. Corner
Sections 1, 2, 11 & 12, 31' north & 20' west
of crossroads, 49' south of S.E. corner of Catholic Church,
2.0' north of sidewalk & in a concrete post standard
tablet stamped "11" 60C 1936 616".
Elev. 616.50

SITE BENCH MARK

FOUND OLD STONE
N.E. Corner of U.S. Survey 61
Elev. 640.47

These "As-Built" plans, are based on actual field measurements conducted during September and November, 2006 and the results are shown hereon.

By:
JAMES R. CHERVEK P.L.S., #2211
STATE OF MISSOURI
PICKETT, RAY & SILVER'S CORPORATE
REGISTRATION NO. LS-54-D

DRAWING INDEX

Sheet	Description
1	COVER SHEET
2	GENERAL NOTES & REVISION BLOCK
3	SITE MAP
4-8	EROSION CONTROL PLANS
9	EROSION DETAIL
10A	VILLAGE "A" COVER SHEET
11A-13A	VILLAGE "A" SITE PLAN
14A-16A	VILLAGE "A" GRADING PLAN
17A	VILLAGE "A" STREET PROFILES
18A-19A	VILLAGE "A" SANITARY SEWER PROFILES
20A-21A	VILLAGE "A" STORM SEWER PROFILES
22A-25A	VILLAGE "A" DRAINAGE AREA MAP
26A-28A	VILLAGE "A" WATER LAYOUT
29A	VILLAGE "A" DETENTION BASIN
30A	VILLAGE "A" WINTER PARK RECREATION AREA
31A	VILLAGE "A" LANDSCAPING PLAN
32B	VILLAGE "B" COVER SHEET
33B-35B	VILLAGE "B" SITE PLAN
36B-38B	VILLAGE "B" GRADING PLAN
39B-41B	VILLAGE "B" STREET PROFILES
42B-44B	VILLAGE "B" SANITARY SEWER PROFILES
45B-47B	VILLAGE "B" STORM SEWER PROFILES
48B-51B	VILLAGE "B" DRAINAGE AREA MAP
52B-54B	VILLAGE "B" WATER LAYOUT
55B	VILLAGE "B" TEMP. SCHOOL BUS ACCESS & POOL SITE
56B	VILLAGE "B" SUMMER PARK POOL SITE
57B	VILLAGE "B" LANDSCAPING PLAN
58C	VILLAGE "C" COVER SHEET
59C-60C	VILLAGE "C" SITE PLAN
61C-62C	VILLAGE "C" GRADING PLAN
63C-64C	VILLAGE "C" STREET PROFILES
65C-66C	VILLAGE "C" SANITARY SEWER PROFILES
67C-68C	VILLAGE "C" STORM SEWER PROFILES
69C-70C	VILLAGE "C" DRAINAGE AREA MAP
71C-72C	VILLAGE "C" WATER LAYOUT
73C	VILLAGE "C" LANDSCAPING PLAN
74D	VILLAGE "D" COVER SHEET
75D-77D	VILLAGE "D" SITE PLAN
78D-80D	VILLAGE "D" GRADING PLAN
81D-82D	VILLAGE "D" STREET PROFILES
83D-84D	VILLAGE "D" SANITARY SEWER PROFILES
85D-86D	VILLAGE "D" STORM SEWER PROFILES
87D-89D	VILLAGE "D" DRAINAGE AREA MAP
90D-92D	VILLAGE "D" WATER LAYOUT
93D	VILLAGE "D" RETAINING WALLS
94D	VILLAGE "D" LANDSCAPING PLAN
95E	VILLAGE "E" COVER SHEET
96E-99E	VILLAGE "E" SITE PLAN
100E-103E	VILLAGE "E" GRADING PLAN
104E-106E	VILLAGE "E" STREET PROFILES
107E	VILLAGE "E" DIEHR RD. ENTRANCE DETAIL
108E	VILLAGE "E" SIGHT DISTANCE EXHIBIT
109E-111E	VILLAGE "E" SANITARY SEWER PROFILES
112E-114E	VILLAGE "E" STORM SEWER PROFILES
115E-120E	VILLAGE "E" DRAINAGE AREA MAP
121E-124E	VILLAGE "E" WATER LAYOUT
125E-126E	VILLAGE "E" DETENTION BASIN
127E	VILLAGE "E" AUTUMN PARK/SPRING PARK REC. AREAS
128E	VILLAGE "E" MBR LANDSCAPING PLAN
129E-130E	VILLAGE "E" LANDSCAPING PLAN
131F	VILLAGE "F" COVER SHEET
132F-136F	VILLAGE "F" SITE PLAN
137F-139F	VILLAGE "F" GRADING PLAN
140F-141F	VILLAGE "F" STREET PROFILES
142F-143F	VILLAGE "F" DIEHR RD. ENTRANCE DETAILS
144F-146F	VILLAGE "F" SANITARY SEWER PROFILES
147F	VILLAGE "F" LIFT STATION SITE PLAN
148F-149F	VILLAGE "F" LIFT STATION DETAILS
150F-151F	VILLAGE "F" STORM SEWER PROFILES
152F-154F	VILLAGE "F" DRAINAGE AREA MAP
155F-157F	VILLAGE "F" WATER LAYOUT
158F	VILLAGE "F" DETENTION BASIN
159F	VILLAGE "F" RETAINING WALLS
160F	VILLAGE "F" LANDSCAPING PLAN
161-164	TRAFFIC CONTROL PLANS
165-174B	GENERAL CONSTRUCTION DETAILS

SEE SHEET 2 FOR FURTHER REVISIONS.

REVISIONS	NO.	DATE	REVISED PER CITY	REVISED PER PSD #1	REVISED PER PSD #2	REVISED PER PSD #3	REVISED PER PSD #4	REVISED PER PSD #5	REVISED PER PSD #6	REVISED PER PSD #7	REVISED PER PSD #8	REVISED PER PSD #9	REVISED PER PSD #10
	1	10/25/04											
	2	12/09/04											
	3	12/29/04											
	4	01/20/05											
	5	02/03/05											
	6	02/18/05											
	7	03/08/05											
	8	03/25/05											
	9	04/08/05											
	10	04/13/05											

ENGINEERS AUTHENTICATION
The responsibility for professional engineering liability on this project is hereby limited to the set of plans authenticated by the seal, signature, and date hereunder attached. Responsibility is disclaimed for all other engineering plans involved in this project and specifically excludes revisions after this date unless reauthenticated.
PICKETT, RAY & SILVER, INC

DRAWN	J.E.E.	DATE	6-29-04
CHECKED	D.W.D.	DATE	6-29-04
PROJECT #	01267.SUPO.02R		
TASK #	2	FIELD BOOK	

WYNDGATE - PHASE 1
BASINS 2, 3, & 4
AS-BUILTS
SHEET 1 OF 174
© Copyright 2004 by Pickett, Ray & Silver Inc.




PICKETT RAY & SILVER
CIVIL ENGINEERS
PLANNERS
LAND SURVEYORS
333 Mid Rivers Mall Drive
St. Peters, MO 63376
Phone (636) 397-1211
Fax (636) 397-1104

WYNDGATE
DETENTION BASINS 2, 3, & 4
AS-BUILTS
Prepared For:
SUMMIT POINTE, L.C.
219 FOX HILL ROAD
ST. CHARLES, MO. 63011
(636) 940-9500





P & Z NO. 3203



BASIN AS-BUILT ONLY

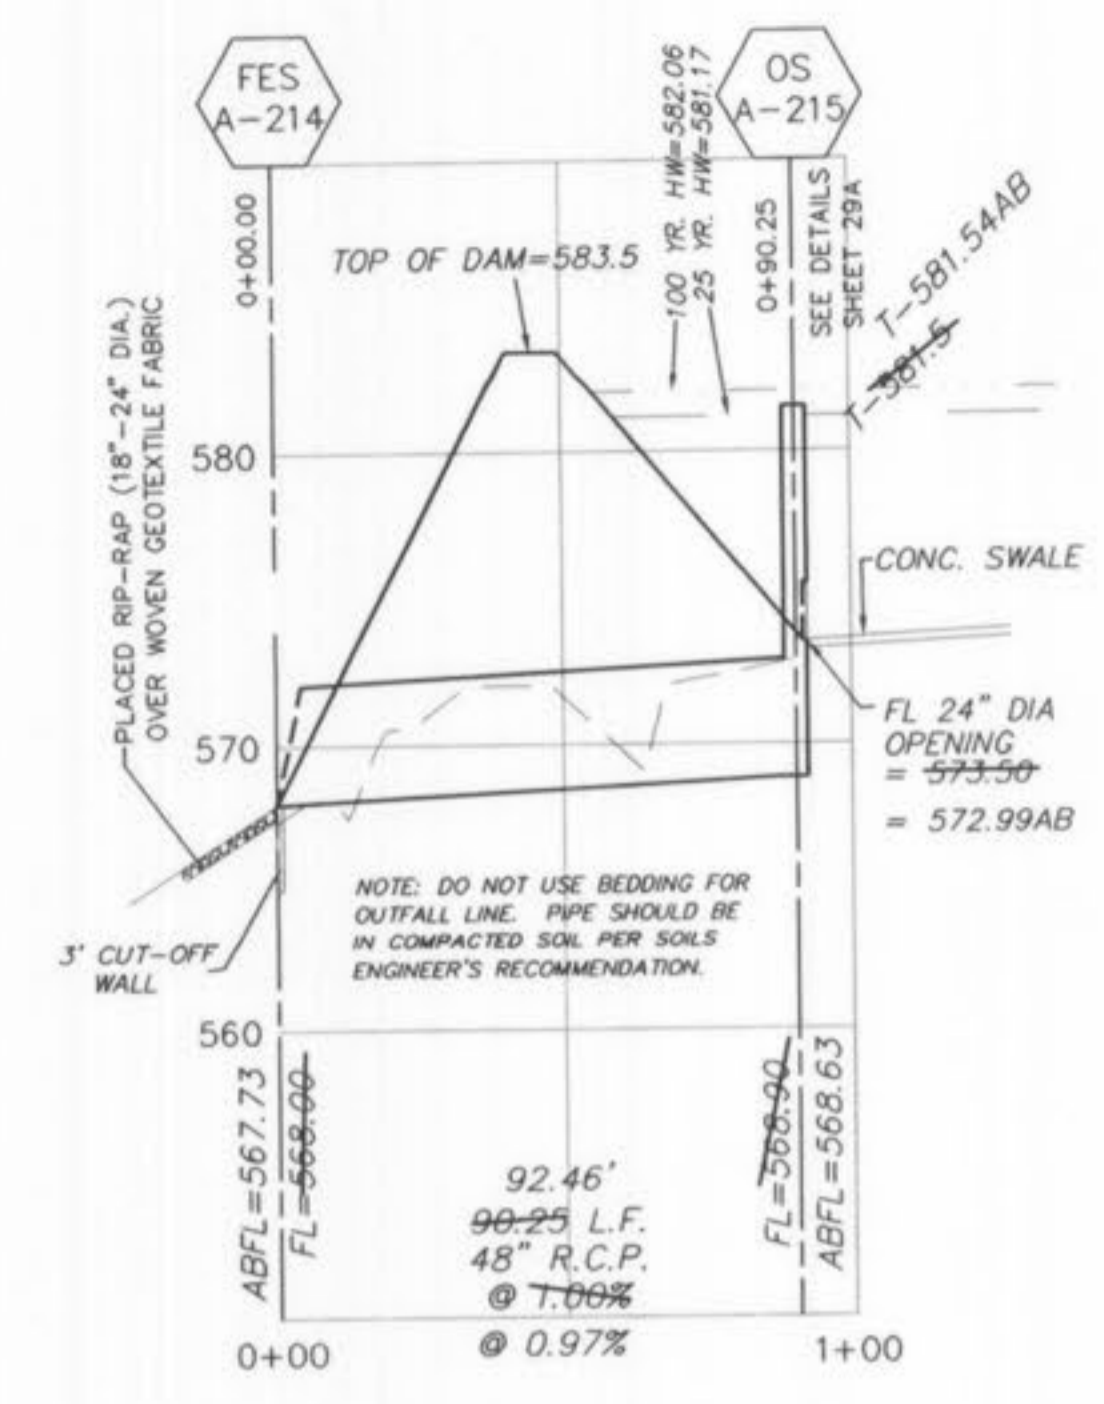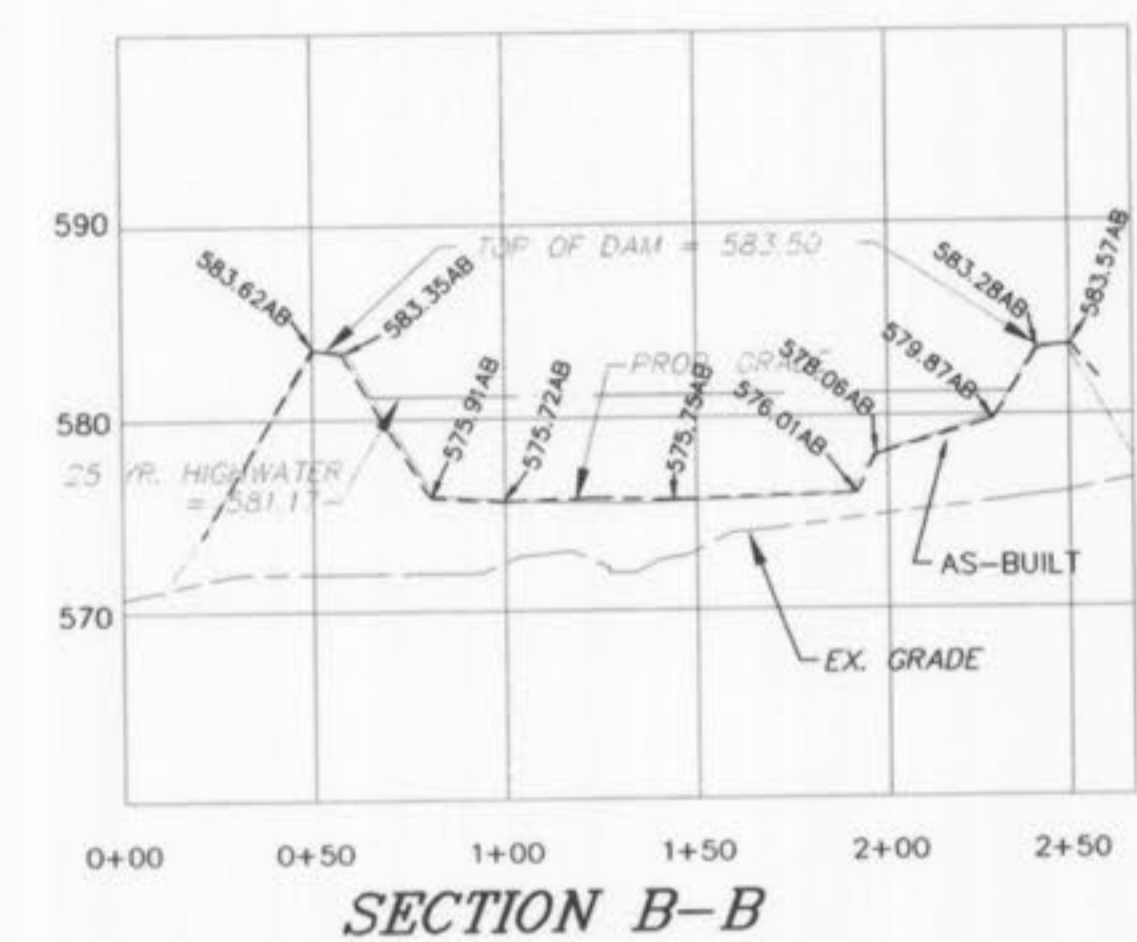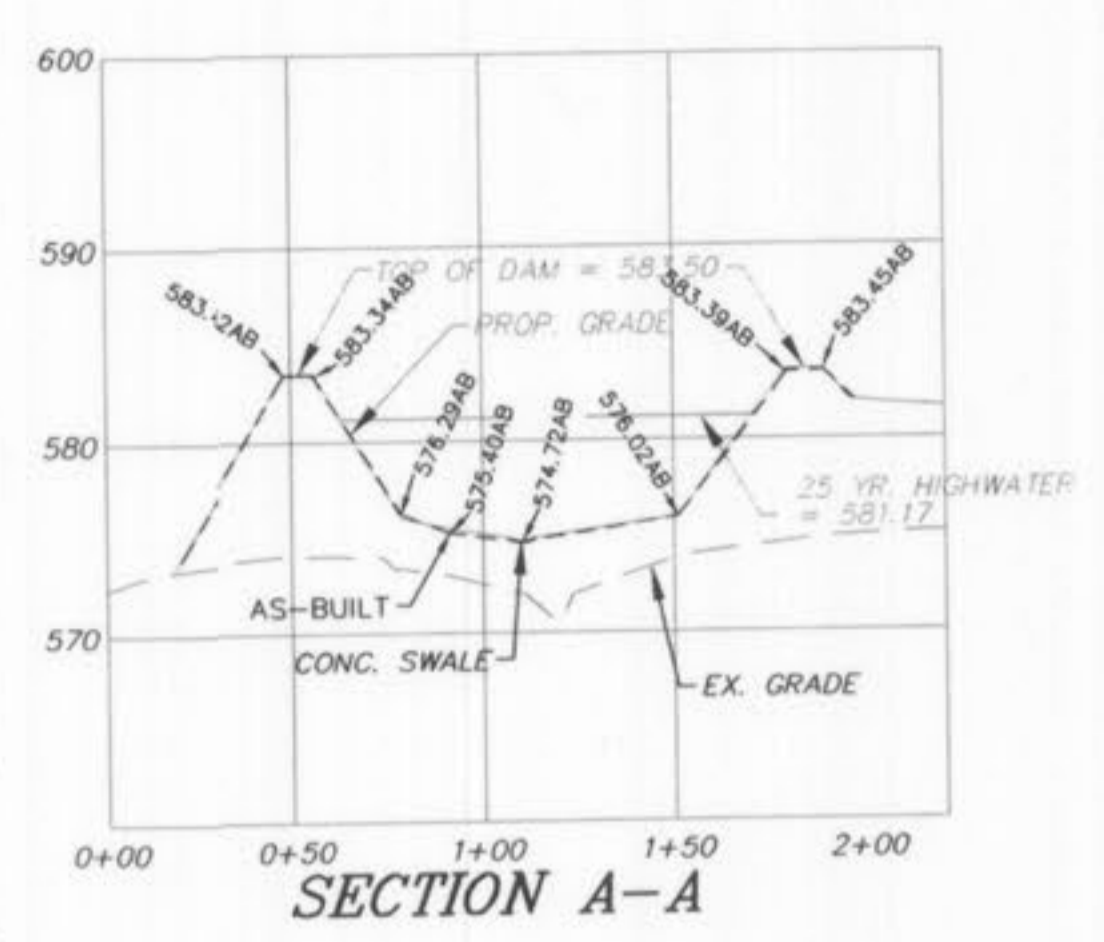

FES A-214-
OS A-215
NTS

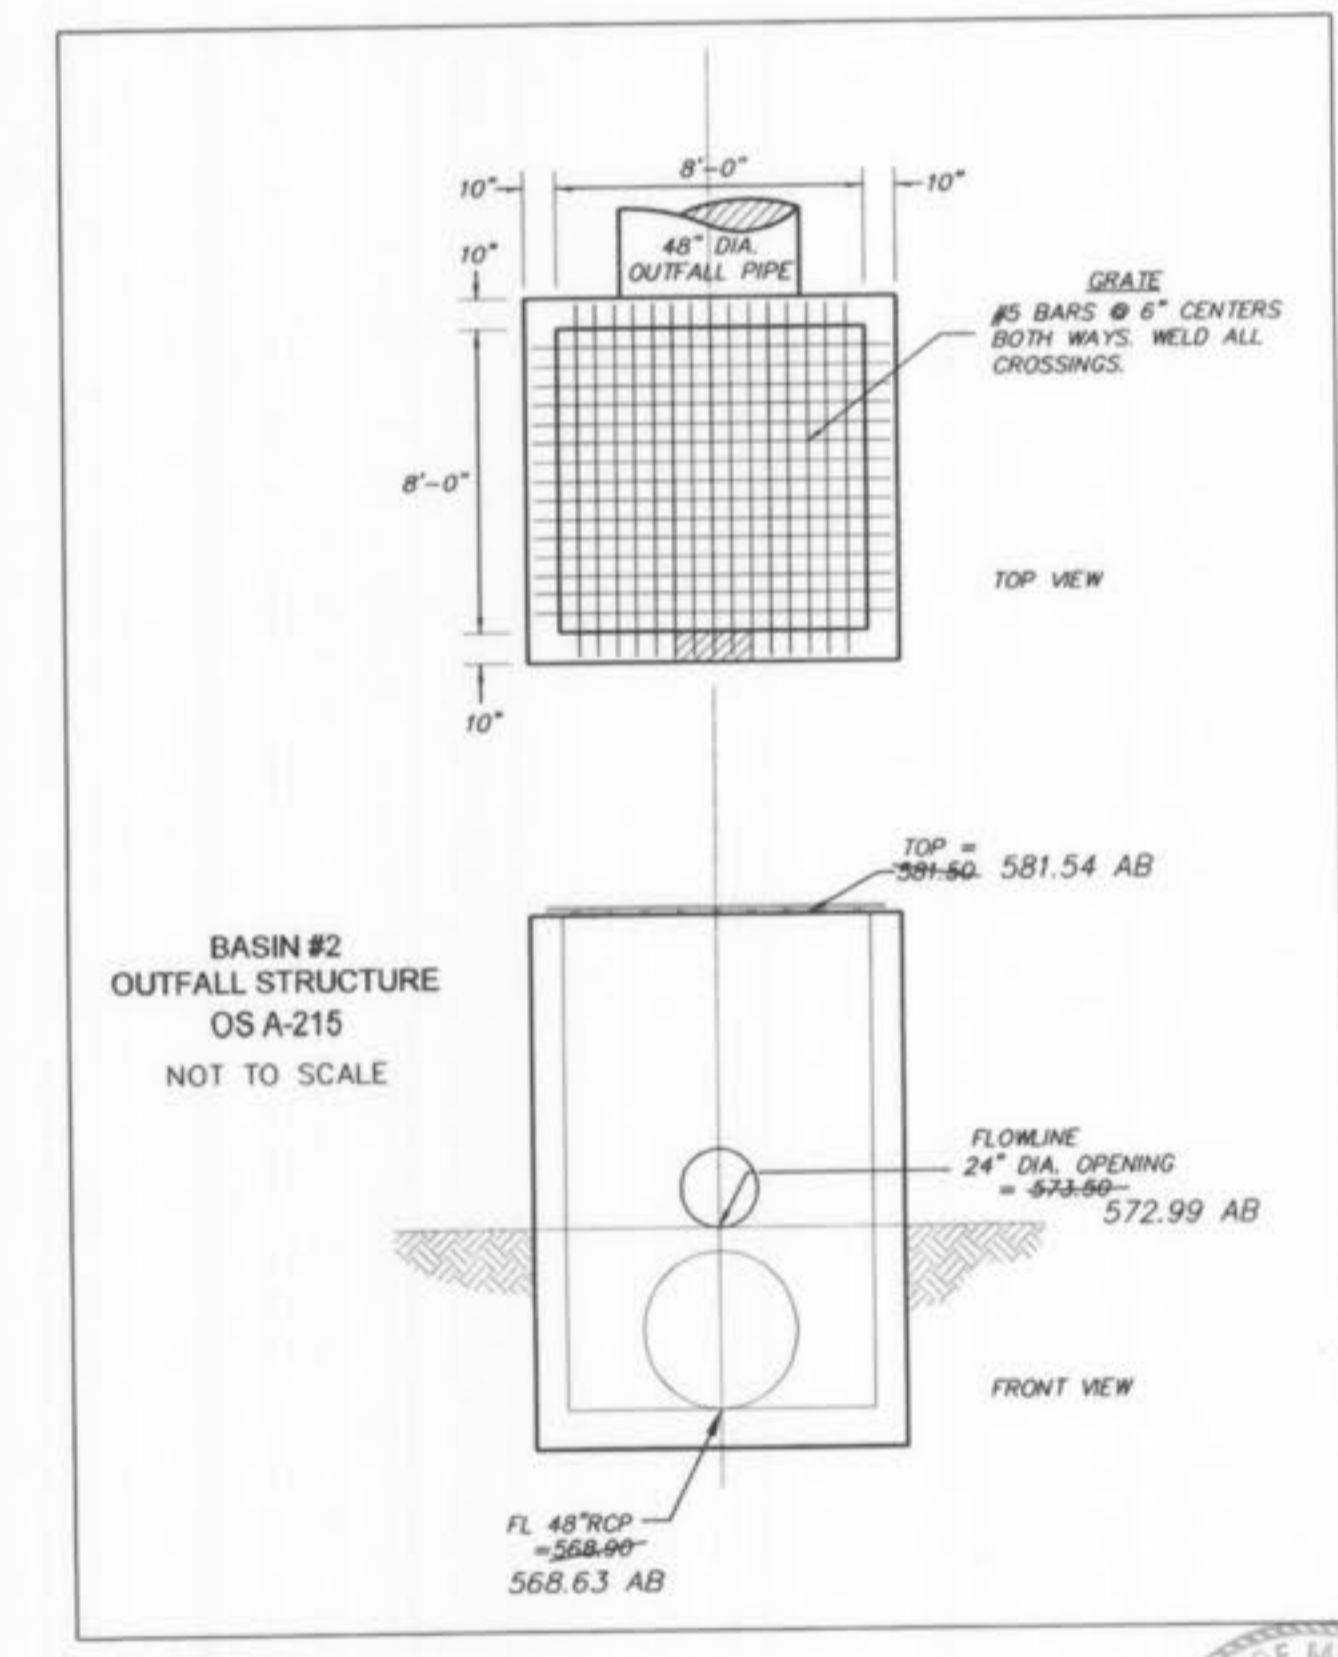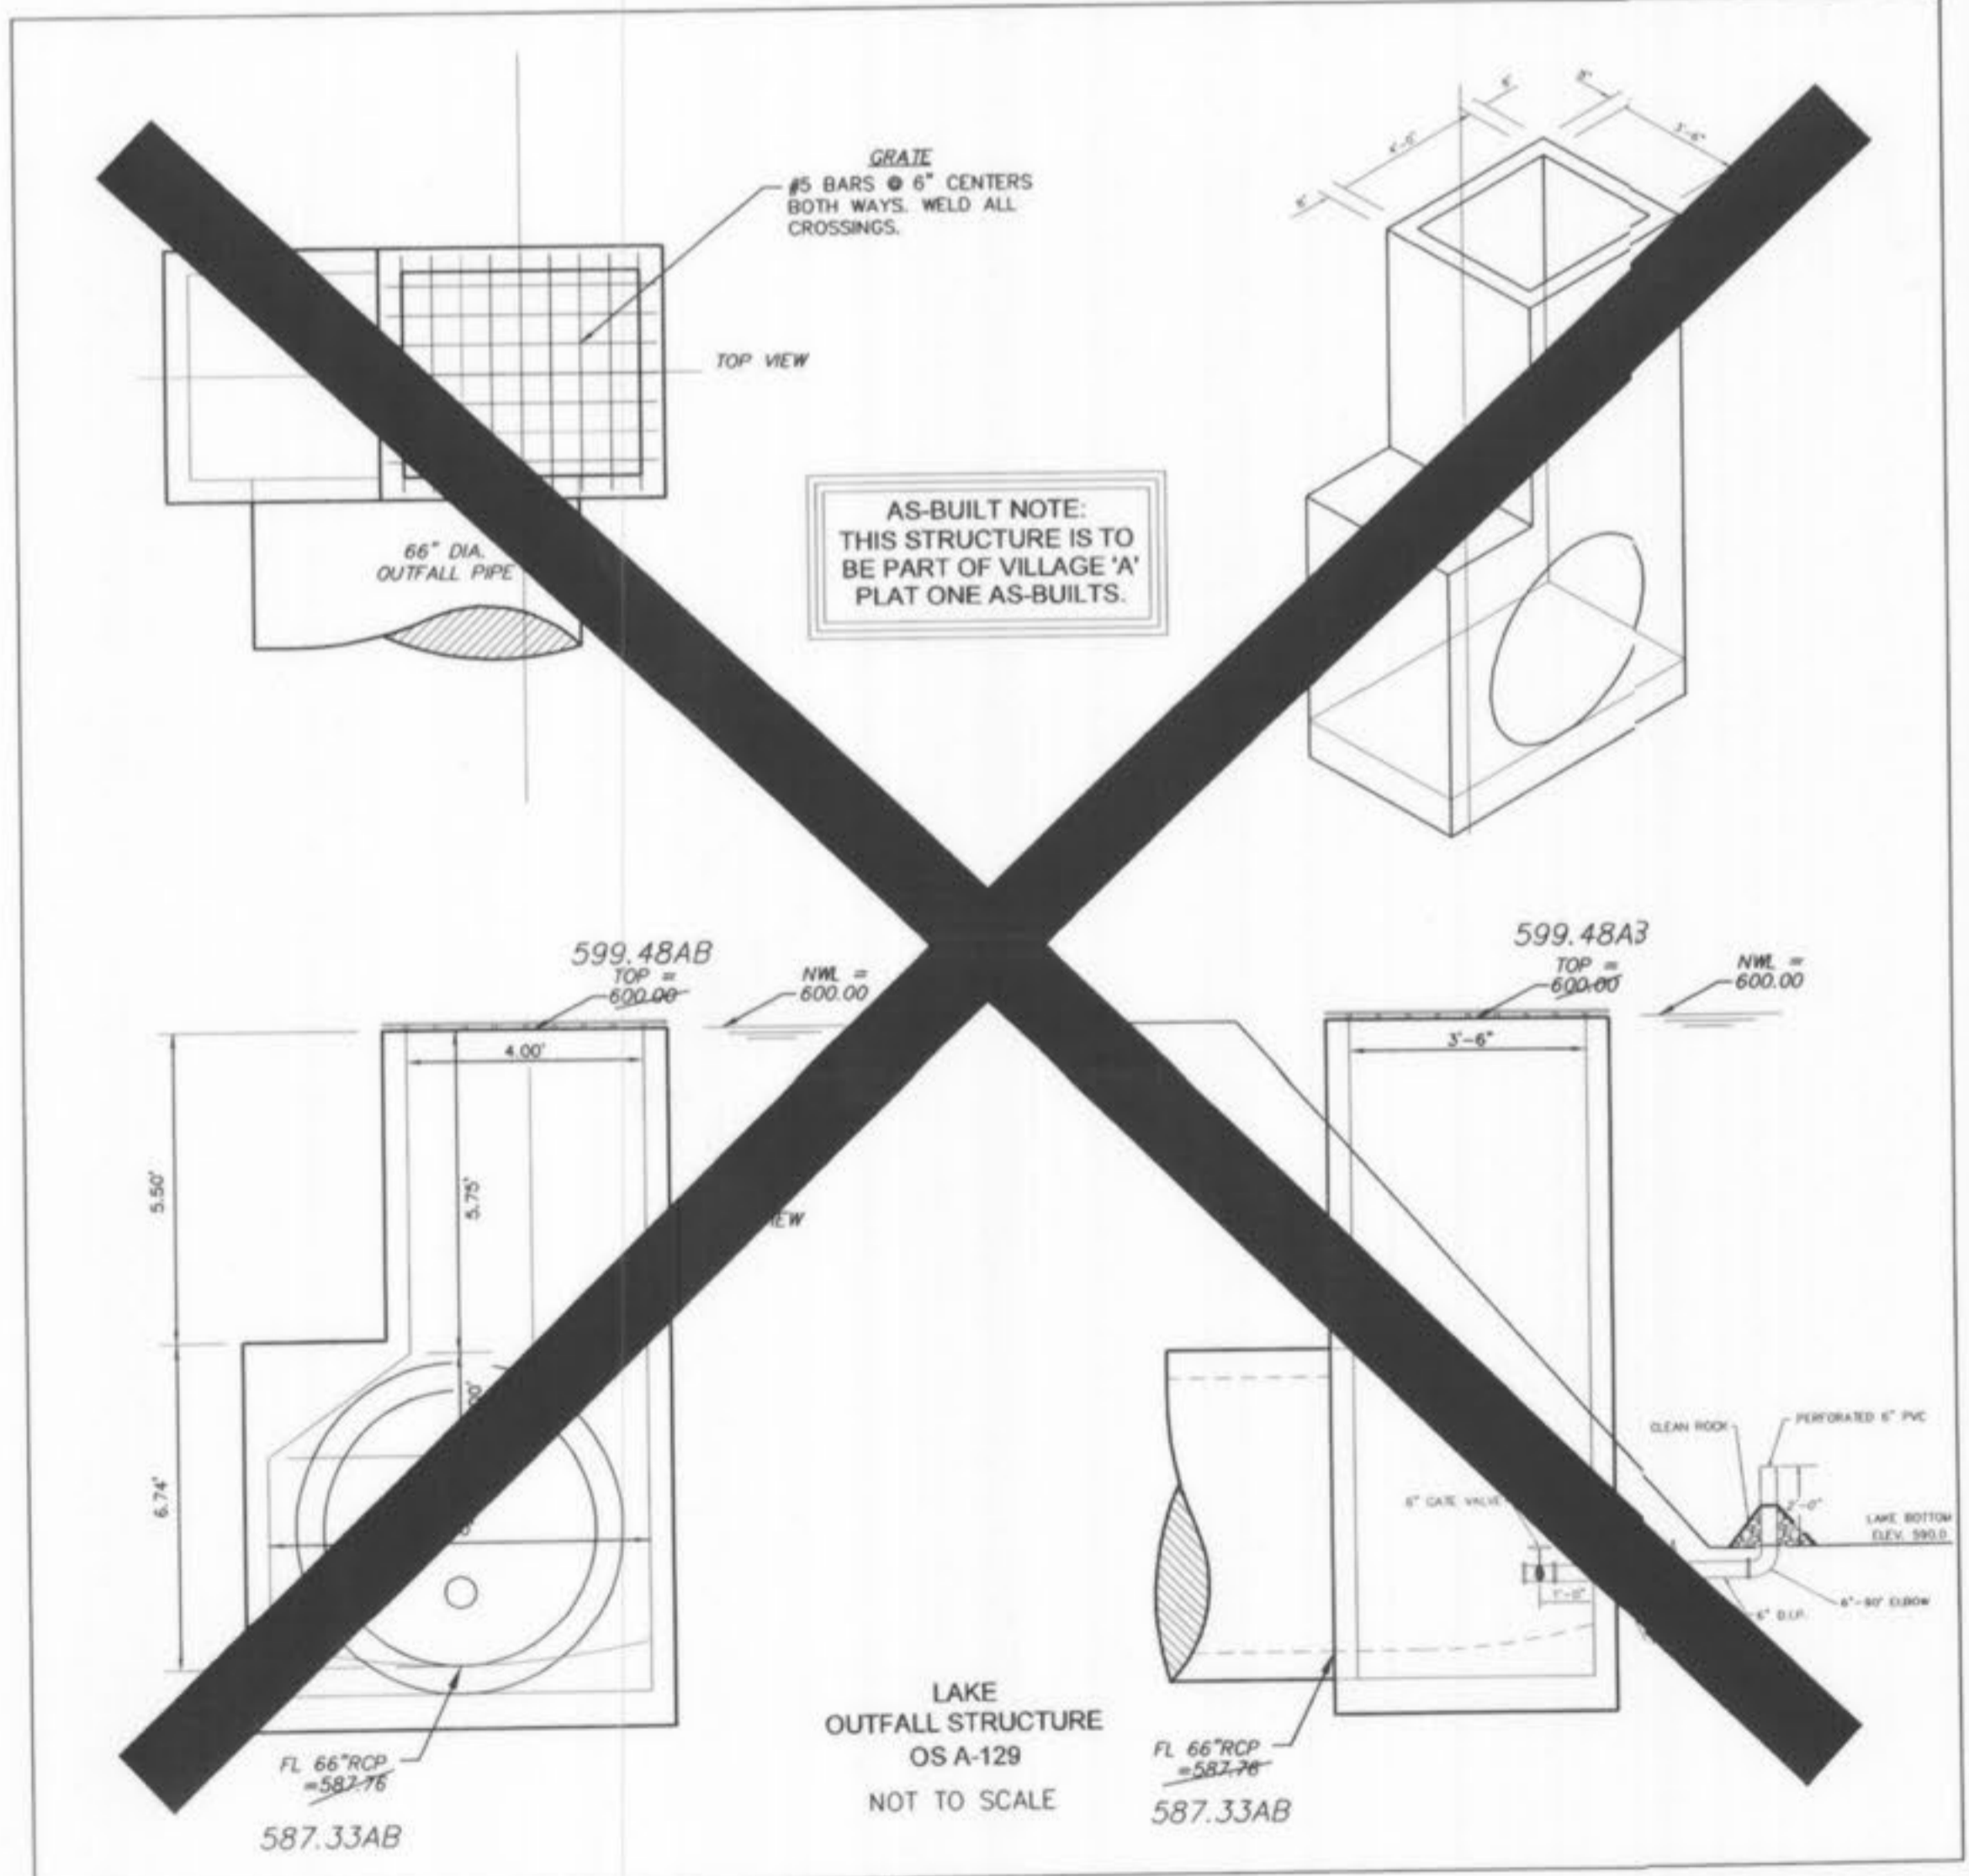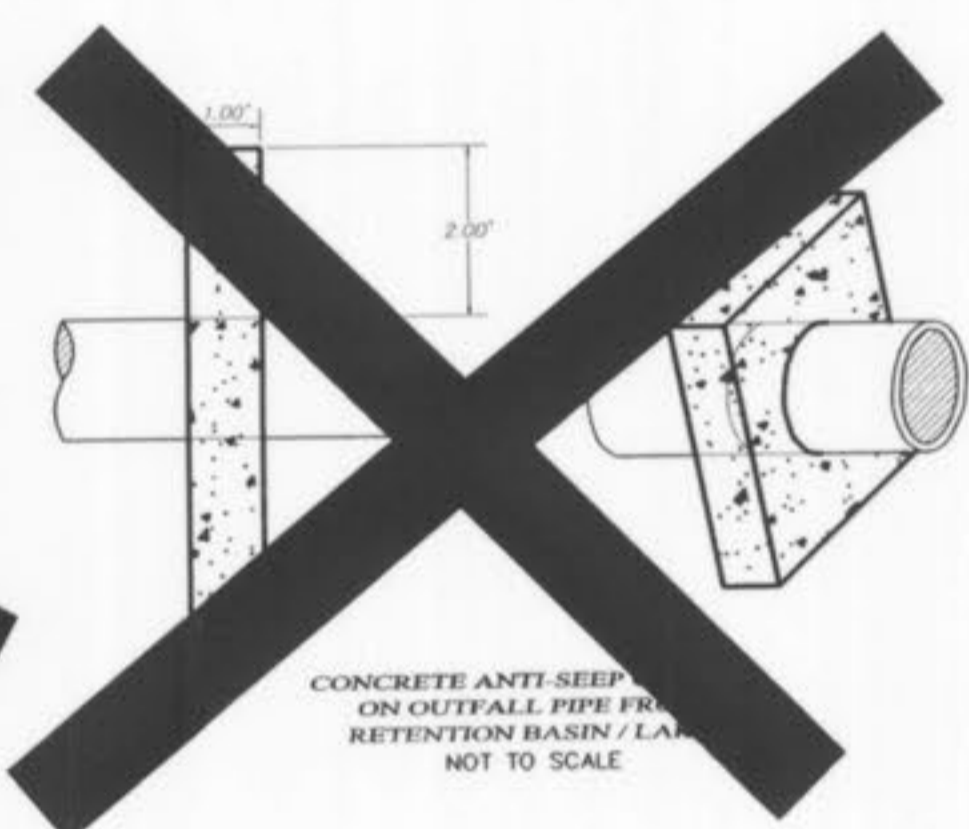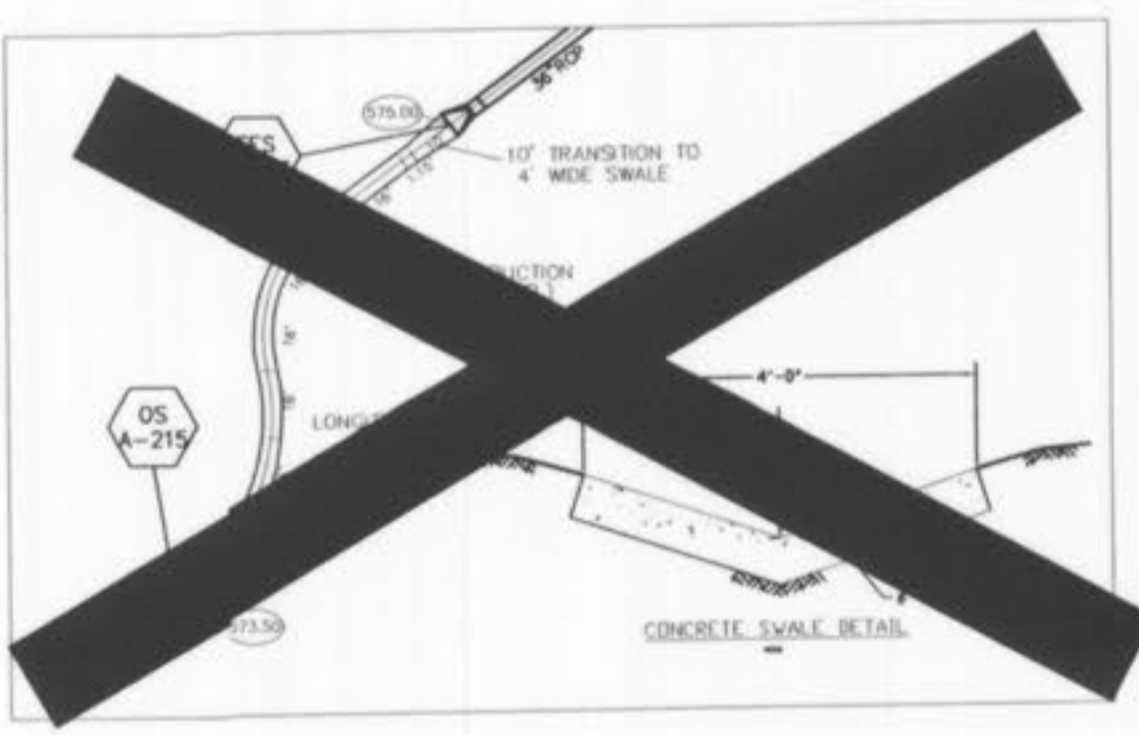

PICKETT RAY & SILVER
CIVIL ENGINEERS
PLANNERS
LAND SURVEYORS

353 Mid Rivers Mall Drive
St. Peters, MO 63376
Phone (636) 397-1211
Fax (636) 397-1104

WYNDGATE
VILLAGE A
DETENTION BASIN 2 AS-BUILTS

Prepared For:
SUMMIT POINTE, L.C.

255 FOXHOLE ROAD
ST. CHARLES, MO 63301
(636) 940-8977

REVISIONS	NO.	DATE	REVISION
	1	10/25/04	REVISED PER CITY OF FALLON
	6	02/19/05	REVISED PER CITY
	10	4/13/05	REVISED BASIN 2
	24	5/12/06	REMOVE RISER NOTE
		6/23/06	AS-BUILT BASIN
		9/11/06	REVISE PER COMMENTS 10/02/06
		1/05/07	

ENGINEERS AUTHENTICATION
The responsibility for professional engineering liability on this project is hereby limited to the set of plans authenticated by the seal, signature, and date hereunder attached. Responsibility is disclaimed for all other engineering plans involved in this project and specifically includes revisions after this date unless reauthenticated.



PICKETT, RAY & SILVER, INC

DRAWN: JEE DATE: 6-29-04
CHECKED: DWD DATE: 6-29-04
PROJECT # 01267-SUPD.02R
TASK # 2 FIELD BOOK





WYNDGATE VILLAGE A
DETENTION BASIN 2 AS-BUILTS
SHEET 29A OF 174

© Copyright 2004 by Pickett, Ray & Silver Inc.

Wyndgate Detention Basin 2,3,4 as-builts 2/07

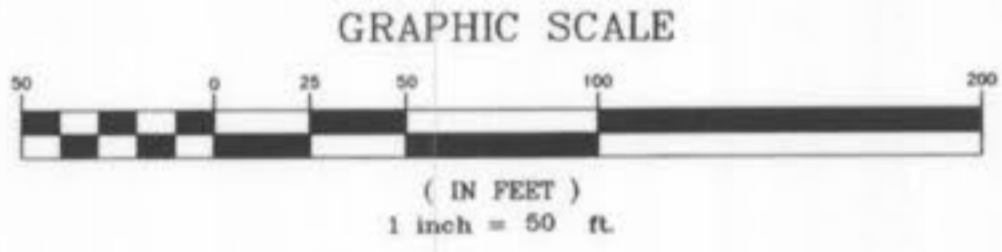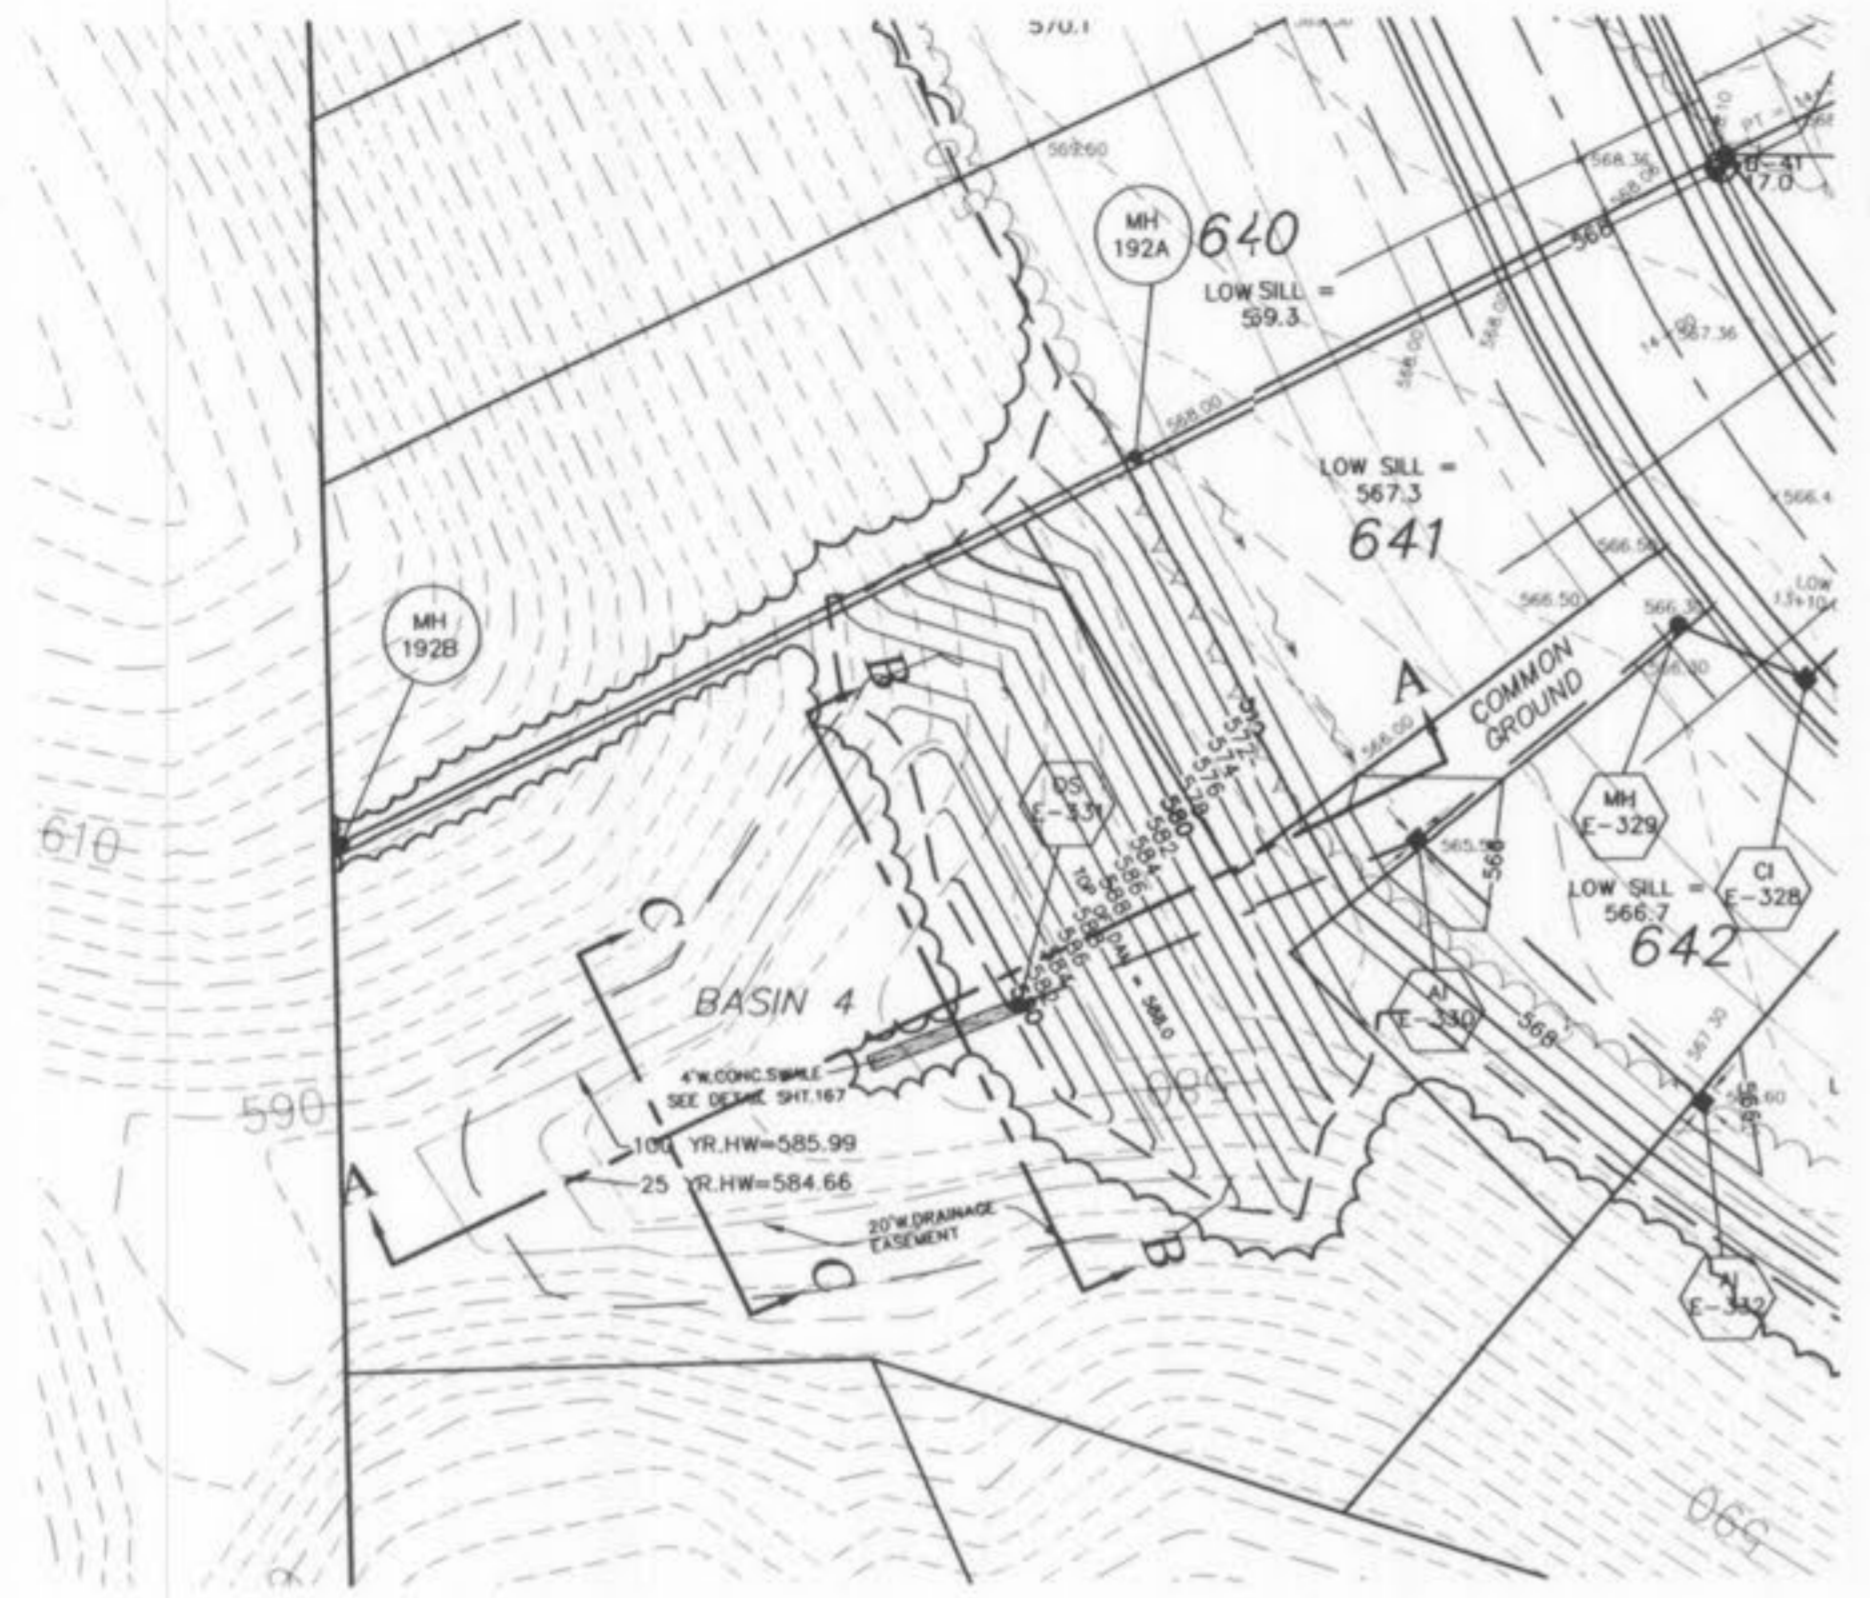

UTILITY NOTE:
 UNDERGROUND FACILITY STRUCTURES AND UTILITIES HAVE BEEN PLOTTED FROM AVAILABLE SURVEYS AND RECORDED INFORMATION AND, THEREFORE, THEIR LOCATIONS MUST BE CONSIDERED APPROXIMATE ONLY. VERIFICATION OF LOCATION OF ALL UNDERGROUND STRUCTURES AND FACILITIES, EITHER SHOWN OR NOT SHOWN ON THESE PLANS, SHALL BE THE RESPONSIBILITY OF THE CONTRACTOR.

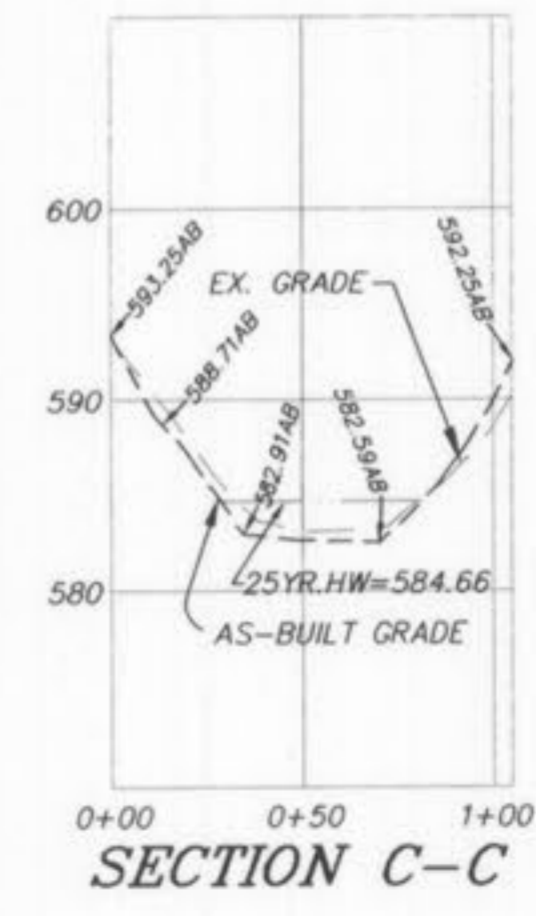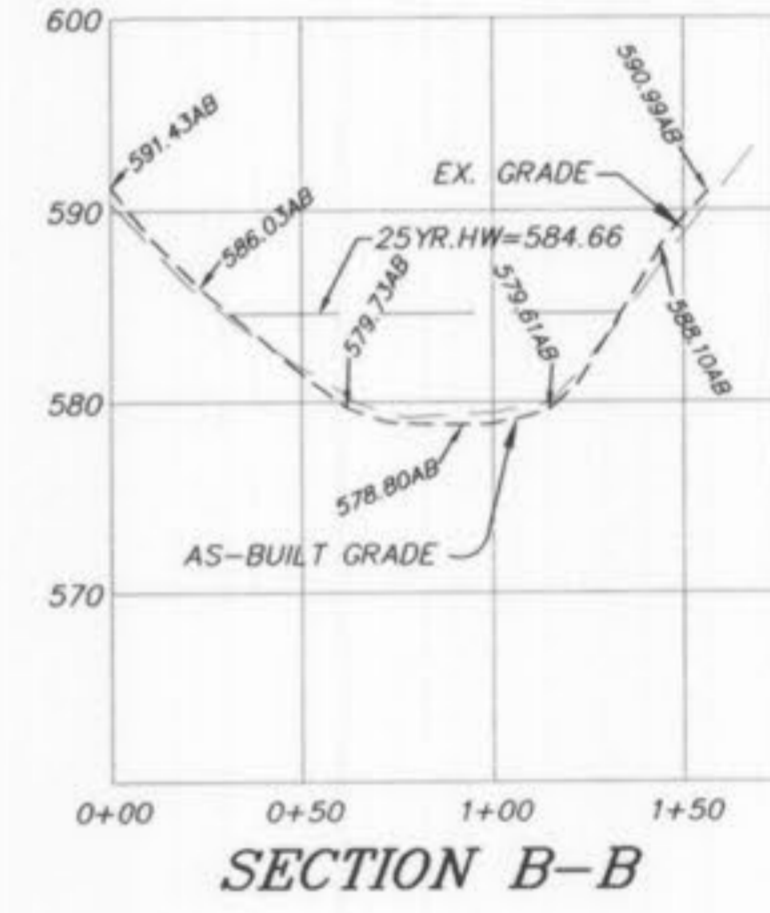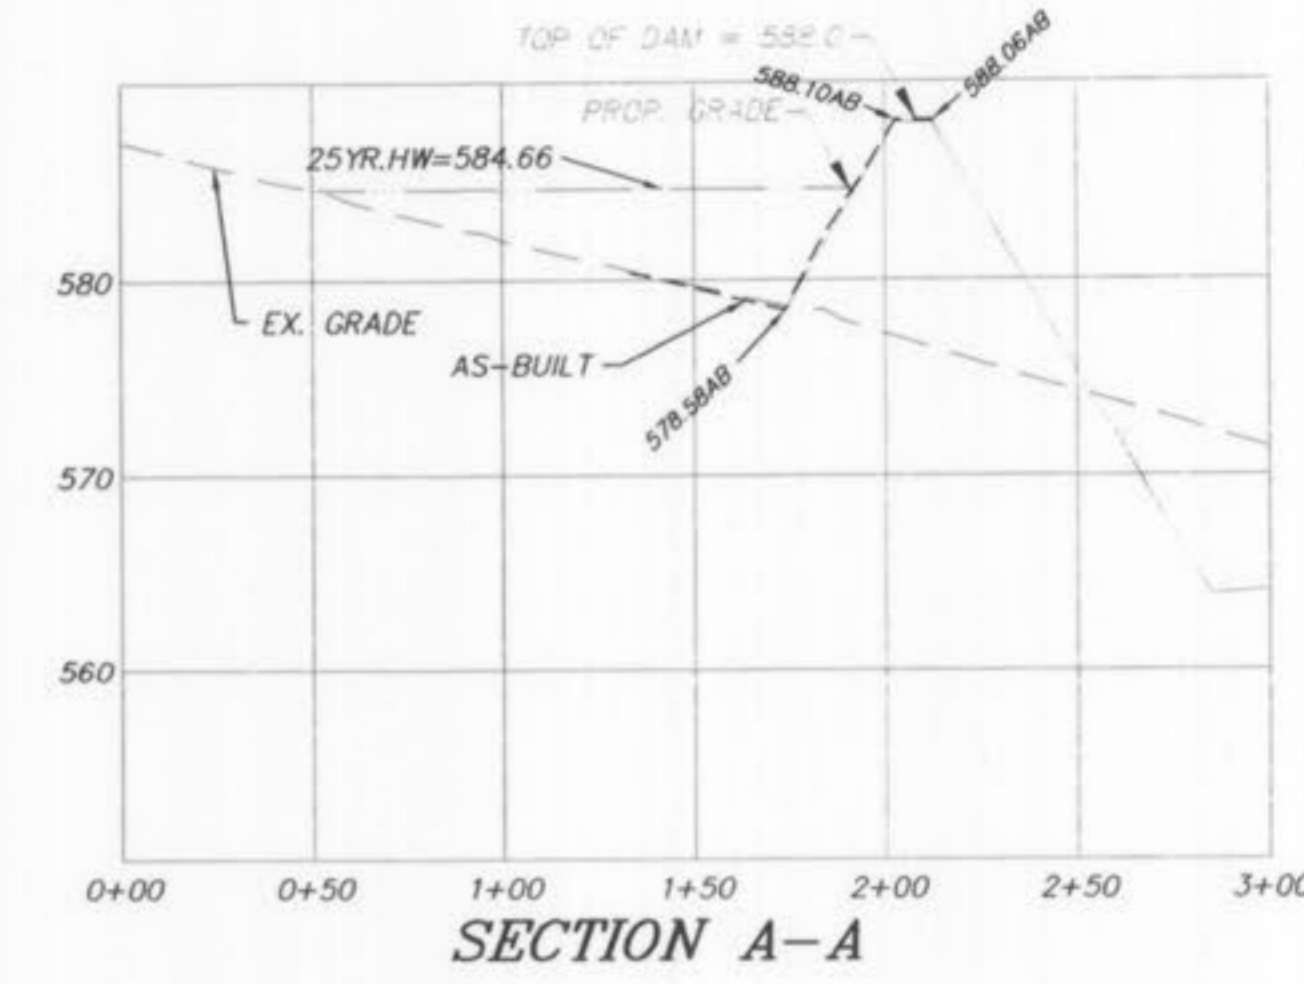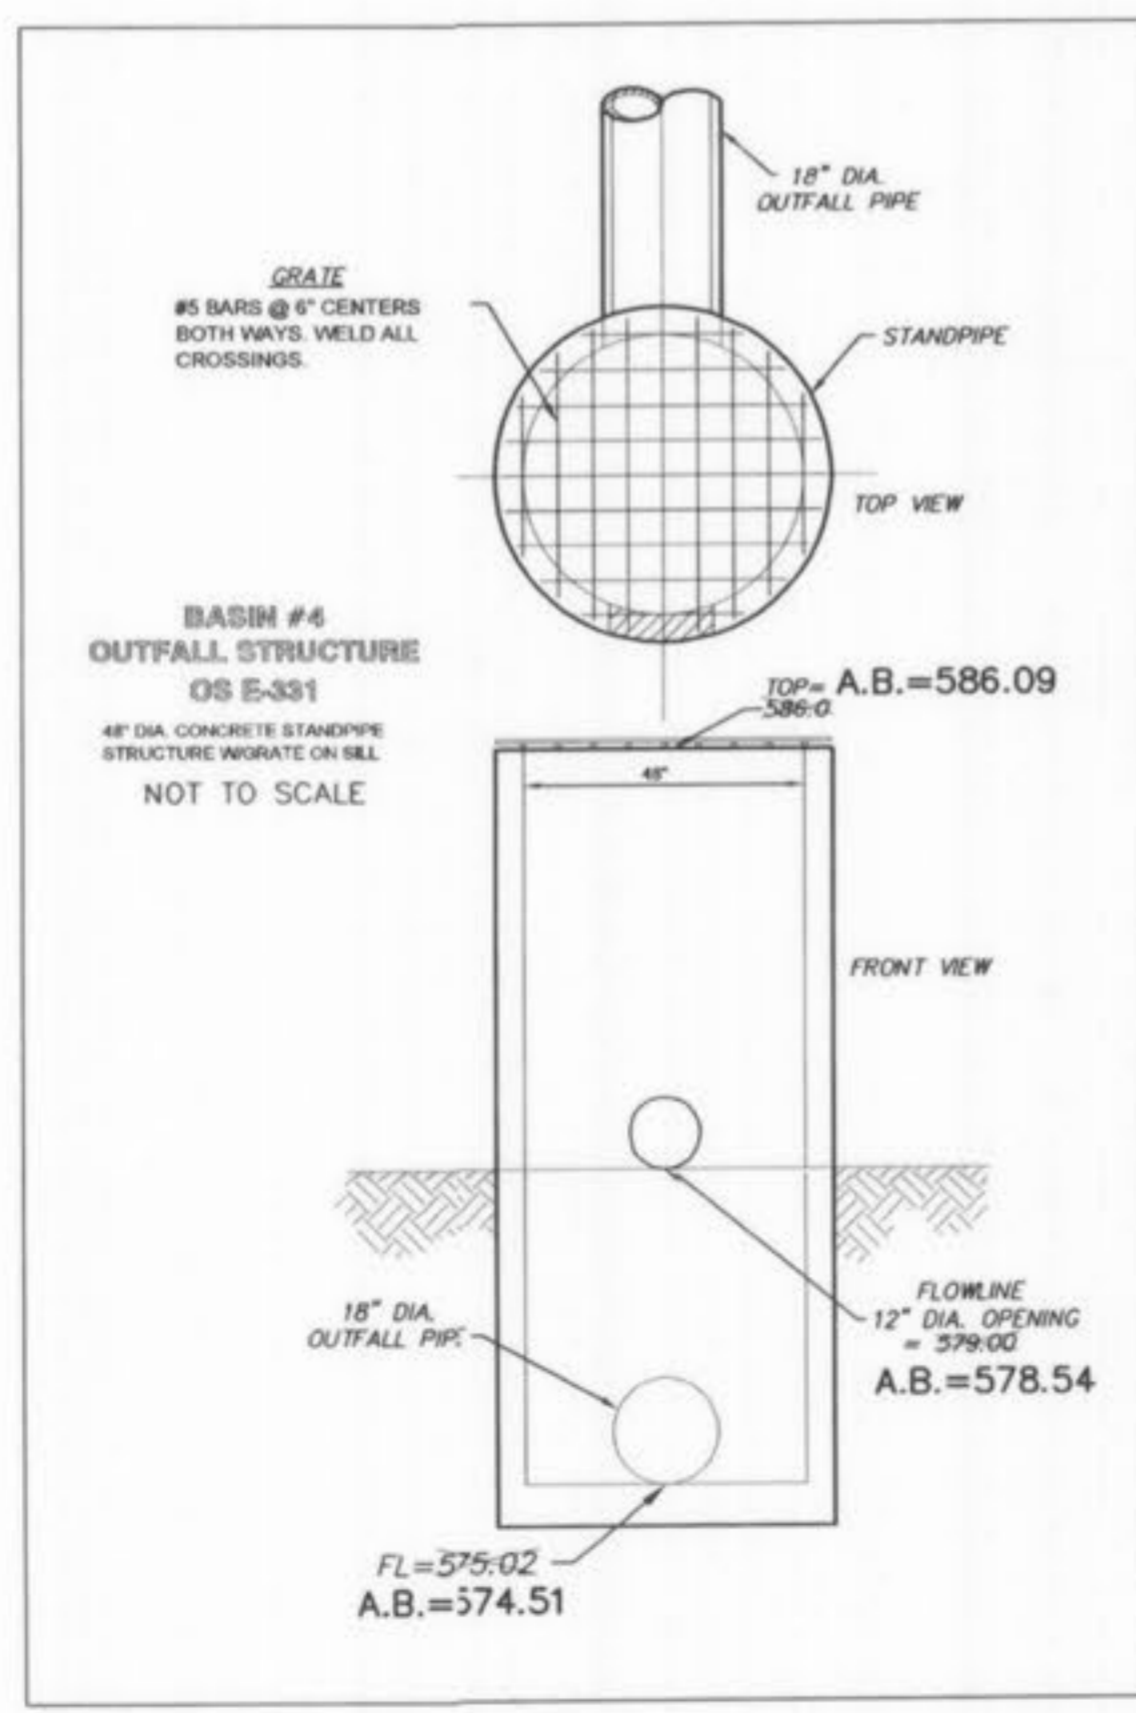

BASIN AS-BUILT ONLY

PICKETT RAY & SILVER
 CIVIL ENGINEERS
 PLANNERS
 LAND SURVEYORS
 333 Mid Rivers Mall Drive
 St. Peters, MO 63376
 Phone (636) 397-1211
 Fax (636) 397-1104

WYNDGATE VILLAGE E
 DETENTION BASIN 4 AS-BUILTS
 Prepared For:
SUMMIT POINTE, L.C.

NO.	DATE	REVISIONS
1	10/25/04	REVISED PER CITY
2	02/16/05	REVISED PER CITY OF FALLON
3	09/11/06	AS-BUILT BASIN
4	1/06/07	REV. PER COMMENTS 10/17/06


ENGINEERS AUTHENTICATION
 The responsibility for professional engineering liability on this project is hereby limited to the set of plans authenticated by the seal, signature, and date hereunder attached. Responsibility is disclaimed for all other engineering plans involved in this project and specifically excludes revisions after this date unless reauthenticated.
PICKETT, RAY & SILVER, INC.

DRAWN	DATE
JEE	6-29-04
CHECKED	DATE
DWD	6-29-04
PROJECT # 01267-SUPD.02R	
TASK # 2	FIELD BOOK

WYNDGATE VILLAGE E
 DETENTION BASIN 4 AS-BUILTS
 SHEET 125E OF 174
 © Copyright 2004 by Pickett, Ray & Silver Inc.









HORIZONTAL SCALE: 1"=50'
 VERTICAL SCALE: 1"=10'

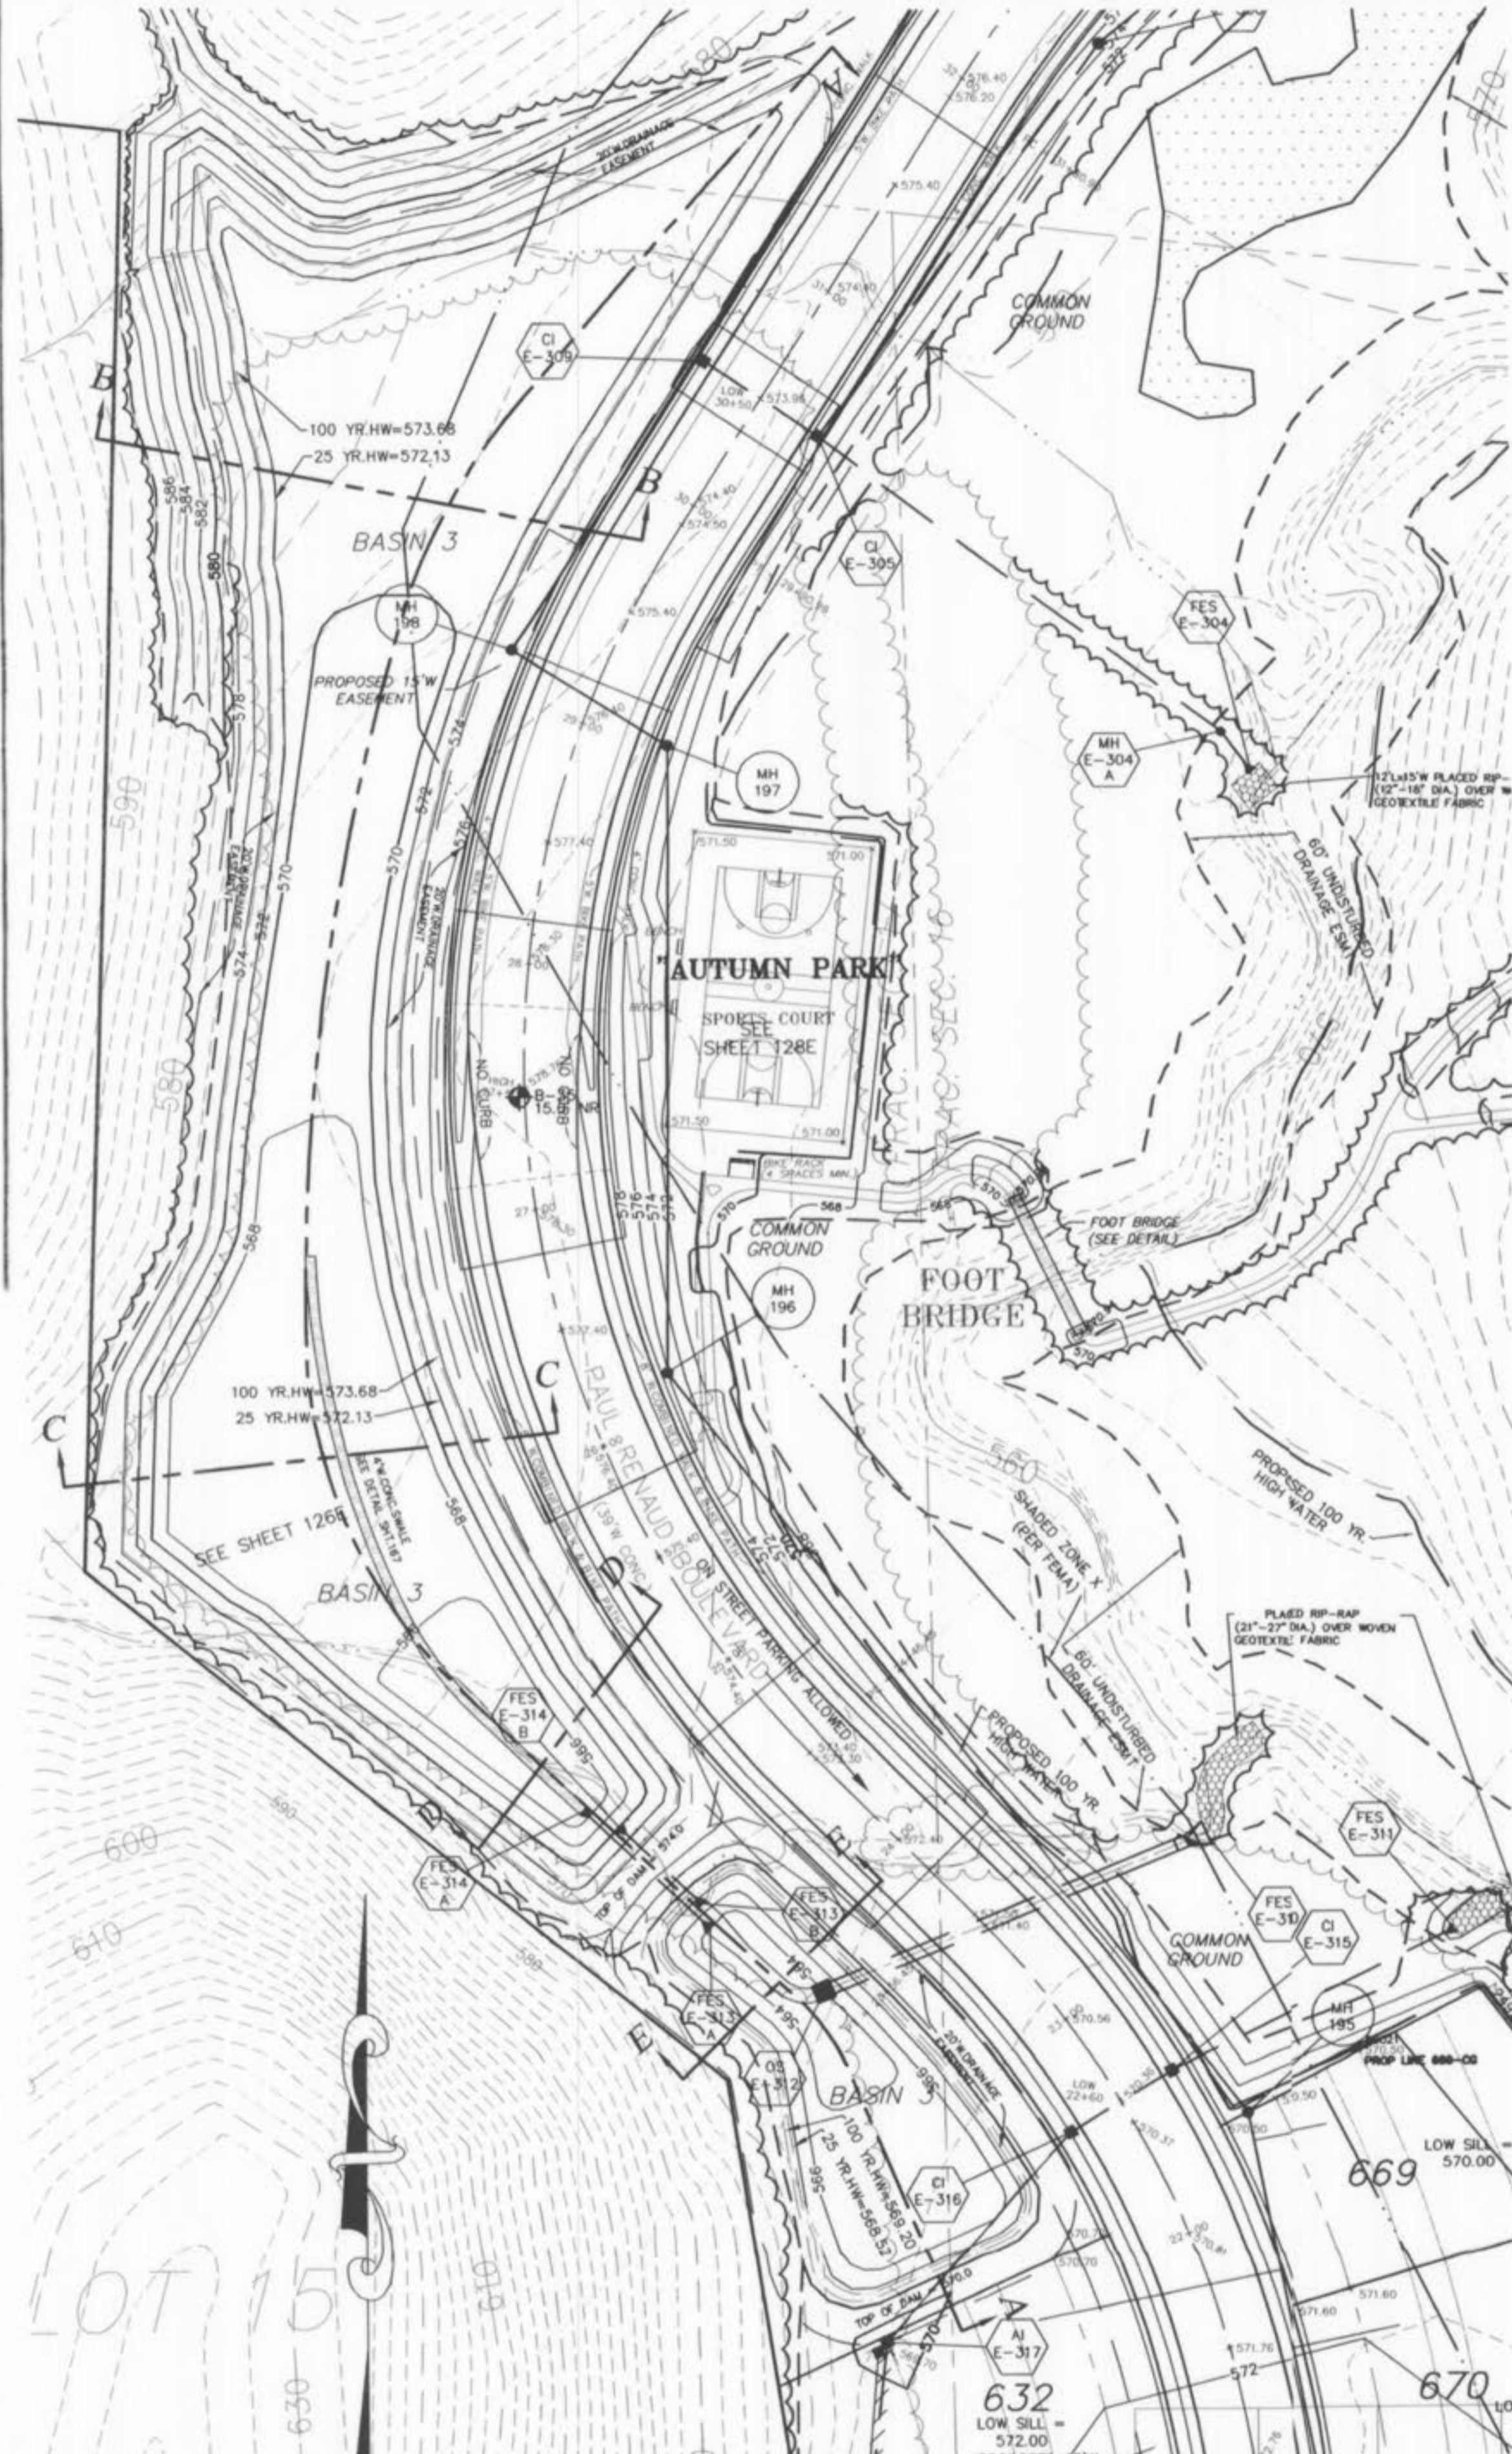


UTILITY NOTE:
 UNDERGROUND FACILITY STRUCTURES AND UTILITIES HAVE BEEN PLOTTED FROM AVAILABLE SURVEYS AND RECORDED INFORMATION AND, THEREFORE, THEIR LOCATIONS MUST BE CONSIDERED APPROXIMATE ONLY. VERIFICATION OF LOCATION OF ALL UNDERGROUND STRUCTURES AND FACILITIES EITHER SHOWN OR NOT SHOWN ON THESE PLANS, SHALL BE THE RESPONSIBILITY OF THE CONTRACTOR.


BASIN AS-BUILT ONLY

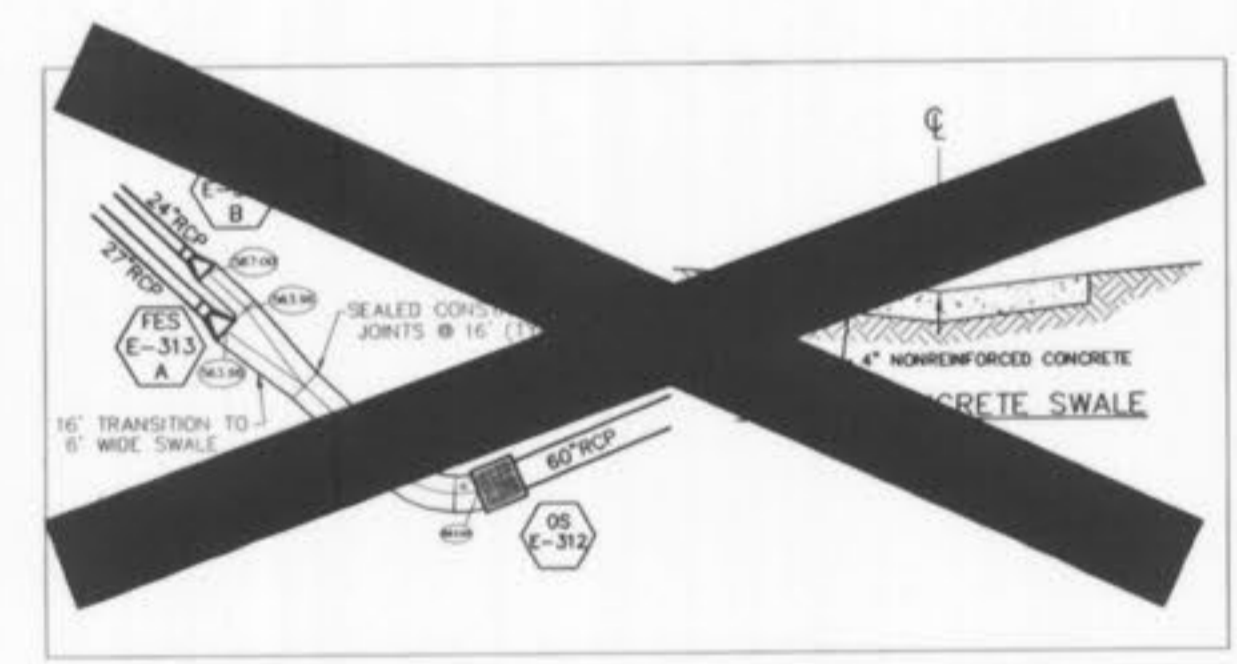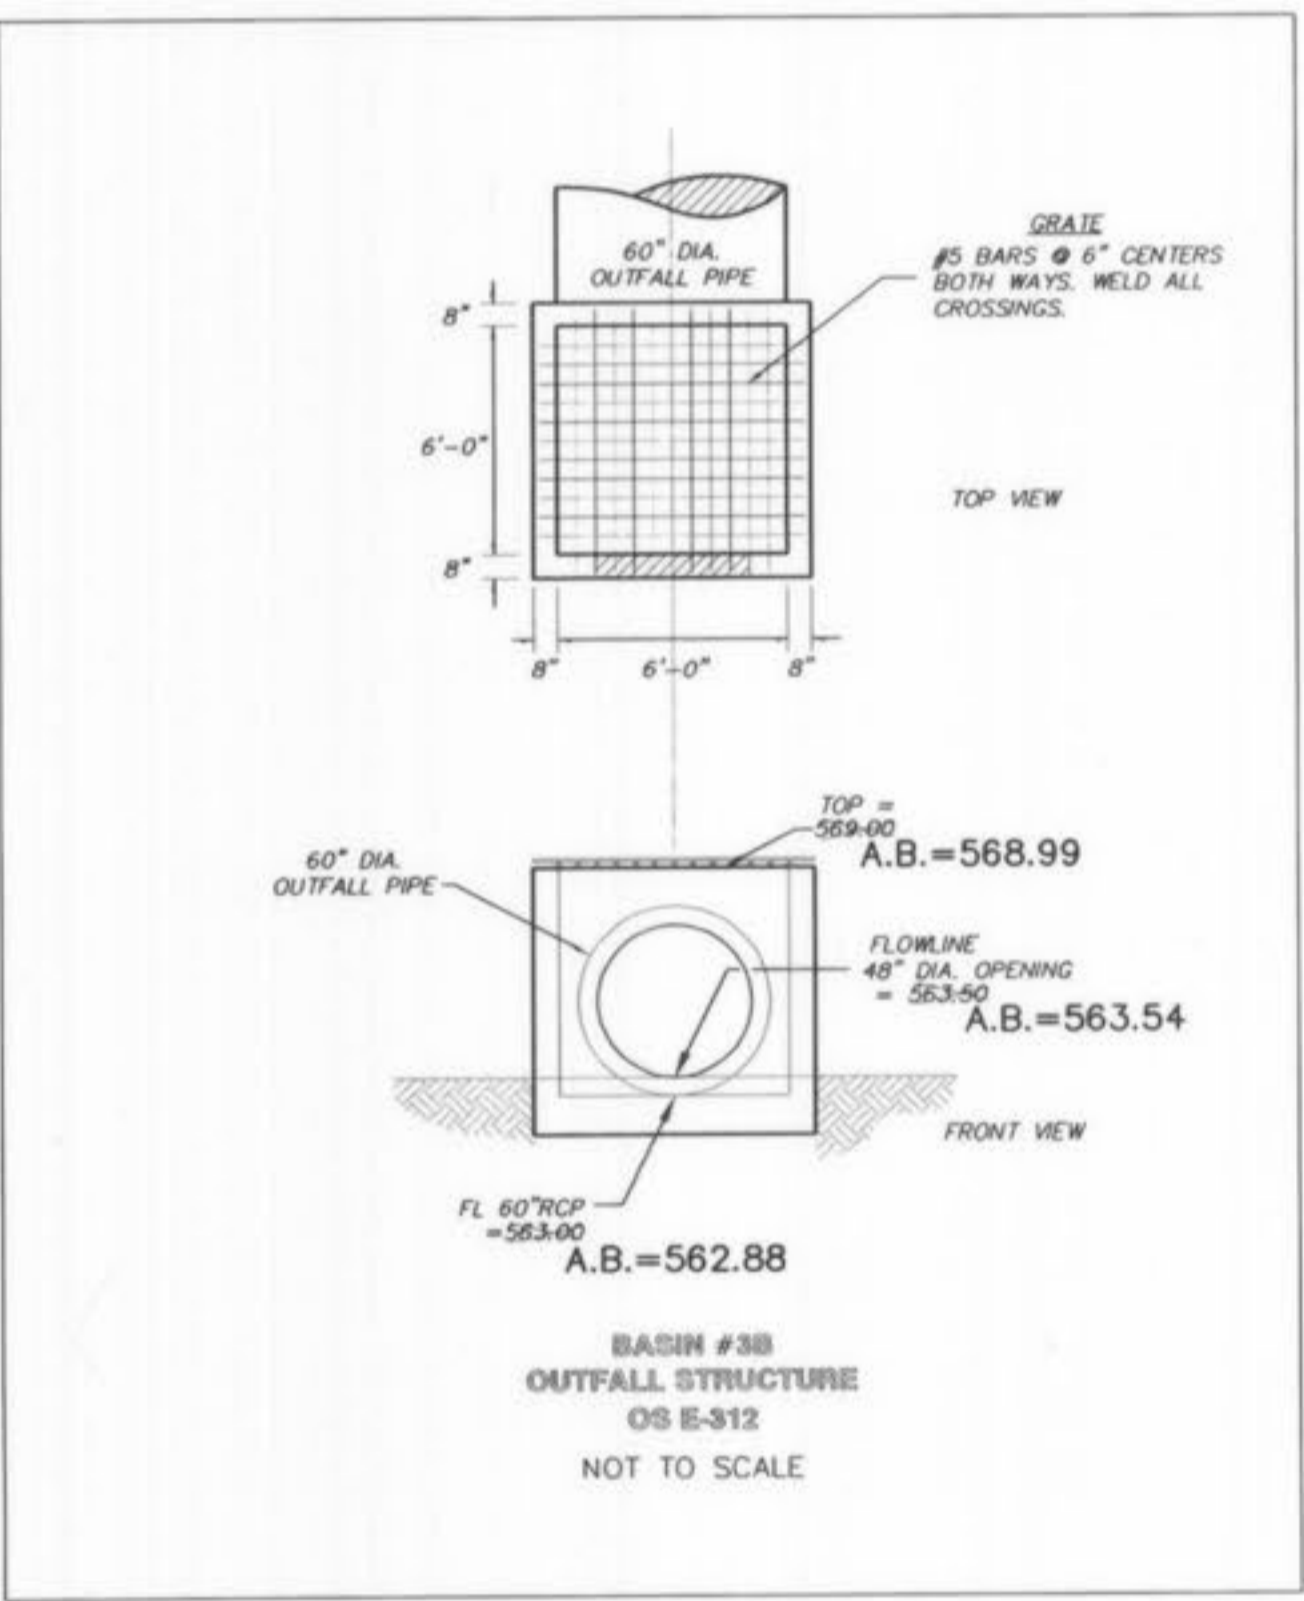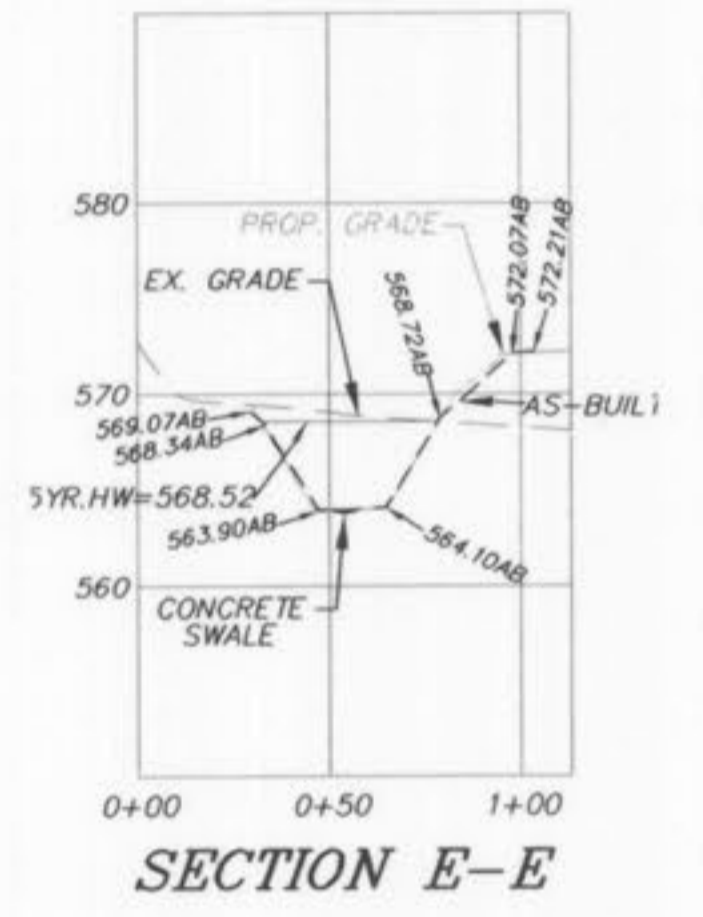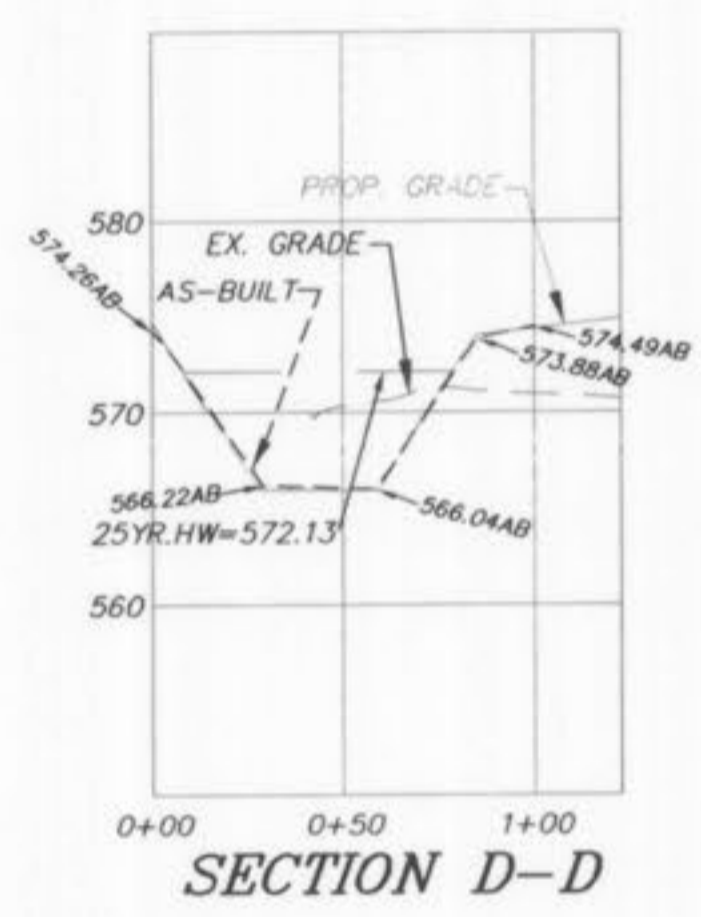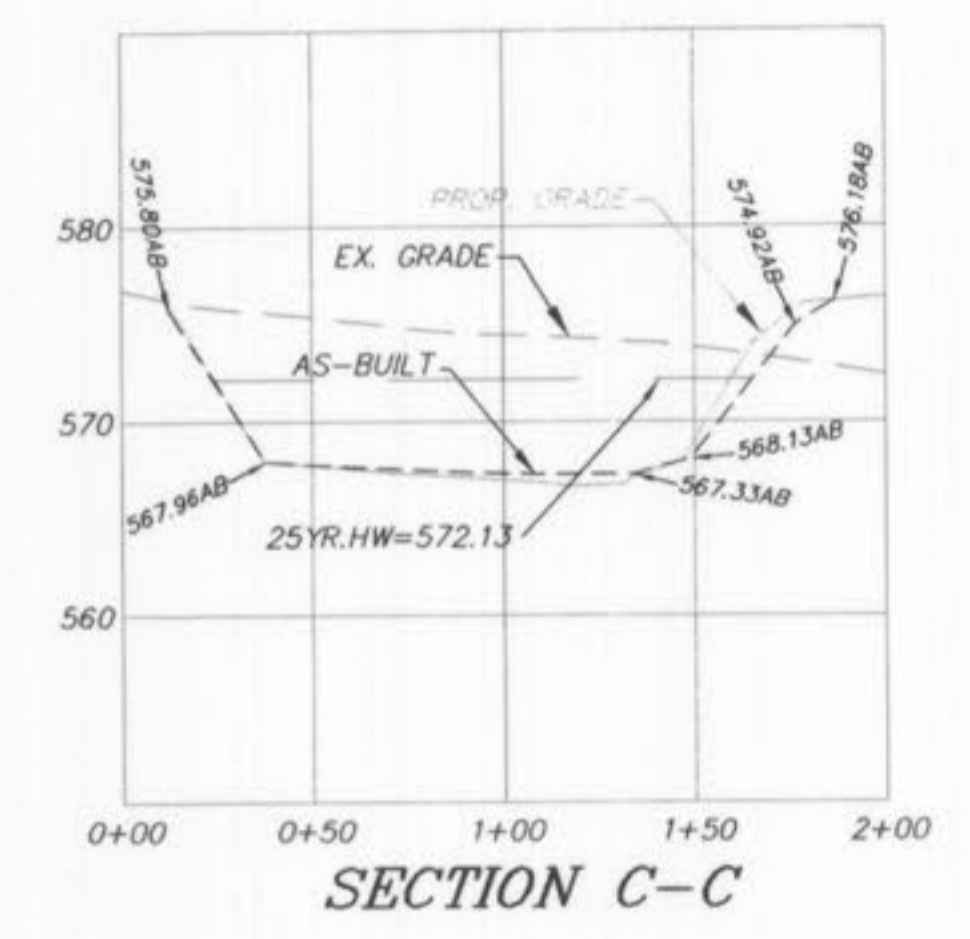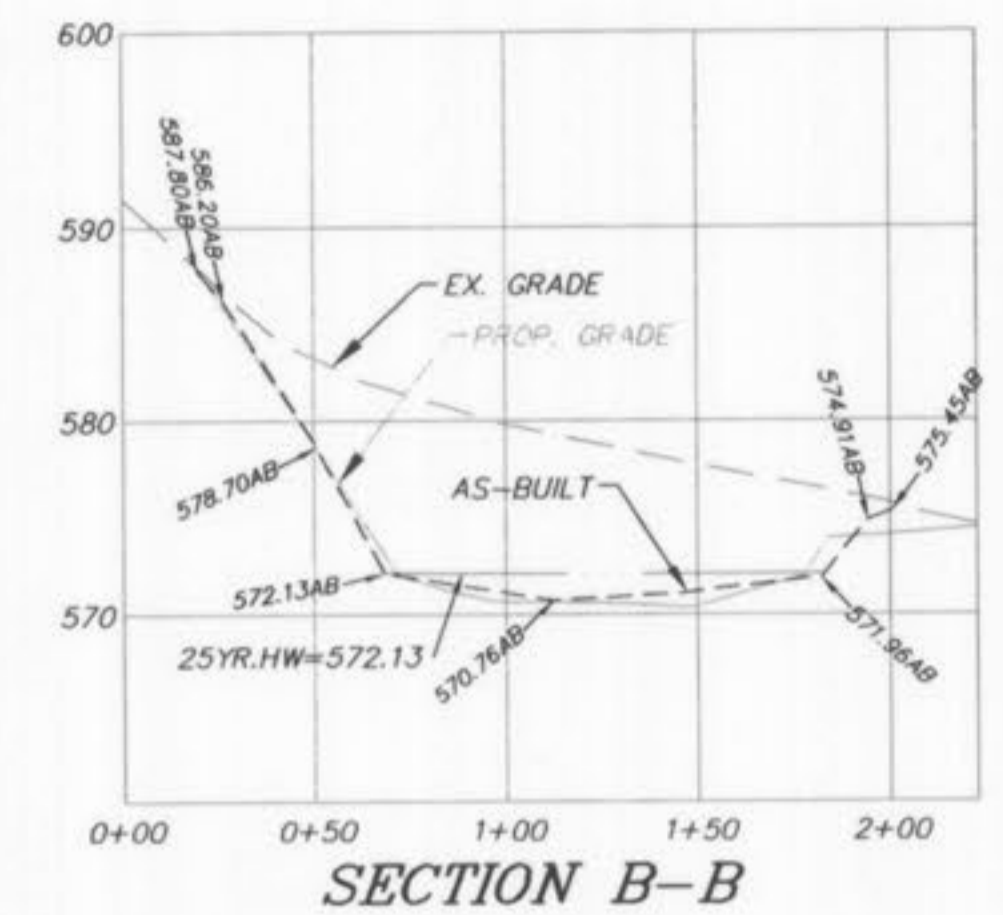

HORIZONTAL SCALE: 1"=50'
 VERTICAL SCALE: 1"=10'

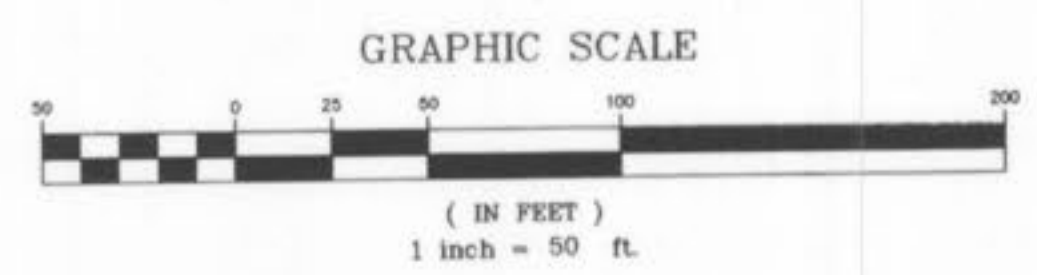

SECTION A-A BASIN AS-BUILT ONLY

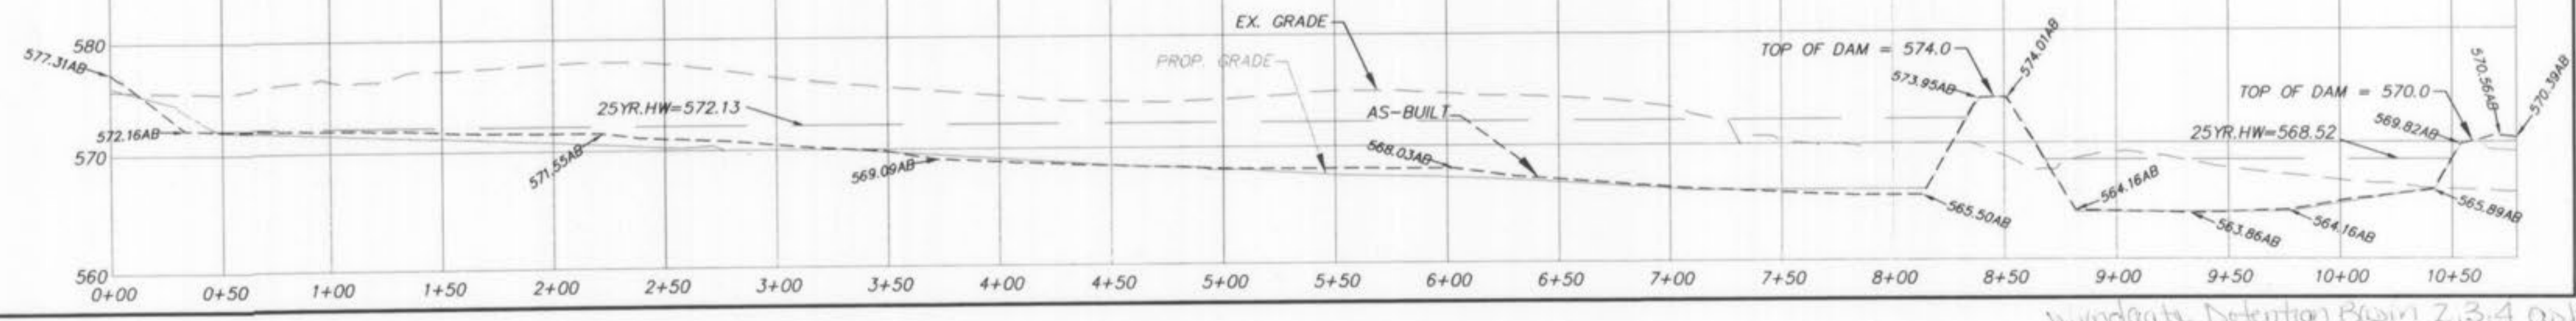

PICKETT RAY & SILVER
 333 Mid Rivers Mall Drive
 St. Peters, MO 63376
 Phone (636) 397-1211
 Fax (636) 397-1104

**CIVIL ENGINEERS
 PLANNERS
 LAND SURVEYORS**

**WYNDGATE VILLAGE E
 DETENTION BASIN**

Prepared For:
SUMMIT POINTE, L.C.

239 FOX HILL ROAD
 ST. CHARLES, MO 63301
 (636) 940-8877

NO.	DATE	REVISIONS
1	10/25/04	REVISED PER CITY OF FALCON
6	02/16/05	REVISED PER CITY OF FALCON
10	11/03/05	REVISED PER CITY OF FALCON
	10/11/06	AS-BUILT BASIN
	1/05/07	REVISED PER COMMENTS

ENGINEERS AUTHENTICATION
 The responsibility for professional engineering liability on this project is hereby limited to the set of plans authenticated by the seal, signature, and date hereunder attached. Responsibility is disclaimed for all other engineering plans involved in this project and specifically excludes revisions after this date unless reauthenticated.

PICKETT, RAY & SILVER, INC

DRAWN	DATE
JEE	6-29-04
CHECKED	DATE
DWD	6-29-04

PROJECT # 01267-SUP0.02R
 TASK # 2 FIELD BOOK

WYNDGATE VILLAGE E
 DETENTION BASIN
 SHEET 126E OF 174

© Copyright 2004 by Pickett, Ray & Silver, Inc.