

# SITE DEVELOPMENT NOTES

- LOT DATA 794 LOTS
- VILLAGE A (R-1) 165 LOTS (SINGLE FAMILY DETACHED COTTAGES) BUILDING LINE SETBACK 25' SIDE YARD SETBACK 6' REAR YARD SETBACK 15' MINIMUM LOT WIDTH - 52' MINIMUM LOT SIZE - 3,850 SQ.FT. AVERAGE LOT SIZE - 5,941 SQ.FT. (EXCLUDES R.O.W. & COMMON GROUND) SMALLEST LOT SIZE SHOWN - 4,088 SQ.FT.
- VILLAGE B (R-1) 215 LOTS (SINGLE FAMILY) BUILDING LINE SETBACK 25' SIDE YARD SETBACK 6' REAR YARD SETBACK 15' MINIMUM LOT WIDTH - 52' MINIMUM LOT SIZE - 5,720 SQ.FT. AVERAGE LOT SIZE - 8,368 SQ.FT. (EXCLUDES R.O.W. & COMMON GROUND) SMALLEST LOT SIZE SHOWN - 6,300 SQ.FT.
- VILLAGE C (R-1) 117 LOTS (SINGLE FAMILY) BUILDING LINE SETBACK - 25' SIDE YARD SETBACK - 6' REAR YARD SETBACK 15' MINIMUM LOT WIDTH - 62' MINIMUM LOT SIZE - 6,620 SQ.FT. AVERAGE LOT SIZE - 10,498 SQ.FT. (EXCLUDES R.O.W. & COMMON GROUND) SMALLEST LOT SIZE SHOWN - 7,035 SQ.FT.
- VILLAGE D (R-1) 114 LOTS (SINGLE FAMILY) BUILDING LINE SETBACK - 25' SIDE YARD SETBACK - 6' REAR YARD SETBACK 15' MINIMUM LOT WIDTH - 72' MINIMUM LOT SIZE - 8,640 SQ.FT. AVERAGE LOT SIZE - 14,313 SQ.FT. (EXCLUDES R.O.W. & COMMON GROUND) SMALLEST LOT SIZE SHOWN - 8,700 SQ.FT.
- VILLAGE E (R-1) 102 LOTS (SINGLE FAMILY) BUILDING LINE SETBACK - 25' SIDE YARD SETBACK - 6' REAR YARD SETBACK 15' MINIMUM LOT WIDTH - 85' MINIMUM LOT SIZE - 10,625 SQ.FT. AVERAGE LOT SIZE - 20,384 SQ.FT. (EXCLUDES R.O.W. & COMMON GROUND) SMALLEST LOT SIZE SHOWN - 10,625 SQ.FT.
- AMENITIES SWIMMING POOL BATH HOUSE 2 - SPORTS COURTS 60'x120' MIN. 3 - PAVILIONS 30'x30' W/ BBQ GRILLS & TABLES 3 - HORSESHOES FIT AREAS 3 - TOTLOT PLAYGROUNDS (AGES 2 - 5) 1 - FOOTBRIDGE AND PEDESTRIAN TRAILS BIKE RACKS AT ALL PAVILION & SPORTS COURTS
- POOL / BATHHOUSE PARKING CALCULATIONS 1 PARKING SPACE / 10 UNITS 794 LOTS = 80 PARKING SPACES REQUIRED 794 LOTS = 83 PARKING SPACES PROVIDED
- THIS TRACT IS IN AND SERVED BY - DUCKETT CREEK SANITARY DISTRICT PUBLIC WATER SUPPLY DISTRICT NO. 2 OF ST. CHARLES COUNTY CURVE RIVER ELECTRIC COOPERATIVE CENTURY TEL ST. CHARLES GAS CO. WENTZVILLE FIRE PROTECTION DISTRICT & NEW WELLS FIRE PROTECTION DISTRICT WENTZVILLE SCHOOL DISTRICT OF'FALLON POST OFFICE
- STREETS SHALL BE BUILT PER CITY OF OF'FALLON SPECIFICATIONS
- ALL DRIVEWAYS SHALL ACCESS INTERIOR STREETS WITH THE EXCEPTION OF THE FOUR CUSTOM LOTS THAT ACCESS DIEHR ROAD
- GRADING SHALL BE PER CITY OF OF'FALLON STANDARDS
- STREET TREES, LANDSCAPING, STREET LIGHTS AND SIDEWALKS SHALL BE PER CITY OF OF'FALLON STANDARDS
- UNDERGROUND FACILITY STRUCTURES AND UTILITIES HAVE BEEN PLOTTED FROM AVAILABLE SURVEYS AND RECORDED INFORMATION AND, THEREFORE, THEIR LOCATIONS MUST BE CONSIDERED APPROXIMATE ONLY. VERIFICATION OF LOCATION OF ALL UNDERGROUND STRUCTURES AND FACILITIES EITHER SHOWN OR NOT SHOWN ON THESE PLANS, SHALL BE THE RESPONSIBILITY OF THE CONTRACTOR.
- THE TOPOGRAPHIC SURVEY IS FROM FIRM DATUM
- THIS PROJECT IS IN COMPLIANCE WITH ARTICLE 26 OF THE CITY OF OF'FALLON ZONING CODE.
- ALL SIDEWALKS AND TRAILS SHALL BE 4' WIDE MINIMUM.
- THIS PLAT IS NOT FOR RECORD
- A PORTION OF THIS SITE IS IN THE 100 YEAR FLOOD AS SHOWN ON FIRM MAP PANEL NUMBERS 29183C0215E & 29183C0220E, DATED MARCH 17, 2003 AND FIRM MAP PANEL NUMBERS 29183C0405E & 29183C0410E DATED AUGUST 2, 1996.
- WETLAND EVALUATIONS HAVE BEEN DETERMINED AND SHALL BE FORWARDED TO THE CITY.
- PROPOSED LIGHT STANDARDS SHALL BE 16' TALL.
- THE PROPOSED UTILITIES AND SEWERS SHALL BE COVERED BY EASEMENTS GRANTED TO THE APPROPRIATE UTILITY COMPANIES AND MUNICIPALITIES.
- COVENANTS & RESTRICTIONS WILL BE SIMILAR TO HOMEFIELD. (Book 2333, Page 79 Amended Book 2474, Page 1951)
- THE DEVELOPER SHALL OBTAIN ALL NECESSARY PERMITS AND APPROVALS FROM THE DEPT. OF NATURAL RESOURCES AND THE ARMY CORPS OF ENGINEERS PRIOR TO DEVELOPMENT.
- ALL ENTRANCE MONUMENTS AND LOCATIONS MUST BE APPROVED SEPARATELY IN ACCORDANCE WITH THE CITY'S SIGN CODE.
- THE DEVELOPER SHALL PROVIDE THE APPROPRIATE APPROVALS FROM DNR AND COE FOR THIS DEVELOPMENT'S IMPACT ON THE EXISTING CREEK.
- NO PORTION OF THE DWELLINGS, INCLUDING THE FOOTING AND ROOF OVERHANG, SHALL ENCRoACH INTO THE FIVE (5) FOOT SETBACK/EASEMENT IN ORDER TO MEET BUILDING AND FIRE DEPARTMENT REQUIREMENTS.
- A SEPARATE SITE PLAN SUBMITTAL WILL BE PROVIDED FOR THE COMMON GROUND AMENITIES SUCH AS BUILDING ELEVATIONS, LANDSCAPING, ETC.
- A 60' WIDE DRAINAGE EASEMENT IS TO BE CENTERED ALONG THE CENTERLINE OF THE EXISTING DRAINAGE DITCH AND WILL BE SHOWN ON THE RECORD PLAT. AREA WITHIN THIS EASEMENT IS TO REMAIN UNDISTURBED.
- UNLESS NOTED OTHERWISE, ALL EXISTING STRUCTURES AND IMPROVEMENTS ARE TO BE REMOVED. PRIOR TO THE ISSUANCE OF BUILDING PERMITS FOR MORE THAN 30% OF THE TOTAL UNITS, BUILDING PERMITS FOR ALL OF THE RECREATIONAL AMENITIES SHALL BE PULLED. PRIOR TO THE ISSUANCE OF BUILDING PERMITS FOR 40% OF THE TOTAL UNITS, ALL RECREATIONAL AMENITIES SHALL BE OPEN FOR USE.
- ADDITIONAL RIGHT OF WAY IS BEING DEDICATED TO PROVIDE THE EXISTING DIEHR ROAD WITH A R.O.W. WIDTH OF 80'.
- ENTRANCE AND ALL IMPROVEMENTS WITHIN HIGHWAY N RIGHT-OF-WAY (INCLUDING ANY ADDITIONAL R.O.W. DEDICATION REQUIRED) WILL BE COORDINATED WITH AND APPROVED BY MDOT. A 10' WIDE UTILITY EASEMENT SHALL BE PROVIDED ALONG DEDICATED HIGHWAY N ROW.
- AN INTERNAL STREET LOOP WILL BE PROVIDED WITH THE FIRST PHASE OF DEVELOPMENT FOR BUS TRAFFIC.
- PROPOSED PEDESTRIAN FOOTBRIDGE DETAIL WILL BE PROVIDED WITH COMMON GROUND & AMENITIES PLANS
- THIS DEVELOPMENT WILL PROVIDE A STORM WATER SYSTEM THAT INSURES THAT THE RATE OF FLOW OF STORM WATER RUNOFF DISCHARGE FROM THE SITE AFTER DEVELOPMENT DOES NOT EXCEED THE RATE OF FLOW OF STORM WATER RUNOFF DISCHARGED FROM THE SITE FOR THE DESIGNATED STORM EVENT BEFORE DEVELOPMENT.
- FENCING ALONG THE REAR OF LOTS ADJACENT TO THE COLLECTOR AND ARTERIAL RIGHTS-OF-WAY SHALL BE WHITE-VINYL FENCE REGULATED BY THE CC&R'S OF THE SUBDIVISION
- STREETS "WYNDGATE RIDGE DRIVE" AND "PAUL RENAUD BLVD." ARE TO HAVE STREET TREES PLANTED AT A SPACING OF 30' FROM CENTER TO CENTER. ALL LOTS BACKING STREETS "WYNDGATE RIDGE DRIVE" AND "PAUL RENAUD BLVD." ARE TO BE LIMITED TO ONE FENCE STYLE DESIGNATED BY THE HOMEOWNERS ASSOCIATION.
- AS PART OF THE SALES CONTRACTS FOR LOTS WITH FLOODWAY AND UNDISTURBED DRAINAGE EASEMENTS ON THEM, THE PURCHASER MUST SIGN AN ACKNOWLEDGEMENT STATING THAT MAINTENANCE OF THAT UNDISTURBED AREA, DRAINAGE WAY AND/OR CREEK WILL BE THE HOME OWNER'S RESPONSIBILITY (LOTS 749, 760, 761, 779, 780, 781, & 782).
- A 10' WIDE NO-GRADE ZONE SHALL BE MAINTAINED BETWEEN VILLAGE A AND ADJACENT LOTS TO THE WEST. ANY EXISTING TREES DESTROYED IN THIS BUFFER SHALL BE REPLACED WITH A THREE (3) INCH CALIPER DECIDUOUS TREE.
- ALL AMENITIES SHALL BE HANDICAPPED ACCESSIBLE WITH PROPER NUMBER OF PARKING SPACES PROVIDED.
- THE BIKE PATH ALONG HIGHWAY N SHALL BE CONSTRUCTED IN CONJUNCTION WITH THE SUBDIVISION CONSTRUCTION.
- STREETS "WYNDGATE RIDGE DRIVE" AND "PAUL RENAUD BLVD." SHALL BE DESIGNED TO MEET OR EXCEED CITY OF OF'FALLON COLLECTOR ROAD STANDARDS AND SPECIFICATIONS. THE DESIGN SPEED FOR STREET "PAUL RENAUD BLVD." SHALL BE 35 M.P.H. AND THE POSTED SPEED SHALL BE 30 M.P.H.

### TREE PRESERVATION

Existing trees = 256.6 Acres  
Trees Saved = 141.2 Acres = 55% of trees saved  
Per ordinance, no trees need to be replaced.

### STREET TREES

1 tree shall be provided for every lot street frontage.  
(corner lots shall require additional trees for each street adjoining it.)

794 lots = 794 trees  
Corner lots fronting two streets = 118 additional trees  
Corner lots fronting three streets = 7 additional trees  
Collector Road trees (30' spacing) = 375 additional trees

Total trees required = 1294 trees

### REVEGETATION SCHEDULE

**Seeding Rates:**  
Permanant: Tall Fescue - 30 lbs./ac.  
Smooth Brome - 20 lbs./ac.  
Combined: Fescue @ 15 lbs./ac. and Brome @ 10 lbs./ac.  
Temporary: Wheat or Rye - 150 lbs./ac. (3.5 lbs. per square foot)  
Oats - 120 lbs./ac. (2.75 lbs. per square foot)

**Seeding Periods:**  
Fescue or Brome - March 1 to June 1  
August 1 to October 1  
Wheat or Rye - March 15 to November 1  
Oats - March 15 to September 15

**Mulch rates:** 100 lbs. per 1,000 sq. ft. (4,356 lbs. per acre)

**Fertilizer rates:** Nitrogen 30 lbs./ac.  
Phosphate 30 lbs./ac.  
Potassium 30 lbs./ac.  
Lime 600 lbs./ac. ENM\*

\*ENM = effective neutralizing material as per State evaluation of quarried rock.

- ALL 26' WIDE STREETS SHALL HAVE THE MINIMUM CENTERLINE RADIUS OF 150'.
- THE EXISTING LAKE SHALL REACH A MINIMUM DEPTH OF TEN (10) FEET AT THE TIME IT IS TURNED OVER TO THE HOMEOWNERS ASSOCIATION AT THE END OF CONSTRUCTION.
- HANDICAPPED ACCESSIBLE PARKING SPACES HAVE BEEN PROVIDED IN ACCORDANCE WITH ADA GUIDELINES.  
HANDICAPPED ACCESSIBLE PARKING SPACES REQUIRED PER CITY OF OF'FALLON ZONING CODE ARTICLE XII, SECTION 400.475, 8a.:  
A. POOL/BATHHOUSE: 84 PARKING SPACES TOTAL  
4 H.C. PARKING SPACES REQUIRED  
4 H.C. PARKING SPACES PROVIDED  
B. LAKESIDE AMENITIES: 16 PARKING SPACES TOTAL  
1 H.C. PARKING SPACE REQUIRED  
1 H.C. PARKING SPACE PROVIDED
- DRIVEWAY LOCATIONS SHALL NOT INTERFERE WITH THE SIDEWALK HANDICAP RAMPS
- ANY PROPOSED PAVILIONS OR PLAYGROUND AREAS WILL NEED A SEPARATE PERMIT FROM THE BUILDING DEPARTMENT
- FOR SEDIMENT AND SILTATION CONTROL MEASURES, SEE PREVIOUSLY APPROVED ROUGH GRADING PLANS
- ALL SIGN POSTS AND BACKS AND BRACKET ARMS SHALL BE PAINTED BLACK USING CARBOLINE RUSTBOND PENETRATING SEALER SO AND CARBOLINE 138B PAINT (OR EQUIVALENT AS APPROVED BY THE CITY AND MDOT).
- DEVELOPER TO PROVIDE CITY CONSTRUCTION INSPECTORS WITH SOIL REPORTS PRIOR TO OR DURING SITE SOIL TESTING.
- ALL SIGN LOCATIONS AND SIZES MUST BE APPROVED BY SEPARATELY THROUGH THE PLANNING DIVISION.
- NO BUILDING PERMITS WILL BE ISSUED FOR LOTS WITHIN THE EXISTING 100-YEAR FLOODPLAIN UNTIL THE CITY RECEIVES THE LOMR FORM FEMA.
- ALL UTILITIES SHALL BE UNDERGROUND
- A SOILS ENGINEER SHALL DETERMINE THE METHOD OF REVEGETATION OF AREAS DISTURBED BY CONSTRUCTION OF THE IMPROVEMENTS ON THESE PLANS IN THE DRAINAGE EASEMENT.
- ALL PAVING TO BE IN ACCORDANCE WITH CT. CHARLES COUNTY STANDARDS AND SPECIFICATIONS EXCEPT AS MODIFIED BY THE CITY OF OF'FALLON ORDINANCES.
- DRIVEWAY LOCATIONS SHALL NOT INTERFERE WITH THE SIDEWALK HANDICAP RAMPS.
- SIDEWALKS, CURB RAMPS, RAMP AND ACCESSIBLE PARKING SPACES SHALL BE CONSTRUCTED IN ACCORDANCE WITH THE CURRENT APPROVED "AMERICAN WITH DISABILITIES ACT ACCESSIBILITY GUIDELINES" (ADAAG) ALONG WITH THE REQUIRED GRADES, CONSTRUCTION MATERIALS, SPECIFICATIONS AND SIGNAGE. IF ANY CONFLICT OCCURS BETWEEN THE ABOVE INFORMATION AND THE PLANS, THE ADAAG GUIDELINES SHALL TAKE PRECEDENCE AND THE CONTRACTOR PRIOR TO ANY CONSTRUCTION SHALL NOTIFY THE PROJECT ENGINEER.
- CITY APPROVAL OF THE CONSTRUCTION SITE PLANS DOES NOT MEAN THAT SINGLE FAMILY AND TWO FAMILY DWELLING UNITS CAN BE CONSTRUCTED ON THE LOTS WITHOUT MEETING THE BUILDING SETBACKS AS REQUIRED BY THE ZONING CODE.
- THE CONTRACTOR SHALL ASSUME COMPLETE RESPONSIBILITY FOR CONTROLLING ALL SILTATION AND EROSION OF THE PROJECT AREA. THE CONTRACTOR SHALL USE WHATEVER MEANS NECESSARY TO CONTROL EROSION AND SILTATION INCLUDING, BUT NOT LIMITED TO STAKED STRAW BALES AND/OR SILTATION FABRIC FENCES (POSSIBLE METHODS OF CONTROL ARE DETAILED IN THE PLAN). CONTROL SHALL COMMENCE WITH GRADING AND BE MAINTAINED THROUGHOUT THE PROJECT UNTIL ACCEPTANCE OF THE WORK BY THE OWNER AND/OR THE CITY OF OF'FALLON AND/OR MDOT MAY AT THEIR OPTION DIRECT THE CONTRACTOR IN HIS METHODS AS DEEMED FIT TO PROTECT PROPERTY AND IMPROVEMENTS. ANY DEPOSITING OF SILT OR MUD ON NEW OR EXISTING PAVEMENT SHALL BE REMOVED IMMEDIATELY. ANY DEPOSITING OF SILTS OR MUD IN NEW OR EXISTING STORM SEWERS OR SWALES SHALL BE REMOVED AFTER EACH RAIN AND AFFECTED AREAS CLEANED TO THE SATISFACTION OF THE OWNER AND/OR THE CITY OF OF'FALLON AND/OR MDOT.
- ALL FILL PLACED UNDER PROPOSED STORM AND SANITARY SEWER, PROPOSED ROADS, AND/OR PAVED AREAS SHALL BE COMPACTED TO 90% OF MAXIMUM DENSITY AS DETERMINED BY THE STANDARD PROCTOR TEST AASHTO T-99. ALL FILL PLACED IN PROPOSED ROADS SHALL BE COMPACTED FROM THE BOTTOM OF THE FILL UP. ALL TESTS SHALL BE VERIFIED BY A SOILS ENGINEER CONCURRENT WITH GRADING AND BACKFILLING OPERATIONS. ENSURE THE MOISTURE CONTENT OF THE SOIL IN FILL AREAS IS TO CORRESPOND TO THE COMPACTIVE EFFORT AS DEFINED BY THE STANDARD OR MODIFIED PROCTOR TEST. OPTIMUM MOISTURE CONTENT SHALL BE DETERMINED USING THE SAME TEST THAT WAS USED FOR COMPACTION. SOIL COMPACTION CURVES SHALL BE SUBMITTED TO THE CITY OF OF'FALLON PRIOR TO THE PLACEMENT OF FILL. PROOF ROLLING MAY BE REQUIRED TO VERIFY SOIL STABILITY AT THE DISCRETION OF THE CITY OF OF'FALLON.
- ENTIRE SITE IS STILL UNDER INVESTIGATION BY THE DEVELOPER'S SOILS CONSULTANT FOR SNKHOLES THAT MAY BE ON THE PROPERTY. THE RESULTING REMEDIATION OF DISCOVERED SNKHOLES WILL BE ADDRESSED BY THE SOILS CONSULTANT ON A SEPARATE SET OF PLANS. THE FINAL RESULTS OF THE SITE INVESTIGATION AND REMEDIATION WILL BE PLACED IN THE CITY'S FILES FOR THIS DEVELOPMENT.
- COPIES OF THE DOCUMENTATION TO THE CORPS OF ENGINEERS FOR THE PRESERVED WETLANDS AREA AS SHOWN ON THE PLANS WILL BE SUPPLIED TO THE CITY WHEN PREPARED.
- ALL MONUMENTS AND FENCES ARE BY SEPARATE PERMIT.


These "As-Built" Storm Sewer plans, are based on actual field measurements conducted during January 2006, and the results are shown thereon.

By: *[Signature]* 2-6-06

JAMES R. CHERVEK P.L.S., #2211  
STATE OF MISSOURI  
PICKETT RAY & SILVER'S CORPORATE  
REGISTRATION NO. LS-54-D

# WYNDGATE IMPROVEMENT PLANS (794 LOTS) VILLAGE E-1 "AS-BUILTS"

TRACTS OF LAND BEING PART OF FRACTIONAL SECTIONS 16 & 17, AND U.S. SURVEYS 61 & 417, TOWNSHIP 46 NORTH, RANGE 2 EAST, ST. CHARLES COUNTY, MISSOURI

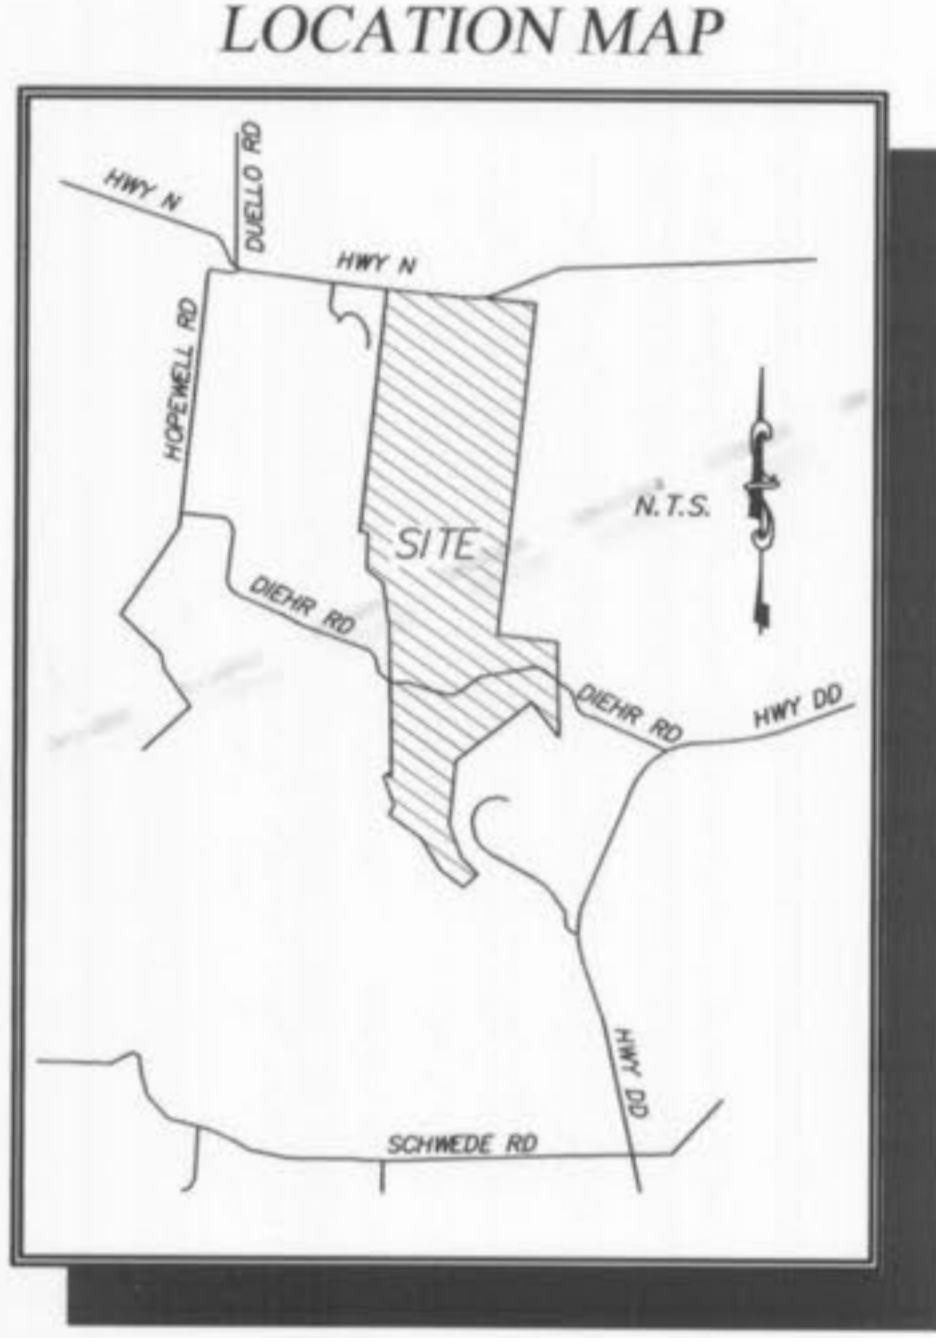

**Call BEFORE you DIG**  
TOLL FREE  
1-800-344-7483  
MISSOURI ONE-CALL SYSTEM, INC.

MoDOT LOCATOR: 314-340-4100

**PROJECT BENCH MARK**  
U.S.G.S BENCH MARK  
At Dardene T.46N., R.2E. Near Approx. Corner Sections 1, 2, 11 & 12, 31' north & 20' west of crossroads, 49' south of S.E. corner of Catholic Church, 2.0' north of sidewalk & in a concrete post standard tablet stamped "T" 60C 1936 616".  
Elev. 616.50

### LEGEND

	Sanitary Sewer (Proposed)		Sanitary Structure		R.C.P. Reinforced Concrete Pipe
	Sanitary Sewer (Existing)		Storm Structure		C.M.P. Corrugated Metal Pipe
	Storm Sewer (Proposed)		Test Hole		C.I.P. Cast Iron Pipe
	Storm Sewer (Existing)		Power Pole		P.V.C. Polyvinyl Chloride
	Water Line & Size		Light Standard		V.C.P. Vitrified Clay Pipe
	Existing water line		Double Water Meter Setting		C.O. Clean Out
	Tee & Valve		Single Water Meter Setting		V.T. Vent Trap
	Hydrant		C.I. Curb Inlet		T.B.R. To Be Removed
	Cap		S.C.I. Skewed Curb Inlet		T.B.R.&R. To Be Removed & Relocated
	Lot or Building Number		D.C.I. Double Curb Inlet		T.B.P. To Be Protected
	Existing Fence Line		G.I. Gate Inlet		T.B.A. To Be Abandoned
	Existing Tree Line		D.A.I. Double Area Inlet		B.C. Base Of Curb
	Street Sign		C.C. Concrete Collar		T.C. Top Of Curb
	Existing Contour		F.E.S. Flared End Section		T.W. Top Of Wall
	Proposed Contour		E.P. End Pipe		B.W. Base Of Wall
	Rip-Rap		E.D. Energy Dissipator		(TYP) Typical
	End of Lateral		M.H. Manhole		U.N.O. Unless Noted Otherwise
	Asphalt Pavement		C.P. Concrete Pipe		U.I.P. Use in Place
	Concrete Pavement		S.A.S. Sinkhole Access Structure		Yield Sign
	Proposed Swale				

# DRAWING INDEX

Sheet	Description
1	COVER SHEET
2	GENERAL NOTES & REVISION BLOCK
3	SITE MAP
4-8	EROSION CONTROL PLANS
9	EROSION DETAIL
10A	VILLAGE "A" COVER SHEET
11A-13A	VILLAGE "A" SITE PLAN
14A-16A	VILLAGE "A" GRADING PLAN
17A	VILLAGE "A" STREET PROFILES
18A-19A	VILLAGE "A" SANITARY SEWER PROFILES
20A-21A	VILLAGE "A" STORM SEWER PROFILES
22A-25A	VILLAGE "A" DRAINAGE AREA MAP
26A-28A	VILLAGE "A" WATER LAYOUT
29A	VILLAGE "A" DETENTION BASIN
30A	VILLAGE "A" WINTER PARK RECREATION AREA
31A	VILLAGE "A" LANDSCAPING PLAN
32B	VILLAGE "B" COVER SHEET
33B,34B,35B	VILLAGE "B" SITE PLAN
36B-38B	VILLAGE "B" GRADING PLAN
39B-41B	VILLAGE "B" STREET PROFILES
42B-44B	VILLAGE "B" SANITARY SEWER PROFILES
45B-47B	VILLAGE "B" STORM SEWER PROFILES
48B-51B	VILLAGE "B" DRAINAGE AREA MAP
52B-54B	VILLAGE "B" WATER LAYOUT
55B	VILLAGE "B" TEMP. SCHOOL BUS ACCESS & POOL SITE
56B	VILLAGE "B" SUMMER PARK POOL SITE
57B	VILLAGE "B" LANDSCAPING PLAN
58C	VILLAGE "C" COVER SHEET
59C-60C	VILLAGE "C" SITE PLAN
61C-62C	VILLAGE "C" GRADING PLAN
63C-64C	VILLAGE "C" STREET PROFILES
65C-66C	VILLAGE "C" SANITARY SEWER PROFILES
67C-68C	VILLAGE "C" STORM SEWER PROFILES
69C-70C	VILLAGE "C" DRAINAGE AREA MAP
71C-72C	VILLAGE "C" WATER LAYOUT
73C	VILLAGE "C" LANDSCAPING PLAN
74D	VILLAGE "D" COVER SHEET
75D-77D	VILLAGE "D" SITE PLAN
78D-80D	VILLAGE "D" GRADING PLAN
81D-82D	VILLAGE "D" STREET PROFILES
83D-84D	VILLAGE "D" SANITARY SEWER PROFILES
85D-86D	VILLAGE "D" STORM SEWER PROFILES
87D-89D	VILLAGE "D" DRAINAGE AREA MAP
90D-92D	VILLAGE "D" WATER LAYOUT
93D	VILLAGE "D" RETAINING WALLS
94D	VILLAGE "D" LANDSCAPING PLAN
95E	VILLAGE "E" COVER SHEET
96E-99E	VILLAGE "E" SITE PLAN <b>97E,98E</b>
100E-103E	VILLAGE "E" GRADING PLAN
104E-106E	VILLAGE "E" STREET PROFILES
107E	VILLAGE "E" DIEHR RD. ENTRANCE DETAIL
108E	VILLAGE "E" SIGHT DISTANCE EXHIBIT
109E-111E	VILLAGE "E" SANITARY SEWER PROFILES
<b>112E-114E</b>	VILLAGE "E" STORM SEWER PROFILES
115E-120E	VILLAGE "E" DRAINAGE AREA MAP
121E-124E	VILLAGE "E" WATER LAYOUT
125E-126E	VILLAGE "E" DETENTION BASIN
127E	VILLAGE "E" AUTUMN PARK/SPRING PARK REC. AREAS
128E	VILLAGE "E" MBR LANDSCAPING PLAN
129E-130E	VILLAGE "E" LANDSCAPING PLAN
131F	VILLAGE "F" COVER SHEET
132F-136F	VILLAGE "F" SITE PLAN
137F-139F	VILLAGE "F" GRADING PLAN
140F-141F	VILLAGE "F" STREET PROFILES
142F-143F	VILLAGE "F" DIEHR RD. ENTRANCE DETAILS
144F-146F	VILLAGE "F" SANITARY SEWER PROFILES
147F	VILLAGE "F" LIFT STATION SITE PLAN
148F-149F	VILLAGE "F" LIFT STATION DETAILS
150F-151F	VILLAGE "F" STORM SEWER PROFILES
152F-154F	VILLAGE "F" DRAINAGE AREA MAP
155F-157F	VILLAGE "F" WATER LAYOUT
158F	VILLAGE "F" DETENTION BASIN
159F	VILLAGE "F" RETAINING WALLS
160F	VILLAGE "F" LANDSCAPING PLAN
161-164	TRAFFIC CONTROL PLANS
165-174B	GENERAL CONSTRUCTION DETAILS

**PICKETT RAY & SILVER**  
335 Mid Rivers Mall Drive  
St. Peters, MO 63376  
Phone (636) 397-1211  
Fax (636) 397-1104

**CIVIL ENGINEERS PLANNERS LAND SURVEYORS**

**WYNDGATE COVER SHEET**

Prepared For: **SUMMIT POINTE, L.C.**  
239 FOX HILL ROAD  
ST. CHARLES, MO. 63001  
(636) 940-9100

NO.	DATE	REVISIONS
1	10/26/04	REVISED PER CITY
2	12/09/04	REVISED PER PMSD #2
3	12/20/04	REVISED PER PMSD #2
4	01/20/05	REVISED PER PMSD #2
5	02/03/05	REVISED PER PMSD #2
6	02/18/05	REVISED PER CITY OF OF'FALLON
7	03/09/05	MOVE MHI 602 PER CLIENT
8	03/25/05	REVISED PER R. & D. #2
9	04/09/05	REVISED PER CITY & CLIENT
10	04/13/05	REVISED PER CITY

**ENGINEERS AUTHENTICATION**  
The responsibility for professional engineering liability on this project is hereby limited to the set of plans authorized by the seal, signature, and date hereunder attached. Responsibility is disclaimed for all other engineering plans involved in this project and specifically excludes revisions after this date unless reauthorized.

**PICKETT, RAY & SILVER, INC.**

SEE SHEET 2 FOR FURTHER REVISIONS.

**P & Z NO. 3203**

WYNDGATE - PHASE 1 COVER SHEET

SHEET 1 OF 174

Copyright 2004 by Pickett, Ray & Silver Inc.



SEE SHEET 97E38

SEE SHEET 99E

**PICKETT RAY & SILVER**  
 CIVIL ENGINEERS  
 PLANNERS  
 LAND SURVEYORS




333 Mid Rivers Mall Drive  
 St. Peters, MO 63376  
 Phone (636) 397-1211  
 Fax (636) 397-1104

**WYNDGATE VILLAGE E SITE PLAN**

Prepared For:  
**SUMMIT POINTE, L.C.**

230 FOX HILL ROAD  
 (636) 944-9777

**UTILITY NOTE:**  
 UNDEGROUND FACILITY STRUCTURES AND UTILITIES HAVE BEEN PLOTTED FROM AVAILABLE RECORDS AND RECONSTRUCTION FROM FIELD SURVEYING. THESE LOCATIONS MUST BE CONSIDERED APPROXIMATE ONLY. VARIATION OF LOCATION OF A.L. UNDEGROUND STRUCTURES AND FACILITIES BETWEEN DRAWING OR BEST AVAILABLE ON THESE PLANS, SHALL BE THE RESPONSIBILITY OF THE CONTRACTOR.

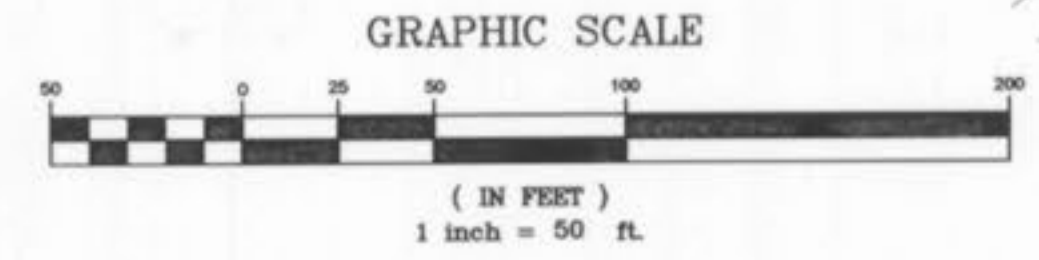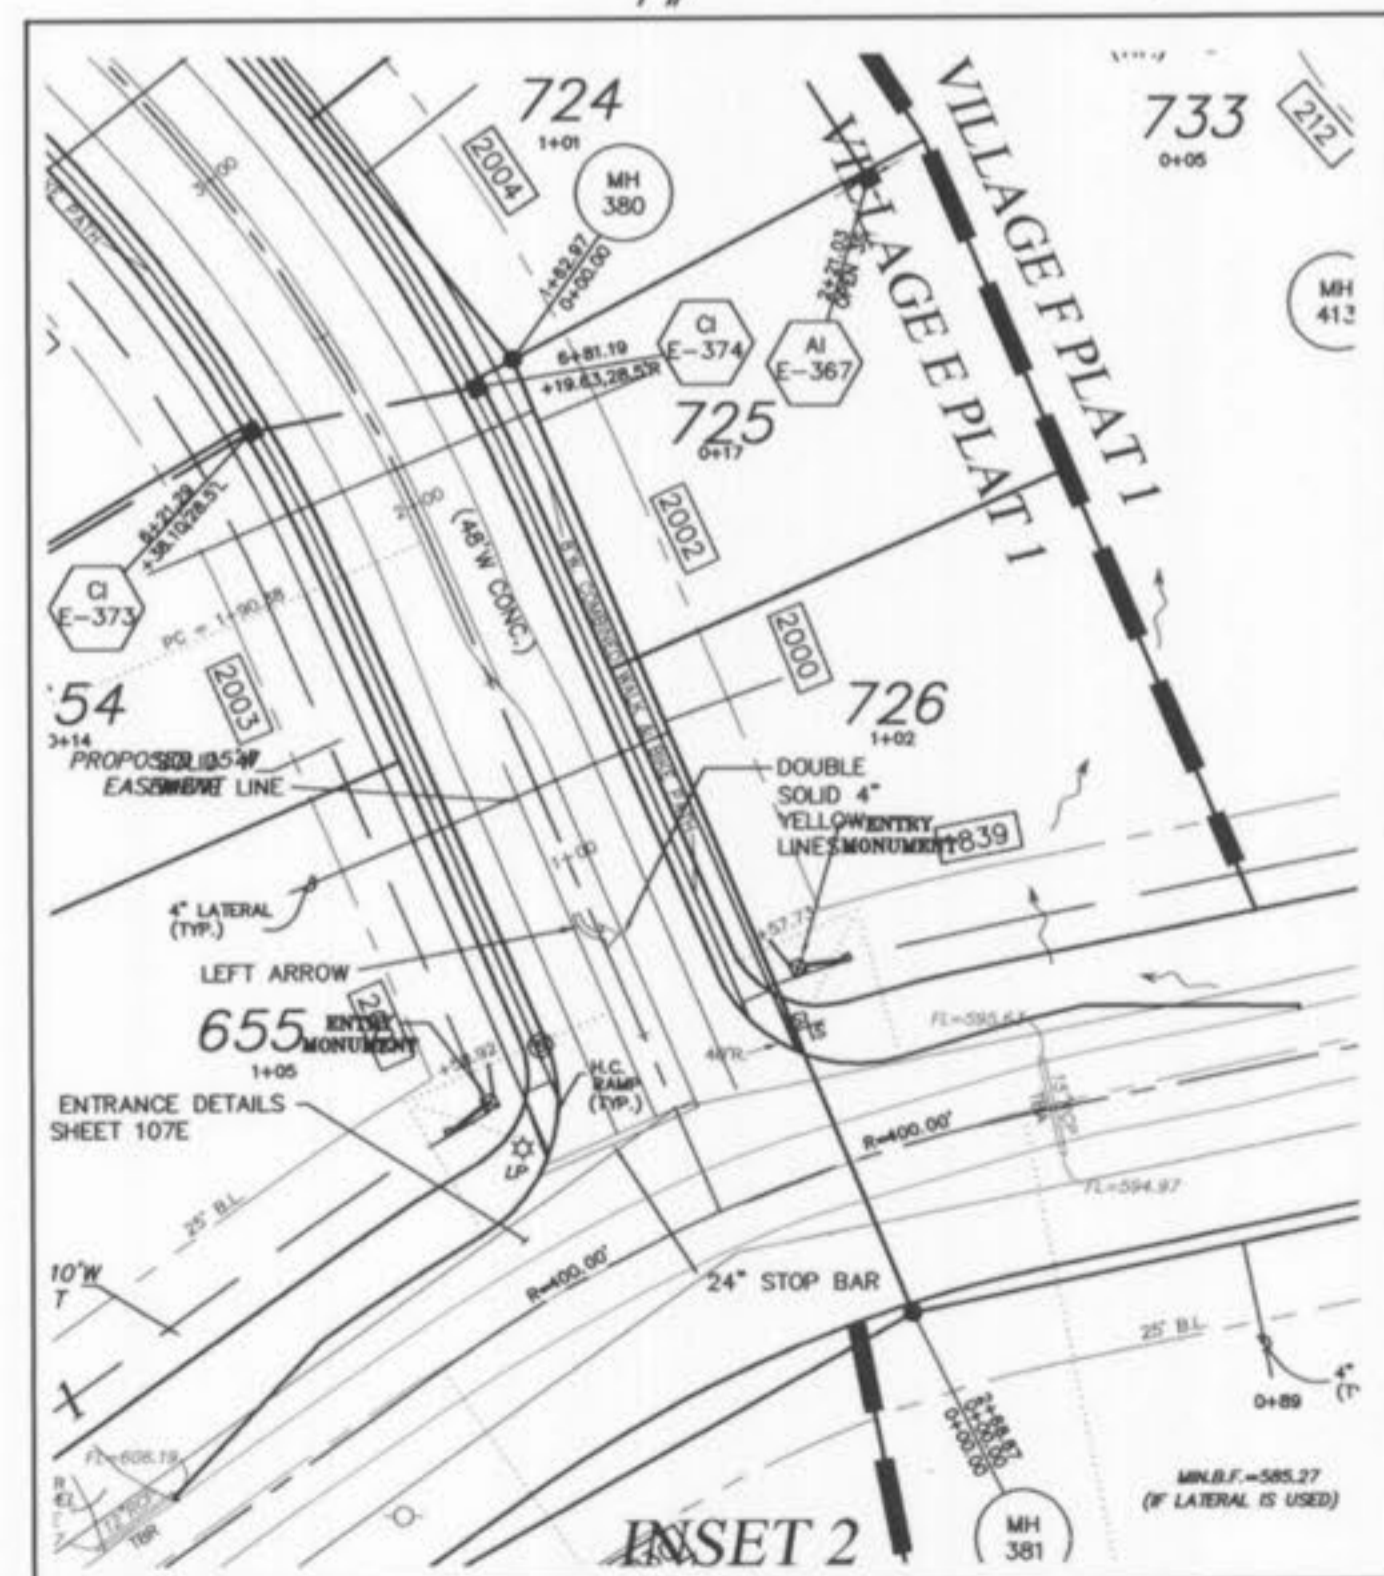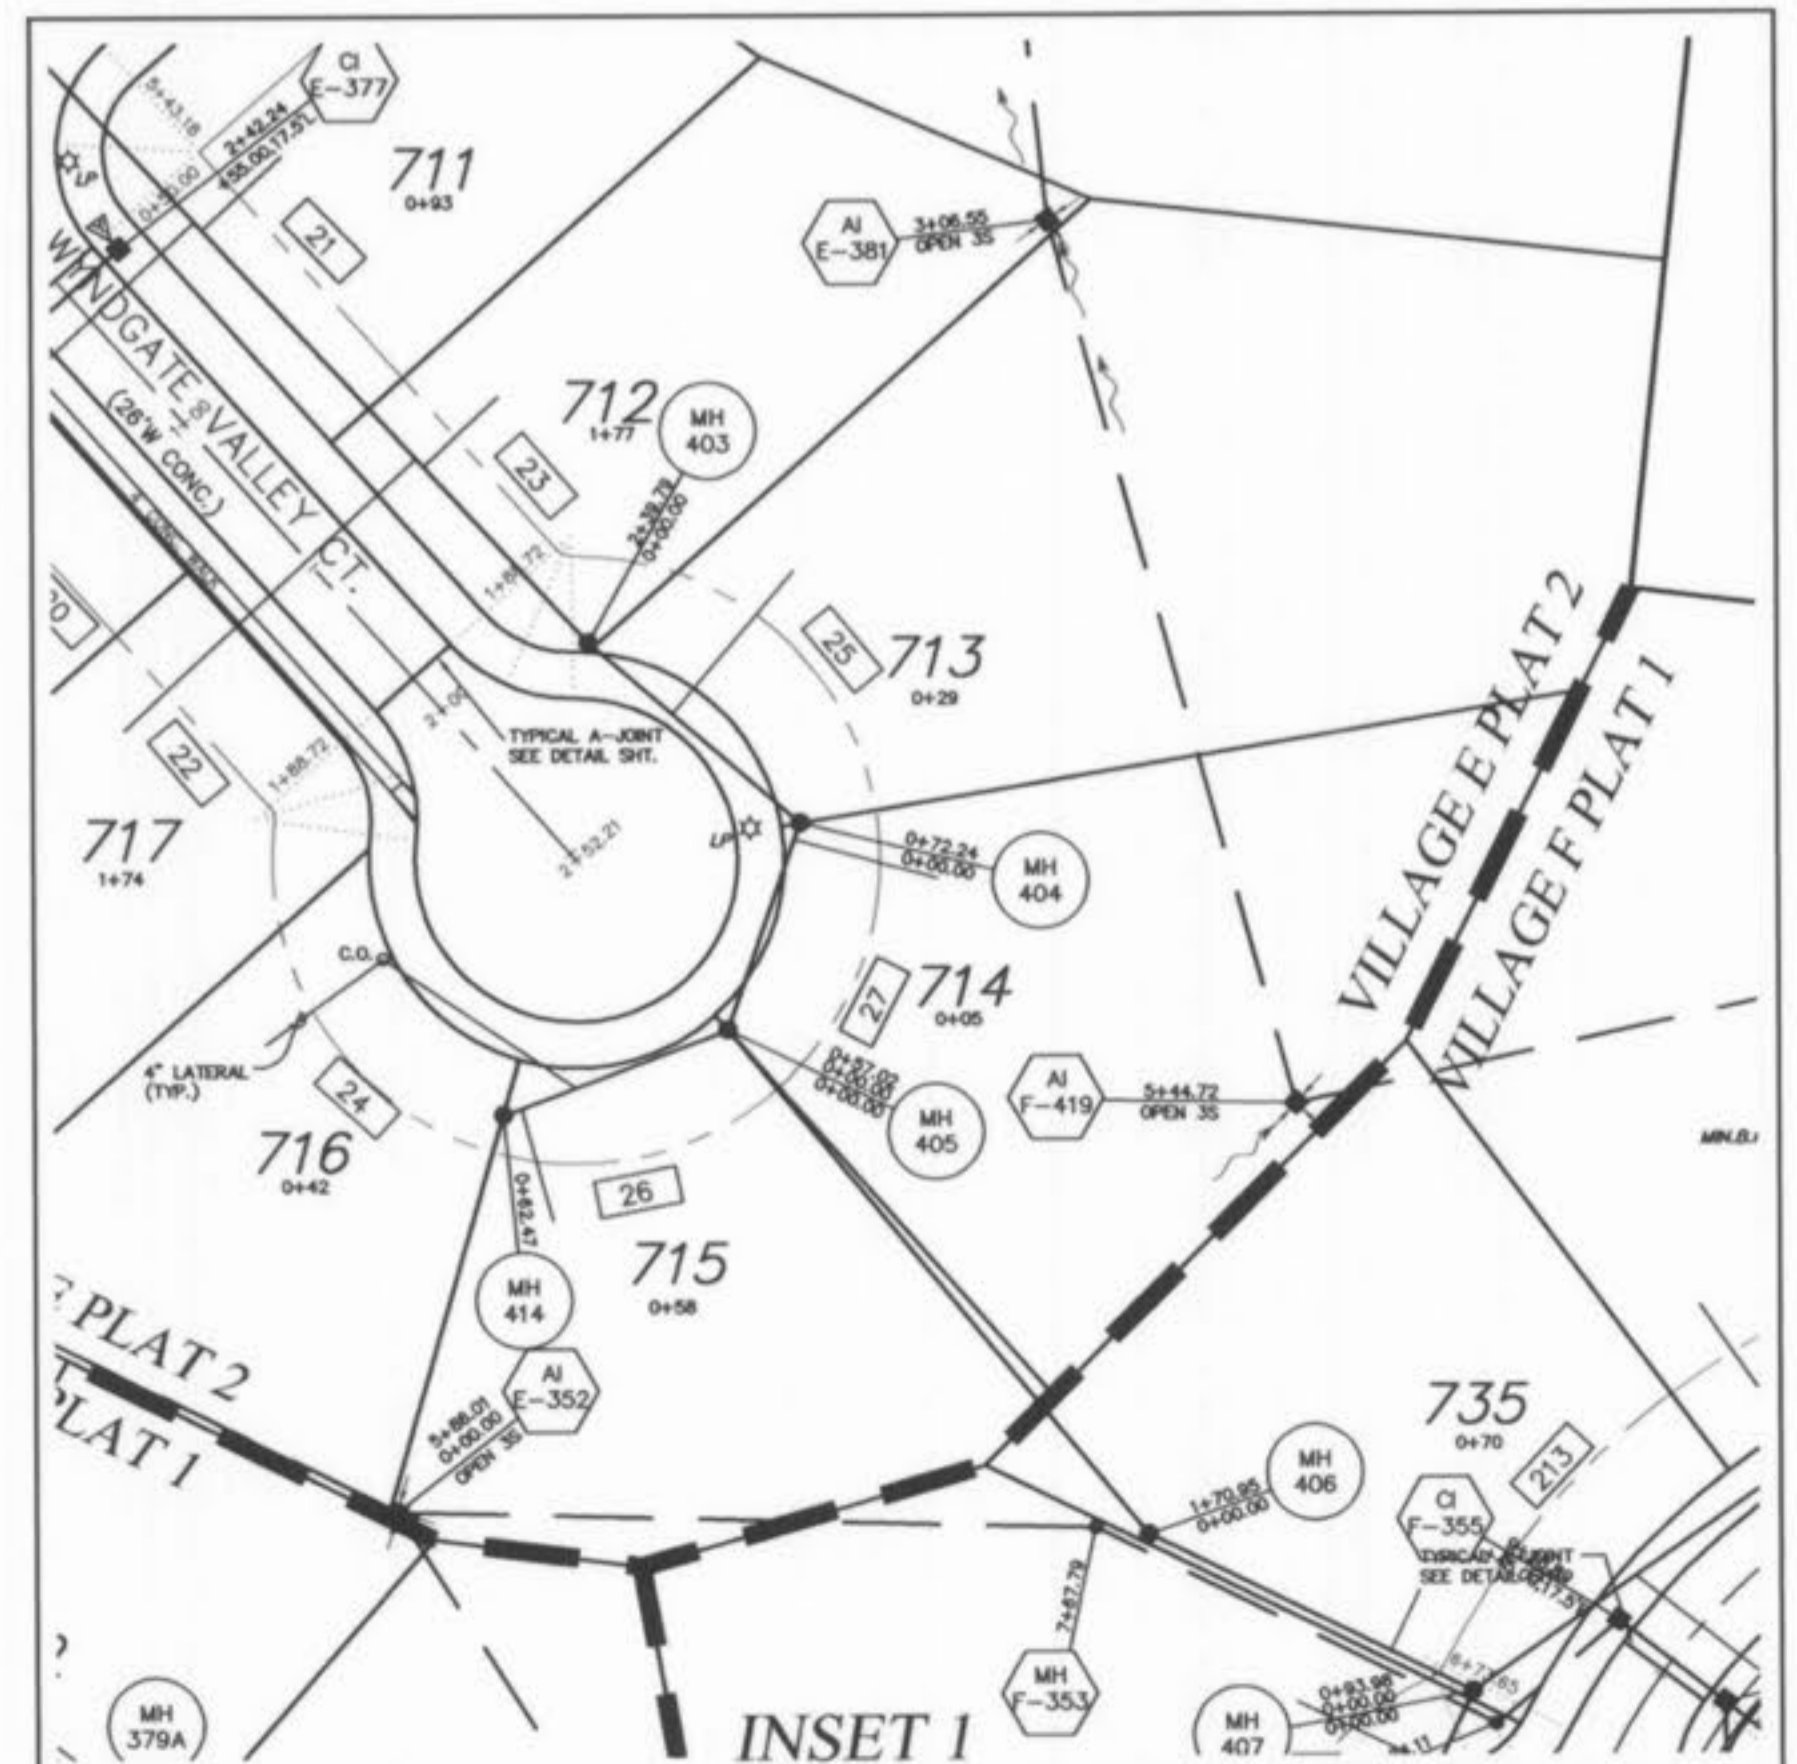

STATE OF MISSOURI  
 ENGINEER  
 R. J. Pickett  
 2-6-06

**"AS-BUILTS"**  
 VILLAGE E-2  
 02/06/06

REVISIONS	NO.	DATE	REVISION
	1	10/25/04	REVISED PER CITY
	2	12/20/04	REVISED PER DCSD
	3	2/03/05	REVISED PER DCSD
	4	02/18/05	REVISED PER CITY & CLIENT
	5	4/09/05	REVISED PER CITY
	6	4/13/05	REVISED PER AMENITY
	7	8/09/05	REVISED PER CITY
	8	10/28/05	SUBMITTAL A - JOINTS ELIMINATED
	9	02/08/06	* AS-BUILTS VILLAGE E-2

**ENGINEERS AUTHENTICATION**  
 The responsibility for professional engineering liability on this project is hereby limited to the set of plans authenticated by the seal, signature, and date hereunder attached. Responsibility is disclaimed for all other engineering plans involved in this project and specifically excludes revisions after this date unless reauthenticated.  
 PICKETT, RAY & SILVER, INC

DRAWN: JEE DATE: 6-29-04  
 CHECKED: DWD DATE: 6-29-04  
 PROJECT # 01267-SUPD.02R  
 TASK # 2 FIELD BOOK

WYNDGATE VILLAGE E SITE PLAN  
 SHEET 98E OF 174  
 © Copyright 2004 by Pickett, Ray & Silver Inc.

"AS-BUILTS"  
VILLAGE E-1  
02/06/06

WYNDGATE  
VILLAGE E  
STORM SEWER PROFILES

Prepared For:  
SUMMIT POINTE, L.C.



CIVIL ENGINEERS  
PLANNERS  
LAND SURVEYORS


333 Mid Rivers Mall Drive  
St. Peters, MO 63376  
Phone (636) 397-1211  
Fax (636) 387-1104

REVISIONS NO.	DATE	REVISIONS
1	10/25/04	REVISED PER CITY
2	12/09/04	REVISED PER PWSB No.2
3	12/20/04	REVISED PER DCSD
4	01/20/05	REVISED PER PWSB No.2
6	02/18/05	REVISED PER CITY OF O'FALLON
9	04/08/05	REVISED PER CITY AND CLIENT
10	02/06/06	"AS-BUILTS" VILLAGE E-1

ENGINEERS AUTHENTICATION  
The responsibility for professional engineering liability on this project is hereby limited to the set of plans authenticated by the seal, signature, and date hereunder attached. Responsibility is disclaimed for all other engineering plans involved in this project and specifically excludes revisions after this date unless reauthenticated.  
PICKETT, RAY & SILVER, INC

DRAWN	JEE	DATE	6-29-04
CHECKED	DWD	DATE	6-29-04
PROJECT	# 01267-SUP0.02R		
TASK #	2	FIELD BOOK	


WYNDGATE  
VILLAGE E  
STORM SEWER PROFILES  
SHEET 112E OF 174  
© Copyright 2004 by Pickett, Ray & Silver Inc.

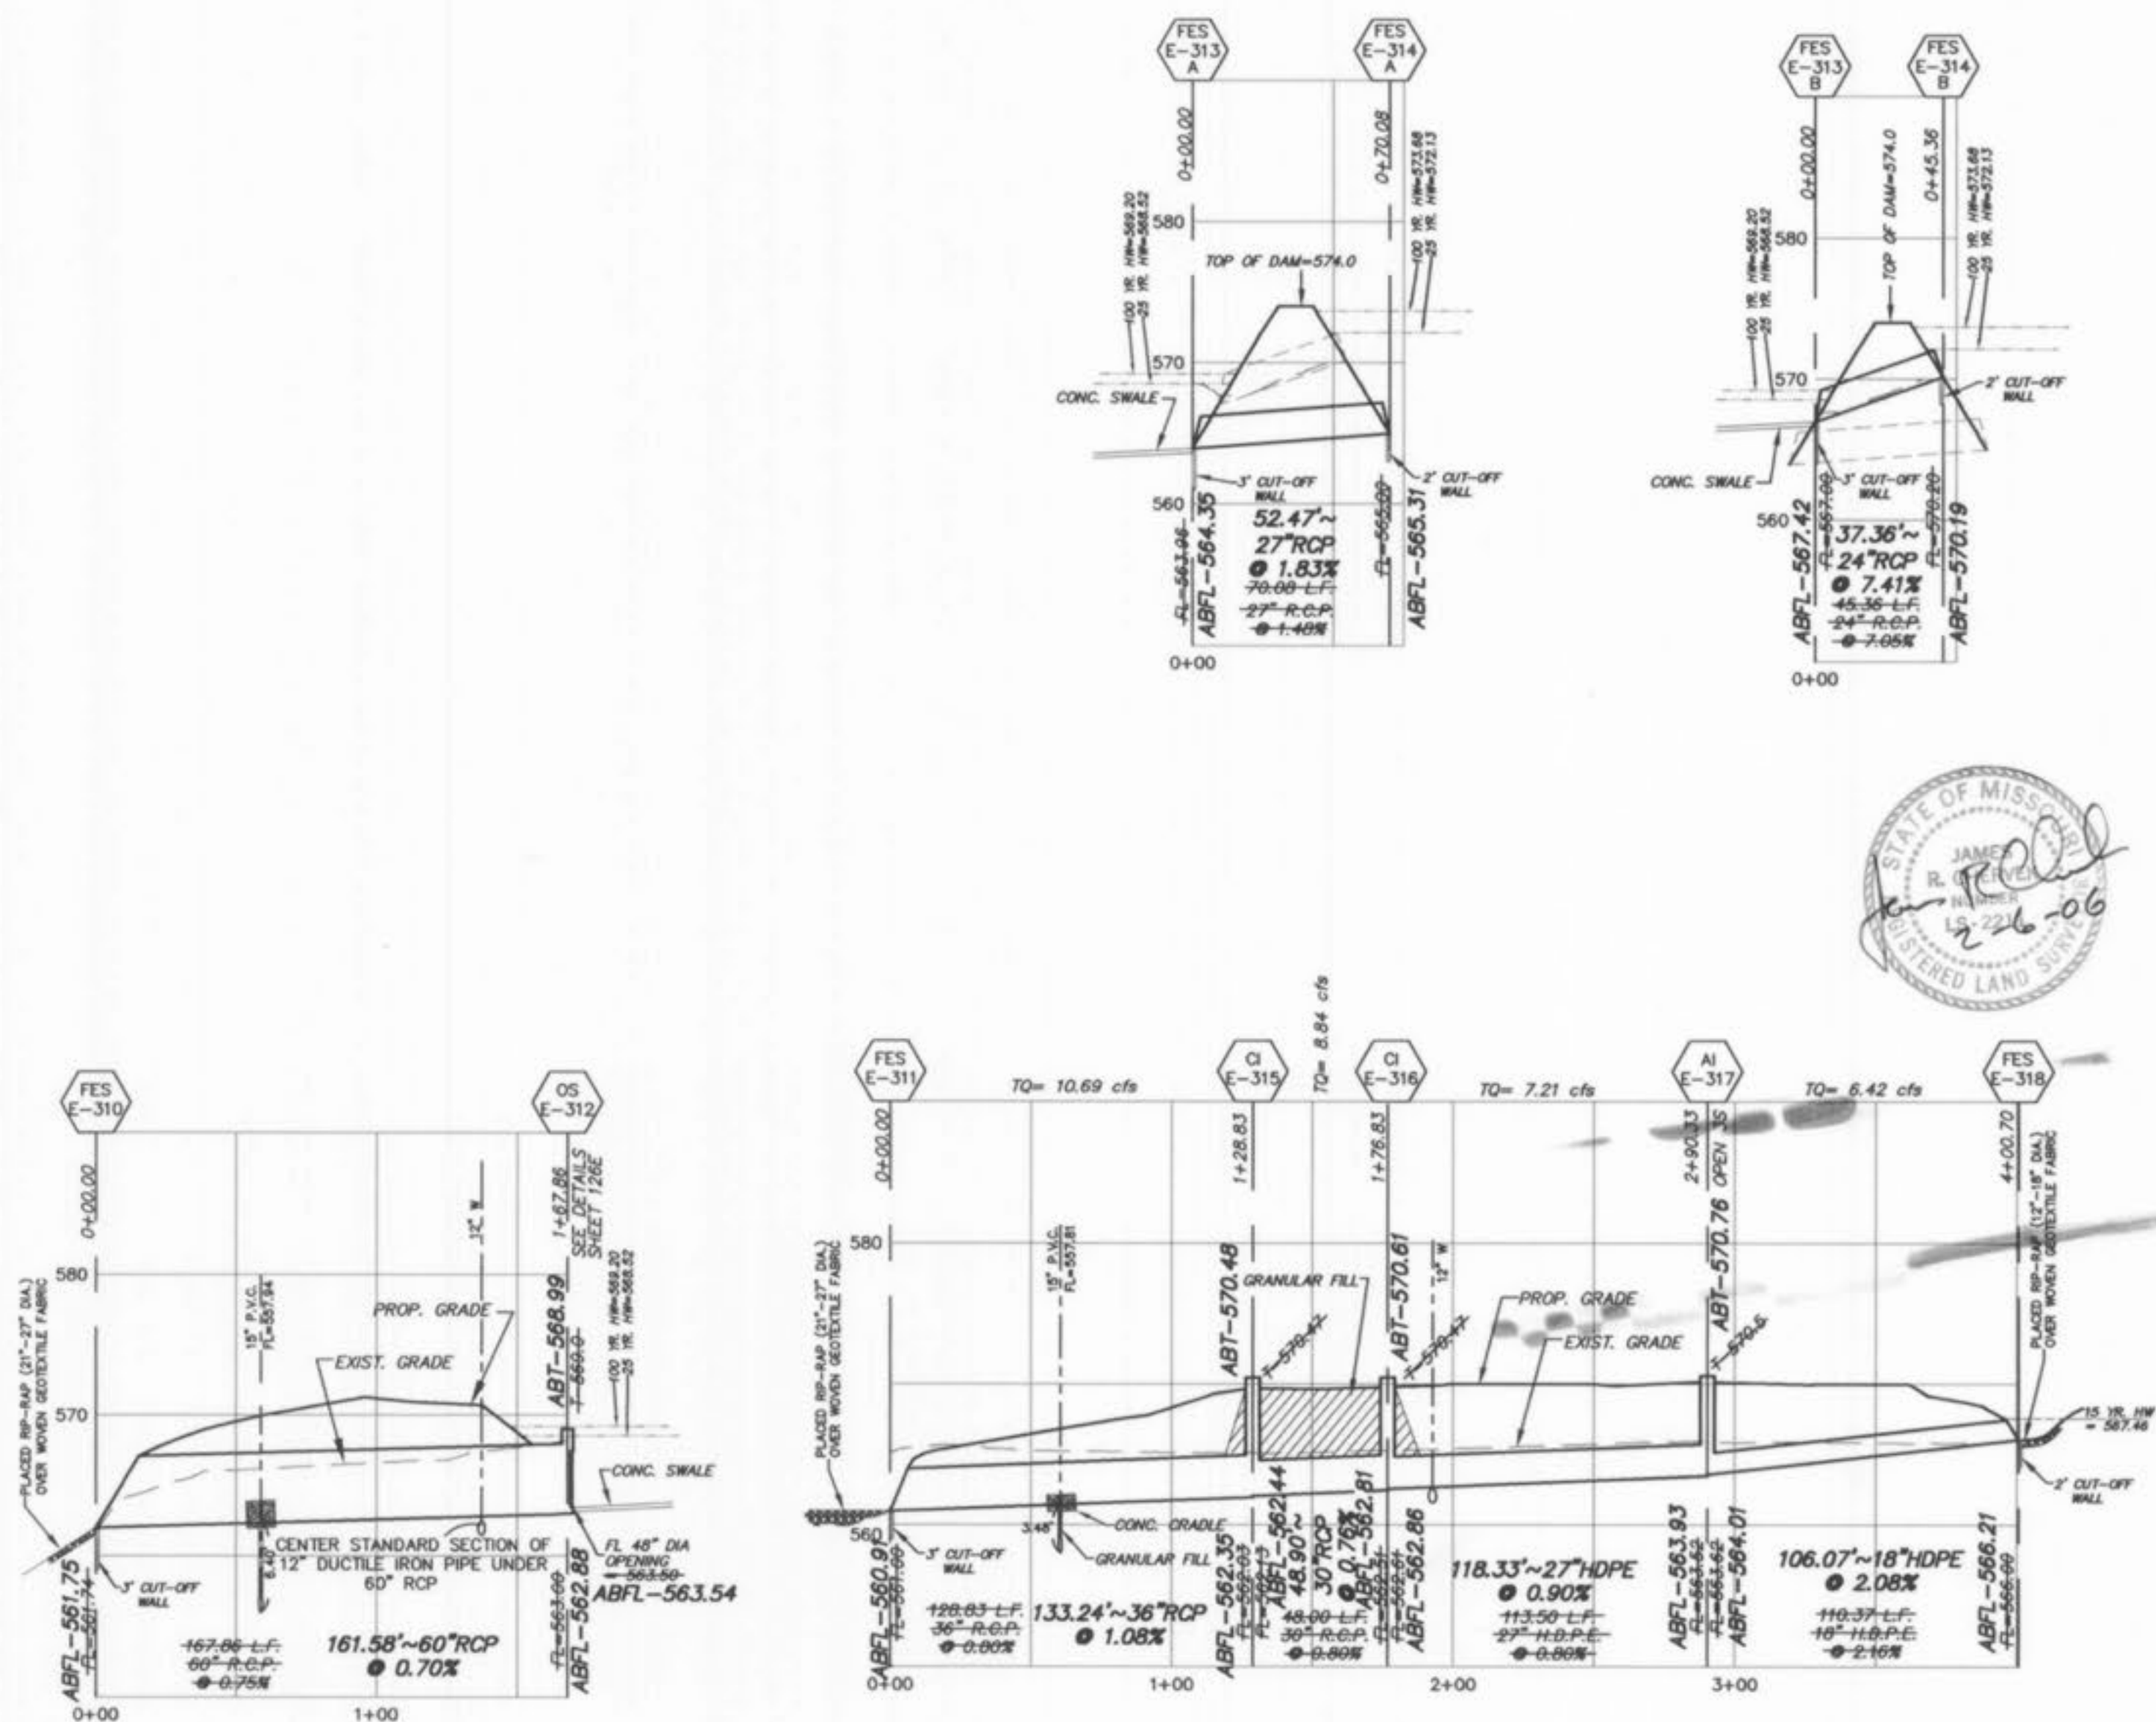

ALL SANITARY LATERAL STREET CROSSINGS, IF TRENCHED, SHALL BE BACKFILLED WITH GRANULAR MATERIAL (AGGREGATE).  
IF THE STORM AND SANITARY SEWERS ARE PARALLEL AND IN THE SAME TRENCH OR OVERDING, THE UPPER SHALL BE PLACED ON A SHELF AND THE LOWER SHALL BE BEDDED IN COMPACTED GRANULAR FILL TO THE FLOW LINE OF THE UPPER.

STORM SEWERS WHICH CROSS OVER EXISTING OR PROPOSED SANITARY SEWER TRENCHES SHALL BE CRADLED IN CONCRETE (OR ENCASED H.D.P.E.) THROUGH THE FULL WIDTH OF THE SANITARY SEWER TRENCH. THE TRENCH SHALL BE BACKFILLED AND COMPACTED GRANULAR FILL TO THE BOTTOM OF THE CONCRETE CRADLE.


HORIZONTAL SCALE: 1"=50'  
VERTICAL SCALE: 1"=10'

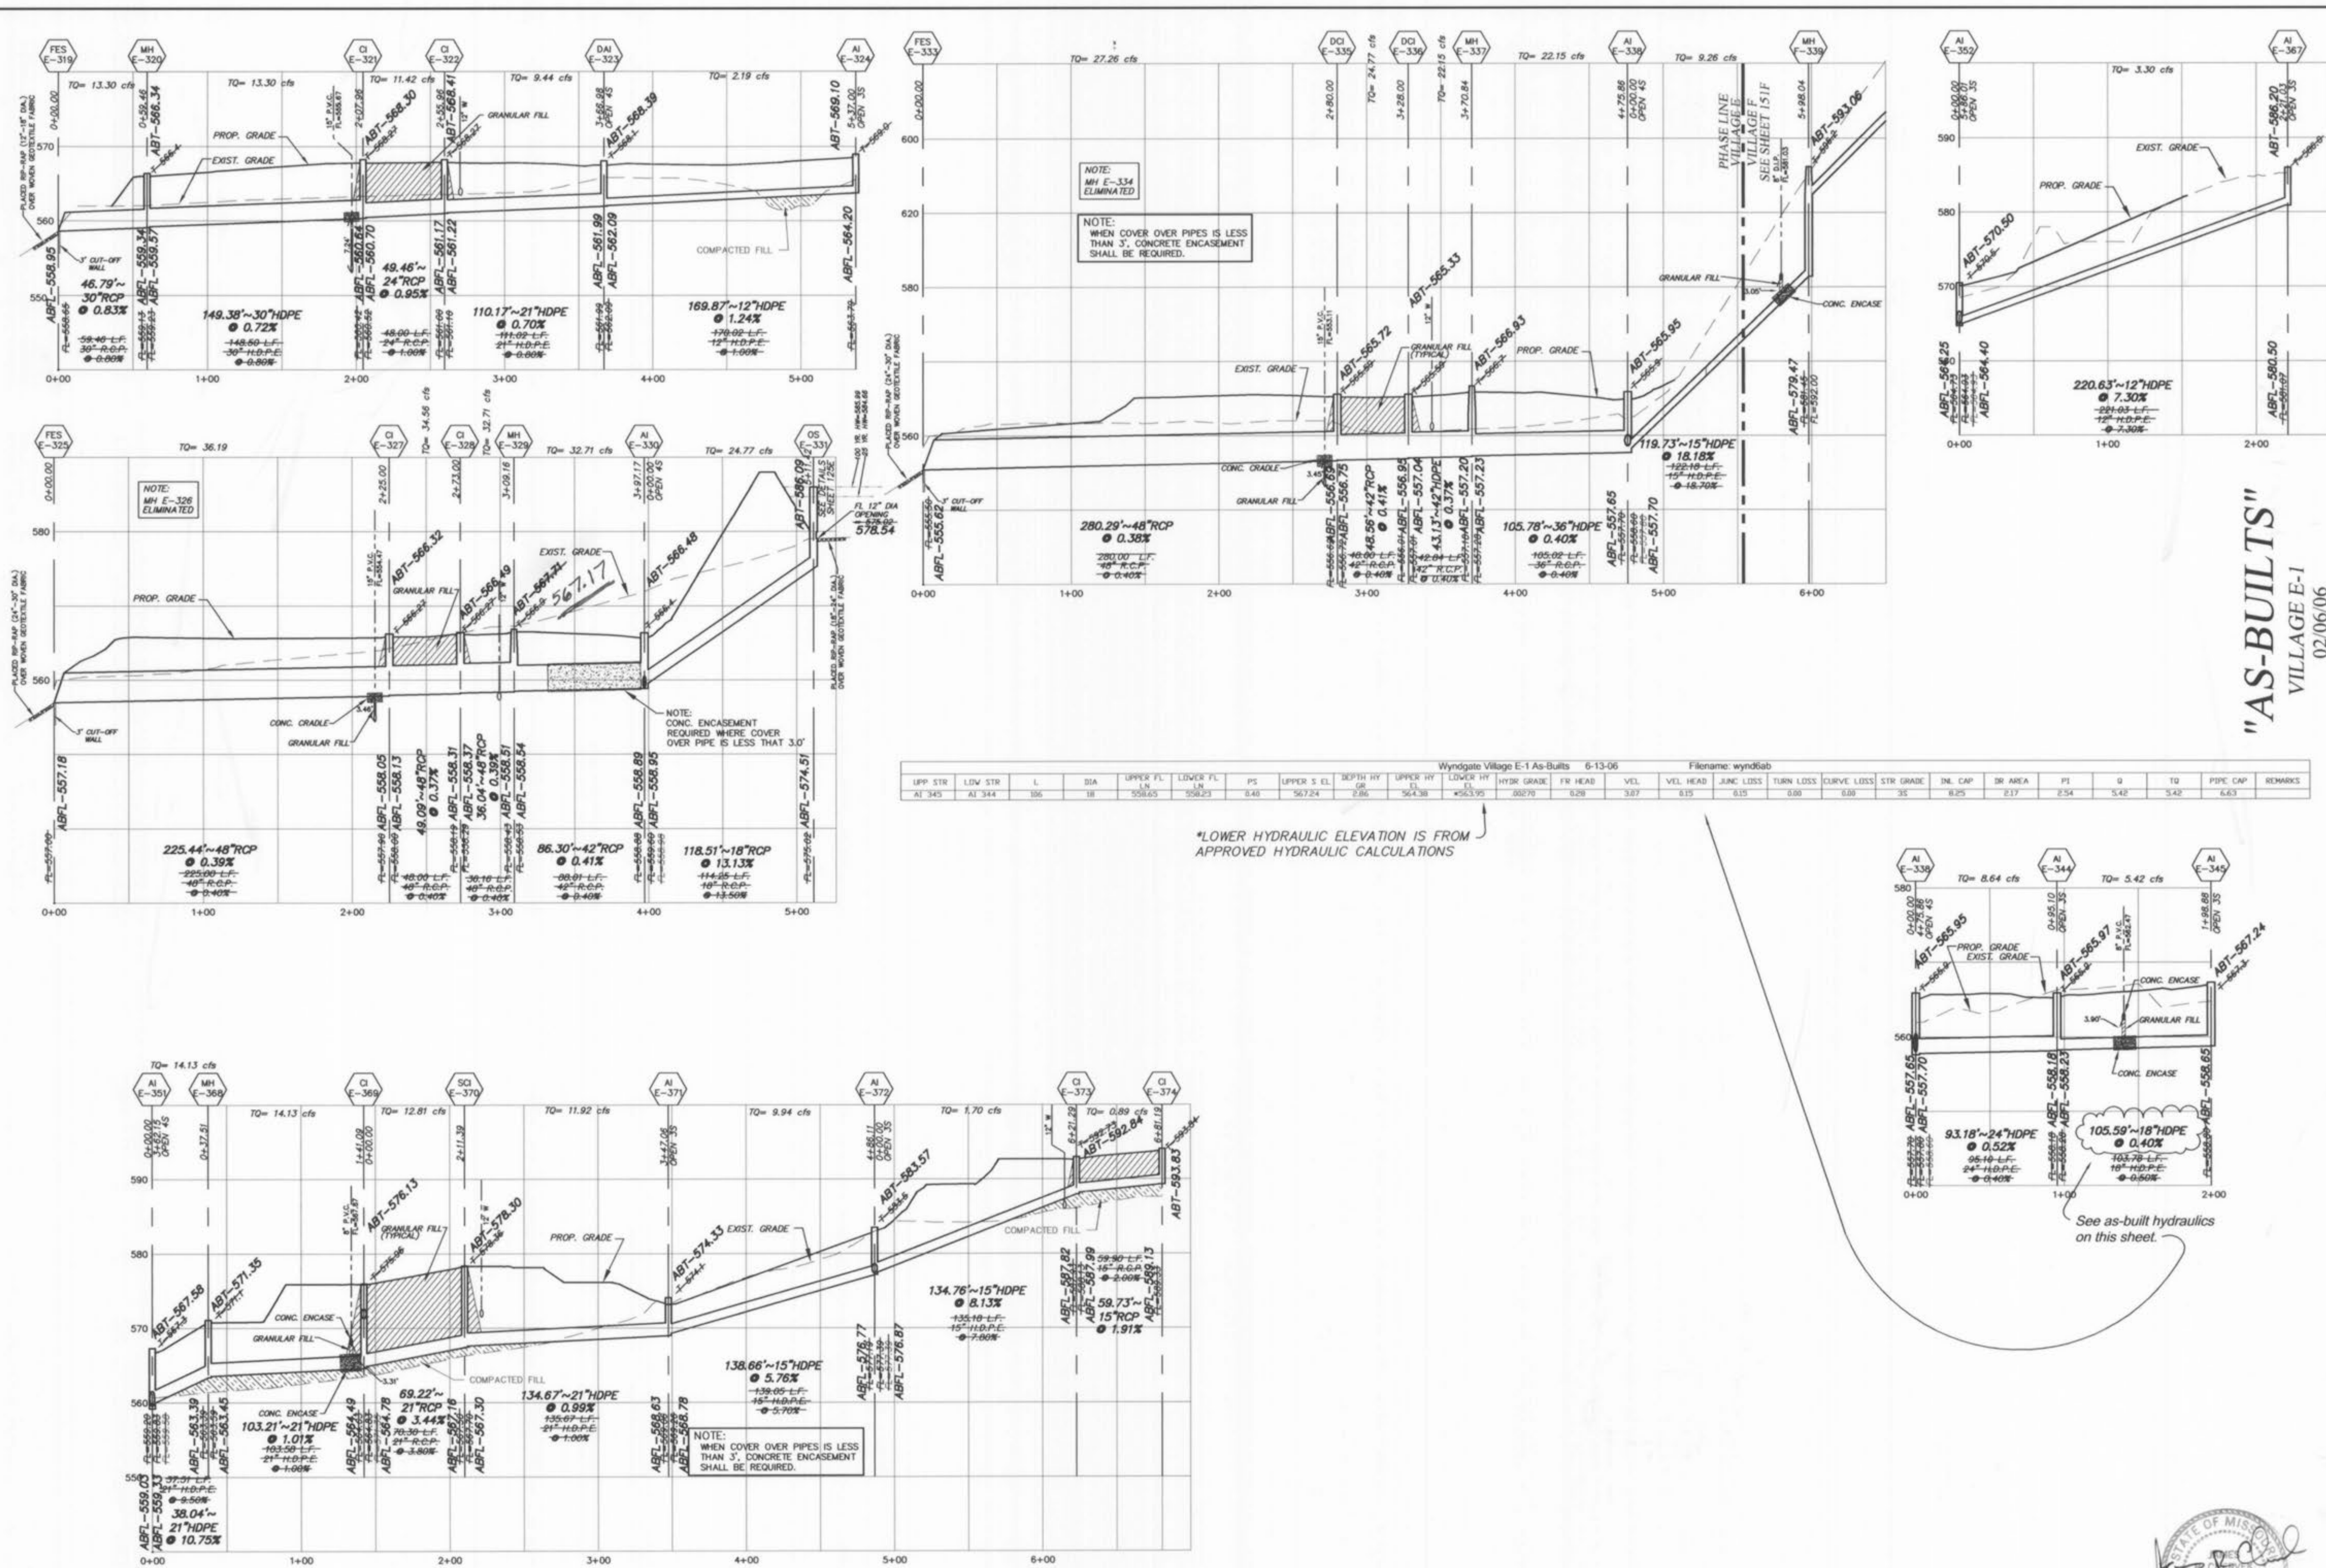

Wyndgate Village E-1 As-Built 6-13-06

UPP STR	LOW STR	L	DIA	UPPER FL	LOWER FL	PS	UPPER S EL	DEPTH HY	UPPER HY	LOWER HY	HYDR GRADE	FR HEAD	VEL	VEL HEAD	JUNC LOSS	TURN LOSS	CURVE LOSS	STR GRADE	IN. CAP	DR AREA	PI	Q	TQ	PIPE CAP	REMARKS
At 345	At 344	106	18	558.65	558.23	0.40	567.24	2.86	564.38	553.95	0.0270	0.26	3.07	6.15	6.15	0.00	0.00	35	8.25	2.17	2.54	5.42	3.42	6.63	

\*LOWER HYDRAULIC ELEVATION IS FROM APPROVED HYDRAULIC CALCULATIONS

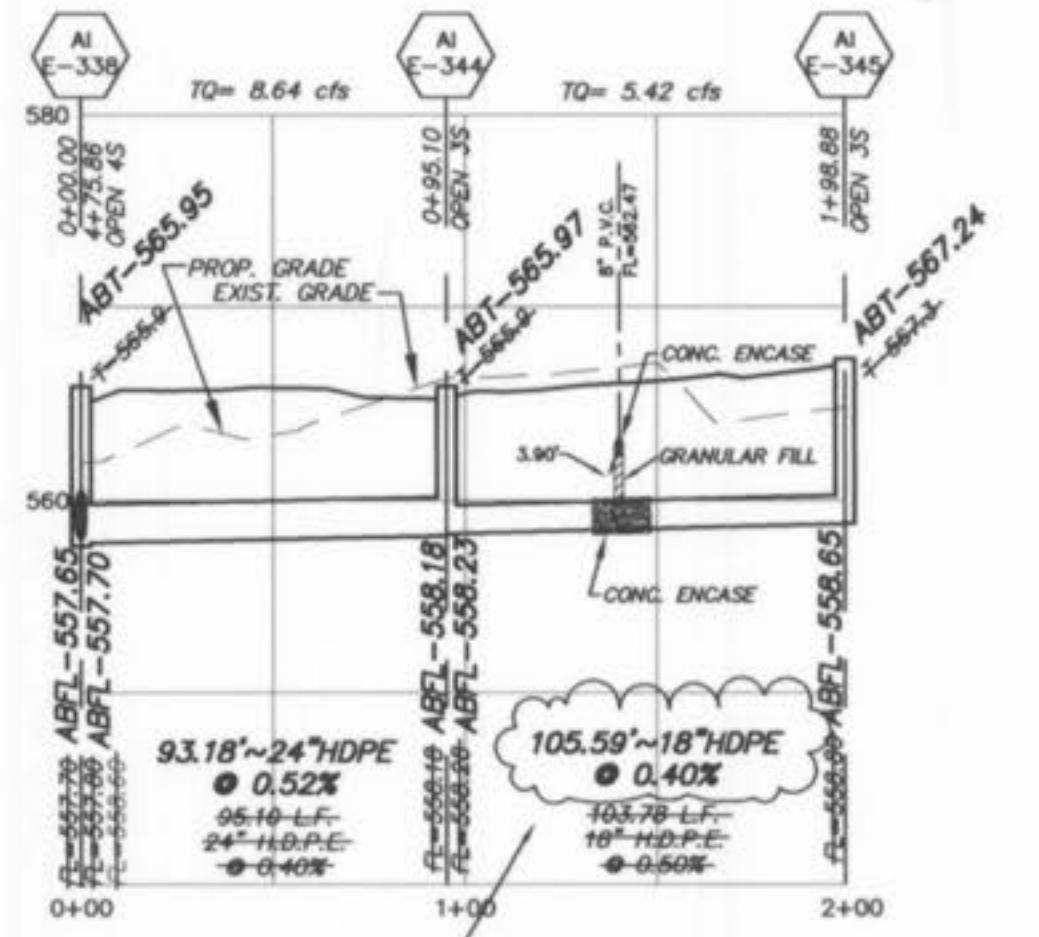

See as-built hydraulics on this sheet.

"AS-BUILTS"  
VILLAGE E-1  
02/06/06

**PICKETT RAY & SILVER**  
CIVIL ENGINEERS  
PLANNERS  
LAND SURVEYORS  
333 Mid Rivers Mall Drive  
St. Peters, MO 63376  
Phone (636) 397-1211  
Fax (636) 397-1104

**WYNDGATE VILLAGE E**  
STORM SEWER PROFILES  
Prepared For:  
**SUMMIT POINTE, L.C.**

REVISIONS

NO.	DATE	REVISION
1	10/25/04	REVISED PER CITY
2	12/09/04	REVISED PER PWD No. 2
3	12/20/04	REVISED PER DCSD
4	01/20/05	REVISED PER PWD No. 2
5	02/15/05	REVISED PER CITY OF O'FALLON
6	04/08/05	REVISED PER CITY AND CLIENT
7	02/18/05	MISC. CORRECTIONS
8	02/06/06	"AS-BUILTS" VILLAGE E-1
9	06/13/06	"AS-BUILTS" HYD CALCS ADDED

**ENGINEERS AUTHENTICATION**  
The responsibility for professional engineering liability on this project is hereby limited to the set of plans authenticated by the seal, signature, and date hereunder attached. Responsibility is disclaimed for all other engineering plans involved in this project and specifically excludes revisions after this date unless reauthenticated.  
PICKETT, RAY & SILVER, INC

DRAWN	DATE
JEF	6-29-04
CHECKED	DATE
DWD	6-29-04
PROJECT #	01267-SUPD.02R
TASK #	2
FIELD	BOOK

WYNDGATE VILLAGE E  
STORM SEWER PROFILES  
SHEET 113E OF 174  
© Copyright 2004 by Pickett, Ray & Silver, Inc.






HORIZONTAL SCALE: 1"=50'  
VERTICAL SCALE: 1"=10'

ALL SANITARY LATERAL STREET CROSSINGS, IF TRENCHED, SHALL BE BACKFILLED WITH GRANULAR MATERIAL (AGGREGATE).

IF THE STORM AND SANITARY SEWERS ARE PARALLEL AND IN THE SAME TRENCH OR OVERDRI, THE UPPER SHALL BE PLACED ON A SHELF AND THE LOWER SHALL BE BEDDED IN COMPACTED GRANULAR FILL TO THE FLOW LINE OF THE UPPER.

STORM SEWERS WHICH CROSS OVER EXISTING OR PROPOSED SANITARY SEWER TRENCHES SHALL BE CRADLED IN CONCRETE (OR ENCASED H.D.P.E.) THROUGH THE FULL WIDTH OF THE SANITARY SEWER TRENCH. THE TRENCH SHALL BE BACKFILLED AND COMPACTED GRANULAR FILL TO THE BOTTOM OF THE CONCRETE CRADLE.

**"AS-BUILTS"**  
 VILLAGE E-1  
 02/06/06

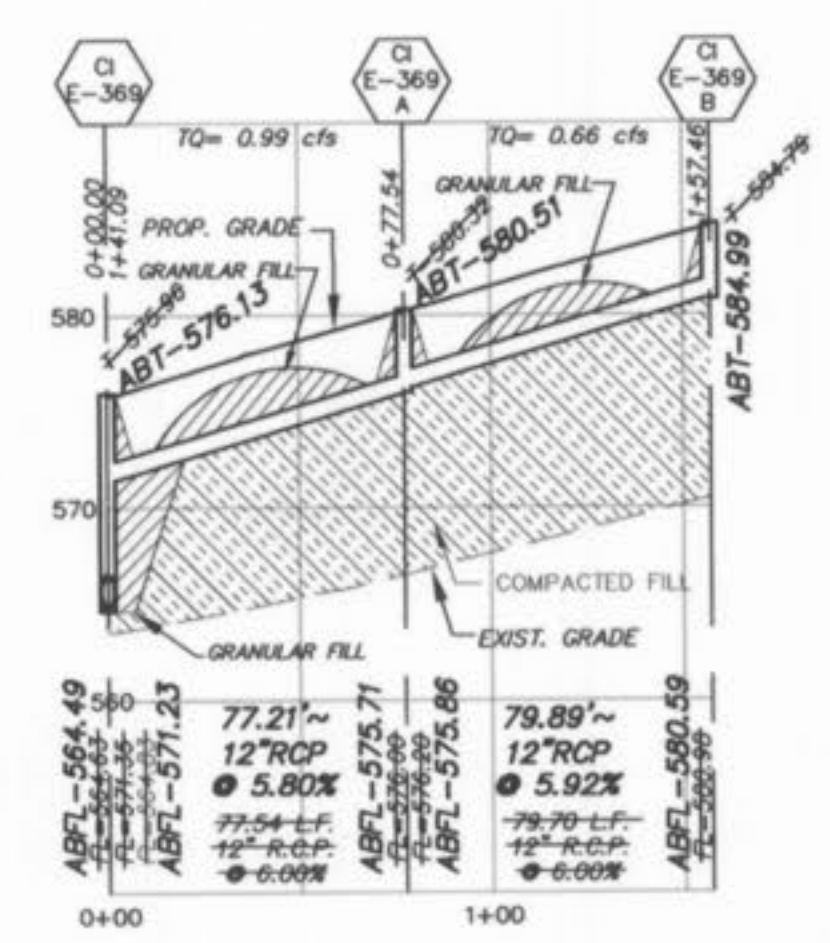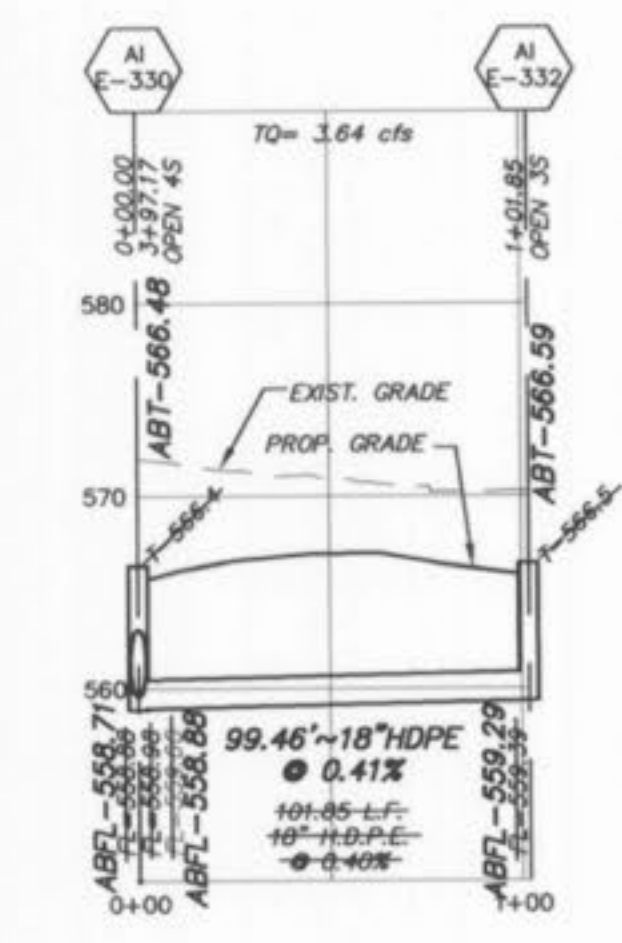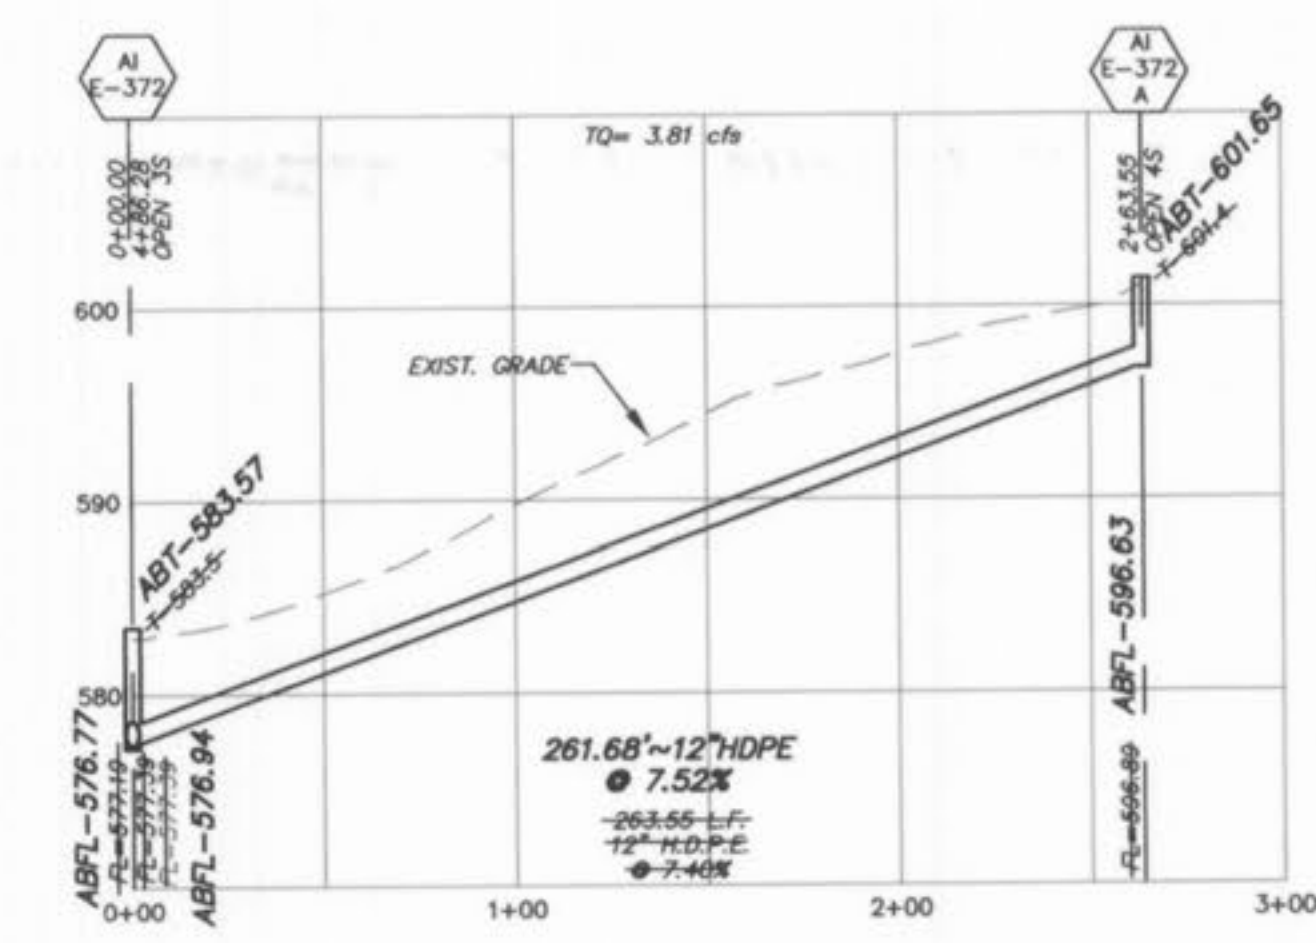

NO.	DATE	REVISIONS
1	10/25/04	REVISED PER CITY
2	12/09/04	REVISED PER PWSD No. 2
3	12/20/04	REVISED PER DCS
4	01/20/05	REVISED PER PWSD No. 2
5	02/18/05	REVISED PER CITY OF FALLON
6	04/08/05	REVISED PER CITY AND CLIENT
7	04/15/05	REVISED PER CITY
8	04/15/05	REVISED PER CITY
9	04/15/05	REVISED PER CITY
10	04/15/05	REVISED PER CITY
11	02/06/06	"AS-BUILTS" VILLAGE E-1

**ENGINEERS AUTHENTICATION**  
 The responsibility for professional engineering liability on this project is hereby limited to the set of plans authenticated by the seal, signature, and date hereunder attached. Responsibility is disclaimed for all other engineering plans involved in this project and specifically excludes revisions after this date unless reauthenticated.  
**PICKETT, RAY & SILVER, INC**

DRAWN JEE	DATE 6-29-04
CHECKED DWD	DATE 6-29-04
PROJECT # 01267-SUP0.02R	TASK # 2 FIELD BOOK

WYNDGATE  
 VILLAGE E  
 STORM SEWER PROFILES  
 SHEET 114E OF 174  
 Copyright 2004 by Pickett, Ray & Silver Inc.

ALL SANITARY LATERAL STREET CROSSINGS, IF TRENCHED, SHALL BE BACKFILLED WITH GRANULAR MATERIAL (AGGREGATE).

IF THE STORM AND SANITARY SEWERS ARE PARALLEL AND IN THE SAME TRENCH OR OVERDRI, THE UPPER SHALL BE PLACED ON A SHELVE AND THE LOWER SHALL BE BEDDED IN COMPACTED GRANULAR FILL TO THE FLOW LINE OF THE UPPER.

STORM SEWERS WHICH CROSS OVER EXISTING OR PROPOSED SANITARY SEWER TRENCHES SHALL BE CRADLED IN CONCRETE (OR ENCASED H.D.P.E.) THROUGH THE FULL WIDTH OF THE SANITARY SEWER TRENCH. THE TRENCH SHALL BE BACKFILLED AND COMPACTED GRANULAR FILL TO THE BOTTOM OF THE CONCRETE CRADLE.

HORIZONTAL SCALE: 1"=50'  
 VERTICAL SCALE: 1"=10'

