

SITE DEVELOPMENT NOTES

- LOT DATA 794 LOTS
 - VILLAGE A (R-1)
 - 165 LOTS (SINGLE FAMILY DETACHED COTTAGES)
 - BUILDING LINE SETBACK 25'
 - SIDE YARD SETBACK 6'
 - REAR YARD SETBACK 15'
 - MINIMUM LOT WIDTH 35'
 - MINIMUM LOT SIZE - 3,850 SQ.FT.
 - AVERAGE LOT SIZE - 5,841 SQ.FT.
 - (EXCLUDES R.O.W. & COMMON GROUND)
 - SMALLEST LOT SIZE SHOWN - 4,088 SQ.FT.
 - VILLAGE B (R-1)
 - 215 LOTS (SINGLE FAMILY)
 - BUILDING LINE SETBACK 25'
 - SIDE YARD SETBACK 6'
 - REAR YARD SETBACK 15'
 - MINIMUM LOT WIDTH - 52'
 - MINIMUM LOT SIZE - 5,720 SQ.FT.
 - AVERAGE LOT SIZE - 8,368 SQ.FT.
 - (EXCLUDES R.O.W. & COMMON GROUND)
 - SMALLEST LOT SIZE SHOWN - 6,300 SQ.FT.
 - VILLAGE C (R-1)
 - 117 LOTS (SINGLE FAMILY)
 - BUILDING LINE SETBACK - 25'
 - SIDE YARD SETBACK - 6'
 - REAR YARD SETBACK 15'
 - MINIMUM LOT WIDTH - 62'
 - MINIMUM LOT SIZE - 6,820 SQ.FT.
 - AVERAGE LOT SIZE - 10,496 SQ.FT.
 - (EXCLUDES R.O.W. & COMMON GROUND)
 - SMALLEST LOT SIZE SHOWN - 7,035 SQ.FT.
 - VILLAGE D (R-1)
 - 114 LOTS (SINGLE FAMILY)
 - BUILDING LINE SETBACK - 25'
 - SIDE YARD SETBACK - 6'
 - REAR YARD SETBACK 15'
 - MINIMUM LOT WIDTH - 72'
 - MINIMUM LOT SIZE - 8,640 SQ.FT.
 - AVERAGE LOT SIZE - 14,313 SQ.FT.
 - (EXCLUDES R.O.W. & COMMON GROUND)
 - SMALLEST LOT SIZE SHOWN - 8,700 SQ.FT.
 - VILLAGE E (R-1)
 - 102 LOTS (SINGLE FAMILY)
 - BUILDING LINE SETBACK - 25'
 - SIDE YARD SETBACK - 6'
 - REAR YARD SETBACK 15'
 - MINIMUM LOT WIDTH - 85'
 - MINIMUM LOT SIZE - 10,625 SQ.FT.
 - AVERAGE LOT SIZE - 20,384 SQ.FT.
 - (EXCLUDES R.O.W. & COMMON GROUND)
 - SMALLEST LOT SIZE SHOWN - 10,625 SQ.FT.
 - VILLAGE F (R-1)
 - 81 LOTS (SINGLE FAMILY)
 - BUILDING LINE SETBACK - 25'
 - SIDE YARD SETBACK - 6'
 - REAR YARD SETBACK 15'
 - MINIMUM LOT WIDTH - 100'
 - MINIMUM LOT SIZE - 15,000 SQ.FT.
 - AVERAGE LOT SIZE - 32,128 SQ.FT.
 - (EXCLUDES R.O.W. & COMMON GROUND)
 - SMALLEST LOT SIZE SHOWN - 15,000 SQ.FT.
- AMENITIES
 - SWIMMING POOL
 - BATH HOUSE
 - 2 - SPORTS COURTS 60'x120' MIN.
 - 3 - PAVILIONS 30'x30' W/ BBQ GRILLS & TABLES
 - 3 - HORSESHOES PIT AREAS
 - 3 - TOT/LOT PLAYGROUNDS (AGES 2 - 5)
 - 1 - FOOTBRIDGE AND PEDESTRIAN TRAILS
 - BIKE RACKS AT ALL PAVILION & SPORTS COURTS
- THIS TRACT IS IN AND SERVED BY -
 - DUCKETT CREEK SANITARY DISTRICT
 - PUBLIC WATER SUPPLY DISTRICT NO. 2 OF ST. CHARLES COUNTY
 - QUIVRE RIVER ELECTRIC COOPERATIVE
 - CENTURY TEL
 - ST. CHARLES GAS CO.
 - WENTZVILLE FIRE PROTECTION DISTRICT & NEW MELLE FIRE PROTECTION DISTRICT
 - WENTZVILLE SCHOOL DISTRICT
 - O'FALLON POST OFFICE
- STREETS SHALL BE BUILT PER CITY OF O'FALLON SPECIFICATIONS
- ALL DRIVEWAYS SHALL ACCESS INTERIOR STREETS WITH THE EXCEPTION OF THE FOUR CUSTOM LOTS THAT ACCESS DIEHR ROAD.
- GRADING SHALL BE PER CITY OF O'FALLON STANDARDS
- STREET TREES, LANDSCAPING, STREET LIGHTS AND SIDEWALKS SHALL BE PER CITY OF O'FALLON STANDARDS
- UNDERGROUND FACILITY STRUCTURES AND UTILITIES HAVE BEEN PLOTTED FROM AVAILABLE SURVEYS AND RECORDED INFORMATION AND, THEREFORE, THEIR LOCATIONS MUST BE CONSIDERED APPROXIMATE ONLY. VERIFICATION OF LOCATION OF ALL UNDERGROUND STRUCTURES AND FACILITIES EITHER SHOWN OR NOT SHOWN ON THESE PLANS, SHALL BE THE RESPONSIBILITY OF THE CONTRACTOR.
- THE TOPOGRAPHIC SURVEY IS FROM FIRM DATUM
- THIS PROJECT IS IN COMPLIANCE WITH ARTICLE 26 OF THE CITY OF O'FALLON ZONING CODE.
- ALL SIDEWALKS AND TRAILS SHALL BE 4' WIDE MINIMUM.
- THIS PLAT IS NOT FOR RECORD
- A PORTION OF THIS SITE IS IN THE 100 YEAR FLOOD AS SHOWN ON FIRM MAP PANEL NUMBERS 2918302215E & 2918302220E, DATED MARCH 17, 2003 AND FIRM MAP PANEL NUMBERS 291830405E & 2918304100E DATED AUGUST 2, 1996.
- WETLAND EVALUATIONS HAVE BEEN DETERMINED AND SHALL BE FORWARDED TO THE CITY.
- PROPOSED LIGHT STANDARDS SHALL BE 16' TALL.
- THE PROPOSED UTILITIES AND SEWERS SHALL BE COVERED BY EASEMENTS GRANTED TO THE APPROPRIATE UTILITY COMPANIES AND MUNICIPALITIES.
- COVENANTS & RESTRICTIONS WILL BE SIMILAR TO HOMEFIELD. (Book 2333, Page 79 Amended Book 2474, Page 1951)
- THE DEVELOPER SHALL OBTAIN ALL NECESSARY PERMITS AND APPROVALS FROM THE DEPT. OF NATURAL RESOURCES AND THE ARMY CORPS OF ENGINEERS PRIOR TO DEVELOPMENT.
- ALL ENTRANCE MONUMENTS AND LOCATIONS MUST BE APPROVED SEPARATELY IN ACCORDANCE WITH THE CITY'S SIGN CODE.
- THE DEVELOPER WILL PROVIDE THE APPROPRIATE APPROVALS FROM DNR AND COE FOR THIS DEVELOPMENT'S IMPACT ON THE EXISTING CREEK.
- NO PORTION OF THE DWELLINGS, INCLUDING THE FOOTING AND ROOF OVERHANG, SHALL ENROACH INTO THE FIVE (5) FOOT SETBACK/EASEMENT IN ORDER TO MEET BUILDING AND FIRE DEPARTMENT REQUIREMENTS.
- A SEPARATE SITE PLAN SUBMITTAL WILL BE PROVIDED FOR THE COMMON GROUND AMENITIES SUCH AS BUILDING ELEVATIONS, LANDSCAPING, ETC.
- A 60' WIDE DRAINAGE EASEMENT IS TO BE CENTERED ALONG THE CENTERLINE OF THE EXISTING DRAINAGE DITCH AND WILL BE SHOWN ON THE RECORD PLAT. AREA WITHIN THIS EASEMENT IS TO REMAIN UNDISTURBED.
- UNLESS NOTED OTHERWISE, ALL EXISTING STRUCTURES AND IMPROVEMENTS ARE TO BE REMOVED.
- PRIOR TO THE ISSUANCE OF BUILDING PERMITS FOR MORE THAN 30% OF THE TOTAL UNITS, BUILDING PERMITS FOR ALL OF THE RECREATIONAL AMENITIES SHALL BE PULLED. PRIOR TO THE ISSUANCE OF BUILDING PERMITS FOR 40% OF THE TOTAL UNITS, ALL RECREATIONAL AMENITIES SHALL BE OPEN FOR USE.
- ADDITIONAL RIGHT OF WAY IS BEING DEDICATED TO PROVIDE THE EXISTING DIEHR ROAD WITH A R.O.W. WIDTH OF 80'.
- ENTRANCE AND ALL IMPROVEMENTS WITHIN HIGHWAY N RIGHT-OF-WAY (INCLUDING ANY ADDITIONAL R.O.W. DEDICATION REQUIRED) WILL BE COORDINATED WITH AND APPROVED BY MODOT. A 10' WIDE UTILITY EASEMENT SHALL BE PROVIDED ALONG DEDICATED HIGHWAY N ROW.
- AN INTERNAL STREET LOOP WILL BE PROVIDED WITH THE FIRST PHASE OF DEVELOPMENT FOR BUS TRAFFIC.
- PROPOSED PEDESTRIAN FOOTBRIDGE DETAIL WILL BE PROVIDED WITH COMMON GROUND & AMENITIES PLANS
- THIS DEVELOPMENT WILL PROVIDE A STORM WATER SYSTEM THAT INSURES THAT THE RATE OF FLOW OF STORM WATER RUNOFF DISCHARGE FROM THE SITE AFTER DEVELOPMENT DOES NOT EXCEED THE RATE OF FLOW OF STORM WATER RUNOFF DISCHARGED FROM THE SITE FOR THE DESIGNATED STORM EVENT BEFORE DEVELOPMENT.
- FENCING ALONG THE REAR OF LOTS ADJACENT TO THE COLLECTOR AND ARTERIAL RIGHTS-OF-WAY SHALL BE WHITE-VINYL FENCE REGULATED BY THE CO&R'S OF THE SUBDIVISION
- STREETS "WYNDGATE RIDGE DRIVE" AND "PAUL RENAUD BLVD." ARE TO HAVE STREET TREES PLANTED AT A SPACING OF 30'-6" FROM CENTER TO CENTER. ALL LOTS BACKING STREETS "WYNDGATE RIDGE DRIVE" AND "PAUL RENAUD BLVD." ARE TO BE LIMITED TO ONE FENCE STYLE DESIGNATED BY THE HOMEOWNERS ASSOCIATION.
- AS PART OF THE SALES CONTRACTS FOR LOTS WITH FLOODWAY AND UNDISTURBED DRAINAGE EASEMENTS ON THEM, THE PURCHASER MUST SIGN AN ACKNOWLEDGEMENT STATING THAT MAINTENANCE OF THAT UNDISTURBED AREA, DRAINAGE WAY AND/OR CREEK WILL BE THE HOME OWNER'S RESPONSIBILITY (LOTS 749, 760, 761, 778, 780, 781, & 782).
- A 10' WIDE NO-GRADE ZONE SHALL BE MAINTAINED BETWEEN VILLAGE A AND ADJACENT LOTS TO THE WEST. ANY EXISTING TREES DESTROYED IN THIS BUFFER SHALL BE REPLACED WITH A THREE (3) INCH CALIPER DECIDUOUS TREE.
- ALL AMENITIES SHALL BE HANDICAPPED ACCESSIBLE WITH PROPER NUMBER OF PARKING SPACES PROVIDED.
- THE BIKE PATH ALONG HIGHWAY N SHALL BE CONSTRUCTED IN CONJUNCTION WITH THE SUBDIVISION CONSTRUCTION.
- STREETS "WYNDGATE RIDGE DRIVE" AND "PAUL RENAUD BLVD." SHALL BE DESIGNED TO MEET OR EXCEED CITY OF O'FALLON COLLECTOR ROAD STANDARDS AND SPECIFICATIONS. THE DESIGN SPEED FOR STREET "PAUL RENAUD BLVD." SHALL BE 35 M.P.H. AND THE POSTED SPEED SHALL BE 30 M.P.H.

POOL / BATHHOUSE PARKING CALCULATIONS

1 PARKING SPACE / 10 UNITS
794 LOTS = 80 PARKING SPACES REQUIRED
= 83 PARKING SPACES PROVIDED

TREE PRESERVATION

Existing trees = 256.6 Acres
Trees Saved = 141.2 Acres = 55% of trees saved
Per ordinance, no trees need to be replaced.

STREET TREES

1 tree shall be provided for every lot street frontage. (corner lots shall require additional trees for each street adjoining it.)

794 lots	= 794 trees
Corner lots fronting two streets	= 113 additional trees
Corner lots fronting three streets	= 1 additional trees
Collector Road trees (30' spacing)	= 375 additional trees
Total trees required	= 1284 trees

REVEGETATION SCHEDULE

Seeding Rates:

Permanent:

Tall Fescue - 30 lbs./ac.
Smooth Brome - 20 lbs./ac.
Combined: Fescue @ 15 lbs./ac. gdt Brome @ 10 lbs./ac.

Temporary:

Wheat or Rye - 150 lbs./ac. (3.5 lbs per square foot)
Oats - 120 lbs./ac. (2.7 lbs per square foot)

Seeding Periods:

Fescue or Brome - March 1 to June 1
August 1 to October 1

Wheat or Rye - March 15 to November 1
Oats - March 15 to September 15

Mulch rates: 100 lbs. per 1,000 sq ft (4,356 lbs. per acre)

Fertilizer rates: Nitrogen 30 lbs./ac.
Phosphate 30 lbs./ac.
Potassium 30 lbs./ac.
Lime 600 lbs./ac. DMM*

*DMM = effective neutralizing material as per State evaluation of quarried roc.


- ALL 26' WIDE STREETS SHALL HAVE THE MINIMUM CENTERLINE RADIUS OF 150'.
- THE EXISTING LAKE SHALL REACH A MINIMUM DEPTH OF TEN (10) FEET AT THE TIME IT IS TURNED OVER TO THE HOMEOWNERS ASSOCIATION AT THE END OF CONSTRUCTION.
- HANDICAPPED ACCESSIBLE PARKING SPACES HAVE BEEN PROVIDED IN ACCORDANCE WITH ADA GUIDELINES.
- HANDICAPPED ACCESSIBLE PARKING SPACES REQUIRED PER CITY OF O'FALLON ZONING CODE ARTICLE XII, SECTION 401.475, 8a:
 - A. POOL/BATHHOUSE: 84 PARKING SPACES TOTAL
4 H.C. PARKING SPACES REQUIRED
4 H.C. PARKING SPACES PROVIDED
 - B. LAKESIDE AMENITIES: 16 PARKING SPACES TOTAL
1 H.C. PARKING SPACE REQUIRED
1 H.C. PARKING SPACE PROVIDED
- DRIVEWAY LOCATIONS SHALL NOT INTERFERE WITH THE SIDEWALK HANDICAP RAMPS
- ANY PROPOSED PAVILIONS OR PLAYGROUND AREAS WILL NEED A SEPARATE PERMIT FROM THE BUILDING DEPARTMENT
- FOR SEDIMENT AND SILTATION CONTROL MEASURES, SEE PREVIOUSLY APPROVED ROUGH GRADING PLANS
- ALL SIGN POST AND BACKS AND BRACE! ARMS SHALL BE PAINTED BLACK USING CARBOLINE RUSTBOND PENETRATING SEALER SO AND CARBOLINE 134B PAINT (OR EQUIVALENT AS APPROVED BY THE CITY AND MODOT).
- DEVELOPER TO PROVIDE CITY CONSTRUCTION INSPECTORS WITH SOIL REPORTS PRIOR TO OR DURING SITE SOIL TESTING.
- ALL SIGN LOCATIONS AND SIZES MUST BE APPROVED BY SEPARATELY THROUGH THE PLANNING DIVISION.
- NO BUILDING PERMITS WILL BE ISSUED FOR LOTS WITHIN THE EXISTING 100-YEAR FLOODPLAIN UNTIL THE CITY RECEIVES THE LOMR FROM FEMA.
- ALL UTILITIES SHALL BE UNDERGROUND
- A SOILS ENGINEER SHALL DETERMINE THE METHOD OF REVEGETATION OF AREAS DISTURBED BY CONSTRUCTION OF THE IMPROVEMENTS IN THESE PLANS IN THE DRAINAGE EASEMENT.
- ALL PAVING TO BE IN ACCORDANCE WITH ST. CHARLES COUNTY STANDARDS AND SPECIFICATIONS EXCEPT AS MODIFIED BY THE CITY OF O'FALLON ORDINANCES.
- DRIVEWAY LOCATIONS SHALL NOT INTERFERE WITH THE SIDEWALK HANDICAP RAMPS.
- SIDEWALKS, CURB RAMPS, RAMP AND ACCESSIBLE PARKING SPACES SHALL BE CONSTRUCTED IN ACCORDANCE WITH THE CURRENT APPROVED "AMERICAN WITH DISABILITIES ACT ACCESSIBILITY GUIDELINES" (ADAAG) ALONG WITH THE REQUIRED GRADES, CONSTRUCTION MATERIALS, SPECIFICATIONS AND SIGNAGE. IF ANY CONFLICT OCCURS BETWEEN THE ABOVE INFORMATION AND THE PLANS, THE ADAAG GUIDELINES SHALL TAKE PRECEDENCE AND THE CONTRACTOR PRIOR TO ANY CONSTRUCTION SHALL NOTIFY THE PROJECT ENGINEER.
- CITY APPROVAL OF THE CONSTRUCTION SITE PLANS DOES NOT MEAN THAT SINGLE FAMILY AND TWO FAMILY DWELLING UNITS CAN BE CONSTRUCTED ON THE LOTS WITHOUT MEETING THE BUILDING SETBACKS AS REQUIRED BY THE ZONING CODE.
- THE CONTRACTOR SHALL ASSUME COMPLETE RESPONSIBILITY FOR CONTROLLING ALL SILTATION AND EROSION OF THE PROJECT AREA. THE CONTRACTOR SHALL USE WHATEVER MEANS NECESSARY TO CONTROL EROSION AND SILTATION INCLUDING, BUT NOT LIMITED TO STAKED STRAW BALES AND/OR SILTATION FABRIC FENCES (POSSIBLE METHODS OF CONTROL ARE DETAILED IN THE PLAN). CONTROL SHALL COMMENCE WITH GRADING AND BE MAINTAINED THROUGHOUT THE PROJECT UNTIL ACCEPTANCE OF THE WORK BY THE OWNER AND/OR THE CITY OF O'FALLON AND/OR MODOT MAY AT THEIR OPTION DIRECT THE CONTRACTOR IN HIS METHODS AS DEEMED FIT TO PROTECT PROPERTY AND IMPROVEMENTS. ANY DEPOSITING OF SLT OR MUD ON NEW OR EXISTING PAVEMENT SHALL BE REMOVED IMMEDIATELY. ANY DEPOSITING OF SILTS OR MUD IN NEW OR EXISTING STORM SEWERS OR SWALES SHALL BE REMOVED AFTER EACH RAIN AND AFFECTED AREAS CLEANED TO THE SATISFACTION OF THE OWNER AND/OR THE CITY OF O'FALLON AND/OR MODOT.
- ALL FILL PLACED UNDER PROPOSED STORM AND SANITARY SEWER, PROPOSED ROADS, AND/OR PAVED AREAS SHALL BE COMPACTED TO 90% OF MAXIMUM DENSITY AS DETERMINED BY THE STANDARD PROCTOR TEST AASHTO T-99. ALL FILL PLACED IN PROPOSED ROADS SHALL BE COMPACTED FROM THE BOTTOM OF THE FILL UP. ALL TESTS SHALL BE VERIFIED BY A SOILS ENGINEER CONCURRENT WITH GRADING AND BACKFILLING OPERATIONS. ENSURE THE MOISTURE CONTENT OF THE SOIL IN FILL AREAS IS TO CORRESPOND TO THE COMPACTIVE EFFORT AS DEFINED BY THE STANDARD OR MODIFIED PROCTOR TEST. OPTIMAL MOISTURE CONTENT SHALL BE DETERMINED USING THE SAME TEST THAT WAS USED FOR COMPACTION. SOIL COMPACTON CURVES SHALL BE SUBMITTED TO THE CITY OF O'FALLON PRIOR TO THE PLACEMENT OF FILL. PROOF ROLLING MAY BE REQUIRED TO VERIFY SOIL STABILITY AT THE DISCRETION OF THE CITY OF O'FALLON.
- ENTIRE SITE IS STILL UNDER INVESTIGATION BY THE DEVELOPER'S SOILS CONSULTANT FOR SINKHOLES THAT MAY BE ON THE PROPERTY. THE NECESSARY REMEDIATION OF DISCOVERED SINKHOLES WILL BE ADDRESSED BY THE SOILS CONSULTANT OF A SEPARATE SET OF PLANS. THE FINAL RESULTS OF THE SITE INVESTIGATION AND REMEDIATION WILL BE PLACED IN THE CITY'S FILES FOR THIS DEVELOPMENT.
- COPIES OF THE DOCUMENTATION TO THE CORPS OF ENGINEERS FOR THE PRESERVED WETLANDS AREA AS SHOWN ON THE PLANS WILL BE SUPPLIED TO THE CITY WHEN PREPARED.
- ALL MONUMENTS AND FENCES ARE BY SEPARATE PERMIT.

AS-BUILT PLANS

Duckett Creek Sanitary District

Phase Six WYNDGATE IMPROVEMENT PLANS (794 LOTS)

TRACTS OF LAND BEING PART OF FRACTIONAL SECTIONS 16 & 17, AND U.S. SURVEYS 61 & 417, TOWNSHIP 46 NORTH, RANGE 2 EAST, ST. CHARLES COUNTY, MISSOURI

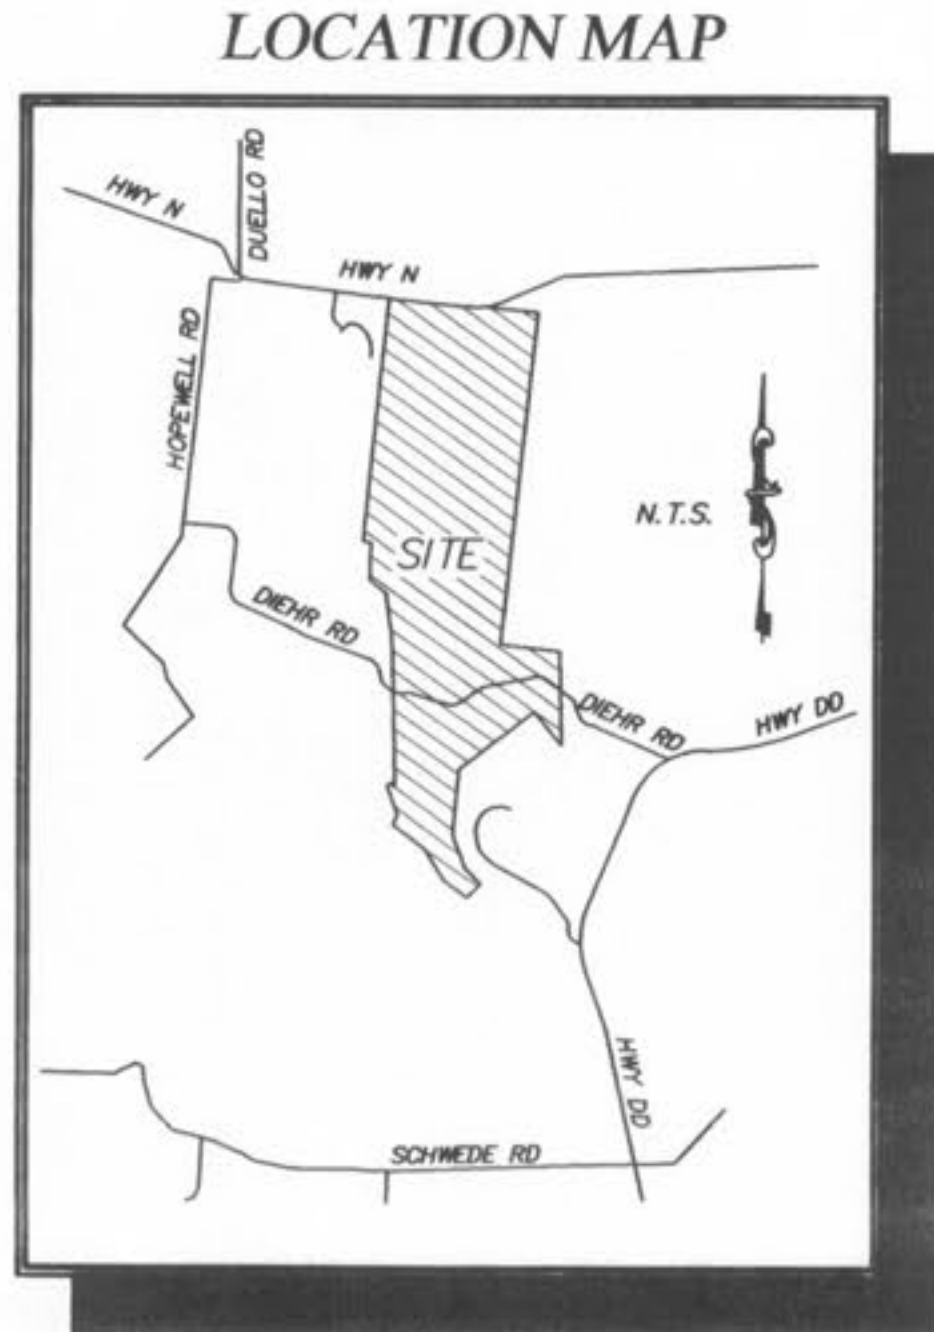

These "As-Built" Sanitary Sewer Plans are based on actual field measurements conducted during Feb. 2006 and the results are shown hereon.

By: *[Signature]* 2-3-06
JAMES R. GHERVEK P.L.S., #2211
STATE OF MISSOURI
PICKETT RAY & SILVER'S CORPORATE
REGISTRATION NO. LS-54-D

Call BEFORE you DIG
TOLL FREE
1-800-344-7483
MISSOURI ONE-CALL SYSTEM, INC.

MoDOT LOCATOR: 314-340-4100

PROJECT BENCH MARK
U.S.G.S BENCH MARK
At Dardenne T.46N., R.2E. Near Approx. Corner Sections 1, 2, 11 & 12, 31' north & 20' west of crossroads, 49' south of S.E. corner of Catholic Church, 2.0' north of sidewalk & in a concrete post standard toilet stamped "T" 60C 1936 616".
Elev. 616.50

LEGEND

	Sanitary Structure	R.C.P. Reinforced Concrete Pipe
	Storm Structure	C.M.P. Corrugated Metal Pipe
	Test Hole	C.I.P. Cast Iron Pipe
	Power Pole	P.V.C. Polyvinyl Chloride
	Light Standard	V.C.P. Vitrified Clay Pipe
	Double Water Meter Setting	C.O. Clean Out
	Single Water Meter Setting	V.T. Vent Trap
	C.I. Curb Inlet	T.B.R. To Be Removed
	S.C.I. Skewed Curb Inlet	T.B.R.R. To Be Removed & Re-routed
	D.C.I. Double Curb Inlet	T.B.P. To Be Protected
	G.I. Gate Inlet	T.B.A. To Be Abandoned
	A.I. Area Inlet	B.C. Base Of Curb
	D.A.I. Double Area Inlet	T.C. Top Of Curb
	C.C. Concrete Collar	T.W. Top Of Wall
	F.E.S. Flared End Section	B.W. Base Of Wall
	E.P. End Pipe	(TYP) Typical
	E.D. Energy Dissipator	U.N.O. Unless Noted Otherwise
	M.H. Manhole	U.L.P. Use In Place
	C.P. Concrete Pipe	Yield Sign
	S.A.S. Sinkhole Access Structure	

DRAWING INDEX

Sheet	Description
1	COVER SHEET
2	GENERAL NOTES & REVISION BLOCK
3	SITE MAP
4-8	EROSION CONTROL PLANS
9	EROSION DETAIL
10A	VILLAGE "A" COVER SHEET
11A-13A	VILLAGE "A" SITE PLAN
14A-16A	VILLAGE "A" GRADING PLAN
17A	VILLAGE "A" STREET PROFILES
18A-19A	VILLAGE "A" SANITARY SEWER PROFILES
20A-21A	VILLAGE "A" STORM SEWER PROFILES
22A-25A	VILLAGE "A" DRAINAGE AREA MAP
26A-28A	VILLAGE "A" WATER LAYOUT
29A	VILLAGE "A" DETENTION BASIN
30A	VILLAGE "A" FUTURE RECREATION AREA
31A	VILLAGE "A" LANDSCAPING PLAN
32B	VILLAGE "B" COVER SHEET
33B-35B	VILLAGE "B" SITE PLAN
36B-38B	VILLAGE "B" GRADING PLAN
39B-41B	VILLAGE "B" STREET PROFILES
42B-44B	VILLAGE "B" SANITARY SEWER PROFILES
45B-47B	VILLAGE "B" STORM SEWER PROFILES
48B-51B	VILLAGE "B" DRAINAGE AREA MAP
52B-54B	VILLAGE "B" WATER LAYOUT
55B	VILLAGE "B" FUTURE POOL SITE
56B	VILLAGE "B" FUTURE DAY CARE CENTER
57B	VILLAGE "B" LANDSCAPING PLAN
58C	VILLAGE "C" COVER SHEET
59C-60C	VILLAGE "C" SITE PLAN
61C-62C	VILLAGE "C" GRADING PLAN
63C-64C	VILLAGE "C" STREET PROFILES
65C-66C	VILLAGE "C" SANITARY SEWER PROFILES
67C-68C	VILLAGE "C" STORM SEWER PROFILES
69C-70C	VILLAGE "C" DRAINAGE AREA MAP
71C-72C	VILLAGE "C" WATER LAYOUT
73C	VILLAGE "C" LANDSCAPING PLAN
74D	VILLAGE "D" COVER SHEET
75D-77D	VILLAGE "D" SITE PLAN
78D-80D	VILLAGE "D" GRADING PLAN
81D-82D	VILLAGE "D" STREET PROFILES
83D-84D	VILLAGE "D" SANITARY SEWER PROFILES
85D-86D	VILLAGE "D" STORM SEWER PROFILES
87D-89D	VILLAGE "D" DRAINAGE AREA MAP
90D-92D	VILLAGE "D" WATER LAYOUT
93D	VILLAGE "D" RETAINING WALLS
94D	VILLAGE "D" LANDSCAPING PLAN
95E	VILLAGE "E" COVER SHEET
96E-99E	VILLAGE "E" SITE PLAN
100E-103E	VILLAGE "E" GRADING PLAN
104E-106E	VILLAGE "E" STREET PROFILES
107E	VILLAGE "E" DIEHR RD. ENTRANCE DETAIL
108E	VILLAGE "E" SIGHT DISTANCE EXHIBIT
109E-111E	VILLAGE "E" SANITARY SEWER PROFILES
112E-114E	VILLAGE "E" STORM SEWER PROFILES
115E-120E	VILLAGE "E" DRAINAGE AREA MAP
121E-124E	VILLAGE "E" WATER LAYOUT
125E-126E	VILLAGE "E" DETENTION BASIN
127E	VILLAGE "E" FUTURE RECREATION AREA
128E	VILLAGE "E" MBR LANDSCAPING PLAN
129E-130E	VILLAGE "E" LANDSCAPING PLAN
131F	VILLAGE "F" COVER SHEET
132F-136F	VILLAGE "F" SITE PLAN
137F-139F	VILLAGE "F" GRADING PLAN
140F-141F	VILLAGE "F" STREET PROFILES
142F-143F	VILLAGE "F" DIEHR RD. ENTRANCE DETAILS
144F-146F	VILLAGE "F" SANITARY SEWER PROFILES
147F	VILLAGE "F" LIFT STATION SITE PLAN
148F-149F	VILLAGE "F" LIFT STATION DETAILS
150F-151F	VILLAGE "F" STORM SEWER PROFILES
152F-154F	VILLAGE "F" DRAINAGE AREA MAP
155F-157F	VILLAGE "F" WATER LAYOUT
158F	VILLAGE "F" DETENTION BASIN
159F	VILLAGE "F" RETAINING WALLS
160F	VILLAGE "F" LANDSCAPING PLAN
161-164	TRAFFIC CONTROL PLANS
165-174B	GENERAL CONSTRUCTION DETAILS

PICKETT RAY & SILVER

333 Mid Rivers Mall Drive
St. Peters, MO 63376
Phone (636) 397-1211
Fax (636) 397-1104

**CIVIL ENGINEERS
PLANNERS
LAND SURVEYORS**

Duckett Creek Sanitary District
Phase Six
WYNDGATE IMPROVEMENT PLANS
COVER SHEET

239 FOX HILL ROAD
SUMMIT POINTE, MO. 63301
(636) 949-9300

Prepared For:
SUMMIT POINTE, L.C.

REVISIONS

NO.	DATE	REVISIONS	PER CITY
1	10/26/04	REVISED PER CITY	
2	12/09/04	REVISED PER PERM #2	
3	12/20/04	REVISED PER PERM #2	
4	01/20/05	REVISED PER PERM #2	
5	02/03/05	REVISED PER PERM #2	
6	02/18/05	REVISED PER PERM #2	
7	03/08/05	REVISED PER PERM #2	
8	03/25/05	REVISED PER PERM #2	
9	04/08/05	REVISED PER PERM #2	
10	04/13/05	REVISED PER PERM #2	

ENGINEERS AUTHENTICATION

The responsibility for professional engineering liability on this project is hereby limited to the set of plans authorized by the seal, signature, and date hereunder attached. Responsibility is disclaimed for all other engineering plans involved in this project and specifically includes revisions after this date unless reauthorized.

PICKETT, RAY & SILVER, INC.

DRAWN J.E.E. **DATE** 6-29-04
CHECKED D.W.D. **DATE** 6-29-04

PROJECT # 01267.SUP0.02R
TASK # 2 FIELD BOOK

**WYNDGATE - PHASE 1
COVER SHEET**






SHEET 1 OF 174

© Copyright 2004 by Pickett, Ray & Silver, Inc.

I:\server\projects\01267\FILES FROM TRILINGUES FOR DCSD\Phase 6\cover.dwg, 12/13/2006 9:50:32 AM, GARY MEYER

P & Z NO. 3203

\\server\Projects\01267\FILES FROM TRUGHES FOR DCSD\Phase 6\cover.dwg, 12/13/2006 10:57:18 AM, GARY MEYER

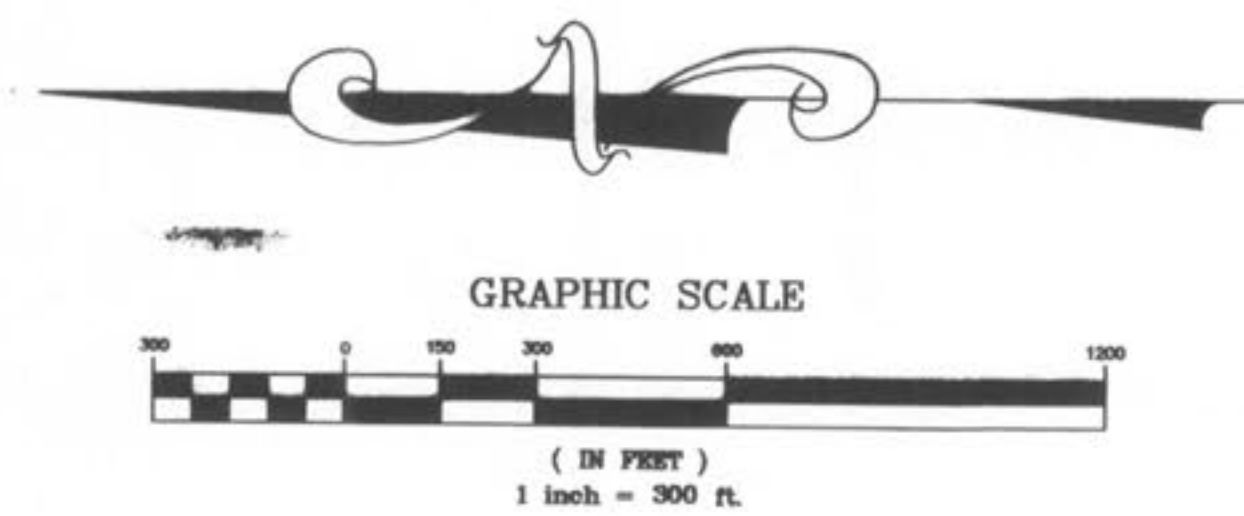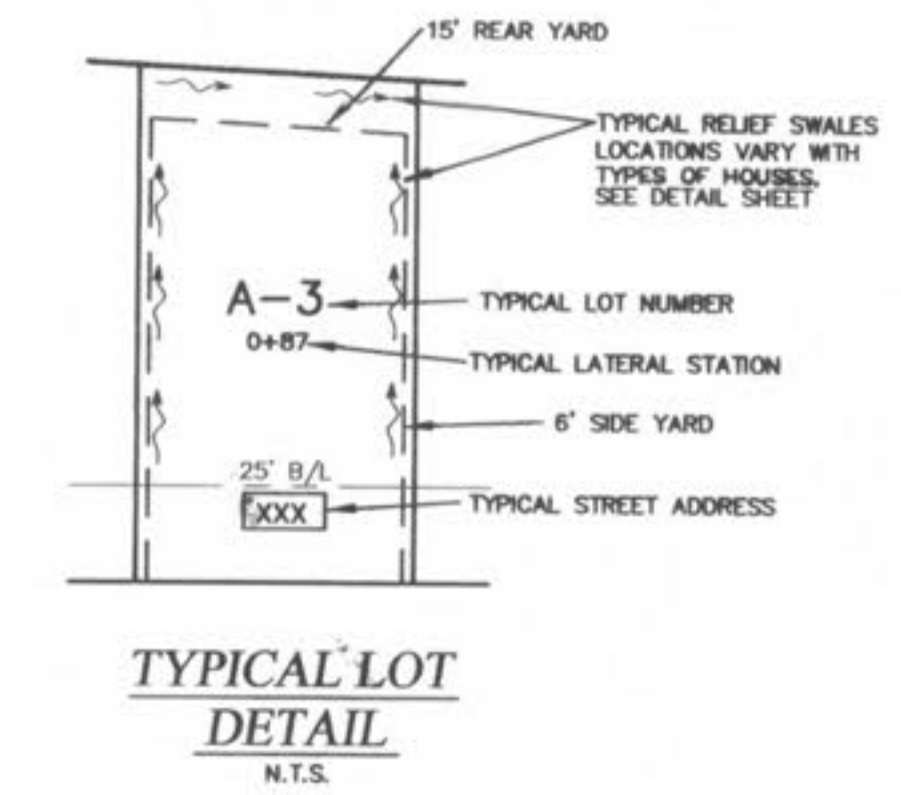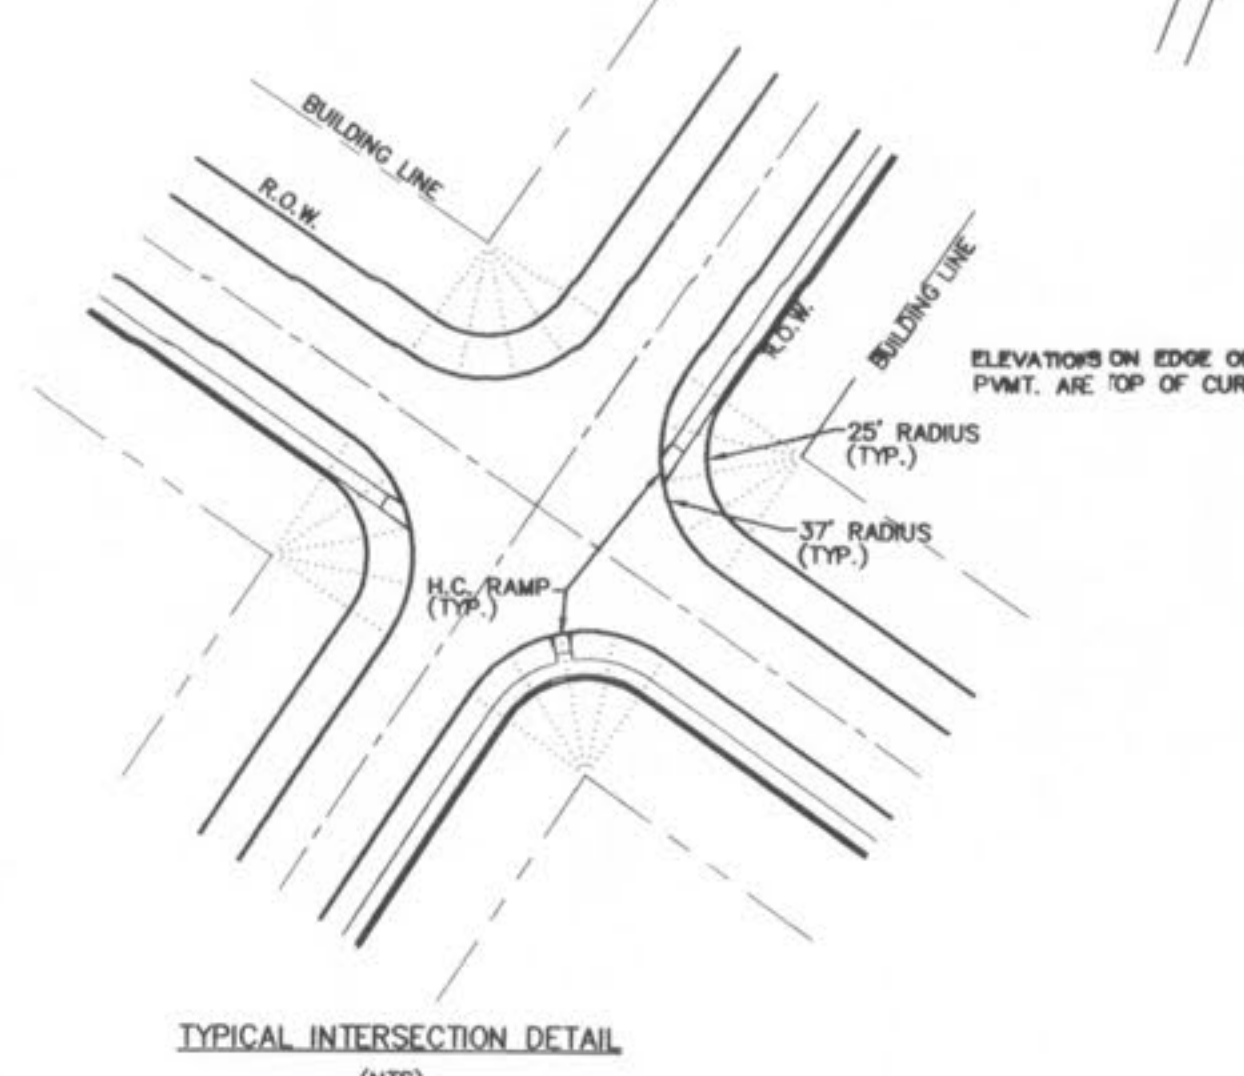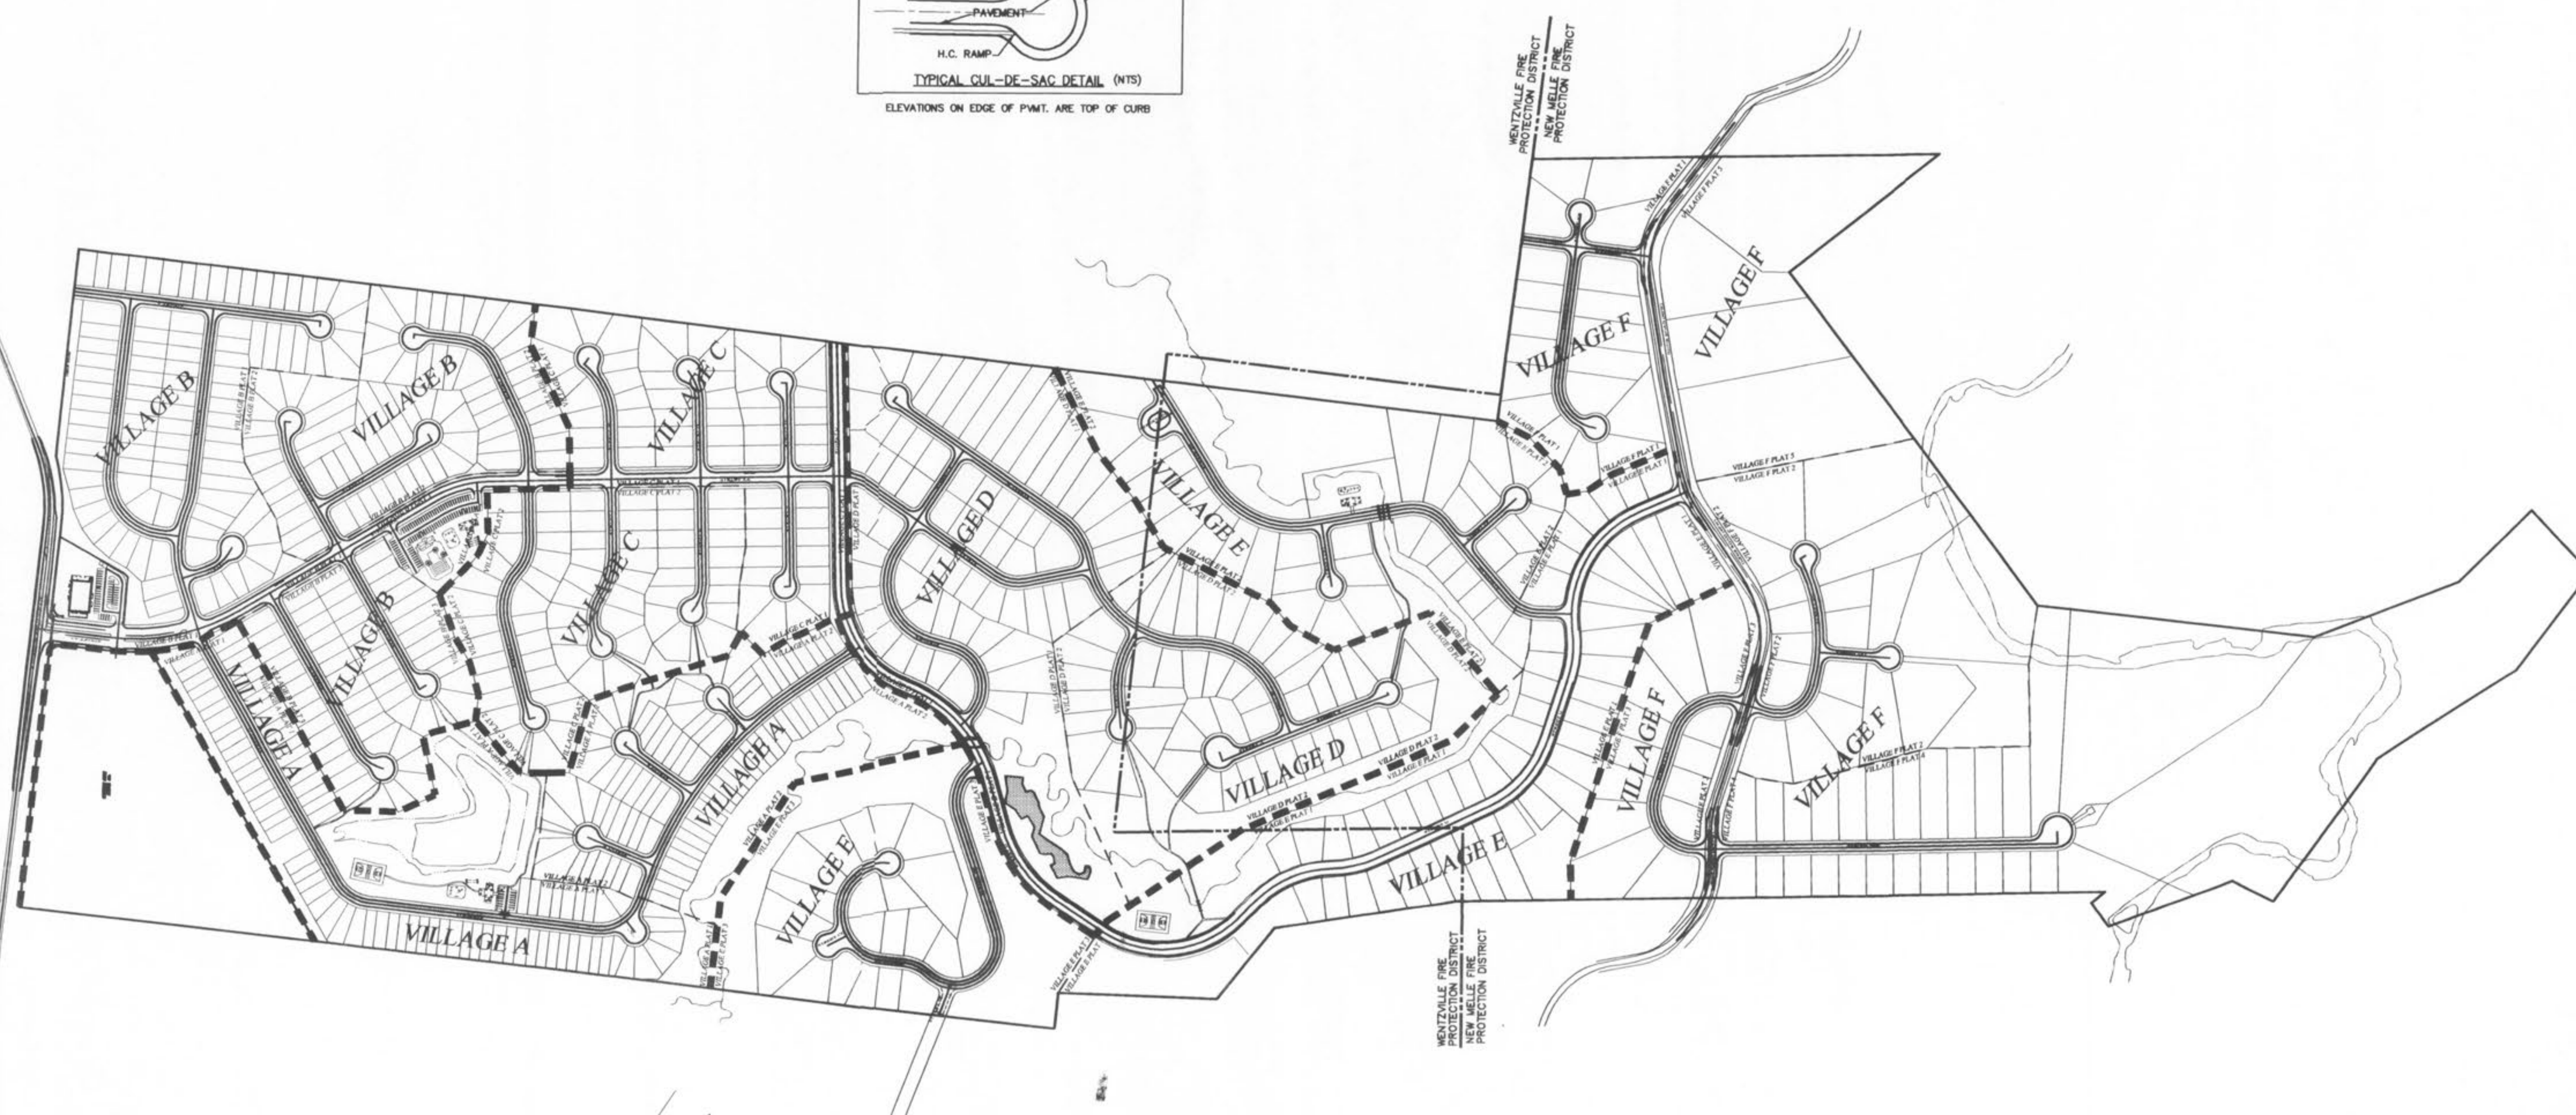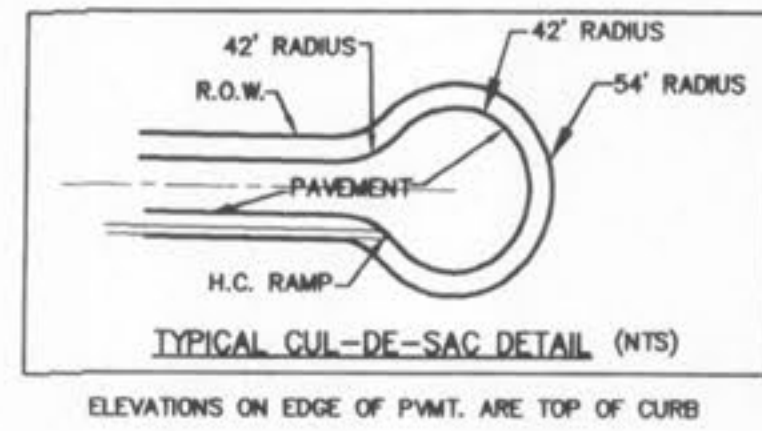

AS-BUILT PLANS

PICKETT RAY & SILVER
CIVIL ENGINEERS
PLANNERS
LAND SURVEYORS
333 Mid Rivers Mall Drive
St. Peters, MO 65376
Phone (636) 397-1211
Fax (636) 397-1104

**WYNDGATE
SITE MAP**
Prepared For:
SUMMIT POINTE, L.C.
239 FOX HILL ROAD
ST. CHARLES, MO. 63301
(636) 940-9300

REVISIONS	DATE	REVISED PER CITY
NO.		
1	10/25/04	REVISED PER CITY OF O'FALON
6	06/18/06	REVISED PER CITY OF O'FALON

ENGINEER'S AUTHORIZATION
The responsibility for professional engineering liability on this project is hereby limited to the set of plans authenticated by the seal, signature, and date hereunder attached. Responsibility is disclaimed for all other engineering plans involved in this project and specifically includes relations other than this date unless reauthenticated.
PICKETT, RAY & SILVER, INC.

DRAWN J.E.E.	DATE 6-29-04
CHECKED D.W.D.	DATE 6-29-04
PROJECT # 01267.SUPD.02R	TASK # 2 FIELD BOOK



WYNDGATE VILLAGE F - IMPROVEMENT PLANS

DRAWING INDEX

Sheet	Description
131F	VILLAGE "F" COVER SHEET
132F-136F	VILLAGE "F" SITE PLAN
137F-139F	VILLAGE "F" GRADING PLAN
140F-141F	VILLAGE "F" STREET PROFILES
142F-143F	VILLAGE "F" DIEHR RD. ENTRANCE DETAILS
144F-146F	VILLAGE "F" SANITARY SEWER PROFILES
147F	VILLAGE "F" LIFT STATION SITE PLAN
148F-149F	VILLAGE "F" LIFT STATION DETAILS
150F-151F	VILLAGE "F" STORM SEWER PROFILES
152F-154F	VILLAGE "F" DRAINAGE AREA MAP
155F-157F	VILLAGE "F" WATER LAYOUT
158F	VILLAGE "F" DETENTION BASIN
159F	VILLAGE "F" RETAINING WALLS
160F	VILLAGE "F" LANDSCAPING PLAN

REVISIONS		
NO.	DATE	DESCRIPTION
8	03/25/05	REVISED PER P.W.S.D #2
9	04/08/05	REVISED PER CITY OF O'FALLON & CLIENT



- (19 LOTS VILLAGE F PLAT 1)
- (18 LOTS VILLAGE F PLAT 2)
- (13 LOTS VILLAGE F PLAT 3)
- (27 LOTS VILLAGE F PLAT 4)
- (4 LOTS VILLAGE F PLAT 5)

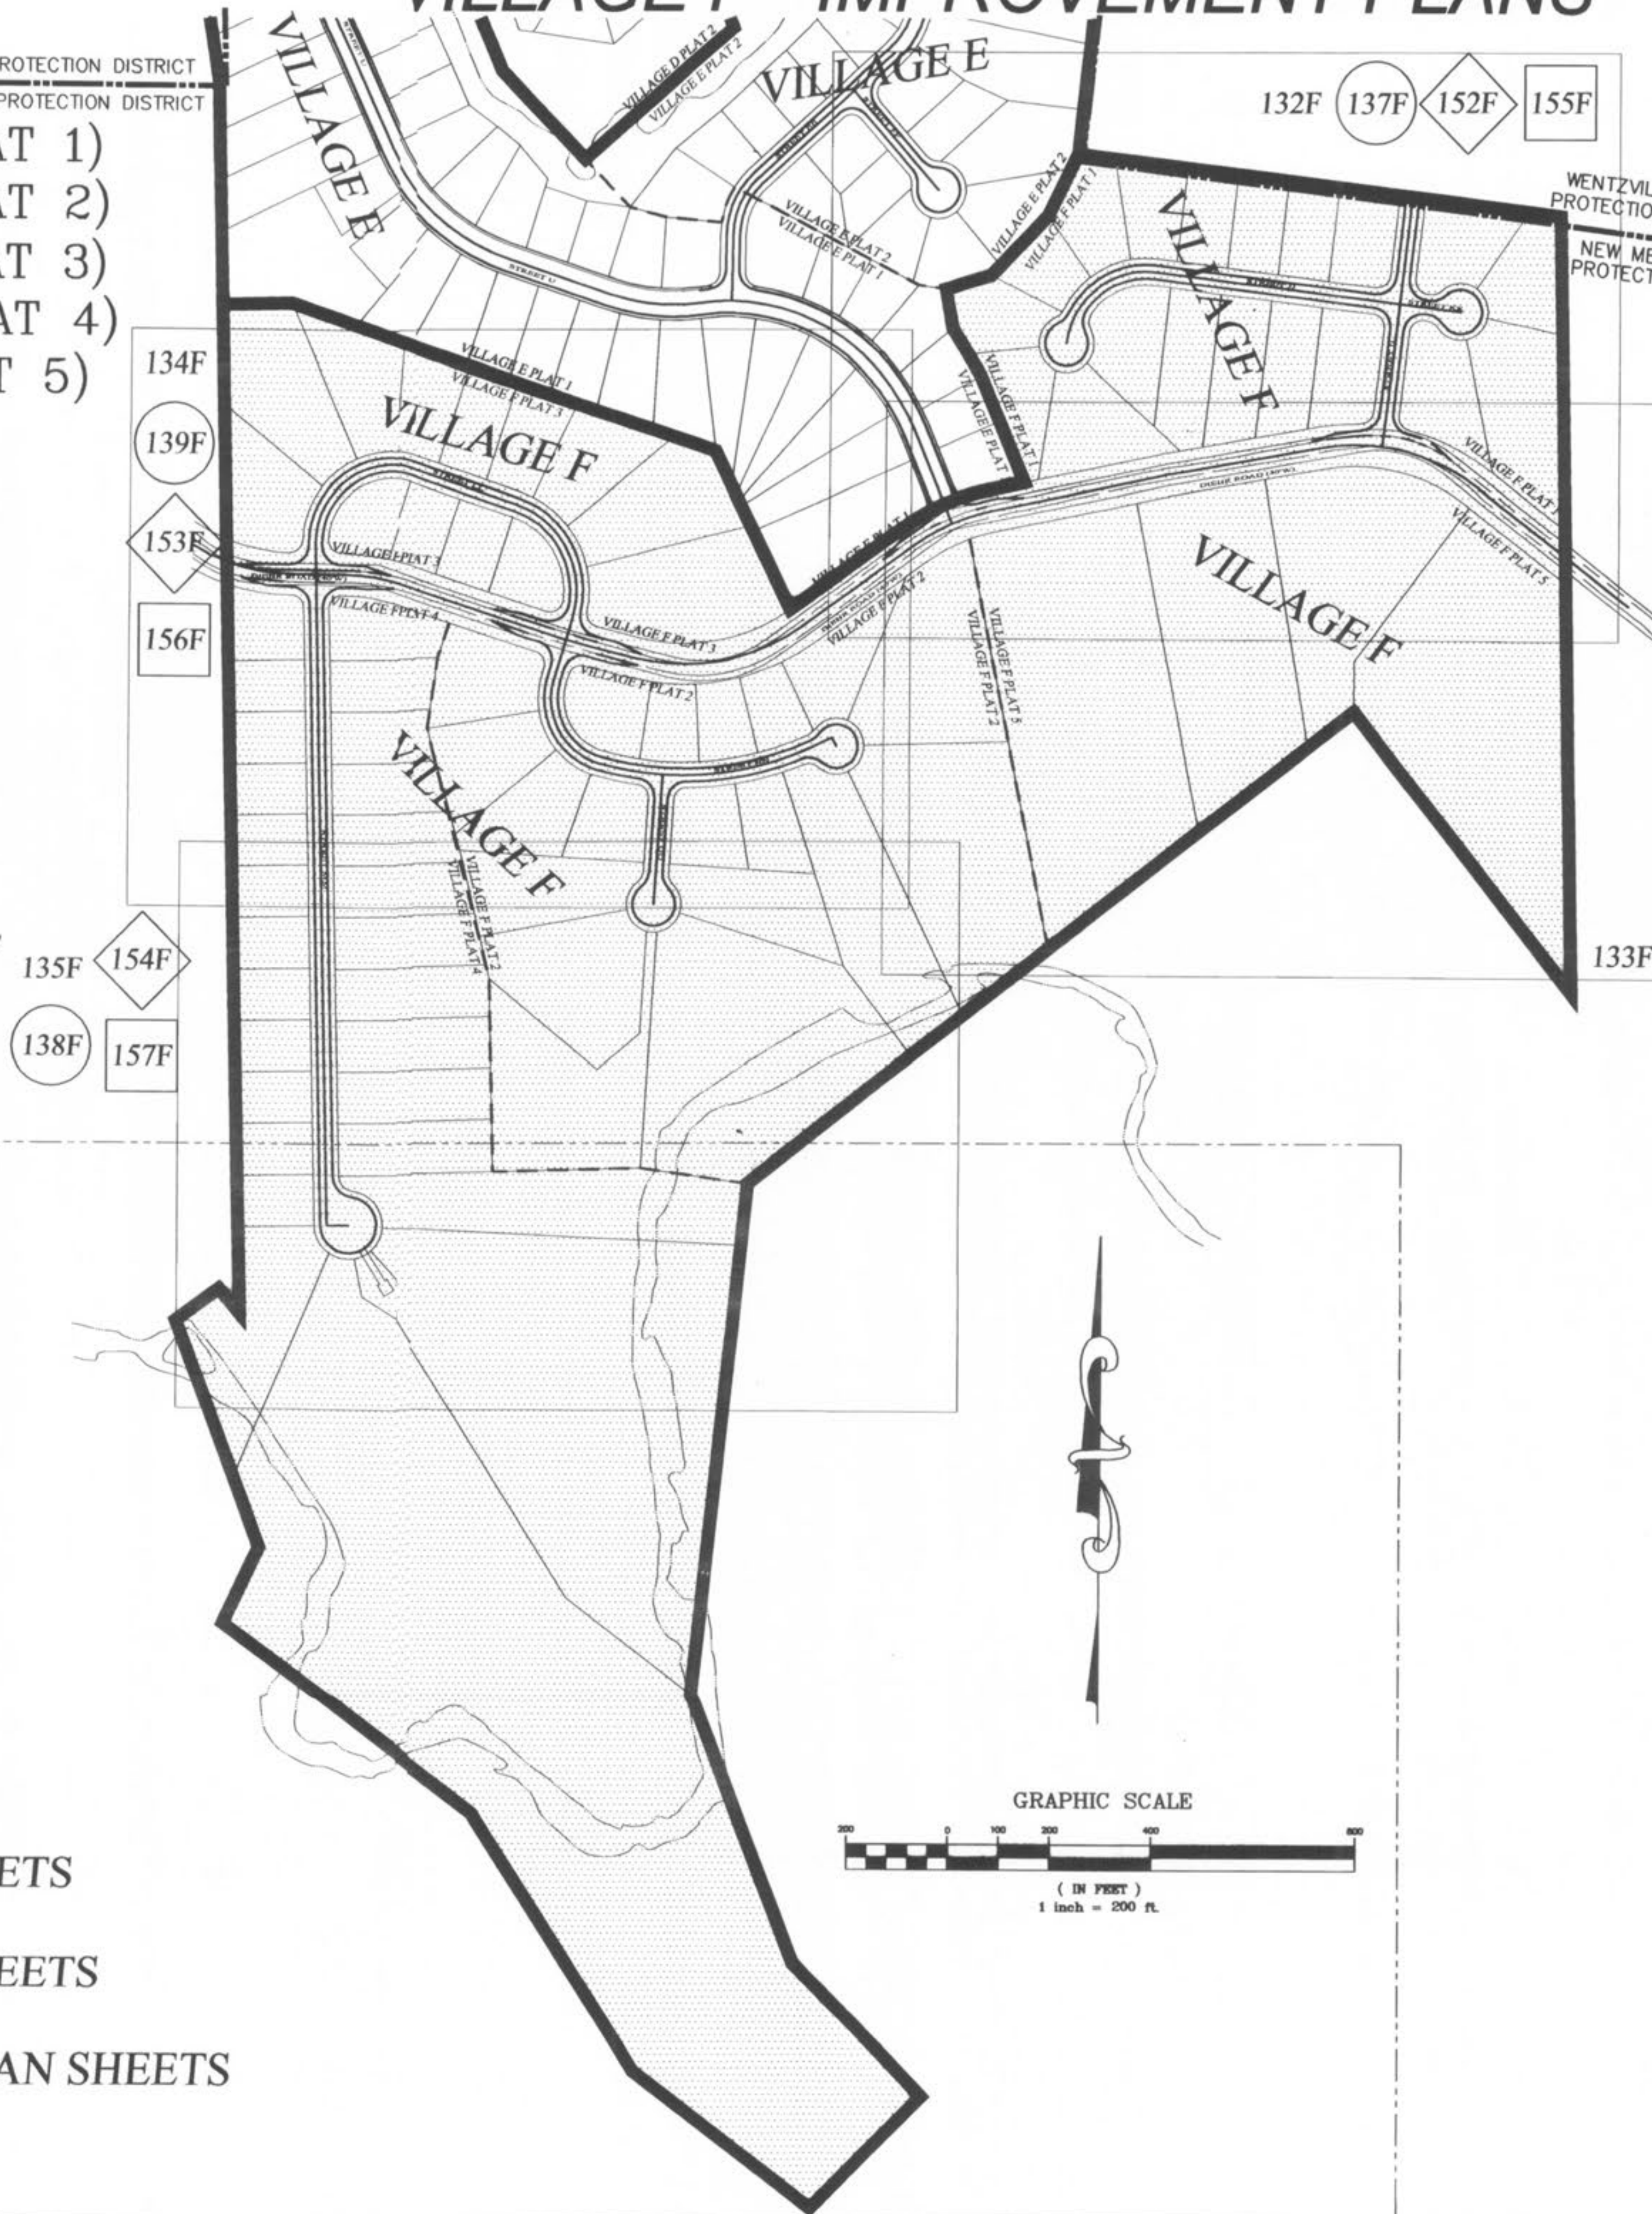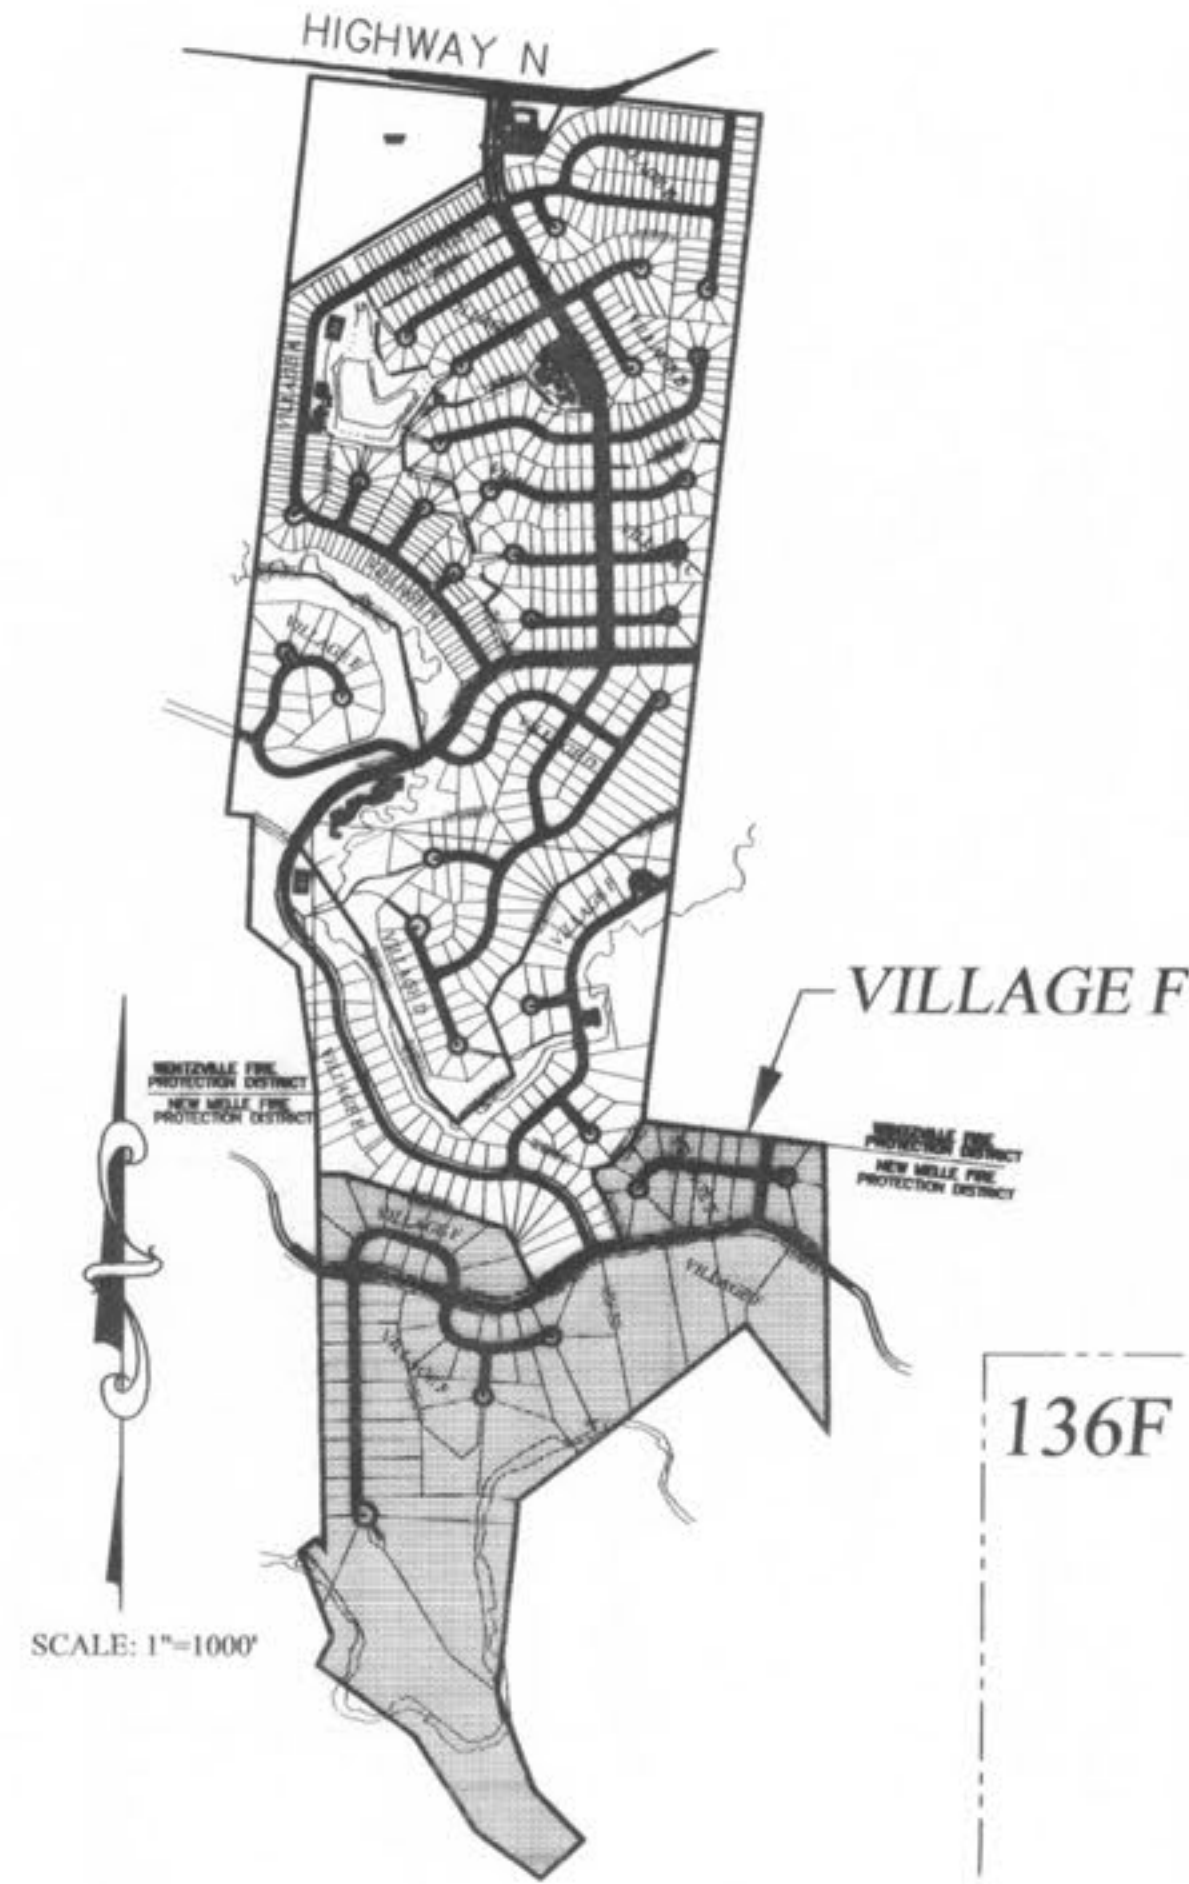

NOTE: ALL MONUMENTS AND FENCES ARE BY SEPARATE PERMIT.

NOTE:

- 132F SITE PLAN SHEETS
- 137F GRADING PLAN SHEETS
- 152F DRAINAGE PLAN SHEETS
- 155F WATER LAY-OUT PLAN SHEETS

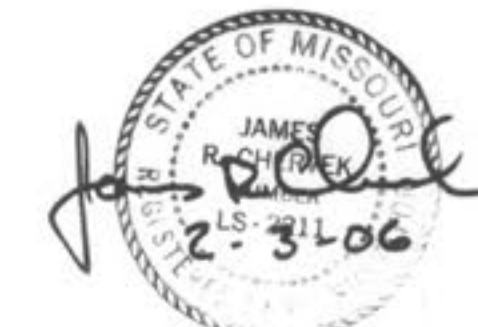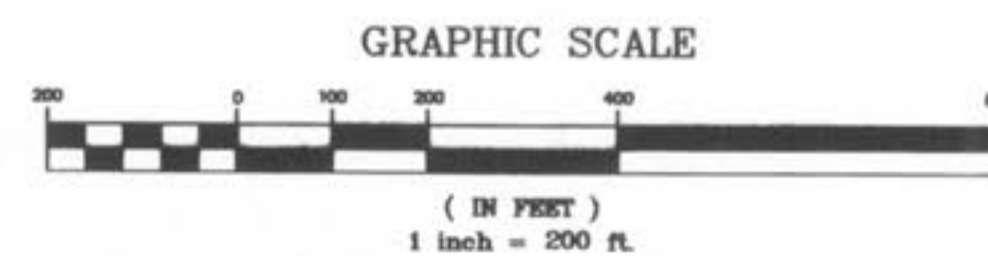

AS-BUILT PLANS

PICKETT RAY & SILVER
 CIVIL ENGINEERS
 PLANNERS
 LAND SURVEYORS

**WYNDGATE
VILLAGE F
COVER SHEET**


Prepared For:
SUMMIT POINTE, L.C.

NO.	DATE	REVISIONS
1	10/26/04	REVISED PER CITY
2	02/16/05	REVISED PER CITY OF O'FALLON
3	03/25/05	REVISED PER P.W.S.D #2
4	04/08/05	REVISED PER CITY & CLIENT
5	04/15/05	REVISED PER CITY

ENGINEER'S AUTHENTICATION
 The responsibility for professional engineering liability on this project is hereby limited to the set of plans authenticated by the seal, signature, and date hereunder attached. Responsibility is disclaimed for all other engineering plans involved in this project and specifically excludes revisions after this date unless reauthenticated.

DRAWN	J.E.E.	DATE	6-29-04
CHECKED	D.W.D.	DATE	6-29-04
PROJECT #	01267.SUPO.02R	TASK #	2 FIELD BOOK

WYNDGATE
VILLAGE F
COVER SHEET
SHEET 131F OF 174

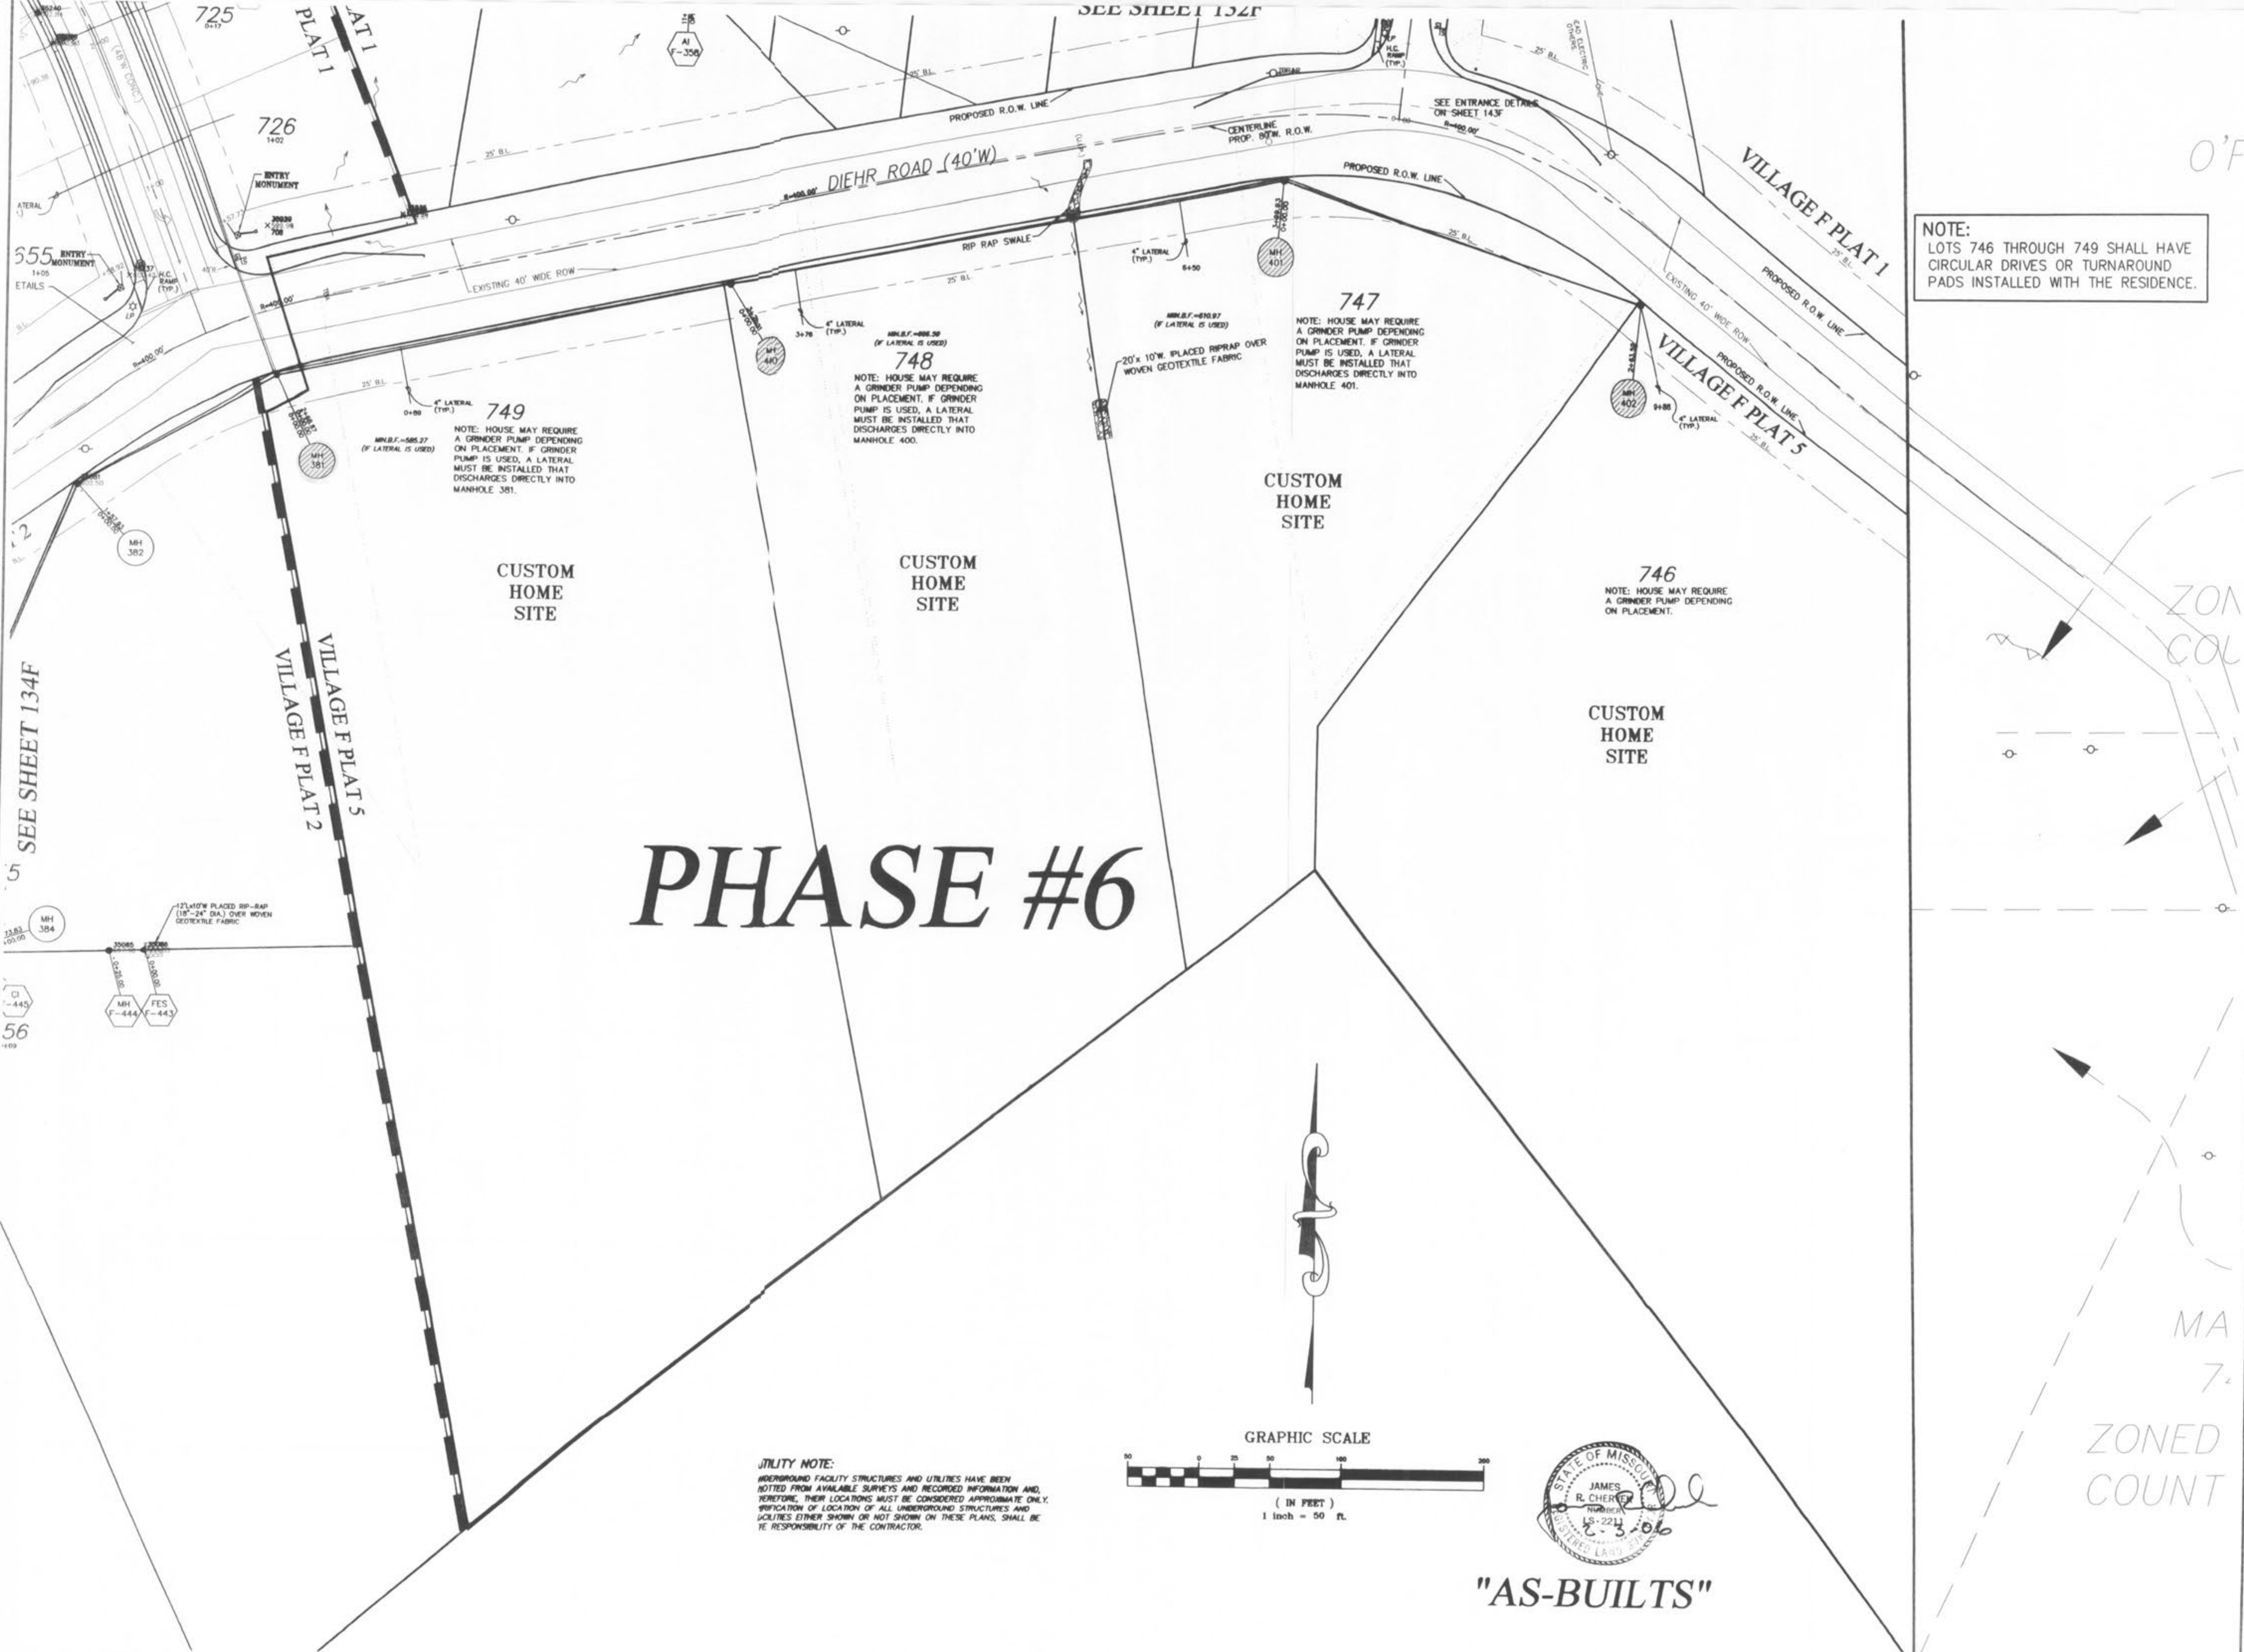

NOTE:
LOTS 746 THROUGH 749 SHALL HAVE CIRCULAR DRIVES OR TURNAROUND PADS INSTALLED WITH THE RESIDENCE.

PICKETT RAY & SILVEI
CIVIL ENGINEERS
PLANNERS
LAND SURVEYORS

388 Mid Rivers Mall Dr
St. Peters, MO 63376
Phone (636) 397-1211
Fax (636) 397-1104

WYNDGATE VILLAGE F SITE PLAN

Prepared For:
SUMMIT POINTE, L.C.

239 FOX HILL ROAD
ST. CHARLES, MO 63301
(636) 948-8777

NO.	DATE	REVISIONS
1	10/25/04	REVISED PER CITY
2	12/29/04	REVISED PER DCSD
3	02/16/05	REVISED PER CITY OF O'FALLON
4	04/06/05	REVISED PER CITY & CLIENT

ENGINEERS AUTHORIZATION
The responsibility for professional engineering liability on this project is hereby limited to the set of plans authenticated by the seal, signature, and date hereunder attached. Responsibility is disclaimed for all other engineering plans involved in this project and specifically excludes revisions after this date unless reauthenticated.



PICKETT, RAY & SILVER, INC

DRAWN JEE	DATE 6-29-04
CHECKED DWD	DATE 6-29-04
PROJECT # 01267-SUPO.02R	TASK # 2 FIELD BOOK


WYNDGATE VILLAGE F SITE PLAN
SHEET 133F OF 174

enverp1\Projects\01267\dwg\01267-PLAN SHEETS VILLAGES F.dwg, 1/11/2007 4:31:39 PM, DON DAWSON

\\snp\projects\101267\dwg\101267-SANITARY AS-BUILTS PHASE 6.dwg, dwg, 11/11/2007 4:34:51 PM, DON DANSON

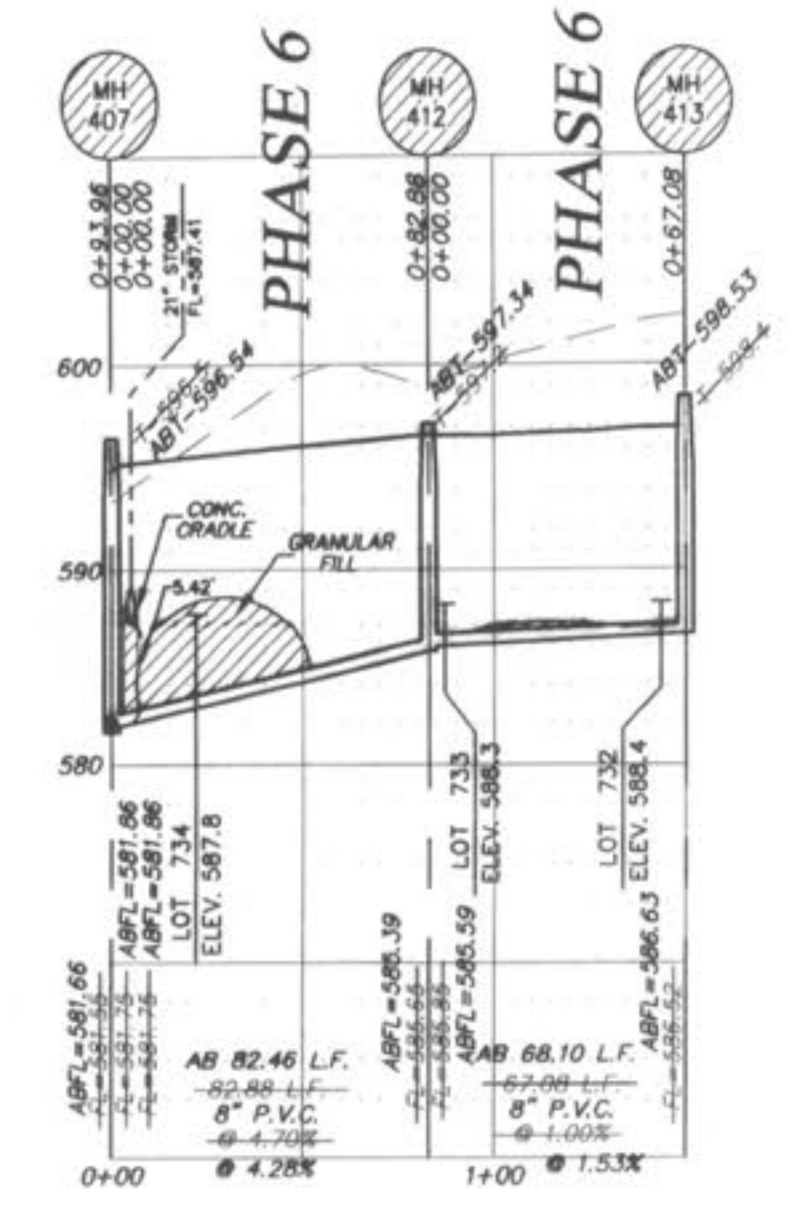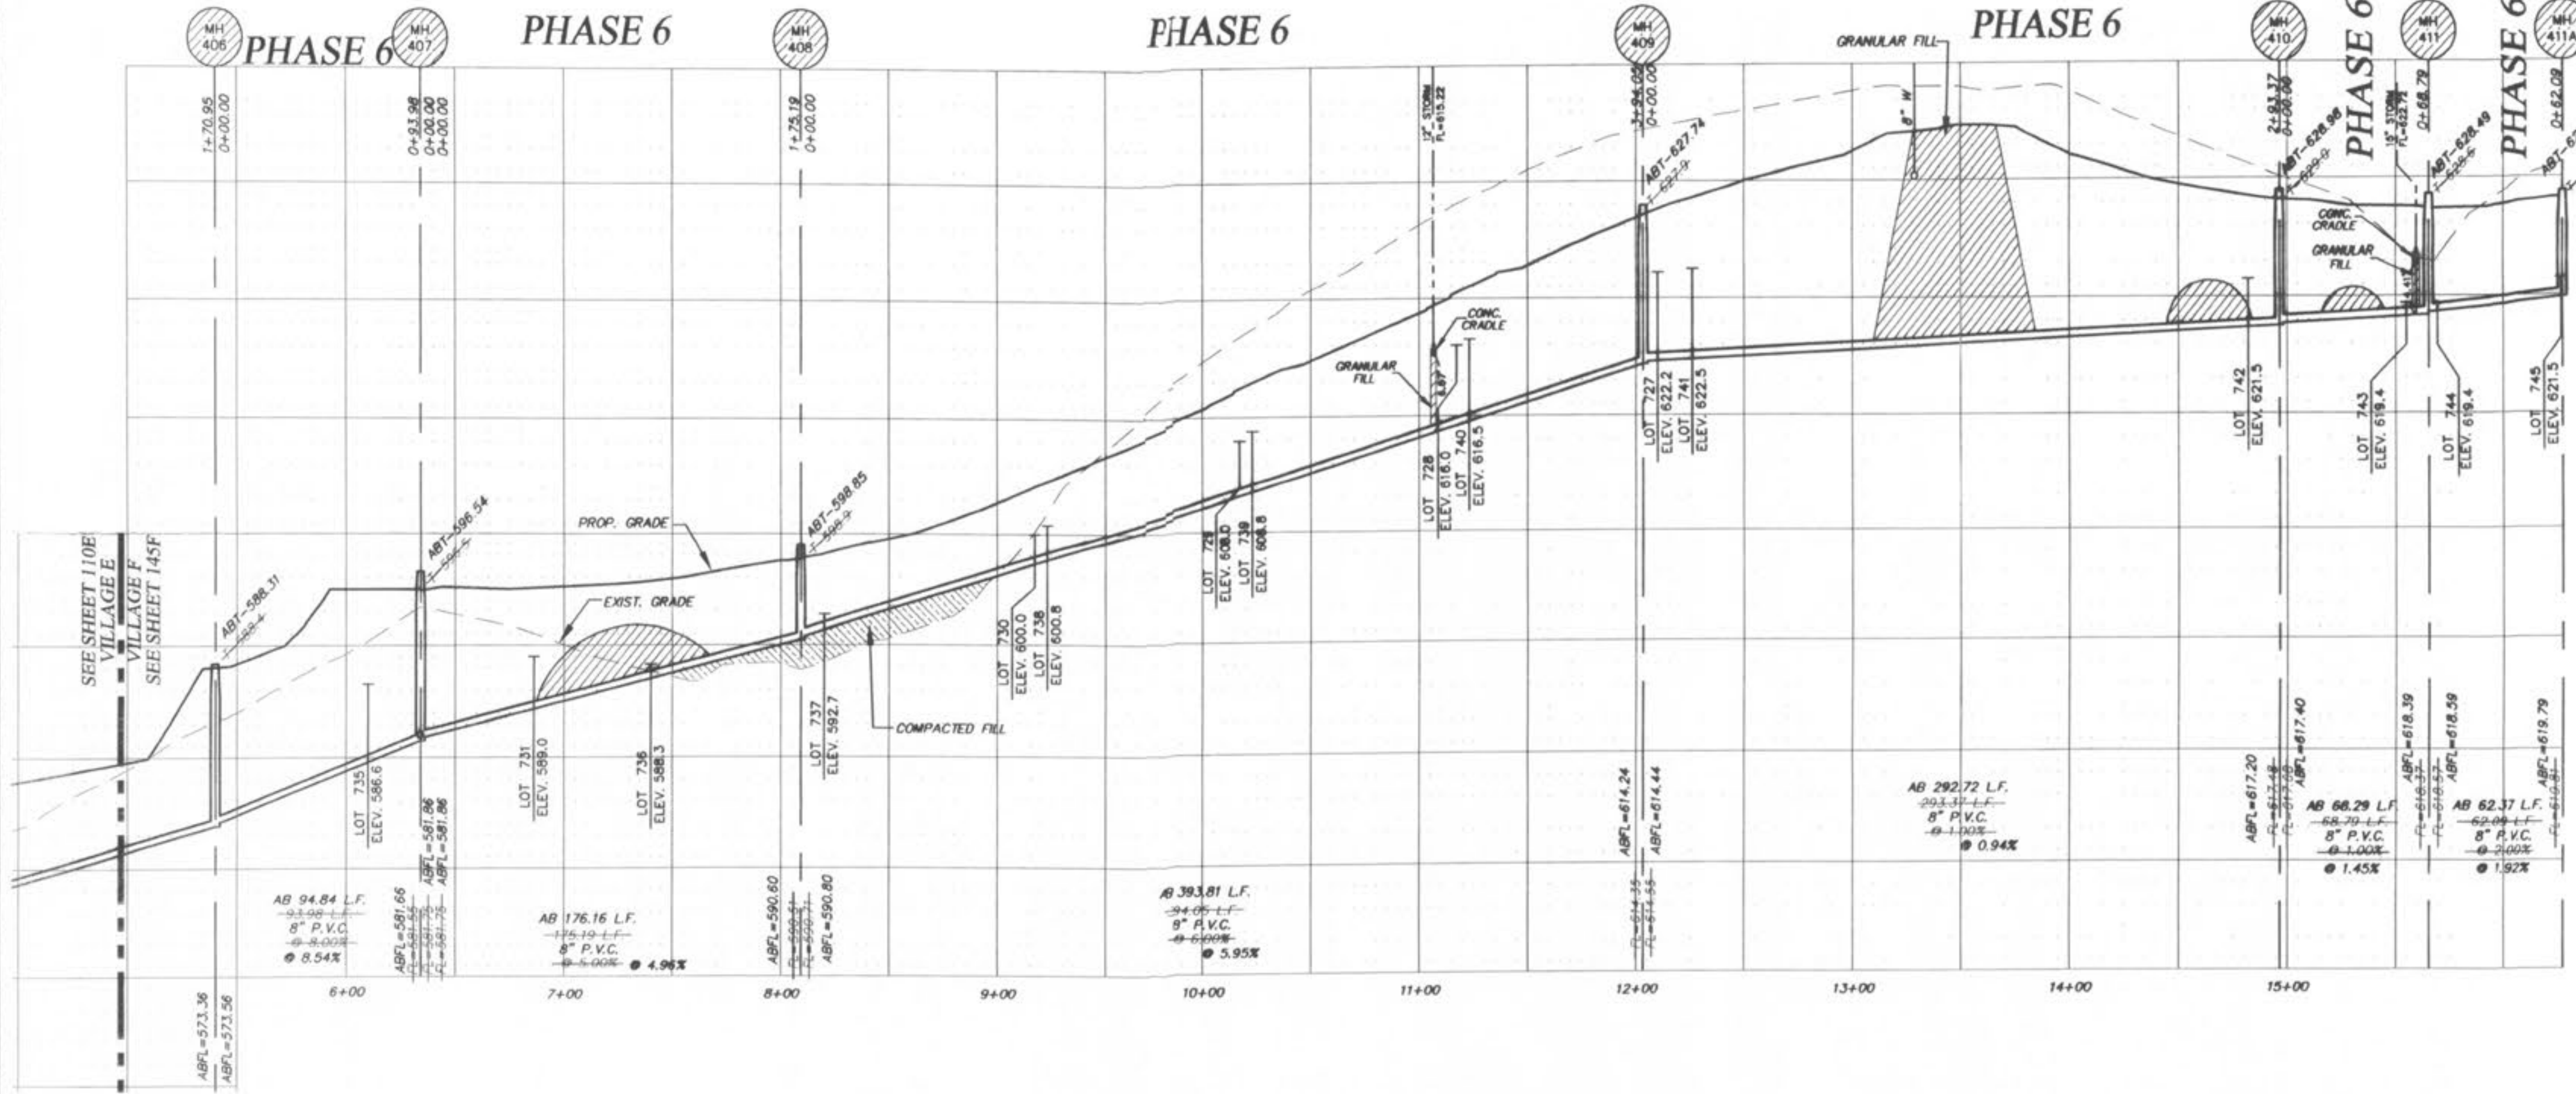

HORIZONTAL SCALE: 1"=50'
VERTICAL SCALE: 1"=10'

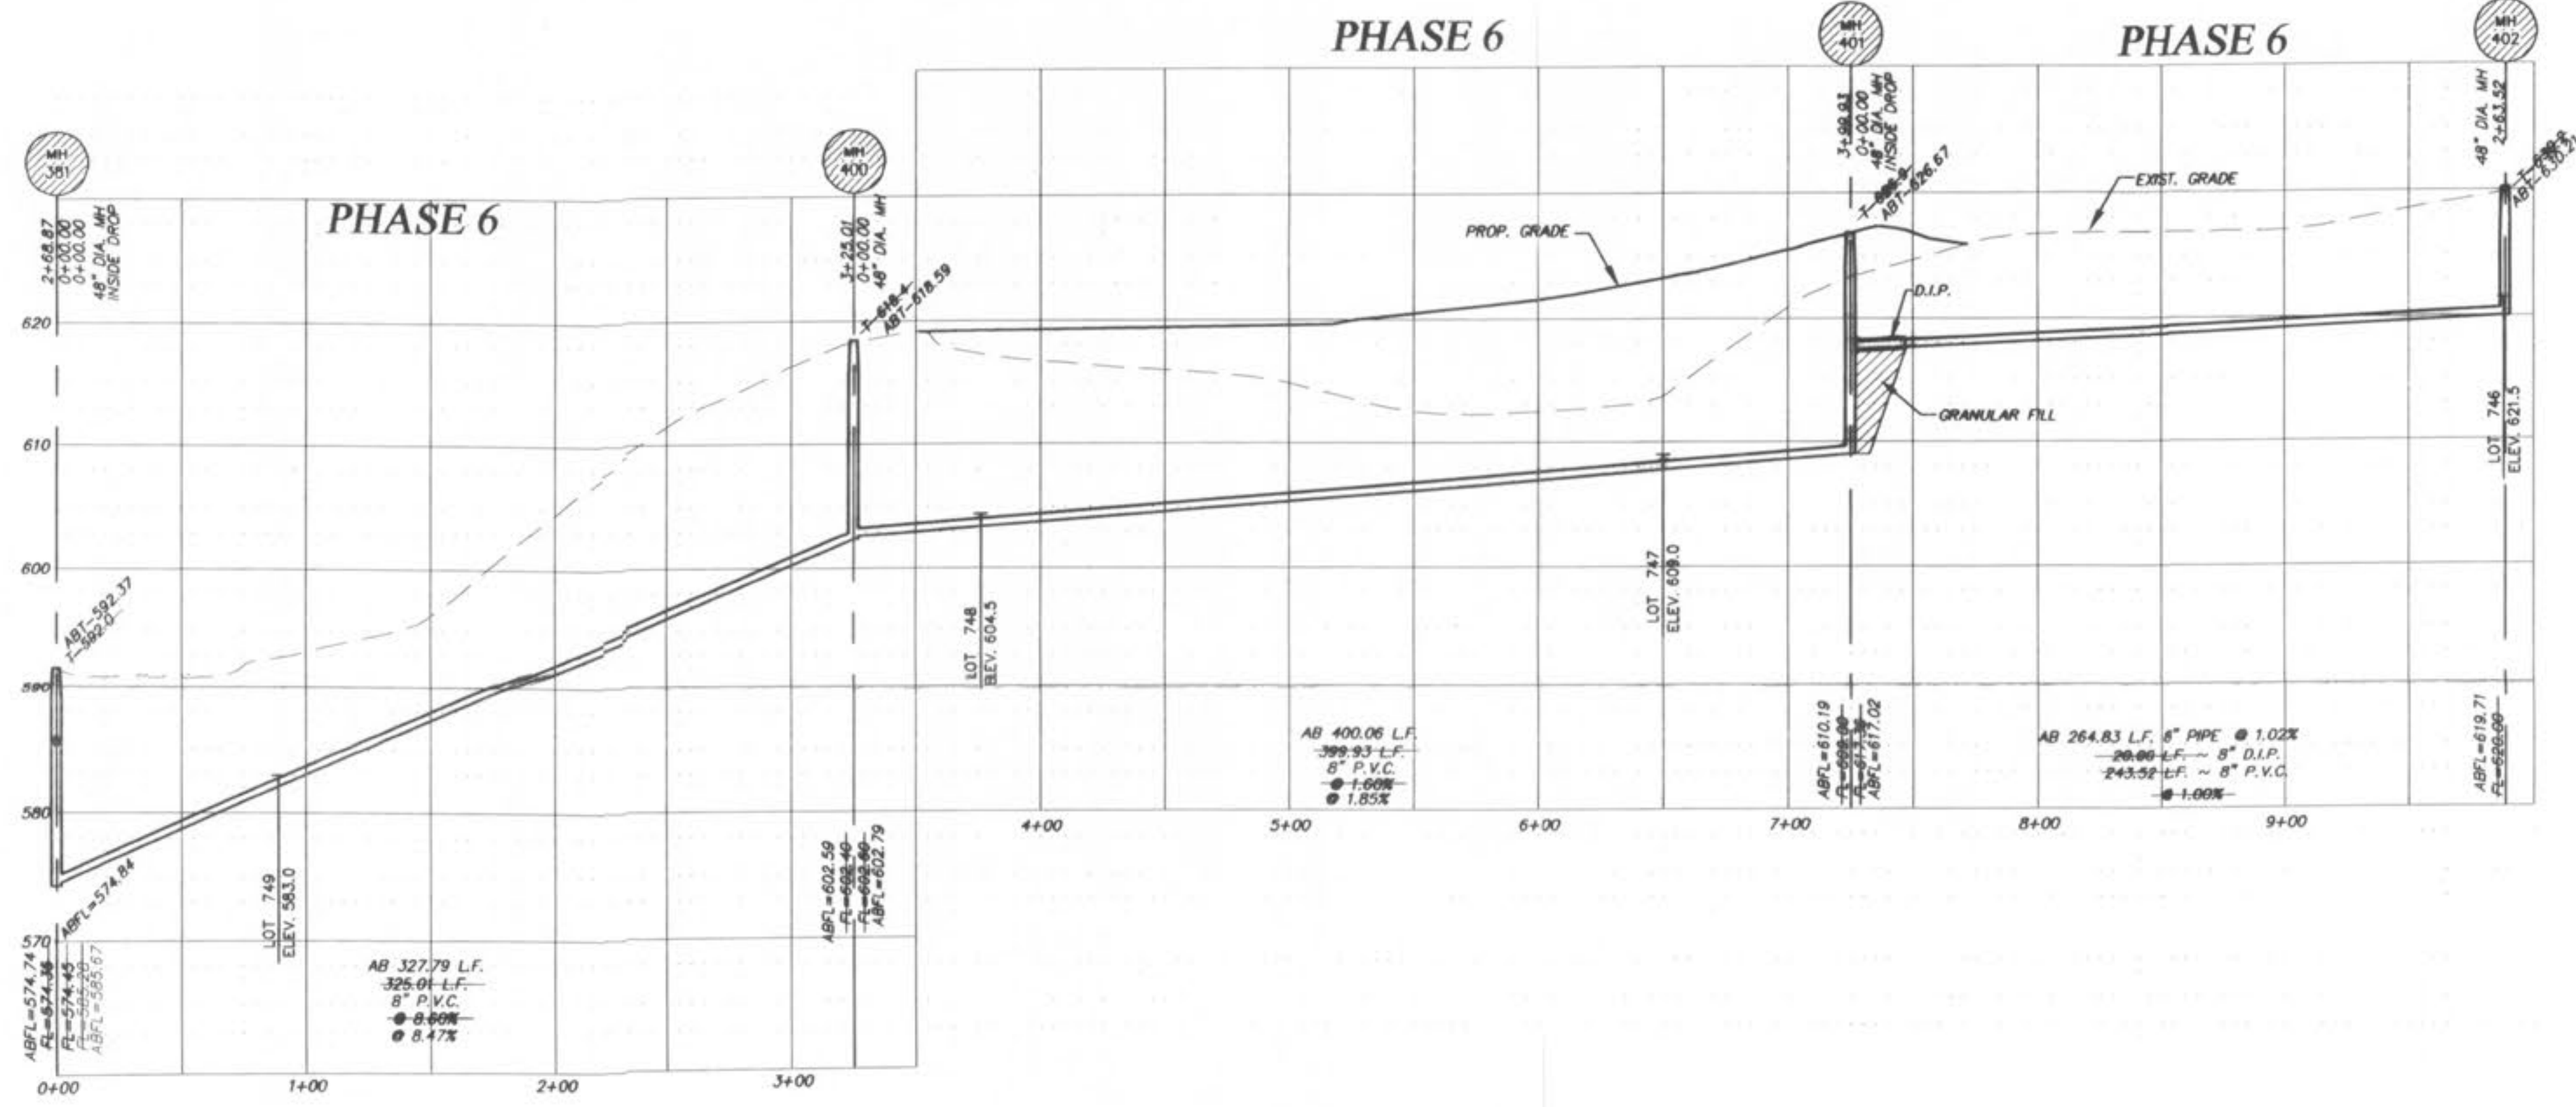

"AS-BUILTS"
PHASE 6
02/03/06



IF THE STORM AND SANITARY SEWERS ARE PARALLEL AND IN THE SAME TRENCH OR OVERING, THE UPPER SHALL BE PLACED ON A SHELFF AND BAGFILLED WITH GRANULAR MATERIAL (AGGREGATE).
ALL SANITARY LATERAL STREET CROSSINGS, IF REQUIRED, SHALL BE BAGFILLED WITH GRANULAR MATERIAL (AGGREGATE).

STORM SEWERS WHICH CROSS OVER EXISTING OR PROPOSED SANITARY SEWER TRENCHES SHALL BE GRADED IN CONCRETE (OR ENGAGED H.O.P.E.) THROUGH THE FULL WIDTH OF THE SANITARY SEWER TRENCH. THE TRENCH SHALL BE BACKFILLED AND COMPACTED GRANULAR FILL TO THE BOTTOM OF THE CONCRETE CRADLE.

REVISIONS	NO.	DATE	REVISION PER CITY
	1	10/25/04	REVISED PER CITY
	3	02/05/05	REVISED PER DCSD
	6	02/16/05	REVISED PER CITY OF OTTAWON

ENGINEERS AUTHENTICATION
The responsibility for professional engineering liability on this project is hereby limited to the set of plans authenticated by the seal, signature, and date hereunder attached. Responsibility is disclaimed for all other engineering plans involved in this project and specifically excludes revisions after this date unless otherwise noted.
PICKETT, RAY & SILVER, INC.

DRAWN	JEE	DATE	6-29-04
CHECKED	DWD	DATE	6-29-04
PROJECT	# 01267.SUP0.02R		
TASK #	2	FIELD BOOK	








WYNDGATE VILLAGE F
SANITARY SEWER PROFILES
SHEET 144F OF 174
© Copyright 2004 by Pickett, Ray & Silver, Inc.

PICKETT RAY & SILVER
CIVIL ENGINEERS
PLANNERS
LAND SURVEYORS
333 Mid Rivers Mall Drive
St. Peters, MO 63376
Phone (636) 397-1211
Fax (636) 397-1104

WYNDGATE VILLAGE F
SANITARY SEWER PROFILES
Prepared For:
SUMMIT POINTE, L.C.
230 FOX HILL ROAD
ST. CHARLES, MO. 63301
(636) 940-9300

ROUND PIPE				HORIZONTAL ELLIPTICAL PIPE			
INSIDE DIAMETER OF PIPE (INCHES)	"W" PAYLINE WIDTH OF TRENCH (INCHES)	"W" PAYLINE WIDTH OF TRENCH (FEET)	PAY-VOLUMES CU. FT. PER FT. CONCRETE ENCASUREMENT	INSIDE DIAMETER OF PIPE (INCHES)	"W" PAYLINE WIDTH OF TRENCH (INCHES)	"W" PAYLINE WIDTH OF TRENCH (FEET)	PAY-VOLUMES CU. FT. PER FT. CONCRETE ENCASUREMENT
4	30	2.50	3.28				
6	30	2.50	3.59				
8	30	2.50	3.87				
10	30	2.50	4.09				
12	30	2.50	4.25				
15	36	3.00	5.55				
18	36	3.00	5.77	14 x 23	41	3.42	5.94
21	39	3.25	6.61				
24	42	3.50	7.39	19 x 30	49	4.08	7.68
27	45	3.75	8.18	22 x 34	53	4.42	8.61
30	48	4.08	9.30	24 x 38	58	4.83	9.70
33	53	4.42	10.53	27 x 42	62	5.17	10.71
36	56	4.67	11.43	29 x 45	66	5.50	11.72
39	DISCONTINUED			32 x 49	71	5.92	13.14
42	63	5.25	13.38	34 x 53	75	6.25	14.05
48	70	5.83	15.67	38 x 60	83	6.92	16.18
54	77	6.42	18.15	43 x 68	92	7.67	18.81
60	84	7.00	20.73	48 x 76	101	8.42	21.59
66	91	7.58	23.45	53 x 83	109	9.08	24.35
72	98	8.17	26.37	58 x 91	118	9.83	27.45
78	105	8.75	29.39	63 x 98	126	10.50	30.50
84	112	9.33	32.57	68 x 106	135	11.25	33.91
90	119	9.92	35.90	72 x 113	143	11.92	36.99
96	126	10.50	39.37	77 x 121	152	12.67	40.69
102	133	11.08	42.99	82 x 128	160	13.33	44.45
108	140	11.67	46.75	87 x 136	168	14.00	47.79
114	147	12.25	50.66	92 x 143	176	14.67	51.70
120	154	12.83	54.72	97 x 151	185	15.42	56.01
126	161	13.42	58.92				
132	168	14.00	63.27	106 x 166	202	16.83	64.48
144	182	15.17	72.40	116 x 180	218	18.17	73.59

Duckett Creek Sanitary District
PAYLINE WIDTHS OF TRENCH AND PAY-QUANTITIES OF CONCRETE
Rev. By: BSM, App. By: KLA, Date: 12-21-99, Sheet No. 1

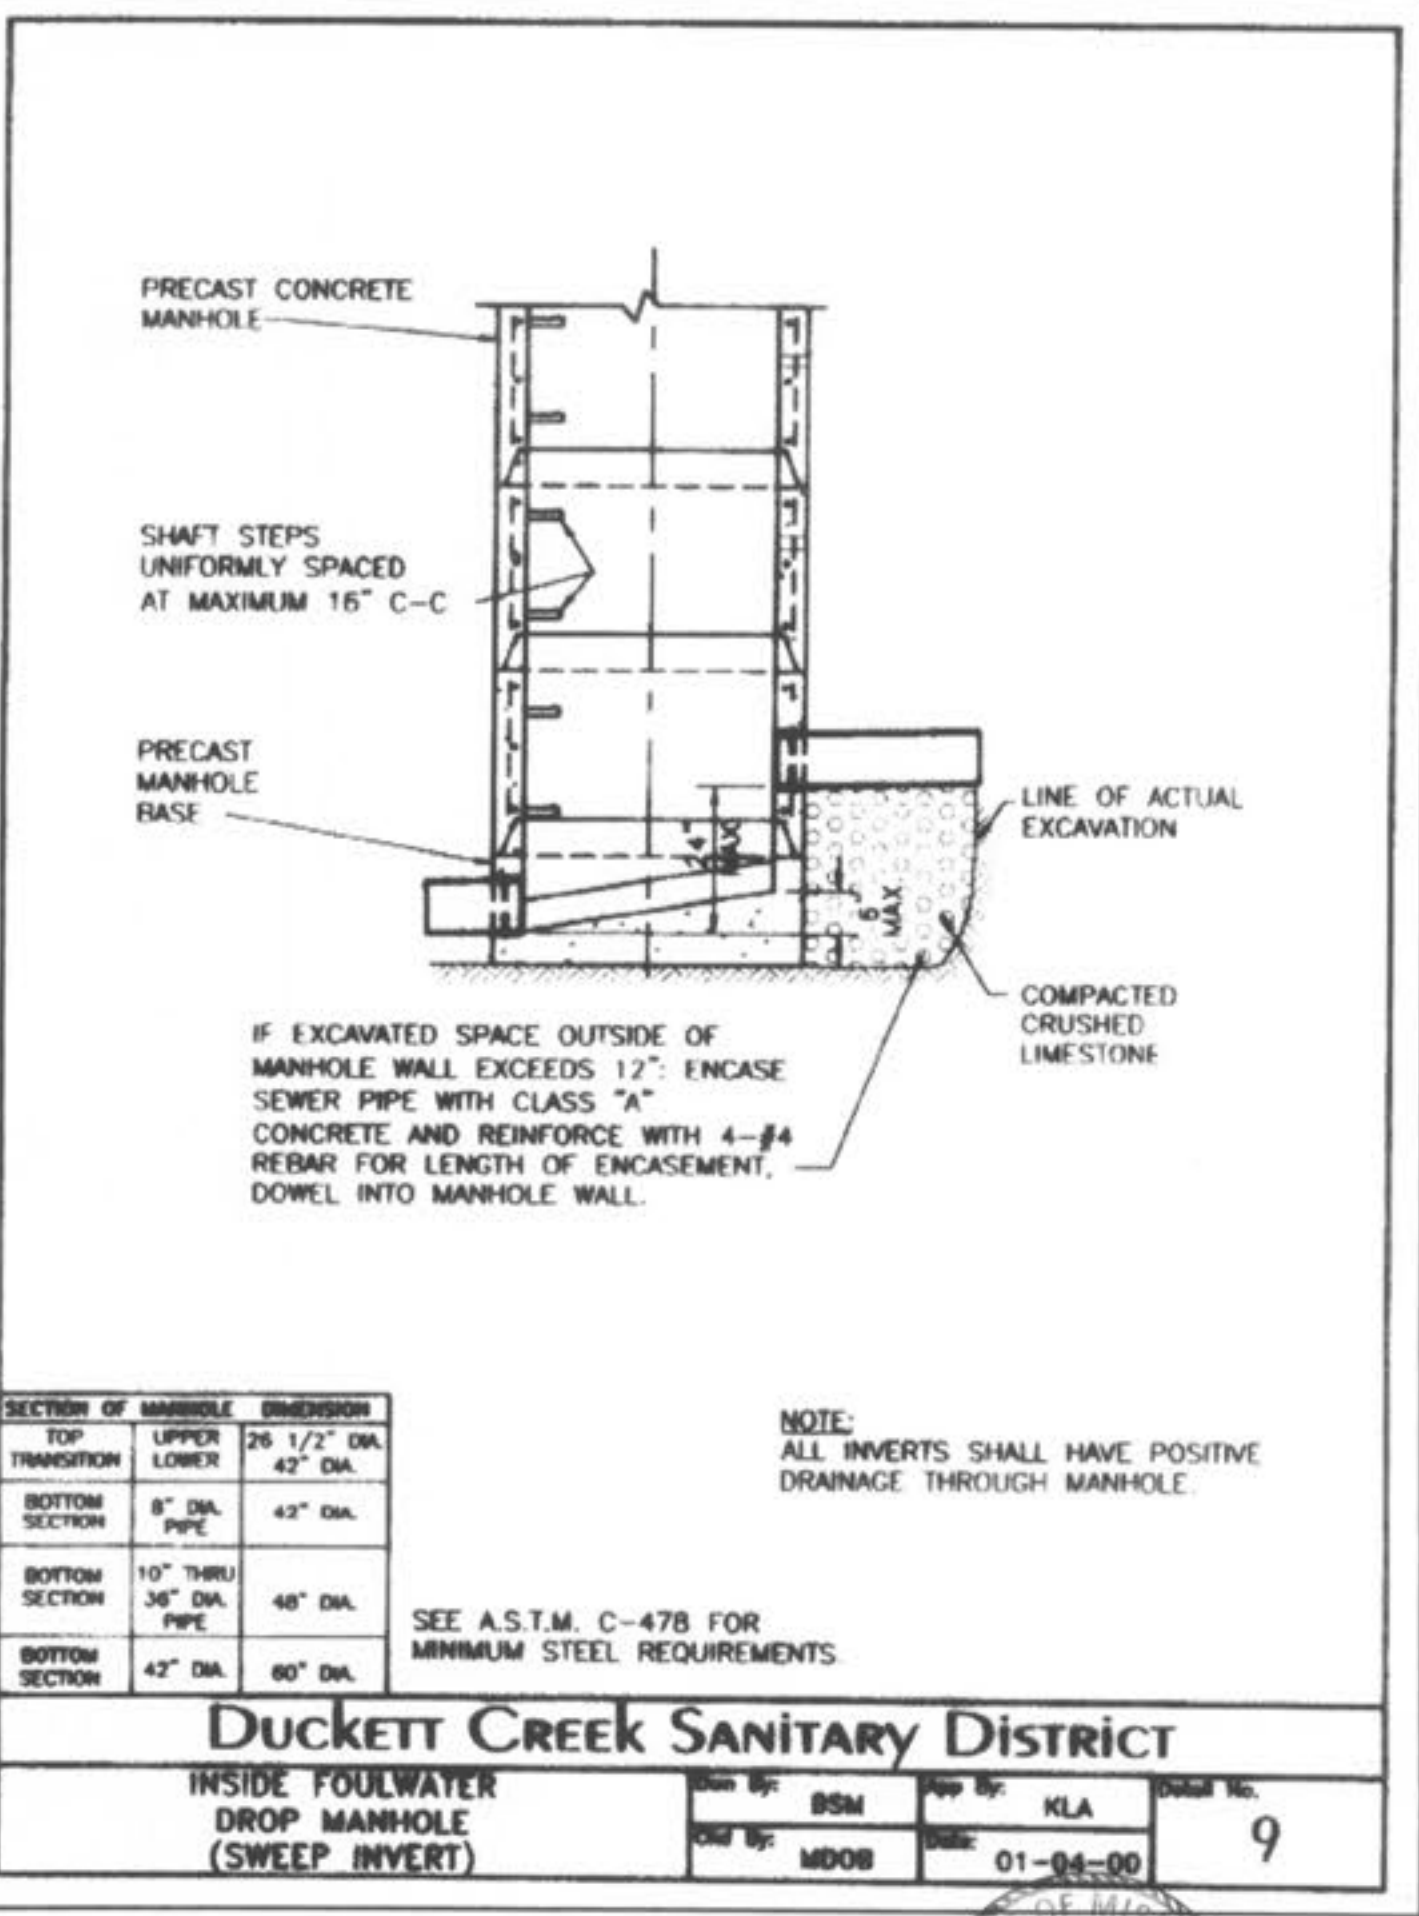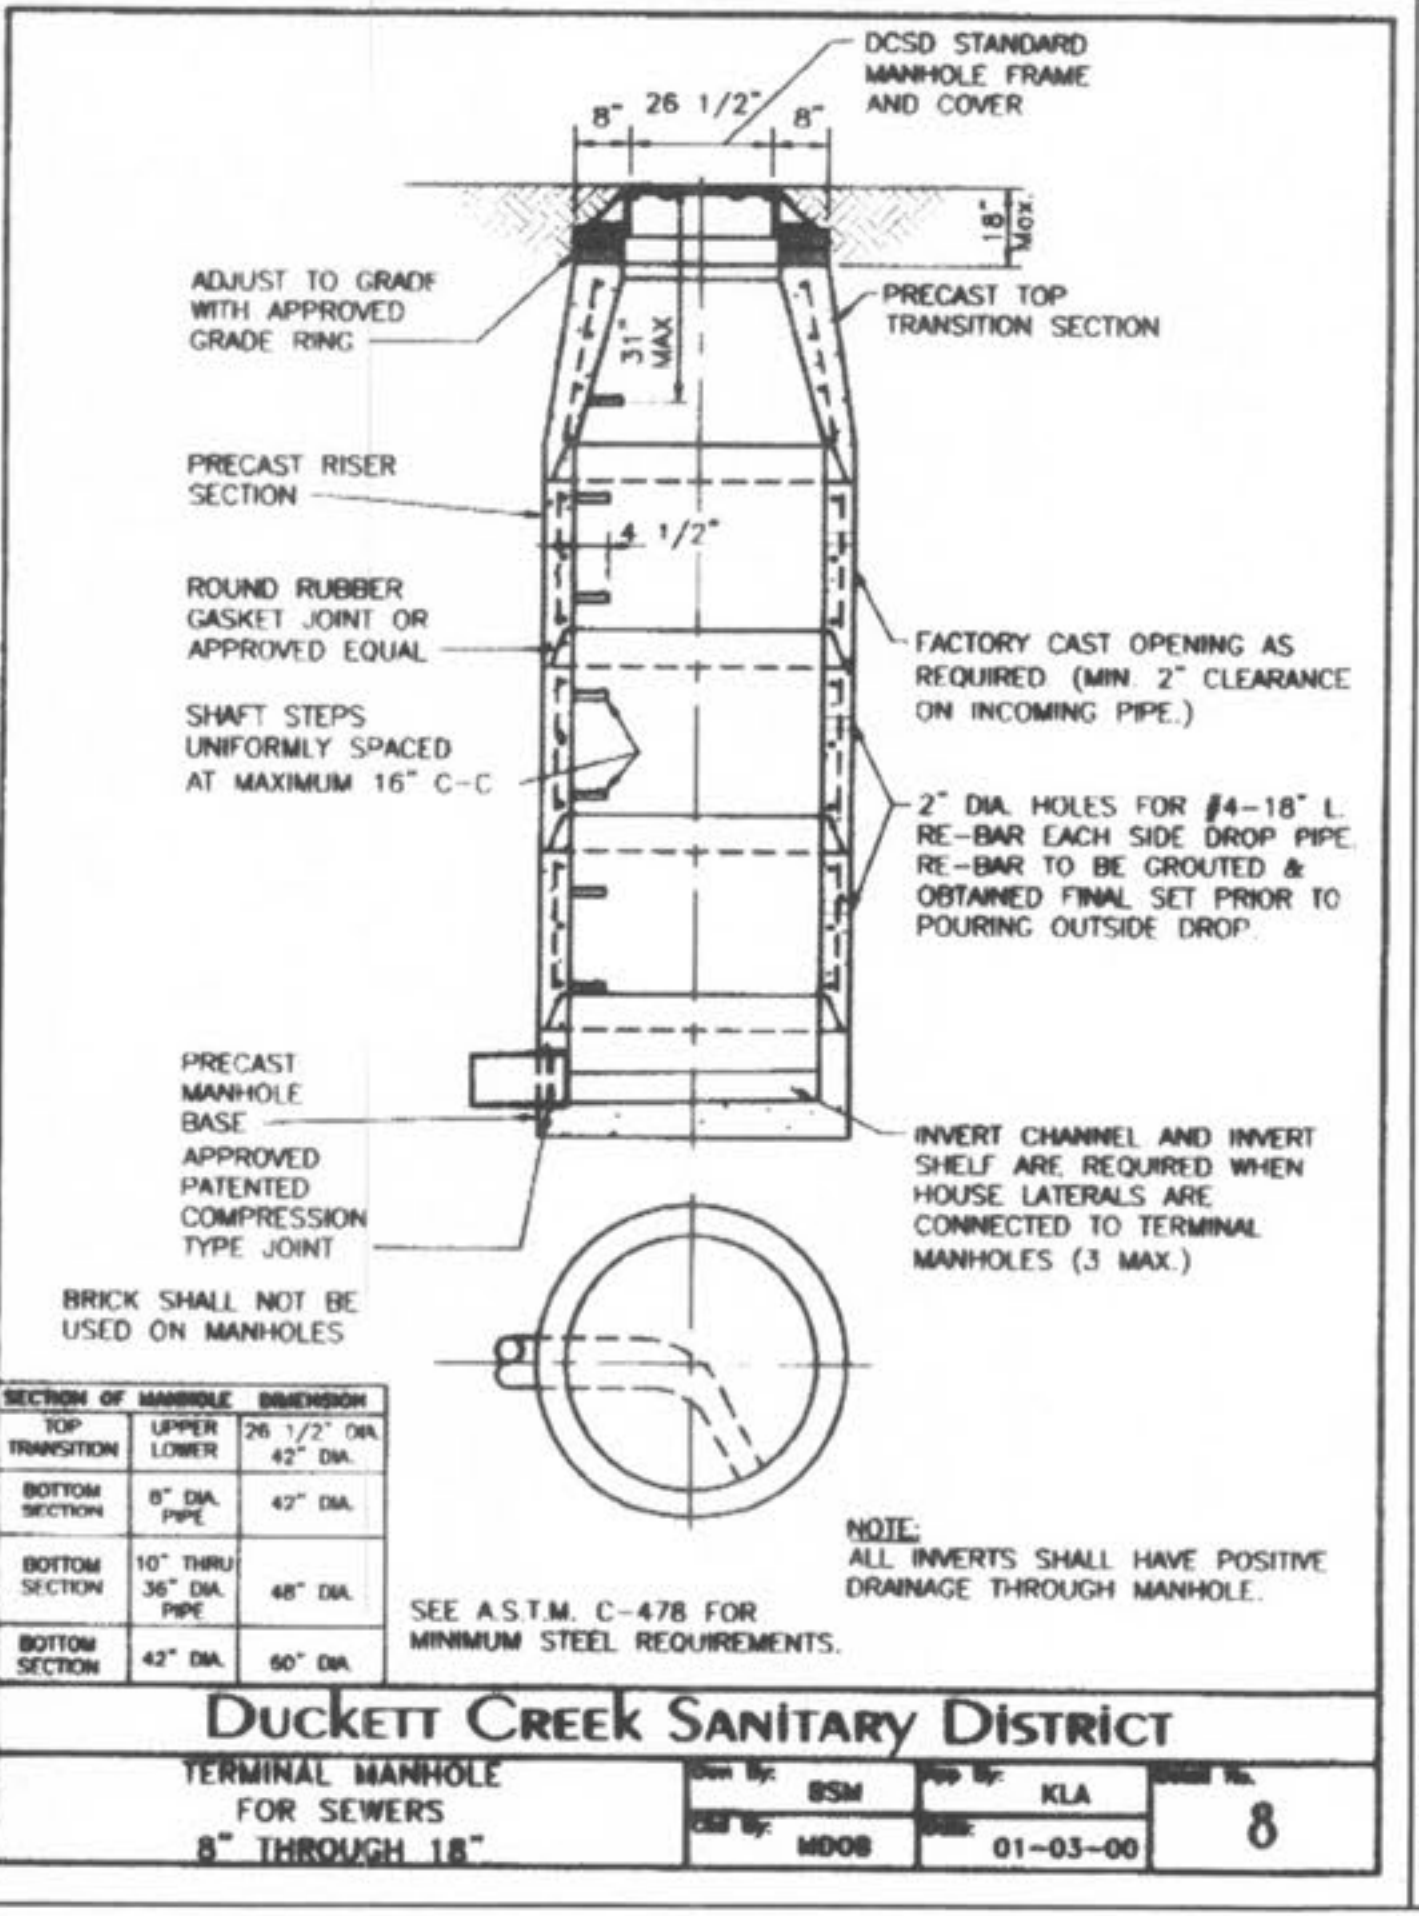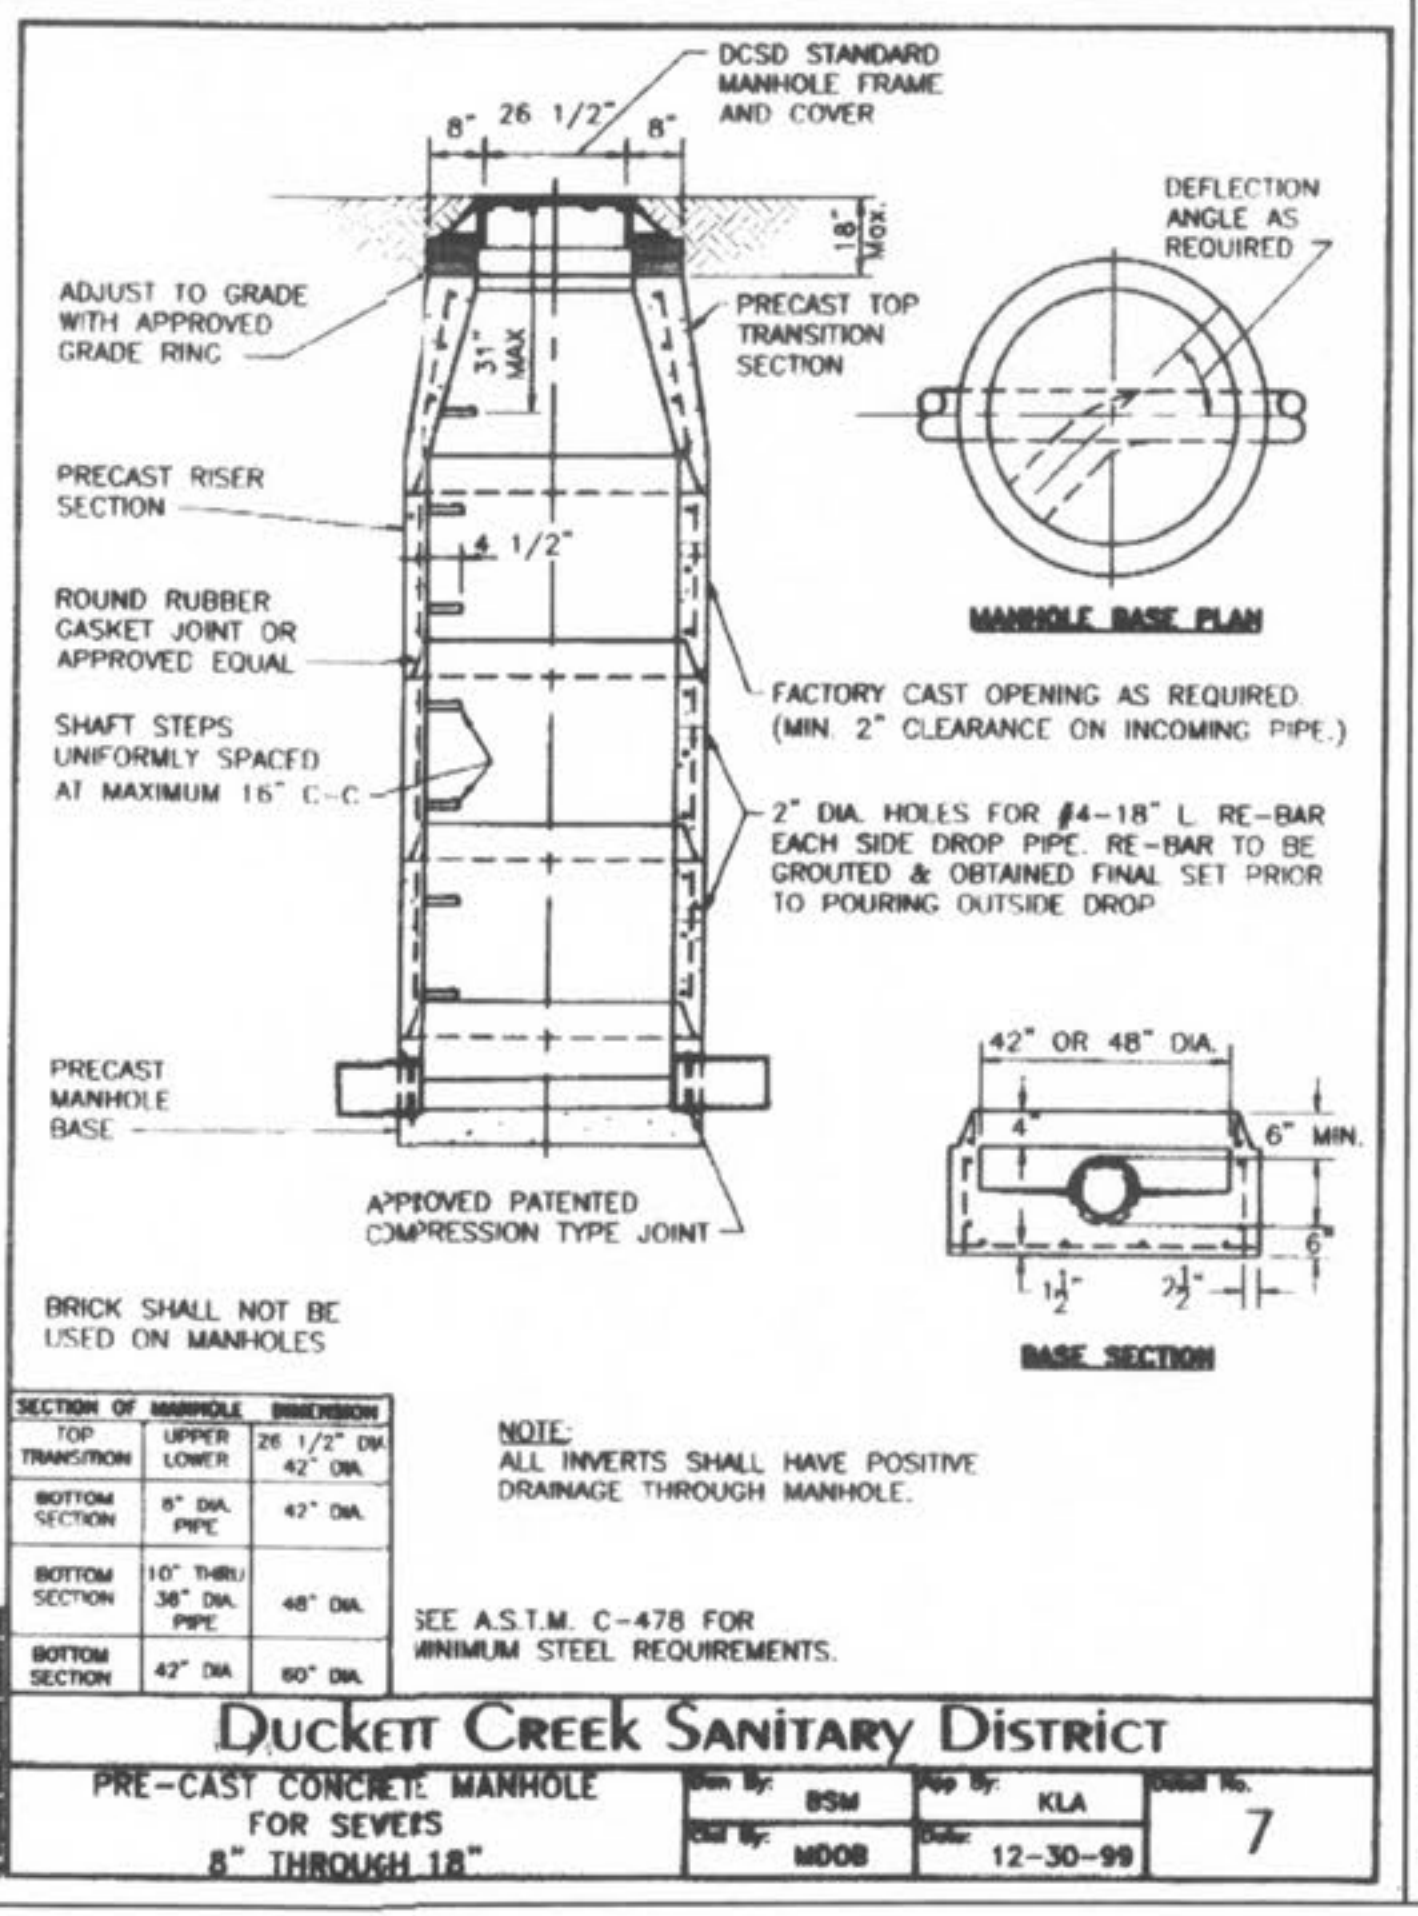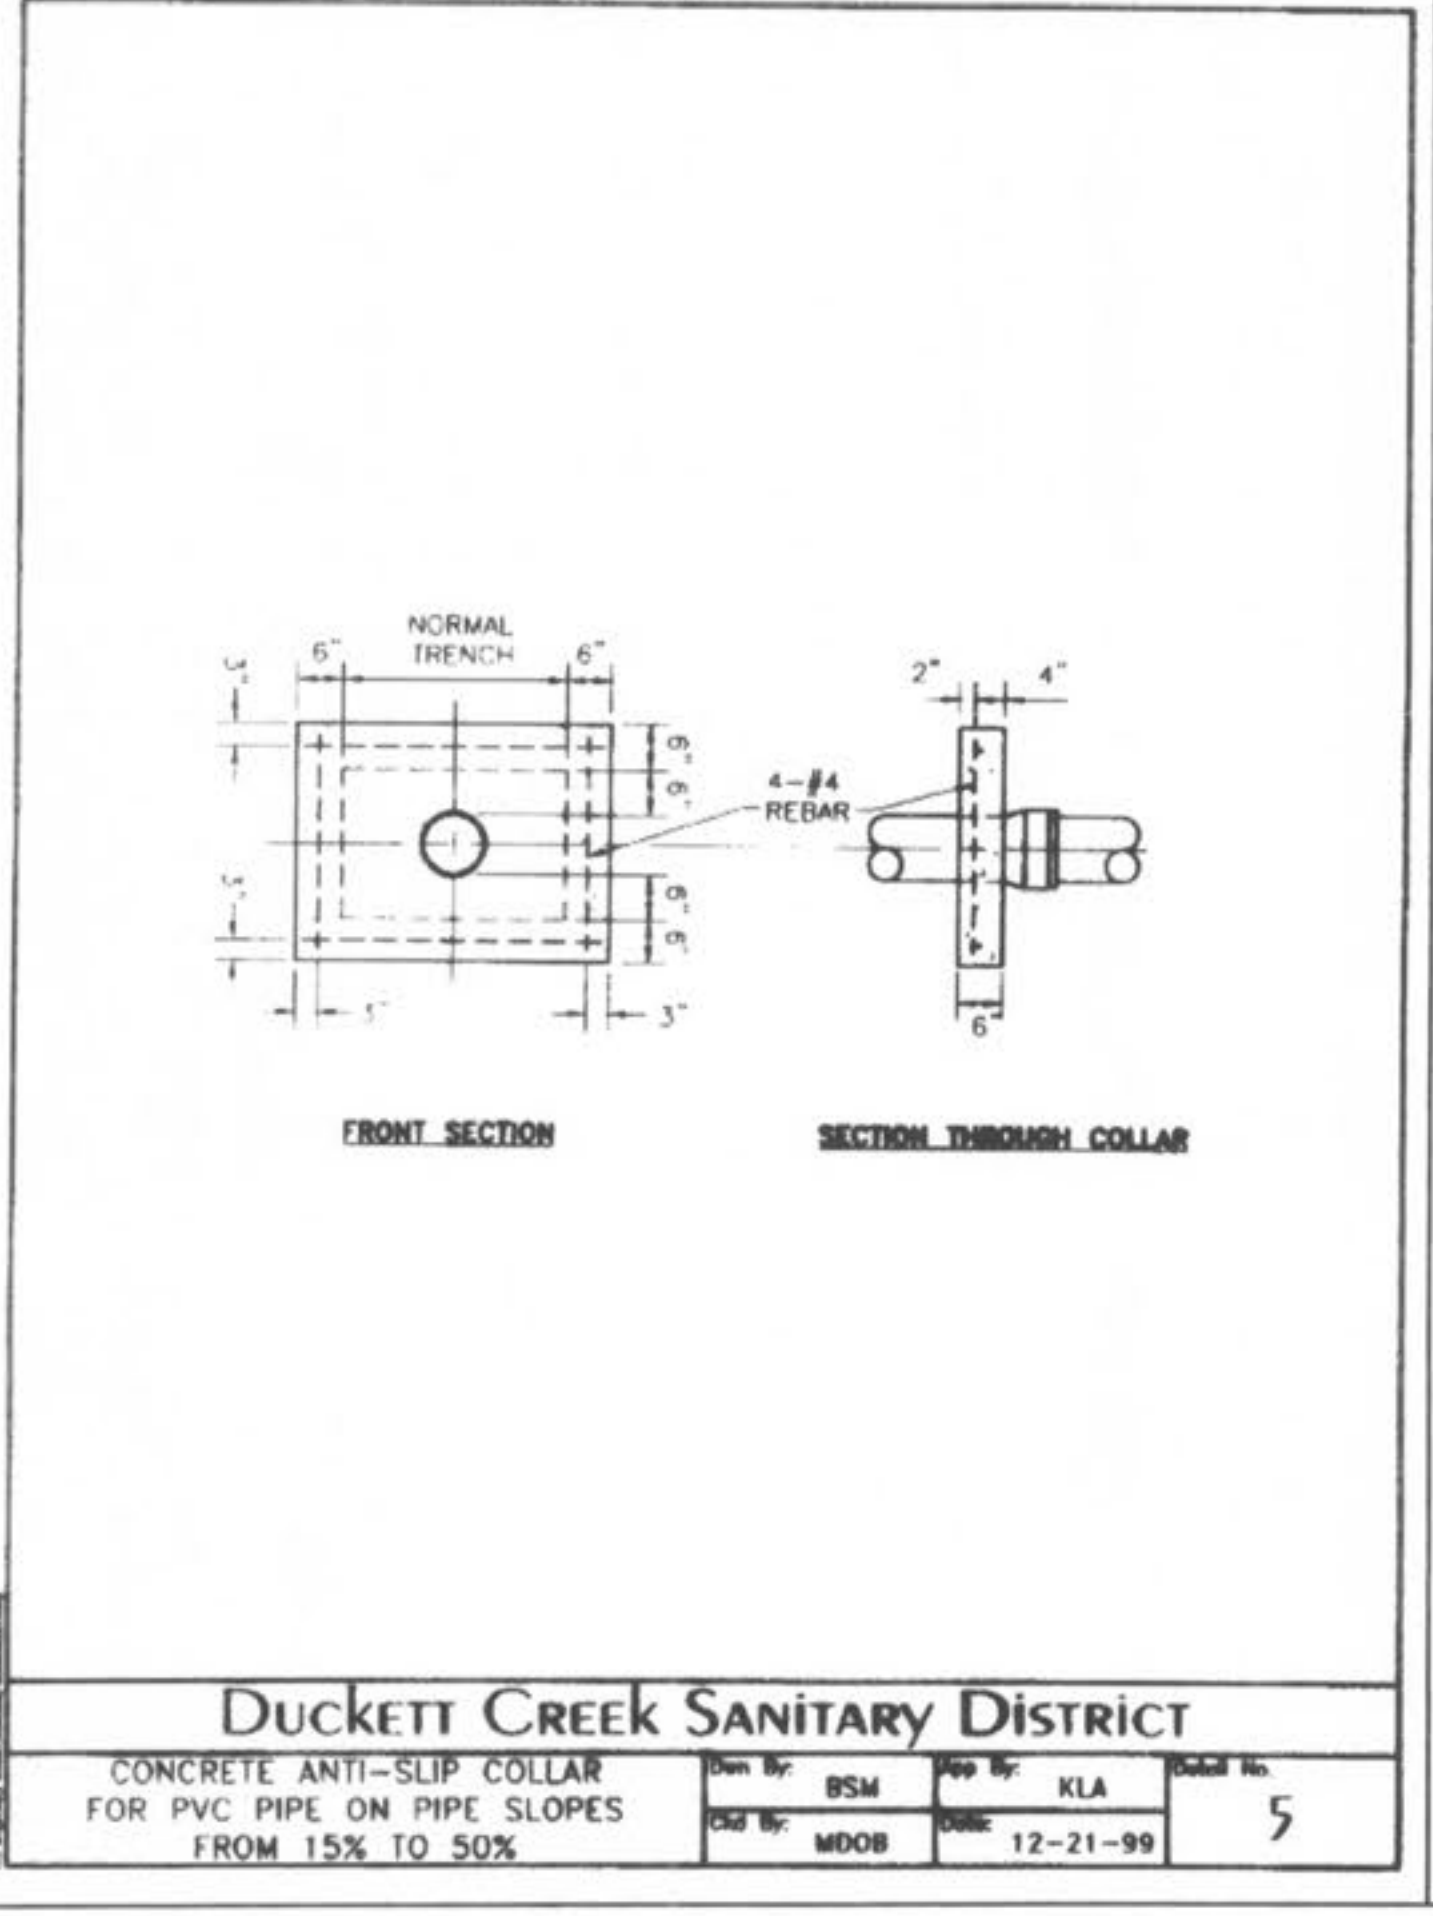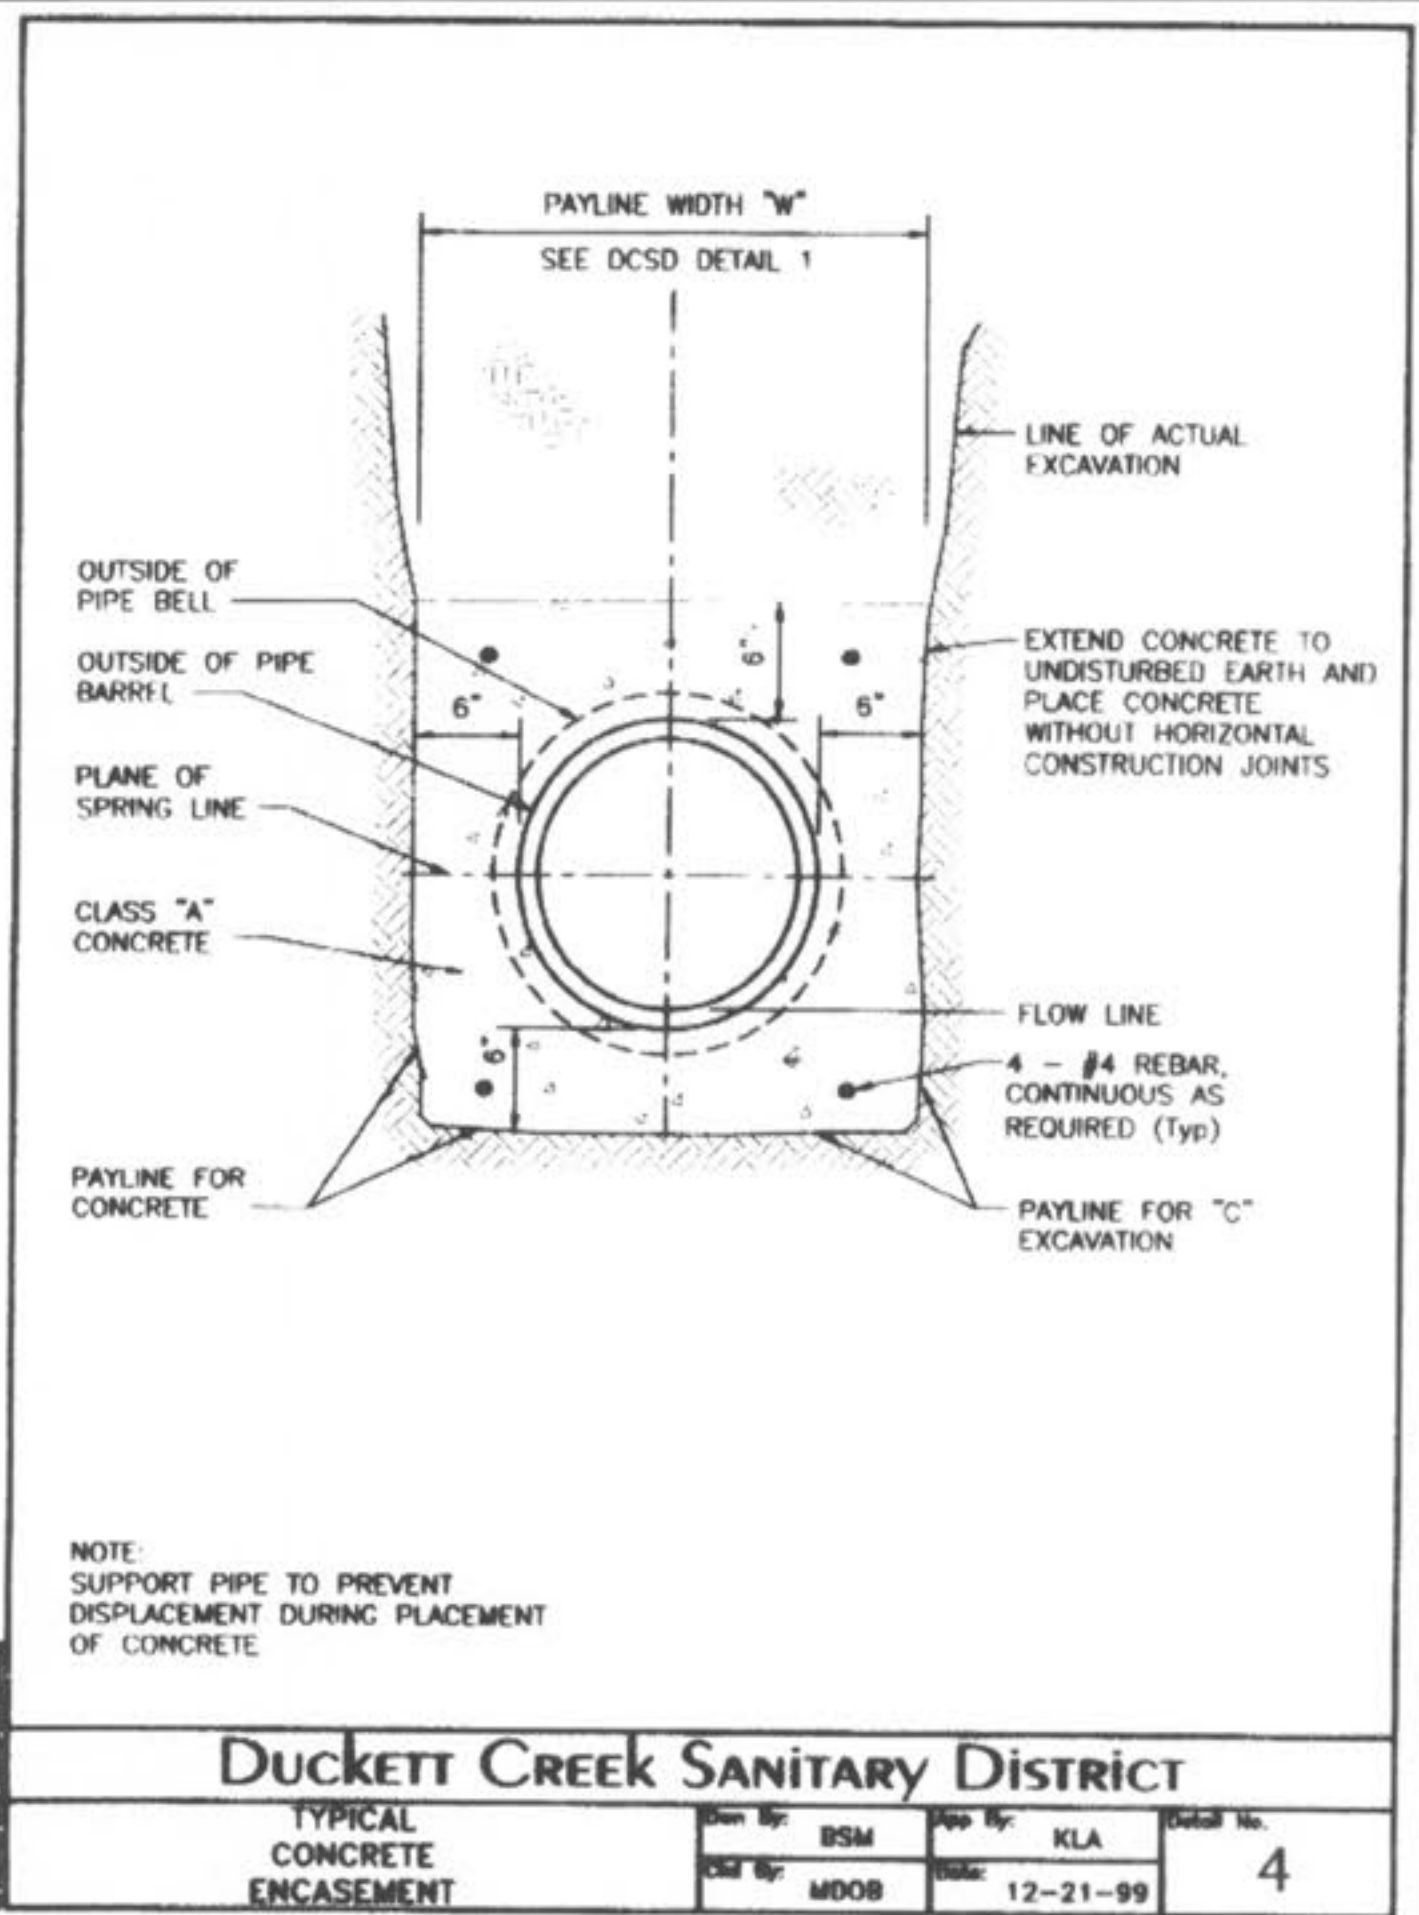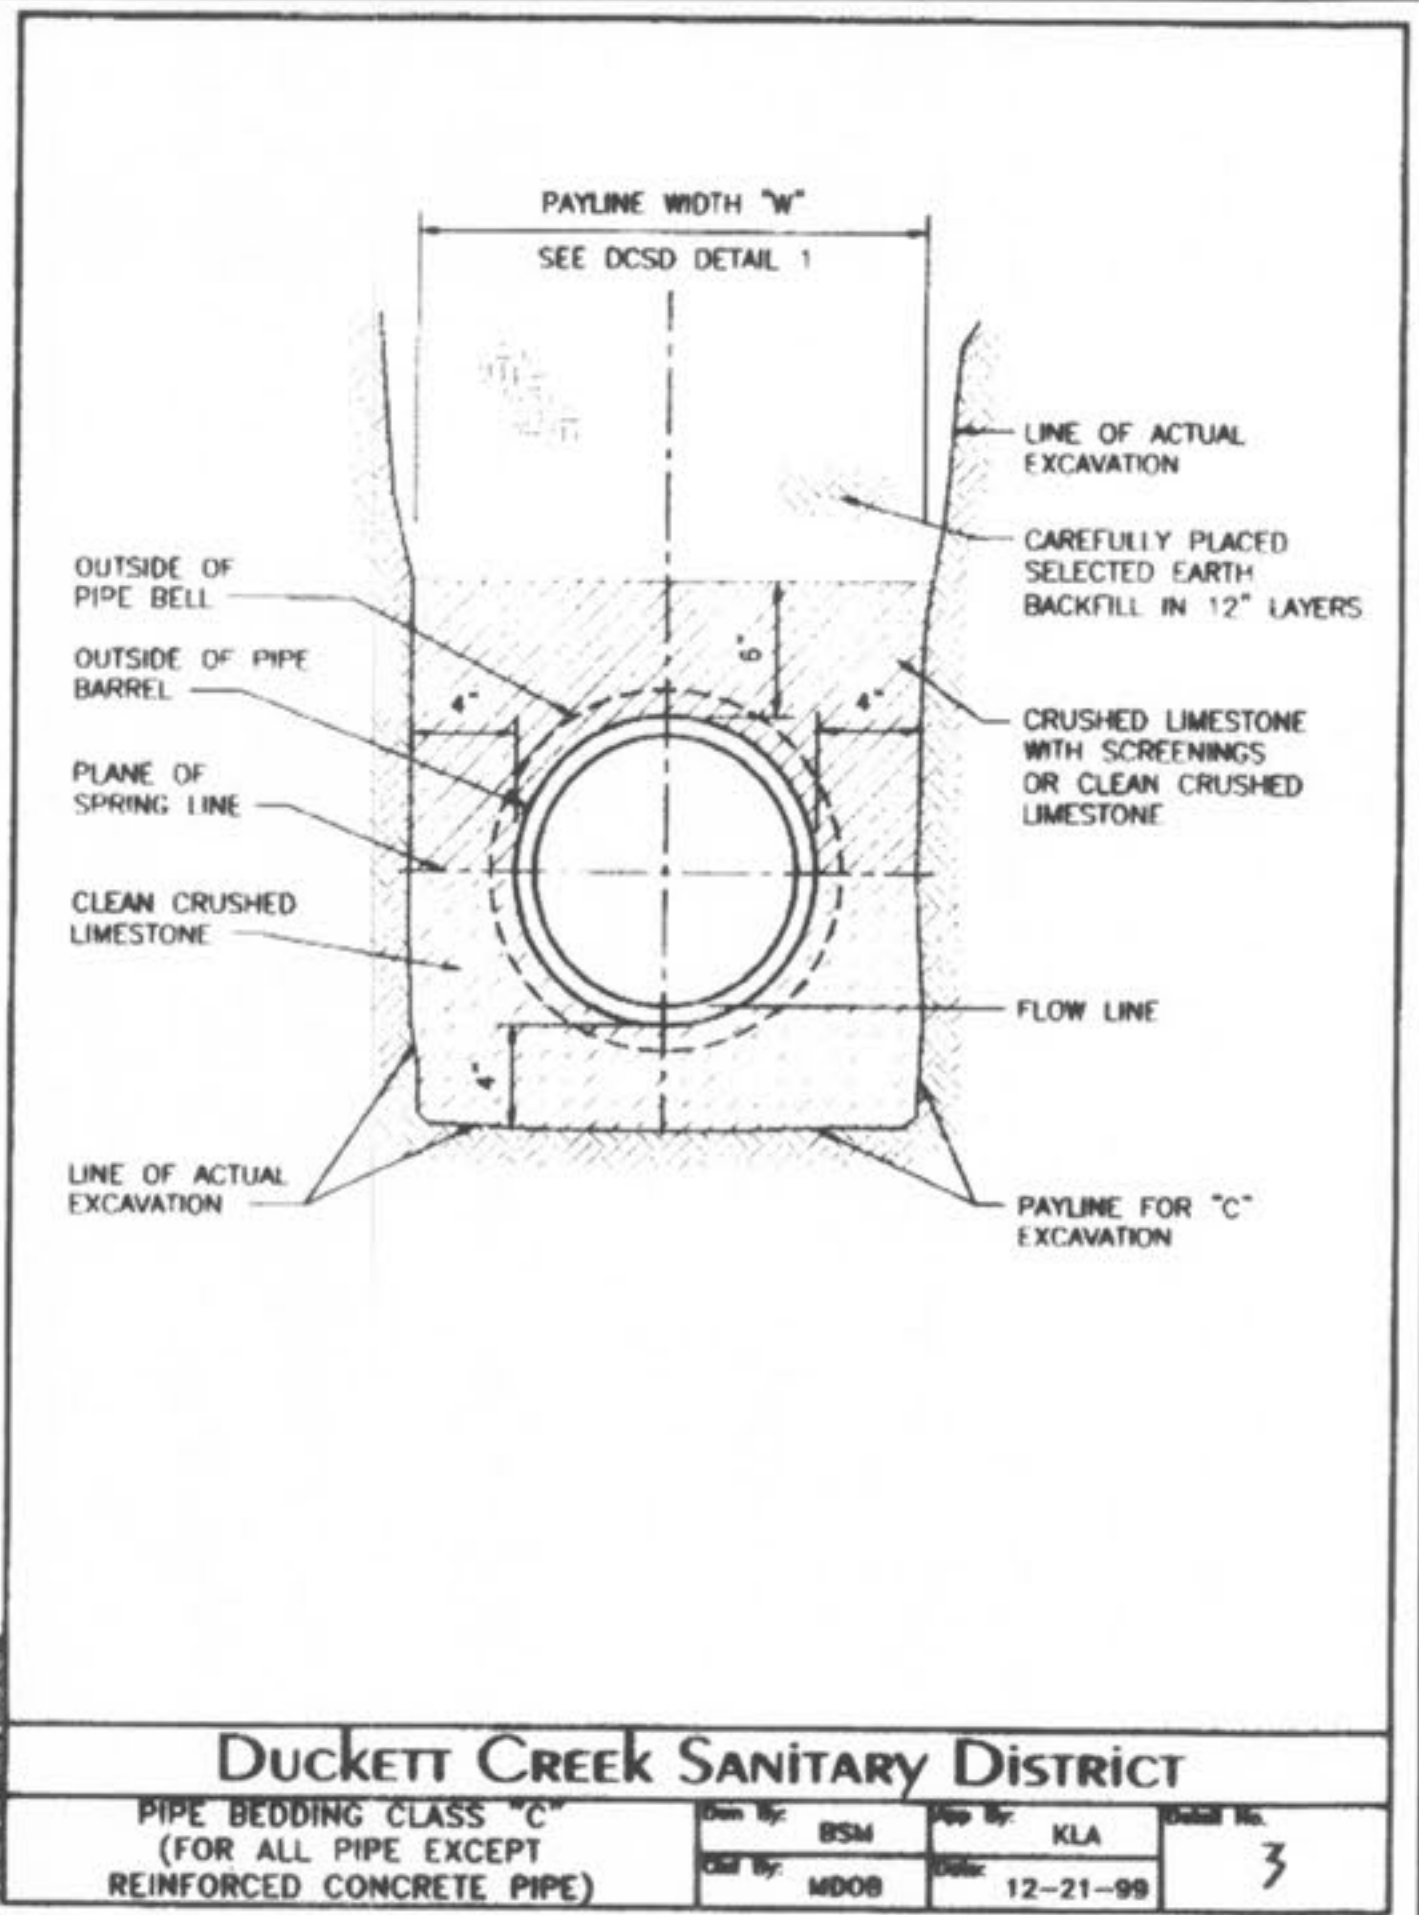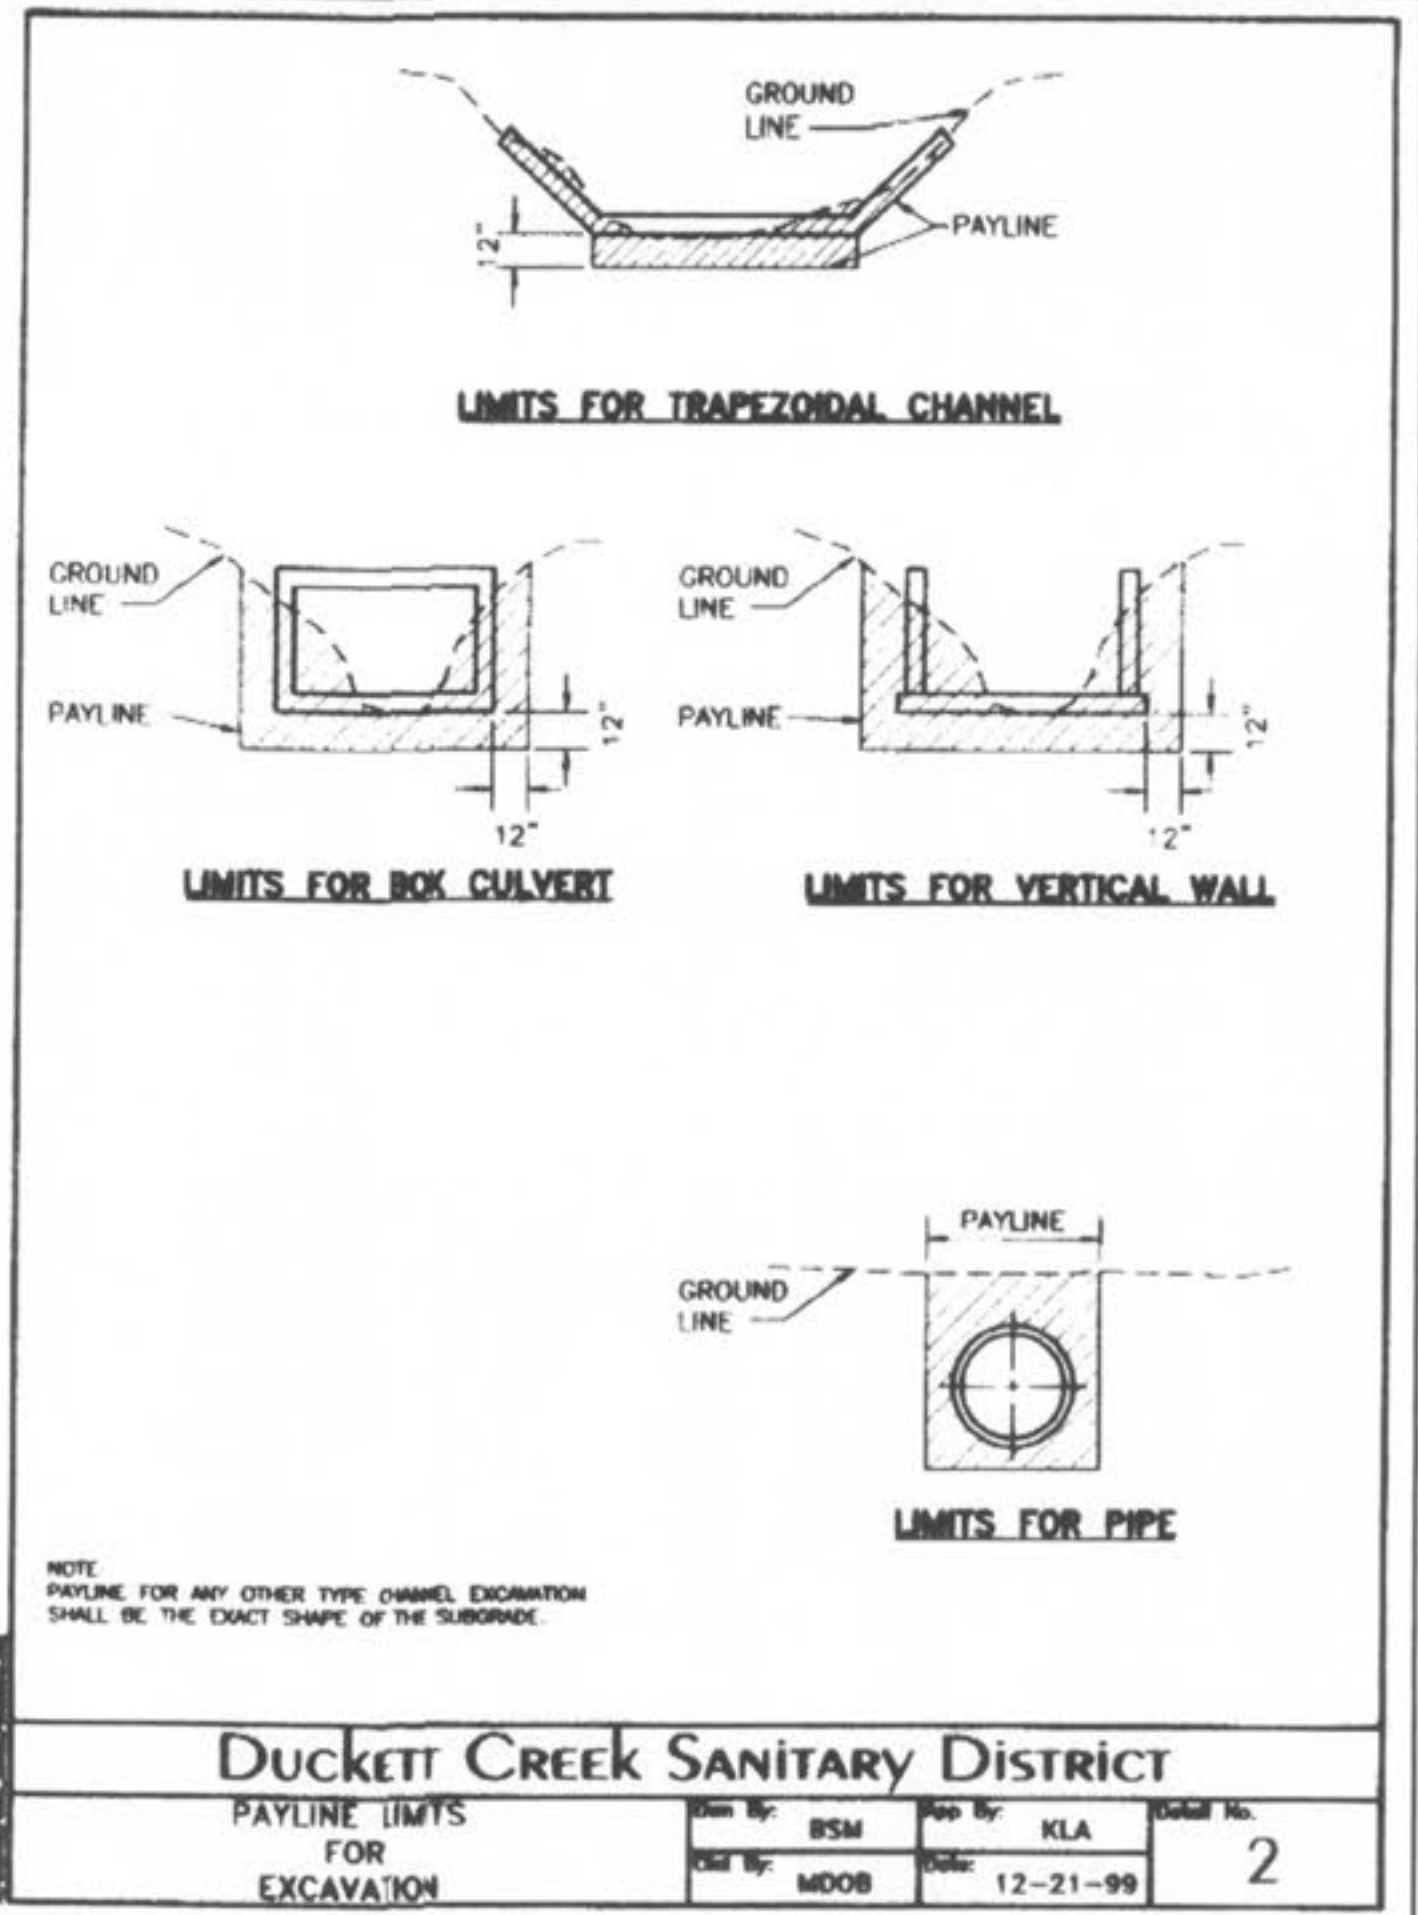

PICKETT RAY & SILVER
333 Mid Rivers Mall Drive
St. Peters, MO 63376
Phone (636) 397-1211
Fax (636) 397-1104

**CIVIL ENGINEERS
PLANNERS
LAND SURVEYORS**

**WYNDGATE
DUCKETT CREEK
SANITARY SEWER DETAILS**

29 FOX HILL ROAD
SUMMIT POINTE, MD. 03301
(636) 940-9300

Prepared For:
SUMMIT POINTE, L.C.



REVISIONS	NO.	DATE	REVISION PER CITY OF FALCON
	1	10/25/04	
	6	02/18/06	

ENGINEERS AUTHENTICATION
The responsibility for professional engineering liability on this project is hereby limited to the set of plans authenticated by the seal, signature, and date hereunder attached. Responsibility is disclaimed for all other engineering plans involved in this project and specifically excludes revisions after this date unless reauthenticating.

PICKETT, RAY & SILVER, INC.

DRAWN	J.E.E.	DATE	6-29-04
CHECKED	D.W.D.	DATE	6-29-04


PROJECT # 01267.SUPO.02R
TASK # 2 FIELD BOOK

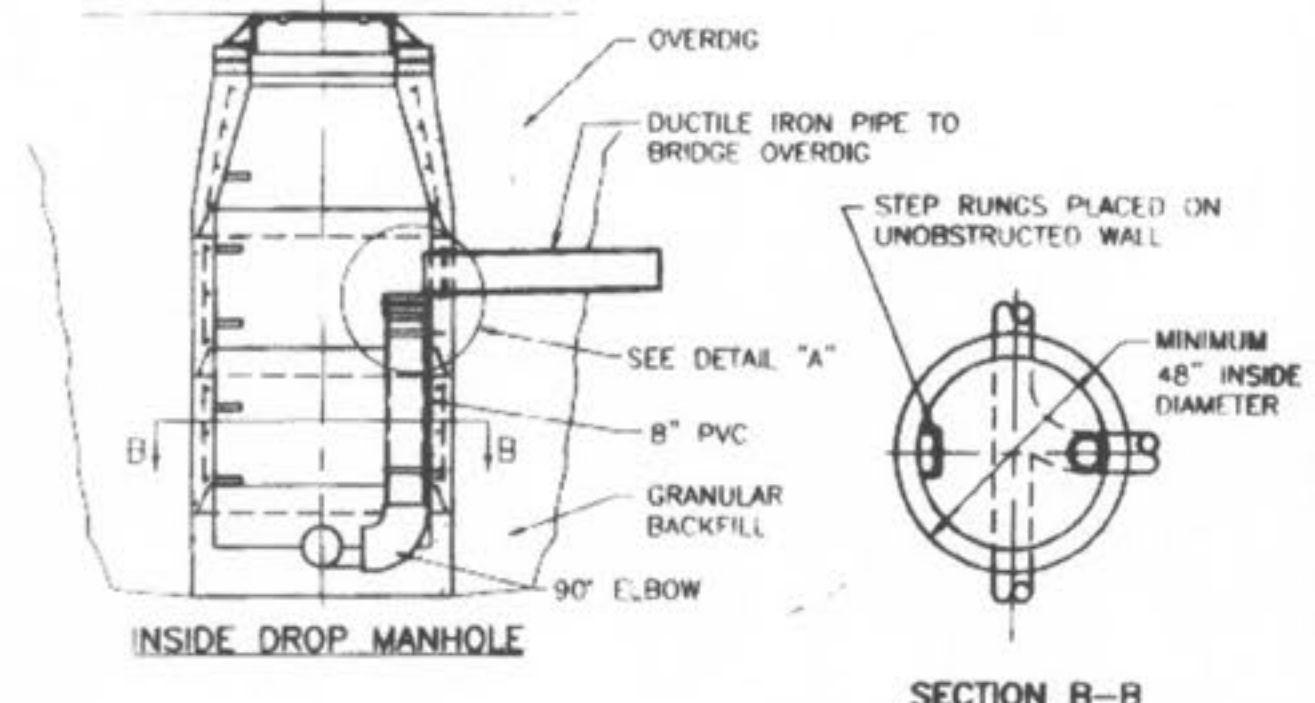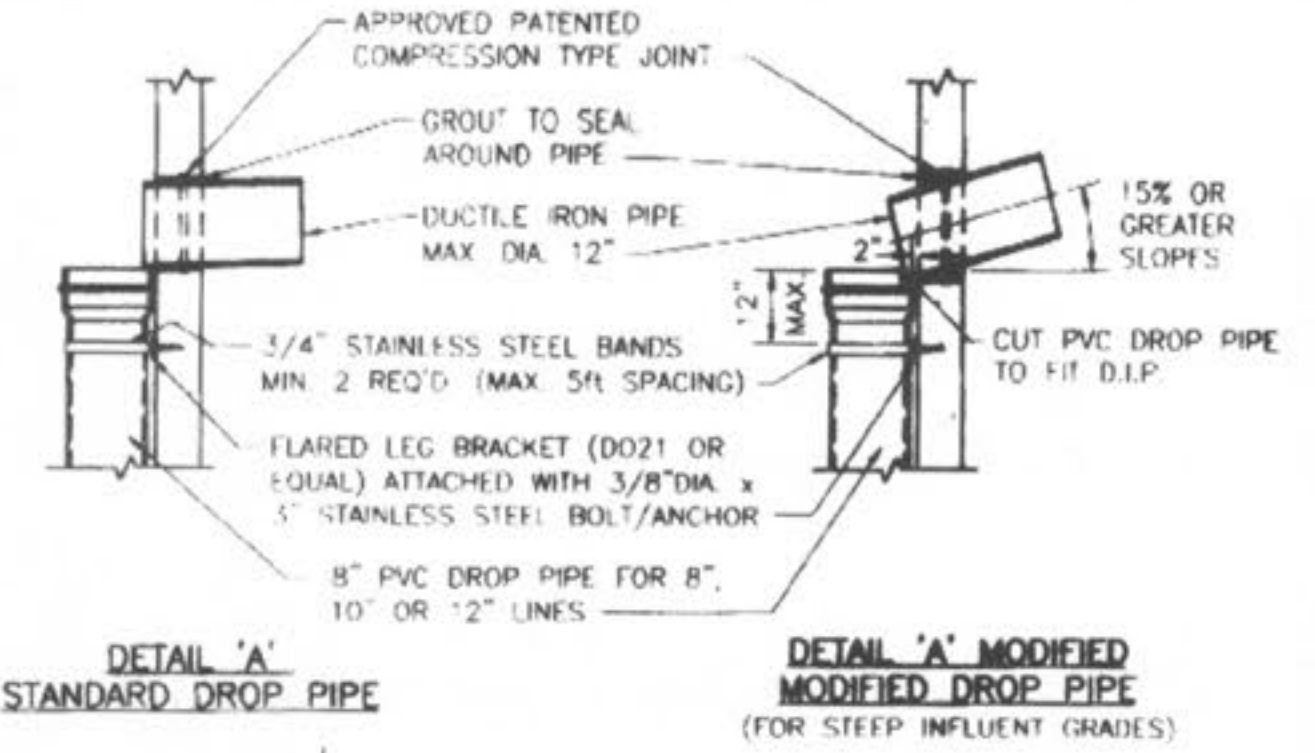


NOTE:
ALL INVERTS SHALL HAVE POSITIVE DRAINAGE THROUGH MANHOLE.

DUCKETT CREEK SANITARY DISTRICT

INSIDE DROP MANHOLE	Drawn By: BSM	App'd By: KLA	Detail No. 10
	Check'd By: MDOB	Date: 01-10-00	

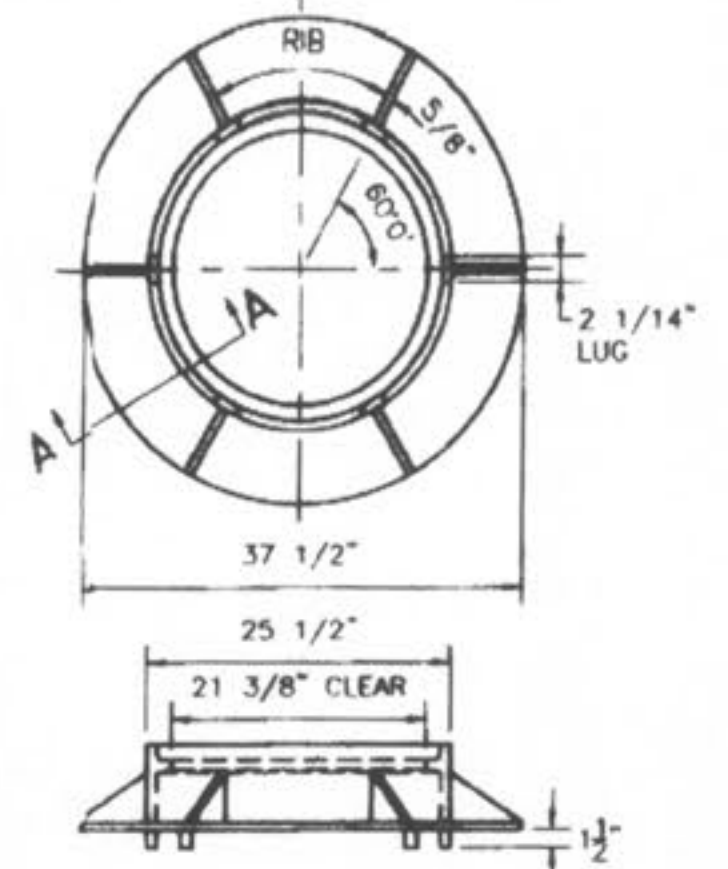

CAST IRON MANHOLE FRAME

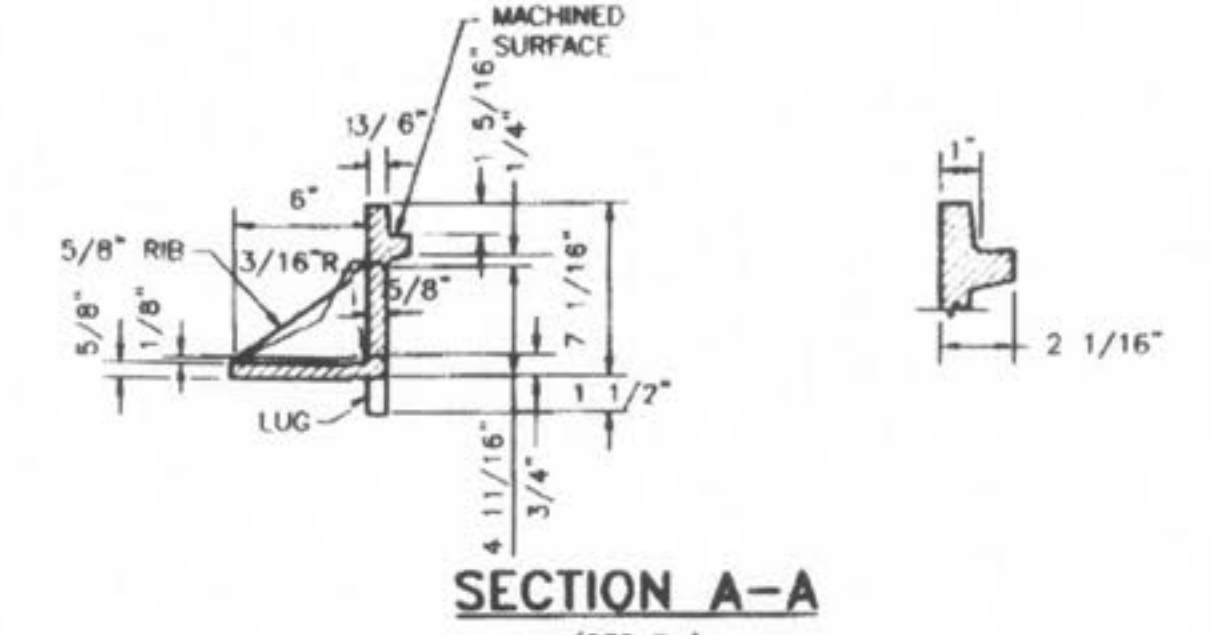


SECTION A-A

(230 lbs)

DUCKETT CREEK SANITARY DISTRICT


CAST IRON MANHOLE FRAME	Drawn By: BSM	App'd By: KLA	Detail No. 11
	Check'd By: MDOB	Date: 01-14-00	

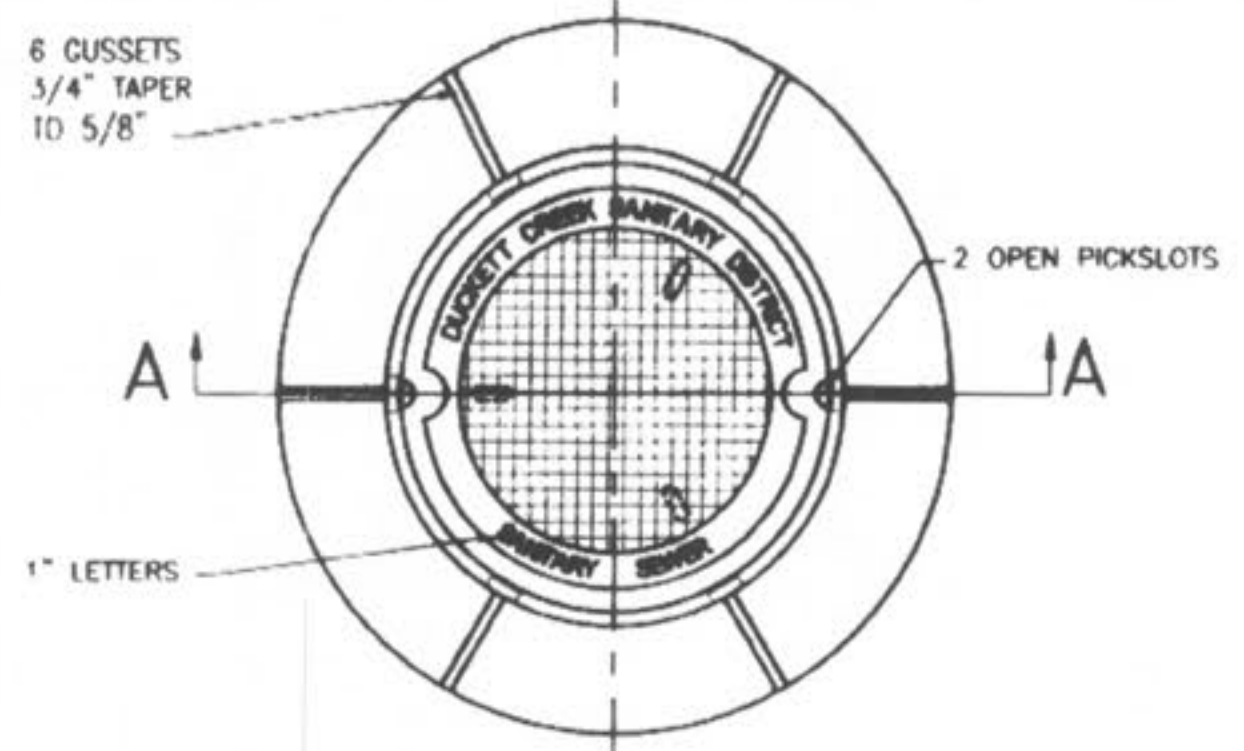


SECTION A-A

DUCKETT CREEK SANITARY DISTRICT

MANHOLE FRAME AND COVER	Drawn By: BSM	App'd By: KLA	Detail No. 12
	Check'd By: MDOB	Date: 01-14-00	

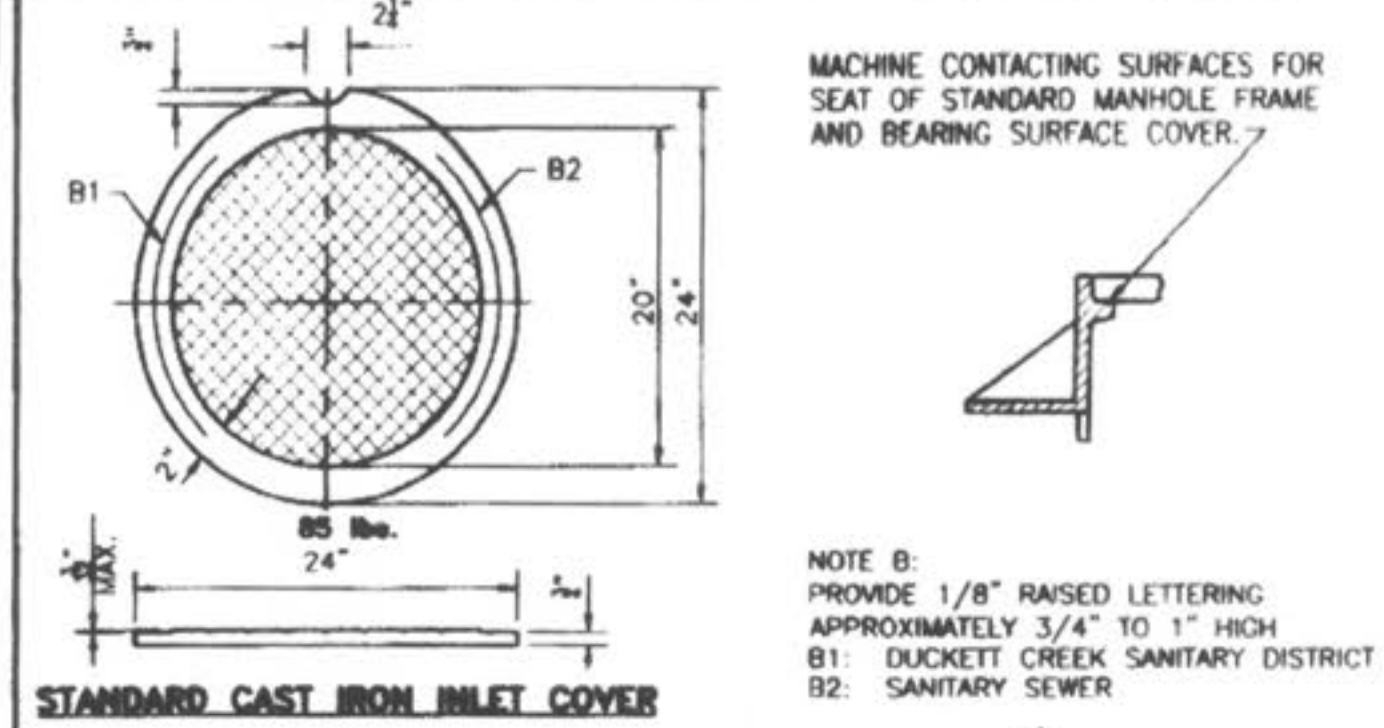


STANDARD CAST IRON INLET COVER

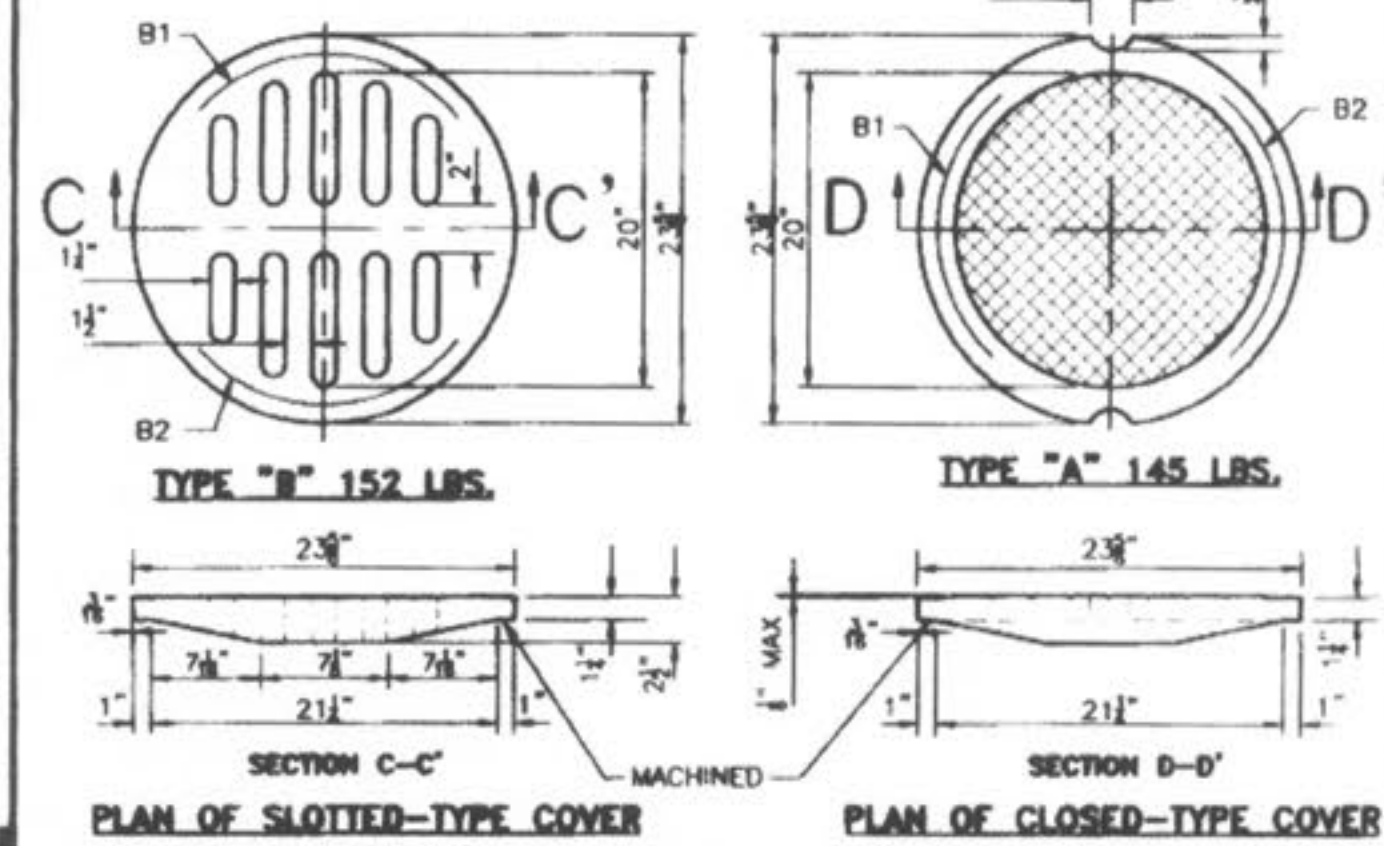

STANDARD CAST IRON MANHOLE COVERS


DUCKETT CREEK SANITARY DISTRICT

CAST IRON COVERS MANHOLES AND INLETS	Drawn By: BSM	App'd By: KLA	Detail No. 13
	Check'd By: MDOB	Date: 12-22-00	

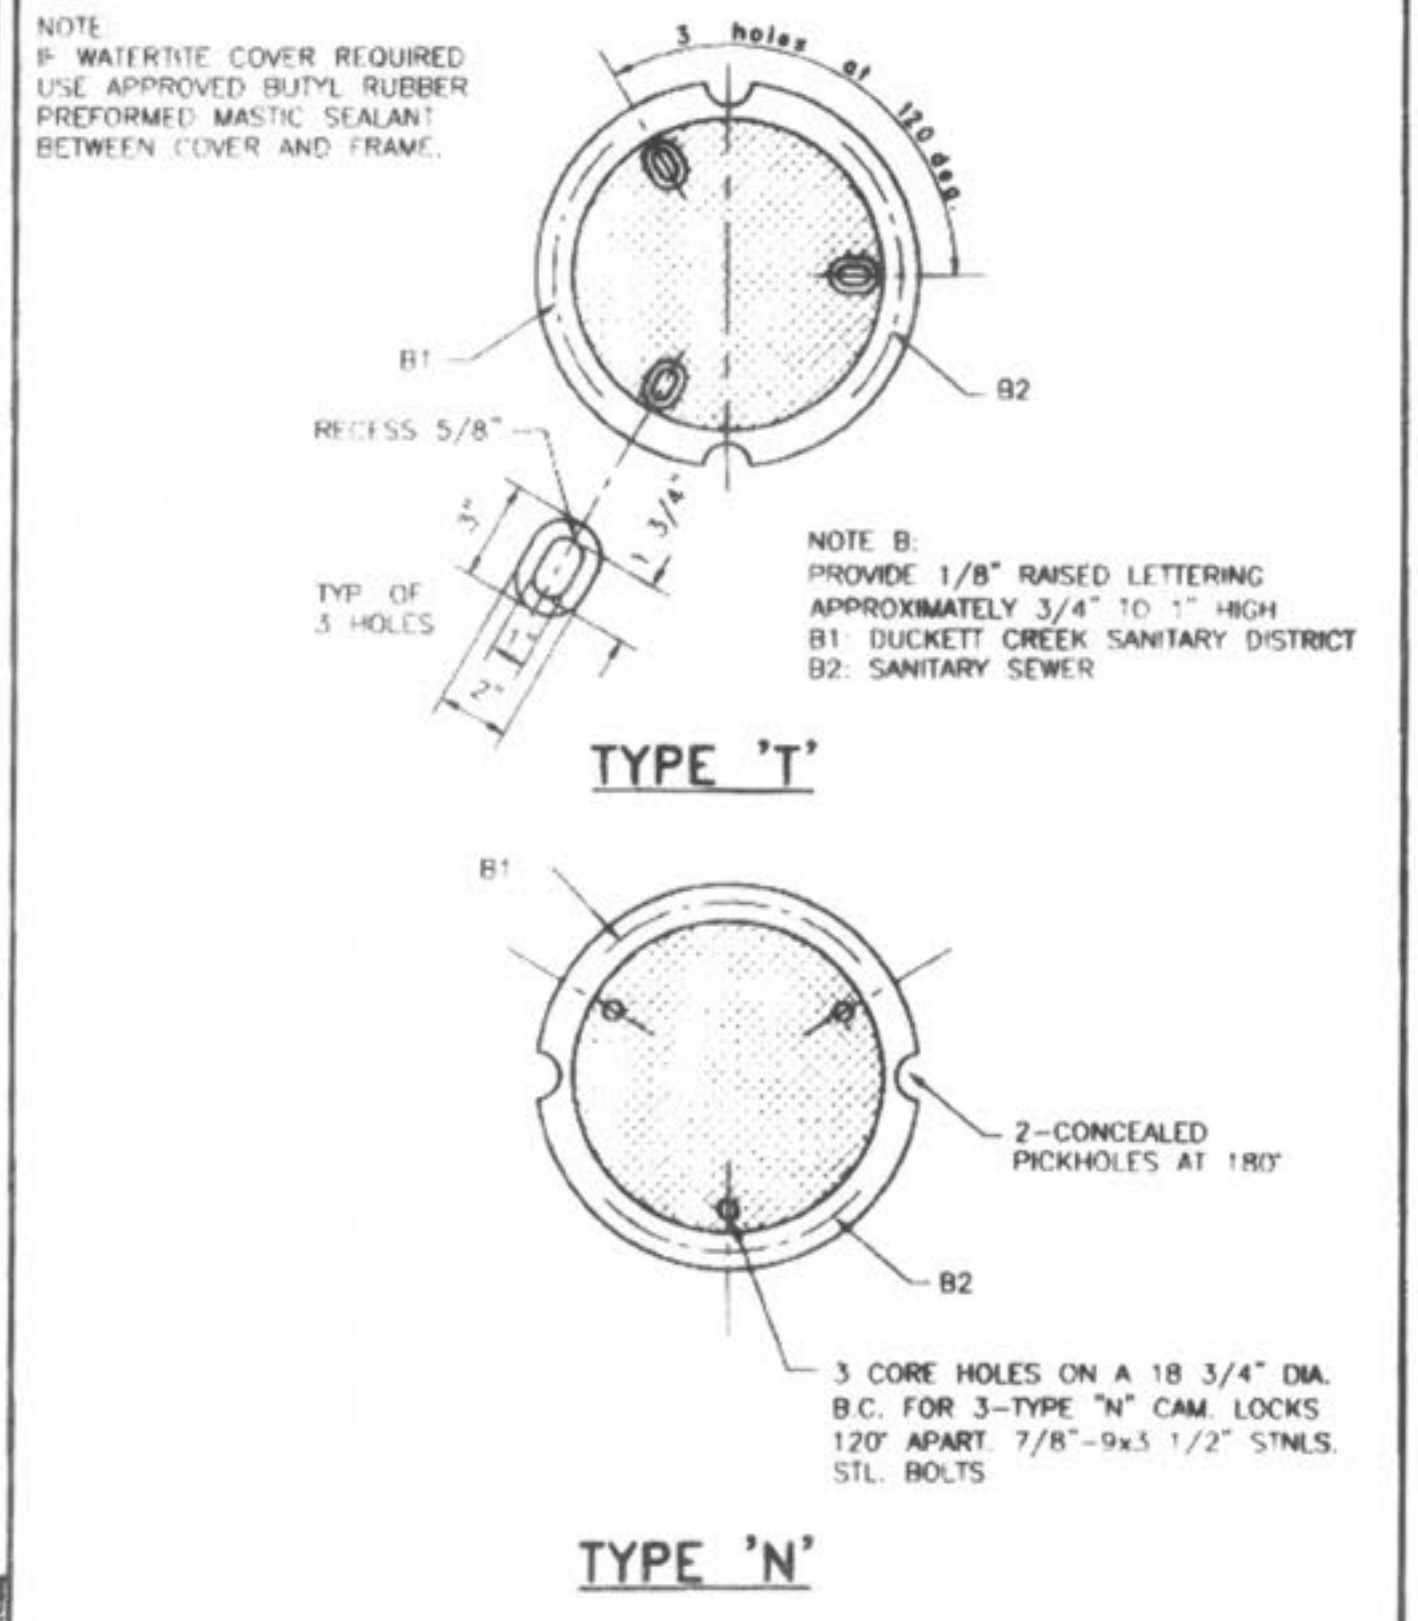


DUCKETT CREEK SANITARY DISTRICT

CAST IRON MANHOLE COVERS (LOCK TYPE)	Drawn By: BSM	App'd By: KLA	Detail No. 14
	Check'd By: MDOB	Date: 12-27-00	

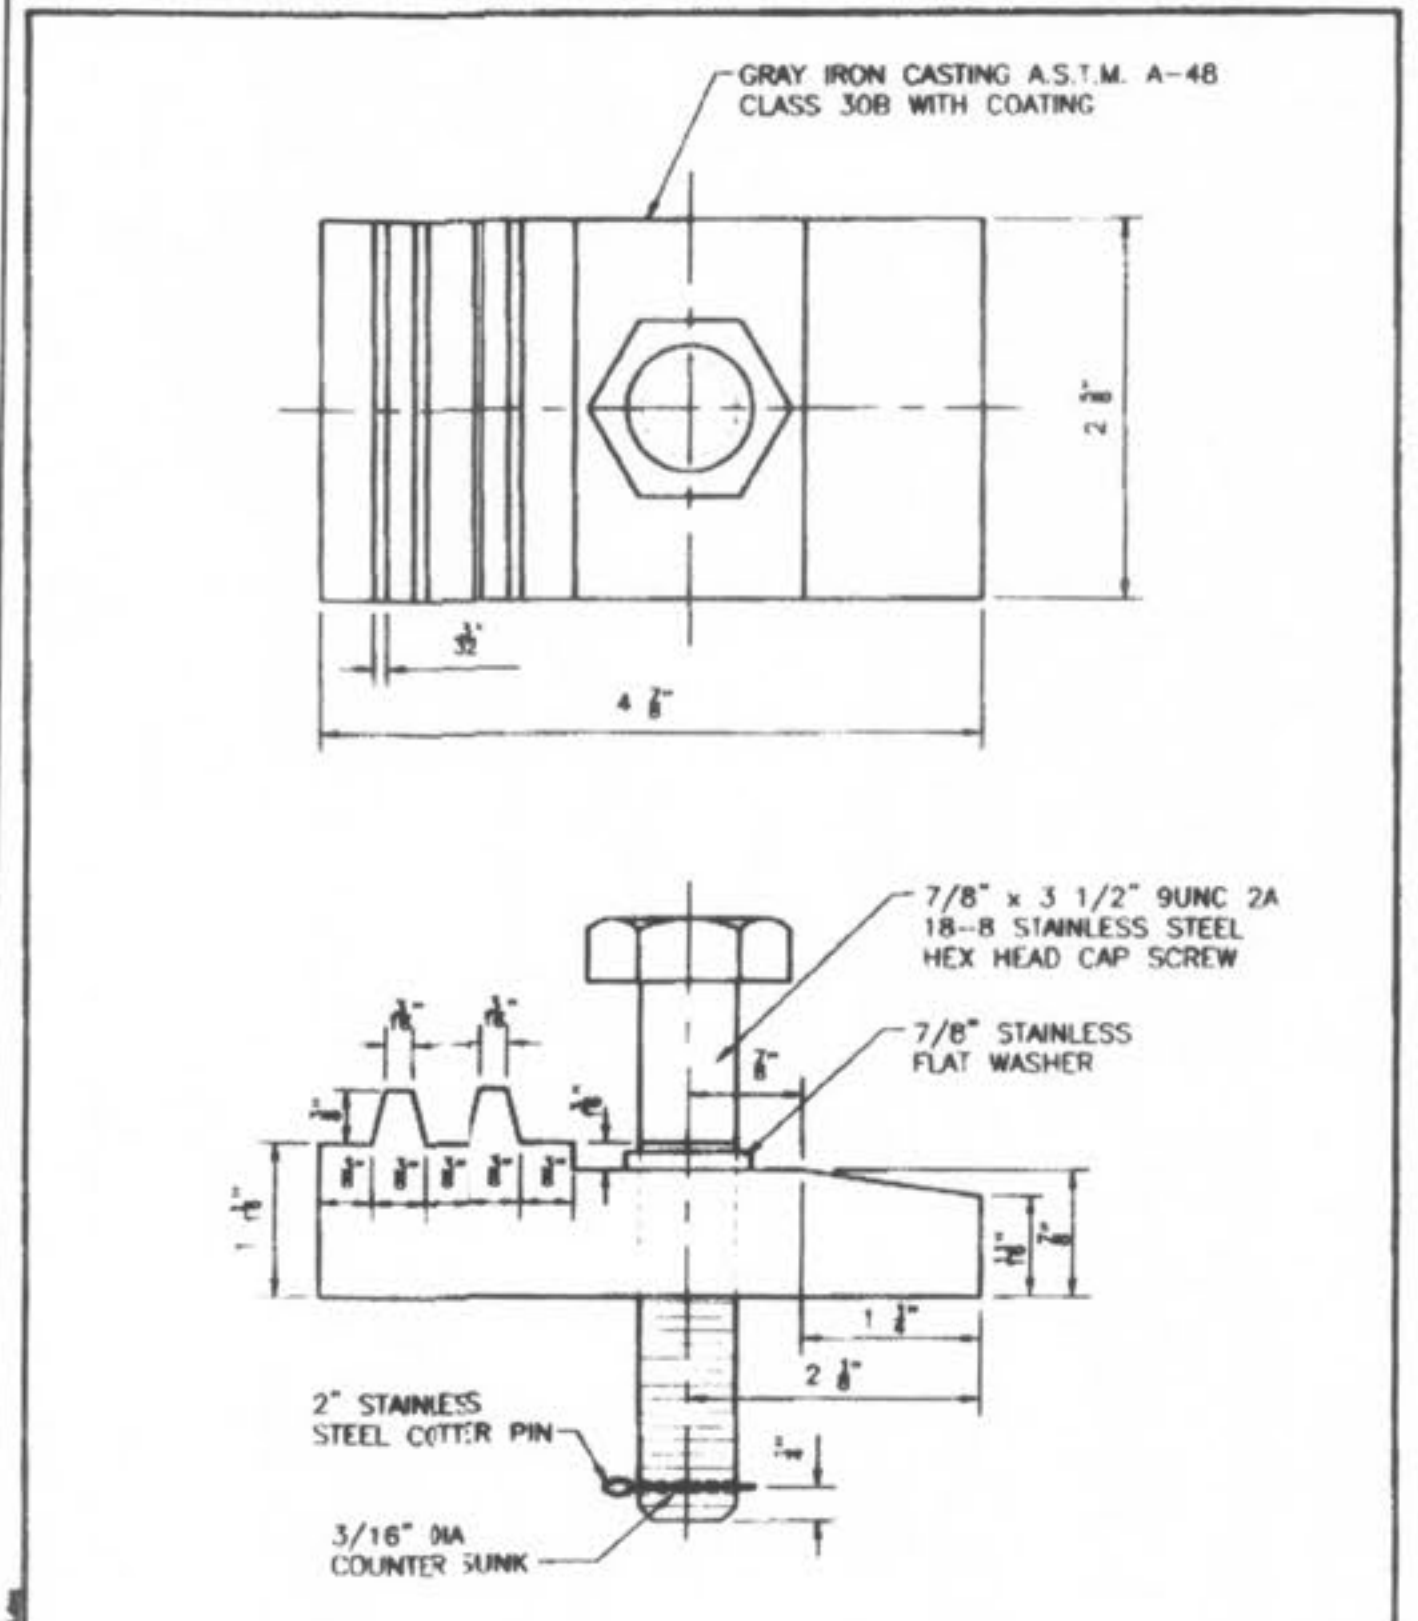


DUCKETT CREEK SANITARY DISTRICT

LOCKING DEVICE FOR TYPE "T" LOCK TYPE MANHOLE COVER	Drawn By: BSM	App'd By: KLA	Detail No. 15
	Check'd By: MDOB	Date: 12-27-00	

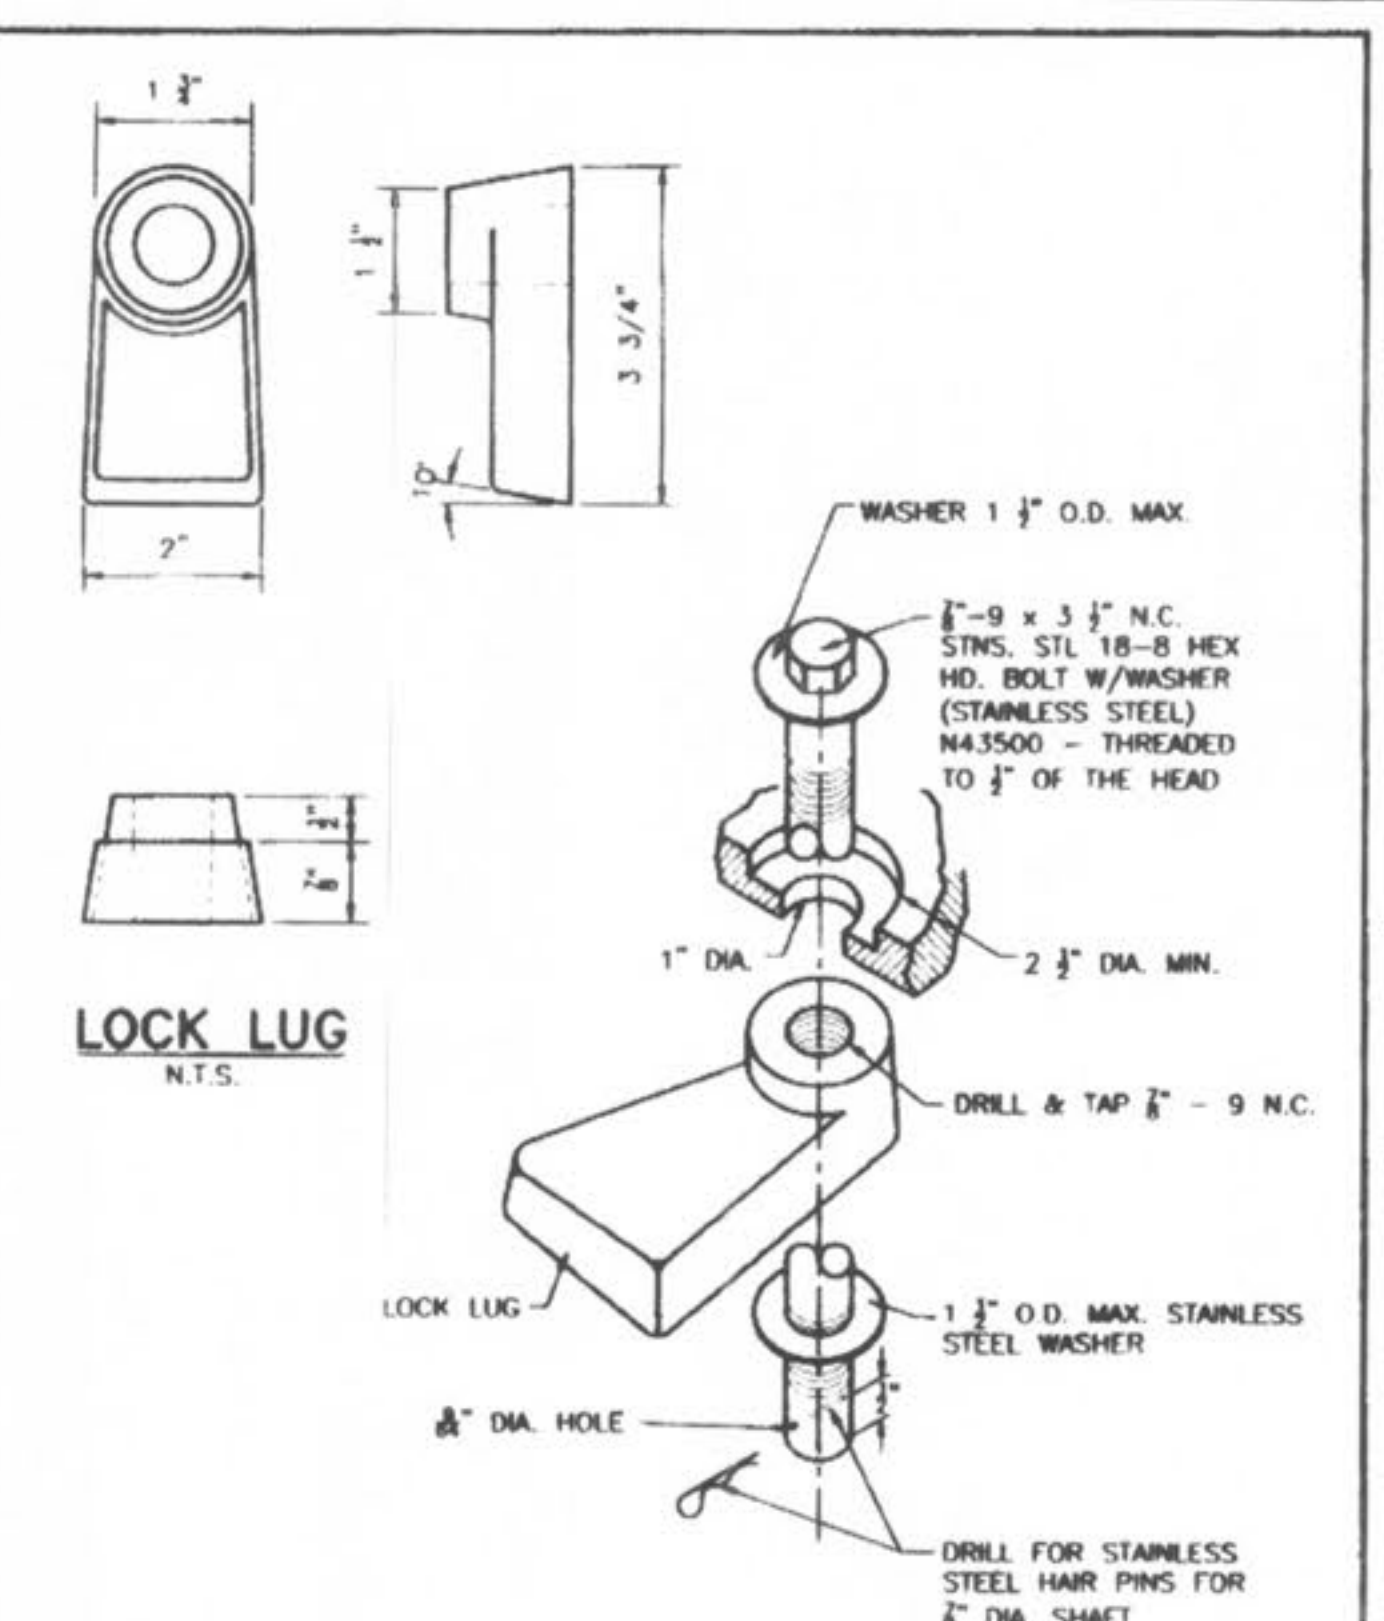

DUCKETT CREEK SANITARY DISTRICT

LOCKING DEVICE FOR TYPE "M" LOCK TYPE MANHOLE COVER	Drawn By: BSM	App'd By: KLA	Detail No. 16
	Check'd By: MDOB	Date: 12-28-00	

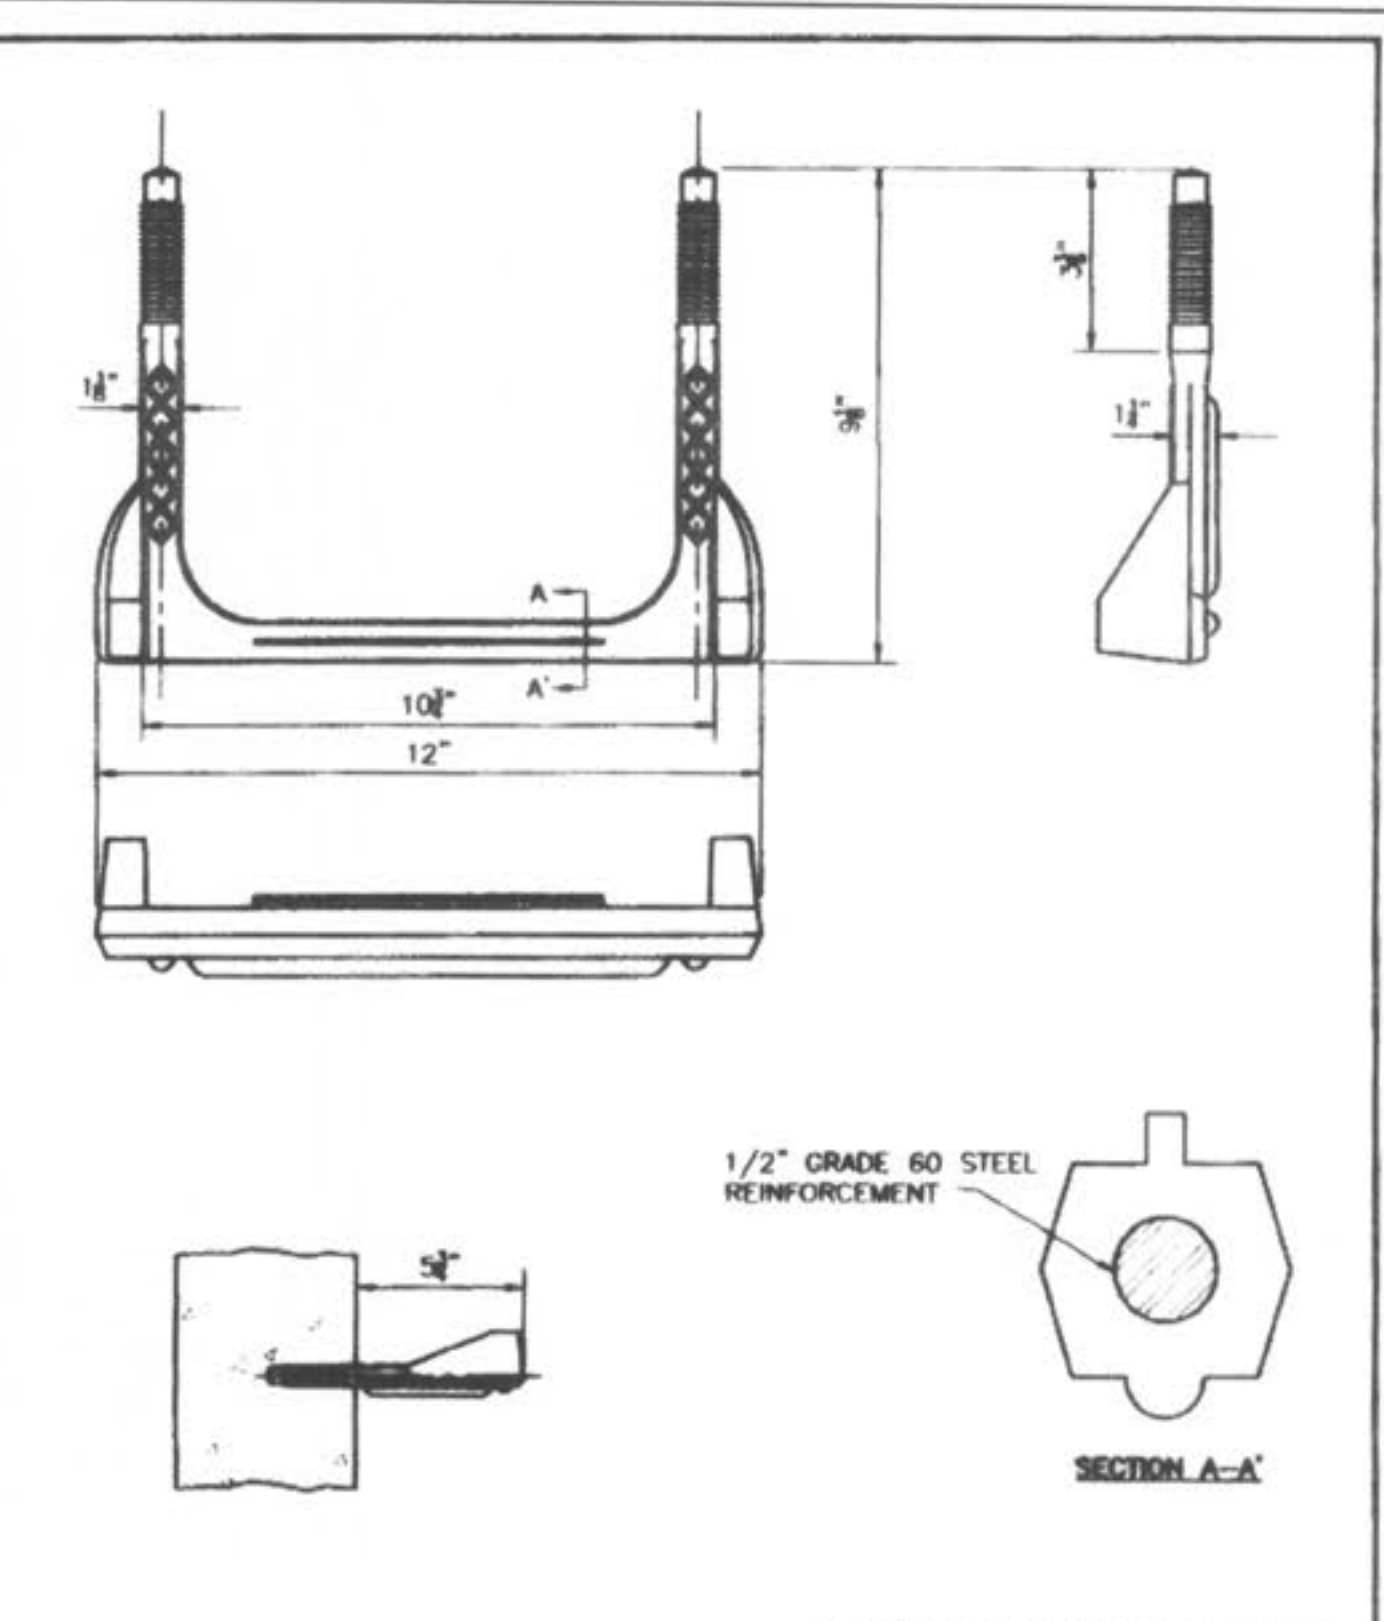

DUCKETT CREEK SANITARY DISTRICT

MANHOLE STEP PRECAST MANHOLE	Drawn By: BSM	App'd By: KLA	Detail No. 18
	Check'd By: MDOB	Date: 1-3-01	

PICKETT RAY & SILVER
CIVIL ENGINEERS
PLANNERS
LAND SURVEYORS
333 Mid Rivers Mall Drive
St. Peters, MO 63376
Phone (636) 397-1211
Fax (636) 397-1104

WYNDGATE
DUCKETT CREEK
SANITARY SEWER DETAILS
Prepared For:
SUMMIT POINTE, L.C.
239 FOX HILL ROAD
ST. CHARLES, MO. 63301
(636) 940-9500

REVISIONS	NO.	DATE	REVISED PER CITY	REVISED PER CITY OF TALLON
	1	10/25/04		
	2	02/25/05		

ENGINEERS AUTHENTICATION
The responsibility for professional engineering liability on this project is hereby limited to the set of plans authenticated by the seal, signature, and date hereunder attached. Responsibility is disclaimed for all other engineering plans involved in this project and specifically excludes revisions after this date unless reauthenticated.
PICKETT, RAY & SILVER, INC


DRAWN	J.E.E.	DATE	6-29-04
CHECKED	D.W.D.	DATE	6-29-04
PROJECT #	01267.SUPO.02R	TASK #	2
		FIELD BOOK	

WYNDGATE
DUCKETT CREEK
SANITARY SEWER DETAILS
SHEET 166 OF 174
© Copyright 2004 by Pickett, Ray & Silver, Inc.

JAMES R. CHARLES
Professional Engineer
15-2311
2-3-06

U:\servicers\Projects\01267.dwg\01267DLS.dwg, 12/13/2006 9:18:28 AM, GARY MEYER

SDR-35 x C900
BELL & SPIGOT ADAPTERS

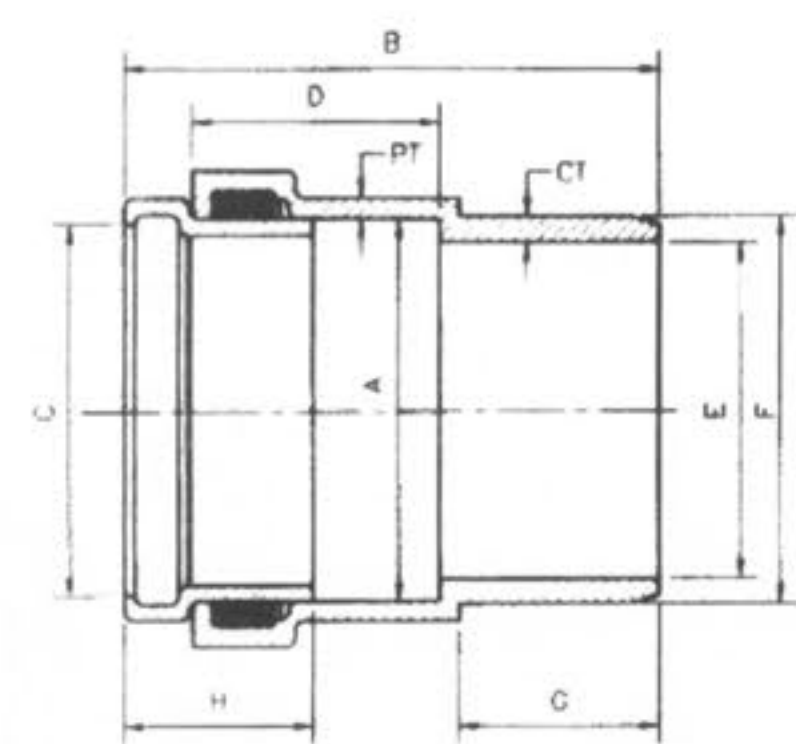


SIZE	CATALOG NO.	A	B	C	D	E	F	G	H	CT	PT
4"	334-040	4.56	8.23	4.25	4.10	3.94	4.80	2.72	2.7	.32	.25
6"	334-060	6.68	9.93	6.31	4.57	5.88	6.90	3.72	3.5	.45	.36

DUCKETT CREEK SANITARY DISTRICT

SDR-35 x C900
BELL AND SPIGOT
ADAPTERS

Drawn By: BSM	App. By: KLA	Detail No.
Check By: MDOB	Date: 1-3-01	19A

SDR-35 x C900
BELL & SPIGOT ADAPTERS

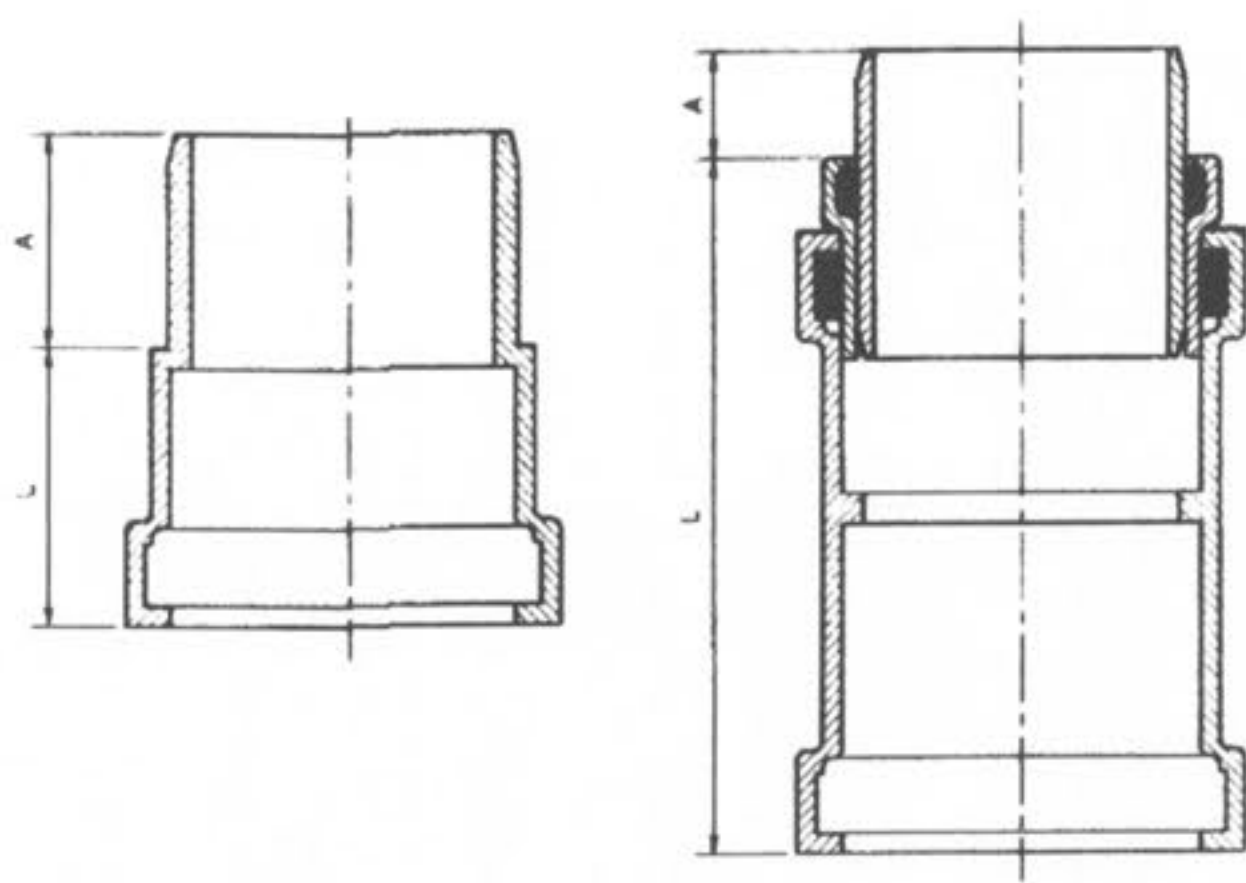


SIZE	CATALOG NO.	A	L	STYLE
4"	335-040	3.2	10.0	FABRICATED
6"	335-060	2.9	3.5	HARCO
8"	335-080	4.0	12.5	FABRICATED

DUCKETT CREEK SANITARY DISTRICT

SDR-35 x C900
BELL AND SPIGOT
SPECIAL 4", 6" & 8" ADAPTERS

Drawn By: BSM	App. By: KLA	Detail No.
Check By: MDOB	Date: 1-3-01	19B

SDR-35 x C900
BELL & BELL ADAPTERS

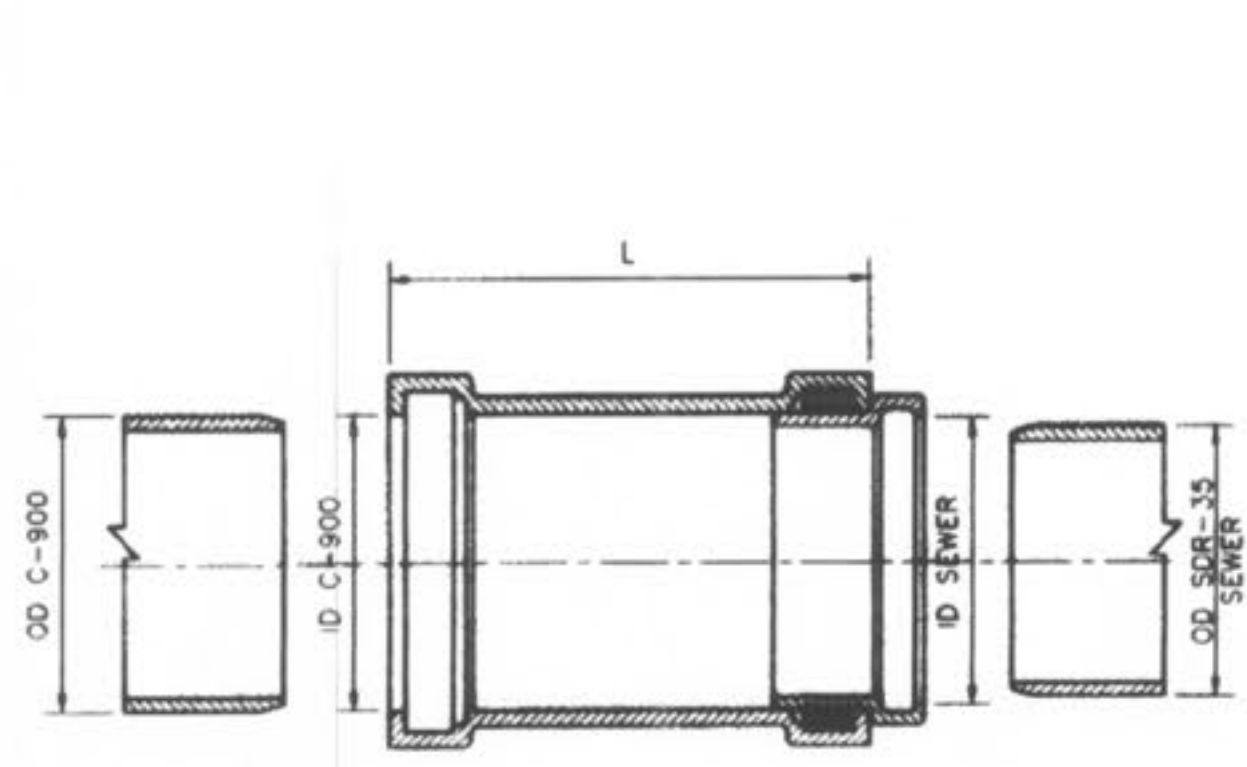


SIZE	CATALOG NO.	OD C900	OD SEWER	ID C900	ID SEWER	L	CTN QTY	CTN WT
4x4	337-040	4.80	4.215	4.88	4.25	10.0	1	4
6x6	337-060	6.90	6.275	6.96	6.32	11.13	1	8
8x8	337-080	9.05	8.400	9.13	8.45	12.50	1	15

DUCKETT CREEK SANITARY DISTRICT

SDR-35 x C900
BELL AND BELL
4", 6" & 8" ADAPTERS

Drawn By: BSM	App. By: KLA	Detail No.
Check By: MDOB	Date: 1-3-01	19C

PLASTIC SADDLE WYE OR WYE FITTING
(SOLVENT WELD)

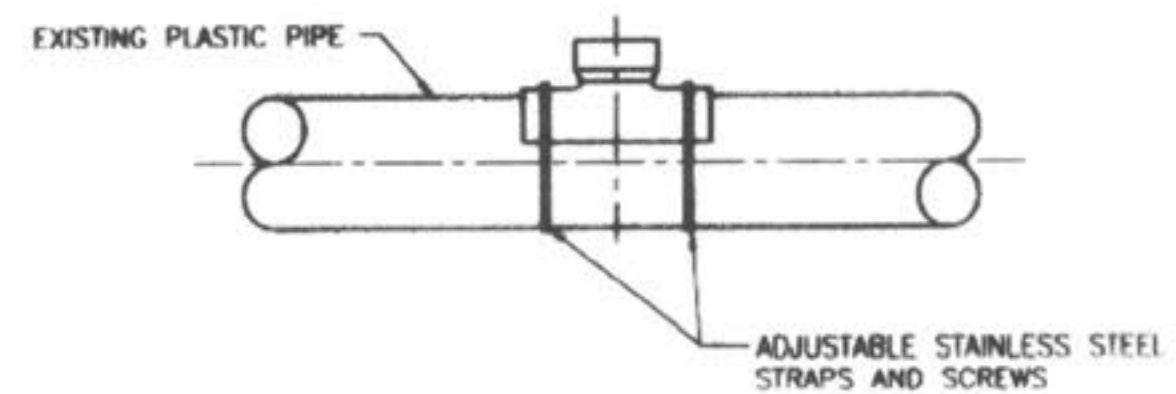

WHEN CONNECTION TO A PLASTIC PIPE IS ALLOWED AND A CONNECTION IS LARGER THAN 6" IN DIAMETER, A SOLVENT WELD WYE OR TEE FITTING OF A SIMILAR MATERIAL MUST BE USED (EXAMPLE: 10" x 8"). THIS IS ACCOMPLISHED BY CAREFULLY CUTTING A HOLE WITH A SAW IN THE MAIN AT THE REQUIRED LOCATION AFTER CUTTING AND SHAPING THE HOLE TO THE SIZE OF THE FITTING. THE FOLLOWING STEPS SHOULD BE TAKEN:


- CLEAN AND DRY BOTH INSIDE THE SADDLE WYE SURFACE AND PIPE SURFACE TO BE SOLVENT CEMENTED.
- IMPORTANT: APPLY A LIBERAL, HEAVY COAT OF ONE-STEP SOLVENT CEMENT TO THE INSIDE SURFACE OF THE SADDLE WYE AND TO THE EXTERIOR WELDING SURFACE TO THE PIPE.
- WITHOUT DELAY, MATE THE SURFACES AND STRAP DOWN TIGHTLY. A BEAD OF SOLVENT SHOULD APPEAR AFTER THE SADDLE HAS BEEN STRAPPED DOWN TIGHTLY.
- USING A RAG OR PAPER TOWEL, WIPE BEAD AND ANY EXCESS SOLVENT CEMENT OFF PIPE AND SADDLE.
- ALLOW 30-60 MINUTES FOR SET-UP TIME BEFORE BACKFILLING. CURE TIME DEPENDS ON SIZE FIT OF MATERIALS BEING INSTALLED AND VARIOUS COLD DAMP CONDITIONS.
- DISCARD OLD SOLVENT IF IT BECOMES JELLED OR LUMPY.
- A CLEAN, DRY BEDDING MATERIAL IS REQUIRED AROUND THE COMPLETED CONNECTION BEFORE BACKFILLING. THE BEDDING MATERIAL SHOULD BE ONE OF THE FOLLOWING:
 - A. 1 TO 3 CEMENT TO SAND MIX
 - B. "TINE-MIX" CONCRETE
 - C. DCSD APPROVED BEDDING FOR SANITARY SEWERS

DUCKETT CREEK SANITARY DISTRICT

8" & LARGER
CONNECTION TO
PLASTIC MAIN

Drawn By: BSM	App. By: KLA	Detail No.
Check By: MDOB	Date: 1-4-01	20A

INSERTA TEE
THE USE OF AN INSERTA TEE
REQUIRES DISTRICT APPROVAL.

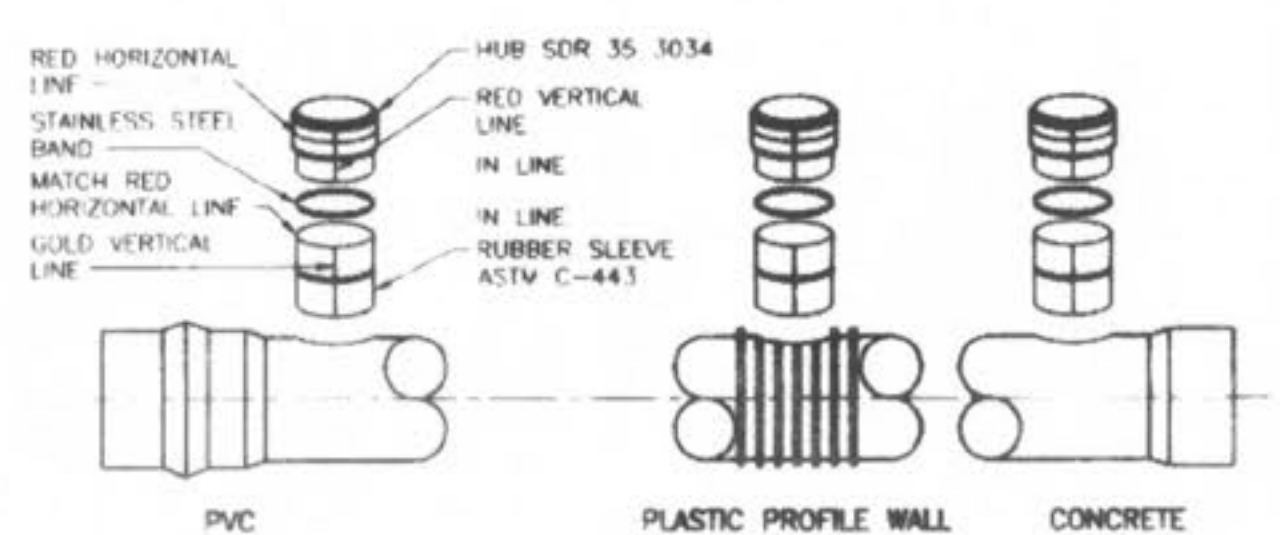


- INSTALLATION PROCEDURE:
- CORE THE PROPER SIZE HOLE. TEE SIZE: 4" 6" 8" 10" 12" 15". BIT SIZE: 4 1/4" 6 1/4" 8 1/4" 10 1/4" 12 1/4" 15 1/4"
 - INSERT THE RUBBER SLEEVE (1) IN THE CORED HOLE WITH THE GOLD VERTICAL LINE ON THE RUBBER SLEEVE (2) FACING TO THE SIDE OF THE MAIN LINE. THE UPPER SEGMENT SHOULD BE ON TOP OF THE WALL OR THE LOWER SEGMENT (PVC, PROFILE WALL, AND POLYETHYLENE PIPE ONLY) SHOULD BE ON THE INSIDE OF THE TEE.
 - APPLY THE INSERTA TEE SOLUTION SUPPLIED TO THE INSIDE OF THE RUBBER SLEEVE AND TO THE OUTSIDE OF THE PVC HUB ADAPTER. CAUTION - DO NOT USE AN OIL-BASED LUBRICANT.
 - PLACE THE PVC HUB ADAPTER (3) INTO THE RUBBER SLEEVE. MAKE SURE THAT THE RED VERTICAL LINE (4) ON THE PVC HUB ADAPTER IS IN LINE WITH THE GOLD VERTICAL LINE (2) ON THE RUBBER SLEEVE.
 - PLACE THE 2x4 BOARD ON TOP OF THE PVC HUB ADAPTER.
 - THE RED HORIZONTAL LINE (5) AT THE TOP OF THE HUB ADAPTER IS A DEPTH MARK. THIS TELLS THE INSTALLER HOW FAR TO DRIVE THE ADAPTER INTO THE RUBBER SLEEVE. DRIVE THE PVC HUB ADAPTER INTO THE RUBBER SLEEVE TO WHERE THE HORIZONTAL RED LINE (5) ON THE PVC HUB ADAPTER (3) MEETS THE TOP OF THE RUBBER SLEEVE (2).
 - PLACE THE STAINLESS STEEL BAND (7) AROUND THE TOP OF THE RUBBER SLEEVE AND TIGHTEN DOWN.
 - INSTALL PIPE IN NORMAL MANNER.

DUCKETT CREEK SANITARY DISTRICT

INSERTA TEE
DETAILS AND
SPECIFICATIONS

Drawn By: BSM	App. By: KLA	Detail No.
Check By: MDOB	Date: 1-4-01	20B

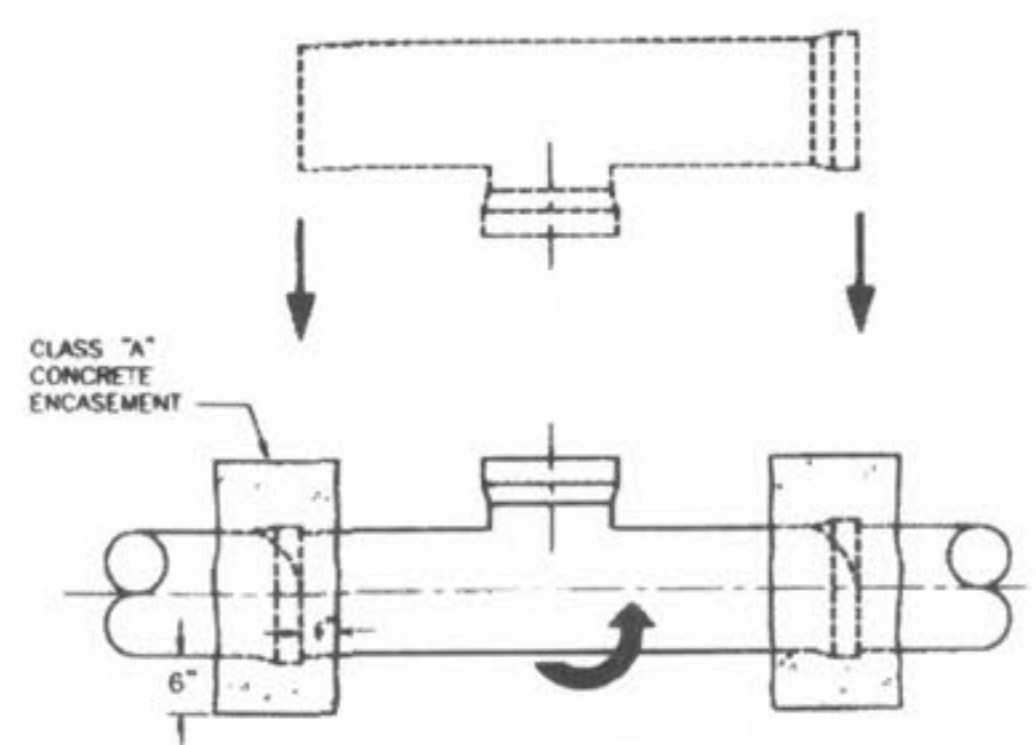


- NOTES:
- WHEN A CONNECTION IS ALLOWED LARGER THAN 6" DIAMETER A SADDLE MAY BE USED IF THE I.D. OF THE CONNECTION PIPE IS NOT GREATER THAN ONE HALF (1/2) OF THE I.D. OF THE MAIN SEWER. (EXAMPLE: 24" x 10")
 - IF THE I.D. OF THE CONNECTION PIPE IS GREATER THAN ONE HALF (1/2) THE I.D. OF THE MAIN SEWER THE WYE OR TEE MUST BE "ROLL-IN" (EXAMPLE: 15" x 8")
 - THIS IS ACCOMPLISHED BY BREAKING AWAY AND REMOVING ONE SECTION OF PIPE. THE TOP HALF OF THE BELL ON THE PIPE LYING ADJACENT TO THE GAP IS CAREFULLY BROKEN OFF. THE TOP HALF OF THE BELL ON THE MAIN REPLACEMENT SECTION (WITH A "TEE" WYE) FITTING IS ALSO BROKEN OFF. THE REPLACEMENT PIPE IS THEN PLACED IN THE LINE GAP WITH THE STUB POINTED IN THE WRONG DIRECTION. THE BROKEN BELLS ON THE REPLACEMENT AND ADJOINING PIPE MAKE IT POSSIBLE FOR THE REPLACEMENT SECTION TO FIT INTO THE SEWER LINE WITHOUT DISTURBING THE ADJOINING PIPE SECTIONS. THE REPLACEMENT SECTION IS THEN ROTATED TO THE DESIRED POSITION AND THE BROKEN BELLS ARE ENCASED WITH A 6" CLASS "A" CONCRETE ENCASEMENT.
 - I.D. OF MAIN SEWER SHALL NOT BE DECREASED BY A ROLL-IN CONNECTION.

DUCKETT CREEK SANITARY DISTRICT

"ROLL-IN"
(FOR EXISTING
CLAY OR CONCRETE PIPE)

Drawn By: BSM	App. By: KLA	Detail No.
Check By: MDOB	Date: 1-5-01	21

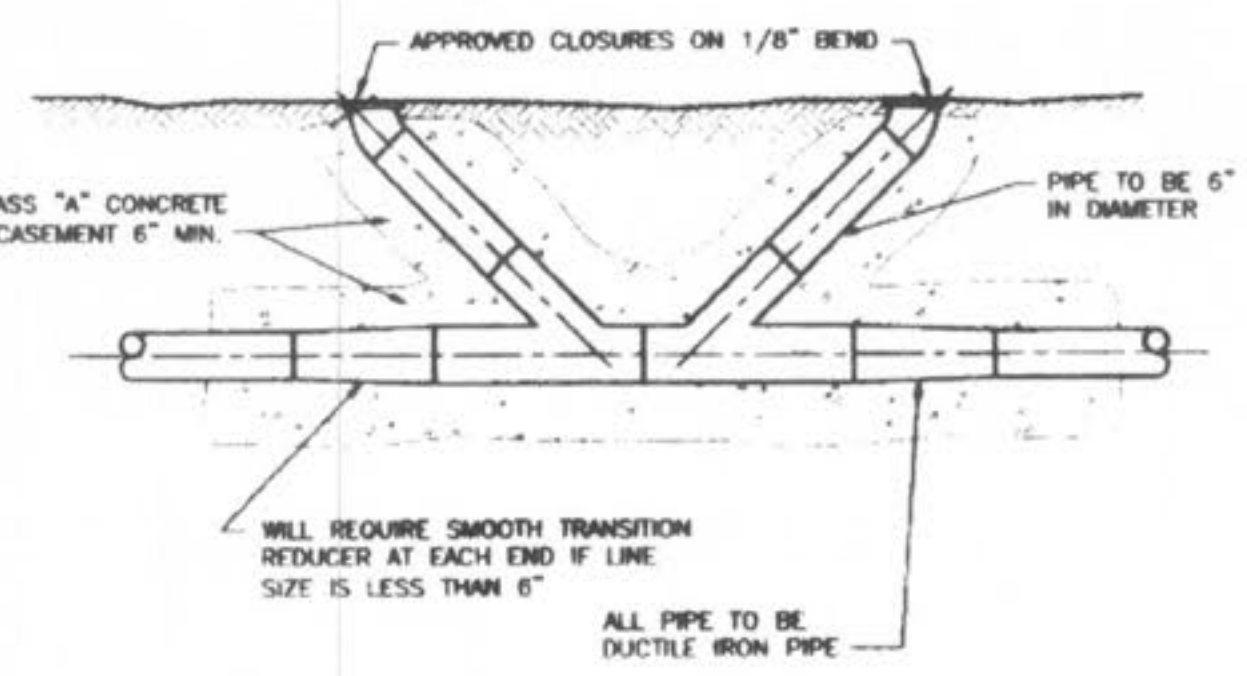


180' MAXIMUM SPACING

DUCKETT CREEK SANITARY DISTRICT


FORCE MAIN
CLEANOUT
(6" DIA. & SMALLER)

Drawn By: BSM	App. By: KLA	Detail No.
Check By: MDOB	Date: 1-5-01	22

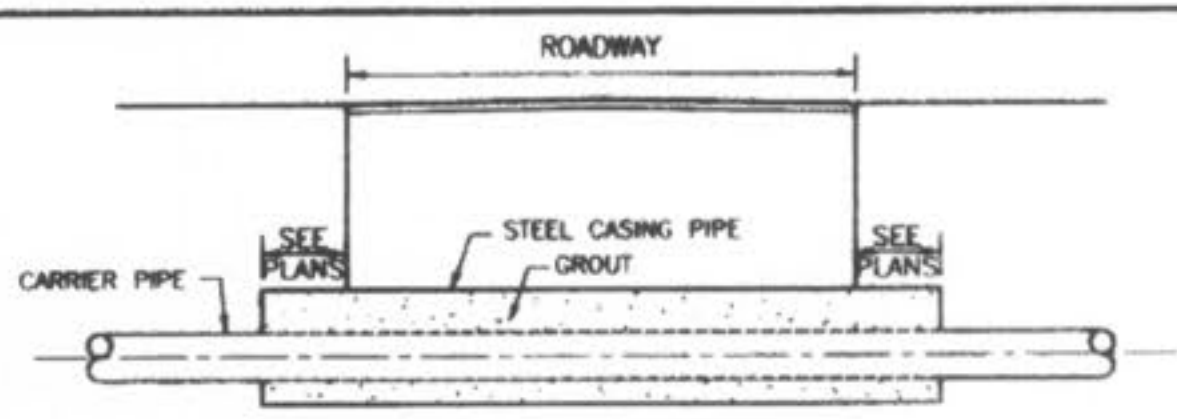


BORING DETAIL

- NOTES:
- INSIDE DIAMETER OF CASING PIPE TO BE MINIMUM OF 4" GREATER THAN COUPLING DIAMETER OF CARRIER PIPE.
 - ENCASEMENTS TO BE INSTALLED UNDER THE ROAD BY MEANS OF JACKING IT THROUGH, OR BY DRY BORING A HOLE THAT WILL RECEIVE THE CASING WITH A SNUG FIT.
 - THE OUTSIDE DIAMETER OF THE CASING SHALL NOT BE LESS THAN, NOR MORE THAN ONE INCH GREATER THAN THE BORED HOLE.
 - THE ANNULAR SPACE BETWEEN THE CASING PIPE AND THE BORED HOLE SHALL BE FILLED WITH GROUT.

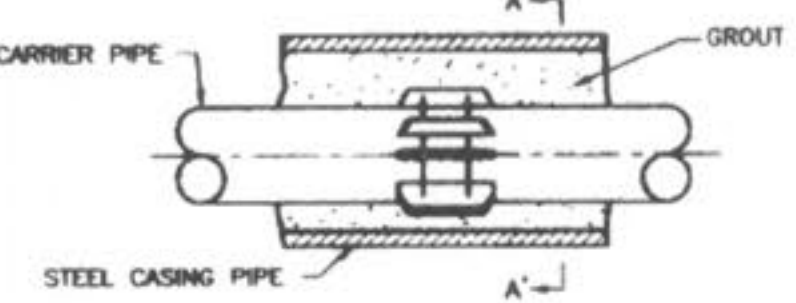

SUPPORT OF CARRIER PIPE OR FORCE MAIN IN CASING

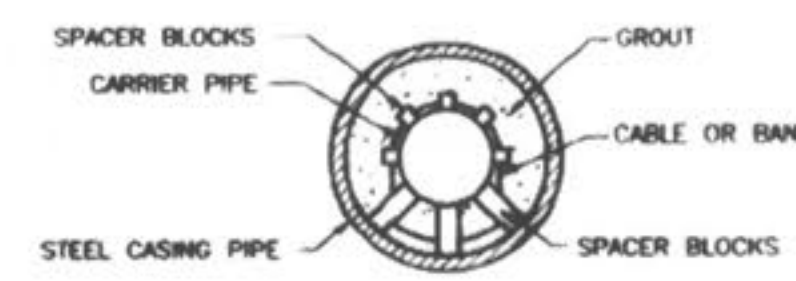

SECTION A-A'

DUCKETT CREEK SANITARY DISTRICT

ROADWAY
BORING
DETAIL


Drawn By: BSM	App. By: KLA	Detail No.
Check By: MDOB	Date: 1-5-01	23

REVISIONS	NO.	DATE	REVISED PER CITY	REVISED PER CITY OF OTTAWON
	1	10/25/04		
	6	02/19/05		

ENGINEERS AUTHENTICATION
The responsibility for professional engineering liability on this project is hereby limited to the set of plans authenticated by the seal, signature, and date hereunder attached. Responsibility is disclaimed for all other engineering plans involved in this project and specifically excludes revisions after this date unless reauthenticated.
PICKETT, RAY & SILVER, INC.

DRAWN	J.E.E.	DATE	6-29-04
CHECKED	D.W.D.	DATE	6-29-04
PROJECT #	01267.SUPO.02R	TASK #	2
		FIELD BOOK	


JAMES R. CHERRY
Professional Engineer
No. 15-211
6-3-06

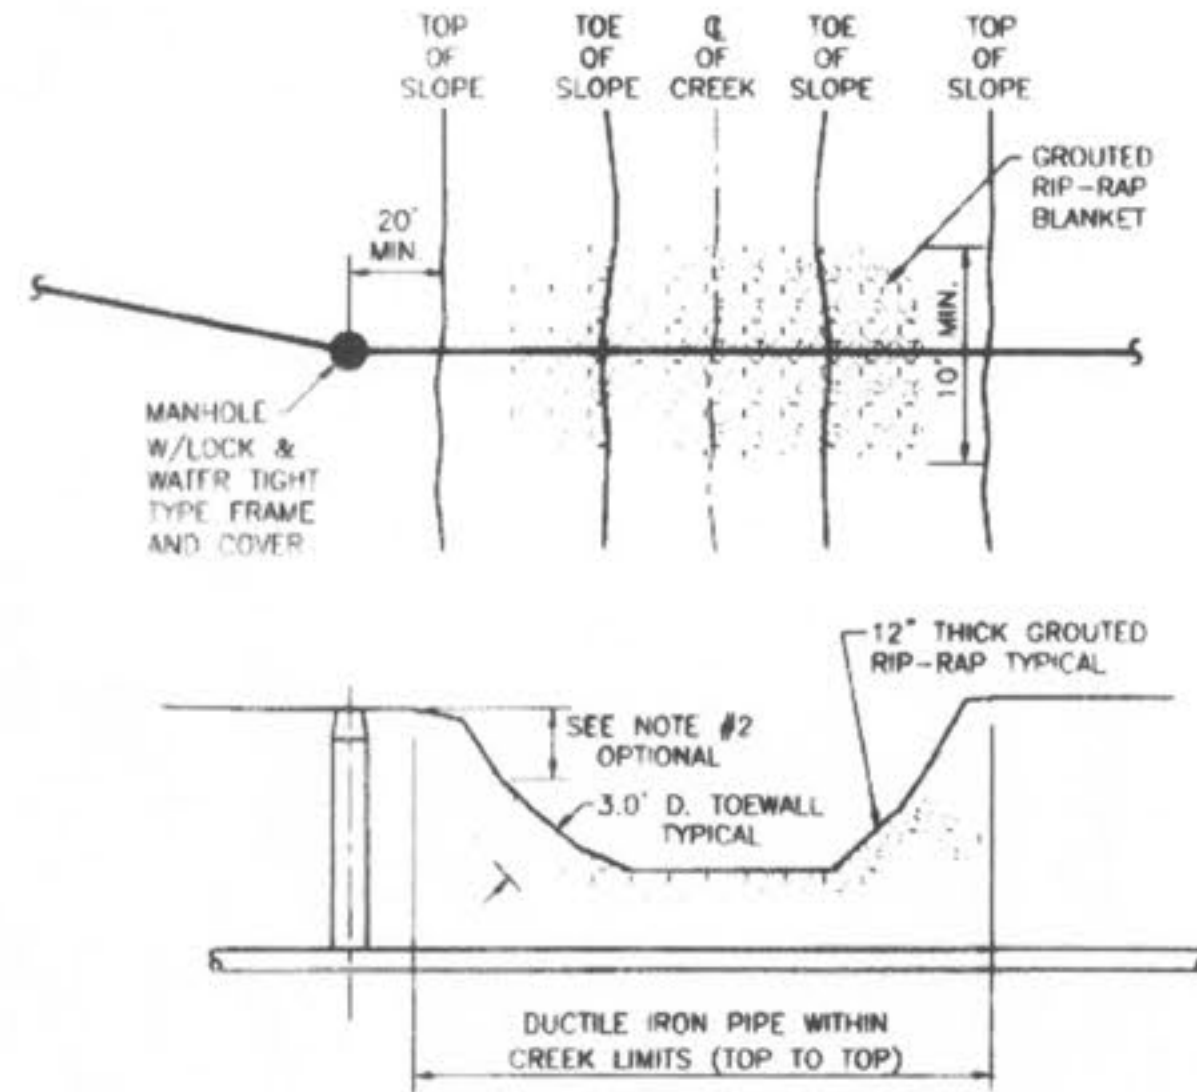


- NOTES:
- GROUTED RIP-RAP IS REQUIRED AT ALL CREEK CROSSINGS WHERE THE EMBANKMENTS CROSSED ARE STEEPER THAN 1 VERTICAL TO 2 HORIZONTAL RATIO SLOPE, AND ALSO WHERE THERE IS 3 FEET OR LESS COVER OVER THE TOP OF THE SEWER MAIN.
 - PLACE RIP-RAP ON LOWER 3/4 OF SLOPE. GRADE UPPER 1/4 OF SLOPE AT 1 VERTICAL TO 2 HORIZONTAL SLOPE FOR SOD OR 1 VERTICAL TO 2.5 HORIZONTAL SLOPE FOR SEED AND STRAW.
 - RIP-RAP TO BE "MSD 5" GRADATION, MINIMUM 12" THICK, GROUTED WITH 8 SACK MIX, SAND-CEMENT SLURRY, BROOM FINISH.
 - INCORPORATE A 3 FEET DEEP TOL WALL ON EMBANKMENT'S UPPER EDGE OF RIP-RAP.
 - TOP SURFACE OF RIP-RAP SHOULD NOT BE HIGHER THAN ADJACENT GROUND SURFACE.
 - IF PIPE HAS LESS THAN 12" COVER, A PAVED CHANNEL MAY BE REQUIRED.
 - DUCTILE IRON PIPE IS REQUIRED WITHIN THE CREEK LIMITS.

DUCKETT CREEK SANITARY DISTRICT

TYPICAL CREEK CROSSING	Drawn By: BSM	App By: KLA	Detail No. 24
	Check By: MDOB	Date: 1-8-01	

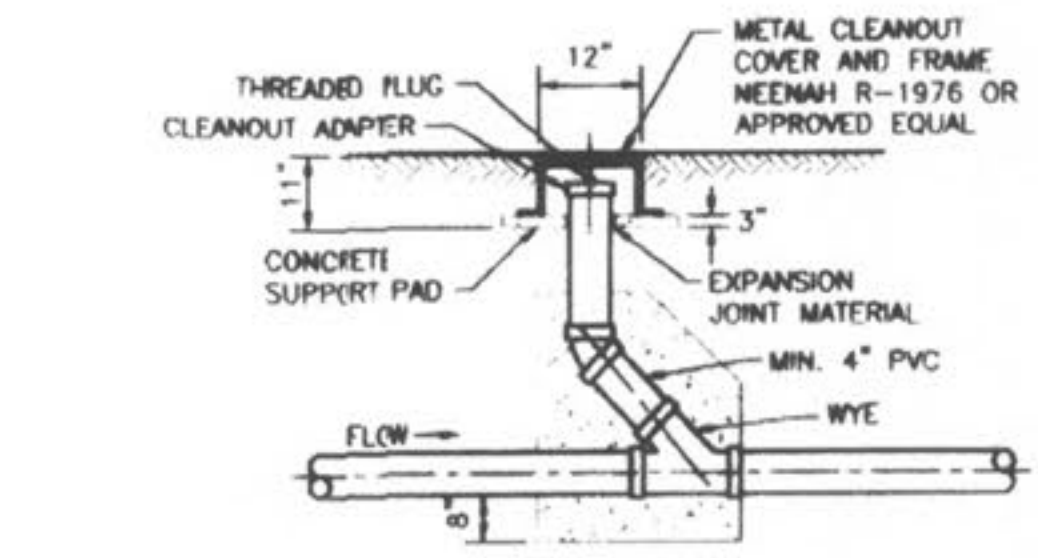


METAL FRAME AND COVER TYPE CLEANOUT

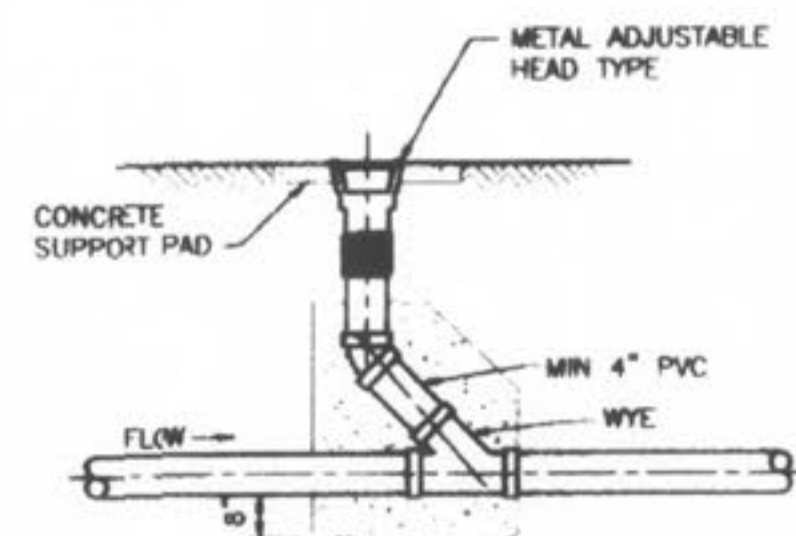

ADJUSTABLE HEAD TYPE CLEANOUT

DUCKETT CREEK SANITARY DISTRICT


TYPICAL SEWER LATERAL CLEANOUT DETAILS	Drawn By: BSM	App By: KLA	Detail No. 25
	Check By: MDOB	Date: 1-8-01	

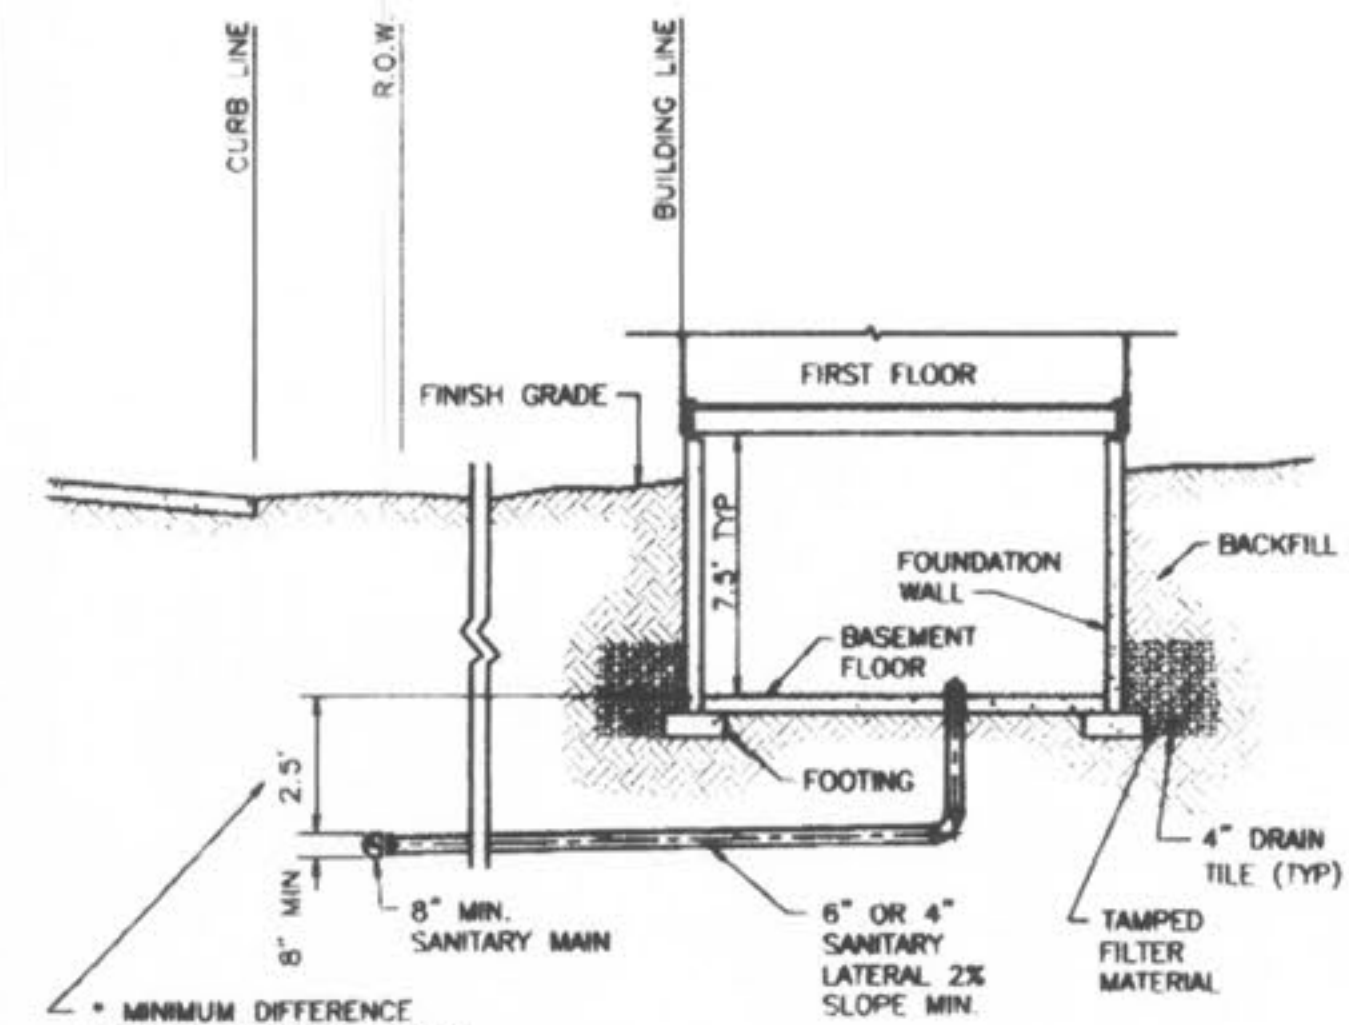

*NOTE: DIFFERENCE IN DEPTH INCREASES WITH PIPE SIZE.


DUCKETT CREEK SANITARY DISTRICT

TYPICAL SANITARY SEWER LATERAL PROFILE	Drawn By: BSM	App By: KLA	Detail No. 26
	Check By: MDOB	Date: 1-9-01	

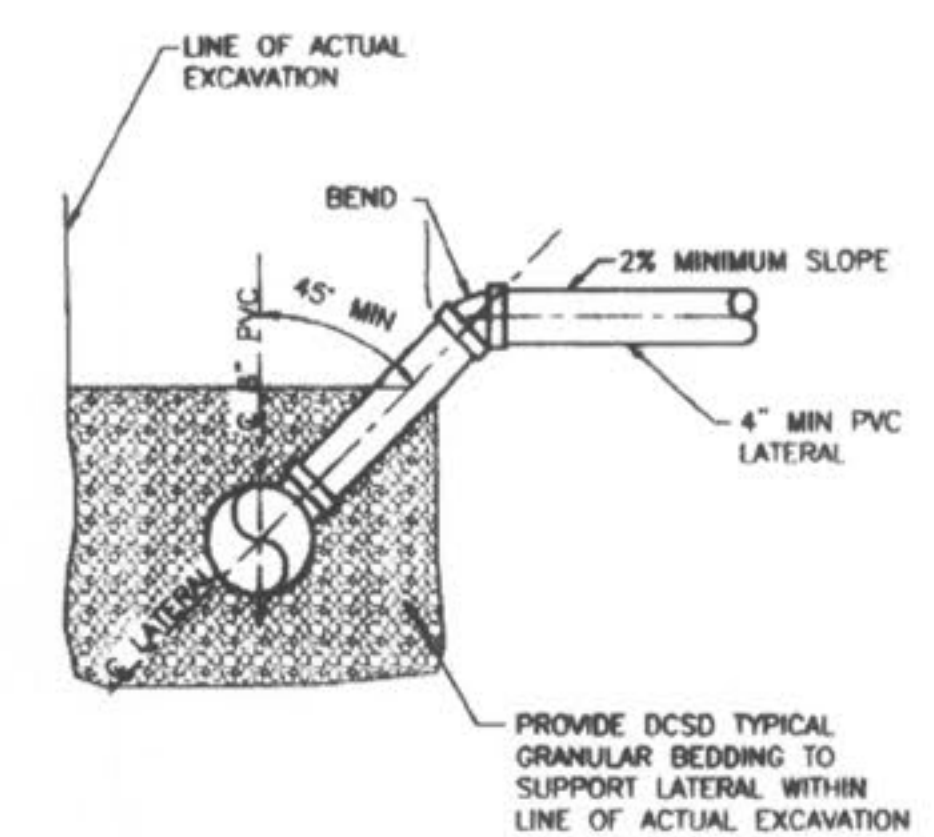

DUCKETT CREEK SANITARY DISTRICT


SANITARY SEWER LATERAL RISER DETAIL	Drawn By: BSM	App By: KLA	Detail No. 27
	Check By: MDOB	Date: 1-9-01	

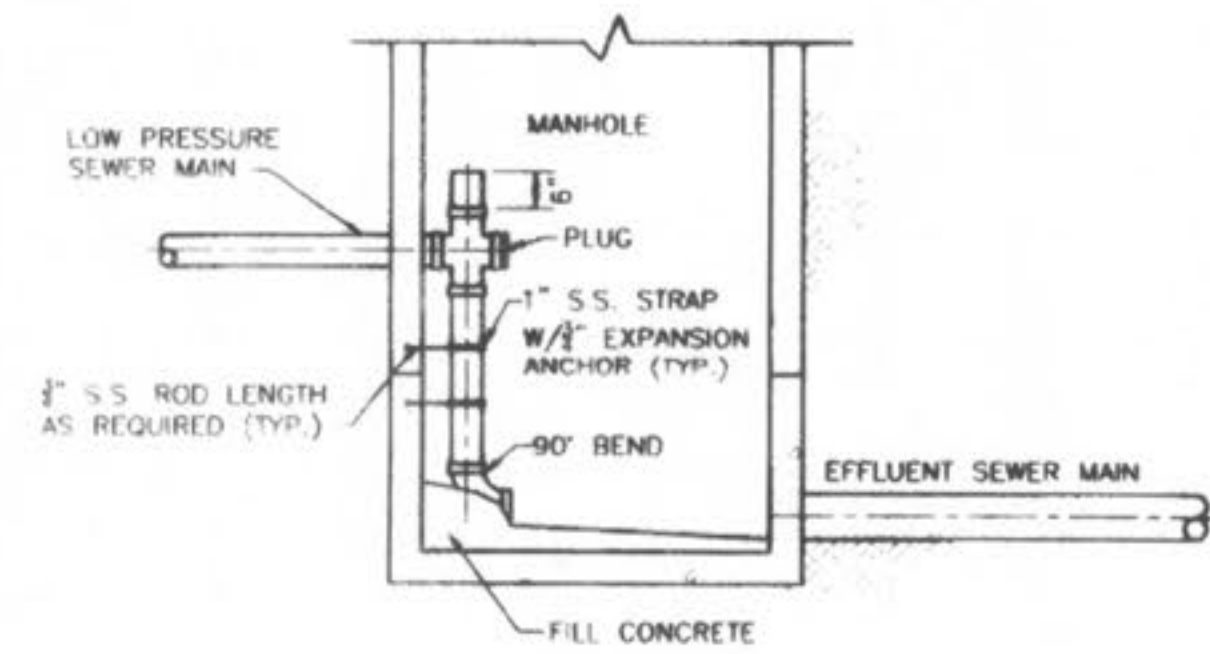

NOTE: INVERT-BOTTOM SHALL BE WORKED TO PROVIDE POSITIVE DRAINAGE THROUGH MANHOLE

DUCKETT CREEK SANITARY DISTRICT

LOW PRESSURE SEWER MAIN CONNECTION AT MANHOLE	Drawn By: BSM	App By: KLA	Detail No. 28
	Check By: MDOB	Date: 1-9-01	

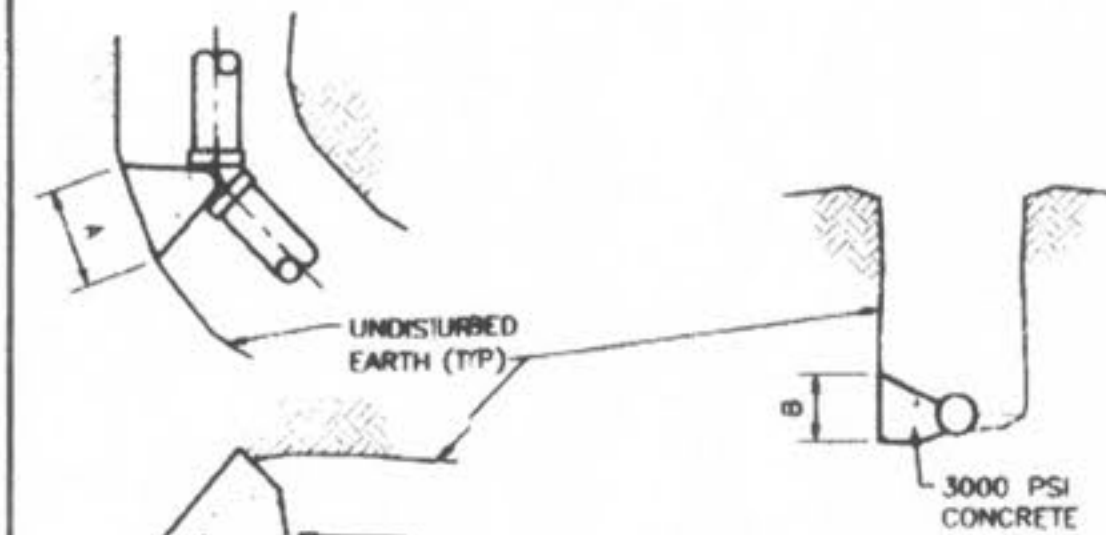

MAIN SIZE	A x B	A x B	A x B	A x B
2"	5' x 1'	5' x 1'	1' x 1'	1' x 1'
4"	1' x 1'	1' x 1'	1.5' x 1'	1' x 1'
6"	1' x 1'	1.5' x 1'	2' x 1'	1.5' x 1'
8"	1' x 1'	2' x 1'	2' x 1'	2' x 1'

DUCKETT CREEK SANITARY DISTRICT

THRUST BLOCK DETAIL AND SIZE SCHEDULE	Drawn By: BSM	App By: KLA	Detail No. 29
	Check By: MDOB	Date: 1-9-01	

PICKETT RAY & SILVER
 333 Mid Rivers Mall Drive
 St. Peters, MO 65376
 Phone (636) 397-1211
 Fax (636) 397-1104

**CIVIL ENGINEERS
 PLANNERS
 LAND SURVEYORS**

**WYNDGATE
 DUCKETT CREEK
 SANITARY SEWER DETAILS**

239 FOX HILL ROAD
 ST. CHARLES, MO. 63301
 (636) 940-9500

Prepared For:
SUMMIT POINTE, L.C.

REVISIONS	NO.	DATE	REVISIONS PER CITY	REVISIONS PER CITY OF FALLON
1	10/25/04			
6	02/16/05			

ENGINEER'S AUTHENTICATION
 The responsibility for professional engineering liability on this project is hereby limited to the set of plans authenticated by the seal, signature, and date hereunder attached. Responsibility is disclaimed for all other engineering plans involved in this project and specifically excludes revisions after this date unless reauthenticated.

PICKETT, RAY & SILVER, INC

DRAWN	J.E.E.	DATE	6-29-04
CHECKED	D.W.D.	DATE	6-29-04
PROJECT #	01267.SUP0.02R	TASK #	2
		FIELD BOOK	

WYNDGATE
 DUCKETT CREEK
 SANITARY SEWER DETAILS
 SHEET 168 OF 174

© Copyright 2004 by Pickett, Ray & Silver Inc.

