

## GRADING NOTES

- A Geotechnical Engineer shall be employed by the owner and be on site during grading operations. All soils tests shall be verified by the Geotechnical Engineer concurrent with the grading and backfilling operations.
- The grading contractor shall perform a complete grading and compaction operation as shown on the plans, stated in these notes, or reasonably implied there from; all in accordance with the plans and notes as interpreted by the Geotechnical Engineer.
- The Contractor shall notify the Soils Engineer at least two days in advance of the start of the grading operation.
- All areas shall be allowed to drain. All low points shall be provided with temporary ditches.
- A sediment control plan that includes monitored and maintained sediment control basins and/or straw bales should be implemented as soon as possible. No graded area is to be allowed to remain bare without being seeded and mulched. Care should be exercised to prevent soil from damaging adjacent property and silting up existing downstream storm drainage system.
- Debris and foundation material from any existing on-site building or structure which is scheduled to be razed for this development must be disposed of off-site.
- All trash and debris on site, either existing or from construction, must be removed and properly disposed of off-site.
- Soft soil in the bottom and banks of any existing or former pond sites or tributaries or on any sediment basins or traps should be removed, spread out and permitted to dry sufficiently to be used as fill. None of this material should be placed in proposed public right-of-way locations or on any storm sewer locations.
- Site preparation includes the clearance of all stumps, trees, bushes, shrubs, and weeds; the grubbing and removal of roots and other surface obstructions from the site; and the demolition and removal of any man-made structures. The material shall be properly disposed of off-site. Topsoil and grass in the fill areas shall be thoroughly disced prior to the placement of any fill. The Soils Engineer shall approve the discing operation.
- Compaction equipment shall consist of tamping rollers, pneumatic-tired rollers, vibratory roller, or high speed impact type drum rollers acceptable to the Soils Engineer. The roller shall be designed so as to avoid the creation of a layered fill without proper blending of successive fill layers.
- The Soils Engineer shall observe and test the placement of the fill to verify that specifications are met. A series of fill density tests will be determined on each lift of fill. Interim reports showing fill quality will be made to the Owner at regular intervals.
- The Soils Engineer shall notify the Contractor of rejection of a lift of fill or portion thereof. The Contractor shall rework the rejected portion of fill and obtain notification from the Soils Engineer of its acceptance prior to the placement of additional fill.
- All areas to receive fill shall be scarified to a depth of not less than 6 inches and then compacted in accordance with the specifications given below. Natural slopes steeper than 1 vertical to 5 horizontal to receive fill shall have horizontal benches, cut into the slopes before the placement of any fill. The width and height to be determined by the Soils Engineer. The fill shall be loosely placed in horizontal layers not exceeding 8 inches in thickness and compacted in accordance with the specifications given below. The Soils Engineer shall be responsible for determining the acceptability of soils placed. Any unacceptable soils placed shall be removed at the Contractor's expense.
- The sequence of operation in the fill areas will be fill, compact, verify acceptable soil density, and repetition of the sequence. The acceptable moisture contents during the filling operation are those at which satisfactory dry densities can be obtained. The acceptable moisture contents during the filling operation in the remaining areas are from 2 to 8 percent above the optimum moisture control.
- The surface of the fill shall be finished so that it will not impound water. If at the end of a days work it would appear that there may be rain prior to the next working day, the surface shall be finished smooth. If the surface has been finished smooth for any reason, it shall be scarified before proceeding with the placement of succeeding lifts. Fill shall not be placed on frozen ground, nor shall filling operations continue when the temperature is such as to permit the layer under placement to freeze.
- Fill and backfill should be compacted to the criteria specified in the following table:

CATEGORY	MINIMUM PERCENT COMPACTION
Fill in building areas below footings	90%
Fill under slabs, walls, and pavement	90%
Fill other than building areas	88%
Natural subgrade	88%
Pavement subgrade	90%
Pavement base course	90%

Measured as a percent of the maximum dry density as determined by modified Proctor Test (ASTM-D-1557).

Moisture content must be within 2 percent below or 4 percent above optimum moisture content if fill is deeper than 10 feet.

## GENERAL NOTES

- Underground utilities have been plotted from available information and therefore their locations shall be considered approximate only. The verification of the location of all underground utilities, either shown or not shown on these plans shall be the responsibility of the contractor, and shall be located prior to any grading or construction of the improvements.
- All manhole tops built without elevations furnished by the Engineer will be the responsibility of the sewer contractor.
- 8" P.V.C. sanitary sewer pipe shall meet the following standards. A.S.T.M.-D-3034 SDR-35, with wall thickness compression joint A.S.T.M.-D-3212. An appropriate rubber seal woterstop as approved by the sewer district shall be installed between P.V.C. pipe and masonry structures.
- All filled places, including trench backfills, under buildings, proposed storm and sanitary sewer lines and/or paved areas, shall be compacted to 90% maximum density as determined by the "Modified AASHTO T-180 Compaction Test," (A.S.T.M.-D-1557). All filled places within public roadways shall be compacted to 95% of maximum density as determined by the "Standard Proctor Test AASHTO T-99, Method C" (A.S.T.M.-D-698).

- All trench backfills under paved areas shall be granular backfill, and shall be compacted to 90% of the maximum density as determined by the "Modified AASHTO T-180 Compaction Test," (A.S.T.M.-D-1557). All other trench backfills may be earth material (free of large cobbles or stones). All trench backfills shall be water jetted.
- All sanitary house connections have been designed so that the minimum vertical distance from the low point of the basement to the flow line of a sanitary sewer at the corresponding house connection is not less than the diameter of the pipe plus the vertical distance of 2 1/2 feet.
- No area shall be cleared without the permission of the Project Engineer.
- All P.V.C. sanitary sewer is to be SDR-35 or equal with clean 1/2" to 1" granular stone bedding uniformly graded. This bedding shall extend from 4" below the pipe to the springline of the pipe. Immediate backfill over pipe shall consist of same size "clean" or minus stone from springline of pipe to 6" above the top of pipe.
- All soils test shall be verified by a Soils Engineer concurrent with the grading and backfilling operations.

- Easements shall be provided for sanitary sewers, and all utilities on the Record Plat. See Record Plat for location and size of easements.
- Maintenance and upkeep of the common ground area shall be the responsibility of the developer and/or successors.
- A 20' building line shall be established along all Public Rights-Of-Way except along Waterbury Falls Drive and along all commercial areas.

- All water lines shall be laid at least 10 feet horizontally, from any sanitary sewer, storm sewer, or manhole. 18" vertical clearance from outside of pipe to outside of pipe shall be maintained wherever water lines must cross sanitary sewers, laterals, or storm drains the water line shall be laid at such an elevation that the bottom of the water line is above the top of the drain or sewer. A full length of water pipe shall be centered over the sewer line to be crossed so that the joints will be equally distant from the sewer and as remote therefrom as possible. This vertical separation shall be maintained for that portion of the water line located within 10 feet horizontally, of any sewer or drain it crosses.

- All PVC water pipe shall conform to A.S.T.M.-D-2241, SDR 21 Standard Specification for P.V.C. Pressure Pipe, 200 P.S.I. working pressure for water, with approved joint.
- Water lines, valves, sleeves, meters, and fittings shall meet all specifications and installation requirements of Public Water Supply District No. 2 of St. Charles County.

- All water hydrants and valves shall be ductile iron and installed in accordance with plans and details. All ductile iron pipe for water mains shall conform to A.W.W.A. Specifications C-106 and/or C-108. The ductile iron fittings shall conform to A.W.W.A. Specification CC-110. All rubber gasket joints for water ductile iron pressure pipe and fittings shall conform to A.W.W.A. Specification C-111.
- All sanitary manholes shall be waterproofed on the exterior in accordance with Missouri Department of Natural Resources specifications 10 CSR-8.120 (7E).
- Brick will not be used in the construction of sanitary sewer manholes.
- All pipes shall have positive drainage through manholes. No flat base structures are allowed.


- The City of O'Fallon and Duckett Creek Sanitary District for sanitary sewers shall be notified 48 hours prior to construction for coordination and inspection.
- Gas, water and other underground utilities shall not conflict with the depth or horizontal location of existing or proposed sanitary or storm sewers, including house laterals.
- All existing site improvements disturbed, damaged or destroyed shall be repaired or replaced to closely match pre-construction conditions.

- The contractor shall prevent all storm, surface water, mud and construction debris from entering the existing sanitary sewer system.
- All construction and materials shall conform to the current construction standards of the City of O'Fallon and Duckett Creek Sanitary District for sanitary sewers.
- All sanitary and storm sewer trench backfills shall be water jetted. Granular backfill will be used under pavement areas.
- All existing areas disturbed during construction of the off-site sanitary sewer line shall be seeded and mulched to prevent erosion.
- All sanitary sewer laterals shall be a minimum of 4" in diameter per City of O'Fallon.

- No flushing hydrants or water meters shall be located in driveways and or walkways.

# A SET OF AS-BUILT PLANS FOR WATERBURY

A TRACT OF LAND BEING PART OF  
LOTS 15 AND 16 OF "JOHN D. COALTERS HOWELL PRAIRIE TRACT"  
IN U.S. SURVEY 1669, TOWNSHIP 46 NORTH, RANGE 3 EAST  
CITY OF O'FALLON, ST. CHARLES COUNTY, MISSOURI

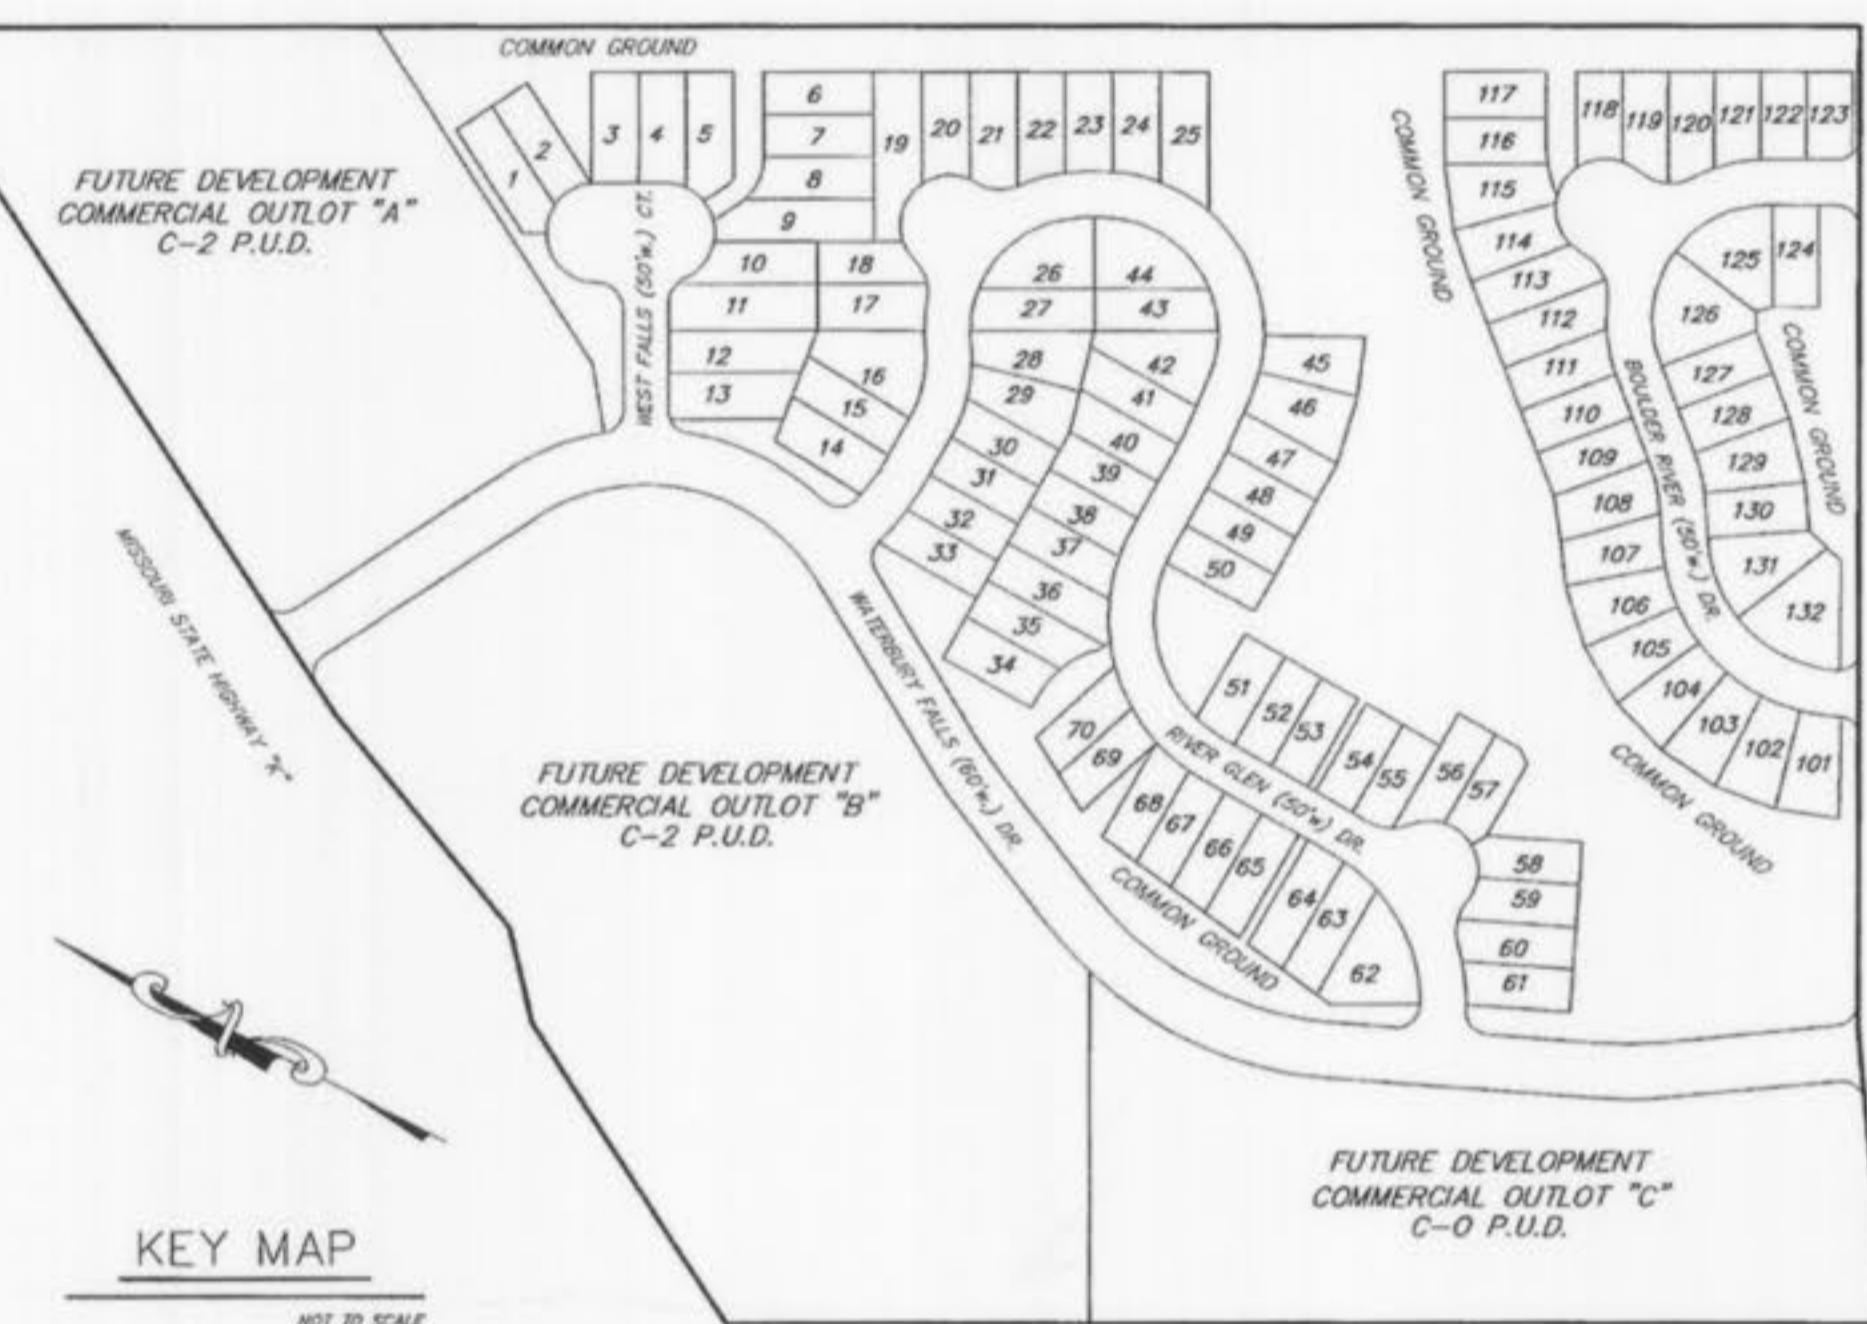

KEY MAP

NOT TO SCALE



## DEVELOPMENT NOTES

- Area of Tract: 54.85 acres
- Proposed Zoning: R-2 P.U.D. - Residential, C-O P.U.D. - Commercial, C-C P.U.D. - Commercial

- Proposed Use: Multi-family dwellings Commercial

- Residential Zoning: R-2 P.U.D. Area Number of Units Units Allowed Proposed Density 102 units = 3.33 units/acre 30.62 acres

- Proposed Height and Lot Setbacks: R-2 PUD Zoning Front yard 20 feet Side yard 5 feet Rear yard 20 feet Maximum Height 35 feet

- Parking Requirements: 2 spaces per unit (206 spaces)

- Parking Provided: 2 spaces per unit (206 spaces)

- Site is served by: Ameren U. E. Public Water Supply District No. 2 - Water St. Charles Gas Company Southwestern Bell Telephone Duckett Creek Sanitary District Cottleville Fire Protection District Franklin Howell School District

- Property Owner and Contract/Developer: Taylor Morley Inc. 1224 Fern Ridge Parkway St. Louis, Missouri 63141 (314) 434-9000

- Boundary information is per survey as compiled by Bax Engineering Co.

- Topographical information is by aerial topography by Walker & Associates.

- All public streets will be constructed to the City of O'Fallon standards. Minor residential streets will consist of a 26 foot wide concrete pavement with integral rolled curb centered in a 50 foot right-of-way and having a minimum centerline radius of 150 feet, a design speed of 30 MPH (posted 25 MPH), and a minimum K value of 25. The minor collector road will consist of a 36 foot wide concrete pavement with vertical curbs centered in a 60 foot right-of-way and having a minimum centerline radius of 300 (unless otherwise indicated) a design speed of 30 MPH (posted 25 MPH), and a minimum K value of 25.

- Minimum street grades shall be 1%.

- No 100'-yr floodplain exist on this tract per F.I.R.M. #29183C0430E. Map revised date: August 2, 1996.

- All utilities must be located underground.

- All homes must have driveway access to interior subdivision streets.

- Street lighting shall conform to the city of O'Fallon standards.

- A sediment and erosion control plan will be submitted to the City of O'Fallon for their review and approval prior to construction.

- The developer shall comply with Article 26 of the O'Fallon Zoning Code.

- The developer shall comply with current Tree Preservation Ordinance Number 1689 and provide landscaping as set forth in Article 23 of the City of O'Fallon Zoning Code.

- Tree Preservation Calculations:  
Trees Existing 11.57 acres  
Tree Removal 3.70 acres

- Trees Required: 11.57 ac - 9.26 ac = 2.31 acres  
3.70 ac > 2.31 ac (no additional trees required)

- All entrances onto highway "K" shall be designed and constructed to MoDOT standards and specifications.

- Individual site plans and applications shall be provided at the time of development of the commercial outlets.

- The existing creek (Crooked Creek) is subject to United States Corp of Engineers (COE) regulations.

- The commercial developments shall construct a multi-use trail along Highway K. Proposed trail will intersect the proposed collector road at the street light intersection of Highway K.

- The developer shall comply to the current requirements for screening and landscaping (bufferyards).

- Lots susceptible to stream creep: 1, 2, 5, 10, 17, 18, 19, 20, 21, 22, 23, 24, 25, 26, 28, 29, 30, 31, 32, 33, 36, 37, 38, 45, 56, 57, 58, 59, 60, 61, 67, 68, 69, 70, 71, 72, 73, 101, 102, 103, 104, 105, 106, 107, 111, 112, 114, 115, 118, 119, 120, 121, 128, 129.

- A cross access drive from commercial outlet "B" and/or "C" to the adjacent property to the south will be required during the commercial site plan submitted.

- Detention basins shown are intended to provide detention for the commercial lots. Additional detention on commercial lots may be required when actual engineering calculations are performed.

- The final grading shall not exceed a 3:1 slope.

- Easements will be provided to adequately cover all proposed sewers and utilities as required by the governing authorities on the record plots.

- Developer shall be responsible for providing a two inch asphalt overlay for the entire width of Weldon Spring Road along the entire length of the subject property once construction of the Waterbury Square villas are 90% constructed and as approved by the Public Works Department.

- Driveways shall not interfere with the sidewalk handicap ramps.

- A pump shall be supplied to the home owners association as a means to drain the lakes.

- All streets intersecting with Waterbury Falls Drive shall have a 5' transition from vertical curb to rolled curb.

- Details of the pavilion and other lot-lot amenities will need to be submitted to the Building Division for a permit.

- All traffic signal posts, mast arms, sign backs, light posts, and bracket arms shall be painted black using Carboline Rustbond Penetrating Sealer SG and Carboline 133 HB Point (or equivalent as approved by the City).

**WATERBURY**  
TAYLOR MORLEY HOMES  
1224 FERN RIDGE PARKWAY  
ST. LOUIS, MISSOURI 63141  
(314) 434-9000

**PREPARED FOR:**  
Copyright 2000  
Bax Engineering Company, Inc.  
All Rights Reserved

**DISCLAIMER OF RESPONSIBILITY**  
I hereby certify that the documents intended to be represented by this map and I hereby disclaim any responsibility for any errors or omissions contained therein. Estimates, Reports or other documents or information contained herein are not to be used for any part or parts of the architecture or engineering project or survey.

04-17-00 CITY & DCSD	COMMENTS
05-30-00 CITY COMMENTS	
06-27-00 CITY COMMENTS	



ENGINEERING  
PLANNING  
SURVEYING

1052 South Cloverleaf Drive  
St. Peters, MO. 63376-6445  
314-928-5552  
FAX 928-1718

Jan 08, 2001  
DATE  
98-9713c  
PROJECT NUMBER  
1 of 9  
SHEET OF  
9713C-asbuilt  
FILE NAME  
TLT WSK  
DRAWN CHECKED

Underground utilities have been plotted from available information and therefore their locations shall be considered approximate only. The verification of the location of all underground utilities, either shown or not shown on these plans shall be the responsibility of the contractor, and shall be located prior to any grading or construction of the improvements.

Revised 04-17-00 City & DCSD Comments  
Revised 05-01-00 PWSD#2 Comments  
Revised 05-30-00 City Comments  
Revised 06-27-00 City Comments

SITE PLAN  
WATERBURY

BRUARY 28, 2000

98-9713C



SEE SHEET 3

AS-BUILT ADDED JANUARY 2001

Waterbury App 2/6/01 As built



Underground utilities have been plotted from available information and therefore their locations shall be considered approximate only. The verification of the location of all underground utilities, either shown or not shown on these plans shall be the responsibility of the contractor, and shall be located prior to any grading or construction of the improvements.


## SEE SHEET 2


Revised 04-17-00 City & DCSD Comments  
Revised 05-01-00 PMSD#2 Comments  
Revised 05-30-00 City Comments  
Revised 06-27-00 City Comments

SITE PLAN  
WATERBURY

FEBRUARY 28, 2000

98-9713C

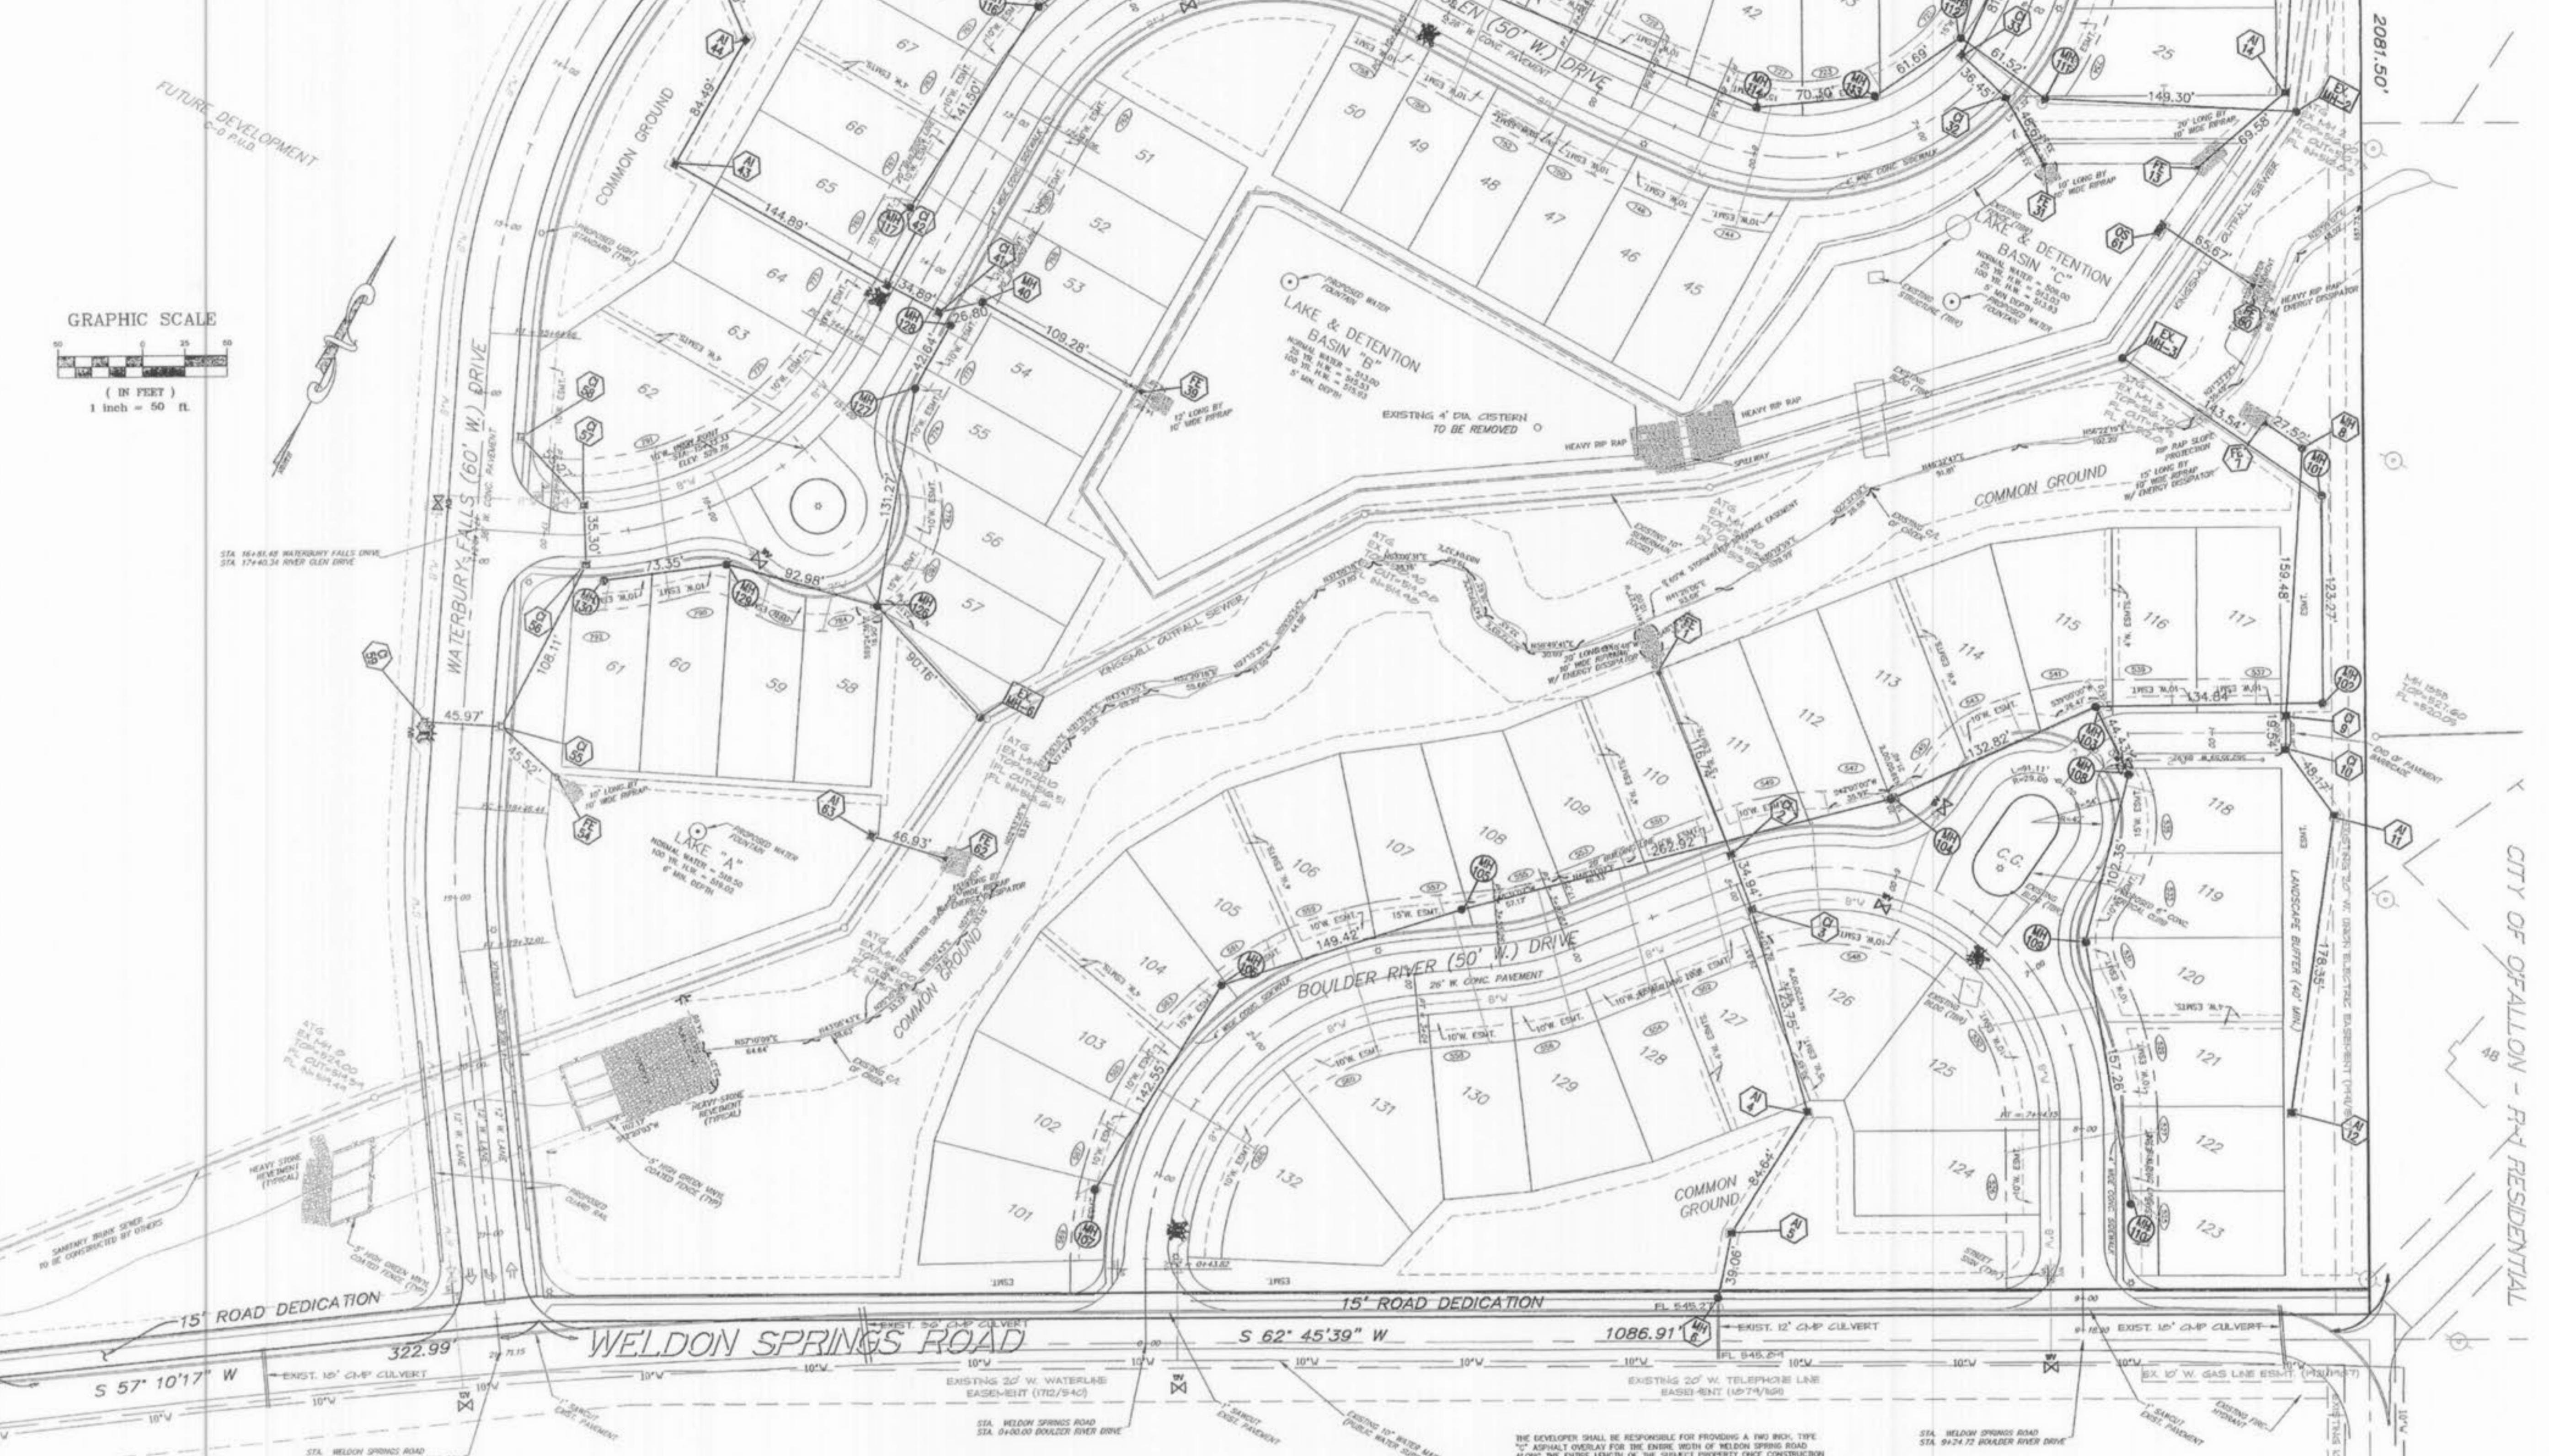

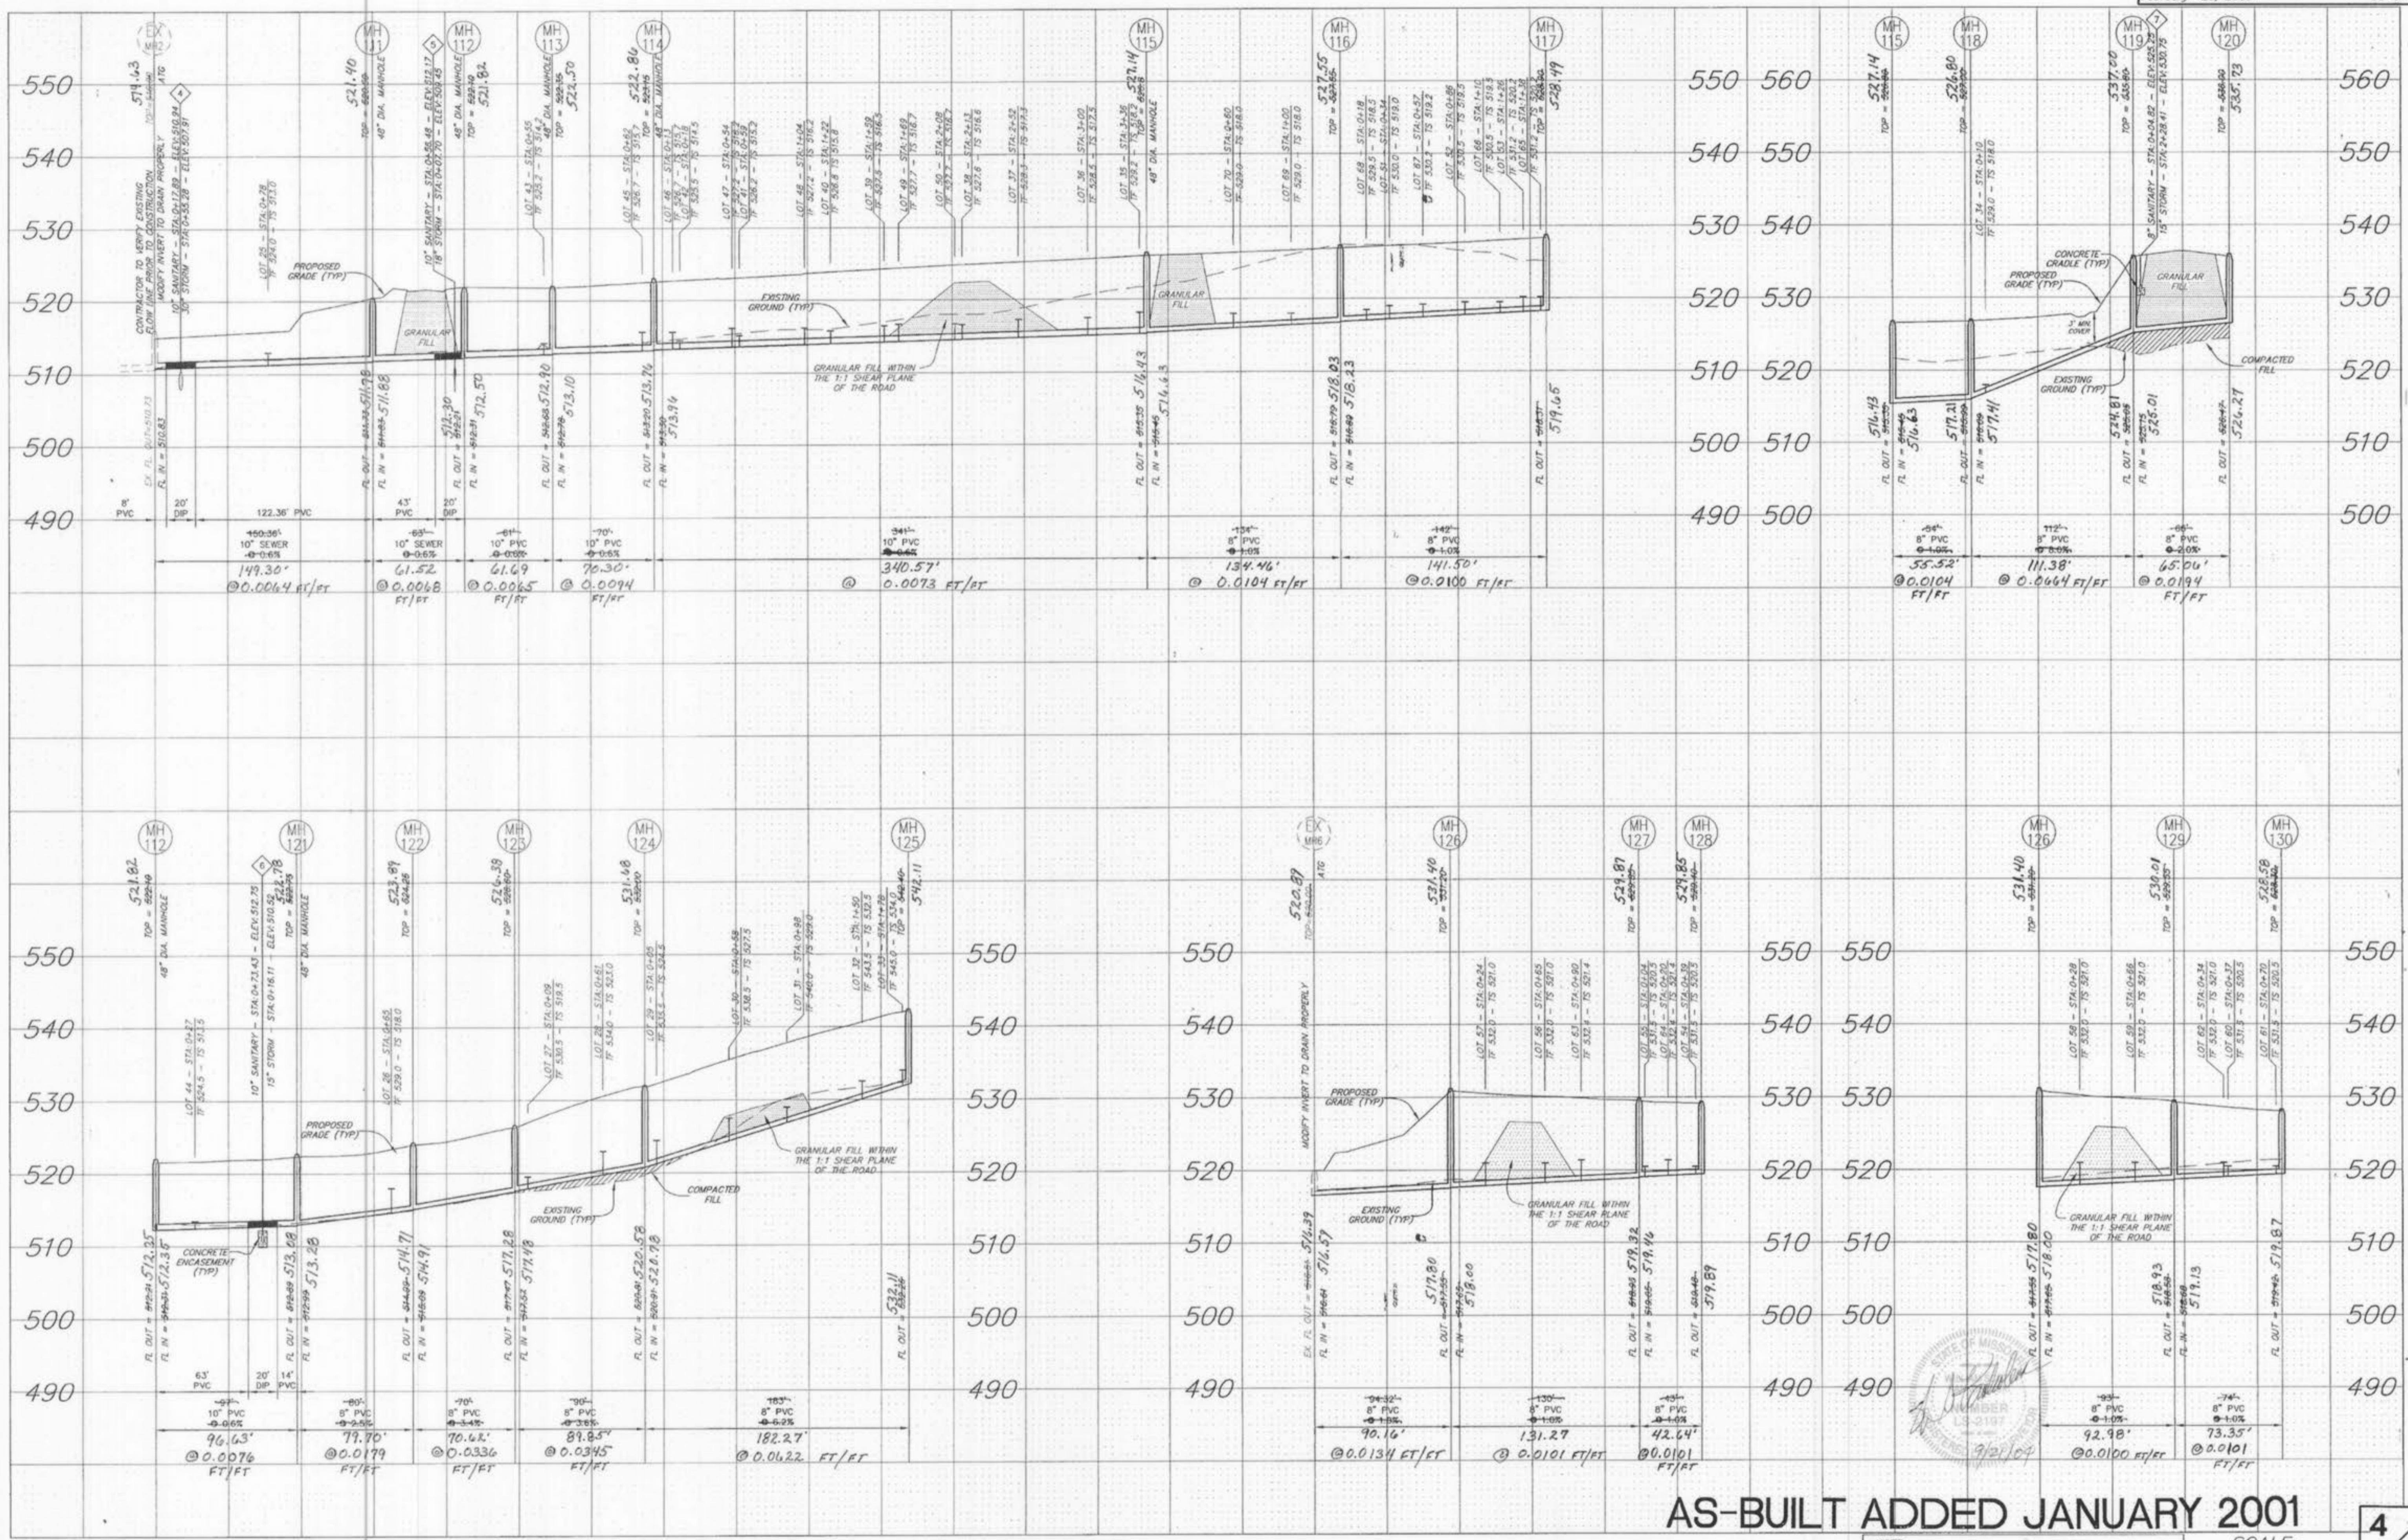

AS-BUILT ADDED JANUARY 2001


NOTE:  
All sanitary sewer lateral tailstake elevations have been  
designed for 9.0' basements in homes.


SCALE:  
VERTICAL = 1:10  
HORIZONTAL = 1:100

Waterbury 2/6/01 As-built

February 28, 2000

98-97130

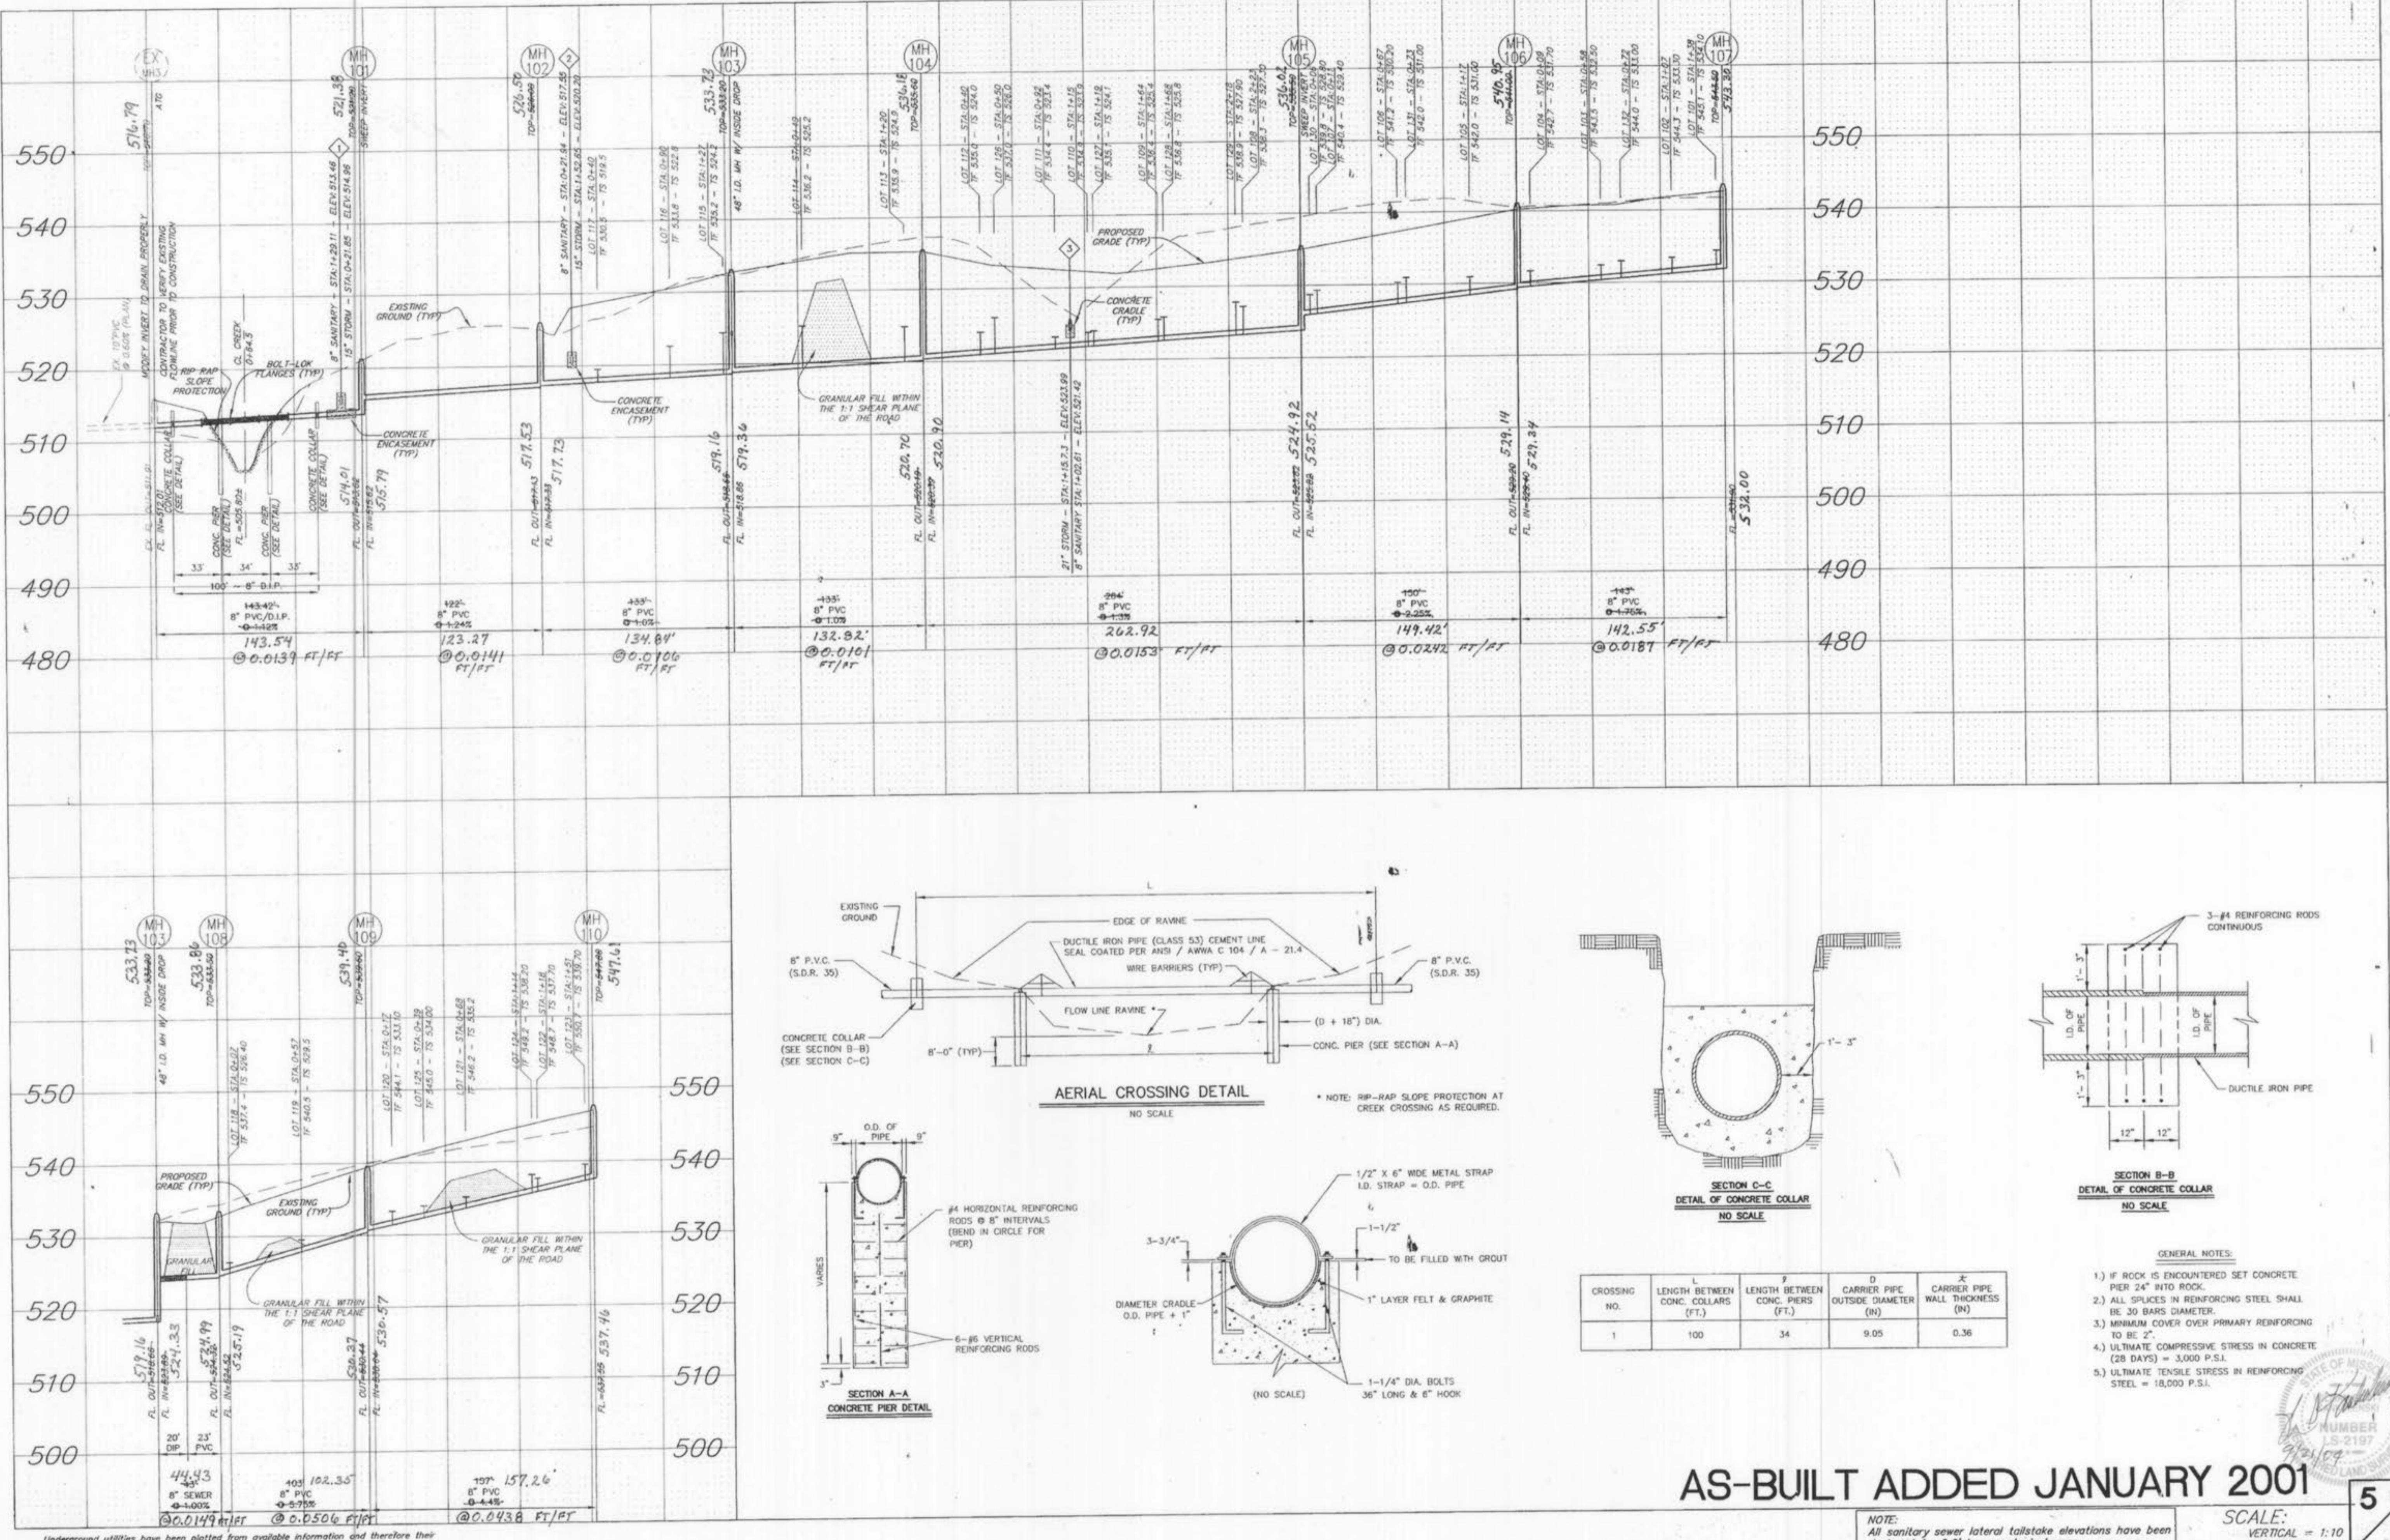

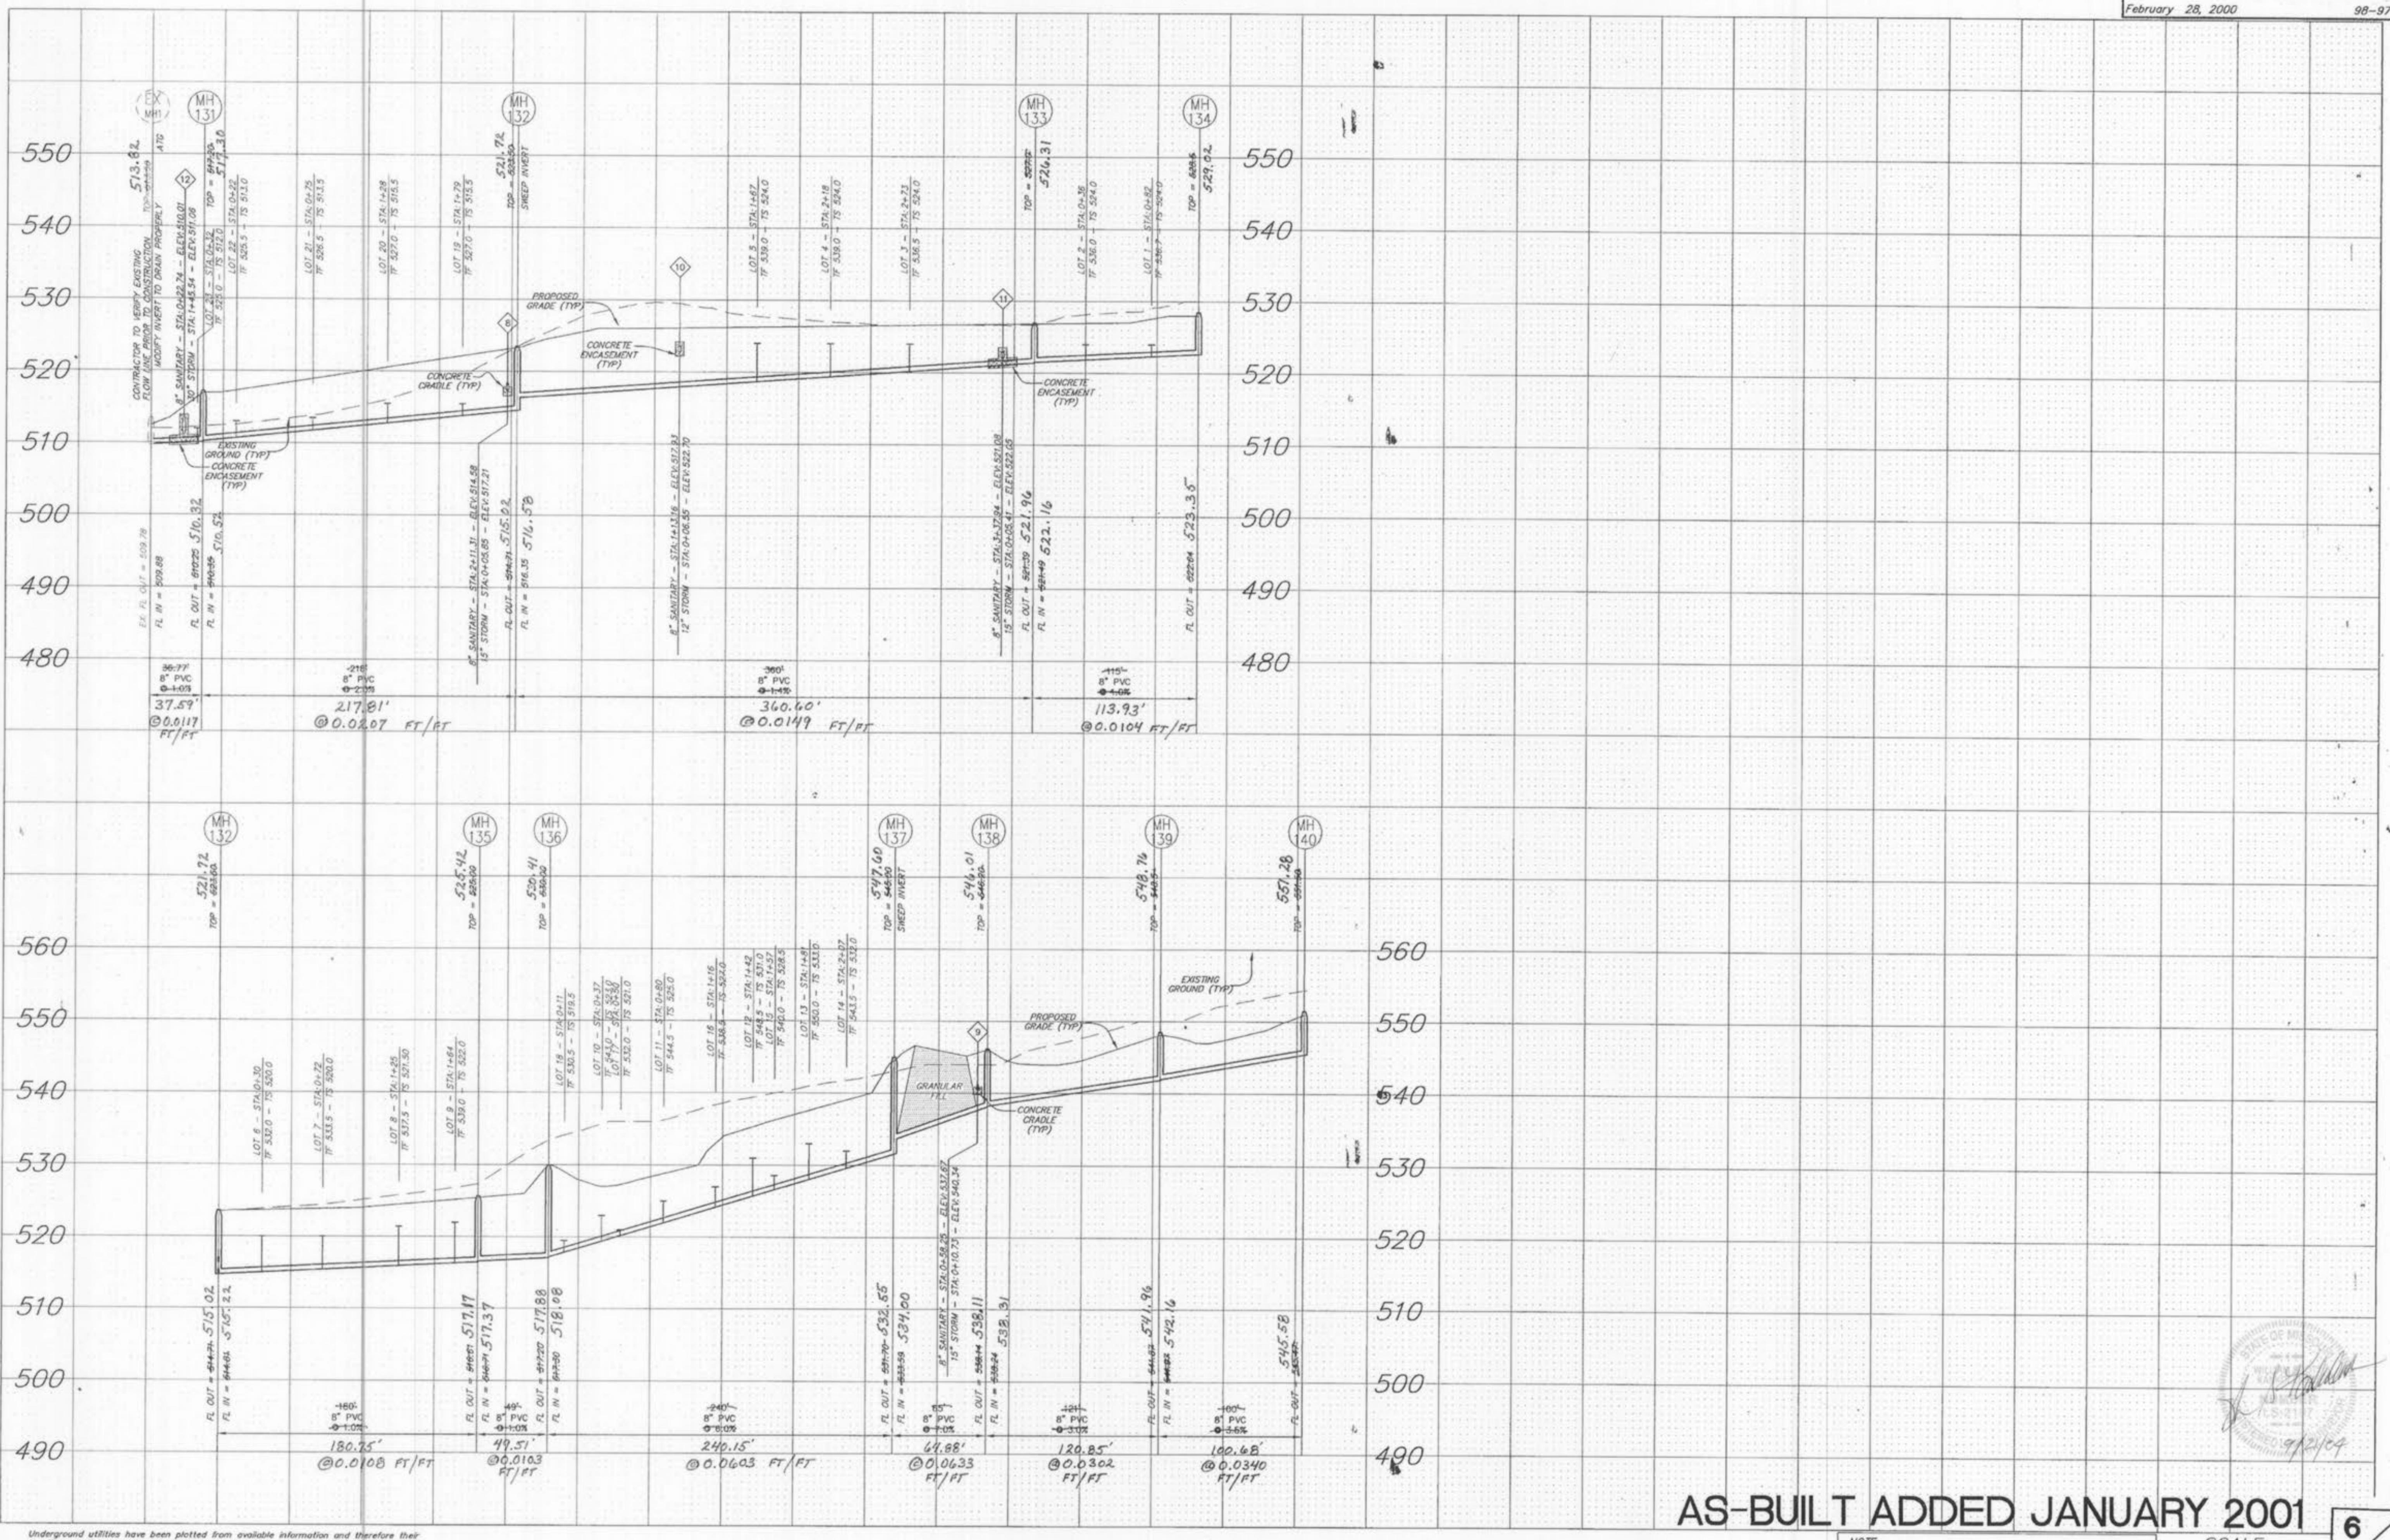


AS-BUILT ADDED JANUARY 2001

*Underground utilities have been plotted from available information and therefore their locations shall be considered approximate only. The verification of the location of all underground utilities, either shown or not shown on these plans shall be the responsibility of the contractor, and shall be located prior to any grading or construction of the improvement.*

**NOTE:**  
*All sanitary sewer lateral tailgate elevations have been designed for 9.0' basements in homes.*

**SCALE:**  
VERTICAL = 1:10  
HORIZONTAL = 1:10

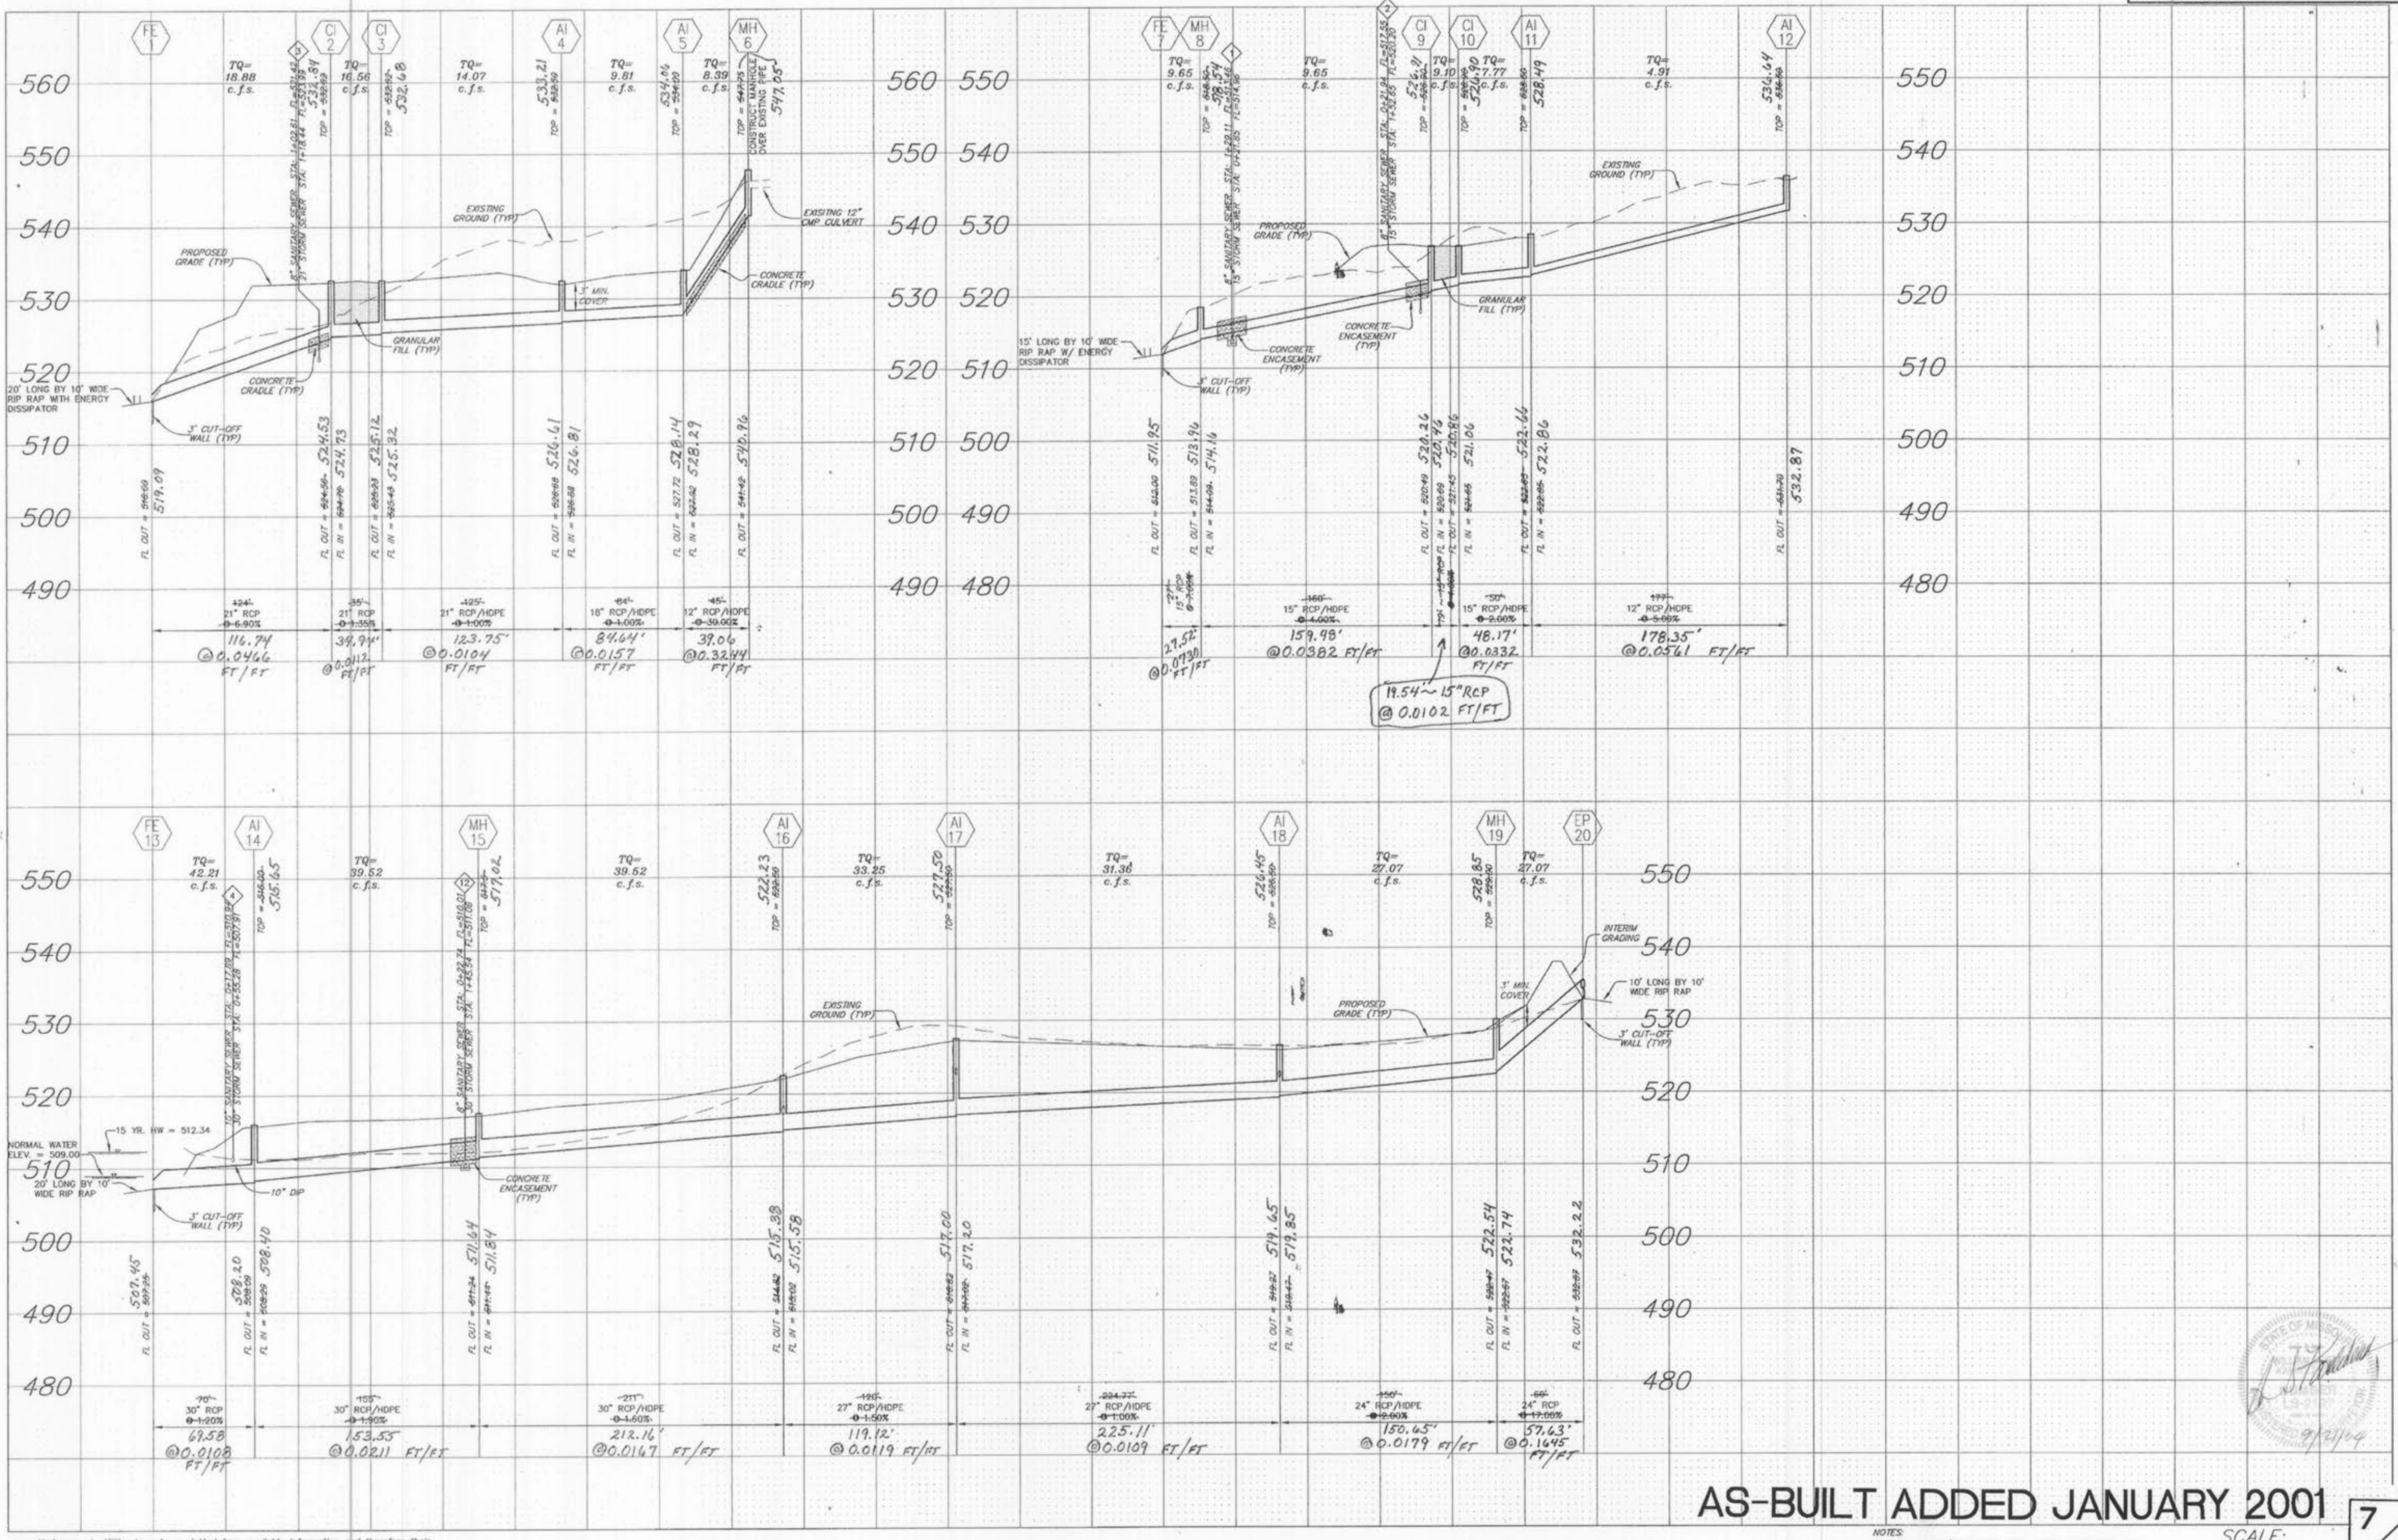

**AS-BUILT ADDED JANUARY 2001**

7  
9


Underground utilities have been plotted from available information and therefore their locations shall be considered approximate only. The verification of the location of all underground utilities, either shown or not shown on these plans shall be the responsibility of the contractor, and shall be located prior to any grading or construction of the improvements.

NOTES:  
 IF CONTRACTOR/DEVELOPER USES ALTERNATIVE HDPE PIPE,  
 ALL SEWER CROSSINGS SHALL BE CONCRETE ENCASED.  
 ALL FLARED END SECTIONS AND INLET STRUCTURES WILL BE CONCRETE.

SCALE:  
 VERTICAL = 1:10  
 HORIZONTAL = 1:10

February 28, 2000

98-9713C

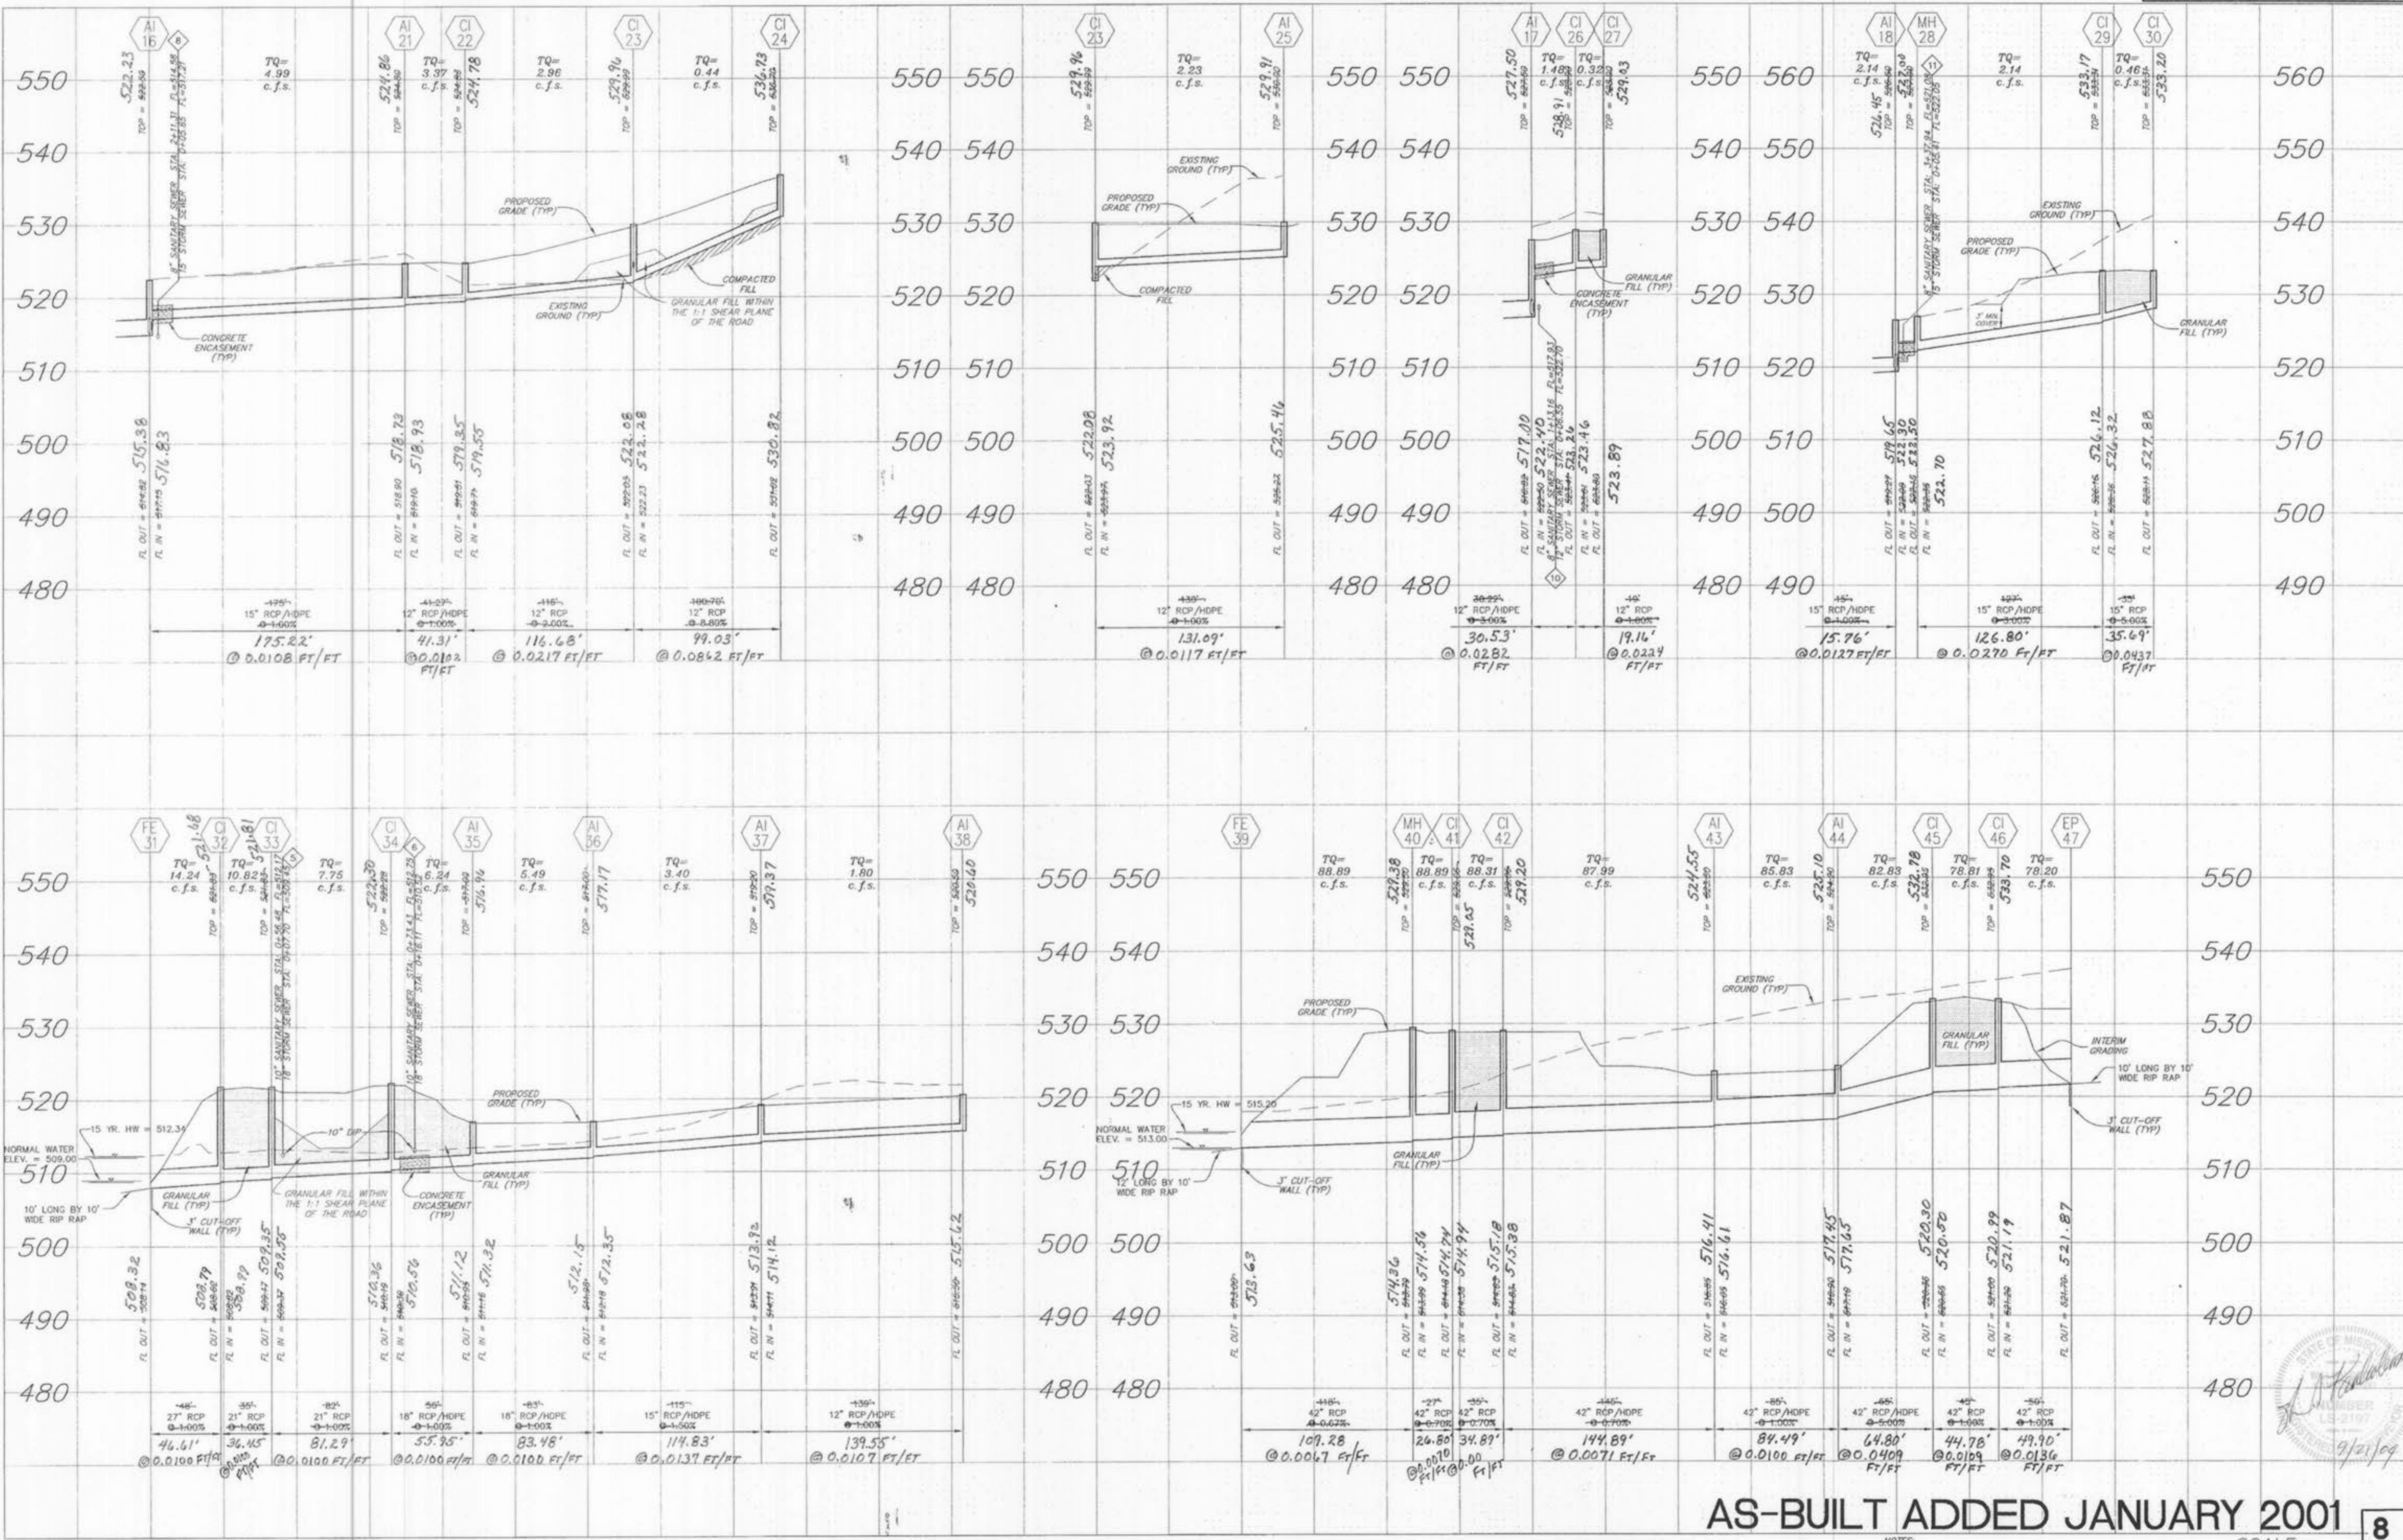


**AS-BUILT ADDED JANUARY 2001**

**8**

NOTES:  
 IF CONTRACTOR/DEVELOPER USES ALTERNATIVE HOPE PIPE,  
 ALL NEW CROSSES SHALL BE CONCRETE ENCASED.  
 ALL FLARED END SECTIONS AND INLET STRUCTURES WILL BE CONCRETE.

SCALE:  
 VERTICAL = 1:10  
 HORIZONTAL = 1:10

waterbury.dwg 2/6/01  
 As built

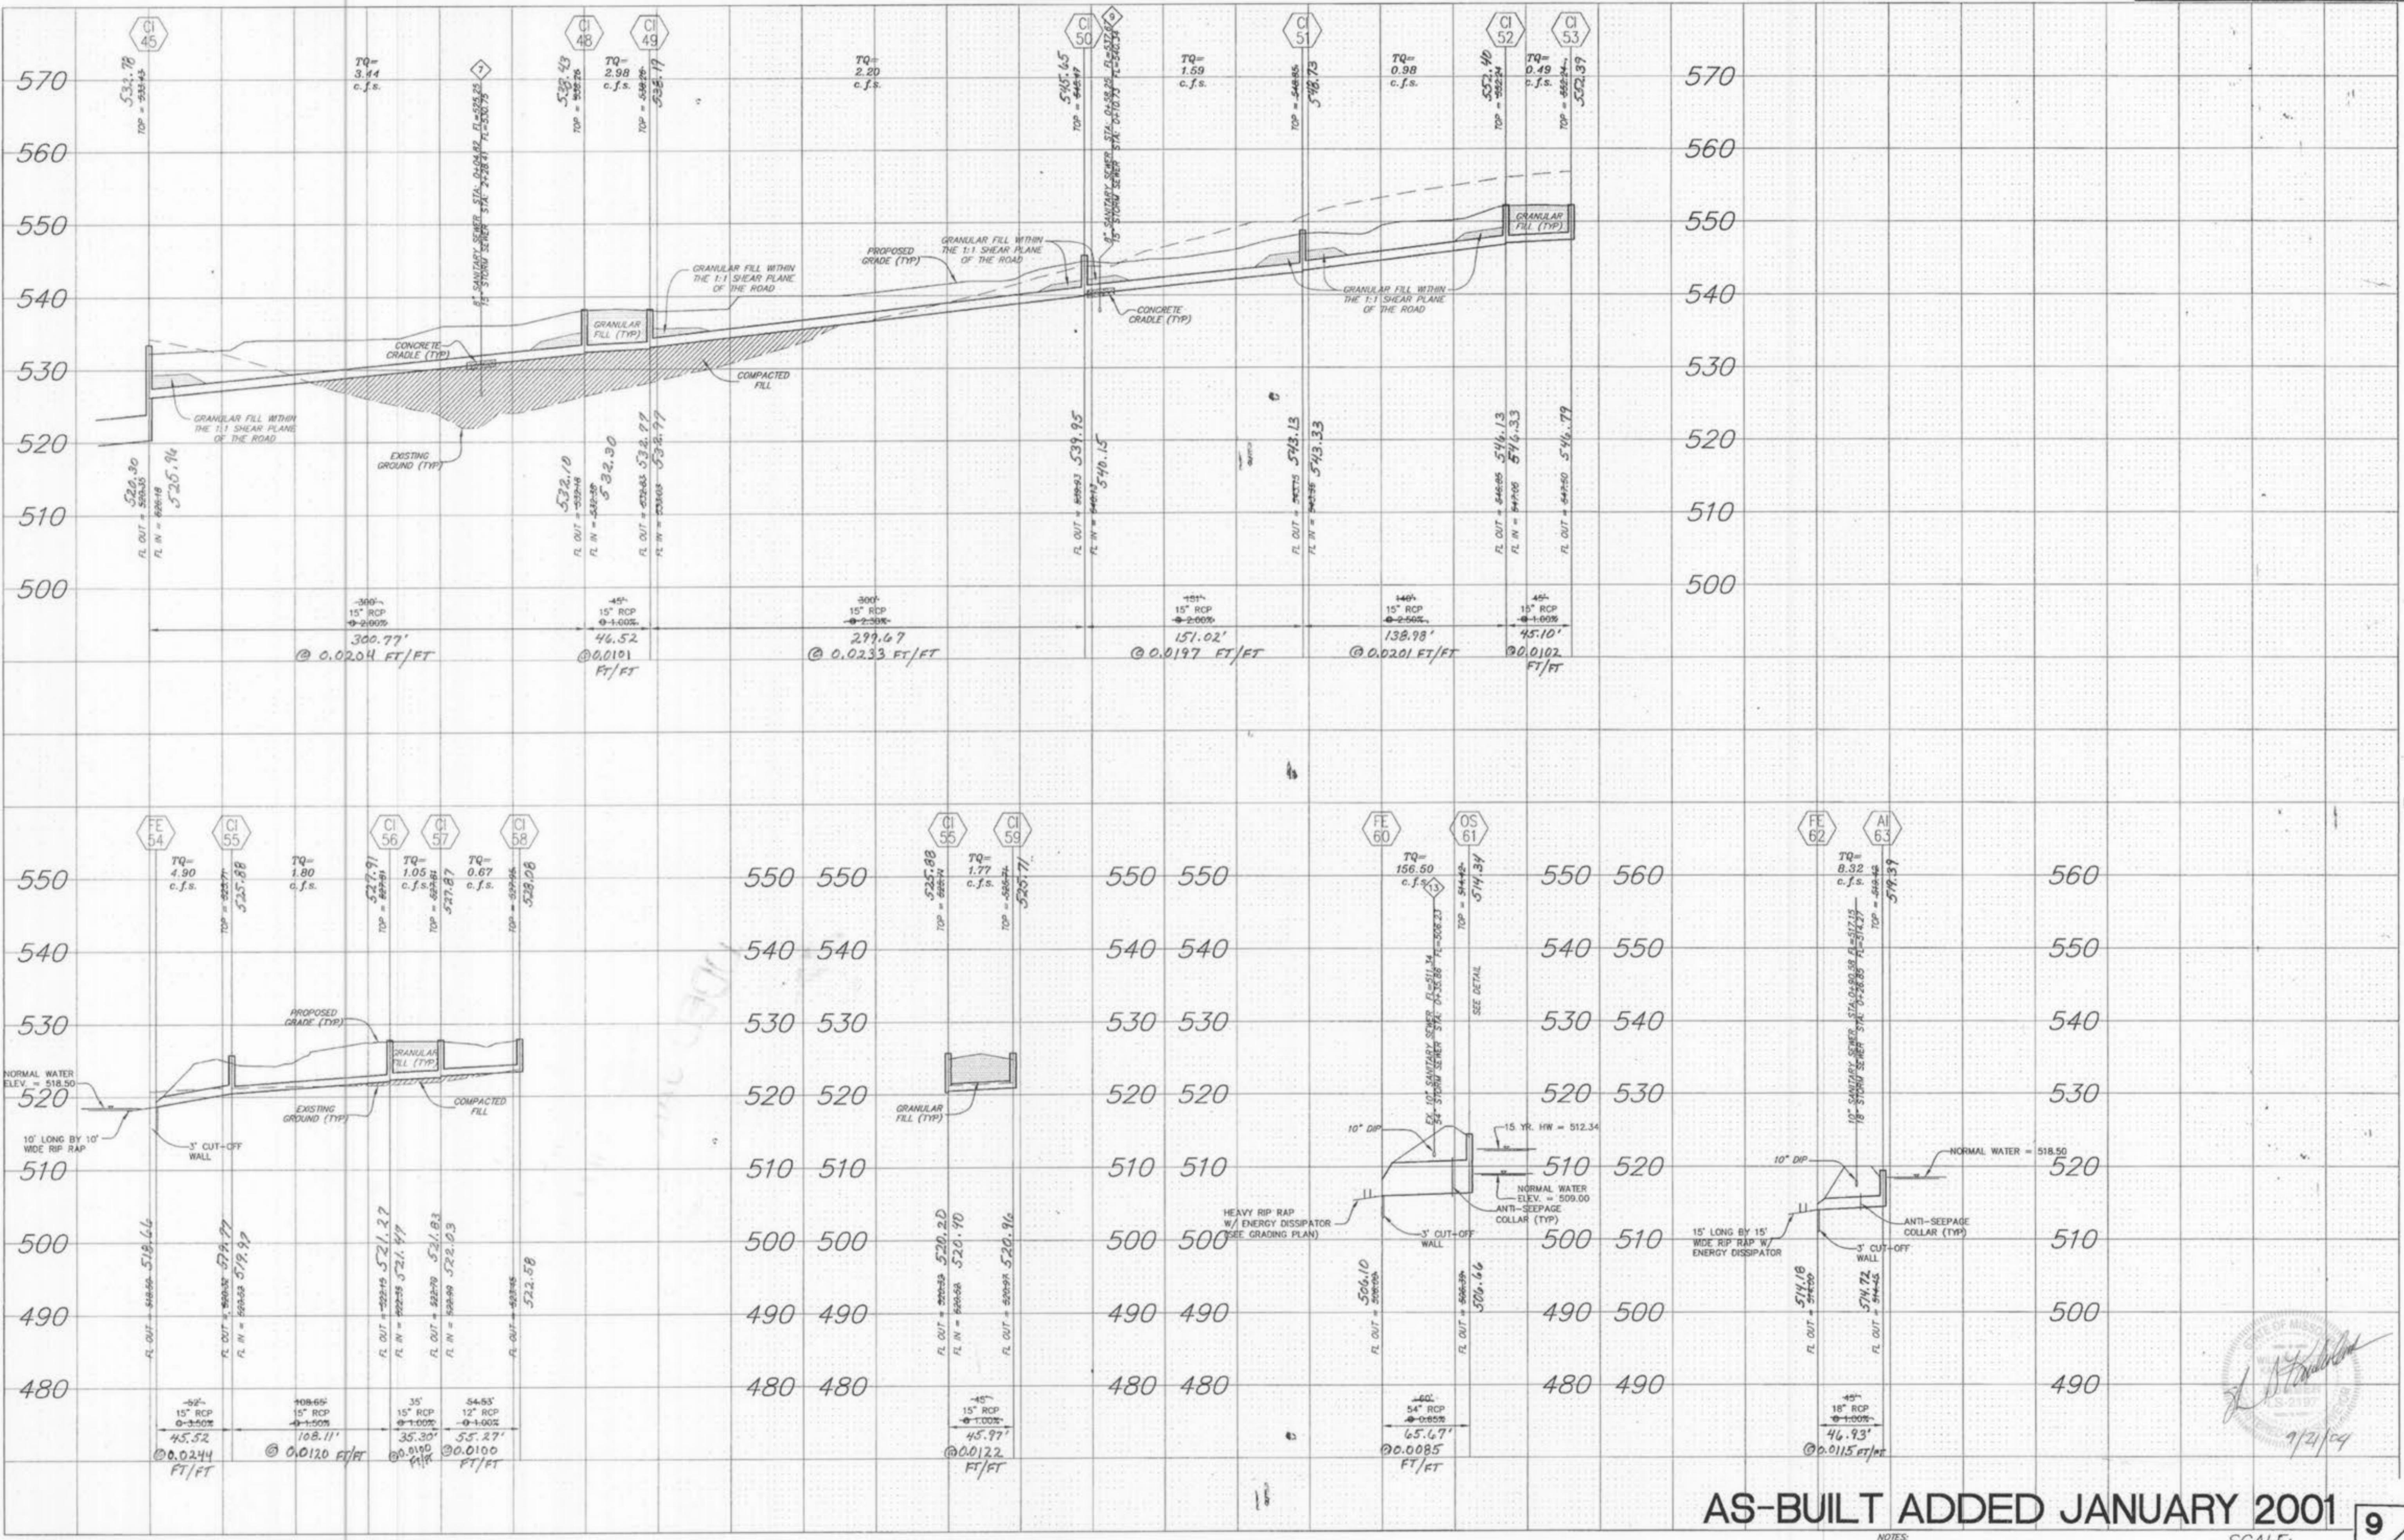

AS-BUILT ADDED JANUARY 2001

NOTES:  
IF CONTRACTOR/DEVELOPER USES ALTERNATIVE HOPE PIPE,  
ALL SEWER CROSSINGS SHALL BE CONCRETE ENCASED.  
ALL FLARED END SECTIONS AND INLET STRUCTURES WILL BE CONCRETE.

**SCALE:**

*Underground utilities have been plotted from available information and therefore their locations shall be considered approximate only. The verification of the location of all underground utilities, either shown or not shown on these plans shall be the responsibility of the contractor and shall be located prior to any grading or construction of the improvements.*