


PROPOSED INTERCEPTOR SEWER BY THE CITY OF O'FALLON, MISSOURI

Exist. 54" (Tunnel Lined Pipes) w/ CMP End Sections

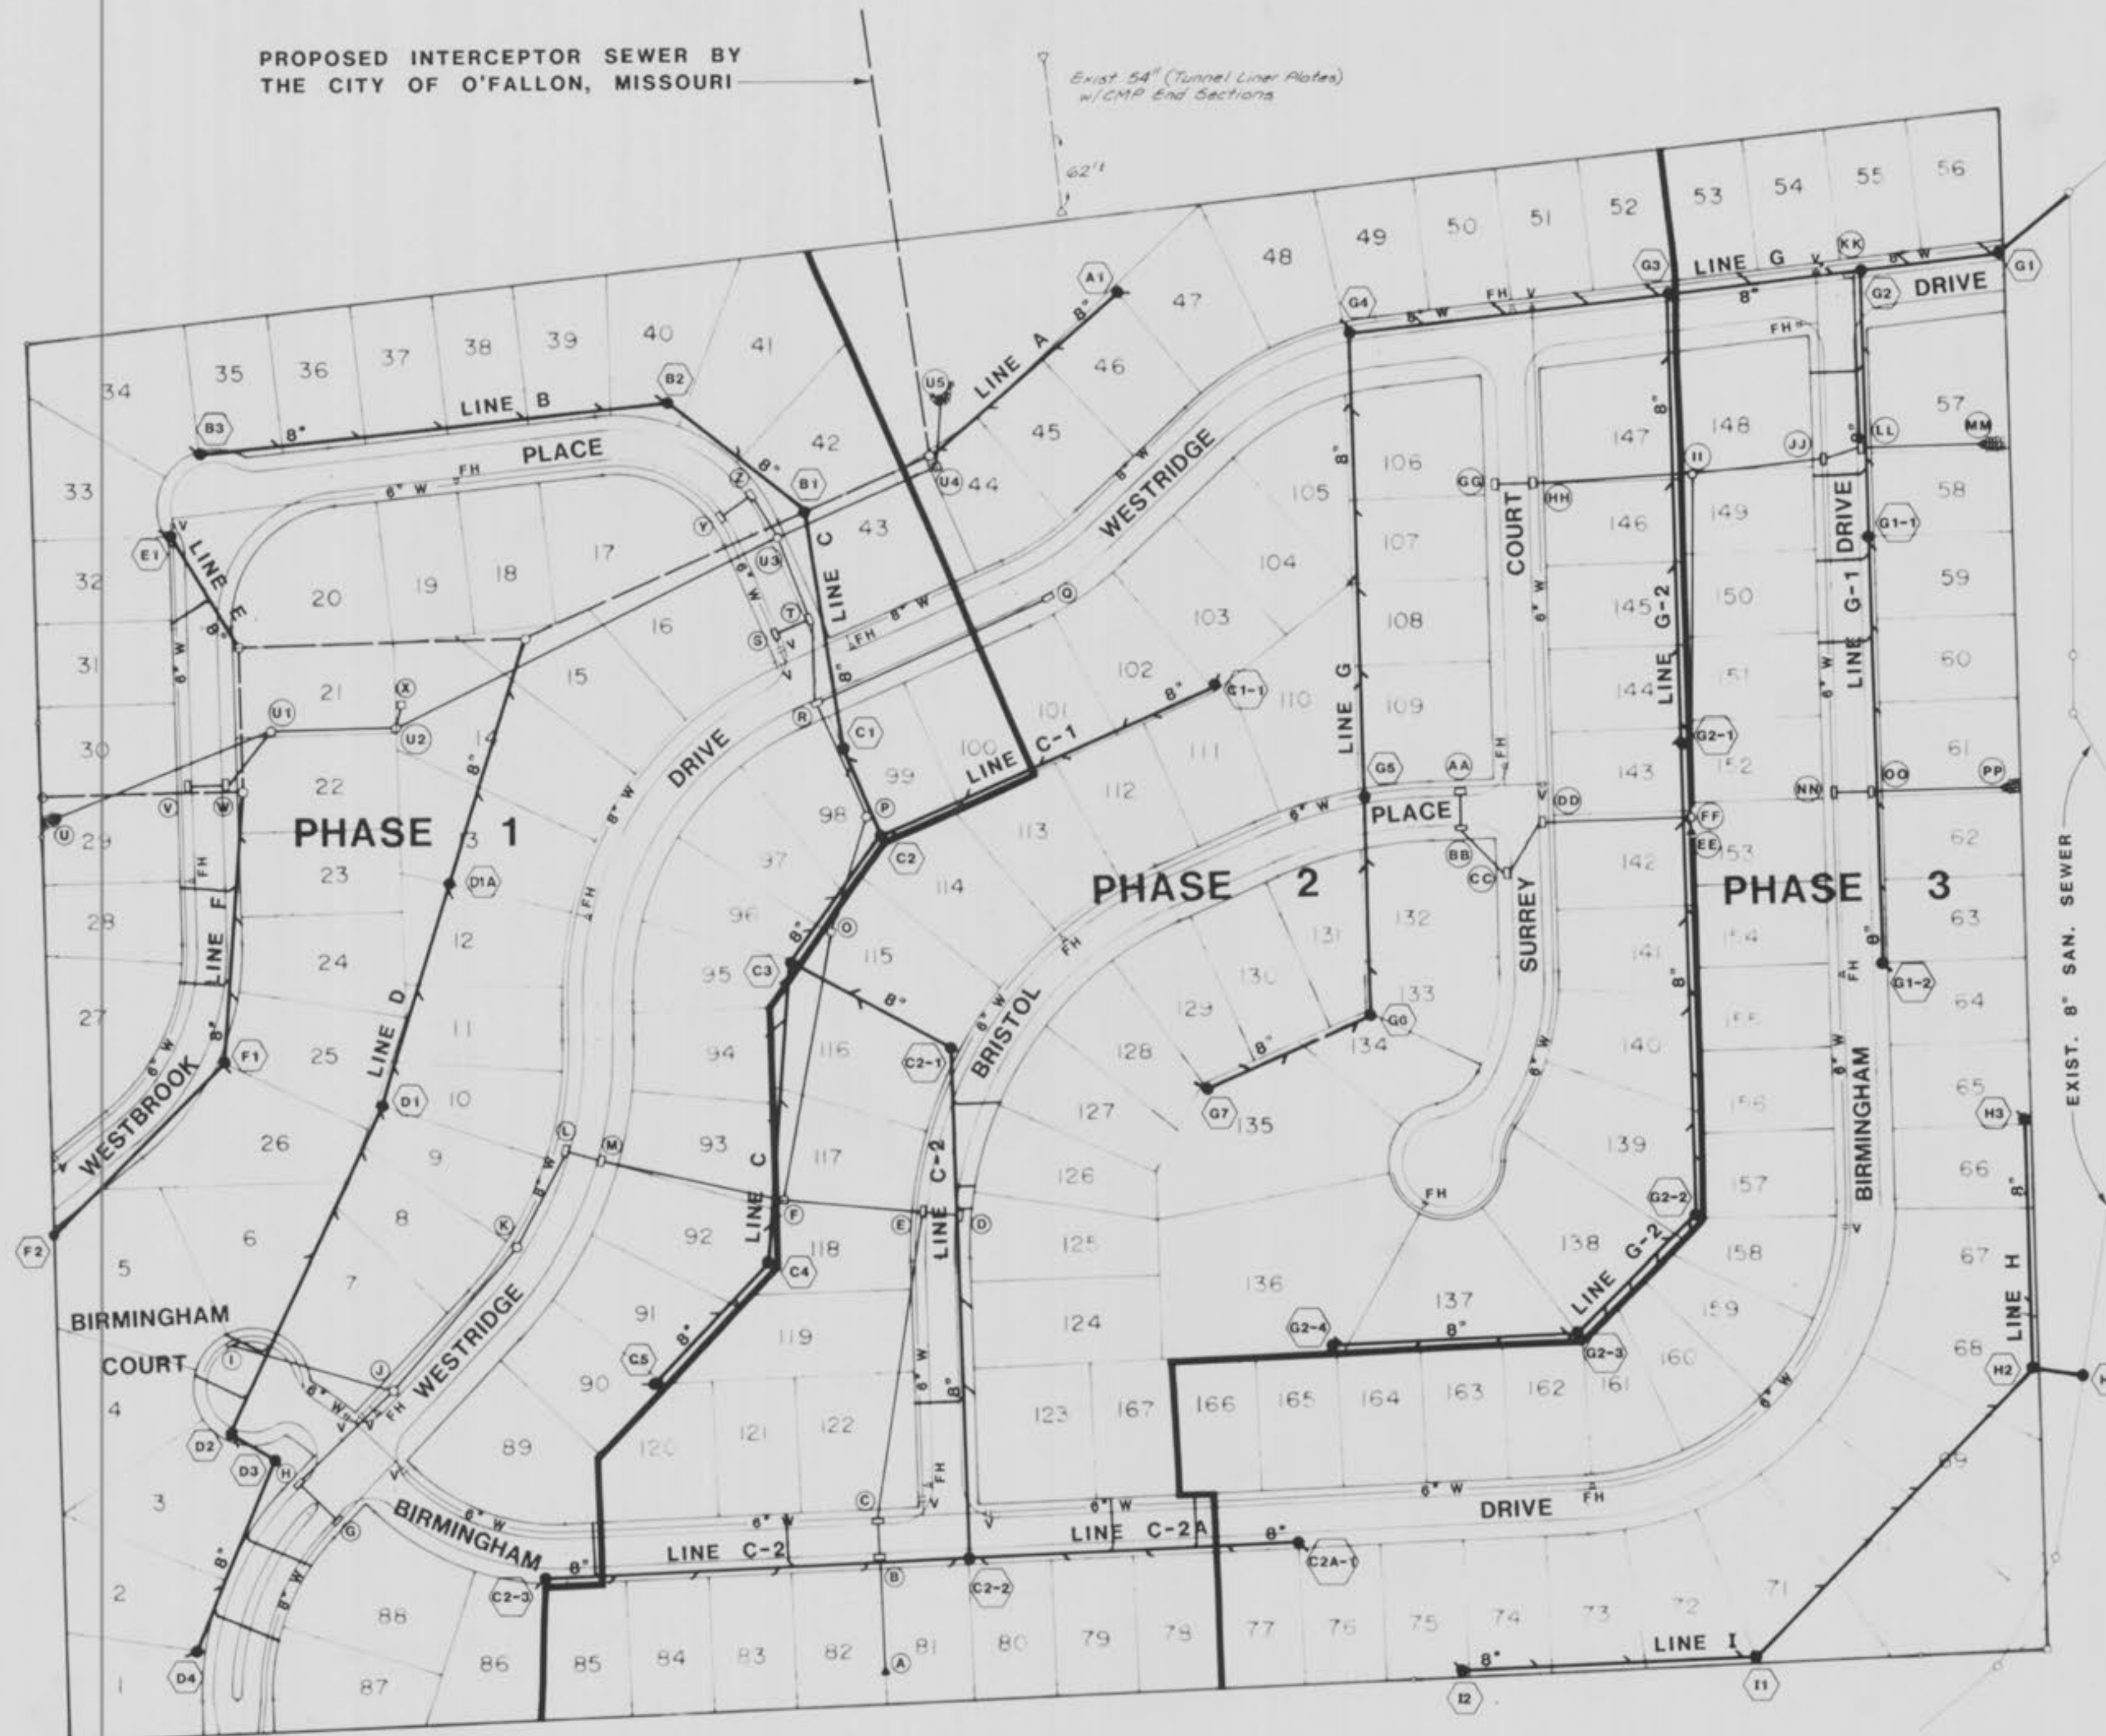

Scale: 1"=100'

SANITARY SEWER WYE LOCATION INFORMATION

LINE #	SEWER LINE STATION	LOT NO.	REMARKS	SEWER LINE STATION	LOT NO.	REMARKS	
LINE #1	0+30 ST.	44		0+40 ST.	31	40 L.F. House Service	
	0+45 ST.	45		1+00 ST.	32		
	1+40 ST.	46		1+07.83 Stubout (W)	33		
LINE #2	0+75 ST.	41		0+35 ST.	23		
	1+55 ST.	40		0+80 ST.	28	50 L.F. House Service	
	2+00 ST.	39		1+35 ST.	26	5 L.F. House Service	
	2+75 ST.	38		1+80 ST.	27	47 L.F. House Service	
	3+45 ST.	37		2+35 ST.	25	5 L.F. House Service	
	4+15 ST.	36		2+77.14 Stubout (SE)	26		
	4+85 ST.	35					
	5+47.77 Stubout (W)	34					
	LINE #3	2+13 ST.	30		0+90 ST.	36	12 L.F. House Service
		2+20 ST.	30		1+35 ST.	35	12 L.F. House Service
2+20 ST.		30		2+00 ST.	34	12 L.F. House Service	
2+93 ST.		30		2+95 ST.	33	12 L.F. House Service	
4+25 ST.		30		4+35 ST.	31	12 L.F. House Service	
4+71 ST.		30		5+05 ST.	30	12 L.F. House Service	
5+17 ST.		30		5+75 ST.	29	12 L.F. House Service	
6+11 ST.		30	22 L.F. House Service	6+29 ST.	28	12 L.F. House Service	
6+43 ST.		30		7+05 ST.	27	12 L.F. House Service	
7+20 ST.		30		7+20 ST.	26		
LINE #4	0+42 ST.	114		0+40 ST.	114		
	0+80 ST.	114		1+20 ST.	114		
	1+50 ST.	114		1+80 ST.	114		
	1+70 ST.	114		1+90 ST.	114		
	2+27 ST.	114		2+54.14 Stubout (W)	114		
	2+33 ST.	114					
	2+33 Stubout (W)	114					
	LINE #5	0+45 ST.	115		0+45 ST.	115	
		1+55 ST.	115		1+42 ST.	115	
		2+87 ST.	115		1+72 ST.	115	
2+82 ST.		115	40 L.F. House Service	2+31 ST.	115	45 L.F. House Service	
2+82 ST.		115	28 L.F. House Service	2+42 ST.	115	45 L.F. House Service	
2+82 ST.		115	22 L.F. House Service	2+89 ST.	115	45 L.F. House Service	
2+82 ST.		115	22 L.F. House Service	3+07 ST.	115	45 L.F. House Service	
2+82 ST.		115	22 L.F. House Service	3+08 ST.	115	45 L.F. House Service	
2+82 ST.		115	22 L.F. House Service	4+49 ST.	115	45 L.F. House Service	
2+82 ST.		115	22 L.F. House Service	5+24 ST.	115	45 L.F. House Service	
LINE #6	0+45 ST.	115		0+45 ST.	115		
	1+55 ST.	115		1+42 ST.	115		
	2+87 ST.	115		1+72 ST.	115		
	2+82 ST.	115	40 L.F. House Service	2+31 ST.	115	45 L.F. House Service	
	2+82 ST.	115	28 L.F. House Service	2+42 ST.	115	45 L.F. House Service	
	2+82 ST.	115	22 L.F. House Service	2+89 ST.	115	45 L.F. House Service	
	2+82 ST.	115	22 L.F. House Service	3+07 ST.	115	45 L.F. House Service	
	2+82 ST.	115	22 L.F. House Service	3+08 ST.	115	45 L.F. House Service	
	2+82 ST.	115	22 L.F. House Service	4+49 ST.	115	45 L.F. House Service	
	2+82 ST.	115	22 L.F. House Service	5+24 ST.	115	45 L.F. House Service	

STORM SEWER SCHEDULE

NO.	TYPE	STREET	STATION	DISTANCE
A	FEES	Birmingham Drive	4+65	123.81
B	FEES	Birmingham Drive	4+65	16.75
C	FEES	Birmingham Drive	4+65	16.75
D	FEES	Bristol Place	2+73	17.00
E	FEES	Bristol Place	2+73	17.00
F	FEES	Westridge Drive	2+17	22.75
G	FEES	Westridge Drive	2+17	22.75
Rev - MH FE Added - 6/12/85 - K.F.

NOTE:
Existing underground (U/G), overhead (O.H.) utilities and drainage structures have been plotted from available information and therefore, their locations must be considered approximate only. It is the responsibility of the individual Contractors to notify the utility companies before actual construction.

GBA
GEORGE BUTLER ASSOCIATES, INC.
CONSULTING ENGINEERS ARCHITECTS
LANDSCAPE ARCHITECTS PLANNERS

WESTRIDGE CONSTRUCTION PHASE & UTILITY PLAN
FOR
R. D. HARRIS CONSTRUCTION CO.

DESIGNED BY: REH DRAWN BY: KP CHECKED BY: WAC

JOB NO. 3749
DATE Nov 1984
SCALE 1"=100'
SHEET NO. 2 OF 22

PROPERTY OF CITY OF O'FALLON BUILDING DEPARTMENT

Westridge Phase 1+11