

ISSUE/REMARKS/DUE DATE
1 -91/5/03 - Printed
2 12/17/03 - Submitted
3 01/11/2004 - Final Submittal
4 08/2004 - Review As-Is
5 C-10-27 ADDRESSED CITY COMM-CT
(a) 10-11-07 ADDRESSED CITY COMM-CT


PREPARED FOR:
WHISPERING L.L.C.
5091 NEW BAUMGARTNER ROAD
ST. LOUIS, MISSOURI 63129
(314) 487-6717


PREPARED BY:
STERLING CO.
ENGINEERS & SURVEYORS
505 NEW BAUMGARTNER ROAD
ST. LOUIS, MISSOURI 63129
E-Mail: Sterling@sterling-eng-sur.com

PROJECT: WHISPERING WOODS
DESIGNED: SITE PLAN
CHECKED: SHEET TITLE

NO. 03 02 021
M.S.D.
P#
DIGITAL FILE LOCATION
SERIAL#STERLING-2
CUST#MP-16

SHEET 2 28

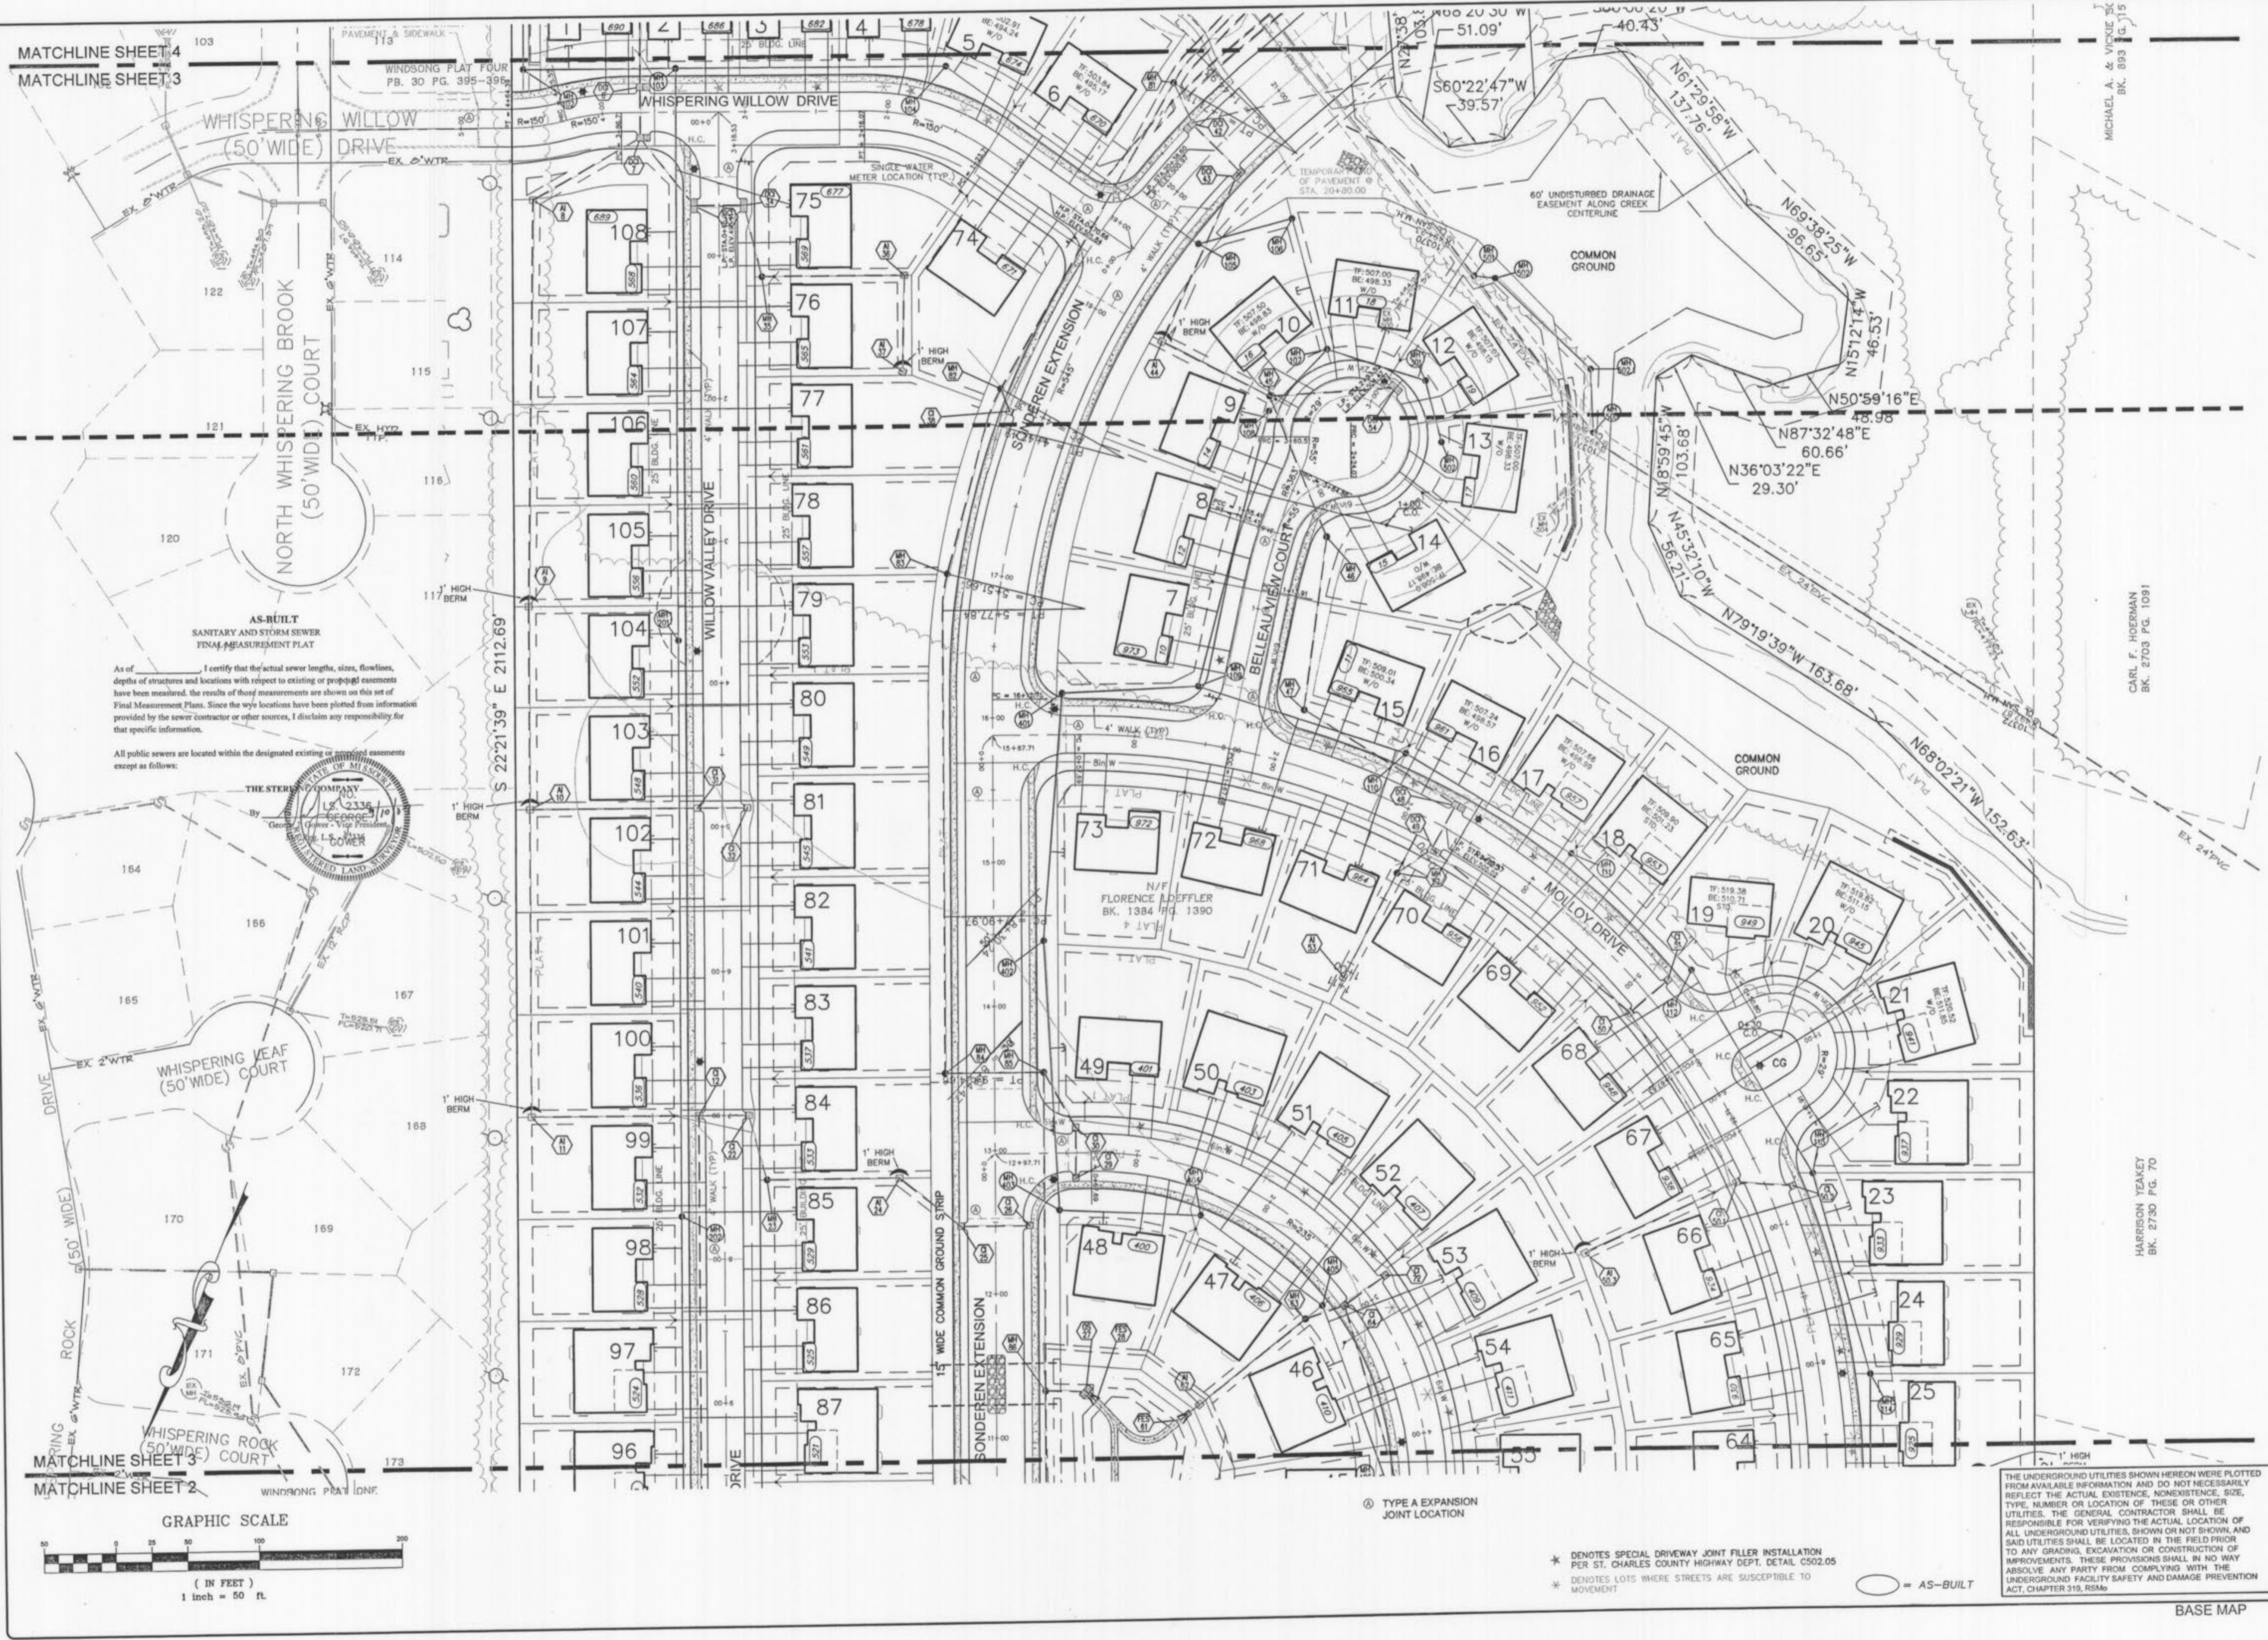

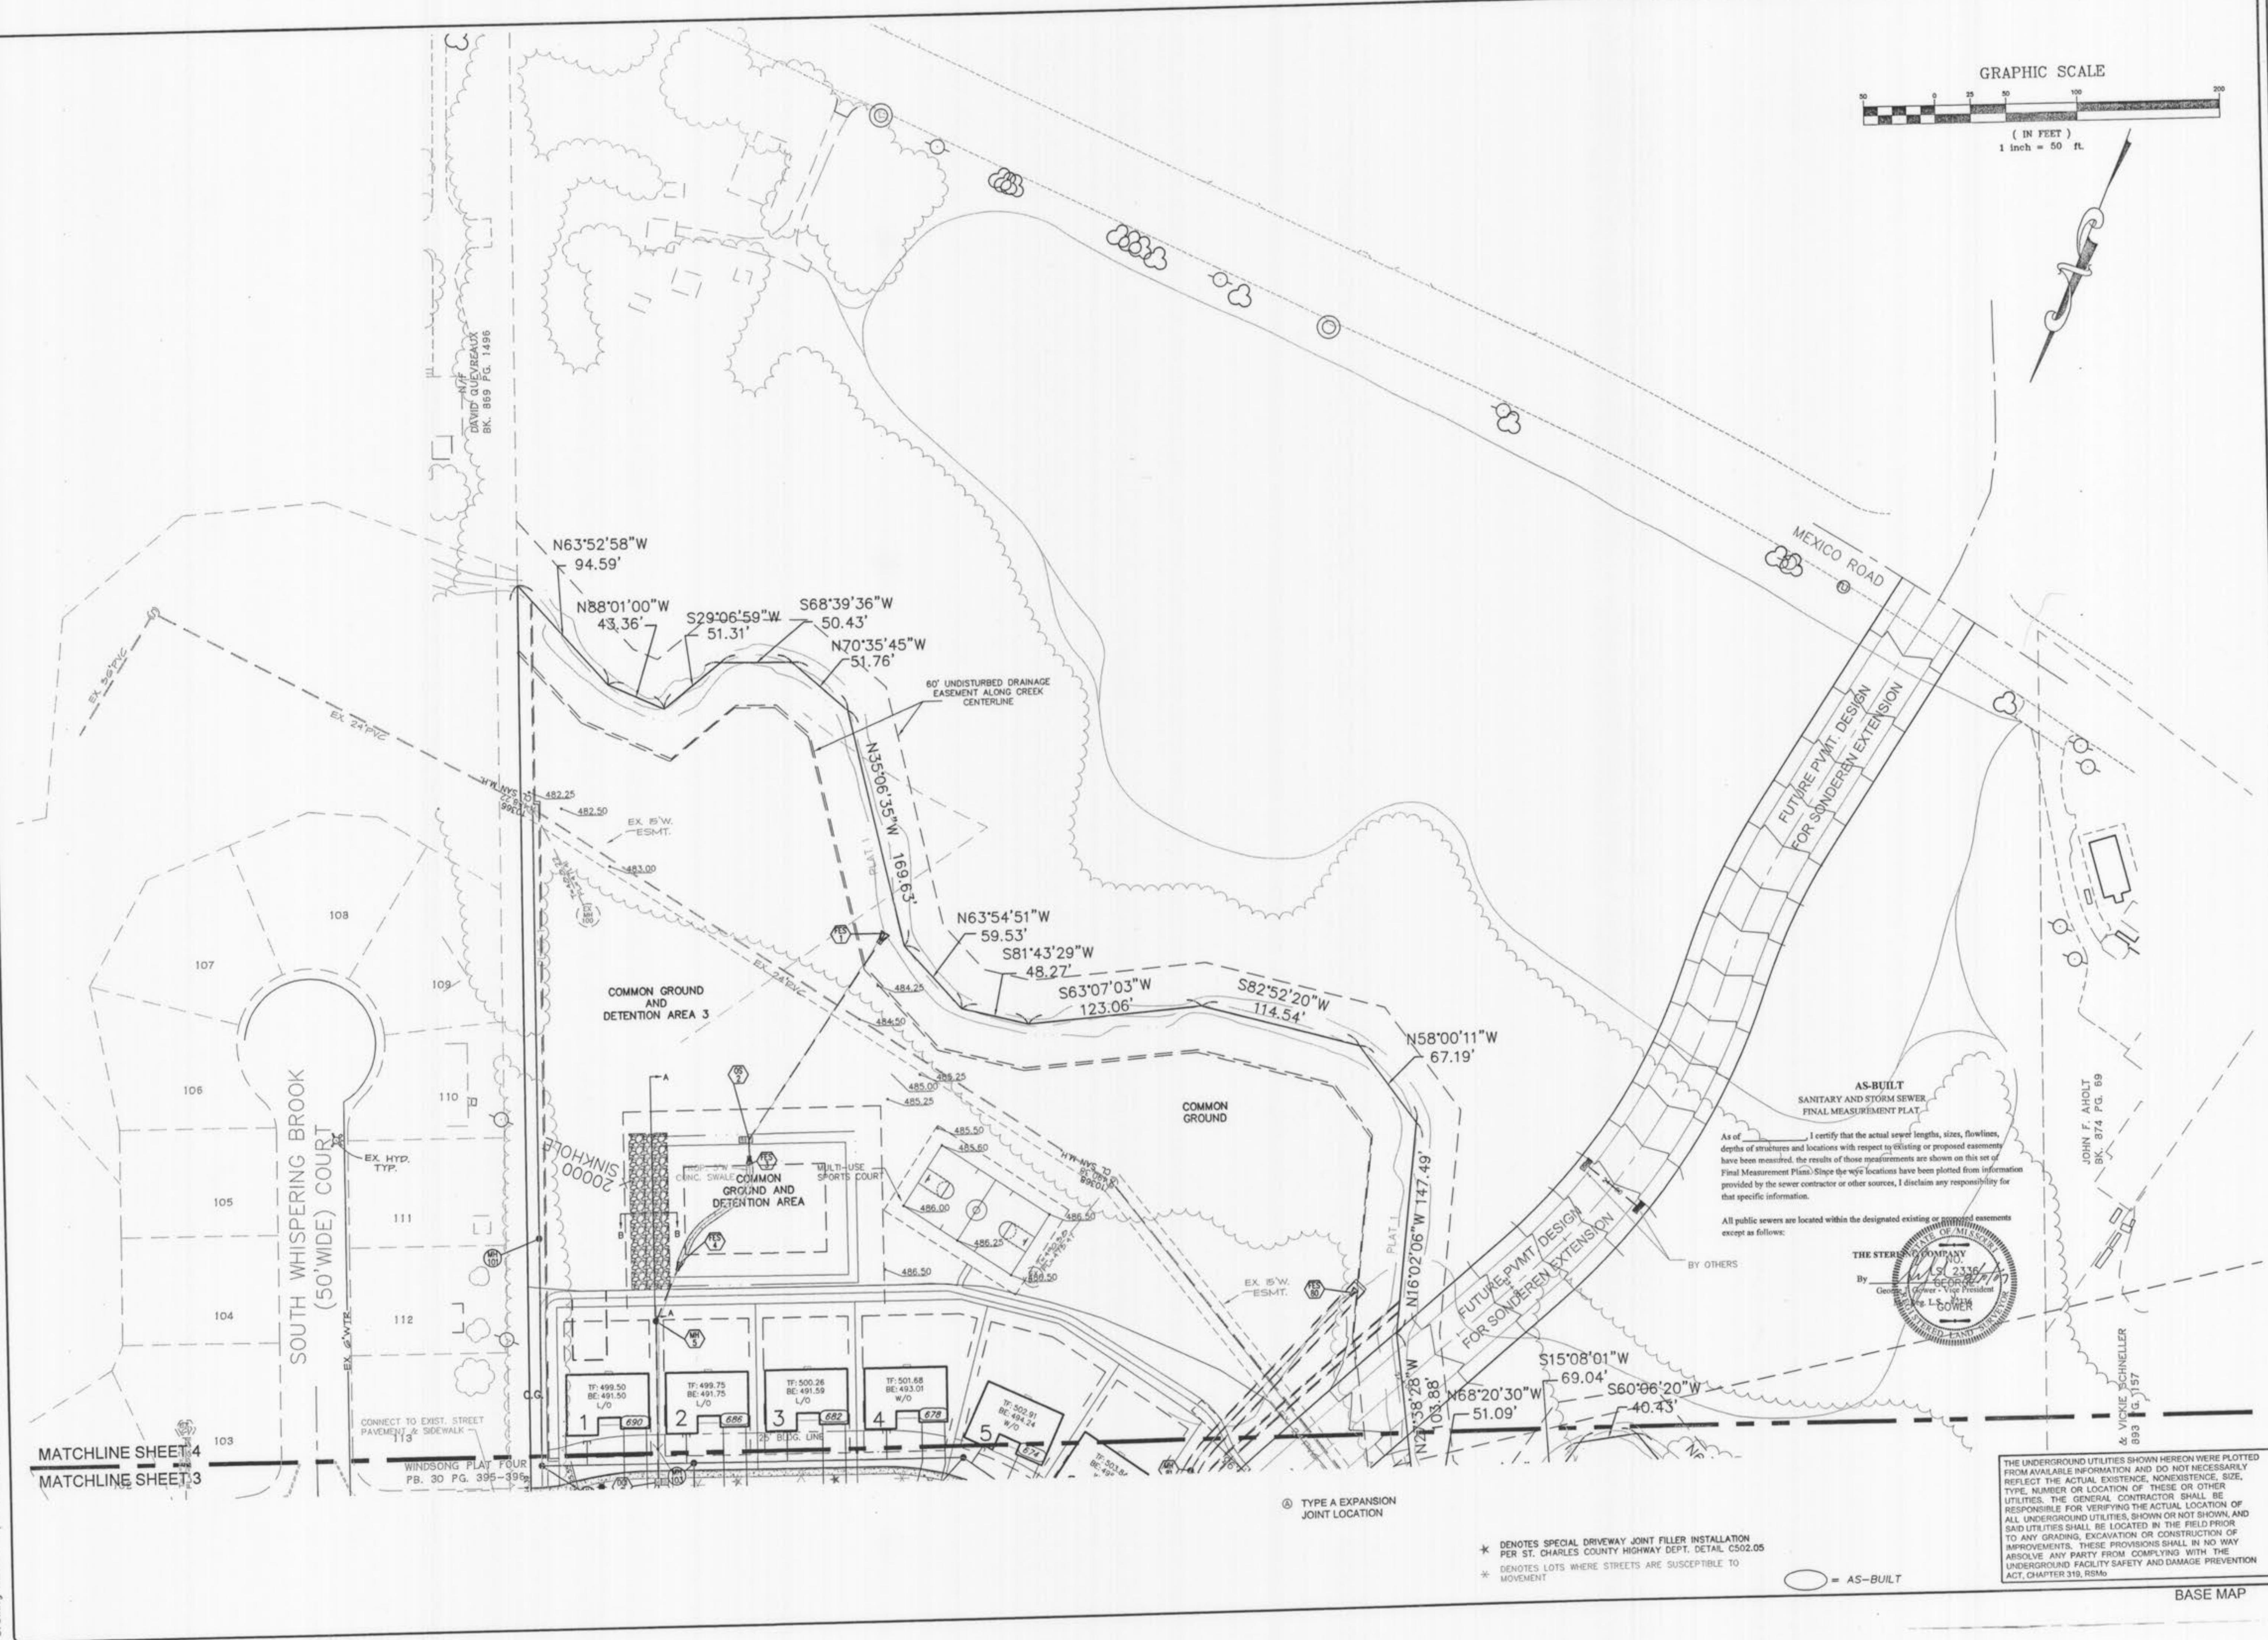

ISSUE REMARKS/DATE
1 09/15/03 - Printed
2 12/17/03 - Submitted
3 01/12/04 - Final Submittal
3 09/23/04 - Revised Address
5 9-10-07 ADRESSED
6 4-0-11-07 ADRESSED
CITY Comments


WHISPERING L.L.C.
5091 NEW BAUMGARTNER ROAD
ST. LOUIS, MISSOURI 63129
(314) 487-0440 FAX 487-3444

STERLING CO.
ENGINEERS & SURVEYORS
5055 NEW BAUMGARTNER ROAD
ST. LOUIS, MISSOURI 63129
(314) 487-0440 FAX 487-3444
E-Mail: Sterling-eng-sur.com


WHISPERING WOODS
SITE PLAN

NO. 03 02 021
M.S.D.
P#
DIGITAL FILE LOCATION
G:\SDSKPROJ\0302021 LOEFFLER TRACT\dwg\Engineering\2021imp.dwg

SHEET 4 OF 28

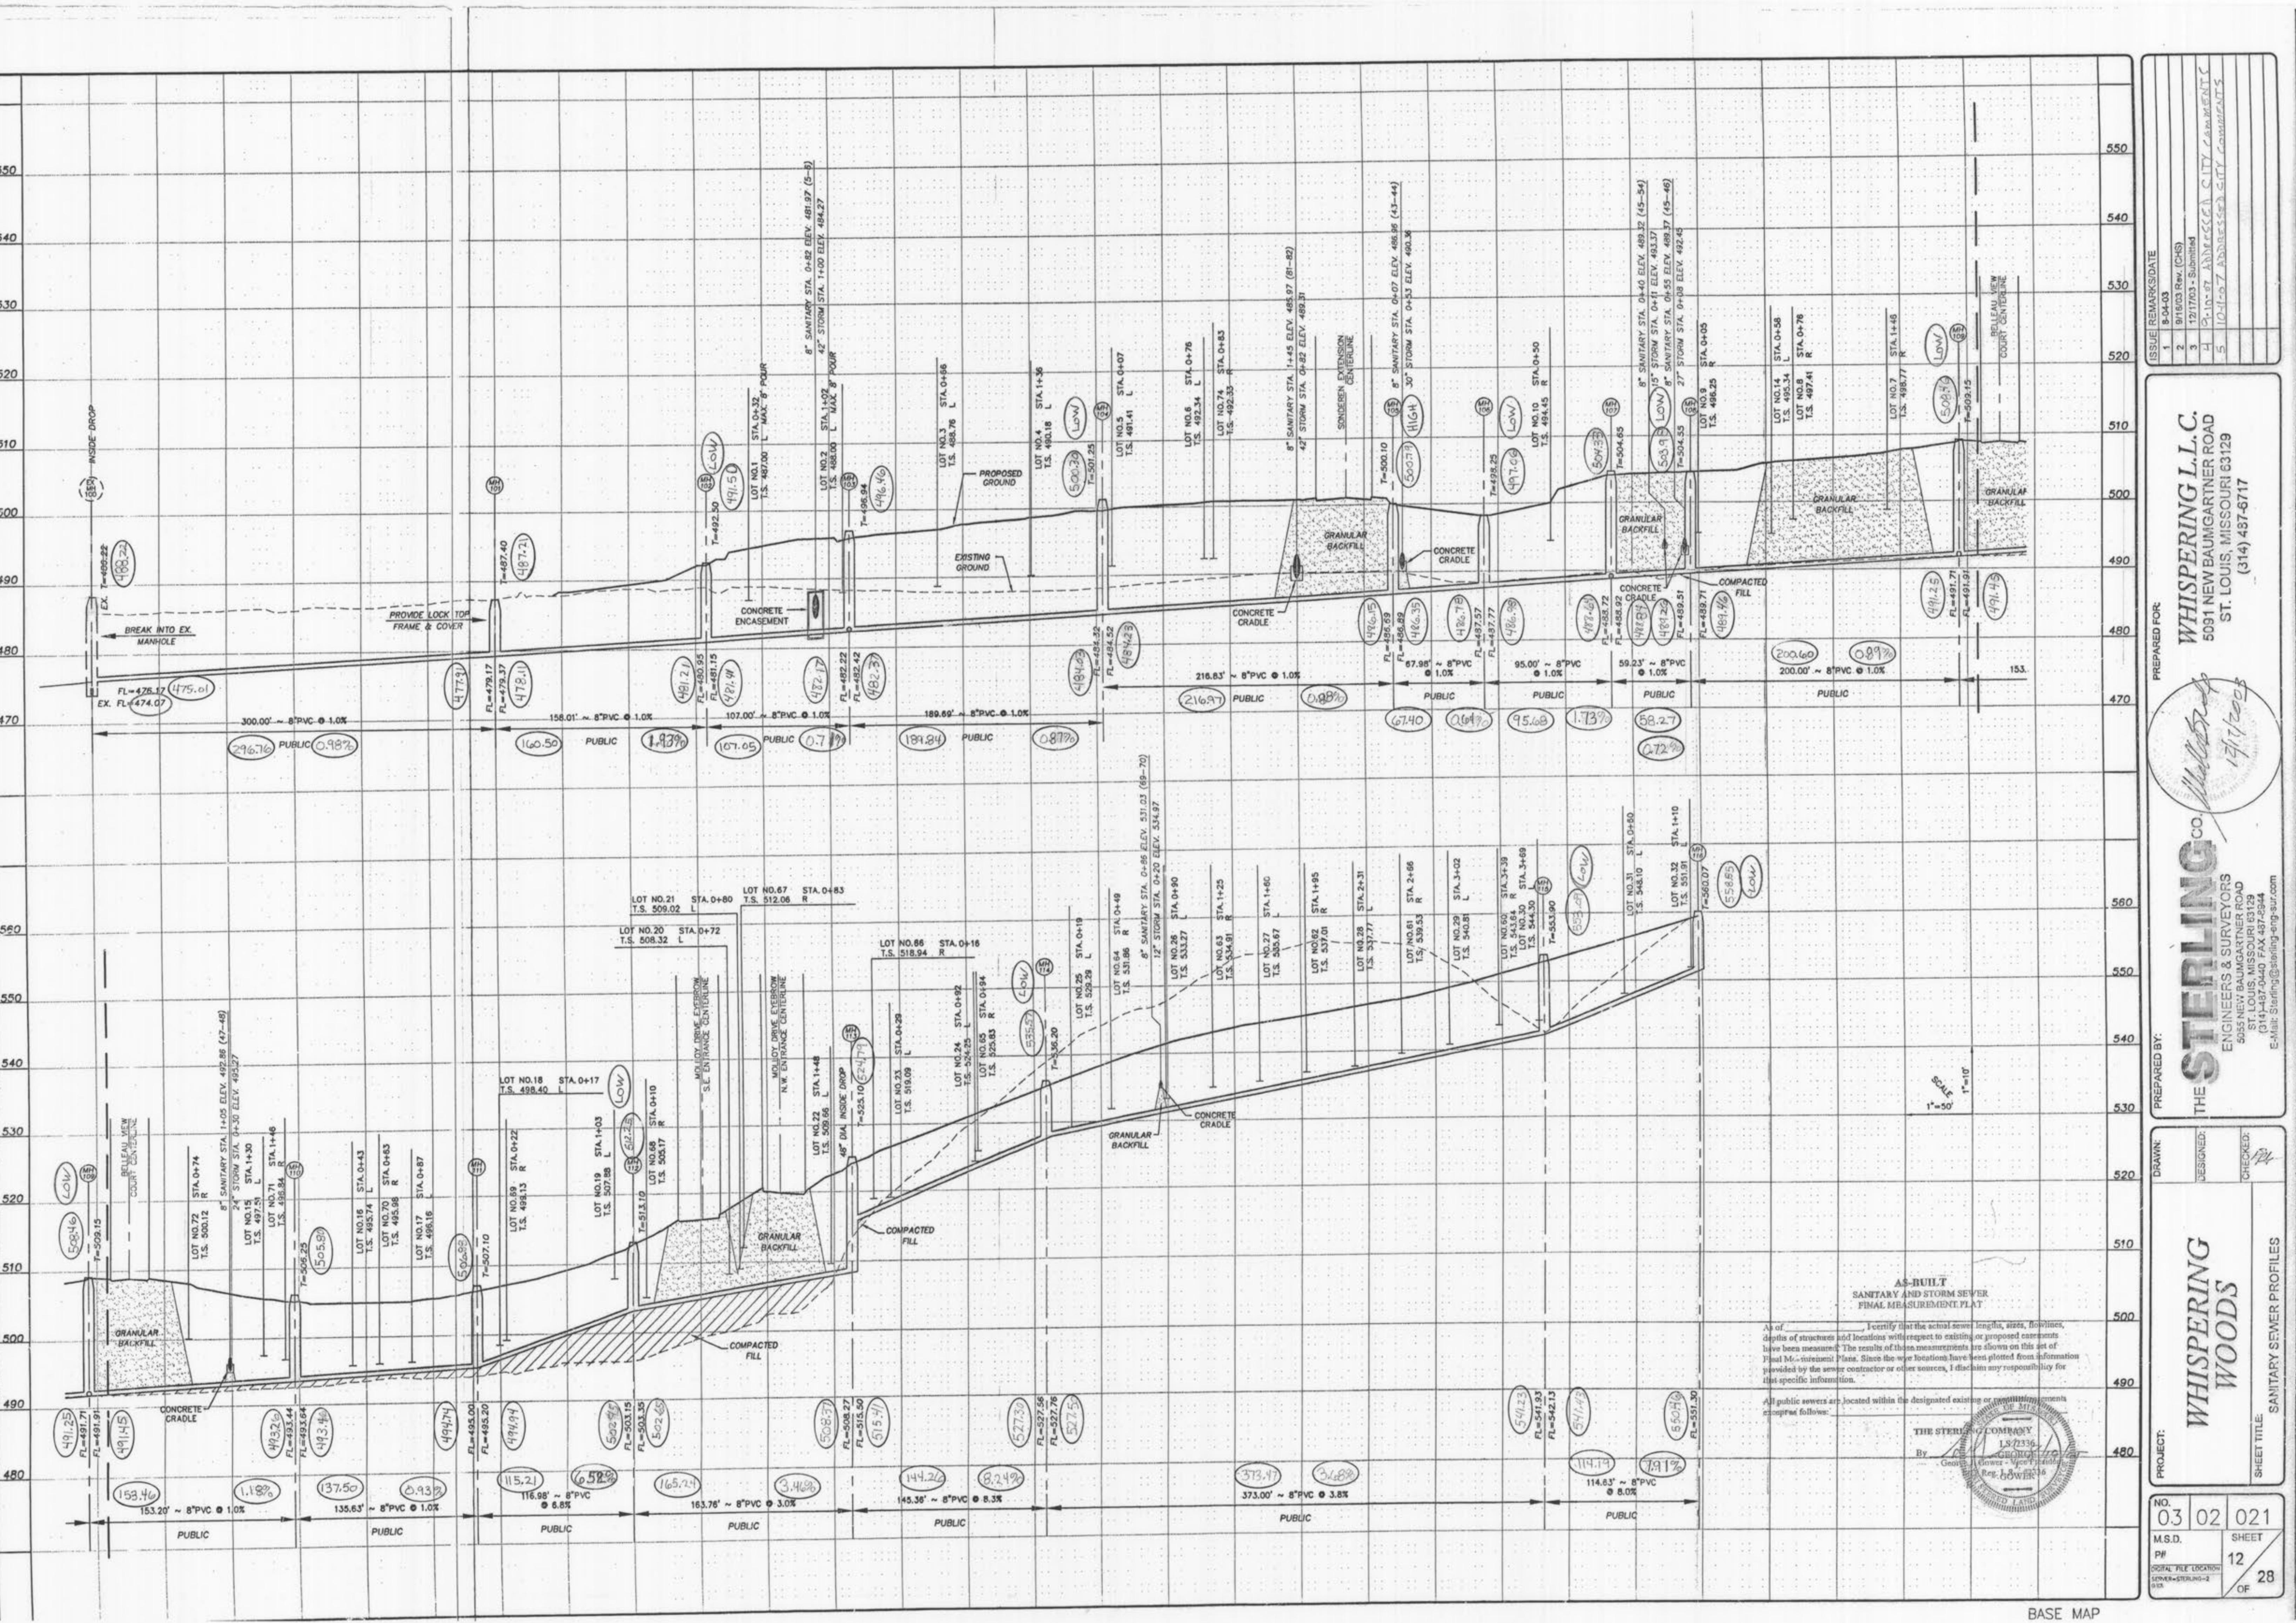

Drawing name: K:\D\0302021 LOEFFLER TRACT\improvement\2021SANPRO.dwg Plotted on: Dec 17, 2003 - 1:43pm Plotted by: cschaefer

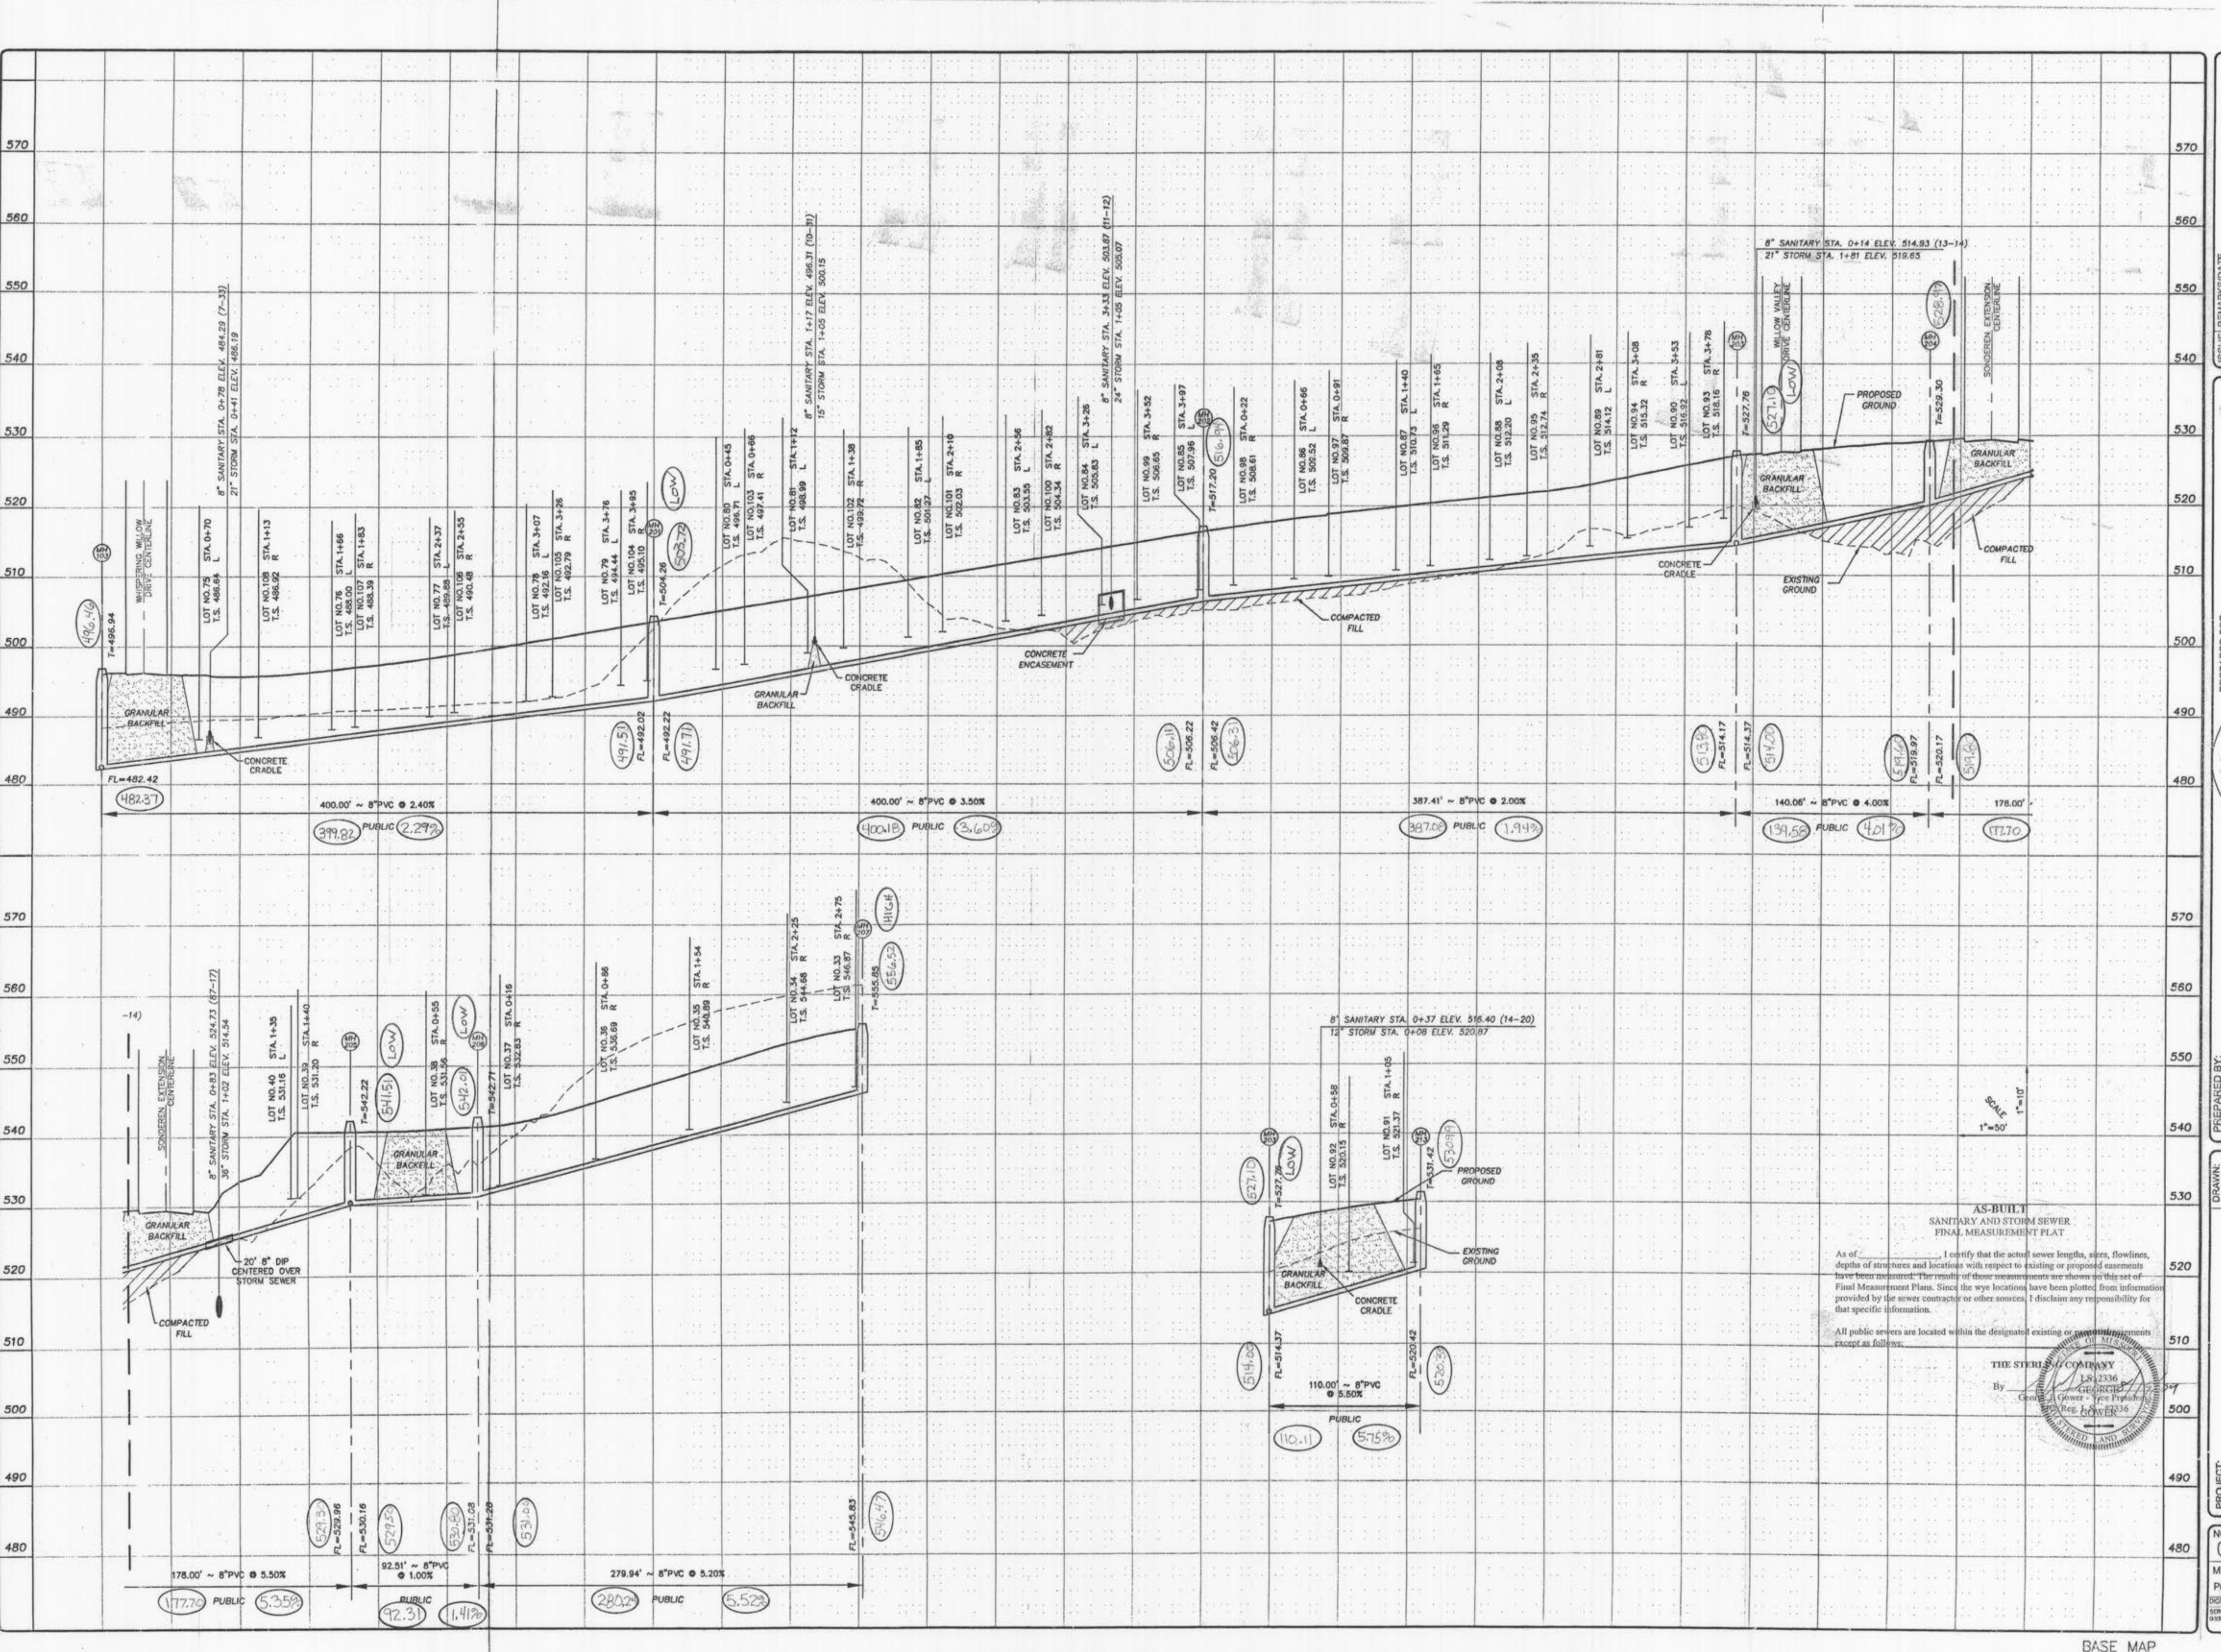

ISSUE NUMBER	ISSUE DATE
1	8-04-03
2	09/16/03 Rev. (CHS)
3	12/17/03 - Submitted
4	9-10-07 - AD
5	10-11-07 AD

ARED FOR
WHISPERING L.L.C.
5091 NEW BAUMGARTNER ROAD
ST. LOUIS, MISSOURI 63129
(314) 487-6717

PREPARED FOR:

1


WHISPERING WOODS

SHEET TITLE

O. 03	02	021
L.S.D. # TAL FILE LOCATION VER-STERLING-2	SHEET 13 OF	28

— 1 —

Drawing name: K:\D\030302021 LEFFLER TRACER improvement\2021Strm Prof.dwg Plotted on: Dec 17, 2003 - 2:03pm Plotted by: ccschaefer

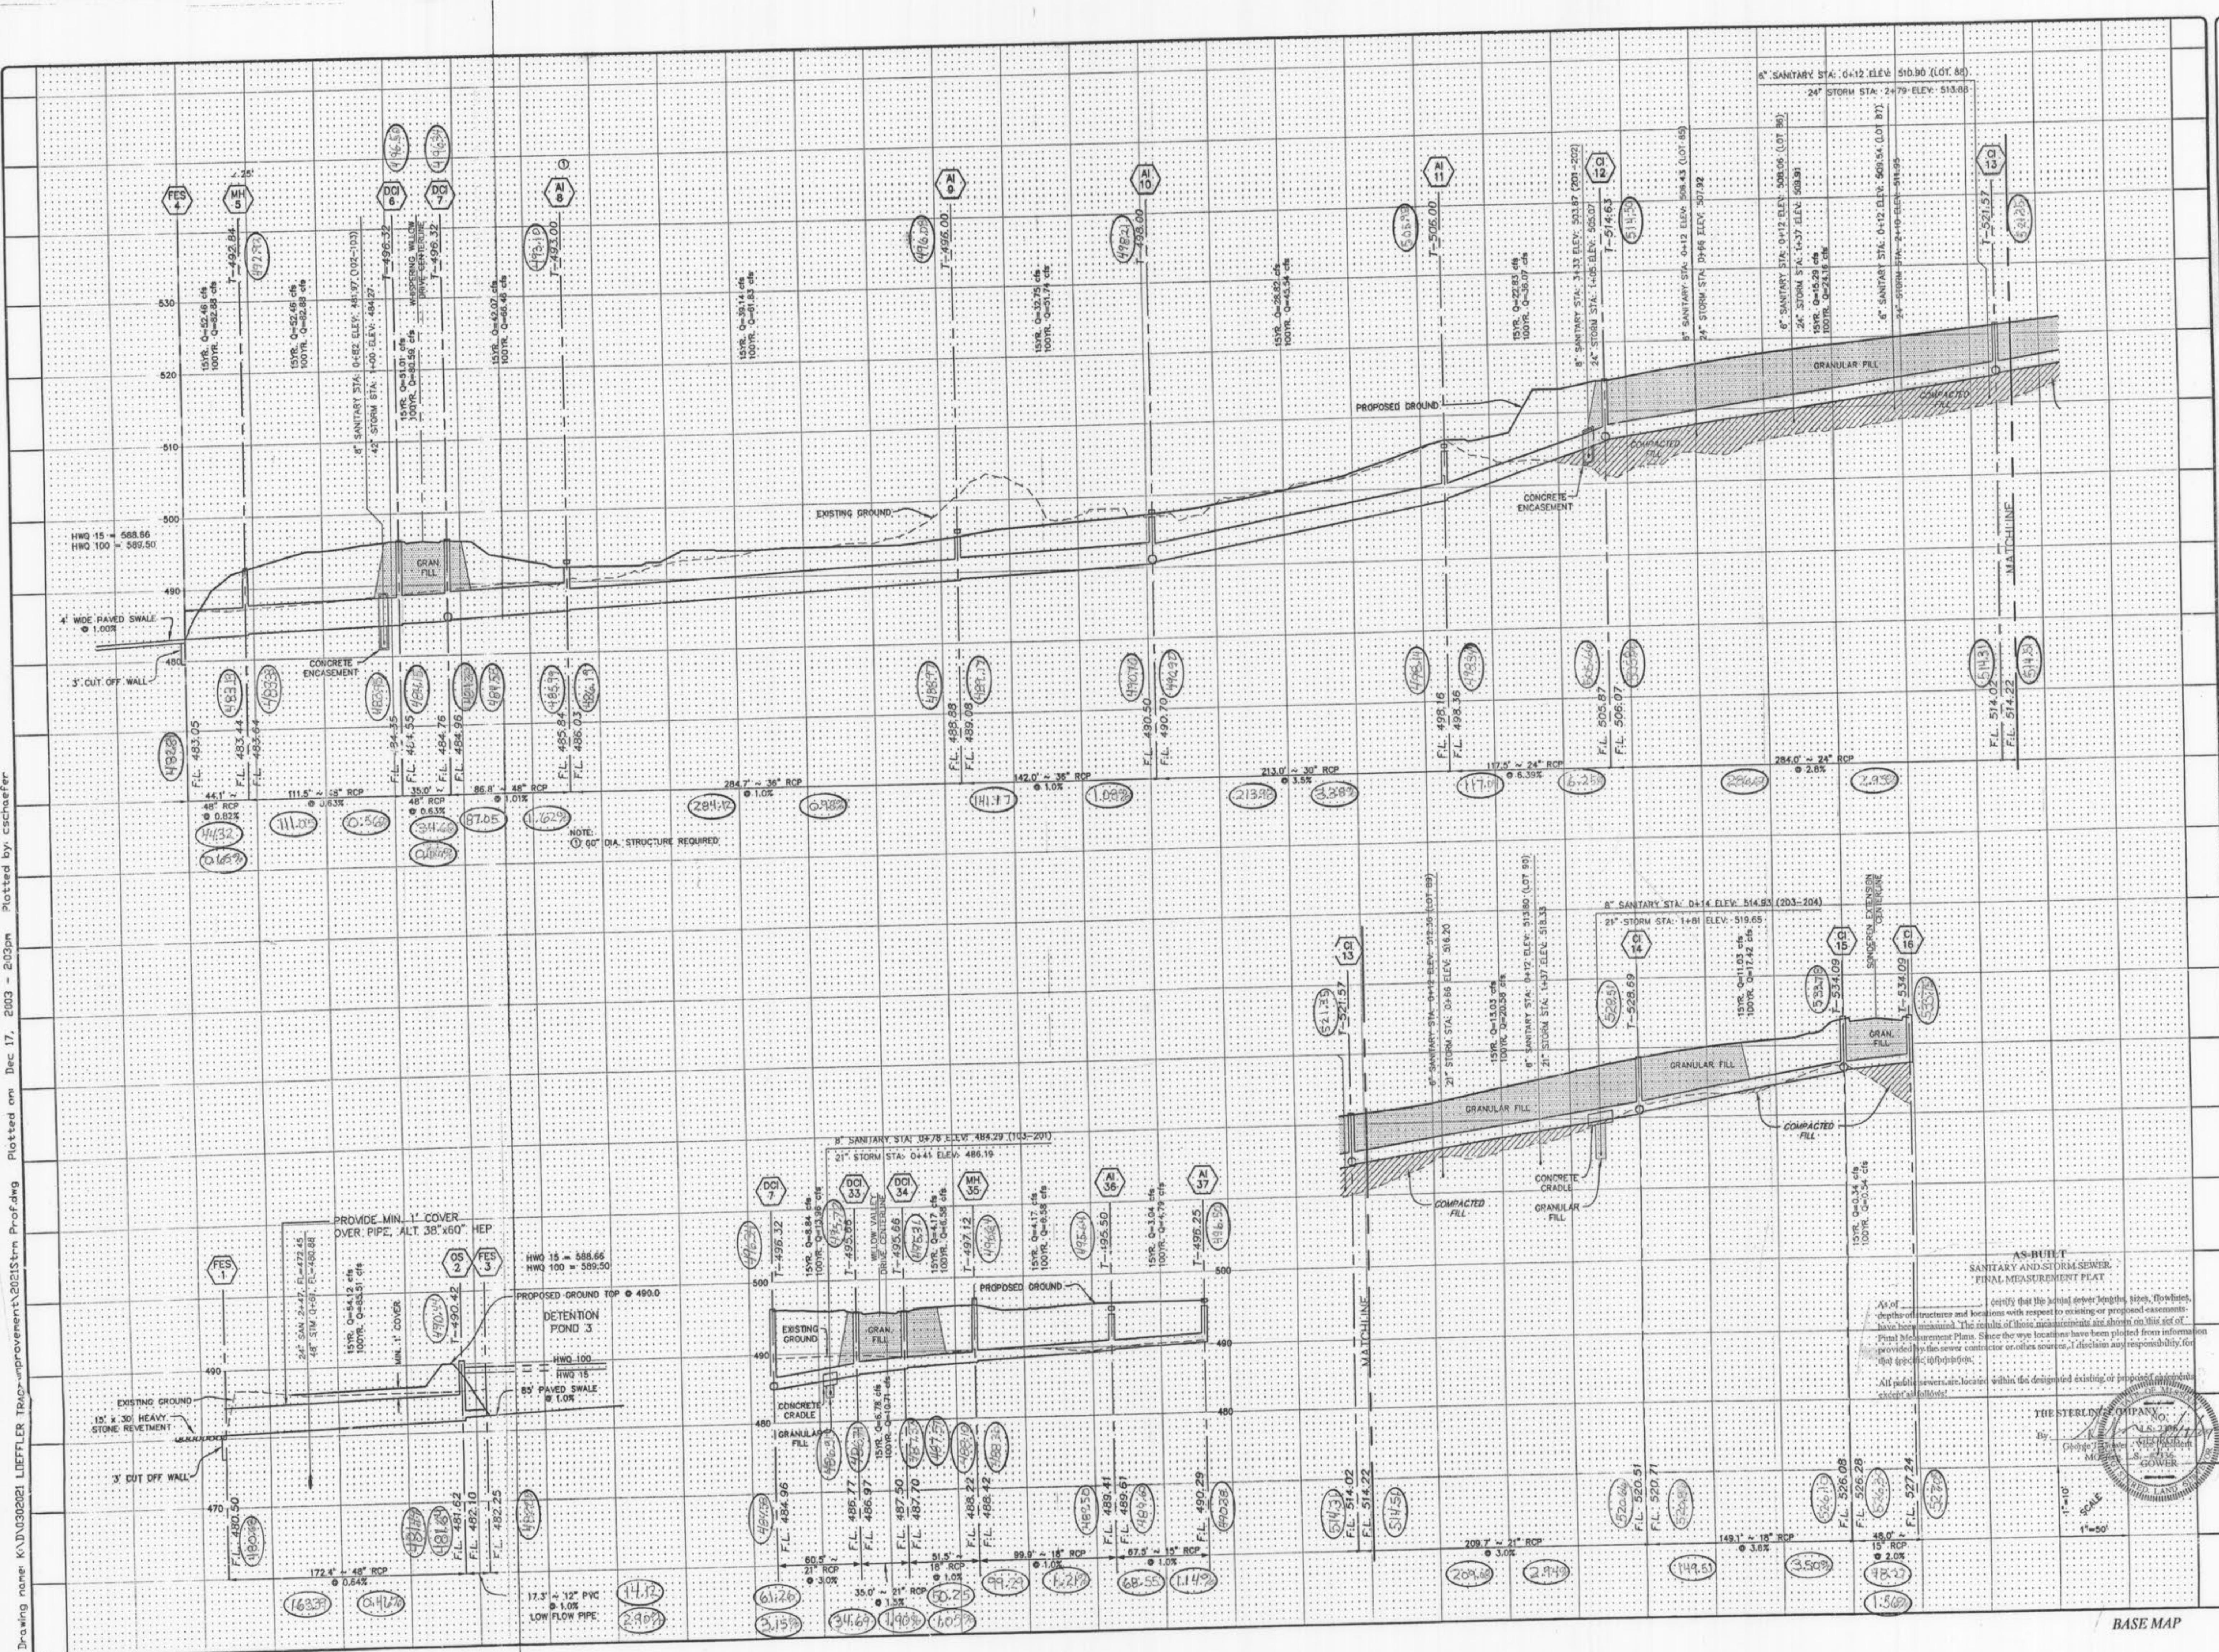

1	08-22-03
2	09-02-03
3	12-11-03
4	12/17/03 - Submitted
5	9-10-07 ADDRESSED CITY COMMENTS

SPRING L.L.C.
NEW BAUMGARTNER ROAD
ST. LOUIS MISSOURI 63129

PREPARED FOR
W.H.
5091
ST


THE SILENT KING

WHISPERING

PROJECT: V

NO. 03	02
M.S.D.	
P#	

四

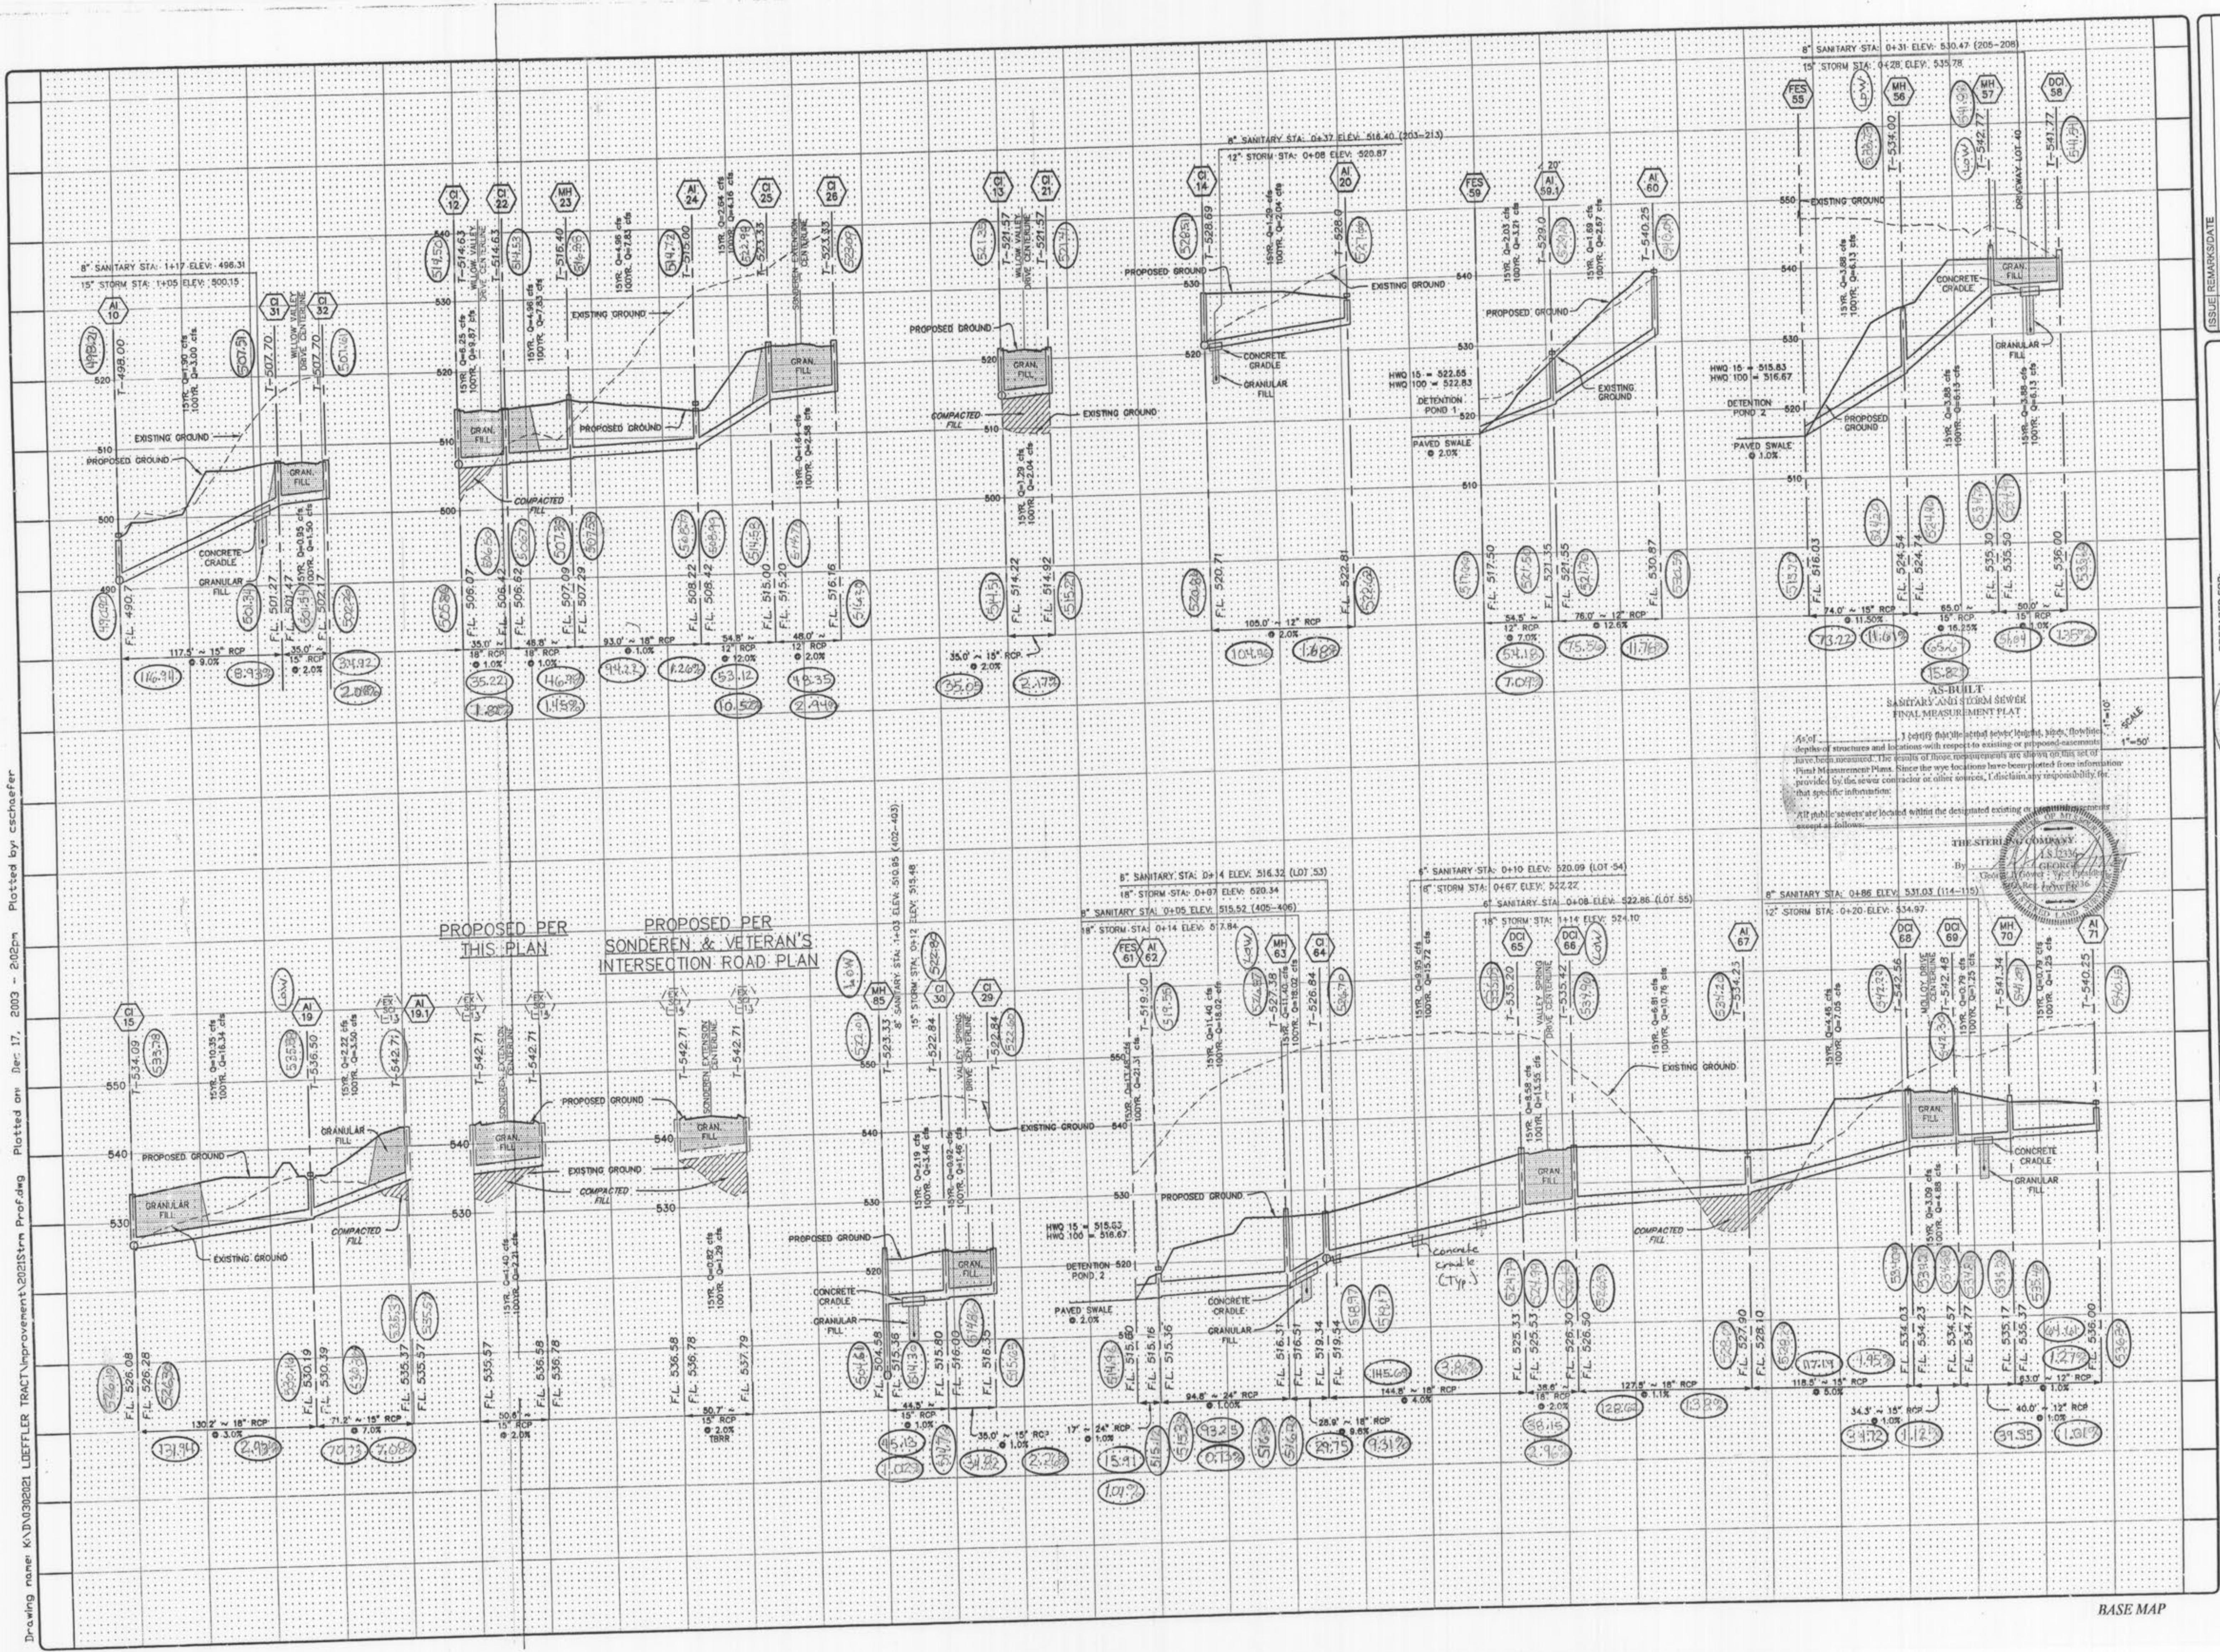

NO. 03 02 021
M.S.D.
PM
DIGITAL FILE LOCATION:
D:\DRIVE\STORING\2
DXF

16 OF 23

PROJECT: WHISPERING WOODS
DRAWN: SHEET TITL: STORM PROFILES

DRAWN:
DESIGNED:
CHECKED:
1/16/04


PREPARED BY:
THE STERLING COMPANY
By: GEORGE COOPER : Project Manager
Reg. Civil Engr. #16

STERLING CO., ENGINEERS & SURVEYORS
5025 NEW BAUMGARTNER ROAD
(314) 487-6329
E-Mail: Sterling@sterling-eng-jur.com


PREPARED FOR:
WHISPERING L.L.C.
5091 NEW BAUMGARTNER ROAD
ST. LOUIS, MISSOURI 63129
(314) 487-6717

ISSUE DATE:
1 08/25/03
2 09/02/03
3 09/15/03 - Plotted
4 12/11/03
5 12/17/03 - Submitted
6 1-10-07 ADDED
7 1-10-07 ADDED
8' SANITARY STA: 0+31 ELEV: 530.47 (205-208)
8' STORM STA: 0+28 ELEV: 535.78
13' SANITARY STA: 0+28 ELEV: 535.78
13' STORM STA: 0+28 ELEV: 535.78
18' SANITARY STA: 0+31 ELEV: 535.78
18' STORM STA: 0+28 ELEV: 535.78
23' SANITARY STA: 0+31 ELEV: 535.78
553' STORM STA: 0+28 ELEV: 535.78
5

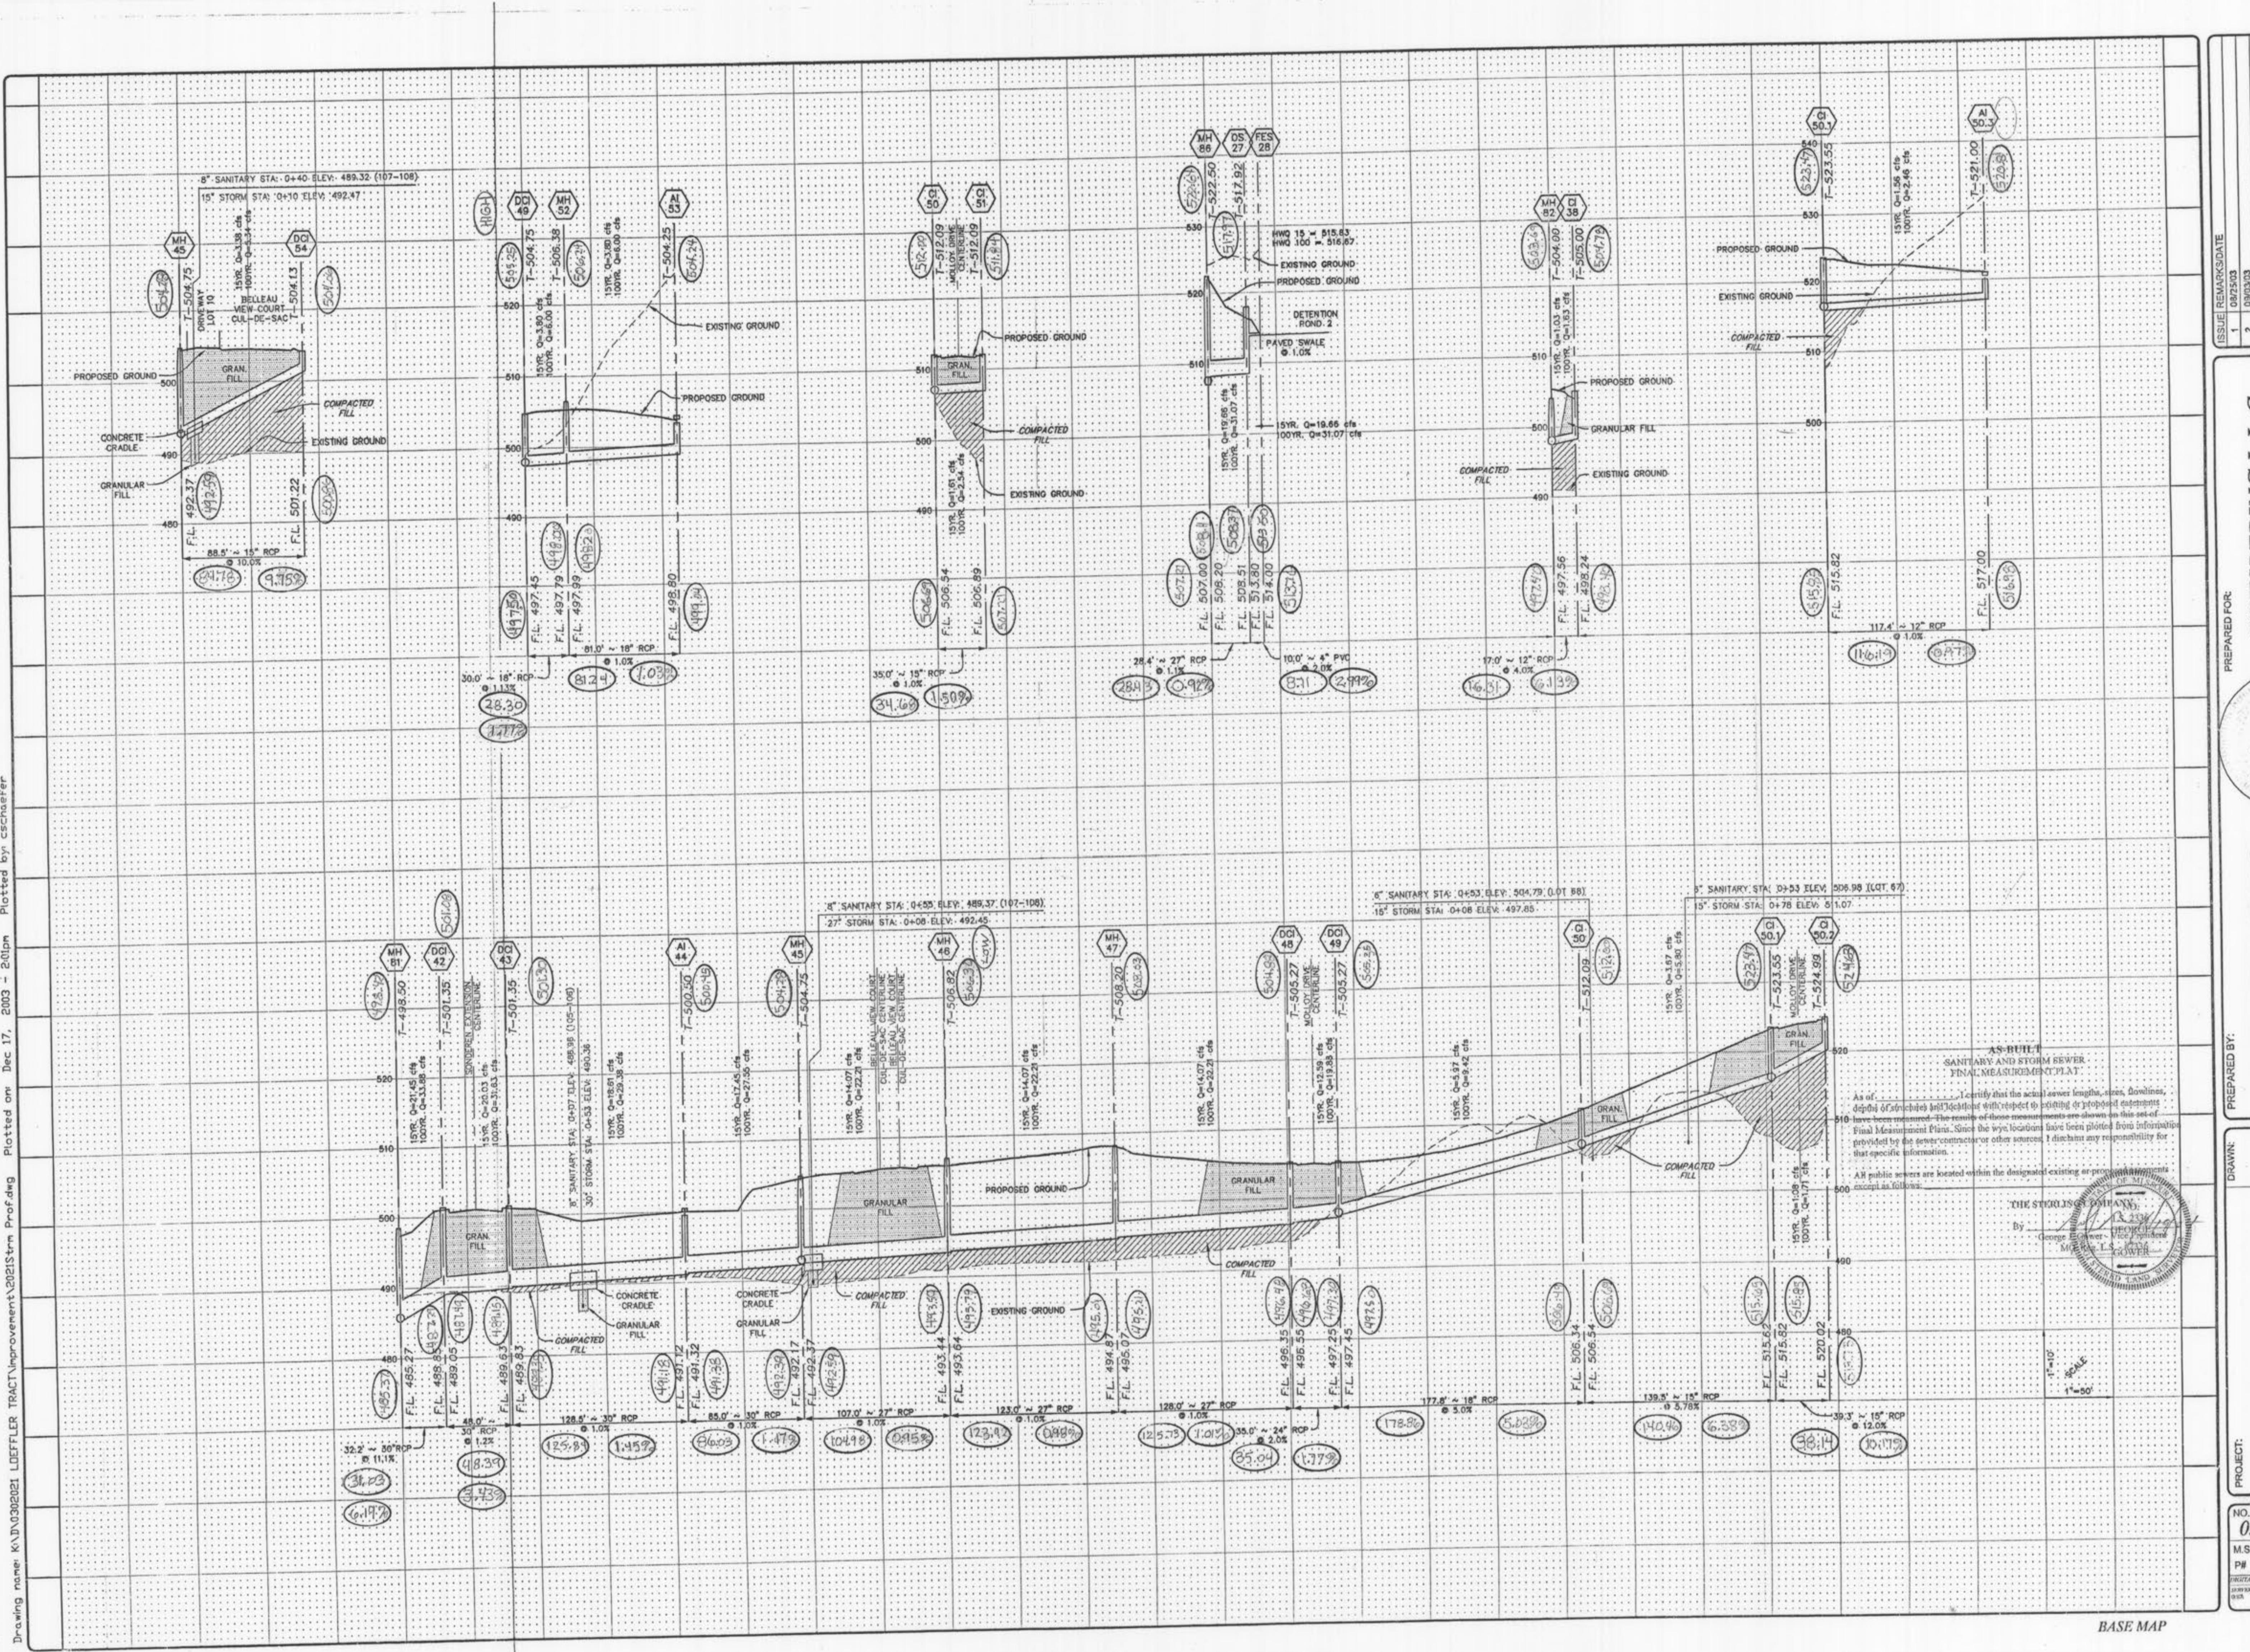

Drawing name: K:\D\0302021 LOEFFLER TRACT\improvement\2021Strm Prof.dwg Plotted on: Dec 17, 2003 - 2:01pm Plotted by c5schaefer

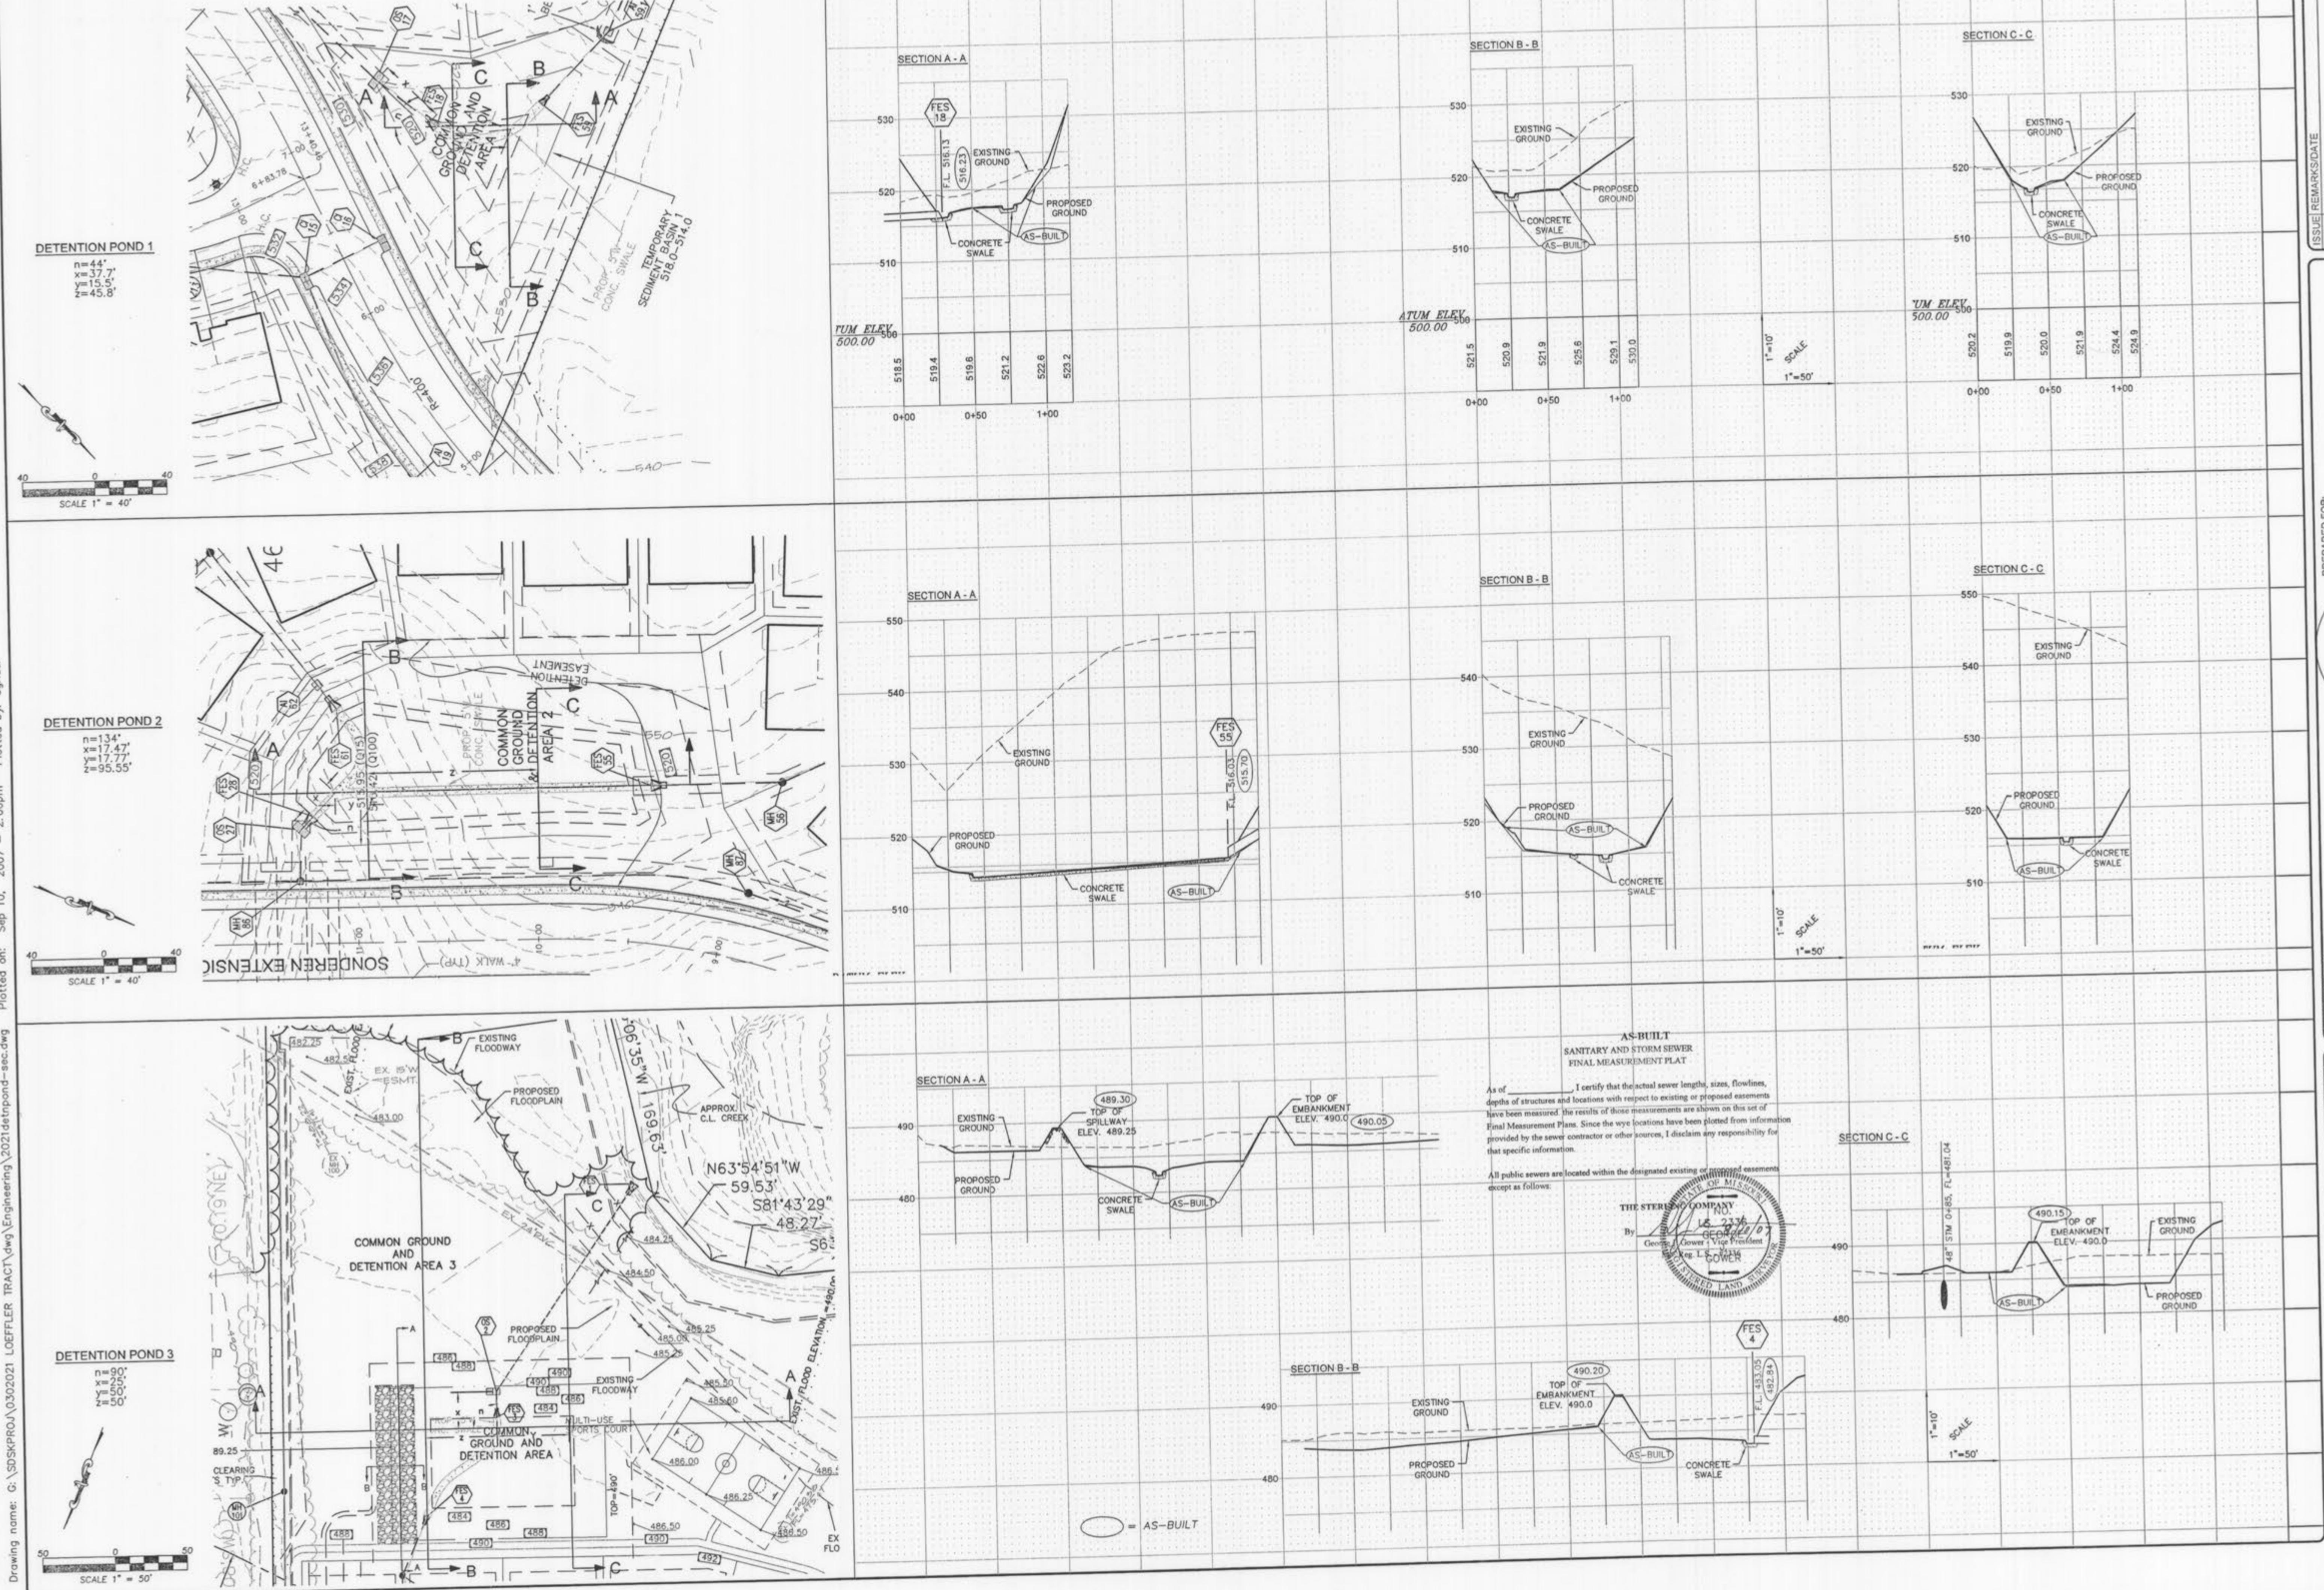

PROJECT:	WHISPERING WOODS		
DRAWN:	03	02	021
DESIGNED:			
CHECKED:			
SHEET TITLE:	DETENTION POND CROSS SECTIONS		
NO.	03	02	021
M.S.D.			
P#			
DIGITAL FILE LOCATION: SERVER-STERLING-2 K:\			

24
OF
28

ISSUE DATE / REMARKS / DATE
1 1/1/2003
2 12/12/03 - Submitted
3 Addressed CITY Commitments 1-1-1-1
4 (314) 487-6717

PREPARED FOR:
WHISPERING L.L.C.
5091 NEW BAUMGARTNER ROAD
ST. LOUIS, MISSOURI 63129
(314) 487-6717

PREPARED BY:
THE STELLING CO.
ENGINEERS & SURVEYORS
5035 NEW BAUMGARTNER ROAD
ST. LOUIS, MISSOURI 63129
(314) 487-0440 FAX: 487-8844
E-Mail: Stelling@angr.com