

THE UNDERGROUND UTILITIES SHOWN HEREON WERE PLOTTED FROM AVAILABLE INFORMATION AND DO NOT NECESSARILY REFLECT THE ACTUAL LOCATION, SIZE, NONEXISTENCE, OR OTHER NUMBER OR LOCATION OF THESE UTILITIES. THE GENERAL CONTRACTOR SHALL BE RESPONSIBLE FOR VERIFYING THE ACTUAL LOCATION OF ALL UNDERGROUND UTILITIES, SHOWN OR NOT SHOWN, AND SAID UTILITIES SHALL BE LOCATED IN THE FIELD PRIOR TO ANY DUGGING, EXCAVATION, OR CONSTRUCTION OF IMPROVEMENTS. THESE PROVISIONS SHALL IN NO WAY ABSOLVE ANY PARTY FROM COMPLYING WITH THE UNDERGROUND FACILITY SAFETY AND DAMAGE PREVENTION ACT, CHAPTER 319, RSMo.

NO. 03	02	021
M.S.D.		
P#		
DIGITAL FILE LOCATION		
DATA SOURCE-STERLING		
DATA		
STAMPING		

PROJECT: WHISPERING WOODS
DESIGNED: THE STERLING CO.
DRAWN: THE STERLING CO.
CHECKED: THE STERLING CO.
SHEET TITLE: WATER LINE ASBUILT

PREPARED FOR:
WHISPERING L.L.C.
5091 NEW BAUMGARTNER ROAD
ST. LOUIS, MISSOURI 63129
(314) 487-0717

ISSUE/REMARKS/DATE
1 6/17/03 (CHS)
2 12/17/03 - Submitted
3 01/12/04 - Final Submittal

BASE MAP whispering woods.dwg 8/6/04 A/B
A/B



THE UNDERGROUND UTILITIES SHOWN HEREON WERE PLOTTED FROM AVAILABLE INFORMATION AND DO NOT NECESSARILY REFLECT THE ACTUAL EXISTENCE, NONEXISTENCE, SIZE, TYPE, NUMBER OR LOCATION OF THESE OR OTHER UTILITIES. THE GENERAL CONDITIONS SHALL BE RESPONSIBLE FOR VERIFYING THE ACTUAL LOCATION OF ALL UNDERGROUND UTILITIES SHOWN OR NOT SHOWN, AND SAID UTILITIES SHALL BE LOCATED IN THE FIELD PRIOR TO ANY GRADING, EXCAVATION OR CONSTRUCTION OF IMPROVEMENTS. THESE PROVISIONS SHALL IN NO WAY ABSOLVE ANY PARTY FROM COMPLYING WITH THE APPROPRIATE SAFETY AND DAMAGE PREVENTION ACT, CHAPTER 319, RSMo.

BASE MAP

NO.	03	02	021
M.S.D.			
P#	26		28

DIGITAL FILE LOCATION
SERIAL#STERLING-2
2001WMP.dwg

WHISPERING WOODS

WATER LINE ASBUILT

PREPARED BY:
STERLING
ENGINEERS & SURVEYORS

5055 NEW BAUMGARTNER ROAD
ST. LOUIS, MISSOURI 63129
(314) 487-0440 FAX: 487-8944
E-Mail: Sterling-eng-sur.com

ISSUE/REMARKS/DATE

1 08/17/03 (CHS)


2 08/17/03 - Submitted

3 01/17/04 - Final Submittal

CARL F. HOFERMAN
BK. 2703 PG. 1091

WHISPERING L.L.C.
5091 NEW BAUMGARTNER ROAD
ST. LOUIS, MISSOURI 63129
(314) 487-6717

PREPARED FOR:

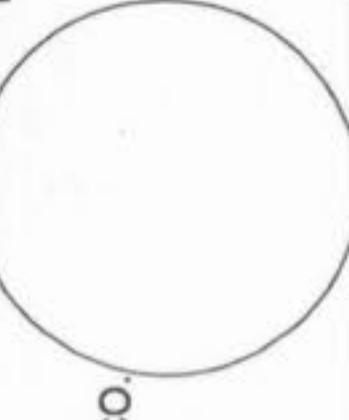

PREPARED BY:
STERLING
ENGINEERS & SURVEYORS

5055 NEW BAUMGARTNER ROAD
ST. LOUIS, MISSOURI 63129
(314) 487-0440 FAX: 487-8944
E-Mail: Sterling-eng-sur.com

PROJECT:

THE WHISPERING WOODS

DRAWN:

08/17/03


DESIGNED:

08/17/03

CHECKED:

08/17/03

A/B

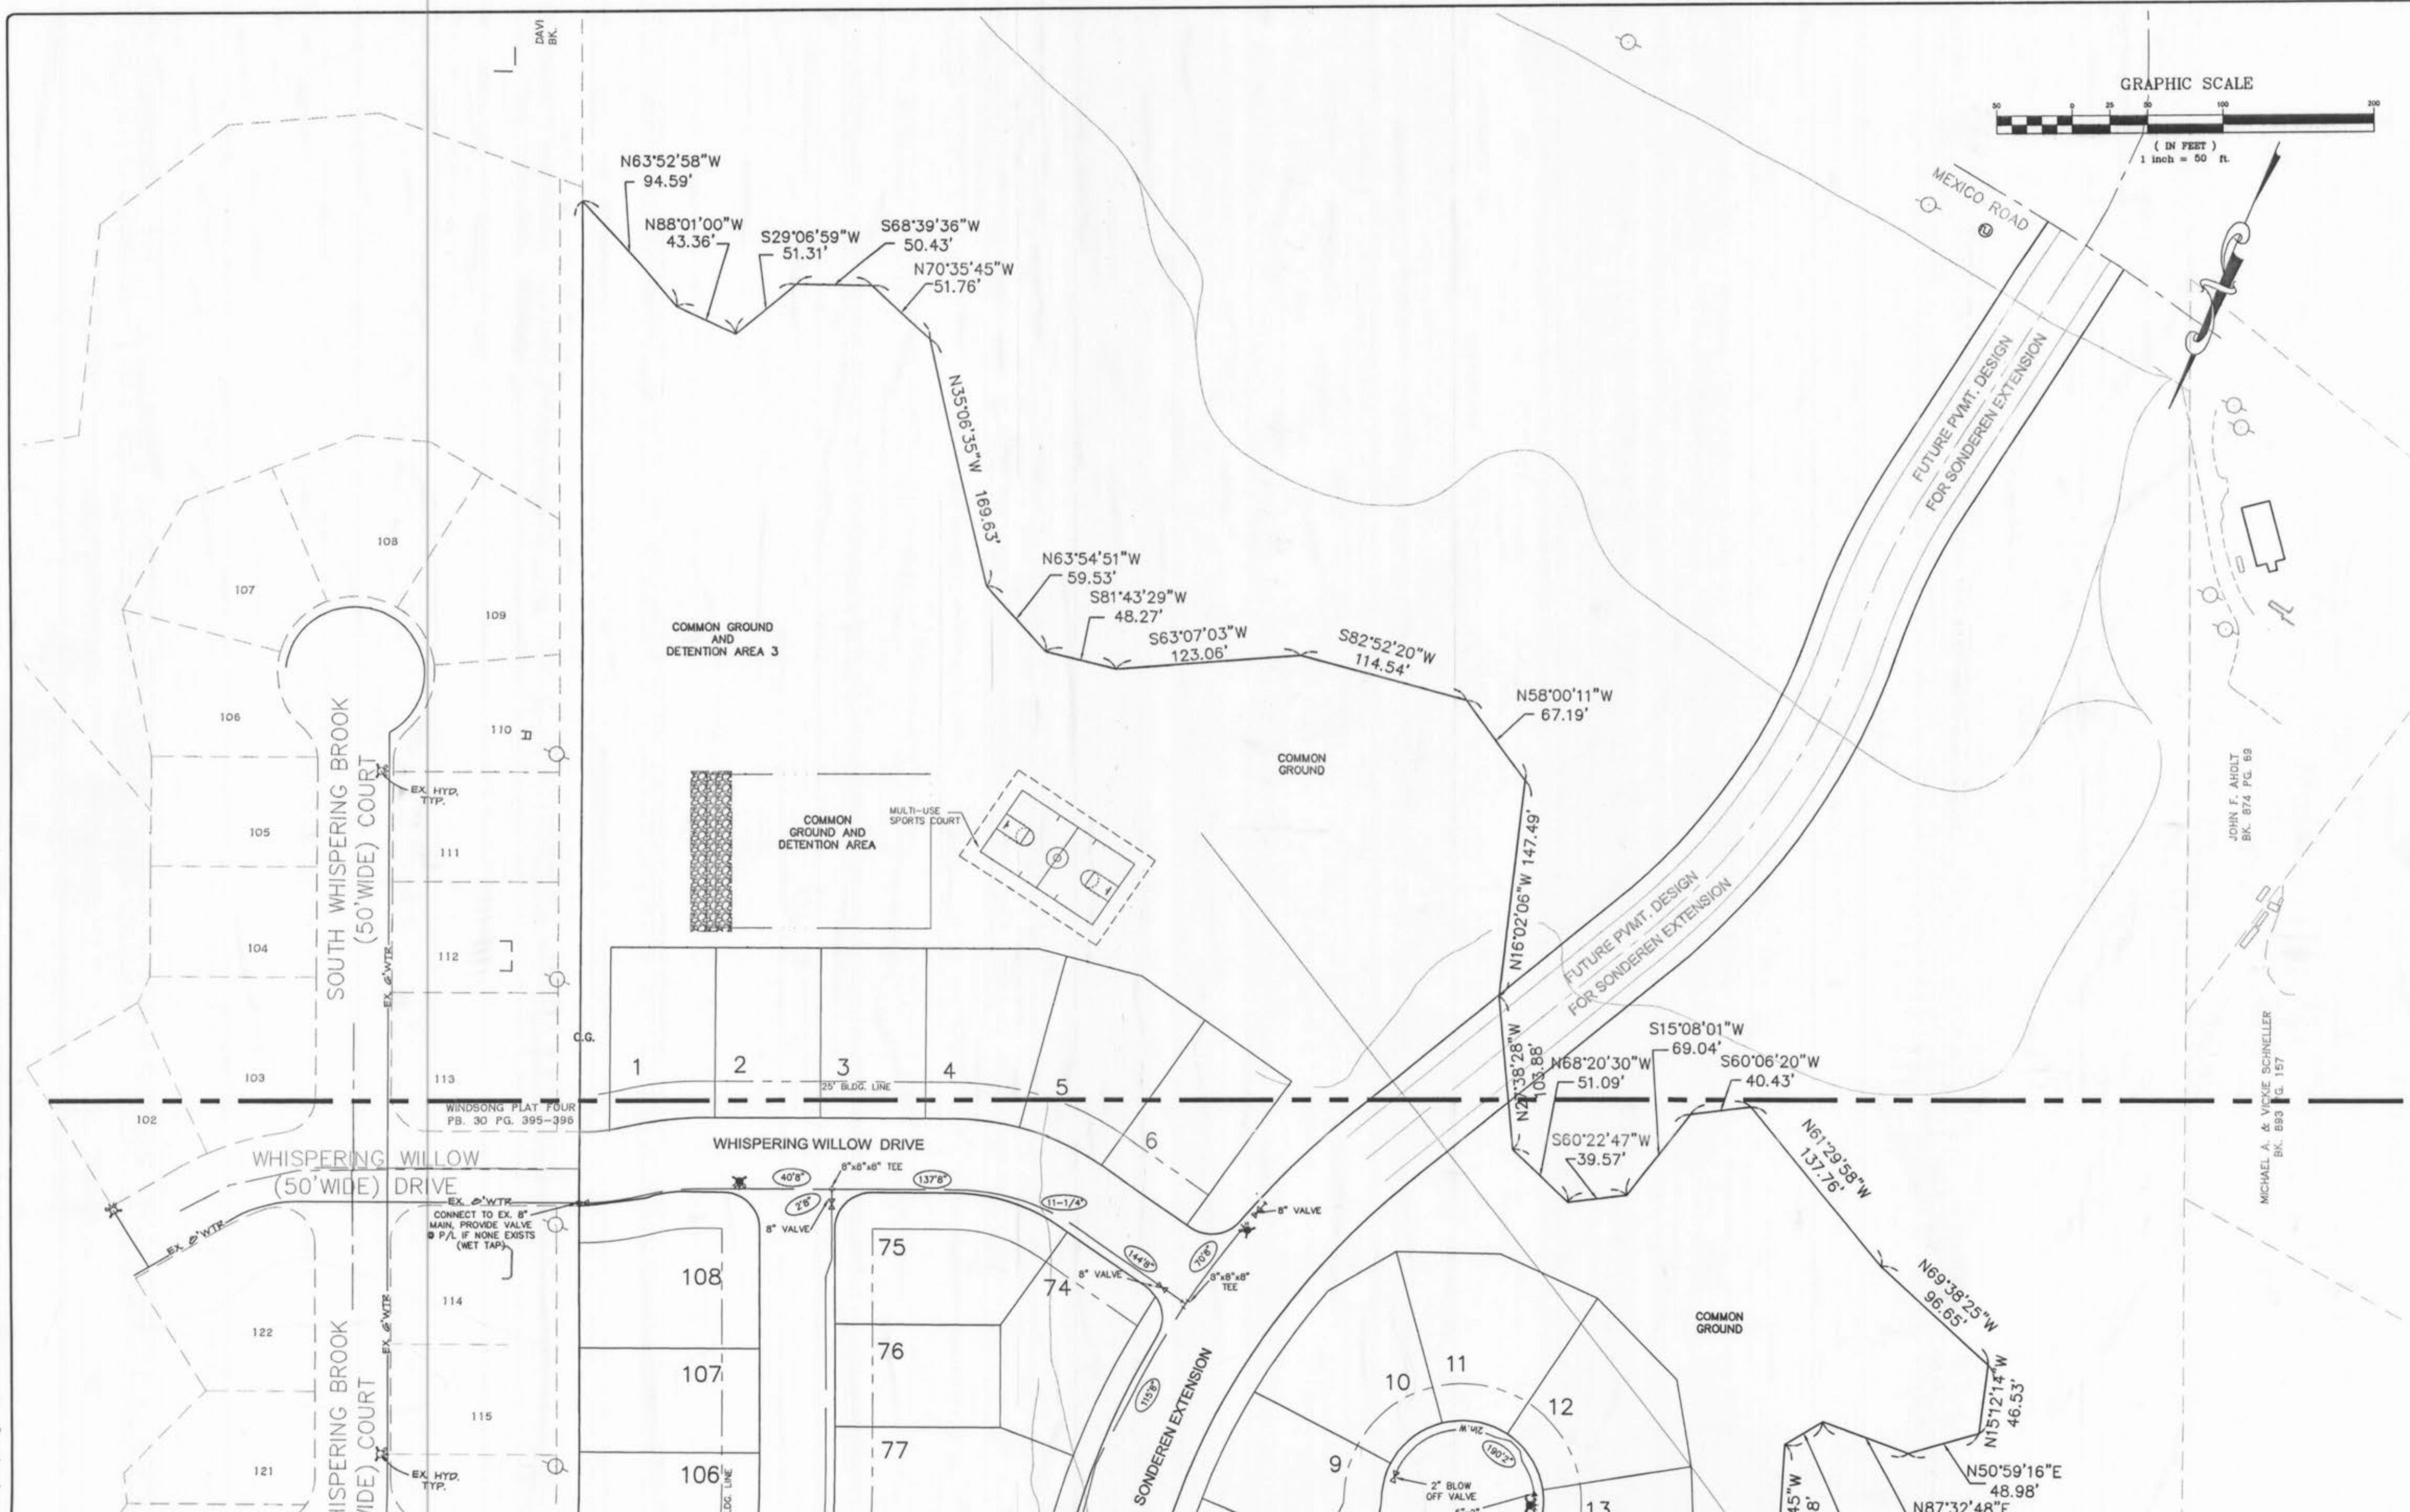

ISSUE REMARKS/DATE		
1	06/17/03 (CHS)	
2	12/17/03 - Submitted	
3	01/12/04 - Final Submittal	

WHISPERING L.L.C.
5091 NEW BAUMGARTNER ROAD
ST. LOUIS, MISSOURI 63129
(314) 487-6717

PREPARED FOR:

STERLING CO.
ENGINEERS & SURVEYORS
5091 NEW BAUMGARTNER ROAD
ST. LOUIS, MISSOURI 63129
(314) 487-0440 FAX 487-8944
E-Mail: Sterling@Sterling-Eng.com

PREPARED BY:

WHISPERING WOODS

DRAWN:

DESIGNED:

CHECKED:

REVIEWED:

APPROVED:

STAMP:

DATE:

INITIALS:

NAME:

COMPANY:

PHONE:

FAX:

E-MAIL:

WEB:

STAMP:

DATE:

INITIALS:

NAME:

COMPANY:

PHONE:

FAX:

E-MAIL:

WEB:

STAMP:

DATE:

INITIALS:

NAME:

COMPANY:

PHONE:

FAX:

E-MAIL:

WEB:

STAMP:

DATE:

INITIALS:

NAME:

<p