


GENERAL NOTES

WHITEGATE MANOR TRUNK SEWER

"AS BUILTS"
(MAY 1985)
(REV 6.19.85)

1. Gas, water and other underground utilities shall not conflict with the depth or horizontal location of existing and proposed sanitary and storm sewers including house laterals.
2. Underground utilities have been plotted from available information and therefore their locations must be considered approximate only. The verification of the location of all underground utilities, either shown or not shown on these plans shall be the responsibility of the contractor, and shall be located prior to grading or construction of improvements.
3. Polyvinyl Chloride (PVC) shall conform to the requirements of ASTM D-3034 Standard Specifications for the PSM Polyvinyl Chloride (PVC) Sewer Pipe and Fittings, SDR35.
4. Storm sewers 18" diameter or smaller shall be A.S.T.M. C-14.
5. Storm sewers 21" diameter or larger shall be A.S.T.M. C-76, Class II.
6. All storm sewer pipe under pavement, regardless of size, shall be reinforced concrete pipe (A.S.T.M. C-76, Class II) unless noted otherwise on the plans.
7. Corrugated metal pipe shall conform to the standard specifications for corrugated culvert pipe M 36, A.A.S.H.O.
8. All filled places under buildings, proposed storm and sanitary sewer lines and/or paved areas including trench backfills shall be compacted to 90% of maximum density as determined by the "Modified A.A.S.H.O. T-180 Compaction Test" (A.S.T.M. D-1557) unless otherwise specified by local governing authority specifications. All tests shall be verified by a Soils Engineer.
9. All filled places in paved State, County or City roads (Highways) shall be compacted to 90% of maximum density as determined by the "Standard Proctor Test A.A.S.H.O. T-99" (A.S.T.M. D-698) unless otherwise specified by local governing authority specifications. All tests shall be verified by a Soils Engineer.
10. Trench backfills within the road right-of-way will be water jetted and granular backfill will be used under paved areas.
11. Easements shall be provided for storm sewers, sanitary sewers and all utilities on the record plat. See record plat for location and size of easements. This does not apply to house laterals.
12. No area shall be cleared without permission of the developer.
13. All grade shall be within 0.2 feet more or less of those shown on the grading plan.
14. No slope shall be greater than 2:1 and shall be either sodded or seeded and mulched.
15. Barricades will consist of three standard 12" x 36" red and white striped scotchlite hazard markers mounted on two pound "U" channel sign post, with bottom of marker seven feet above pavement surface.
16. All manhole and catch basin tops built without elevations furnished by the Engineer will be the responsibility of the sewer contractor. At the time of construction stake-out of the sewer lines, all curb and grate inlets will be face staked. If normal face stakes fall in line with sewer construction the Engineer will set these stakes on a double offset. It shall be the responsibility of the sewer contractor to preserve all face stakes from destruction.
17. All standard street catch basins to have front of inlet 2 feet behind curb.
18. The minimum vertical distance from the low point of the basement to the flowline of a sanitary sewer at the corresponding house connection shall not be less than the diameter of the sanitary sewer plus a vertical distance not less than two and one half feet (2-1/2').
19. Water lines, valves, sleeves, meters and etc. shall meet all specifications and installation requirements of the local governing authority.
20. All cast iron pipe for water mains shall conform to AWWA specification C-106 and/or C-108. The cast iron fittings shall conform to AWWA specification C-110. All rubber gasket joints for water cast iron pressure pipe and fittings shall conform to AWWA specification C-111.
21. All water hydrants and valves shall be cast iron and installed in accordance with plans and details.
22. All sanitary and storm sewers shall meet all specifications and installation requirements of the local governing authority.
23. All PVC water pipe shall have a minimum pressure rating of PR-200 or SDR-21.
24. All PVC sanitary sewer pipe to be DR-35 or equal with crushed stone bedding uniformly graded between 1" and 1/4" size. This bedding shall extend from 6" below the pipe to 7/10 of the pipe dia. above the bottom of the pipe.
25. All grading on Missouri State Highway Right-of-Way shall be seeded and mulched and all disturbed Right-of-Way Markers shall be reset at the completion of grading.

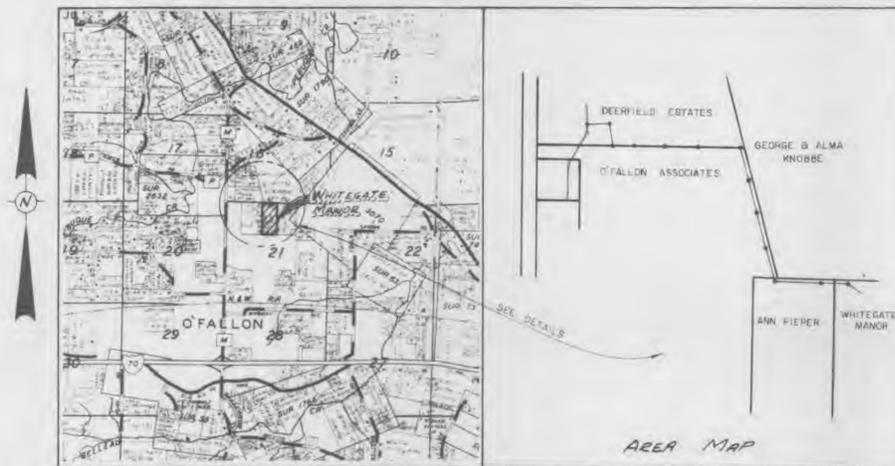

SITE LOCATION MAP

BENCHMARK No 1: R/R Spike North Face Utility Pole
At Rear Corner Lot 17 & 18 Forest
Park Addition Two Elev. 523.61
BENCHMARK No 2: Top Old Stone of North Quarter
Corner of Section 21 Elev. 524.35

LEGEND

CB	Catch basin
D.C.B.	Double catch basin
Y.C.B.	Yard catch basin
2G.C.B.	Two grates catch basin
M.H.	Manhole
F.E.	Flared end section
E.P.	End pipe
C.P.	Concrete pipe
R.C.P.	Reinforced concrete pipe
C.M.P.	Corrugated metal pipe
C.I.P.	Cast iron pipe
P.V.C.	Polyvinyl chloride pipe
V.C.P.	Vitrified clay pipe
C.O.	Clean out
V.T.	Vent trap
—	Storm sewer (proposed)
—	Sanitary sewer (proposed)
—	Existing contour
—	Proposed contour
—	Street sign
—	End of lateral
—	Lateral
5	Lot or building number
(12)	Depth of rock
—	Existing fence line
—	Existing tree line
—	Storm sewer (existing)
—	Sanitary sewer (existing)
—	Water line
—	Tee and valve
—	Cap
—	Hydrant
—	Thrust block

RECEIVED JUN 10 1985

Ninth Submittal

	CIVIL ENGINEER'S LAND SURVEYORS Pickett R P & S Silver	REV. DATE. DESCRIPTION. BY. ENGR.
		WHITEGATE MANOR DEV. CO. 661 BENT BRICK COURT ST. LOUIS, MO. 63128 PHONE: 365-2883 ATTN: FRANK TEGENHOF
DRAWN BY: [Signature] CHECKED BY: [Signature]	DATE: [Date]	1 5

PLAN	DATE
REVISION	BY
DATE	BY
DATE	BY
DATE	BY

MO. STATE ROUTE M

DEERFIELD ESTATES CORP.


EX. M.H.
TOP = 482.84
E = 469.35

ANN PIEPER
(SECOND) 95/1838


EX. M.H.
TOP = 485.06
E = 473.12

O'FALLON ASSOCIATES
a PARTNERSHIP
812/1834

NOTE:
ALL MANHOLE TOPS SHALL BE CONSTRUCTED
A MINIMUM OF 0.2M. HIGHER THAN EXISTING
GRADE.

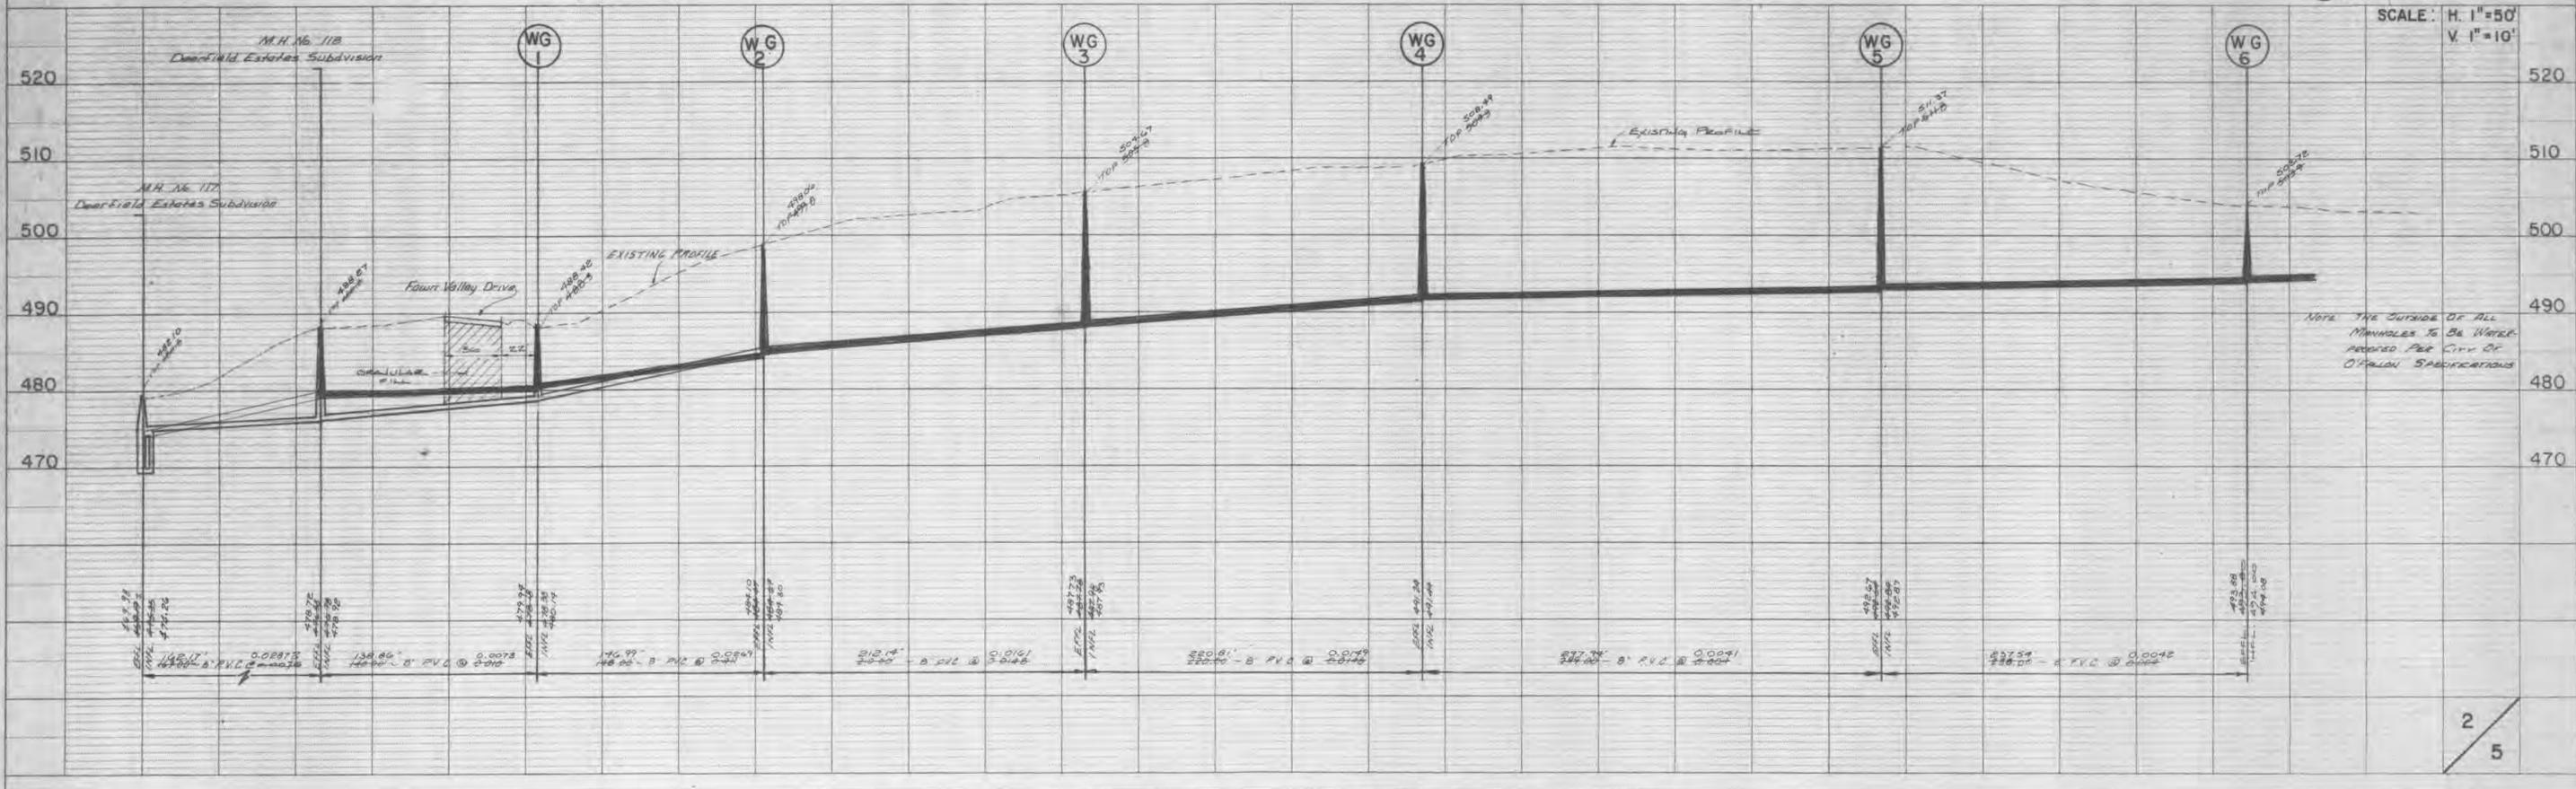

DATE	
BY	
PLAN	
NO. OF SHEETS	
NO. OF SHEETS CHECKED	
NO. OF SHEETS NOT CHECKED	

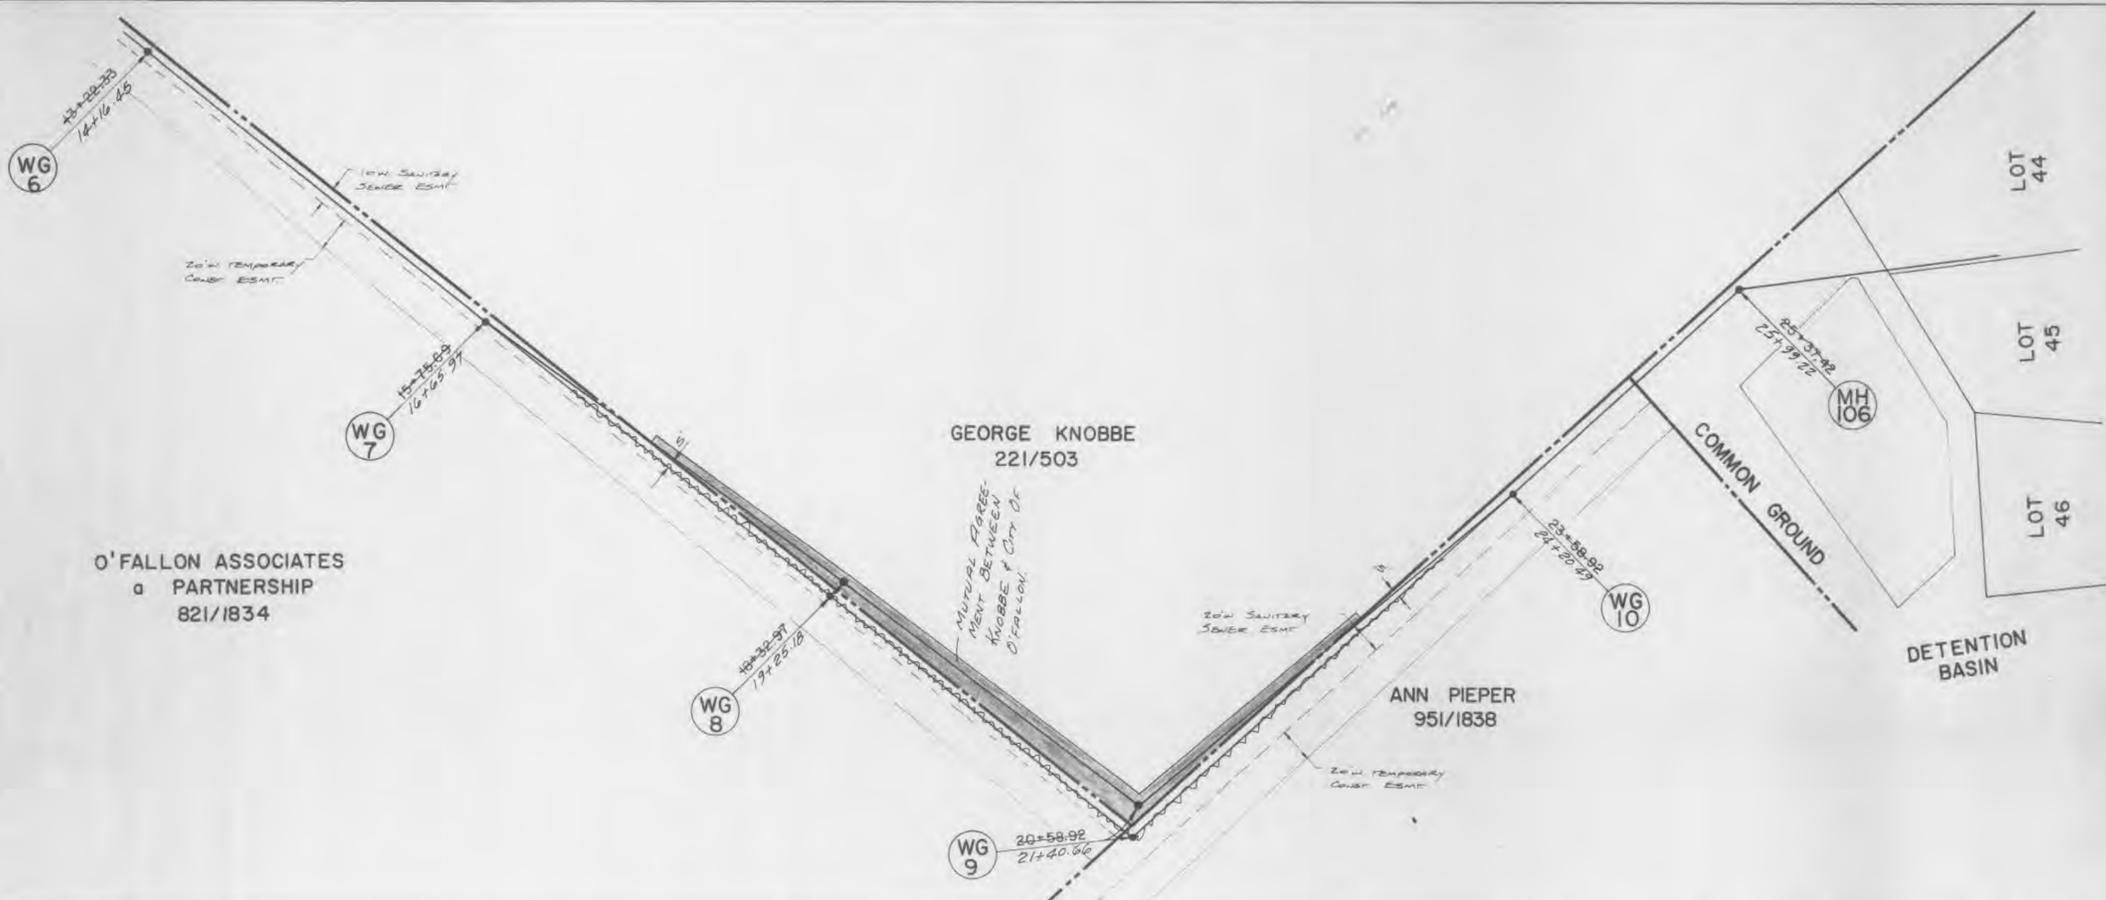

O'FALLON ASSOCIATES
a PARTNERSHIP
821/1834


GEORGE KNOBBE
221/503

ANN PIEPER
951/1838

WHITEGATE MANOR
DEVELOPMENT CO.
991/685

NOTE:
ALL MANHOLE TOPS SHALL BE CONSTRUCTED A
MINIMUM OF ONE FOOT HIGHER THAN EXISTING GROUND

DATE	
BY	
PROFILE	
NO. OF SHEETS	
NO. OF SHEETS CHECKED	
NO. OF SHEETS NOT CHECKED	

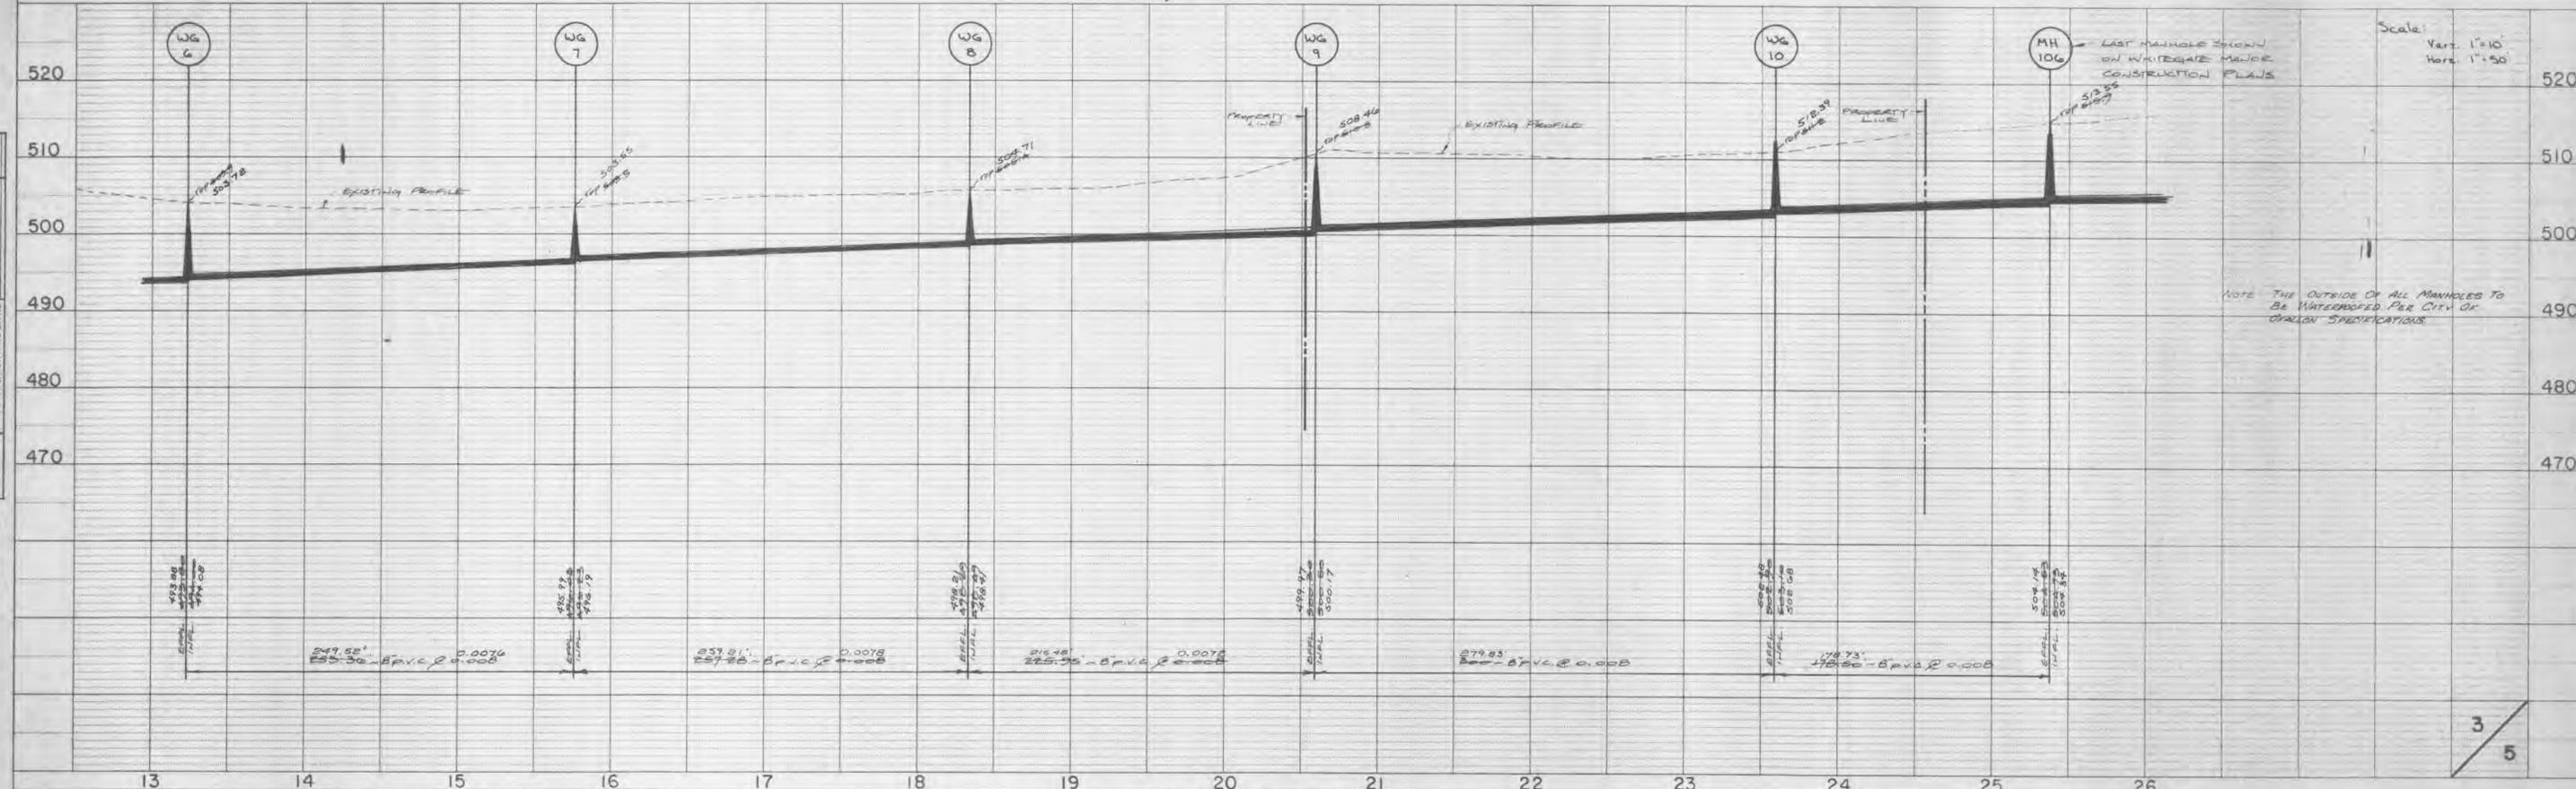

Scale:
Vert. 1"=10'
Hori. 1"=50'

NOTE: THE OUTSIDE OF ALL MANHOLES TO
BE WATERPROOFED PER CITY OF
CHALMERS SPECIFICATIONS