


COPPERFIELD SUBDIVISION  
 PLAT 3  
 P.O. CT., P. 2 120

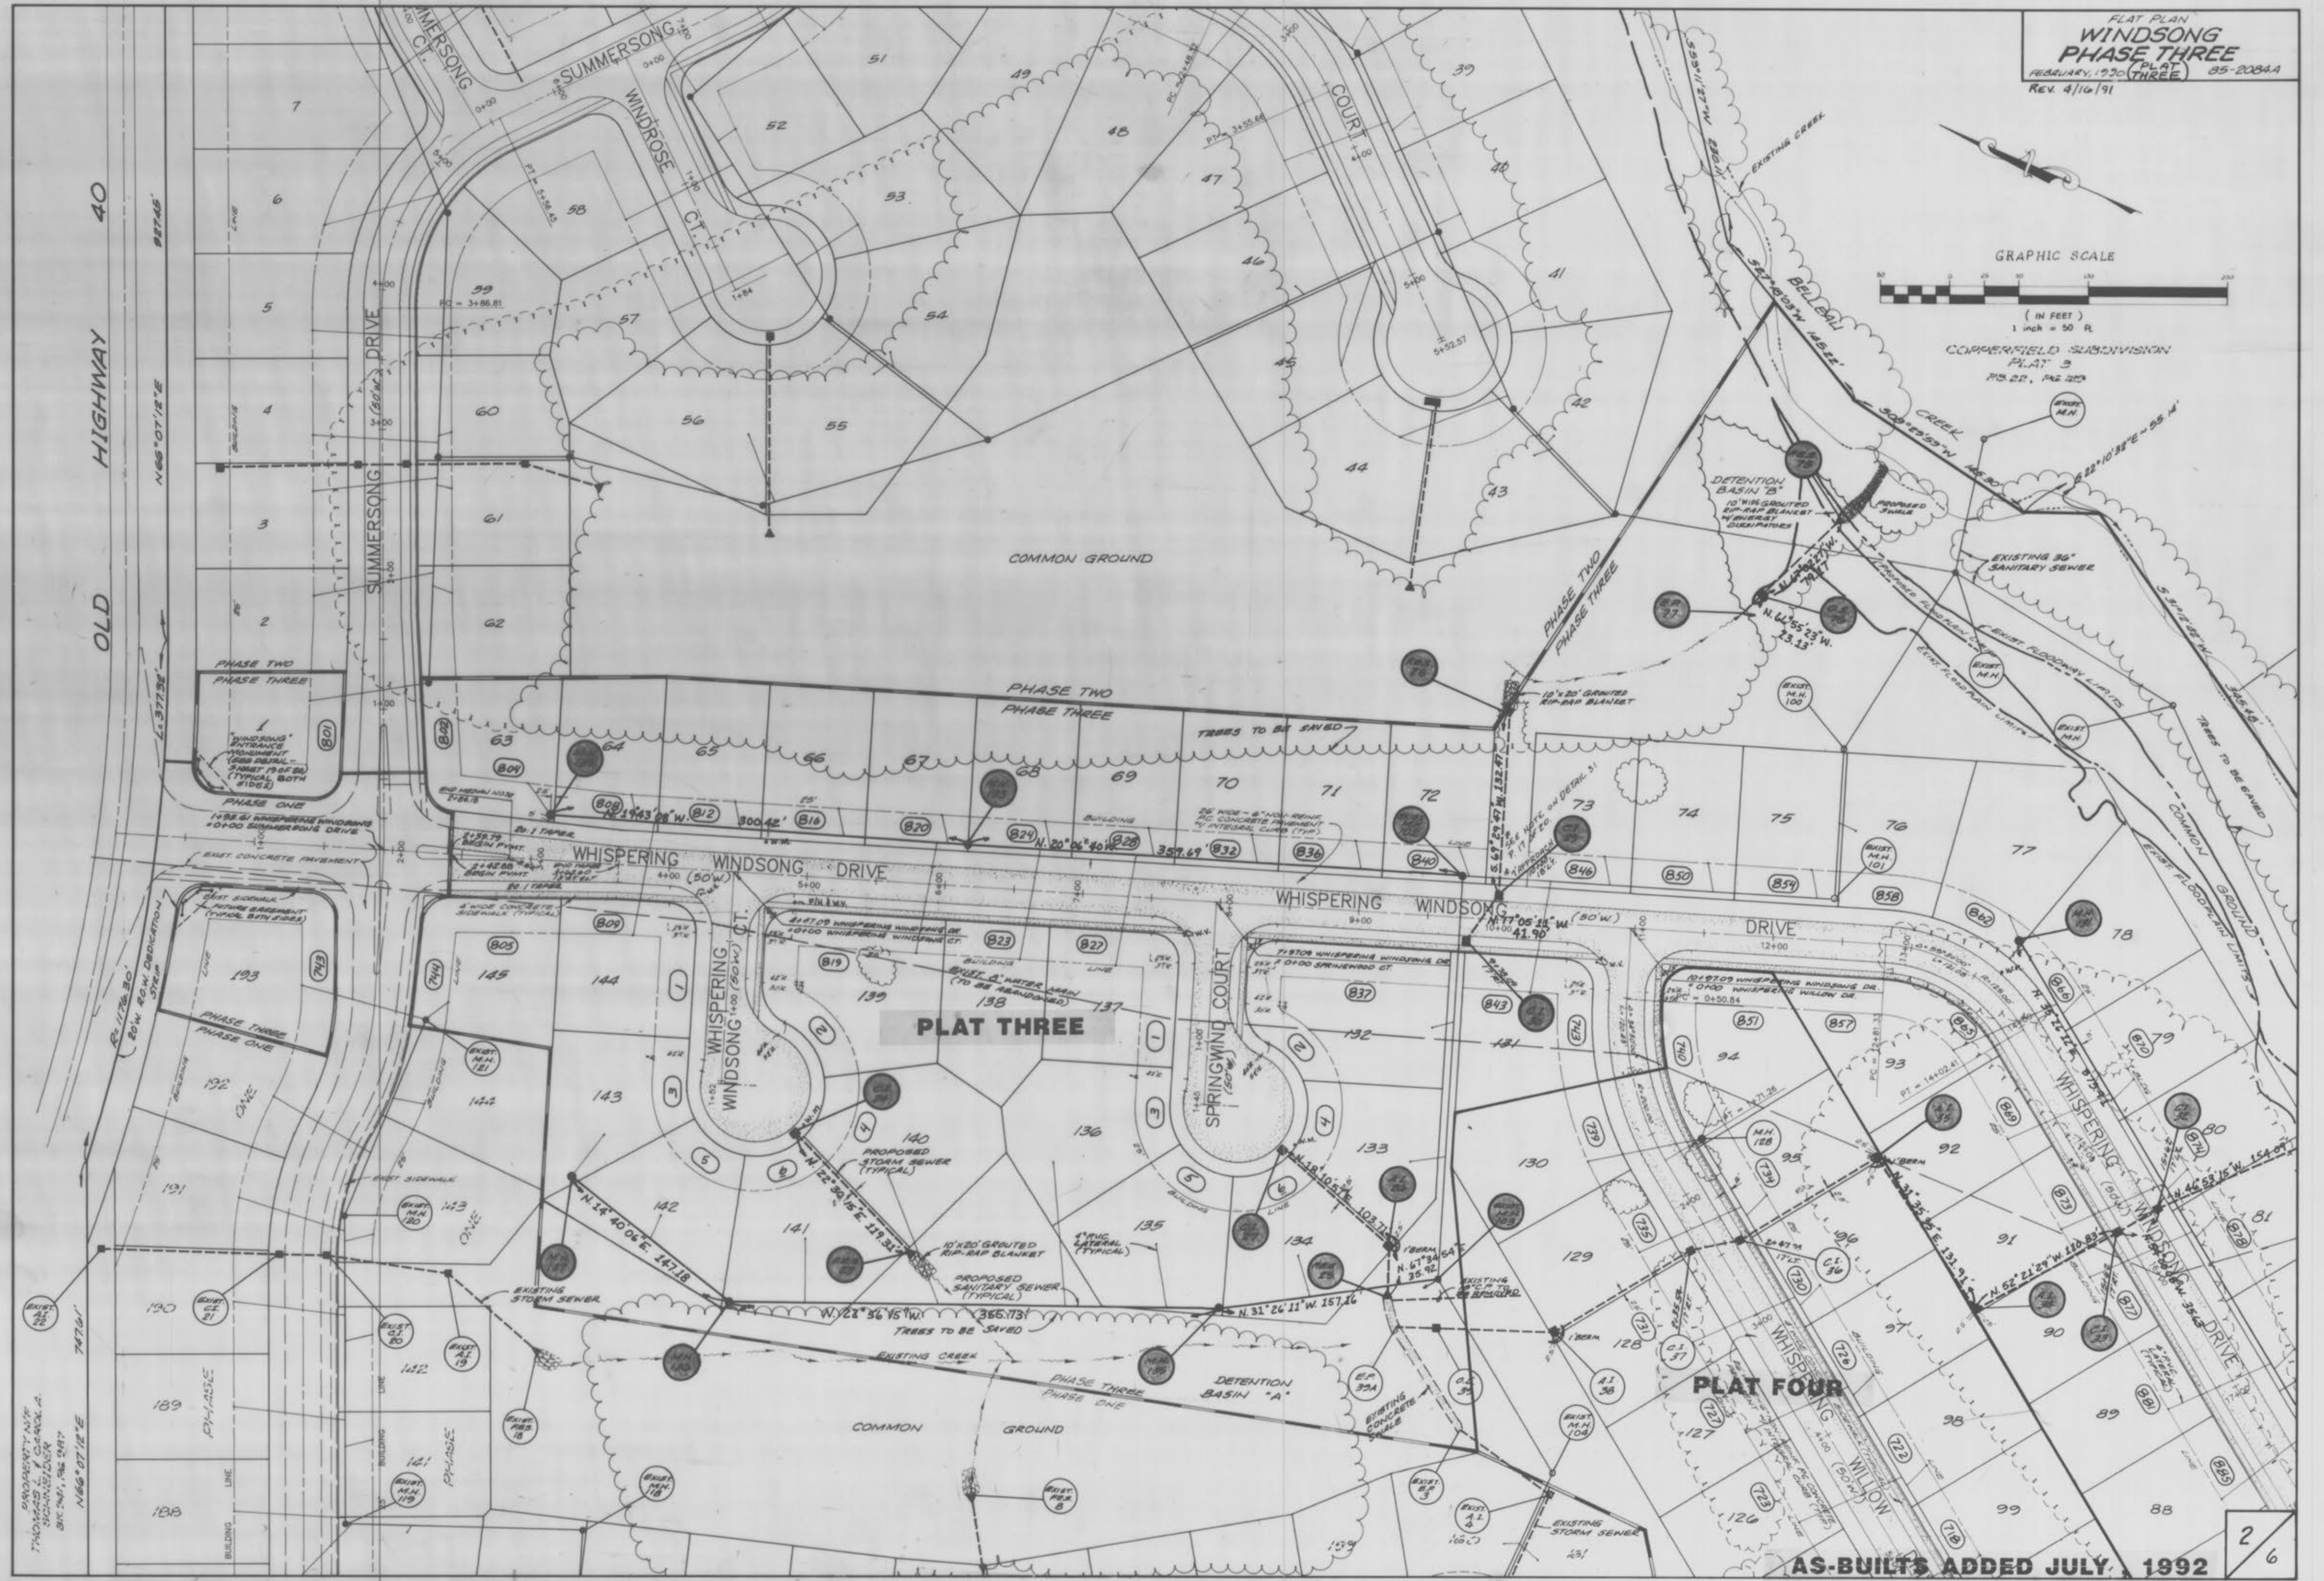



PROPERTY MAP  
 TYPED AND CHECKED  
 BY: [Name]  
 DATE: [Date]

AS-BUILTS ADDED JULY, 1992

COPPERFIELD SUBDIVISION  
 PLAT 5  
 RB. 24, P. 6.73

PROPERTY OF  
 DAVID E. & EULA B. QUELREAU  
 BK 653, PG. 1496

GRAPHIC SCALE

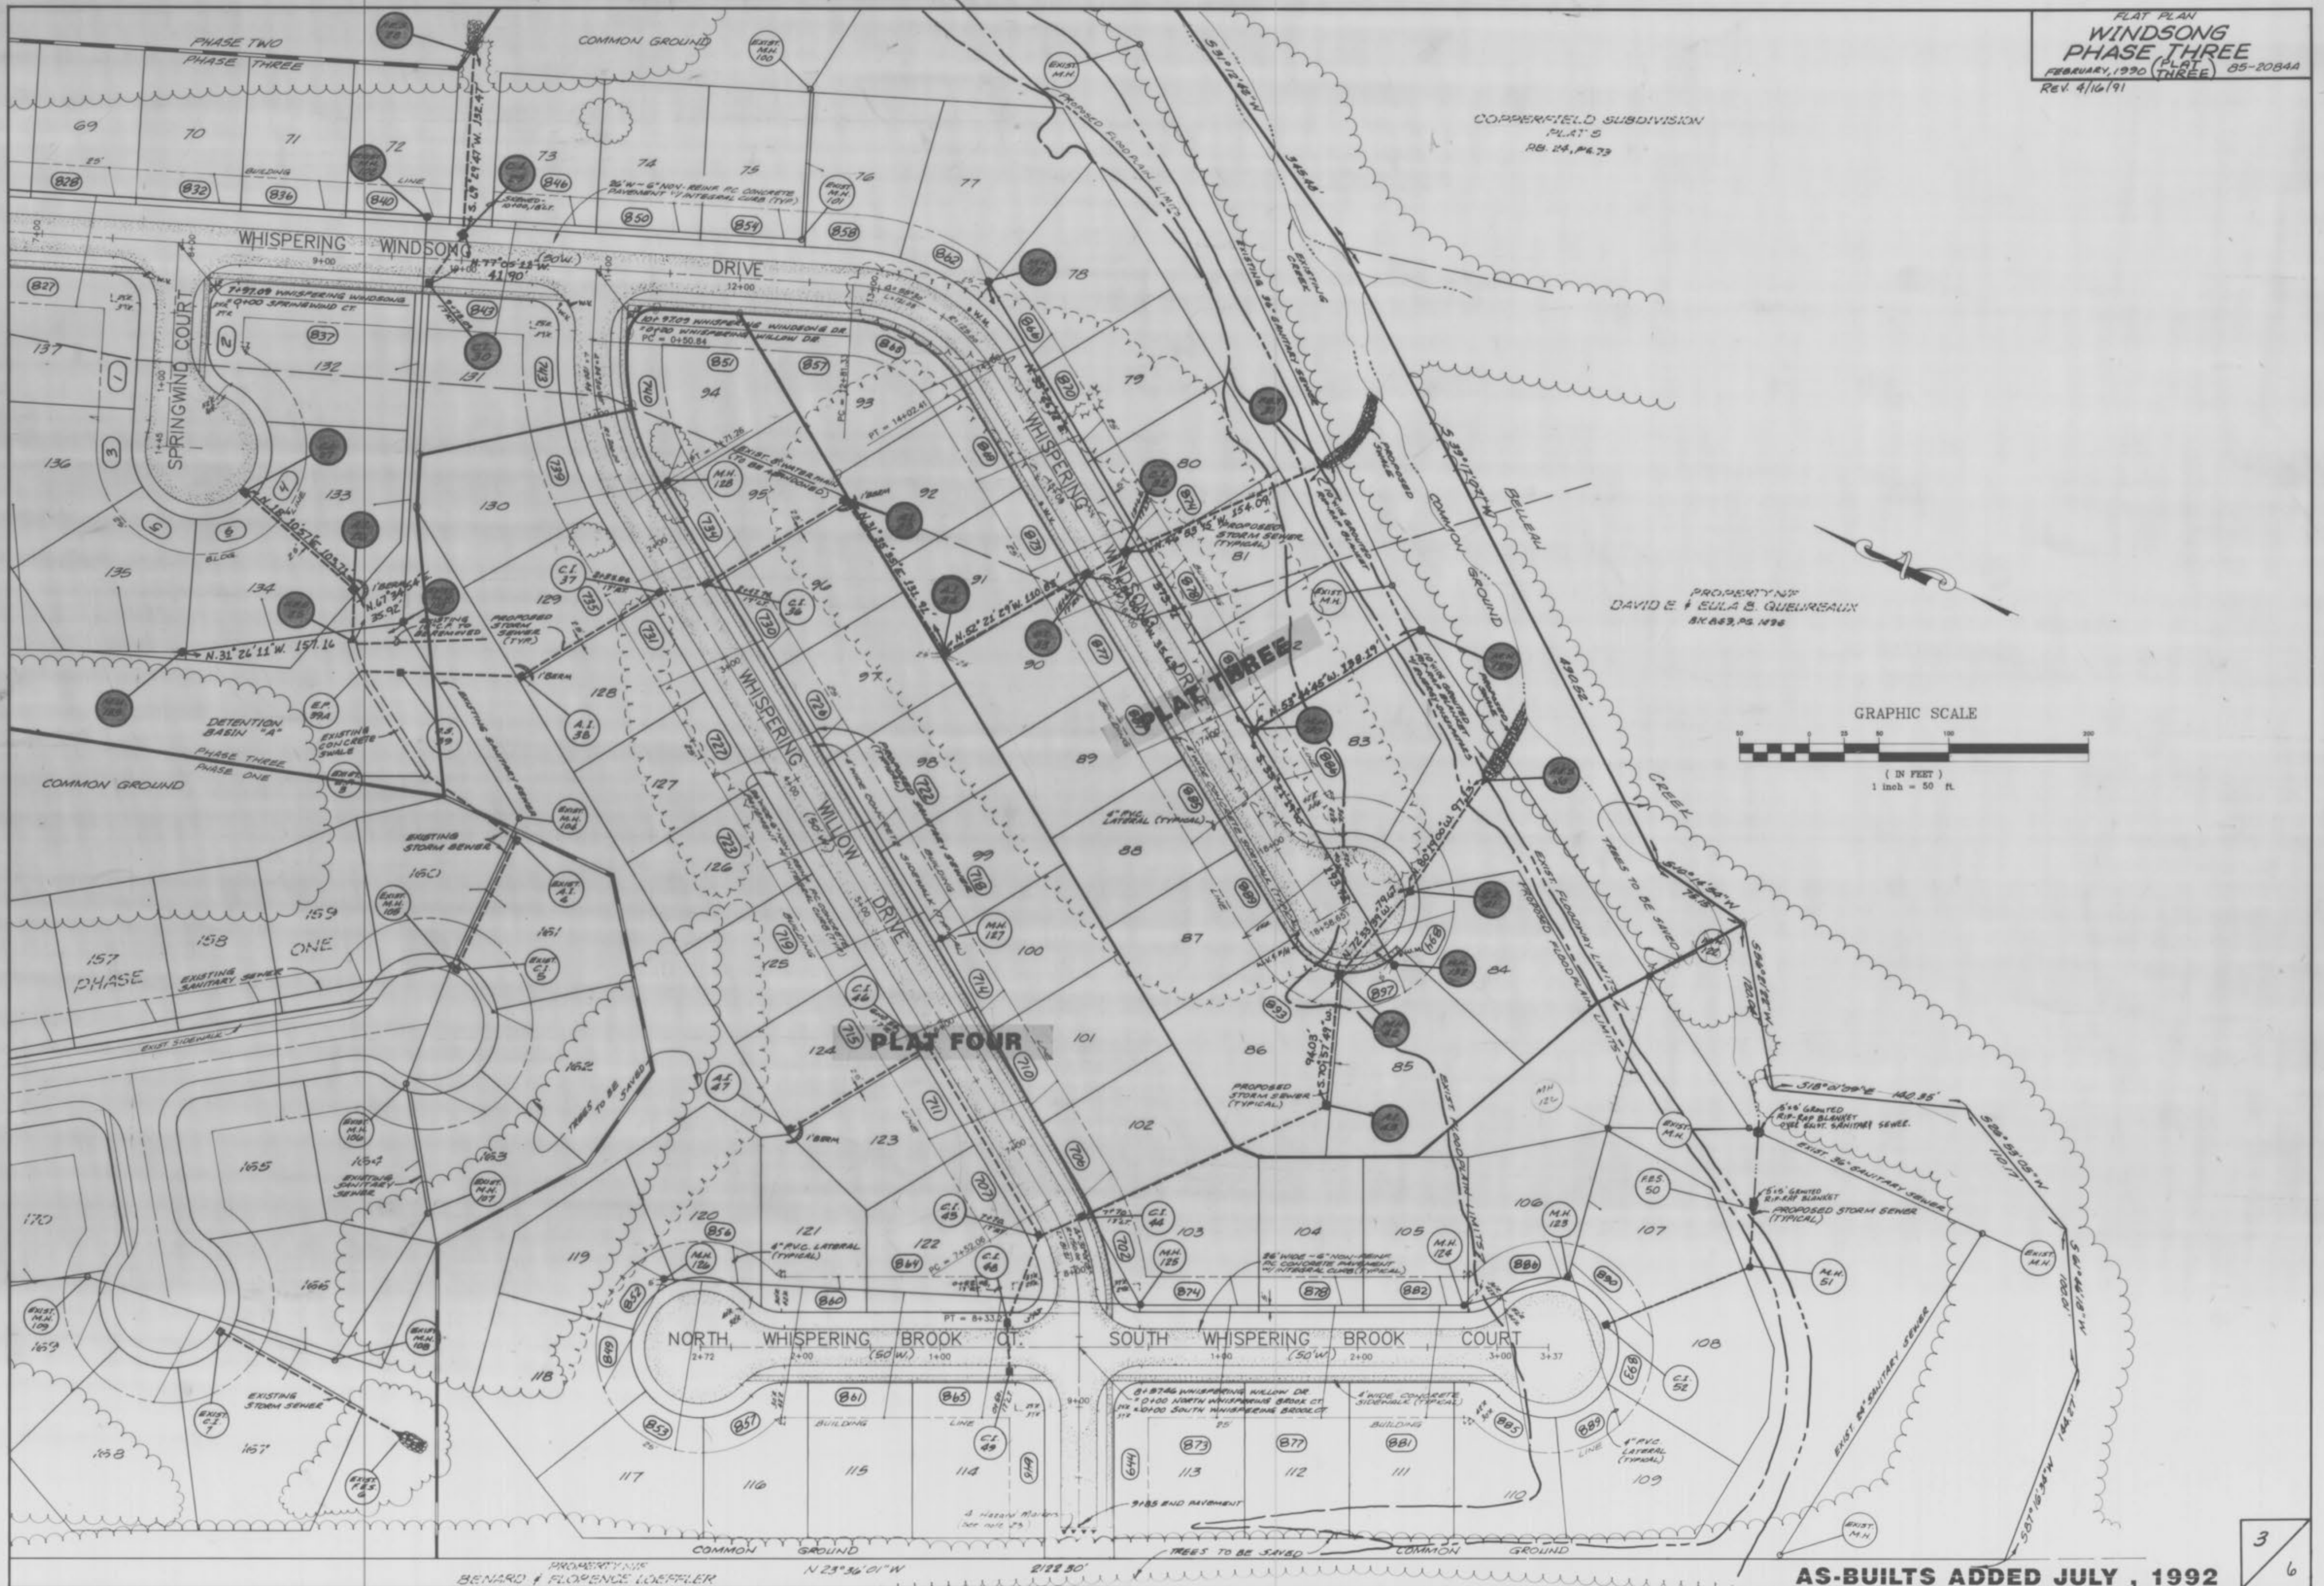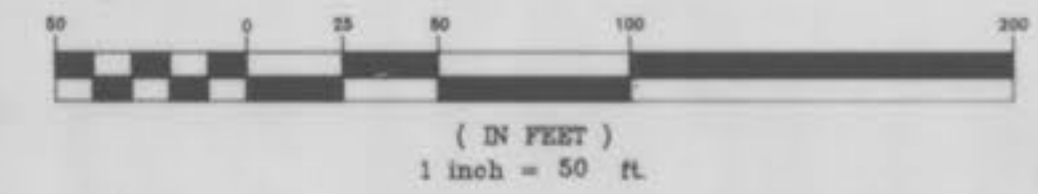


PROPERTY OF  
 BERNARD & FLORENCE LOEFFLER  
 N 23° 36' 01" W  
 2122.50'

AS-BUILTS ADDED JULY, 1992

FINAL SURVEY DRAWING  
 DATE  
 BY  
 CHECKED  
 AREA

ORIGINAL SURVEY DRAWING  
 DATE  
 BY  
 CHECKED  
 AREA


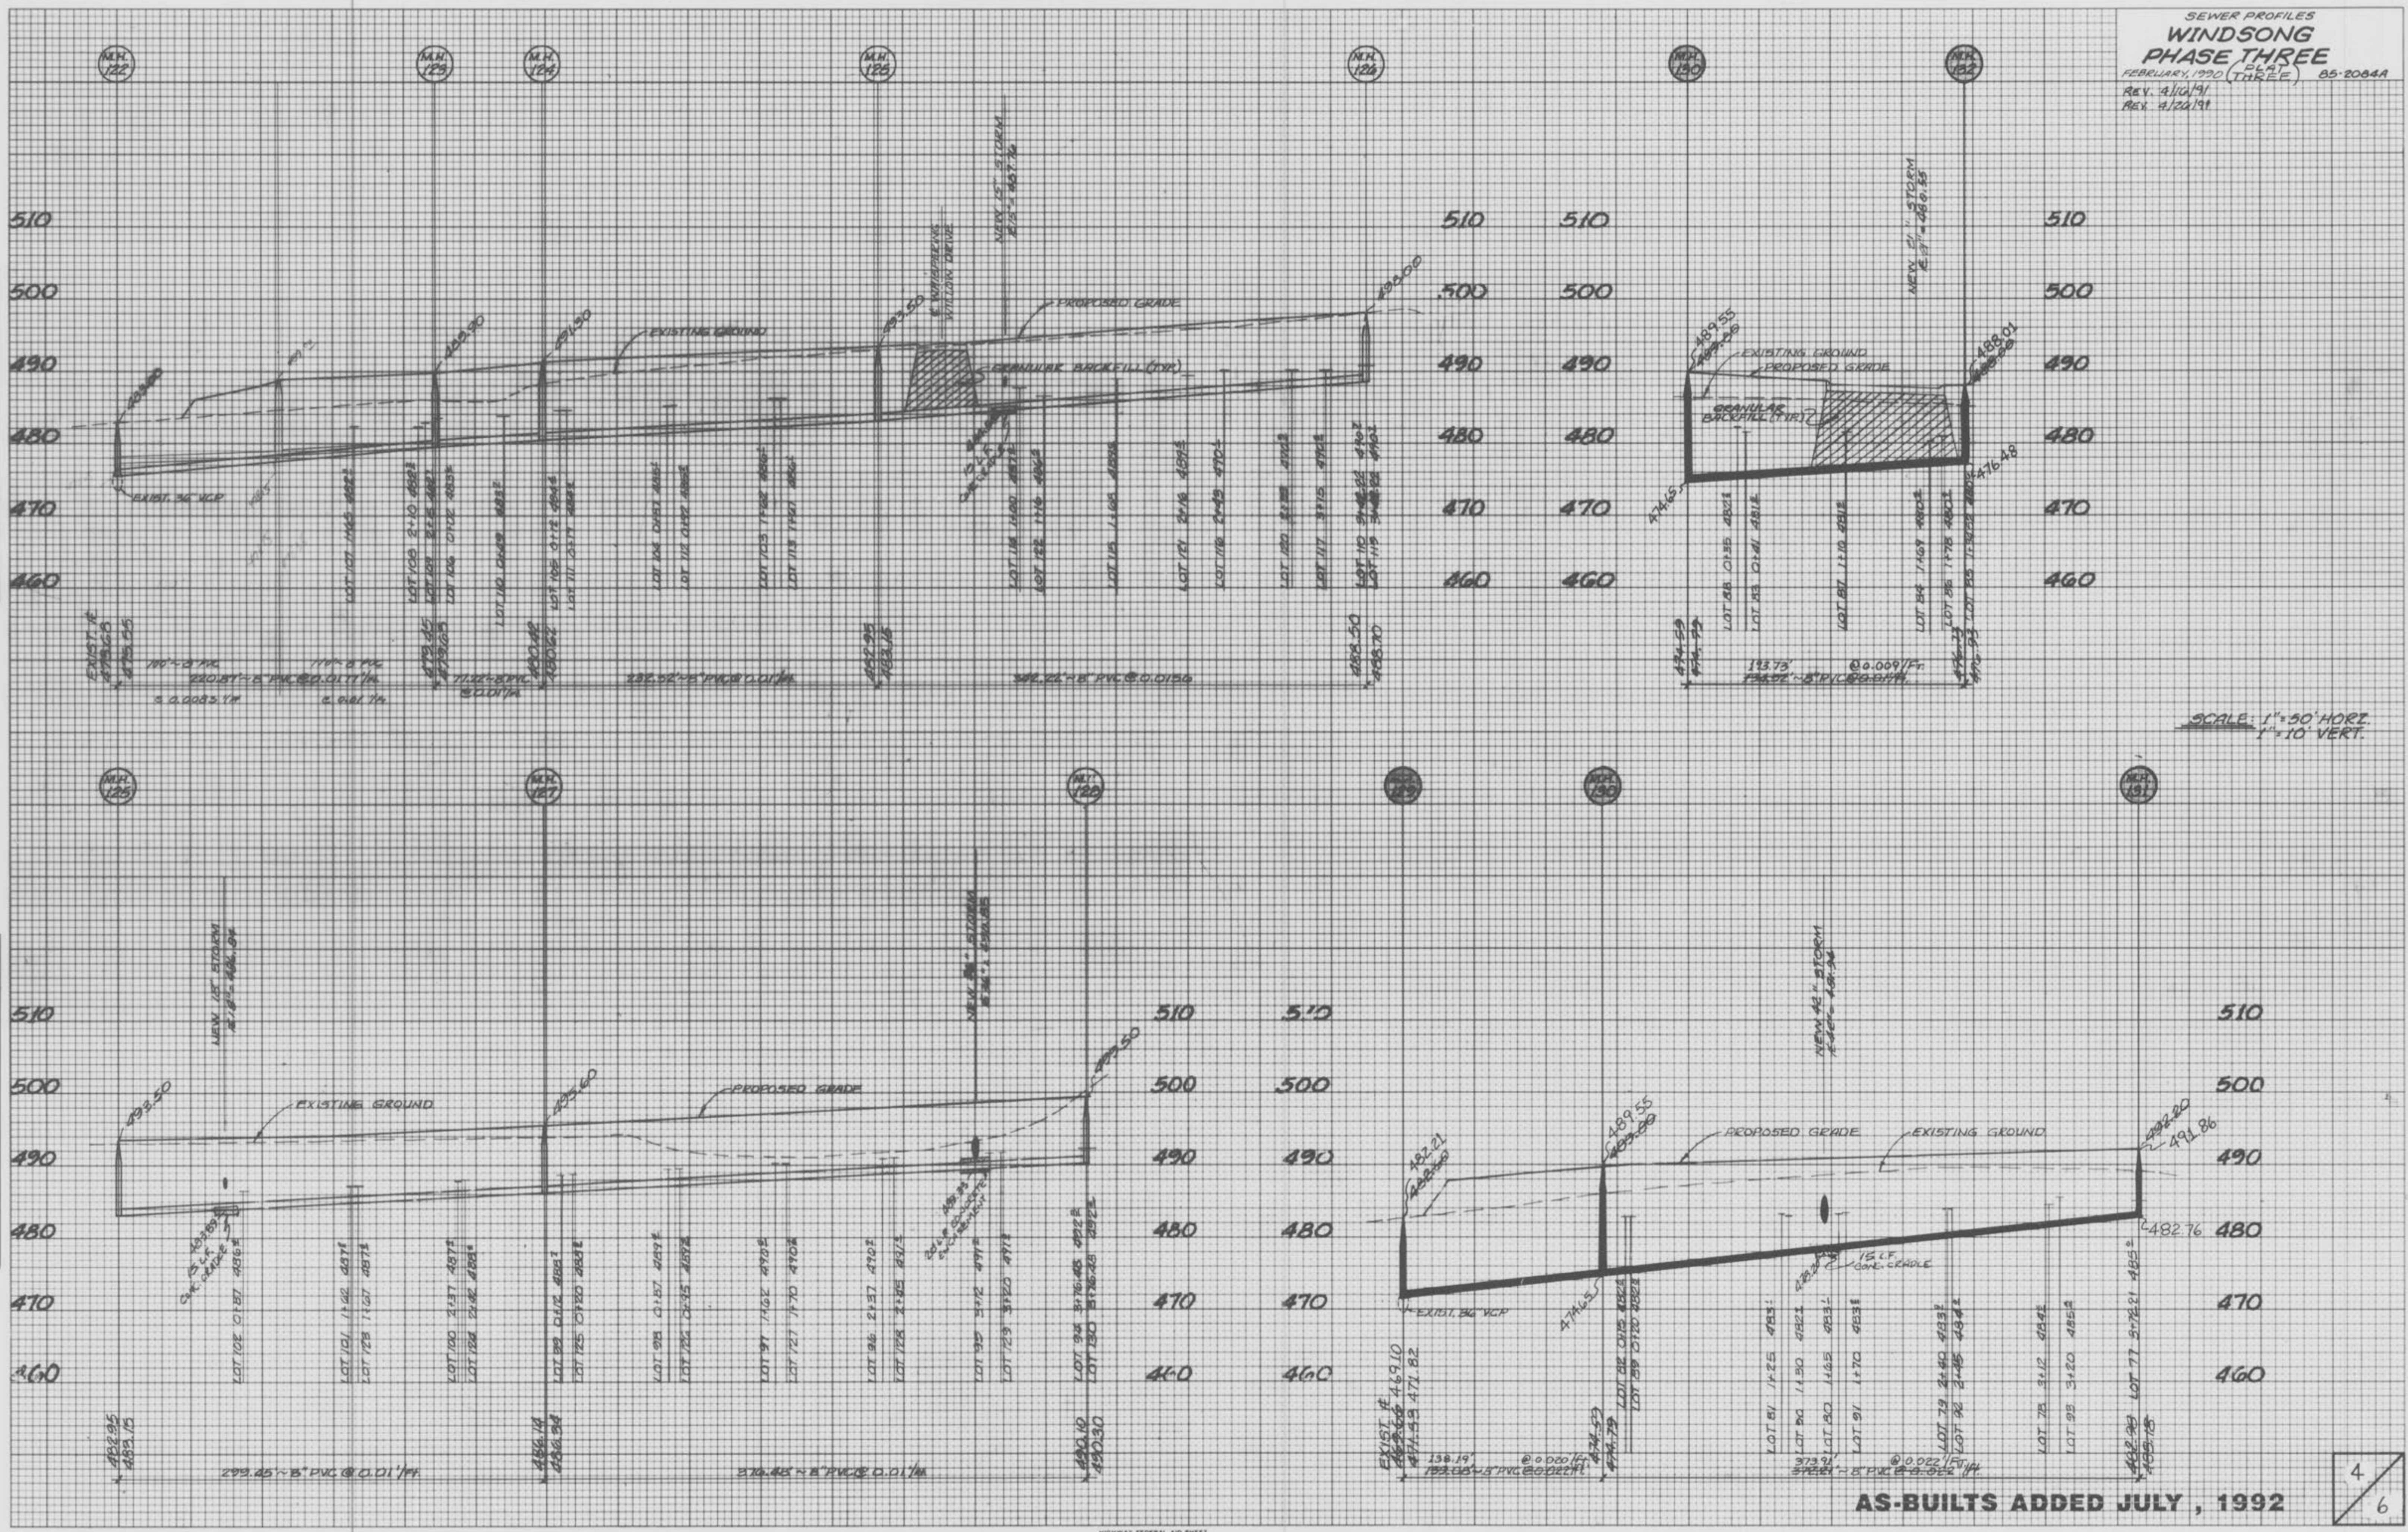


AS-BUILTS ADDED JULY, 1992

SEWER PROFILES  
**WINDSONG  
 PHASE THREE**  
 FEBRUARY, 1990 (THREE) 85-208AA  
 REV. 4/16/91 REV. 4/20/91

FINAL SURVEY  
 SURVEYED  
 PLOTTED  
 NOTE BOOK  
 AREAS CHECKED

ORIGINAL SURVEY  
 SURVEYED  
 PLOTTED  
 NOTE BOOK  
 AREAS CHECKED

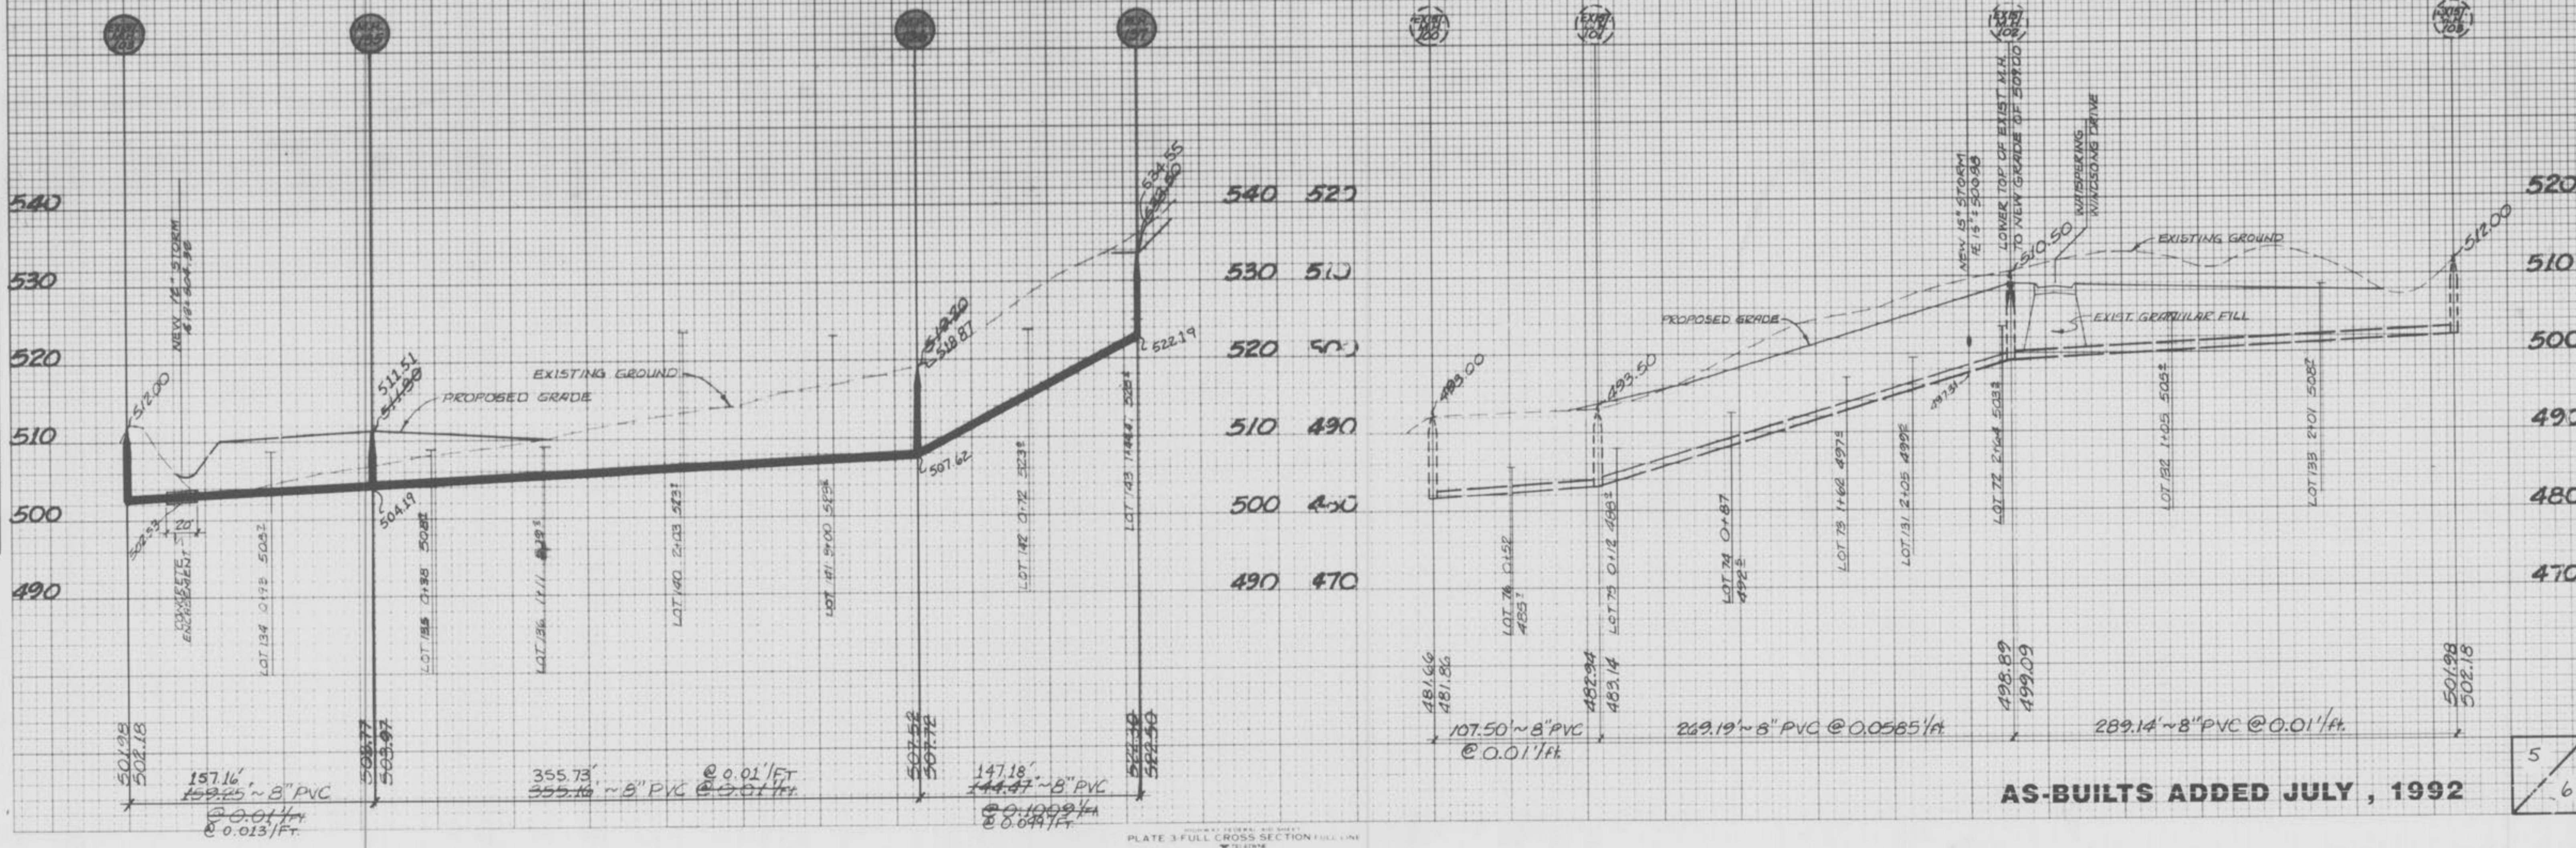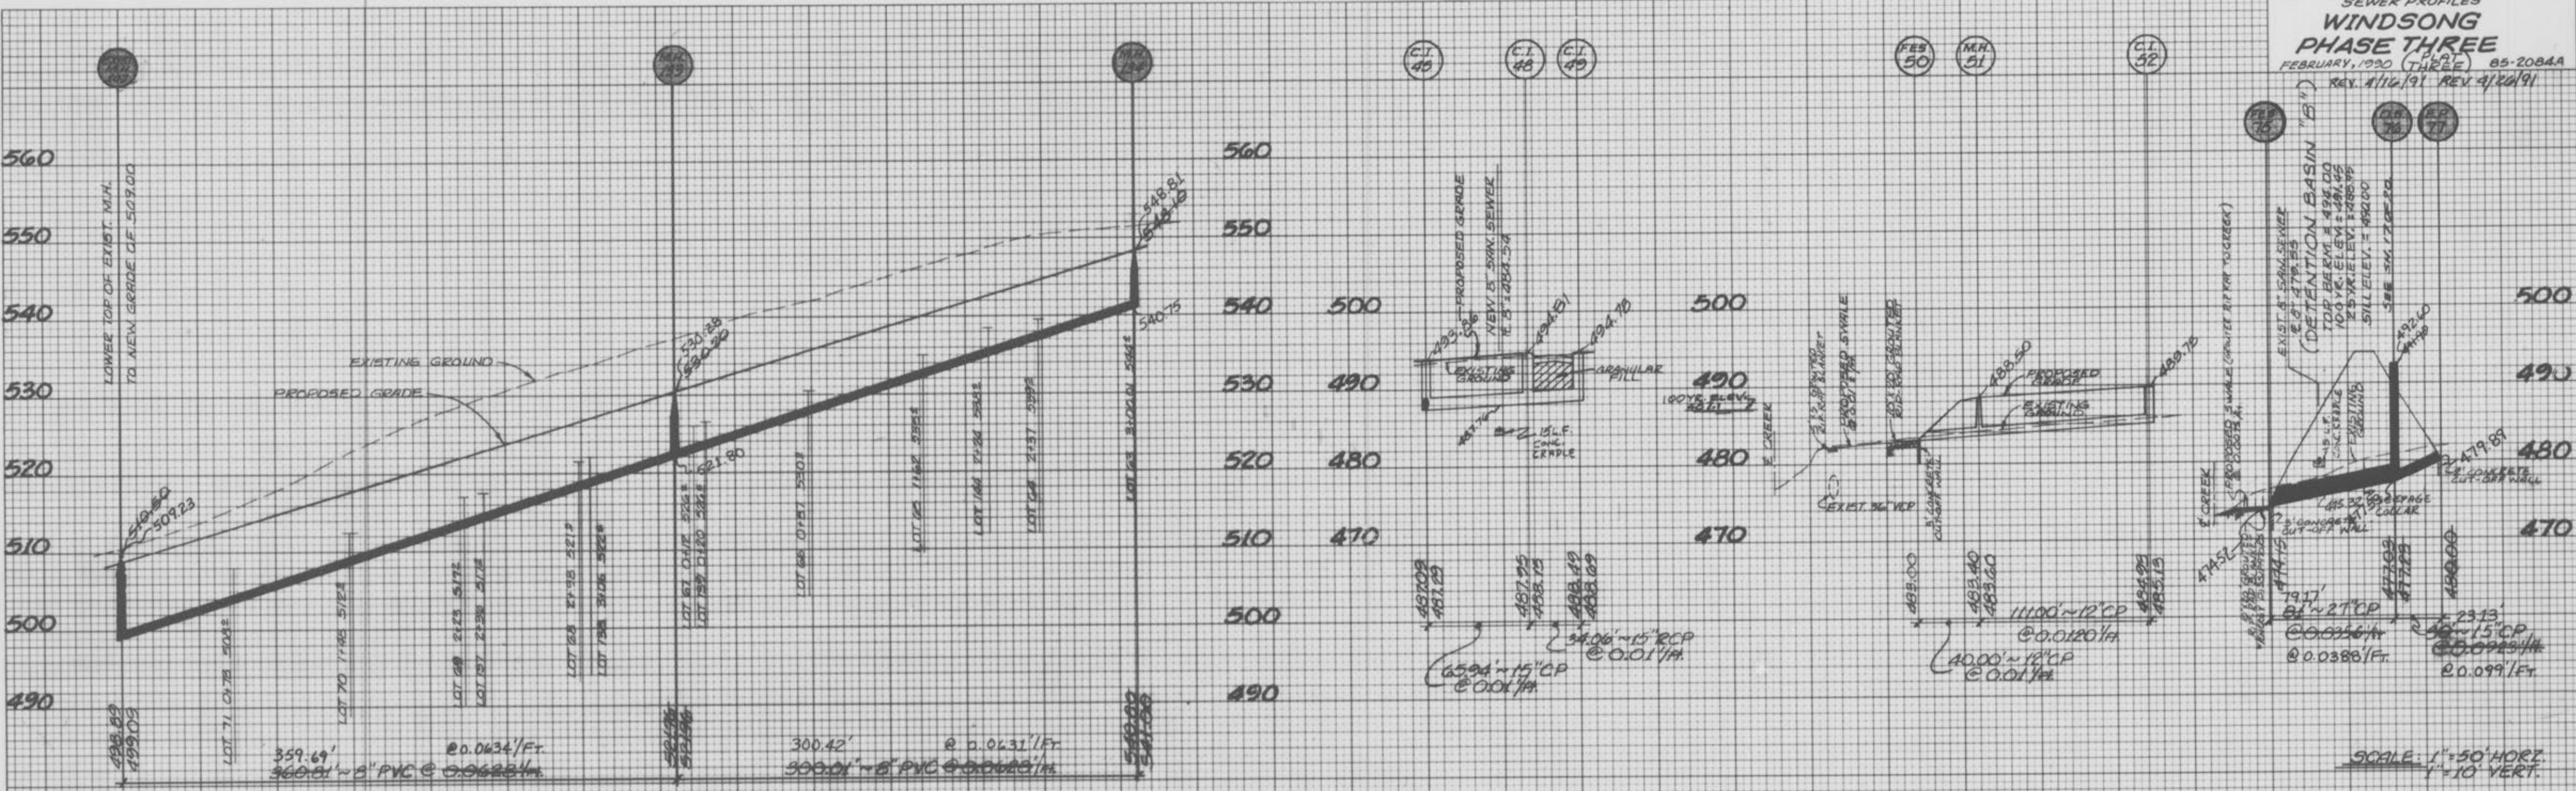


AS-BUILTS ADDED JULY, 1992

5  
6

FINAL SURVEY  
 DATE: 11/14/91  
 BY: [Signature]

ORIGINAL SURVEY  
 DATE: 11/14/91  
 BY: [Signature]

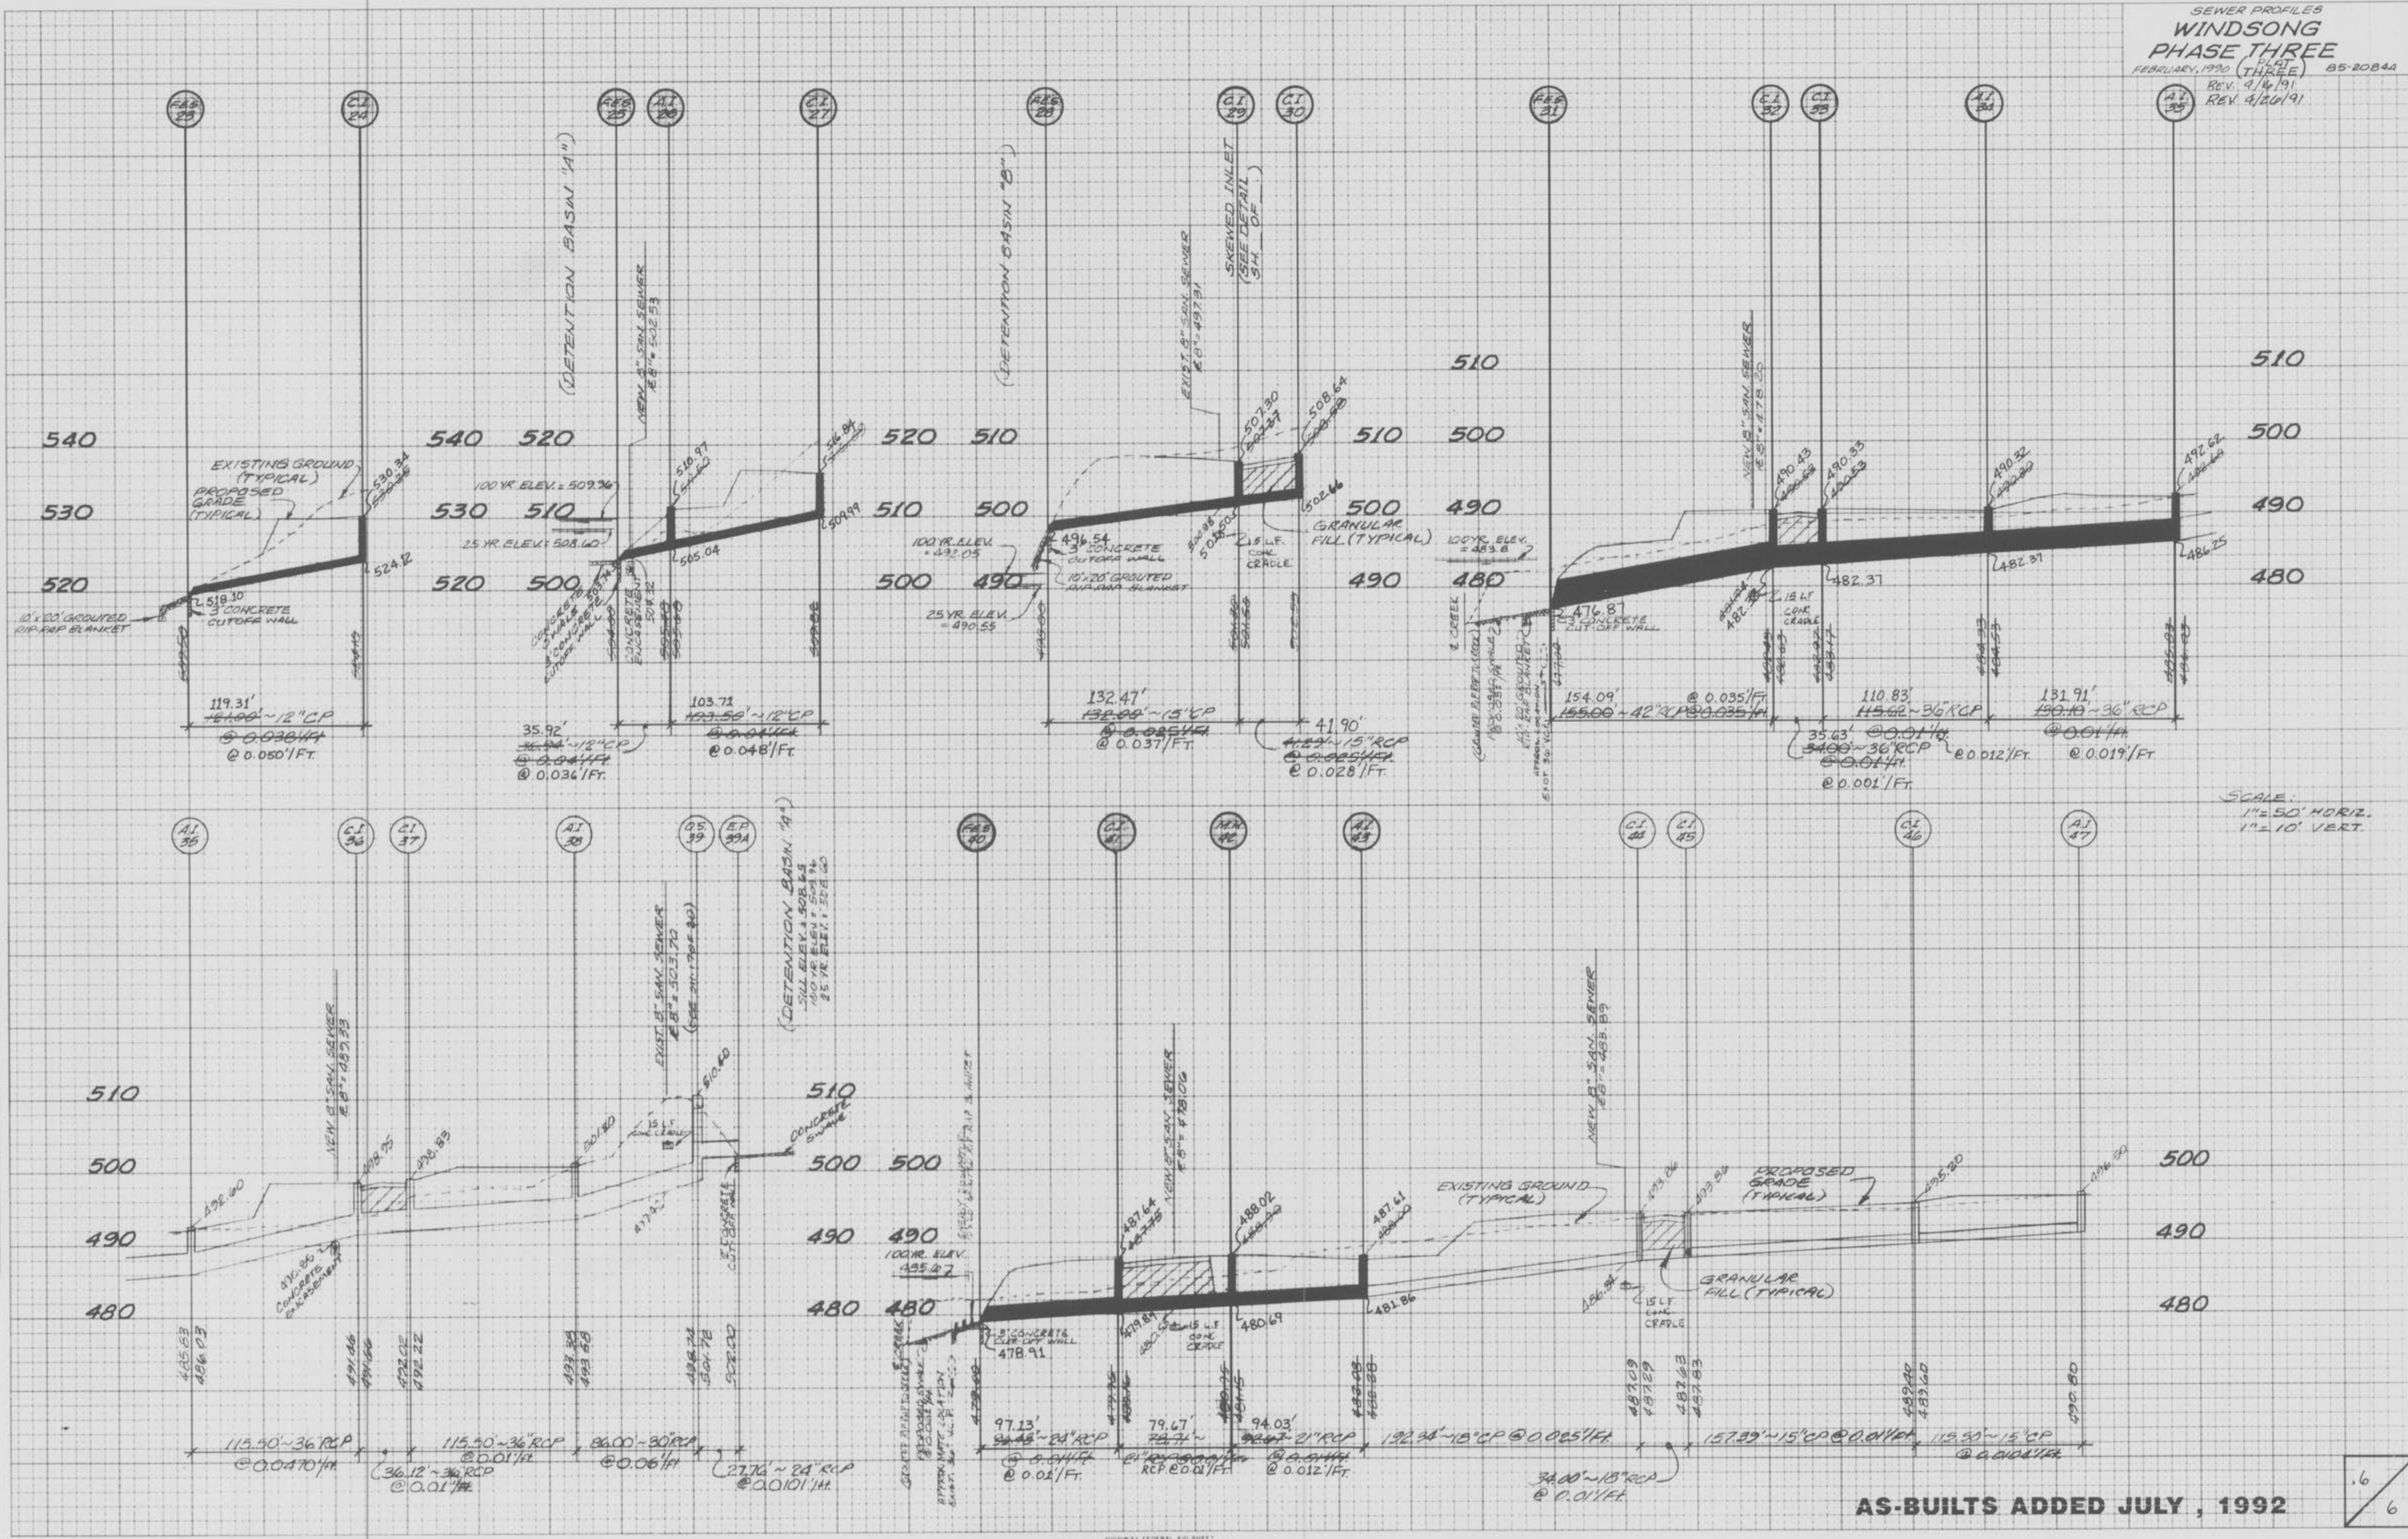

SCALE:  
 1" = 50' HORIZ.  
 1" = 10' VERT.

AS-BUILTS ADDED JULY, 1992