
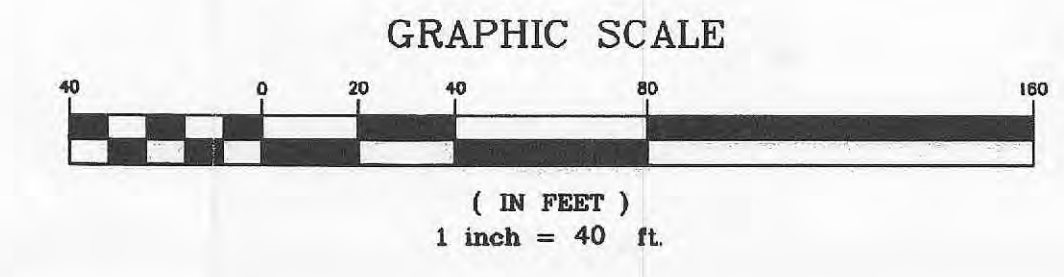


CHANGE ORDER WYG-003
FOR REFERENCE PURPOSES ONLY

APPROVED

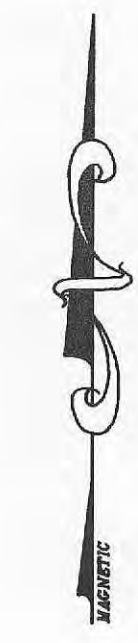

PICKETT RAY & SILVER
383 Mid Rivers Mall Drive
St. Peters, MO 65276
Phone (636) 397-1211
Fax (636) 397-1104

**CIVIL ENGINEERS
PLANNERS
LAND SURVEYORS**

**WYNDGATE VILLAGE A
LAKE / BASIN 1 AS-BUILT**

Prepared For:
SUMMIT POINTE, L.C.

239 FOX HILL ROAD
ST. CHARLES, MO. 63301
(636) 940-9500

REVISIONS NO.	DATE

ENGINEERS AUTHENTICATION
The responsibility for professional engineering liability on this project is hereby limited to the set of plans authenticated by the seal, signature, and date hereunder attached. Responsibility is disclaimed for all other engineering plans involved in this project and specifically excludes revisions after this date unless reauthenticated.
PICKETT, RAY & SILVER, INC

This "As-Built" Lake/Basin 1 plan, is based on actual field measurements conducted during November 2006 and the results are shown hereon.

By: 12-21-06
JAMES R. SHERVEK, P.E., #2211
STATE OF MISSOURI
PICKETT, RAY & SILVER'S CORPORATE
REGISTRATION NO. LS-54-D

DRAWN MAK	DATE 11/06
CHECKED MAK	DATE 11/06
PROJECT # 01267.SUPO.02R	TASK # FIELD BOOK

WYNDGATE VILLAGE A LAKE / BASIN 1 AS-BUILT
SHEET 1 OF 1
© Copyright 2006 by Pickett, Ray & Silver Inc.