
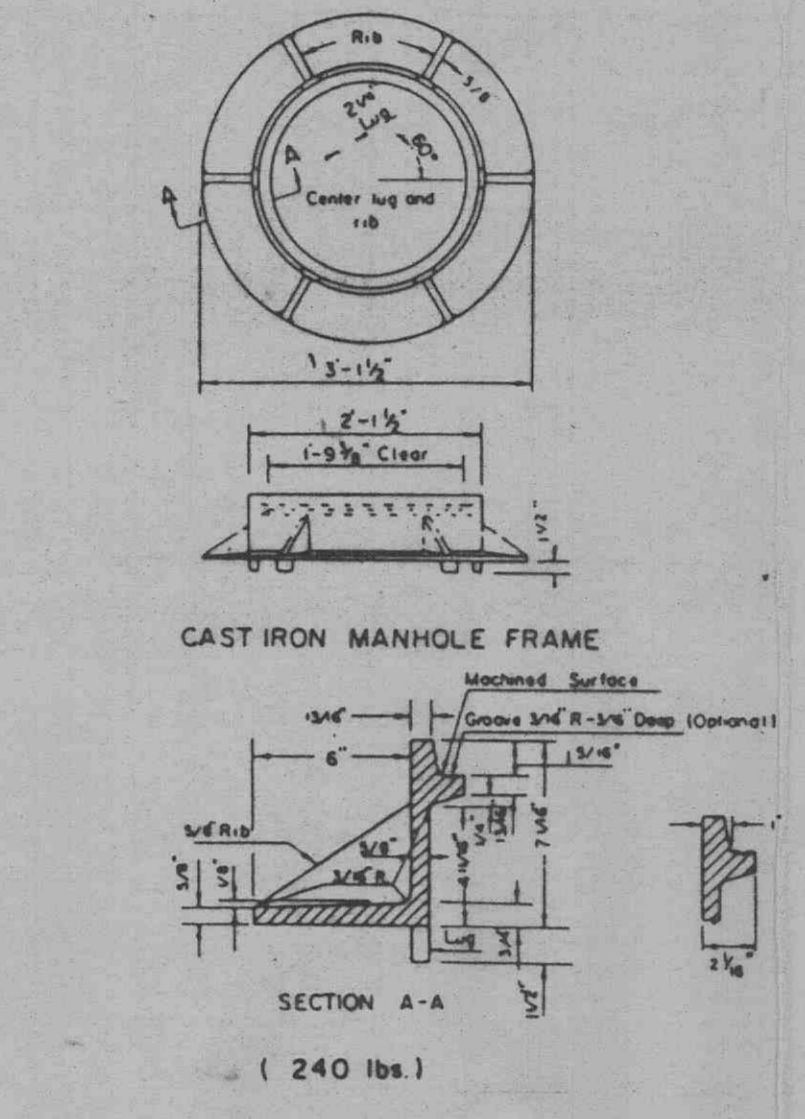


Section of Manhole	Dimension
Top Transition	Upper 2'-2 1/2" Dia.
	Lower 3'-6" Dia.
Bottom Section	8" thru 24" Dia. Pipe 3'-6" Dia.
Bottom Section	24" thru 36" Dia. Pipe 3'-6" Square


TABLE NO. 2
STANDARD MANHOLE DIMENSIONS

PIPE BEDDING CLASS "C"
(FOR ALL PIPE EXCEPT
REINFORCED CONCRETE PIPE)
(FOR SANITARY LATERAL)


PIPE BEDDING CLASS "C*"
(MODIFIED FOR REINFORCED
CONCRETE PIPE)

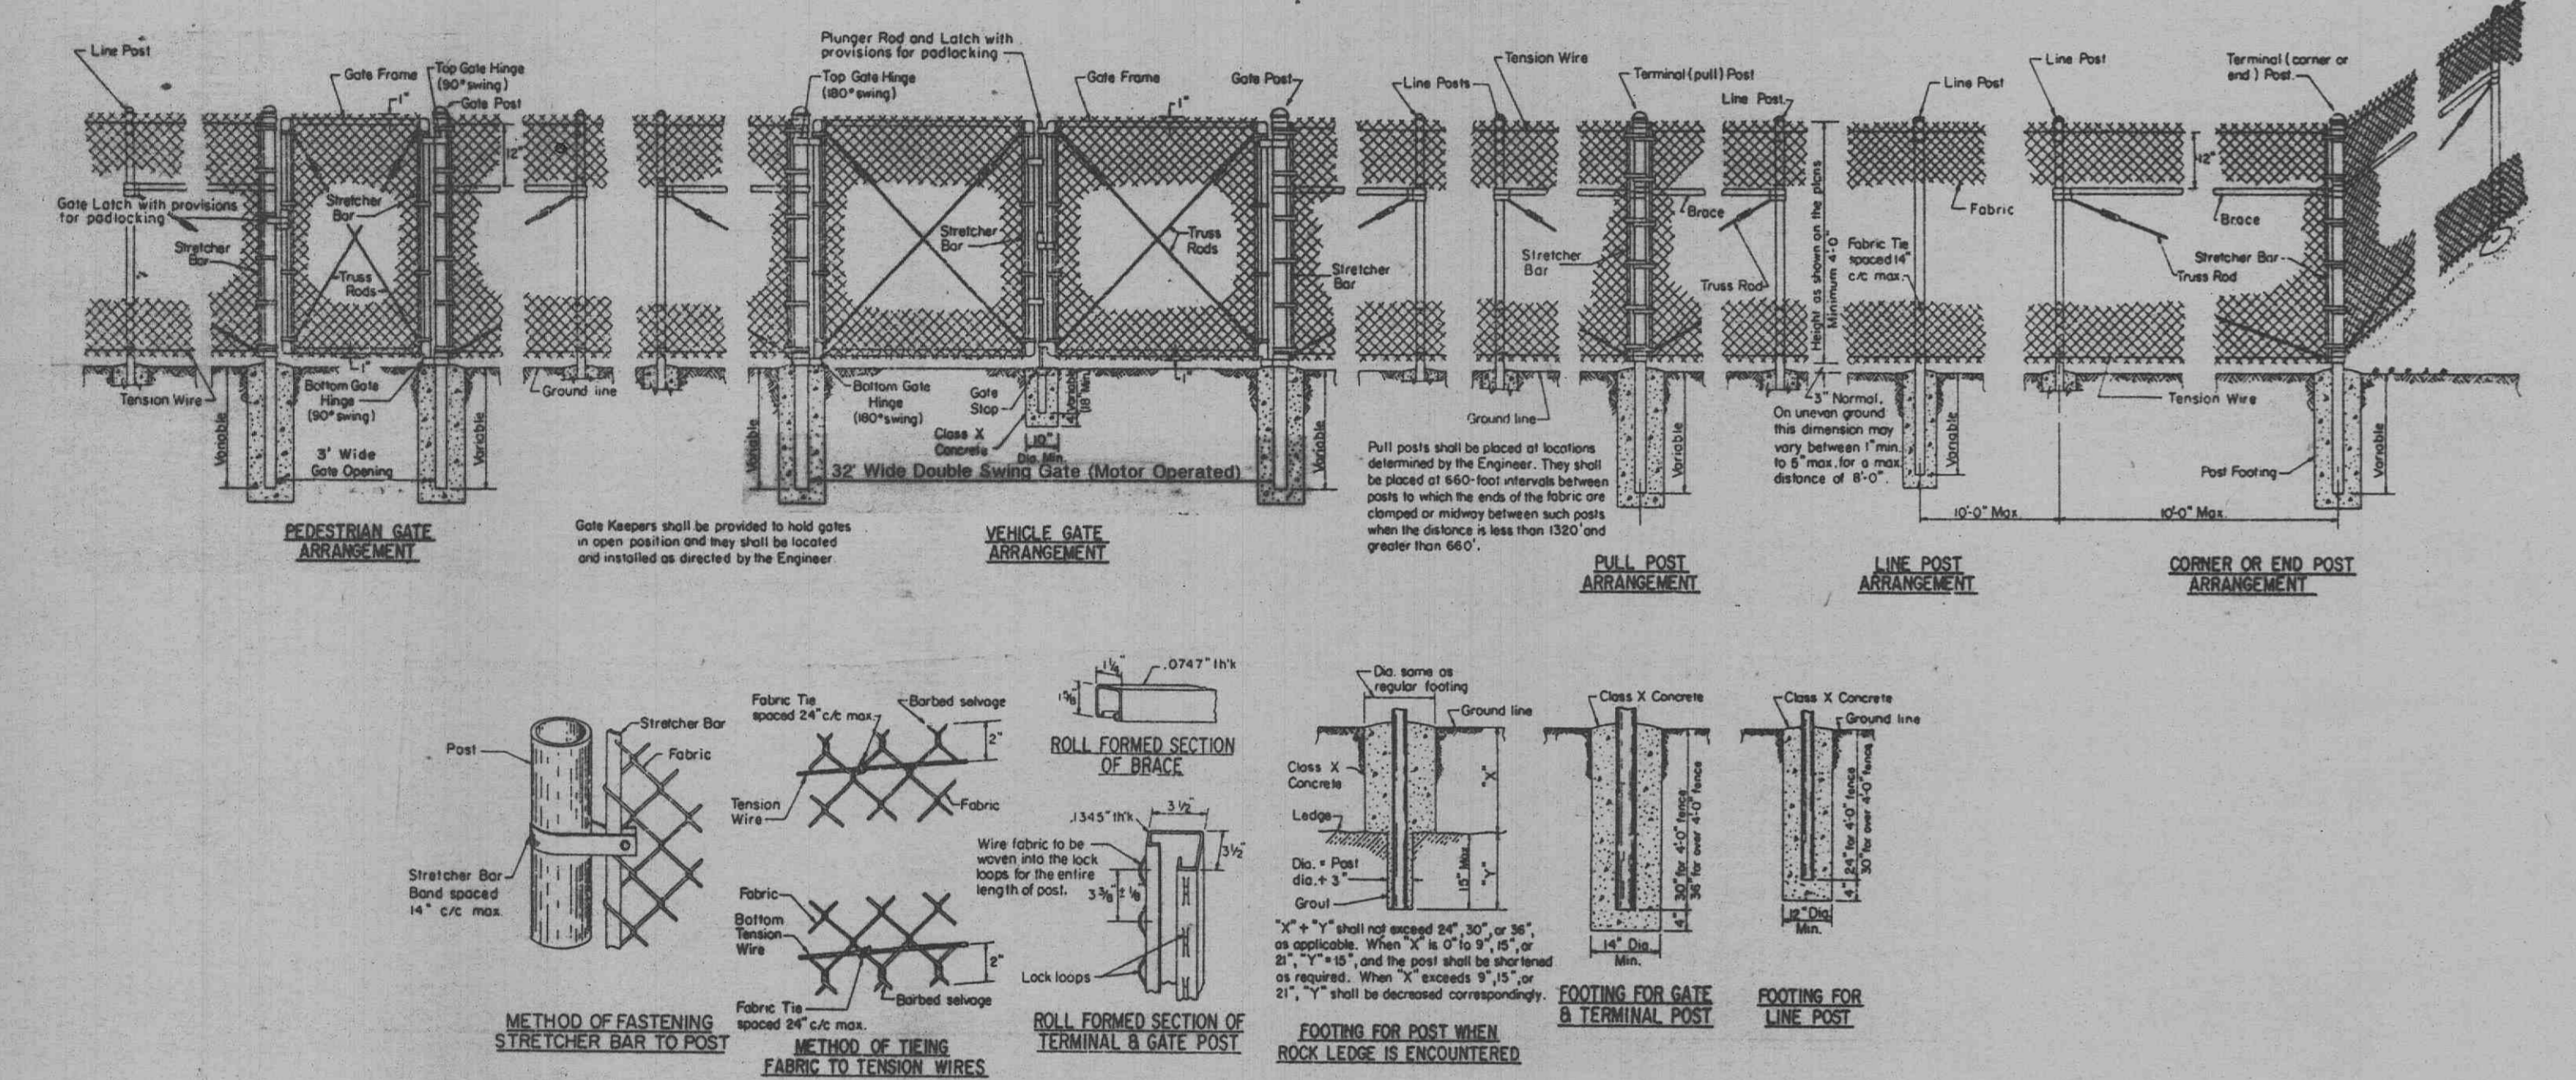

CAST IRON MANHOLE FRAME

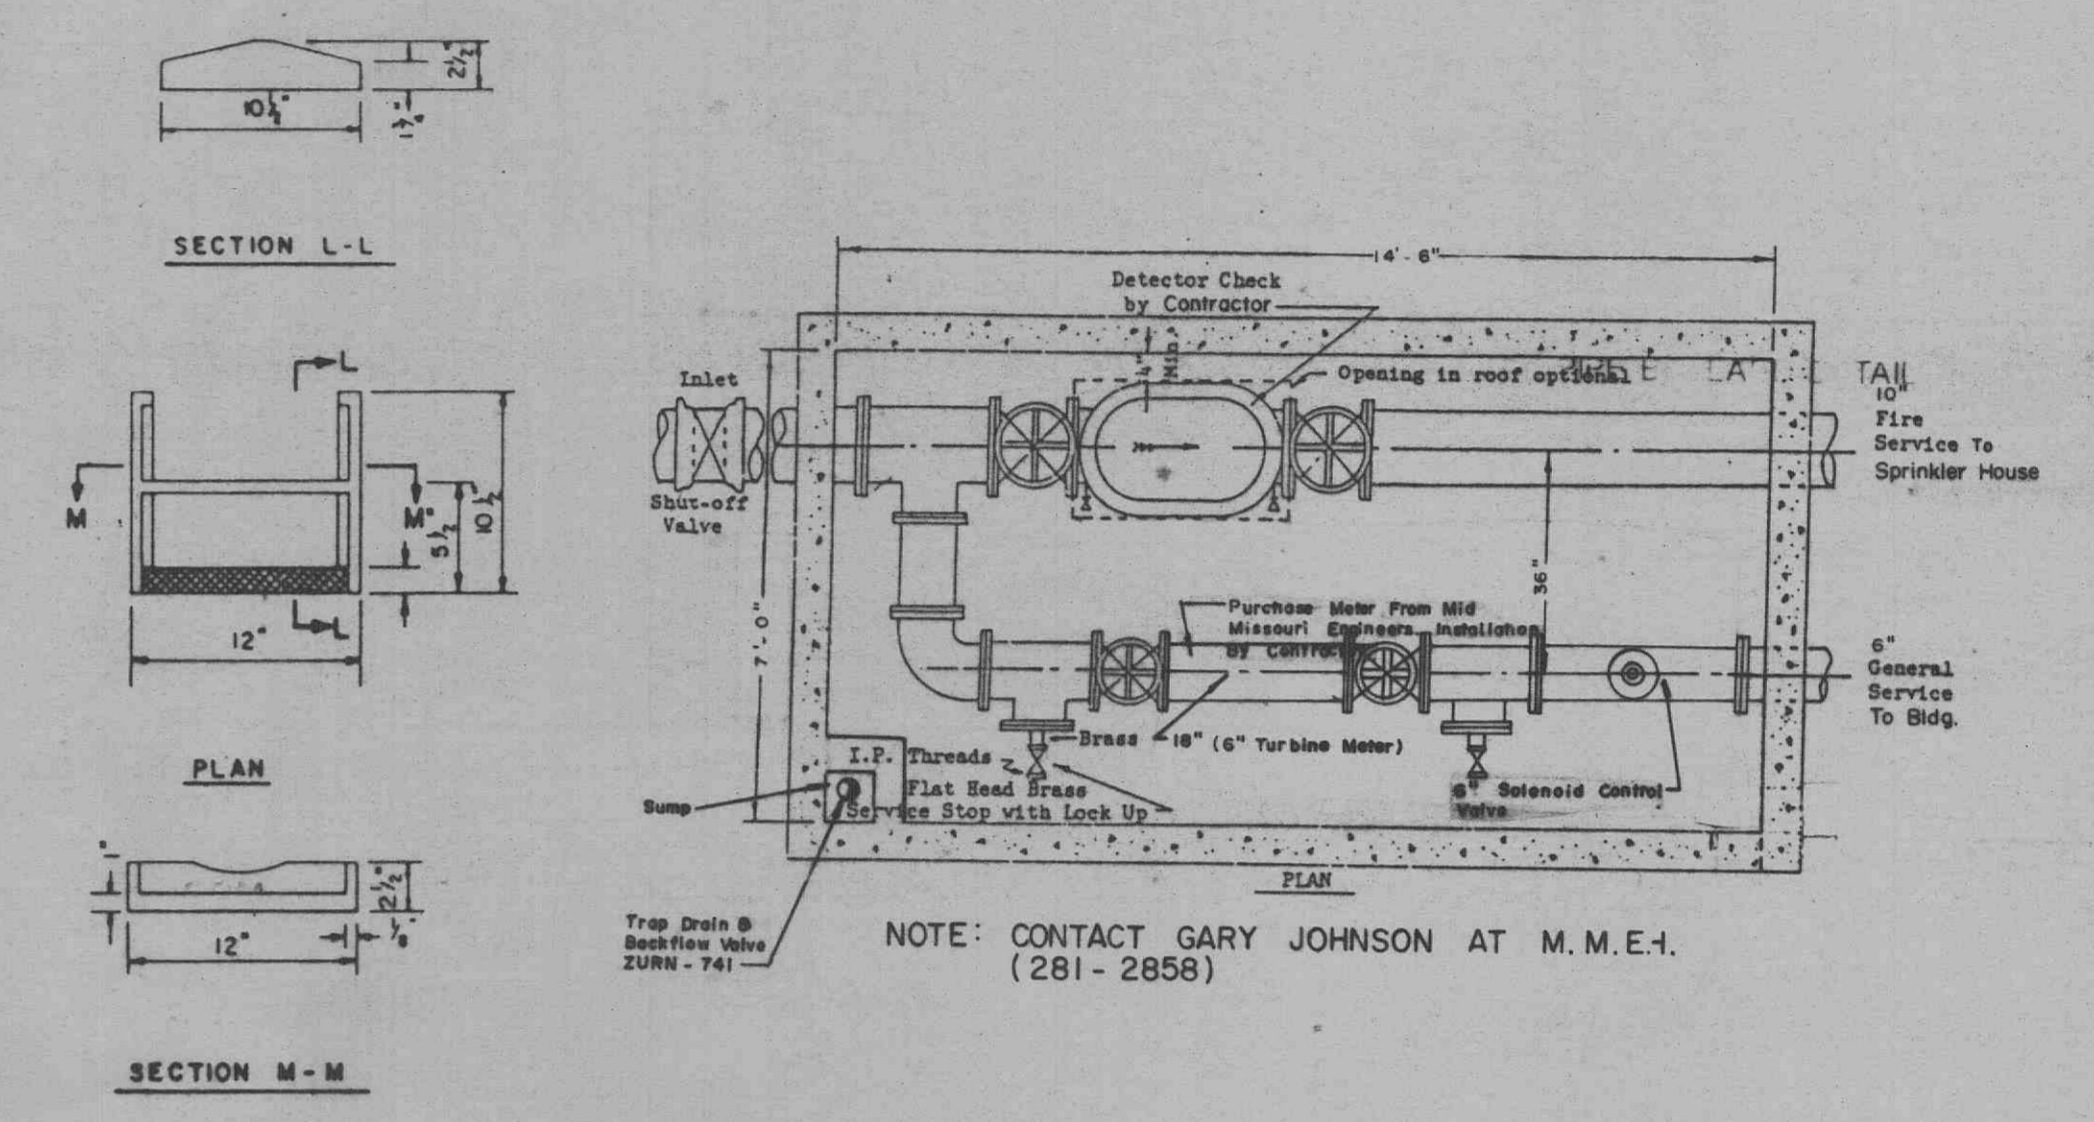


METER BOX FOR SPLIT SERVICE

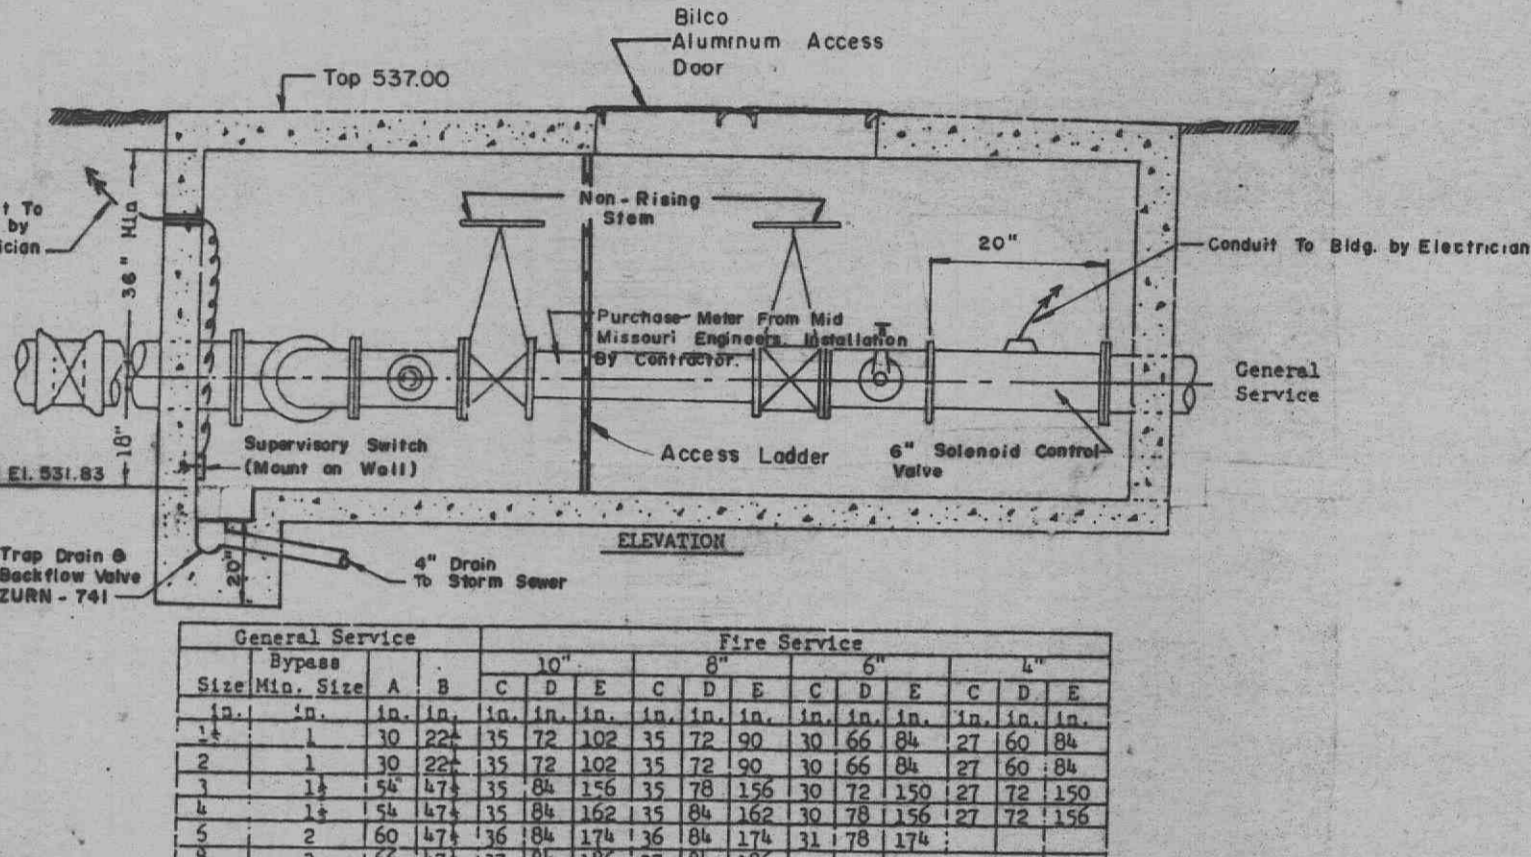


AREA INLET (12" thru 24")

ROUND PIPE				HORIZONTAL ELLIPTICAL PIPE			
Inside Diameter of Pipe (Inches)	Flowline Width of Trench (Feet)	Flowline Width of Trench (Feet)	Flowline Width of Trench (Feet)	Inside Dimensions of Pipe (Inches)	Flowline Width of Trench (Feet)	Flowline Width of Trench (Feet)	Flowline Width of Trench (Feet)
4	28	2.33	3.20				
6	28	2.33	3.46				
8	28	2.33	3.70				
10	28	2.33	3.86				
12	28	2.33	3.98				
15	32	2.67	4.89				
18	35	2.92	5.63	14 x 23	41	3.42	5.94
21	38	3.25	6.61				
24	42	3.50	7.39	19 x 30	49	4.08	7.60
27	45	3.75	8.18	22 x 34	53	4.62	8.61
30	49	4.08	9.30	24 x 38	58	4.83	9.70
33	53	4.42	10.53	27 x 42	62	5.17	10.71
36	56	4.67	11.63	29 x 45	66	5.50	11.72
39	DISCONTINUED			32 x 49	71	5.92	13.14
42	63	5.25	13.38	34 x 53	75	6.25	14.05
48	70	5.83	15.67	38 x 60	83	6.92	16.16
54	77	6.42	18.15	43 x 68	92	7.67	18.91
60	84	7.00	20.73	48 x 76	101	8.42	21.59
66	91	7.58	23.45	53 x 83	109	9.08	24.35
72	96	8.17	26.37	58 x 91	118	9.83	27.45
78	105	8.75	29.39	63 x 98	126	10.50	30.55
84	112	9.33	32.57	68 x 106	135	11.25	33.90
90	119	9.92	35.90	72 x 113	143	11.92	36.93
96	126	10.50	39.37	77 x 121	152	12.67	40.69
102	133	11.08	42.99	82 x 128	160	13.33	44.48
108	140	11.67	46.75	87 x 136	169	14.00	47.79
114	147	12.25	50.66	92 x 143	176	14.67	51.70
120	154	12.83	54.72	97 x 151	185	15.42	56.01
126	161	13.42	58.92				
132	168	14.00	63.27	106 x 166	202	16.83	64.48
144	182	15.17	72.40	116 x 180	219	18.17	73.99


TABLE NO. 1
PAYLINE WIDTHS OF
TRENCH AND
PAY - QUANTITIES OF
CONCRETE

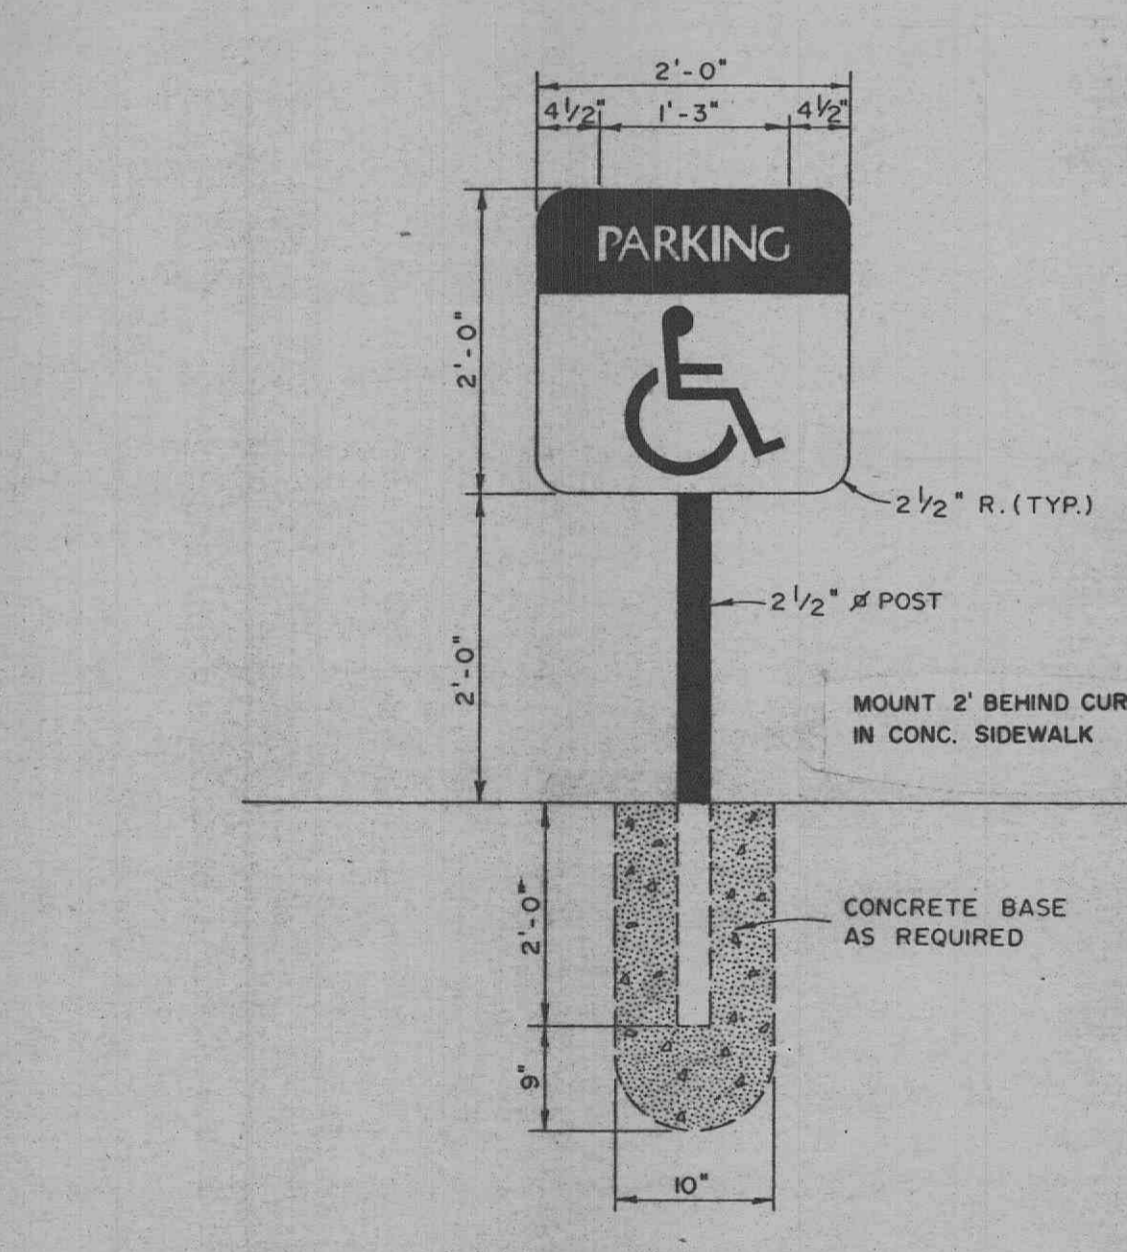


HANDICAPPED SIGN DETAIL

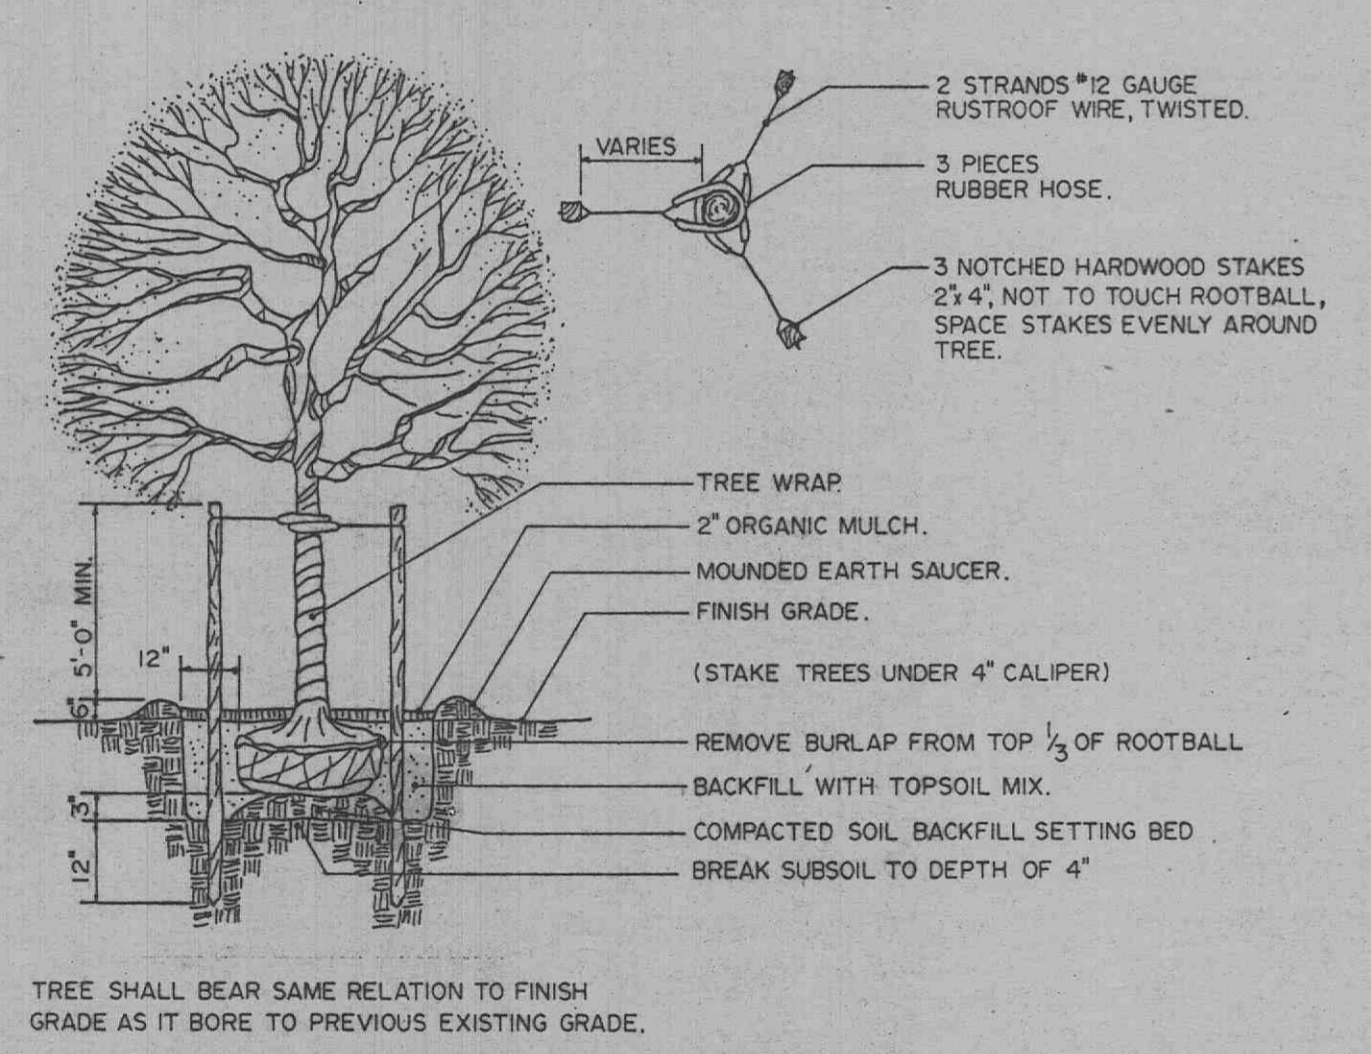


DECIDUOUS TREE PLANTING DETAIL - STAKED
NO SCALE

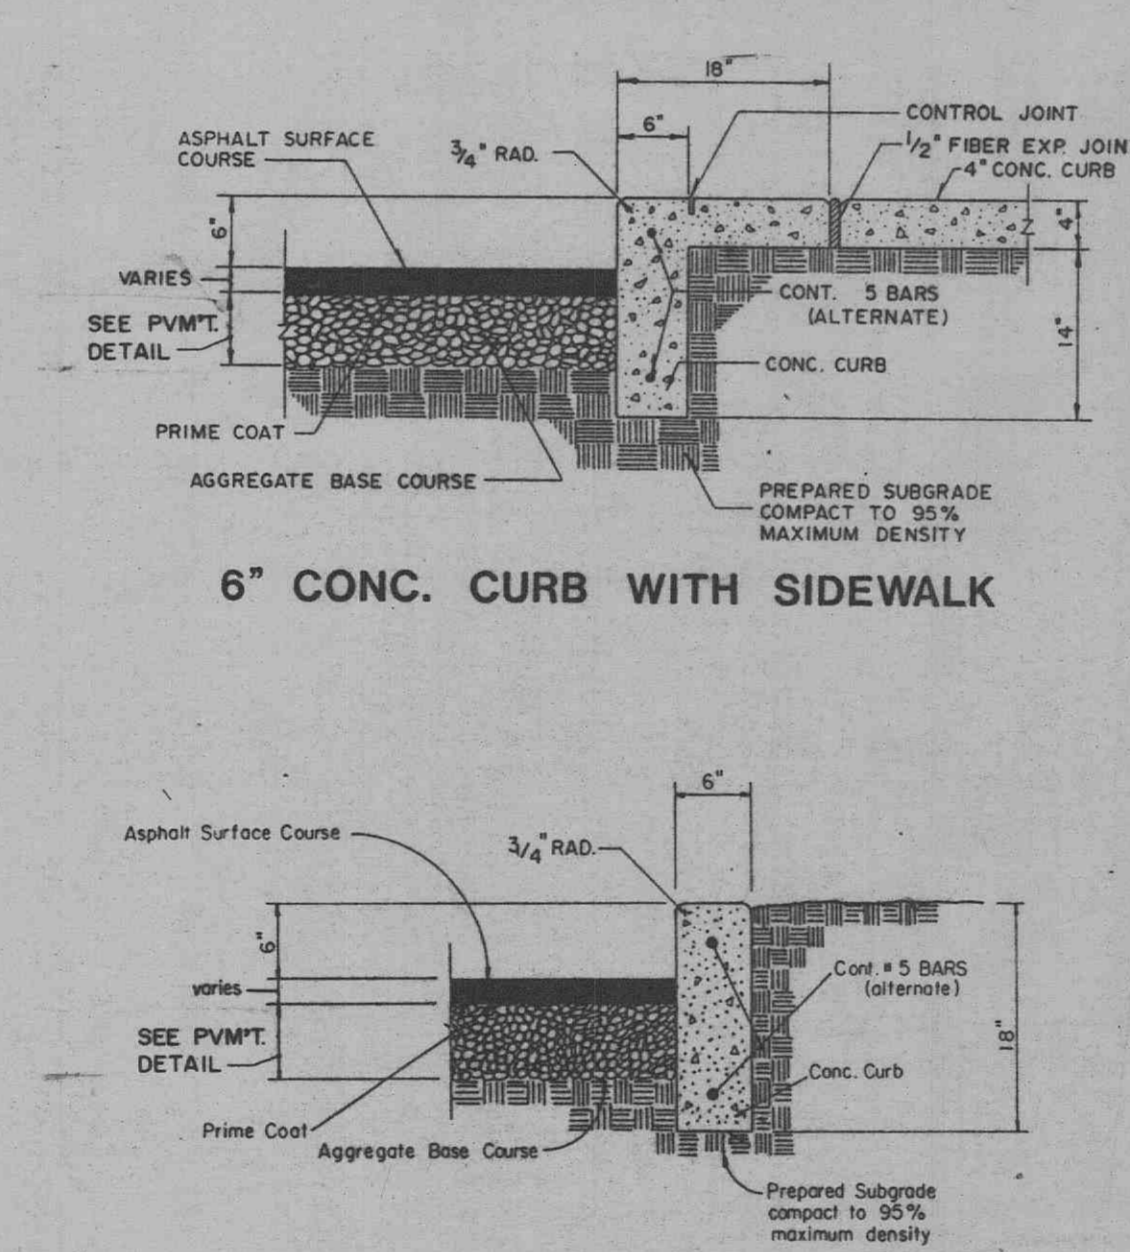



6" CONCRETE CURB

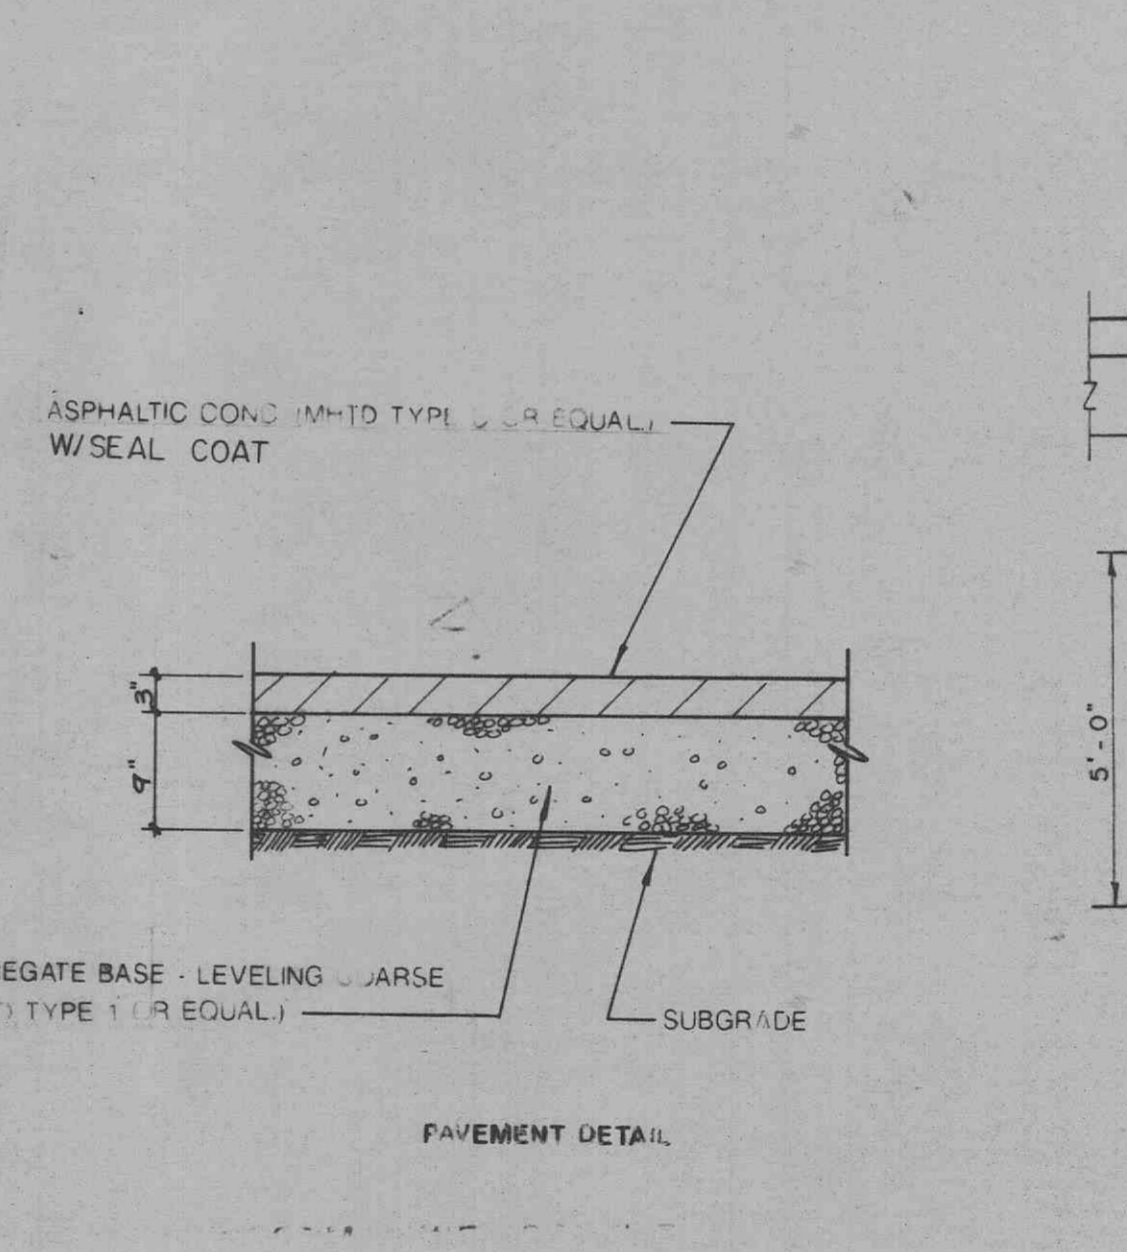


PAVEMENT DETAIL

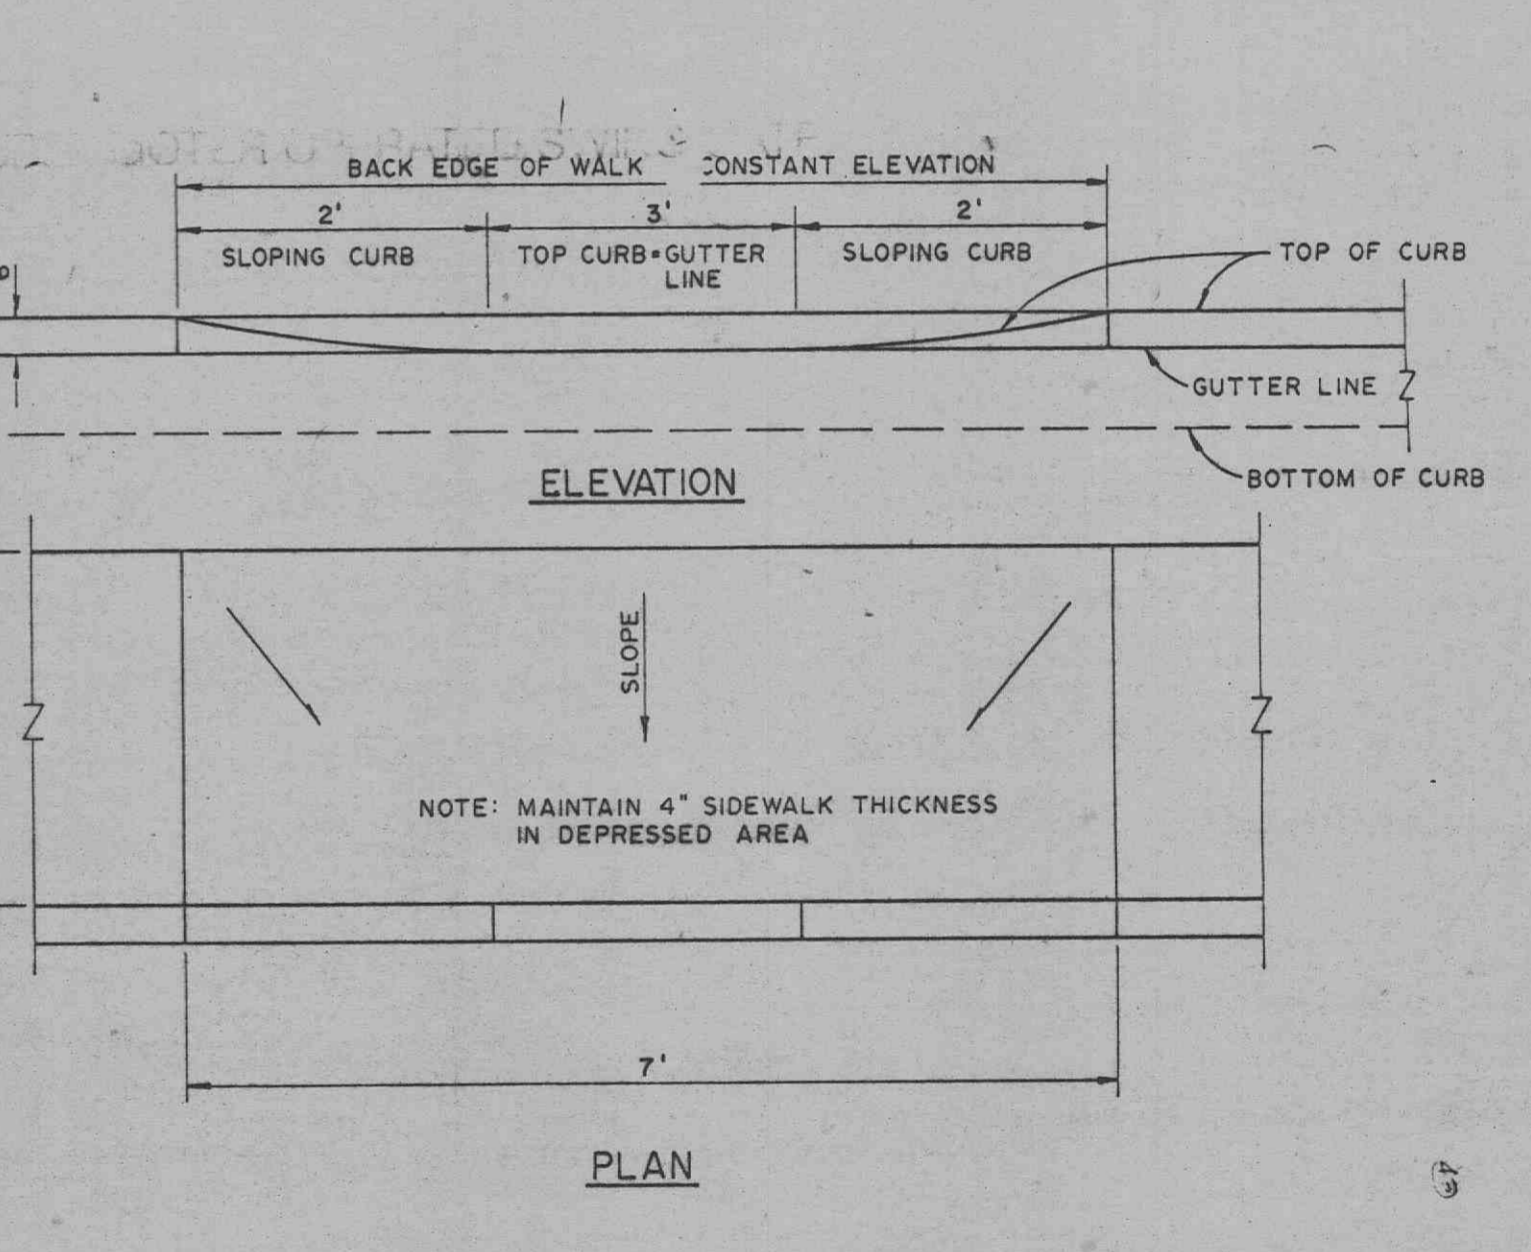


HANDICAPPED RAMP

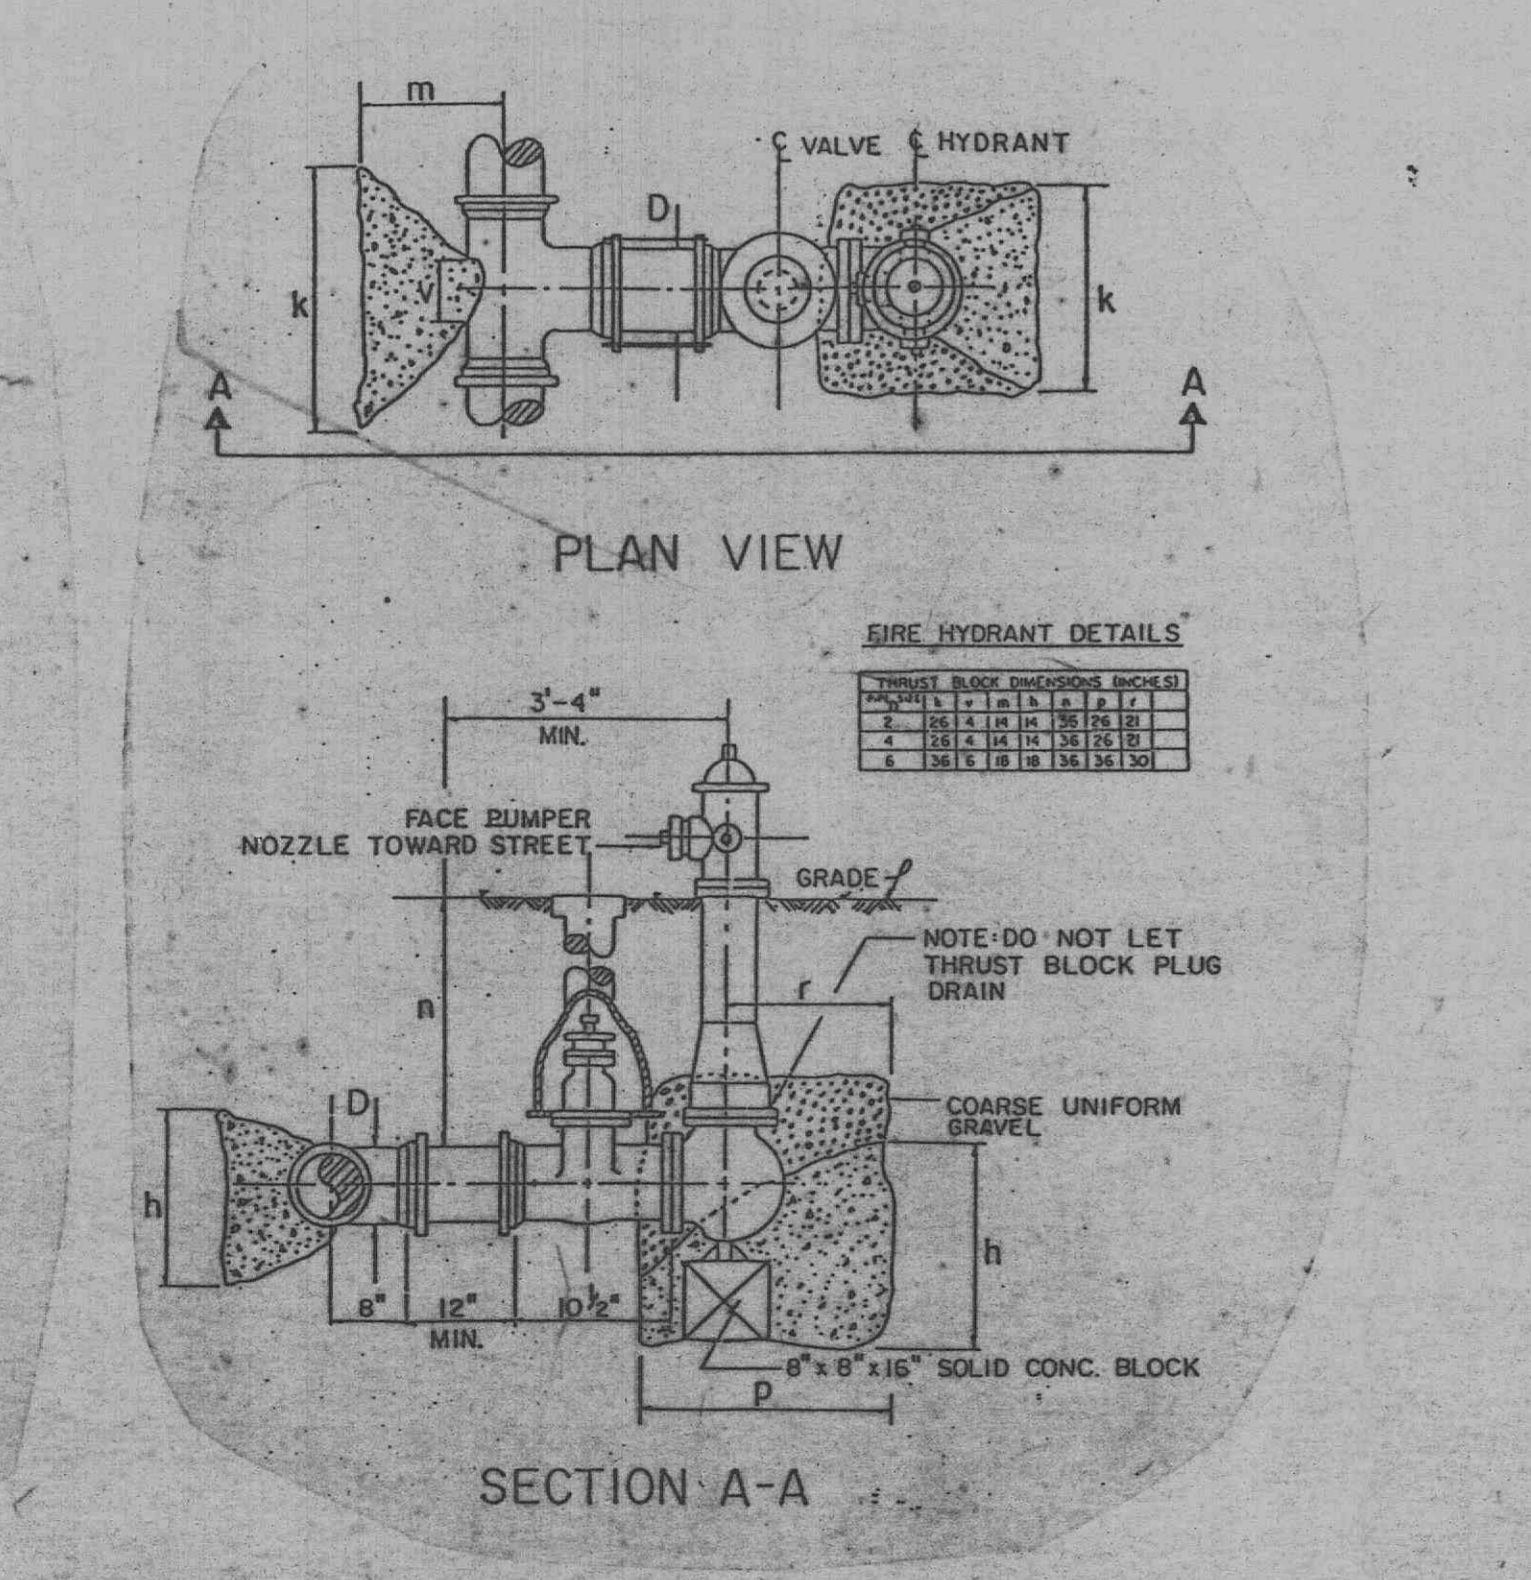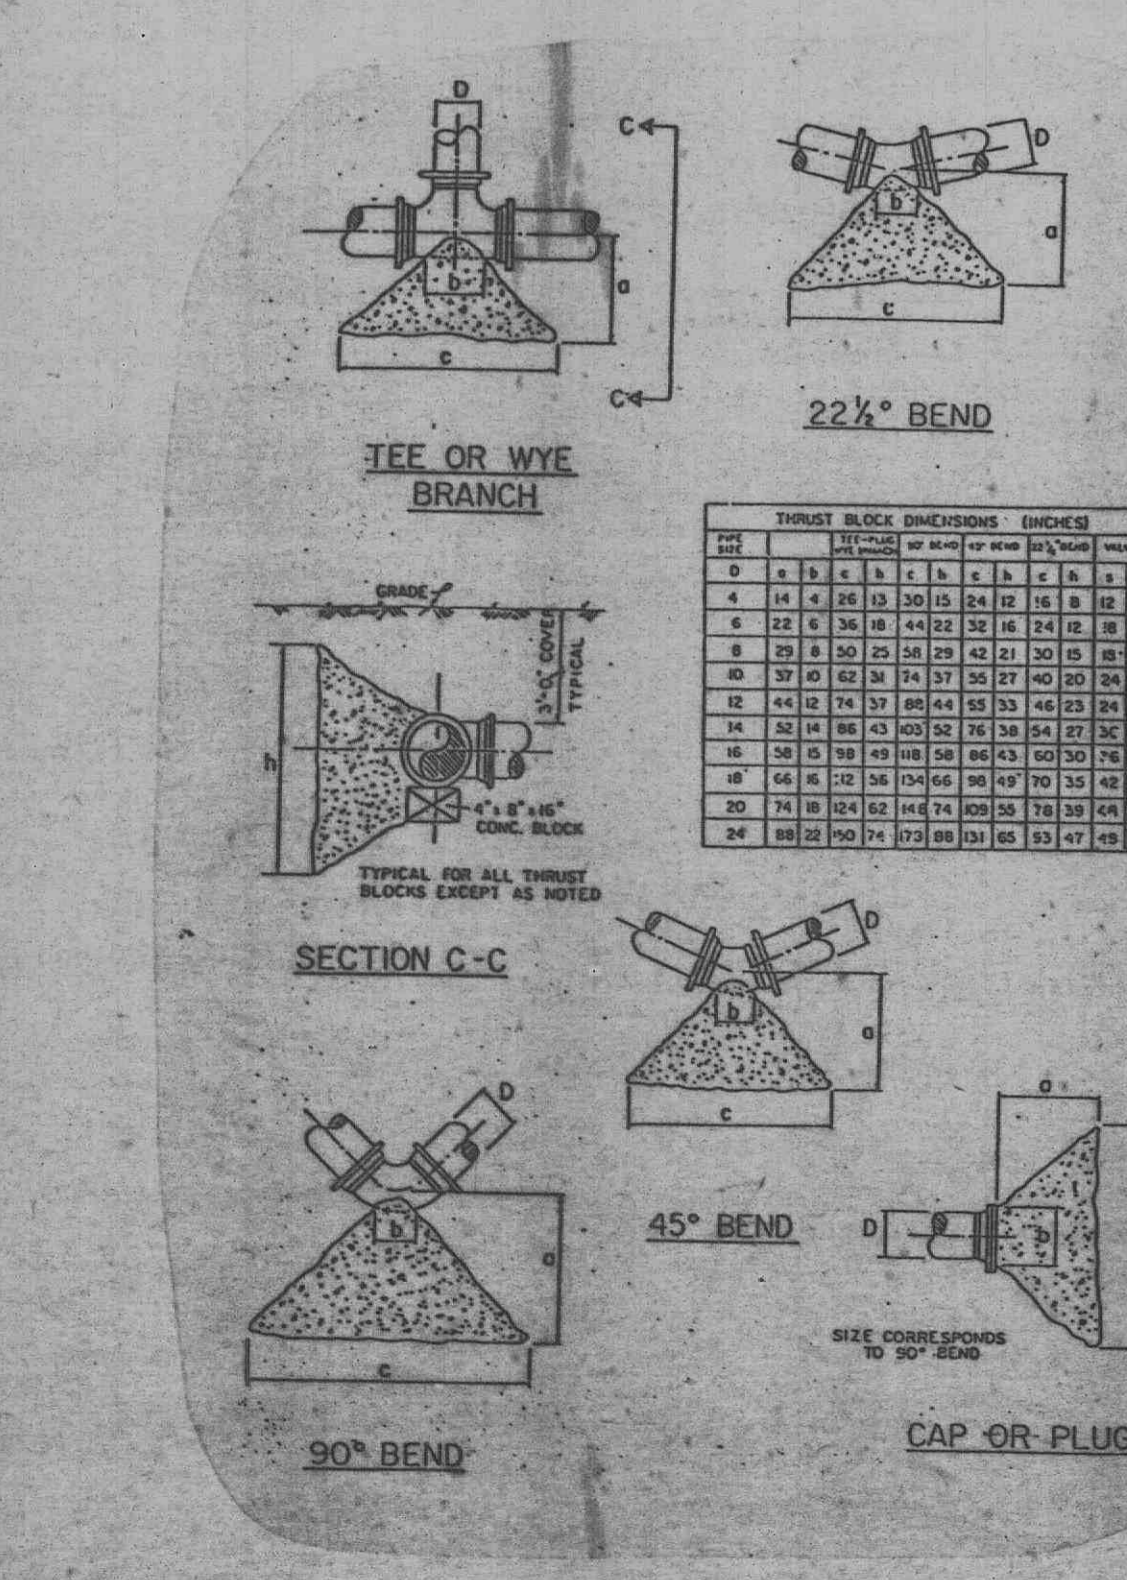

- Sanitary sewer pipes shall be 316-C stainless steel.
- Valves shall be resilient wedge, non-rising stem valves with operating nut and mechanical joint flanges manufactured in accordance with A.M.W.A. Standard C 509-80. The permanently bonded wedge sealing surfaces shall be resilient material meeting A.S.T.M. D 429 requirements for rubber bonded to cast iron and shall be as manufactured by Mueller Company or equal.
- All fire hydrants shall be 5-1/4" Mueller Figure #123. The hydrant assembly will be furnished with a 6" flanged shoe. A 6" auxiliary valve and valve box to be flanged by Mechanical Joint installed. All hydrants to be 5-way.
- All pipe and fittings shall be installed and pressure tested in accordance with A.M.W.A. Specification C-609-64 (300 psi at the low point).
- All pipe shall be disinfected in accordance with A.M.W.A. Specifications C-601 prior to being placed into service in the following manner: Disinfection shall be by the tablet method. Hypochlorite tablets (HTH) shall be attached to the pipe during installation. Two tablets per 50 foot length. Following installation, the main shall be filled with water at a velocity not to exceed one (1) foot per second. The water shall remain in the pipe for 24 hours prior to flushing.
- Horizontal and vertical separation of water and sewer lines shall be in accordance with regulations as prescribed by the Missouri Department of Natural Resources, Division of Environmental Quality, Public Drinking Water Program.
- Trenches shall be backfilled full width with granular backfill material a minimum of 12" above the pipe and a minimum of 3" below the pipe.
- Trenches at road crossings and parking areas shall be backfilled with compacted granular backfill material full height.
- All fittings within 6'-0" of each other shall be rodbed by utilizing two (2) 5/8" threaded rods, four (4) duct lugs, and four (4) 5/8" nuts and washers per pair of fittings and/or valves.
- A single No. 12 THW copper wire shall be placed in pipe trench with plastic watermain. Terminals of wire shall be brought above ground elevation at each end of watermain segment.
- All fasteners on all fittings, tapping elbows, and valves must be stainless steel or morden steel.
- Water meter to be installed 42" off ground.

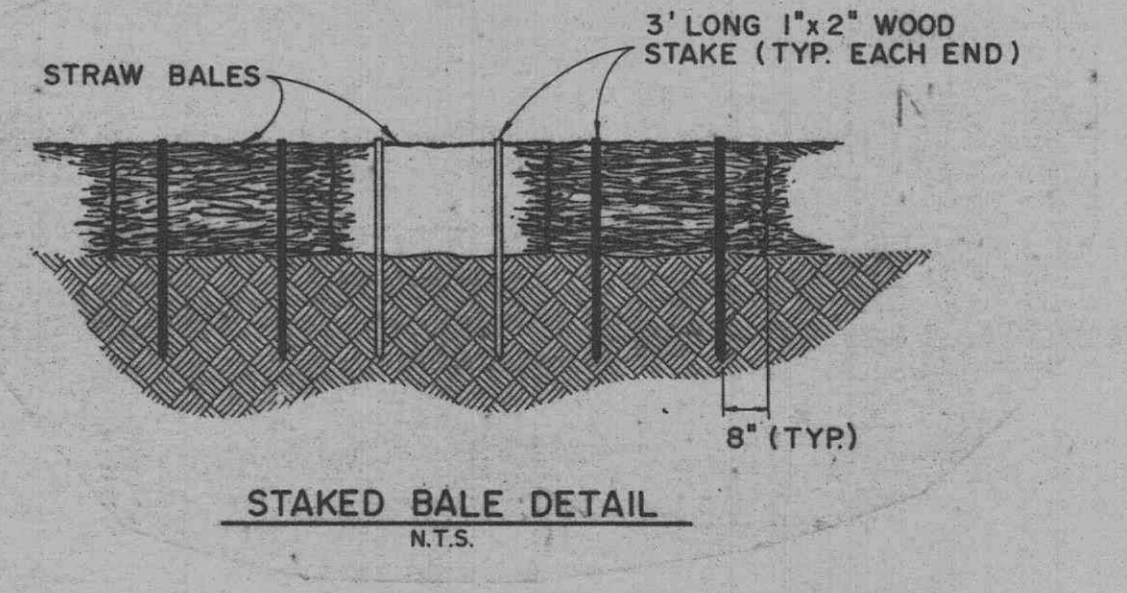

STRAKED BALE DETAIL

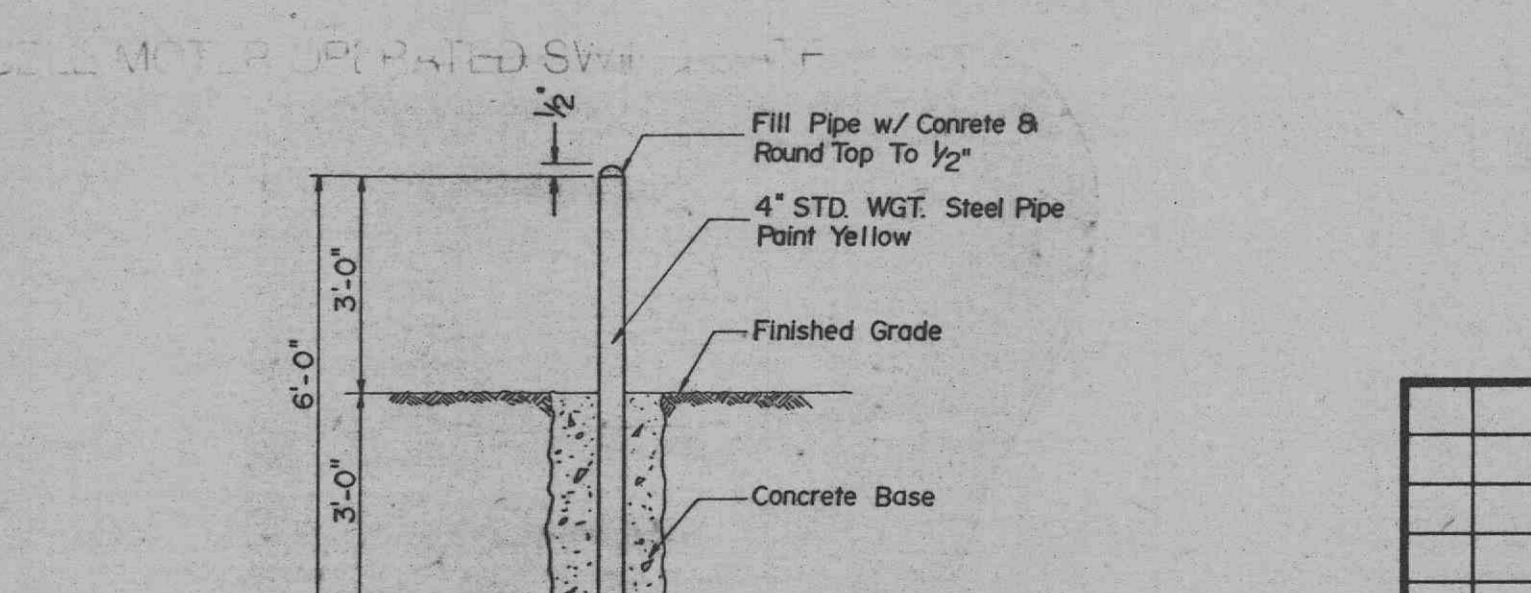

PIPE BOLLARD DETAIL

NO.	DATE	DESCRIPTION OF REVISION OR ISSUE	BY	CHK.	APPROVAL
1	10-25-89	AS-BUILT	JPT	JPT	JPT
2	6-5-91	NOTE REV.	JPT	JPT	JPT
3	7-28-91	MOTORIZED GATE & PIPE BOLLARD DETAIL	DPB	JPT	JPT
4	1-10-91	PT & MISC. REVISIONS	DLM	JPT	JPT
5	1-4-89	PIT DRAIN	DPB	JPT	JPT

DESIGNED	JPT	PROJ.	IO3B
DRAWN	DPB	COMPANIES	
CHECKED		ANHEUSER-BUSCH, INC.	
SCALE	NO SCALE	O'FALLON, MO.	
DATE	DEC. 23, 1986		

CONSULTANT		PROPERTY OF CITY OF O'FALLON BUILDING DEPARTMENT	
CLC	Colton/Lester Corporation Civil/Structural Engineers & Surveyors 14023 South Outer Perry Road O'Fallon, Missouri 63077 (618) 678-7007		

CIVIL DETAIL SHEET				
BLDG. NAME	PILOT PLANT			
ENGINEER APPROVED	OWNER APPROVED			
PLANT	BLDG. NO.	DIV.	DRG. NO.	REV.
OPB - 1	C - 1001			