


**STORM AND SANITARY SEWER MEASUREMENTS**  
 THE EXISTING SEWER LENGTHS, SIZES, FLOWLINES, DEPTHS OF STRUCTURES AND SEWERS AND LOCATIONS WITH RESPECT TO EXISTING OR PROPOSED EASEMENTS HAVE BEEN MEASURED. THE RESULTS OF THOSE MEASUREMENTS ARE SHOWN ON THIS SET OF FINAL MEASUREMENT PLANS. SINCE THE WYE LOCATIONS HAVE BEEN PLOTTED FROM INFORMATION PROVIDED BY THE SEWER CONTRACTOR OR OTHER SOURCES, I DISCLAIM ANY RESPONSIBILITY FOR THAT SPECIFIC INFORMATION.  
 ALL PUBLIC SEWERS ARE LOCATED WITHIN DESIGNATED EXISTING OR PROPOSED EASEMENTS EXCEPT AS FOLLOWS:

58-232 59.80 DENOTES AS-BUILT (TYP.)  
**METRON**  
 Surveying & Layout Co.  
 313 Wood Street  
 O'Fallon, MO, 63368  
 Ph: 314-432-5400 Fx: 636-294-5851

*John E. Winkler Jr.*  
 John E. Winkler Jr., PLS-200601664  
 Order No. 8284 Date: 11-7-18



32 COUNTRY LIVE DR  
 N/F CROSSER, RODNEY  
 2-056B-4235-00-0012.0000000

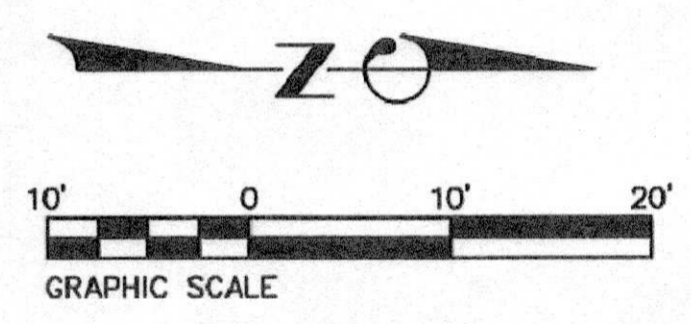

ALIGNMENT	STATION	STRUCTURE / PIPE	INVERT	OUTVERT	GRADE
ALIGNMENT A (0+00.00 - 1+34.30)	0+00.00	12" FES #1	529.16	529.16	529.16
	0+00.00	BEEHIVE INLET (48") #2	529.78	529.78	529.78
	0+00.00	6" P.C.C. WITH 2" ASPHALT OVERLAY	529.78	529.78	529.78
	0+00.00	BEEHIVE INLET (48") #4	529.56	529.56	529.56
	0+00.00	BEEHIVE INLET (48") #6	527.26	527.26	527.26
	0+00.00	18" FES #8	527.07	527.07	527.07
	0+00.00	12" FES #3	529.00	529.00	529.00
	0+00.00	BEEHIVE INLET (48") #2	529.78	529.78	529.78
	0+00.00	BEEHIVE INLET (48") #4	529.56	529.56	529.56
	0+00.00	BEEHIVE INLET (48") #6	527.26	527.26	527.26
	0+00.00	12" FES #5	527.93	527.93	527.93
	0+00.00	12" FES #7	528.43	528.43	528.43
ALIGNMENT B (0+00.00 - 0+19.02)	0+00.00	12" FES #3	529.00	529.00	529.00
	0+00.00	BEEHIVE INLET (48") #2	529.78	529.78	529.78
	0+00.00	BEEHIVE INLET (48") #4	529.56	529.56	529.56
	0+00.00	BEEHIVE INLET (48") #6	527.26	527.26	527.26
	0+00.00	12" FES #5	527.93	527.93	527.93
	0+00.00	12" FES #7	528.43	528.43	528.43
	0+00.00	12" FES #3	529.00	529.00	529.00
	0+00.00	BEEHIVE INLET (48") #2	529.78	529.78	529.78
	0+00.00	BEEHIVE INLET (48") #4	529.56	529.56	529.56
	0+00.00	BEEHIVE INLET (48") #6	527.26	527.26	527.26
	0+00.00	12" FES #5	527.93	527.93	527.93
	ALIGNMENT C (0+00.00 - 0+41.35)	0+00.00	12" FES #5	527.93	527.93
0+00.00		BEEHIVE INLET (48") #2	529.78	529.78	529.78
0+00.00		BEEHIVE INLET (48") #4	529.56	529.56	529.56
0+00.00		BEEHIVE INLET (48") #6	527.26	527.26	527.26
0+00.00		12" FES #7	528.43	528.43	528.43
0+00.00		12" FES #5	527.93	527.93	527.93
0+00.00		12" FES #3	529.00	529.00	529.00
0+00.00		BEEHIVE INLET (48") #2	529.78	529.78	529.78
0+00.00		BEEHIVE INLET (48") #4	529.56	529.56	529.56
0+00.00		BEEHIVE INLET (48") #6	527.26	527.26	527.26
0+00.00		12" FES #5	527.93	527.93	527.93
ALIGNMENT D (0+00.00 - 0+39.08)		0+00.00	12" FES #7	528.43	528.43
	0+00.00	BEEHIVE INLET (48") #6	527.26	527.26	527.26
	0+00.00	12" FES #7	528.43	528.43	528.43
	0+00.00	BEEHIVE INLET (48") #6	527.26	527.26	527.26
	0+00.00	12" FES #7	528.43	528.43	528.43
CHAD D. ROSS  
 ENGINEER NO. PE-2011024027  
 DATE PREPARED: 03/06/2018  
 DATE: 03/06/2018

ROUTE	STATE
DISTRICT	SHEET NO.
COUNTY	JOB NO.
ST. CHARLES	M29160608
CONTRACT ID.	PD #17-00040
PROJECT NAME	BOYER ST. STORM
SHEET NAME	STORM SEWER P&P

DESCRIPTION

DATE	DESCRIPTION

CITY OF O'FALLON, MO  
 PUBLIC WORKS DEPARTMENT  
 100 NORTH MAIN STREET  
 O'FALLON, MO 63366  
 636.379.5566

THOUVENOT,  
 WADE &  
 MOERCHEN, INC.  
 ENGINEERS & SURVEYORS