



BRISTOL AT WINGHAVEN

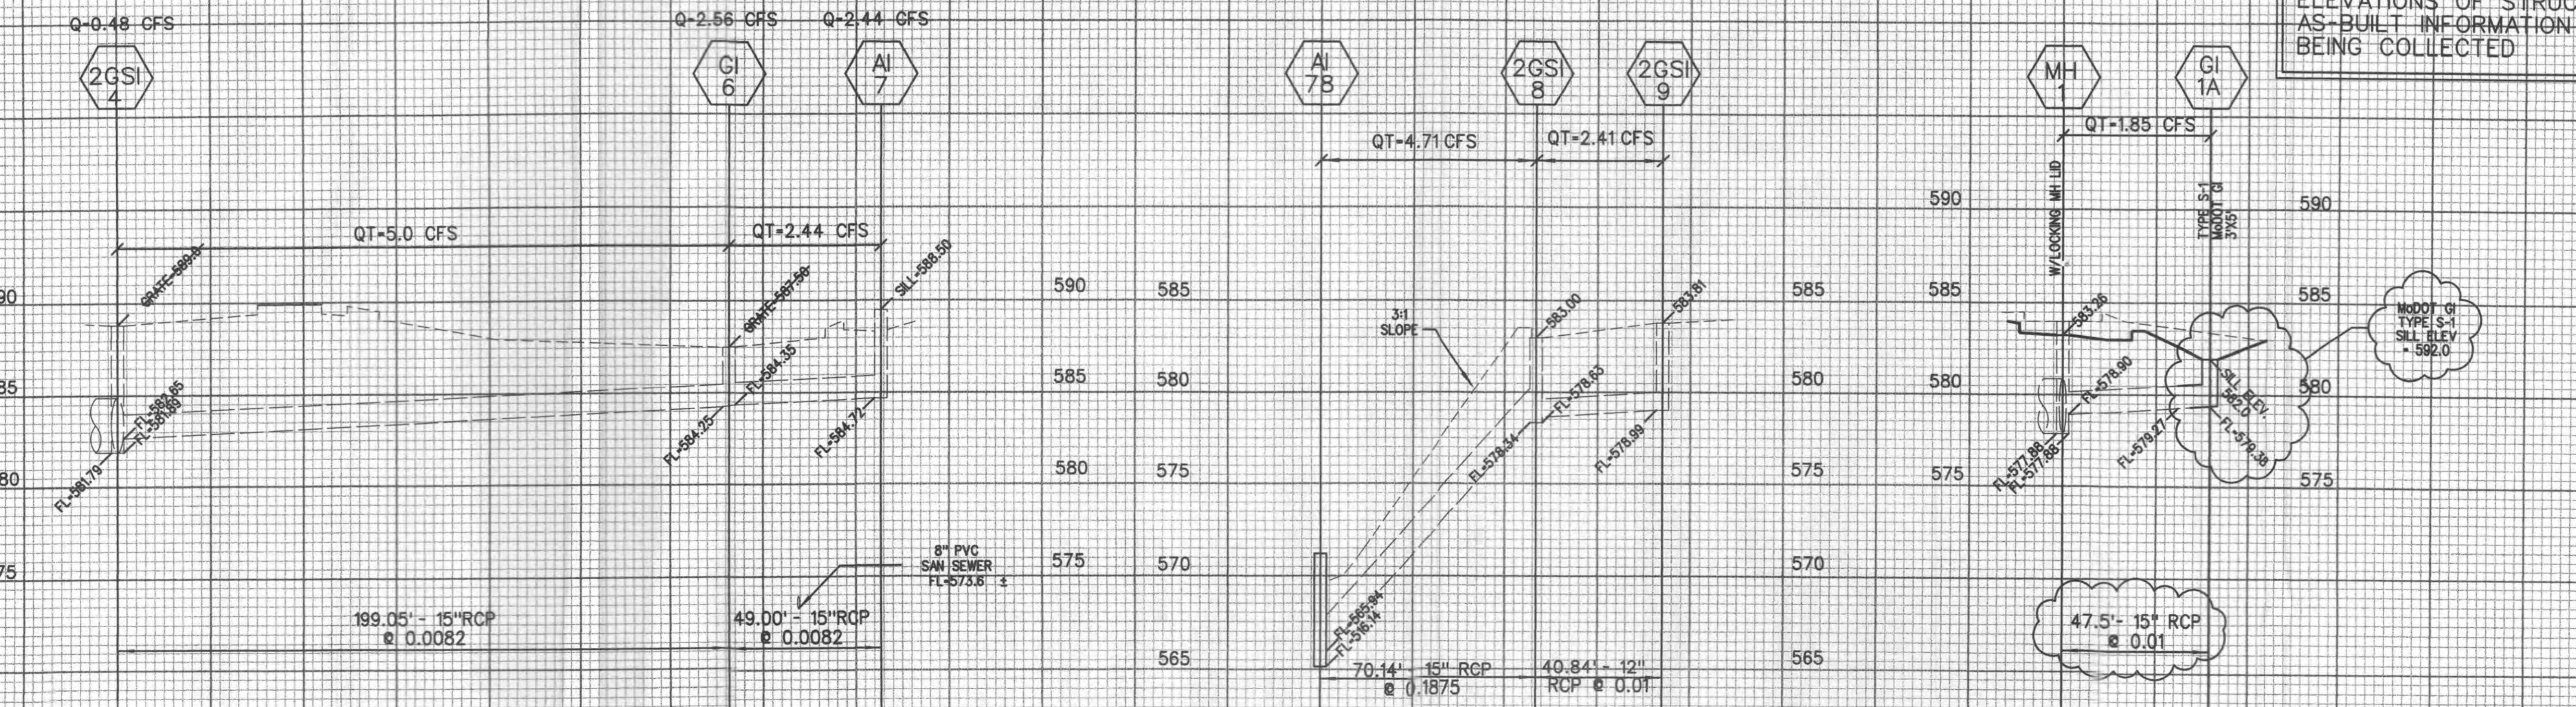

STORM SEWER PROFILES
Design By: JAF
Drawn By: JRS
Checked By: JAF
B-5630-33
12-12-02

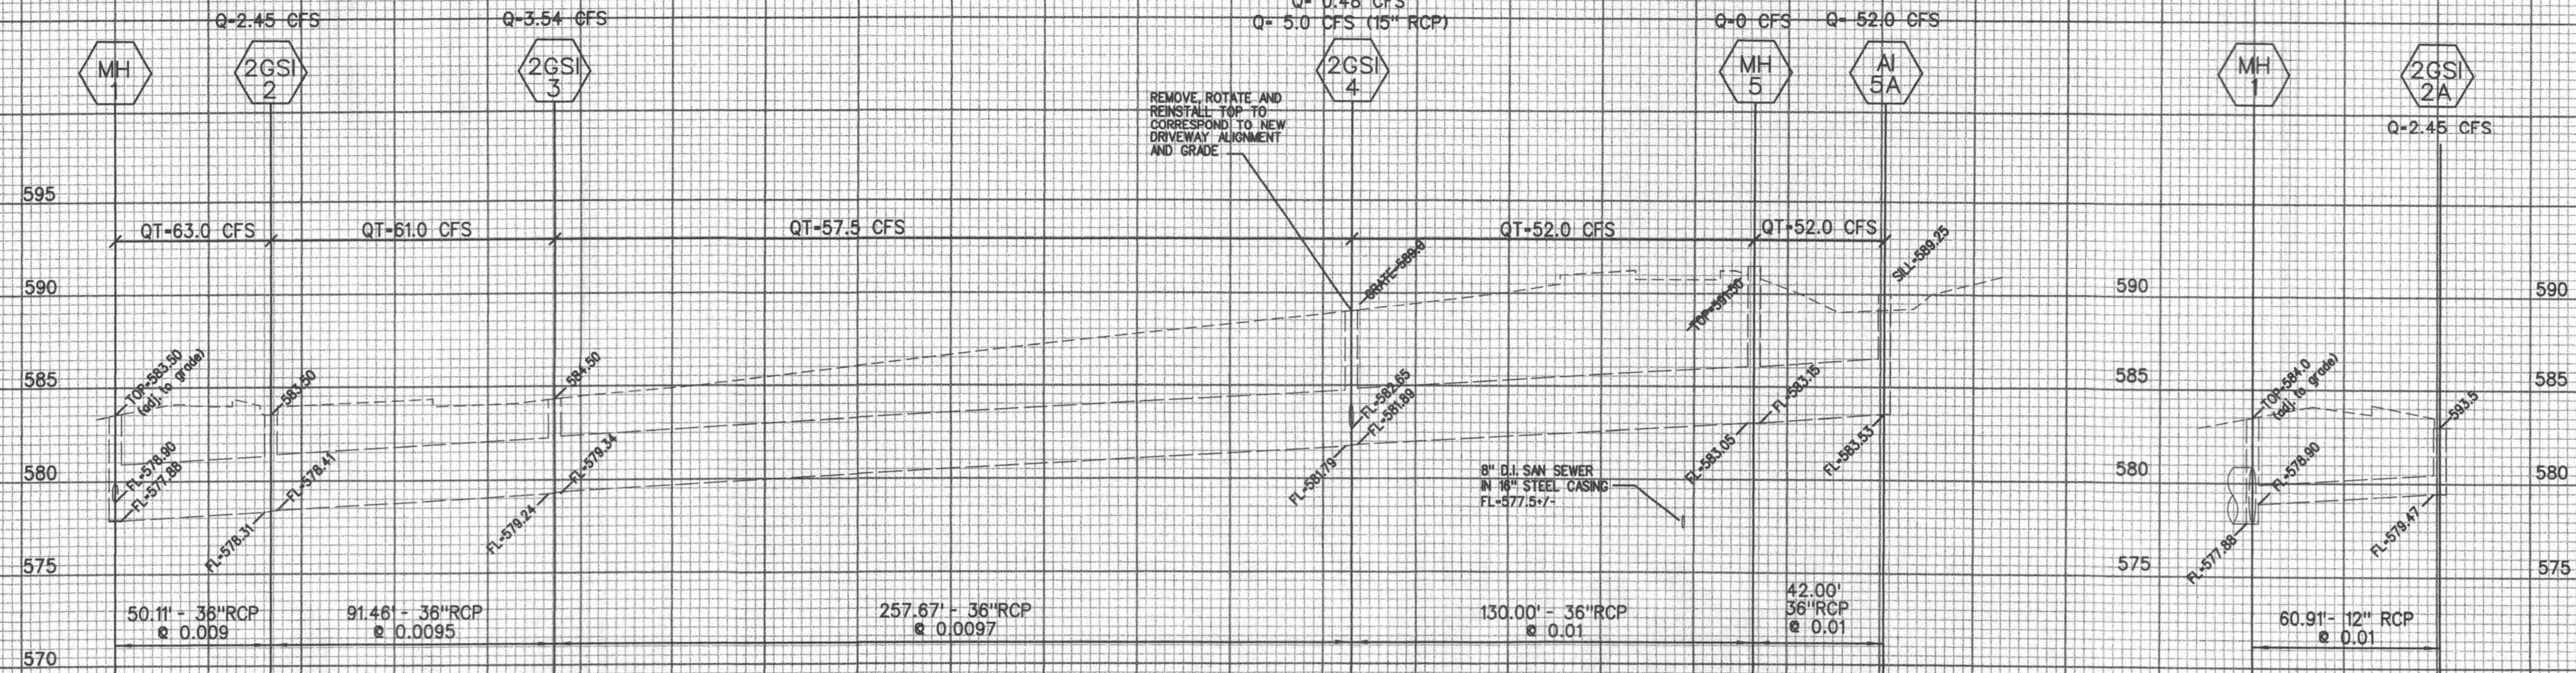

DO NOT RELY ON TF/GRATE/SILL ELEVATIONS OF STRUCTURES. AS-BUILT INFORMATION IS STILL BEING COLLECTED

REVISED: 4-02-03 PER MOBOT COMMENTS