



SCALE: 1"=50' HORIZONTAL
1"=10' VERTICAL

ALL STORM SEWERS MUST MAINTAIN A MINIMUM OF 36" COVER OVER TOP OF PIPE.


VILLAGE A PHASE ONE AS-BUILTS

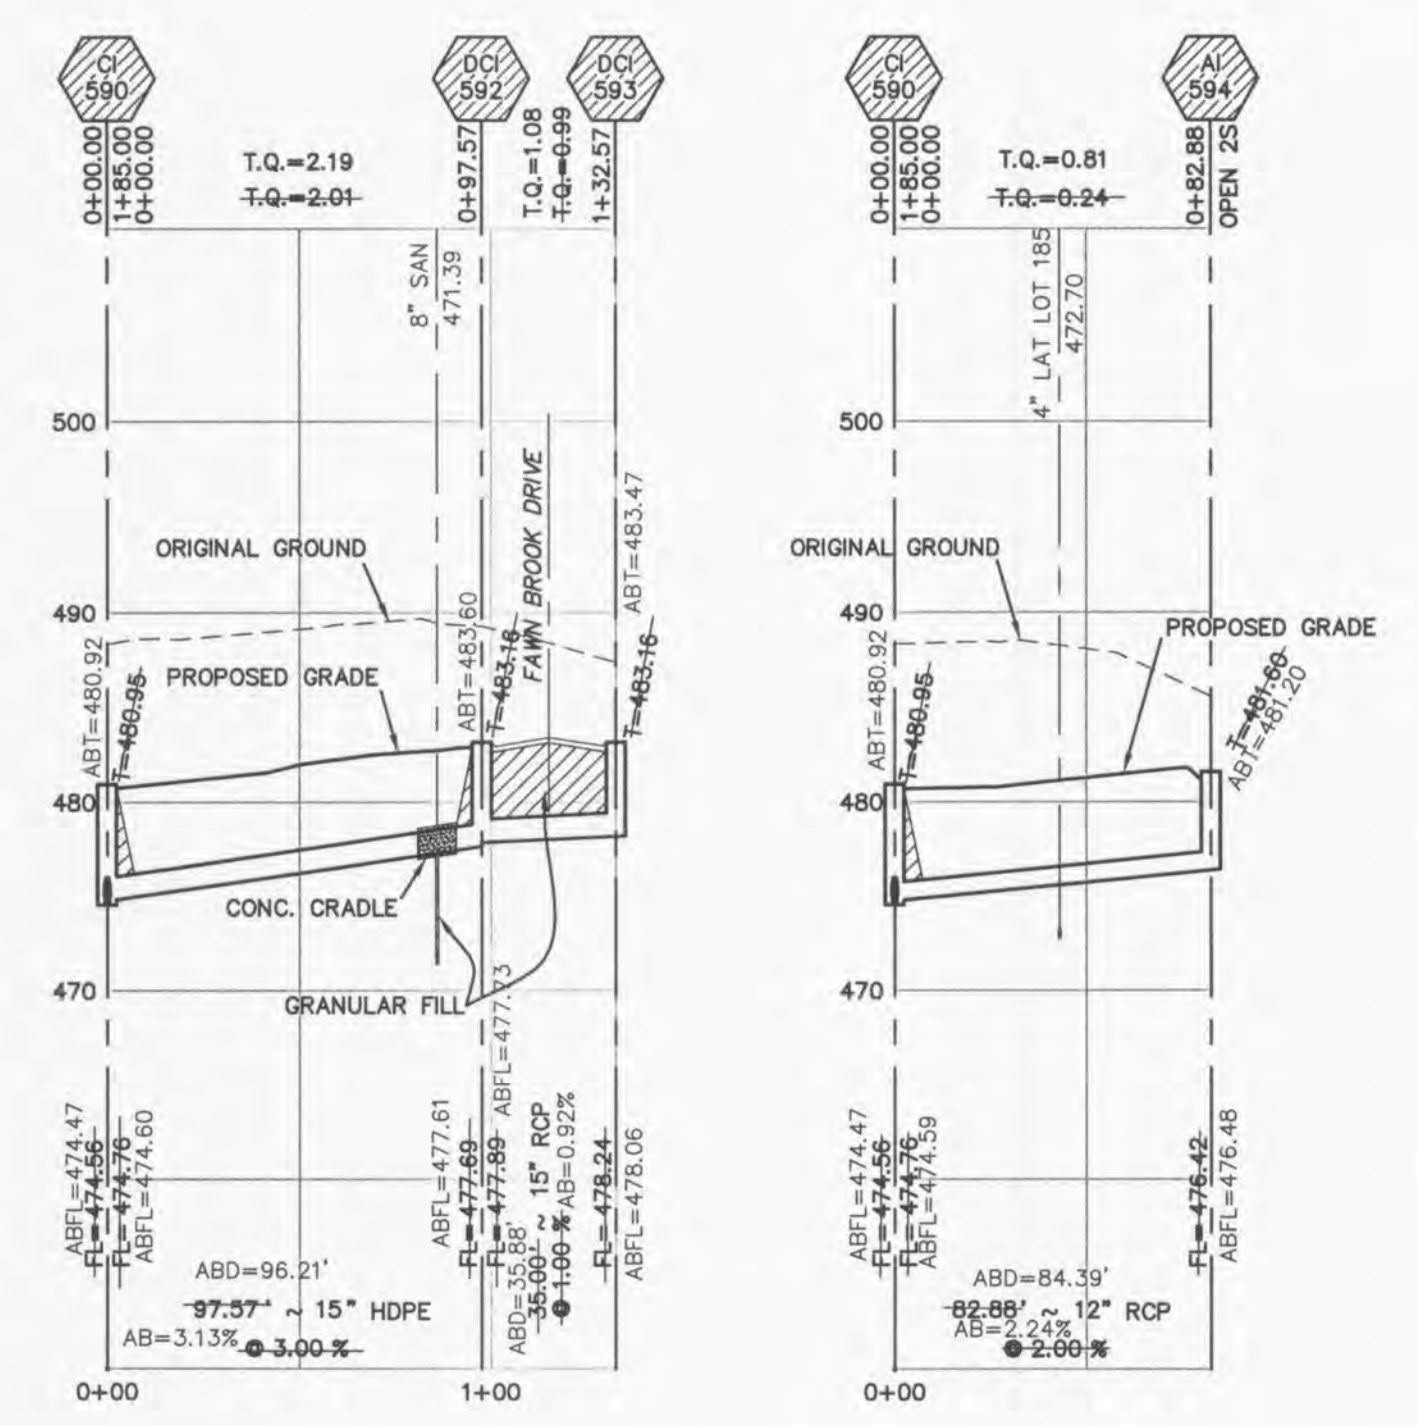

VILLAGE A PHASE ONE AS-BUILTS

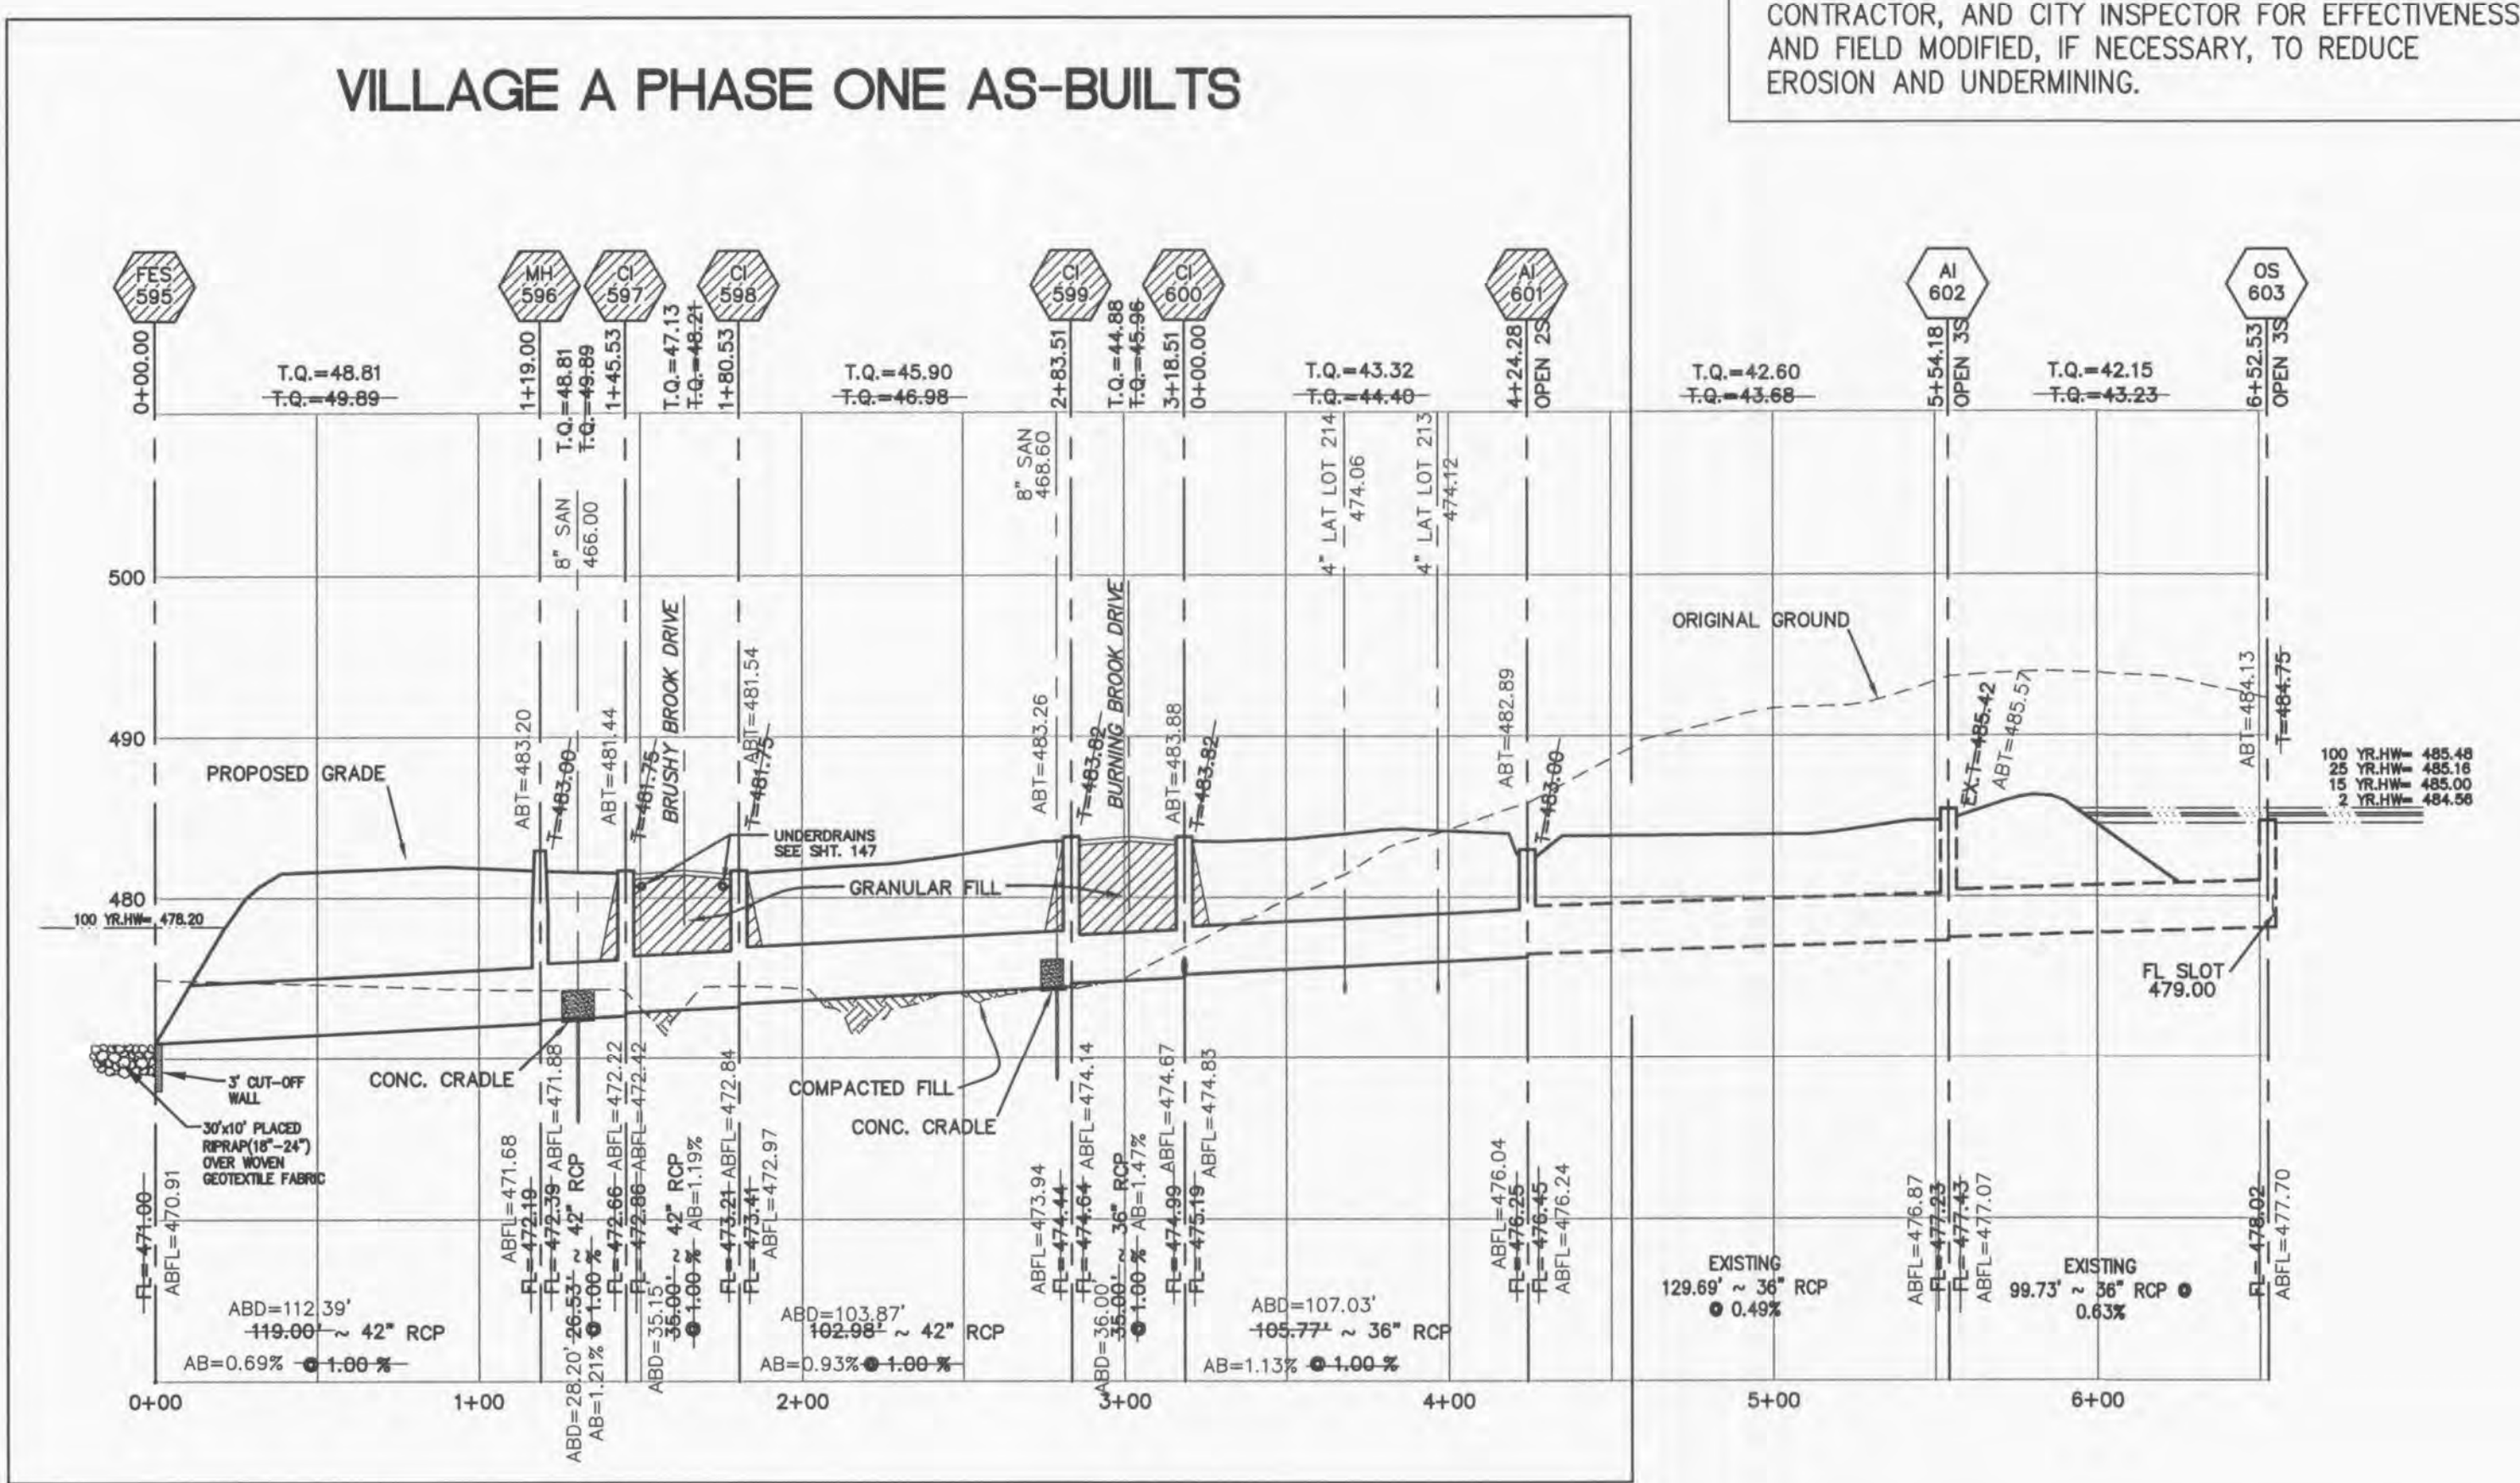

VILLAGE A PHASE ONE AS-BUILTS

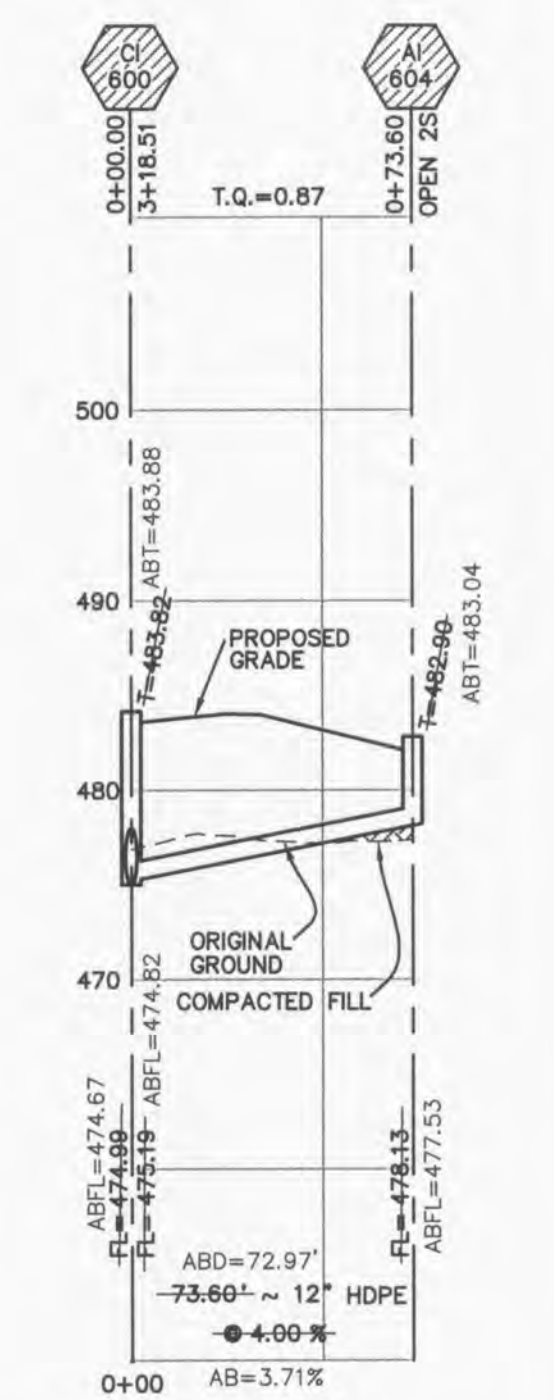

PROJECT TITLE

BROOKSIDE
VILLAGE A

PRS No. 03029.LOMB.01R


PICKETT, RAY & SILVER INC.

CIVIL ENGINEERING, LAND SURVEYING,
AND NATURAL RESOURCES SERVICES

115 W. Main Street, Suite 201
Bremen, MO 64606

Phone (636) 397-1211 Fax (636) 397-1104
www.prs.com 1-800-708-9916

ENGINEERS AUTHENTICATION
THE RESPONSIBILITY FOR PROFESSIONAL ENGINEERING LIABILITY ON THIS PROJECT IS HEREBY CERTIFIED TO THE SET OF PLANS AUTHORIZED BY THE SEAL, SIGNATURE, AND DATE HEREON ATTACHED. RESPONSIBILITY IS DECLARED FOR ALL OTHER ENGINEERING PLANS INVOLVED IN THIS PROJECT AND SPECIFICALLY EXCLUDED REVISIONS AFTER THIS DATE UNLESS REAUTHENTICATED.

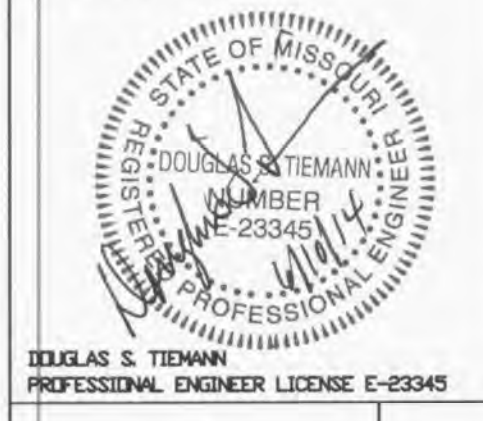

Douglas S. Tiemann
PROFESSIONAL ENGINEER LICENSE E-23345

Developer / Owner Information

Lombardo Homes of St. Louis, LLC
2299 Technology Drive, Suite 150
O'Fallon, Missouri 63368



CITY OF O'FALLON Storm Sewer Profiles

P+Z No. 2603.04

City No.

Page No.

19 of 40