



ADDENDUM #1  
SEE SHEET C-13.3 FOR REVISED METER  
BOX AND DETECTOR CHECK VAULT DETAILS

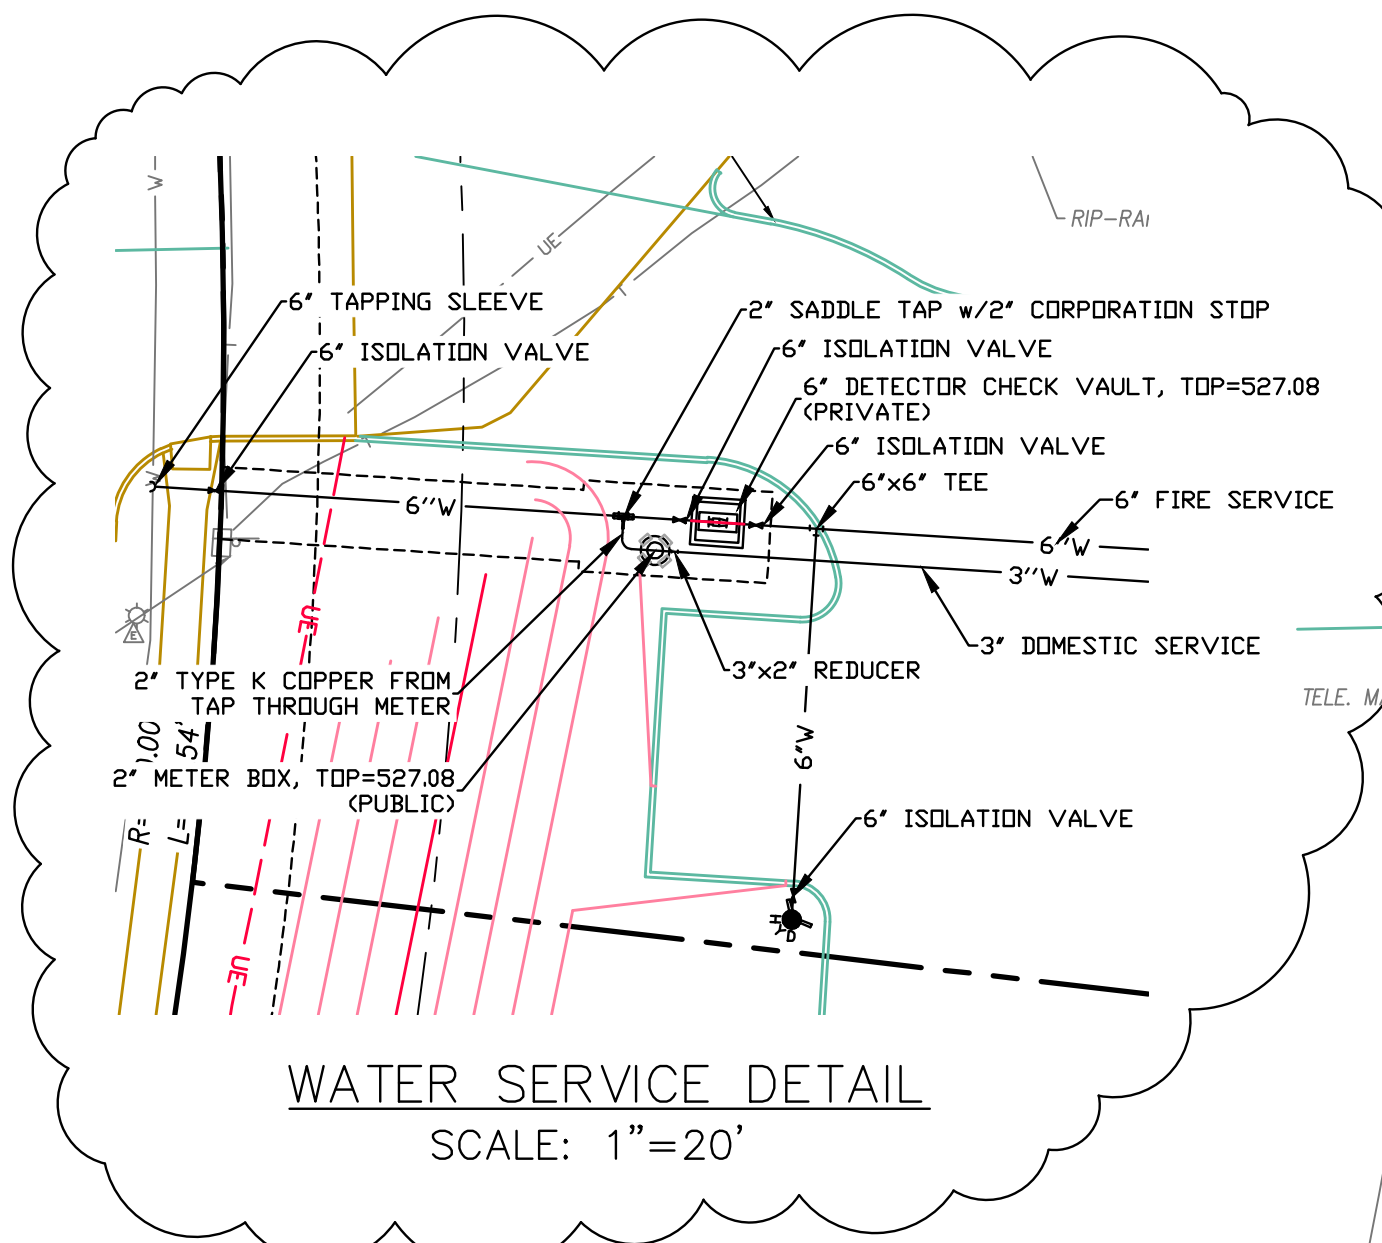


ADDENDUM #1

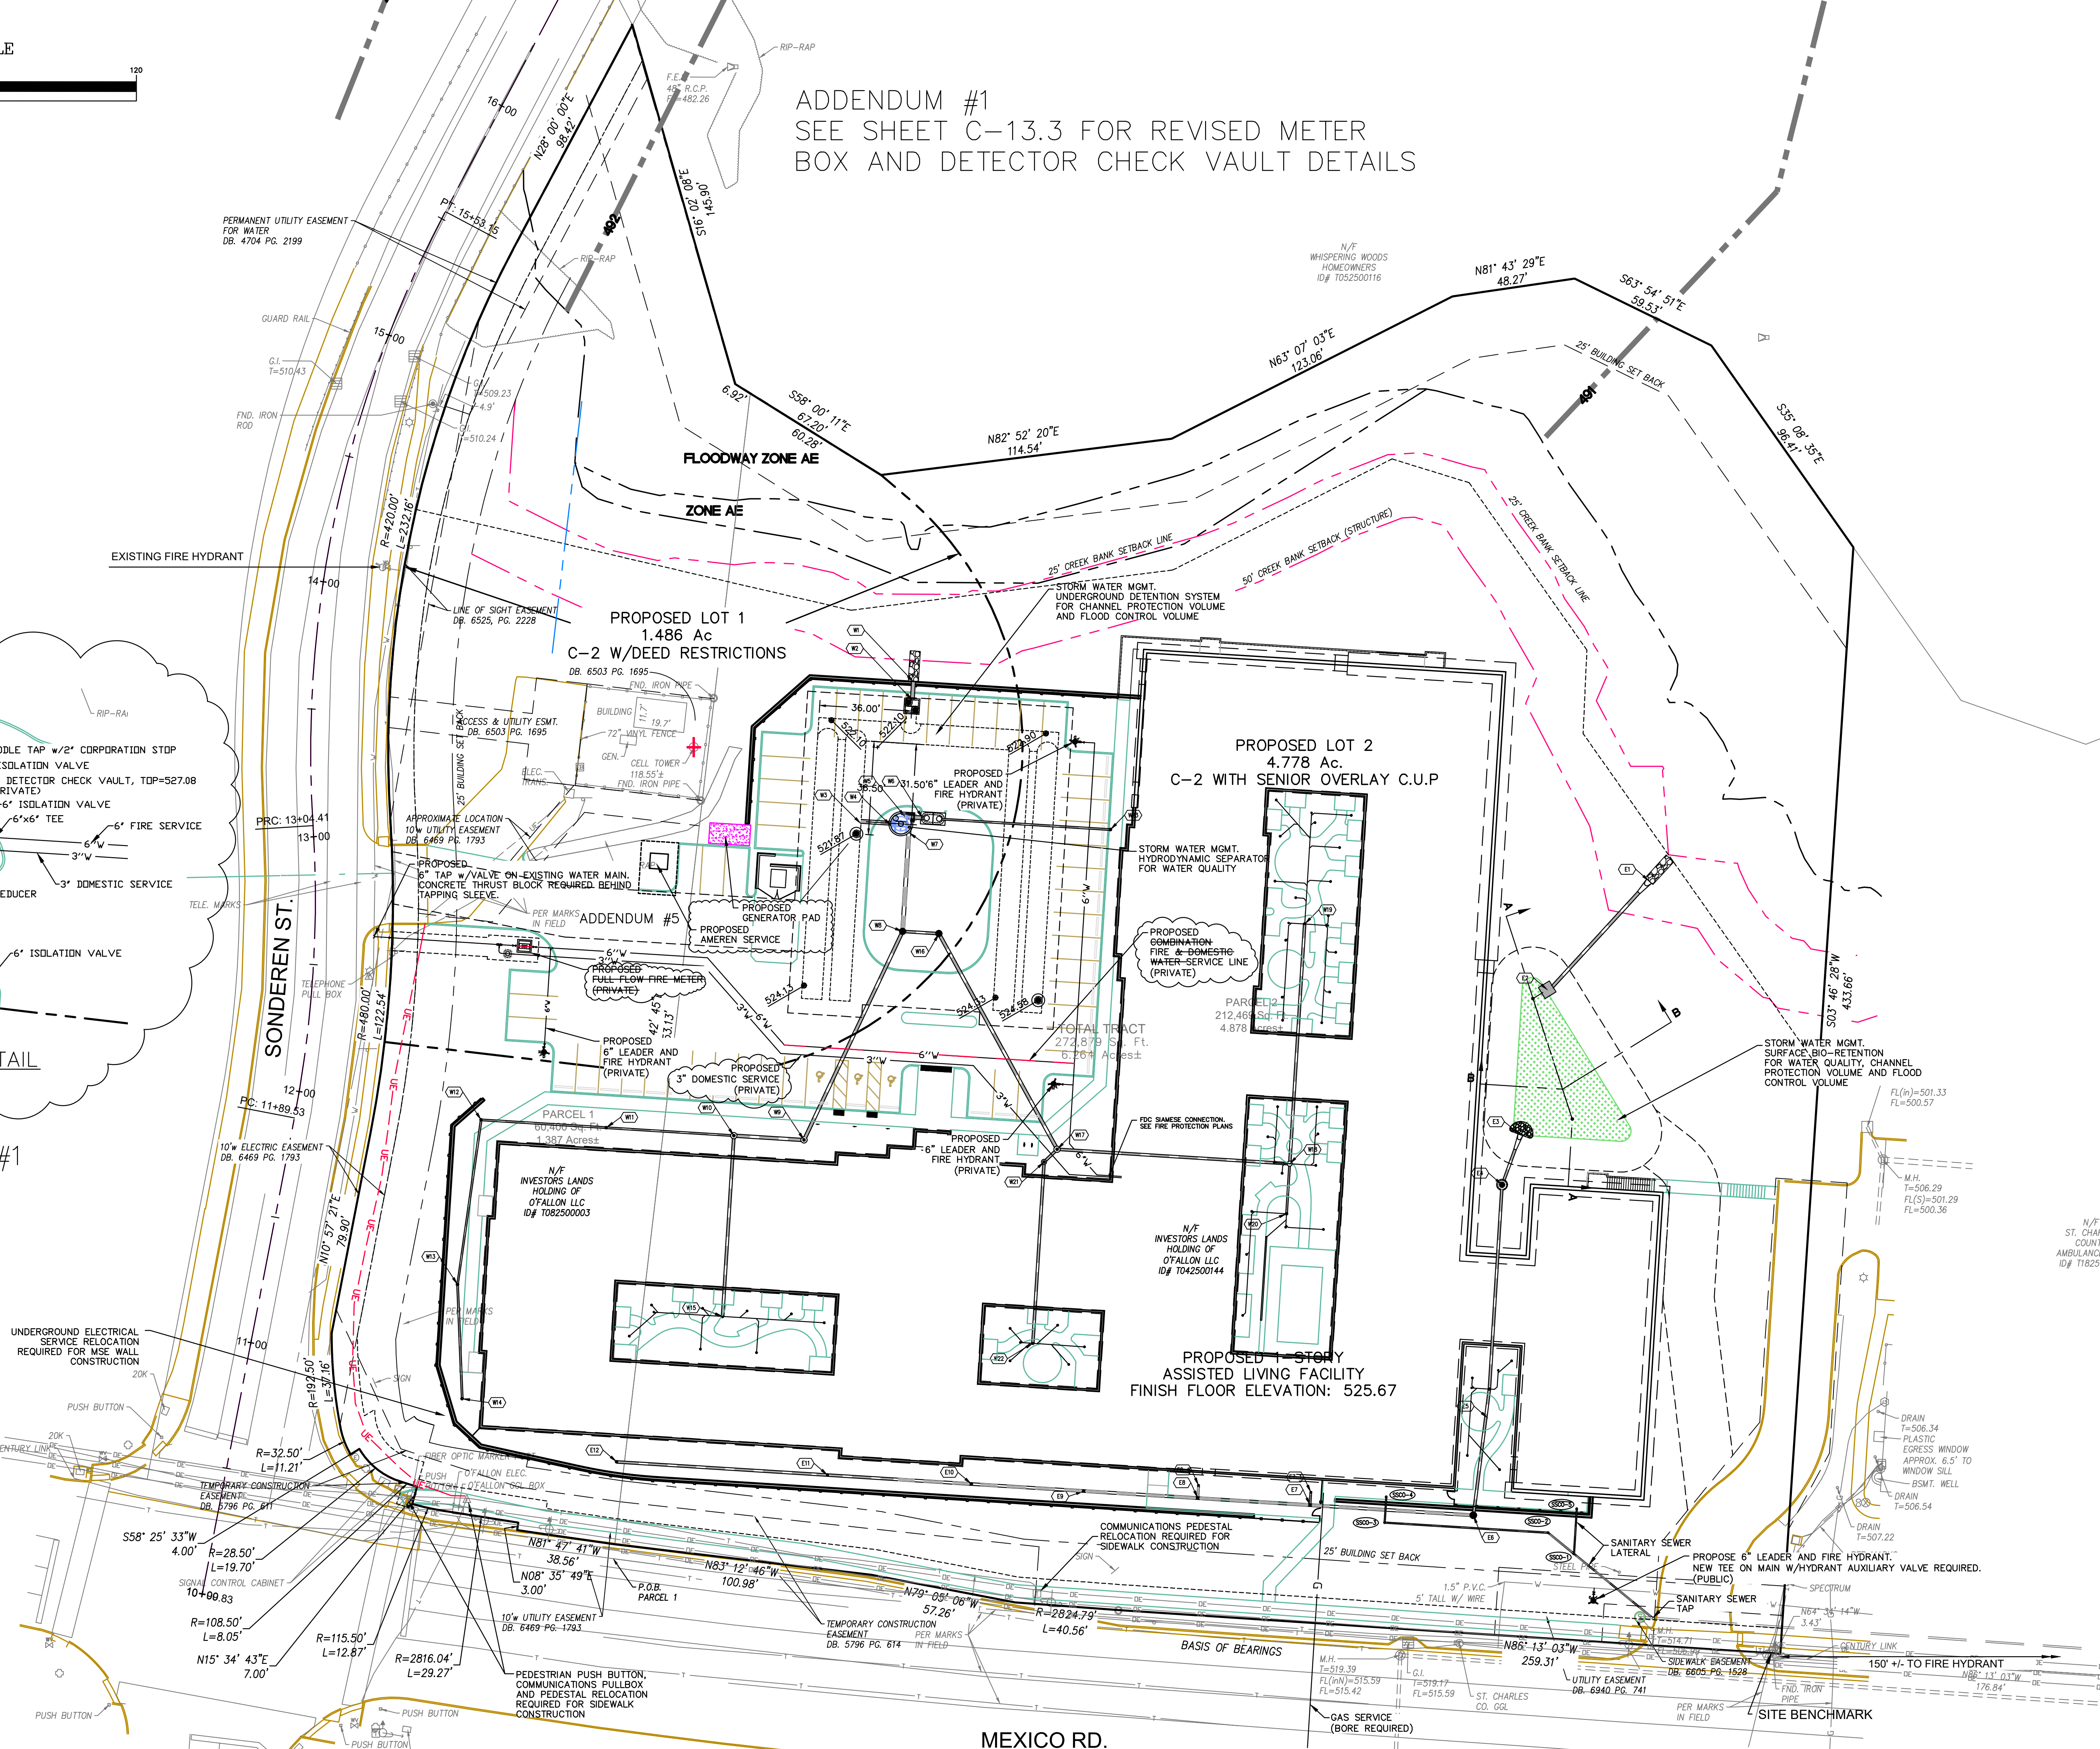

PREPARED BY:  
**STOCK & ASSOCIATES**  
Consulting Engineers, Inc.

SITE IMPROVEMENT PLANS FOR:  
**HAMPTON MANOR OF O'FALLON**  
NEW HOME FOR THE AGED  
MEXICO ROAD and SONDEREN STREET  
O'FALLON, MISSOURI 63376

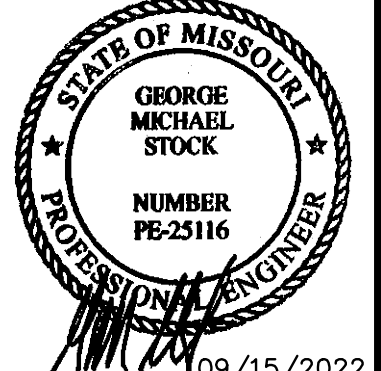

GEORGE M. STOCK E-28116  
CIVIL ENGINEER  
CERTIFICATE OF AUTHORITY  
NUMBER: 000996

REVISIONS:

1	ENGINEERING PLAN REVIEW SUBMITTAL 06/09/21
2	ENGINEERING PLAN REVIEW SUBMITTAL REVISED PER CITY COMMENTS AND CLIENT PROJECT & CONTRACT REVISIONS 09/20/21
3	ENGINEERING PLAN REVIEW 3rd SUBMITTAL 10/19/21 REVISED PER CITY COMMENTS DATED 10/04/21
4	ENGINEERING PLAN REVIEW 4th SUBMITTAL 11/02/21 REVISED PER CITY COMMENTS DATED 11/02/21
5	ADDENDUM #1 03/29/22 - WATER SERVICE REVISIONS PER CITY COMMENTS DATED 03/23/22
6	ADDENDUM #1 06/23/22 - CONCEPT OMP DETENTION SYSTEM SHOP DRAWINGS ADDED TO PLAN
7	ADDENDUM #1 06/27/22 - METAL BACKFILL COMPUTATION REQUIREMENTS
8	ADDENDUM #1 06/28/22 - ADDED TYPICAL MANHOLE DETAIL TO MEET S-18
9	ADDENDUM #1 09/15/22 - REVISED WALL & TOP OF WALL (T.O.W.) ELEVATIONS, ADDS GENERATOR

DRAWN BY: D.P.B. CHECKED BY: G.M.S.  
DATE: 01/25/2021 JOB NO: 220-6888  
M.S.D. P #: B22-MAP #:  
S.L.C. HAT #: HAT S.U.P. #:  
M.D.N.R. #:

SHEET TITLE: **SITE UTILITY PLAN**  
SHEET NO: **C-4**

DRAWN BY: D.P.B. CHECKED BY: G.M.S. DATE: 01/25/2021 JOB NO: 220-6888 M.S.D. P #: B22-MAP #: S.L.C. HAT #: HAT S.U.P. #: M.D.N.R. #: