

NOTE: Provide a marking on the storm sewer inlet. The City will allow the following markers and adhesive procedures only as shown in the table below or an approved equal by Almetek Industries. \*Peel and stick\* adhesive pods will not be allowed.

Manufacturer	Size	Adhesive	Style	Message (Part #)	Website
ACP International	3 7/8"	Epoxy	Crystal Cap	No Dumping Drains To Waterway (SD-W-C)	www.acpinternational.com
DAS Manufacturing, Inc.	4"	Epoxy	Standard Style	No Dumping Drains To Stream (SDS)	www.dasmanufacturing.com

NOTE: RP RAP SHOWN AT FLARED ENDS WILL BE EVALUATED IN THE FIELD AFTER INSTALLATION FOR EFFECTIVENESS AND FIELD MODIFIED IF NECESSARY TO REDUCE EROSION ON AND OFF SITE. RP RAP IS NOT TO BE GROUTED.

NOTE: CUTOFF WALLS ON FE'S ARE 2' DEEP UPSTREAM, 3' DEEP DOWNSTREAM. (FE'S SHALL BE CONC.)

SCALE:  
 HOR. - 1"=40'  
 VERT. - 1"=10'  
 P&Z APPROVAL 10.05.06  
 FILE #2606.01

"AS-BUILTS" 12-17-07

**PICKETT RAY & SILVER**  
 CIVIL ENGINEERS  
 PLANNERS  
 LAND SURVEYORS

333 Mid Rivers Mall Drive  
 St. Peters, MO 63376  
 Phone (636) 397-1211  
 Fax (636) 397-1104


SSM HEALTHCARE  
 IMPROVEMENT PLANS  
 OF ALLON, MO

Prepared For:  
 LILLIBRIDGE

LILLIBRIDGE  
 CONTACT: NOE MARTINEZ  
 5308 WEST PLANO PARKWAY  
 PLANO, TEXAS, 75093-4821  
 972-867-0000 EXT. 560

REVISIONS NO.	DATE	REVISED PER CITY COMMENTS
1	10.19.06	REVISED PER MDOT COMMENTS
2	11.09.06	REVISED PER MDOT COMMENTS
3	12.15.06	REVISED PER MDOT COMMENTS
4	12.17.07	"AS-BUILTS"

**ENGINEERS AUTHENTICATION**  
 The responsibility for professional engineering liability on this project is hereby limited to the set of plans authenticated by the seal, signature, and date hereunder attached. Responsibility is disclaimed for all other engineering plans involved in this project and specifically excludes revisions after this date unless reauthenticated.

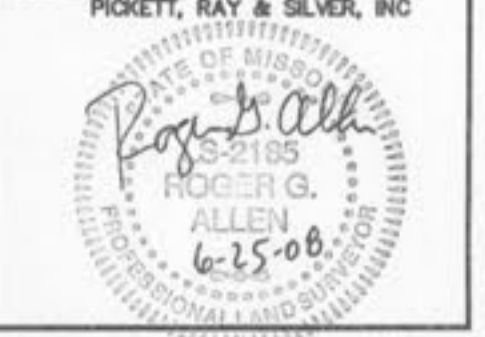

DRAWN	DATE
J.M. WINTERS	10.11.06
CHECKED	DATE
S.D. MARION	10.11.06

PROJECT # 91090.LILB.02C  
 TASK # 2 FIELD BOOK 450E

3:enverpra/Projects/91090.LILB.dwg(91090) 12/19/2007 1:08:36 PM, ERUK STOSZ