


Sanitary Sewer Profiles
MAR-TON EST.

Jan. 1984 85-020
As-Built 12-11-84 -K

DATE
BY
FINAL SURVEY
SURVEYED
TEMPLATE
NOTE BOOK
AREAS CHECKED
NO.

DATE
BY
ORIGINAL SURVEY
SURVEYED
TEMPLATE
NOTE BOOK
AREAS CHECKED
NO.

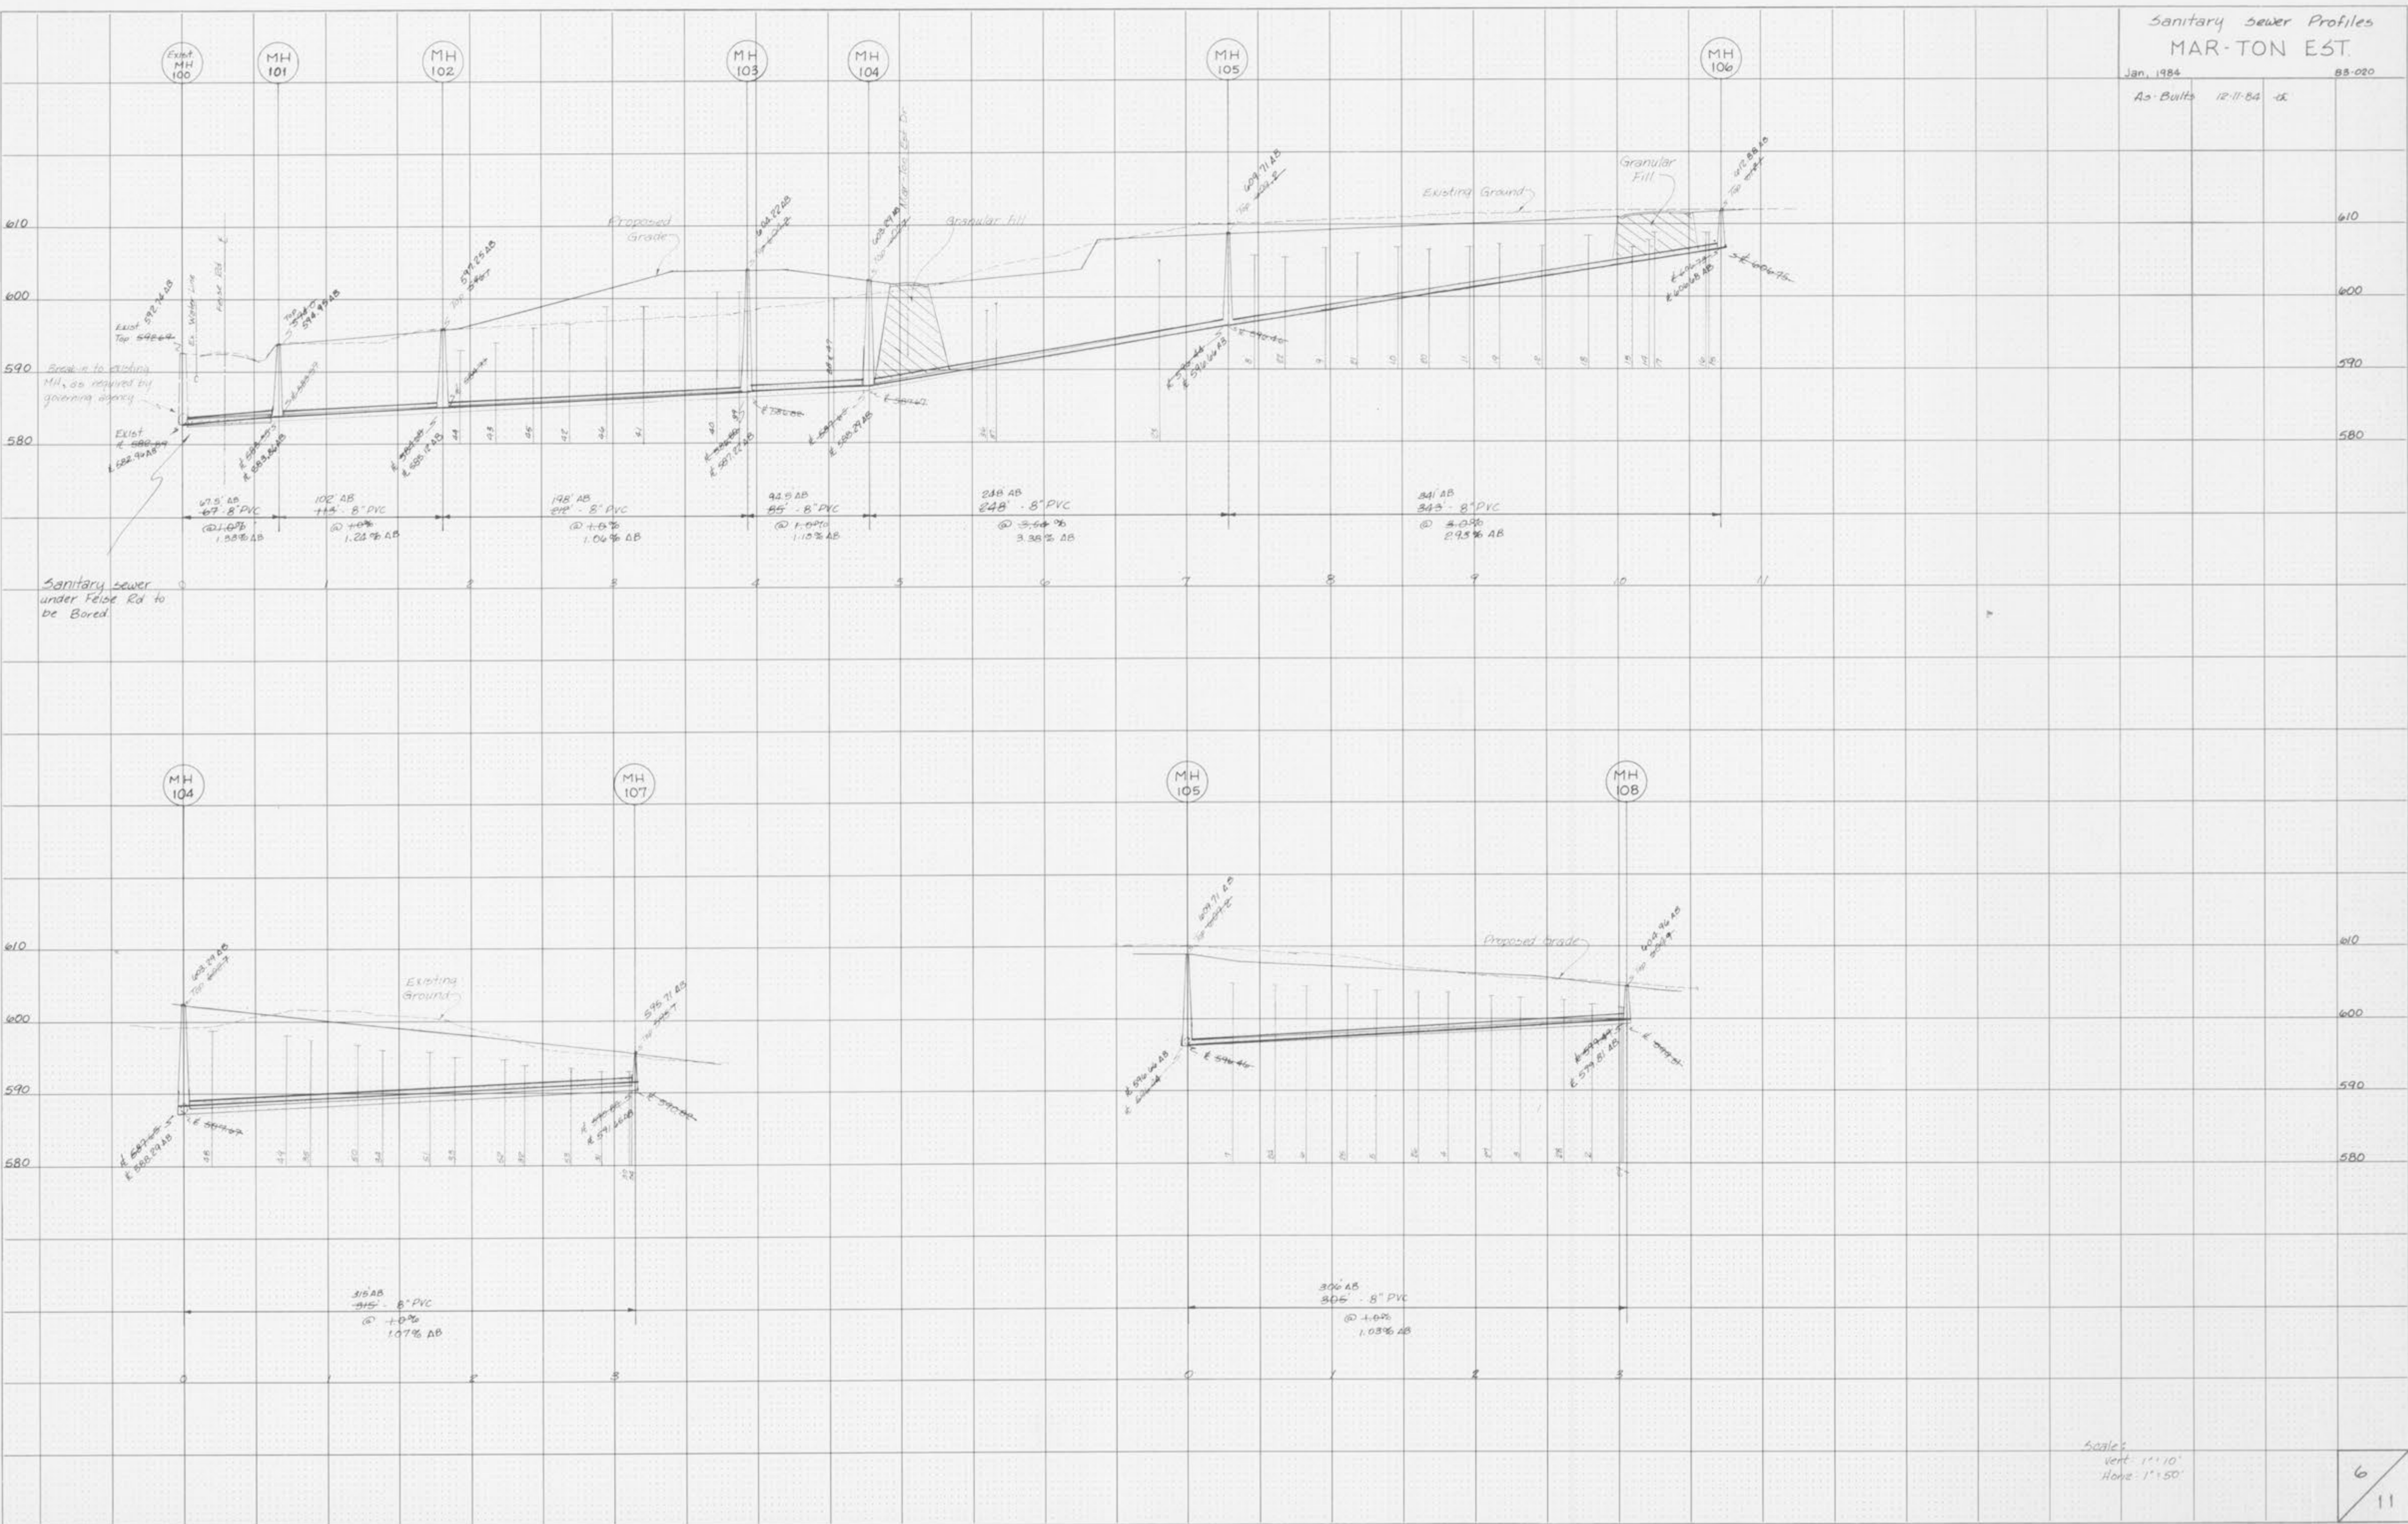

Scale:
vert. 1" = 10'
HORIZ. 1" = 50'