

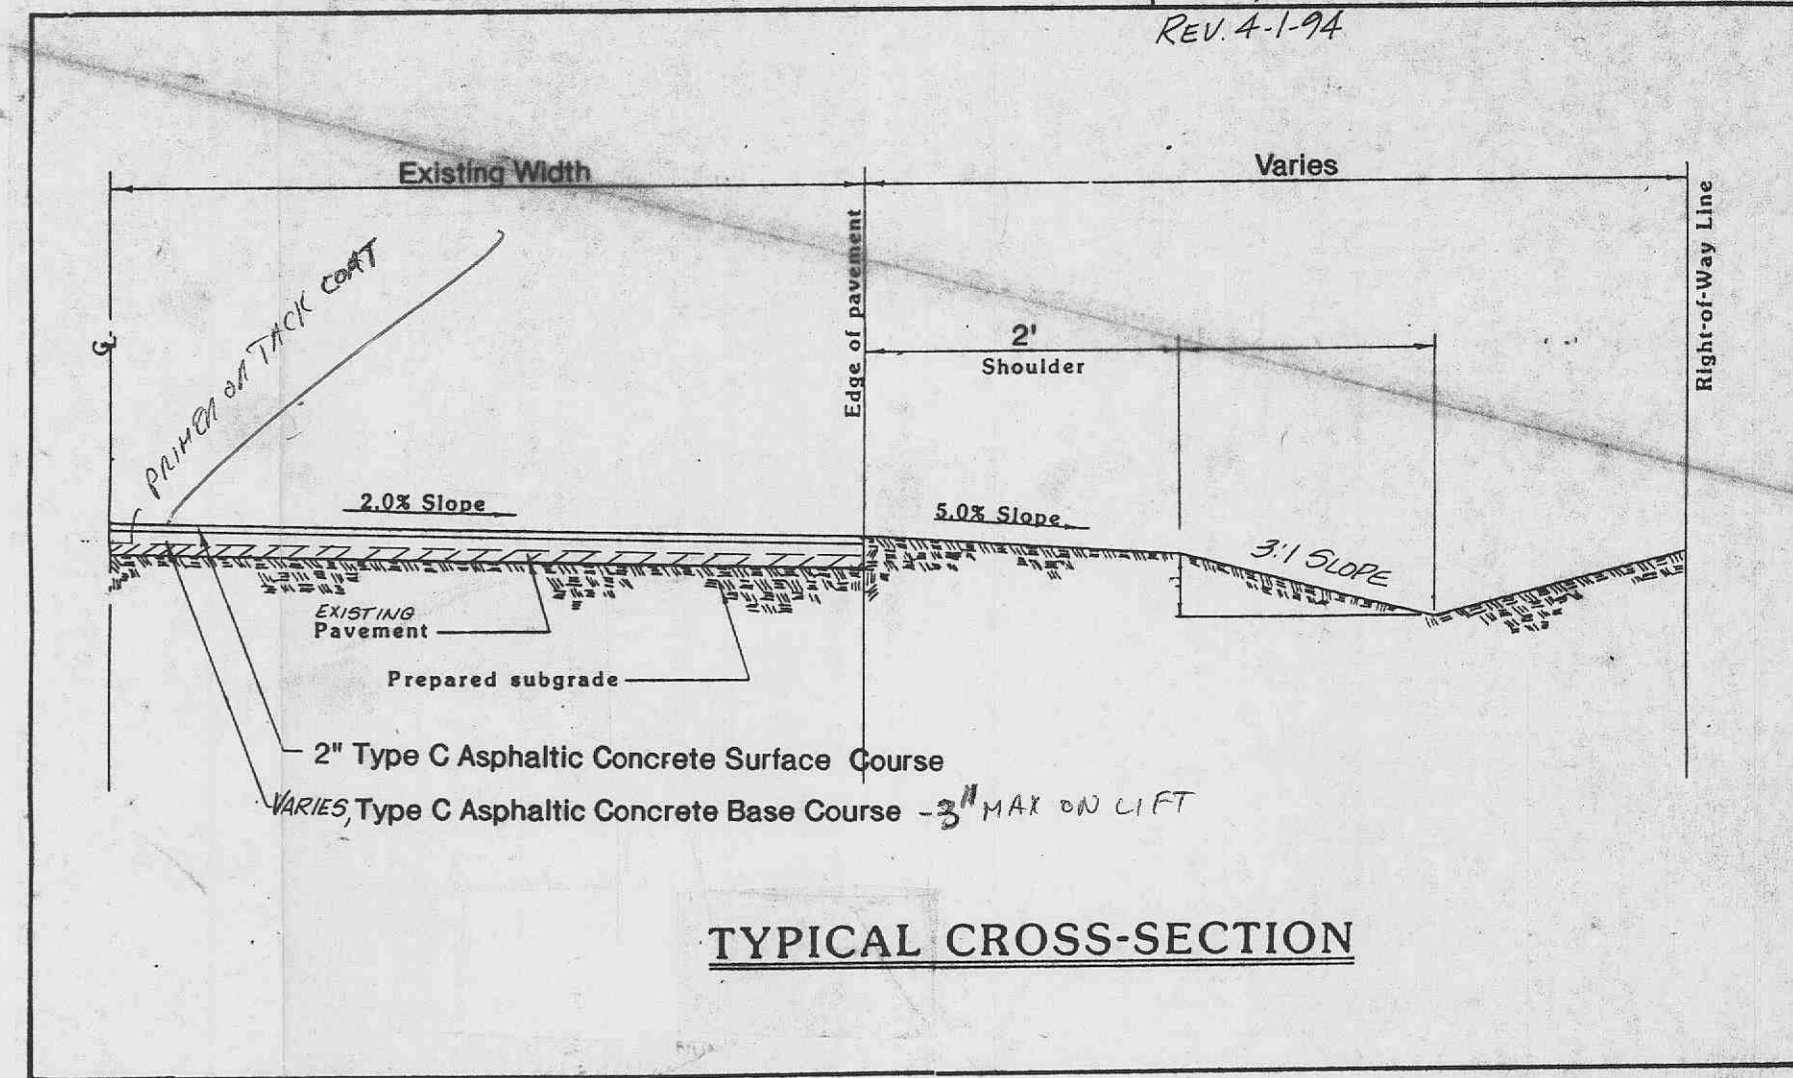


DATE _____ BY _____
 SURVEYED _____
 ALIGNMENT CHECKED _____
 RT OF WAY CHECKED _____
 PLAN NO. _____


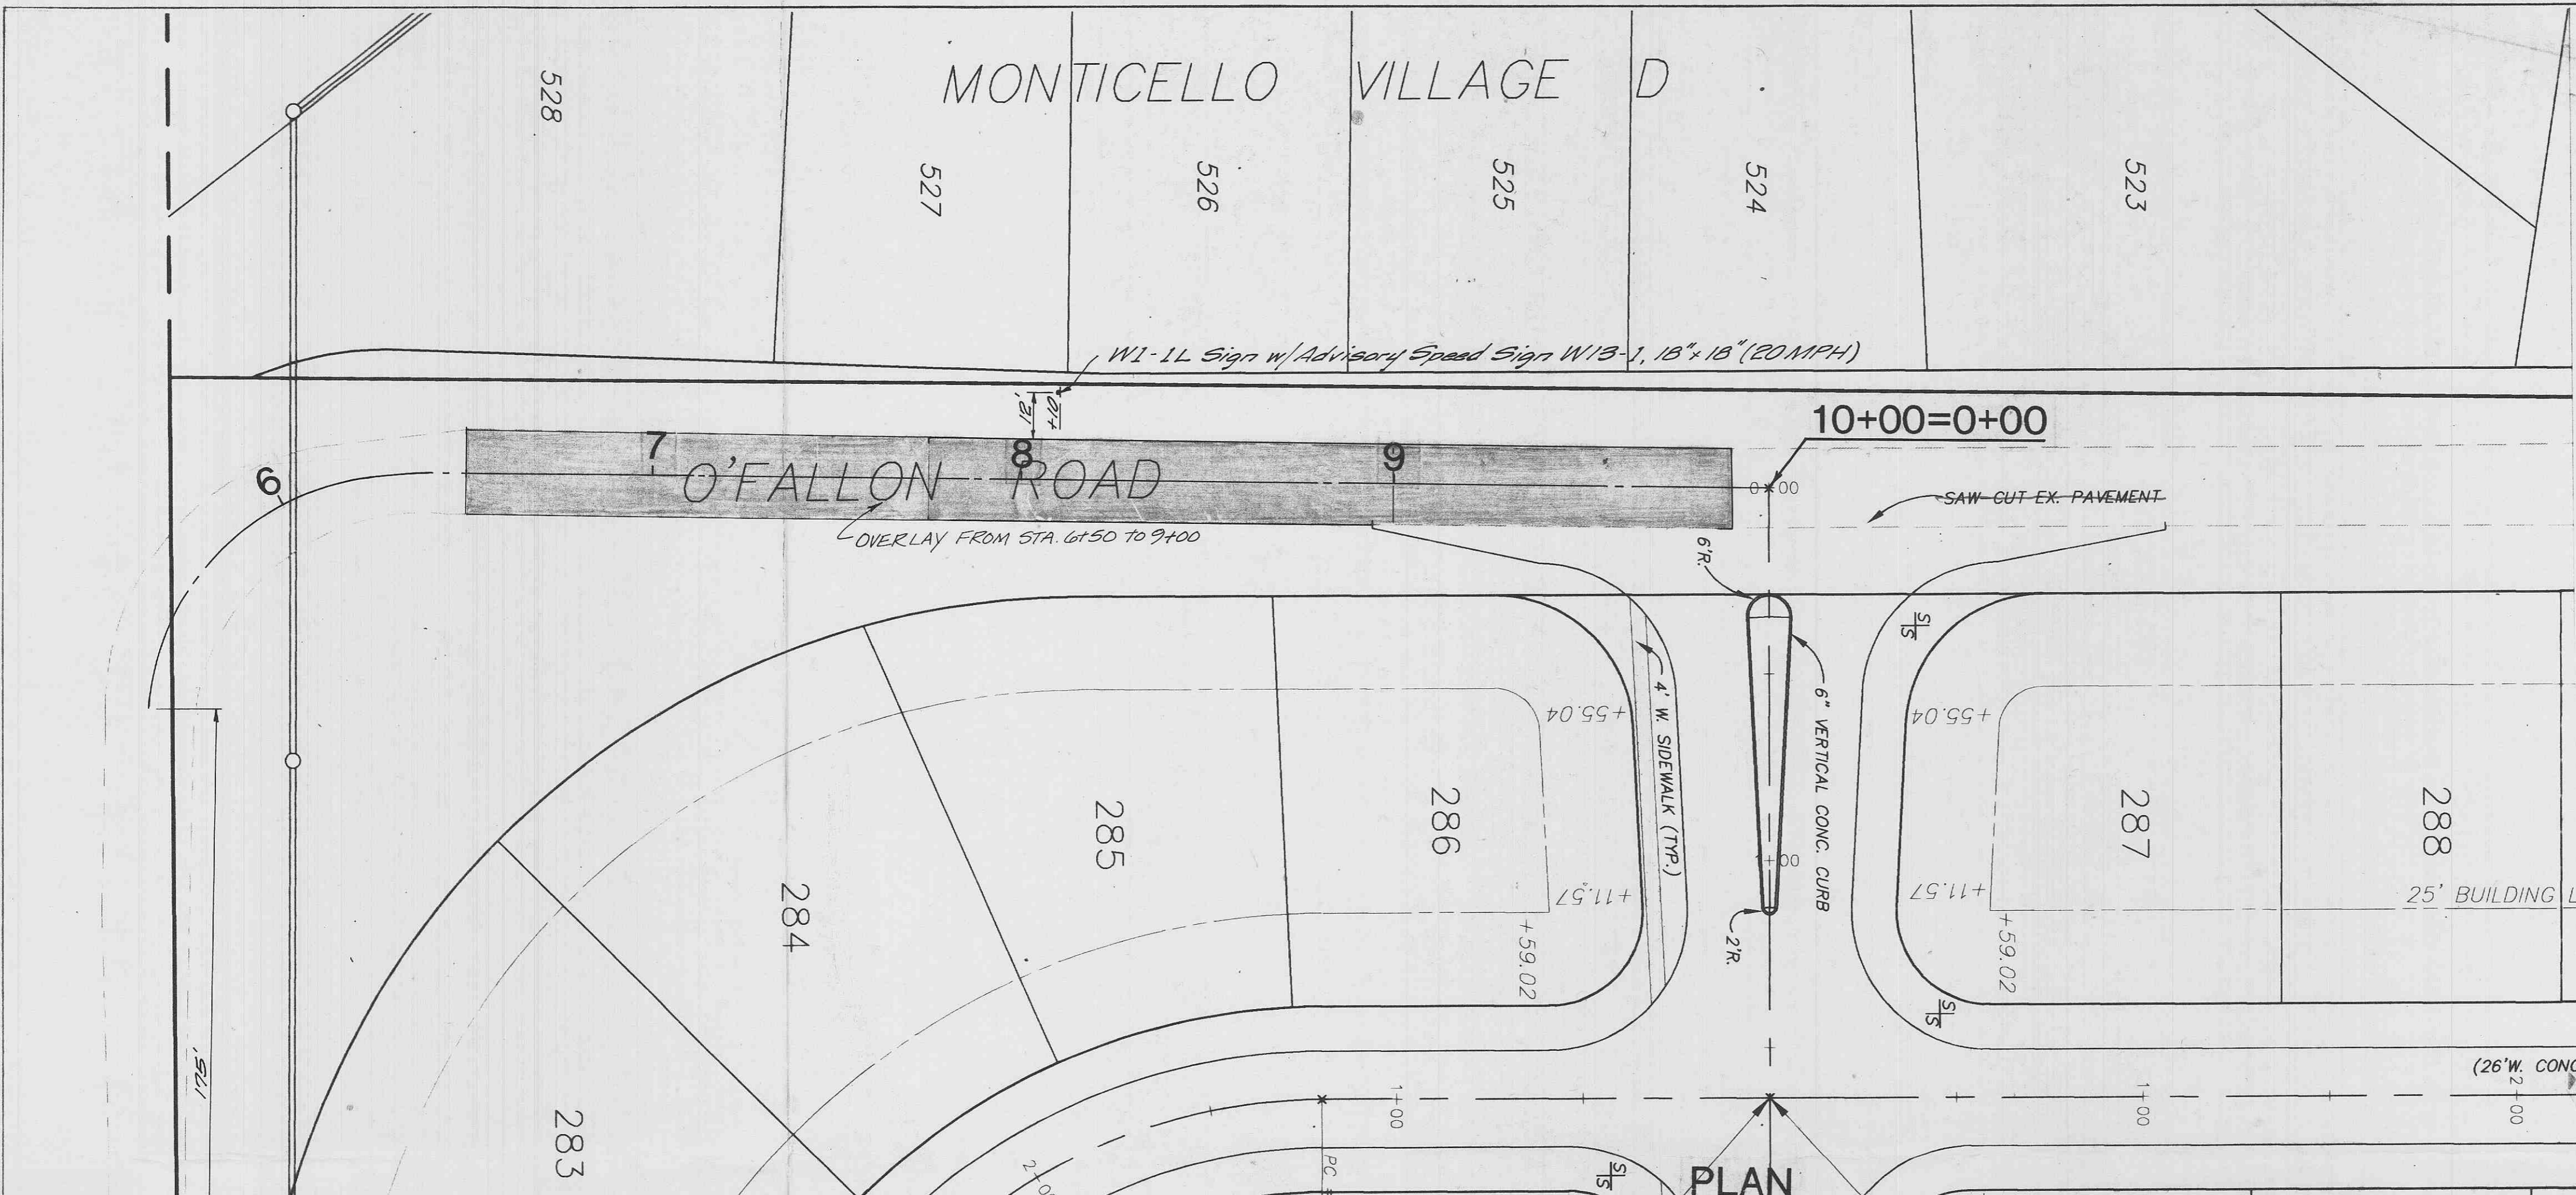


Maintain Thru Traffic at All Times.
 Roadway may be reduced to one lane during daylight hours if proper warning devices and flaggers are used.

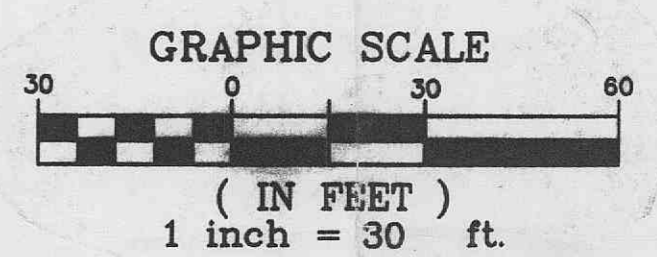

FILE COPY APPROVED AS NOTED
 4-9-94
 Frank Adewunmi

DATE _____ BY _____
 SURVEYED _____
 GRADES CHECKED _____
 STRUCTURE NOTATIONS CHKD _____
 PROFILE NO. _____

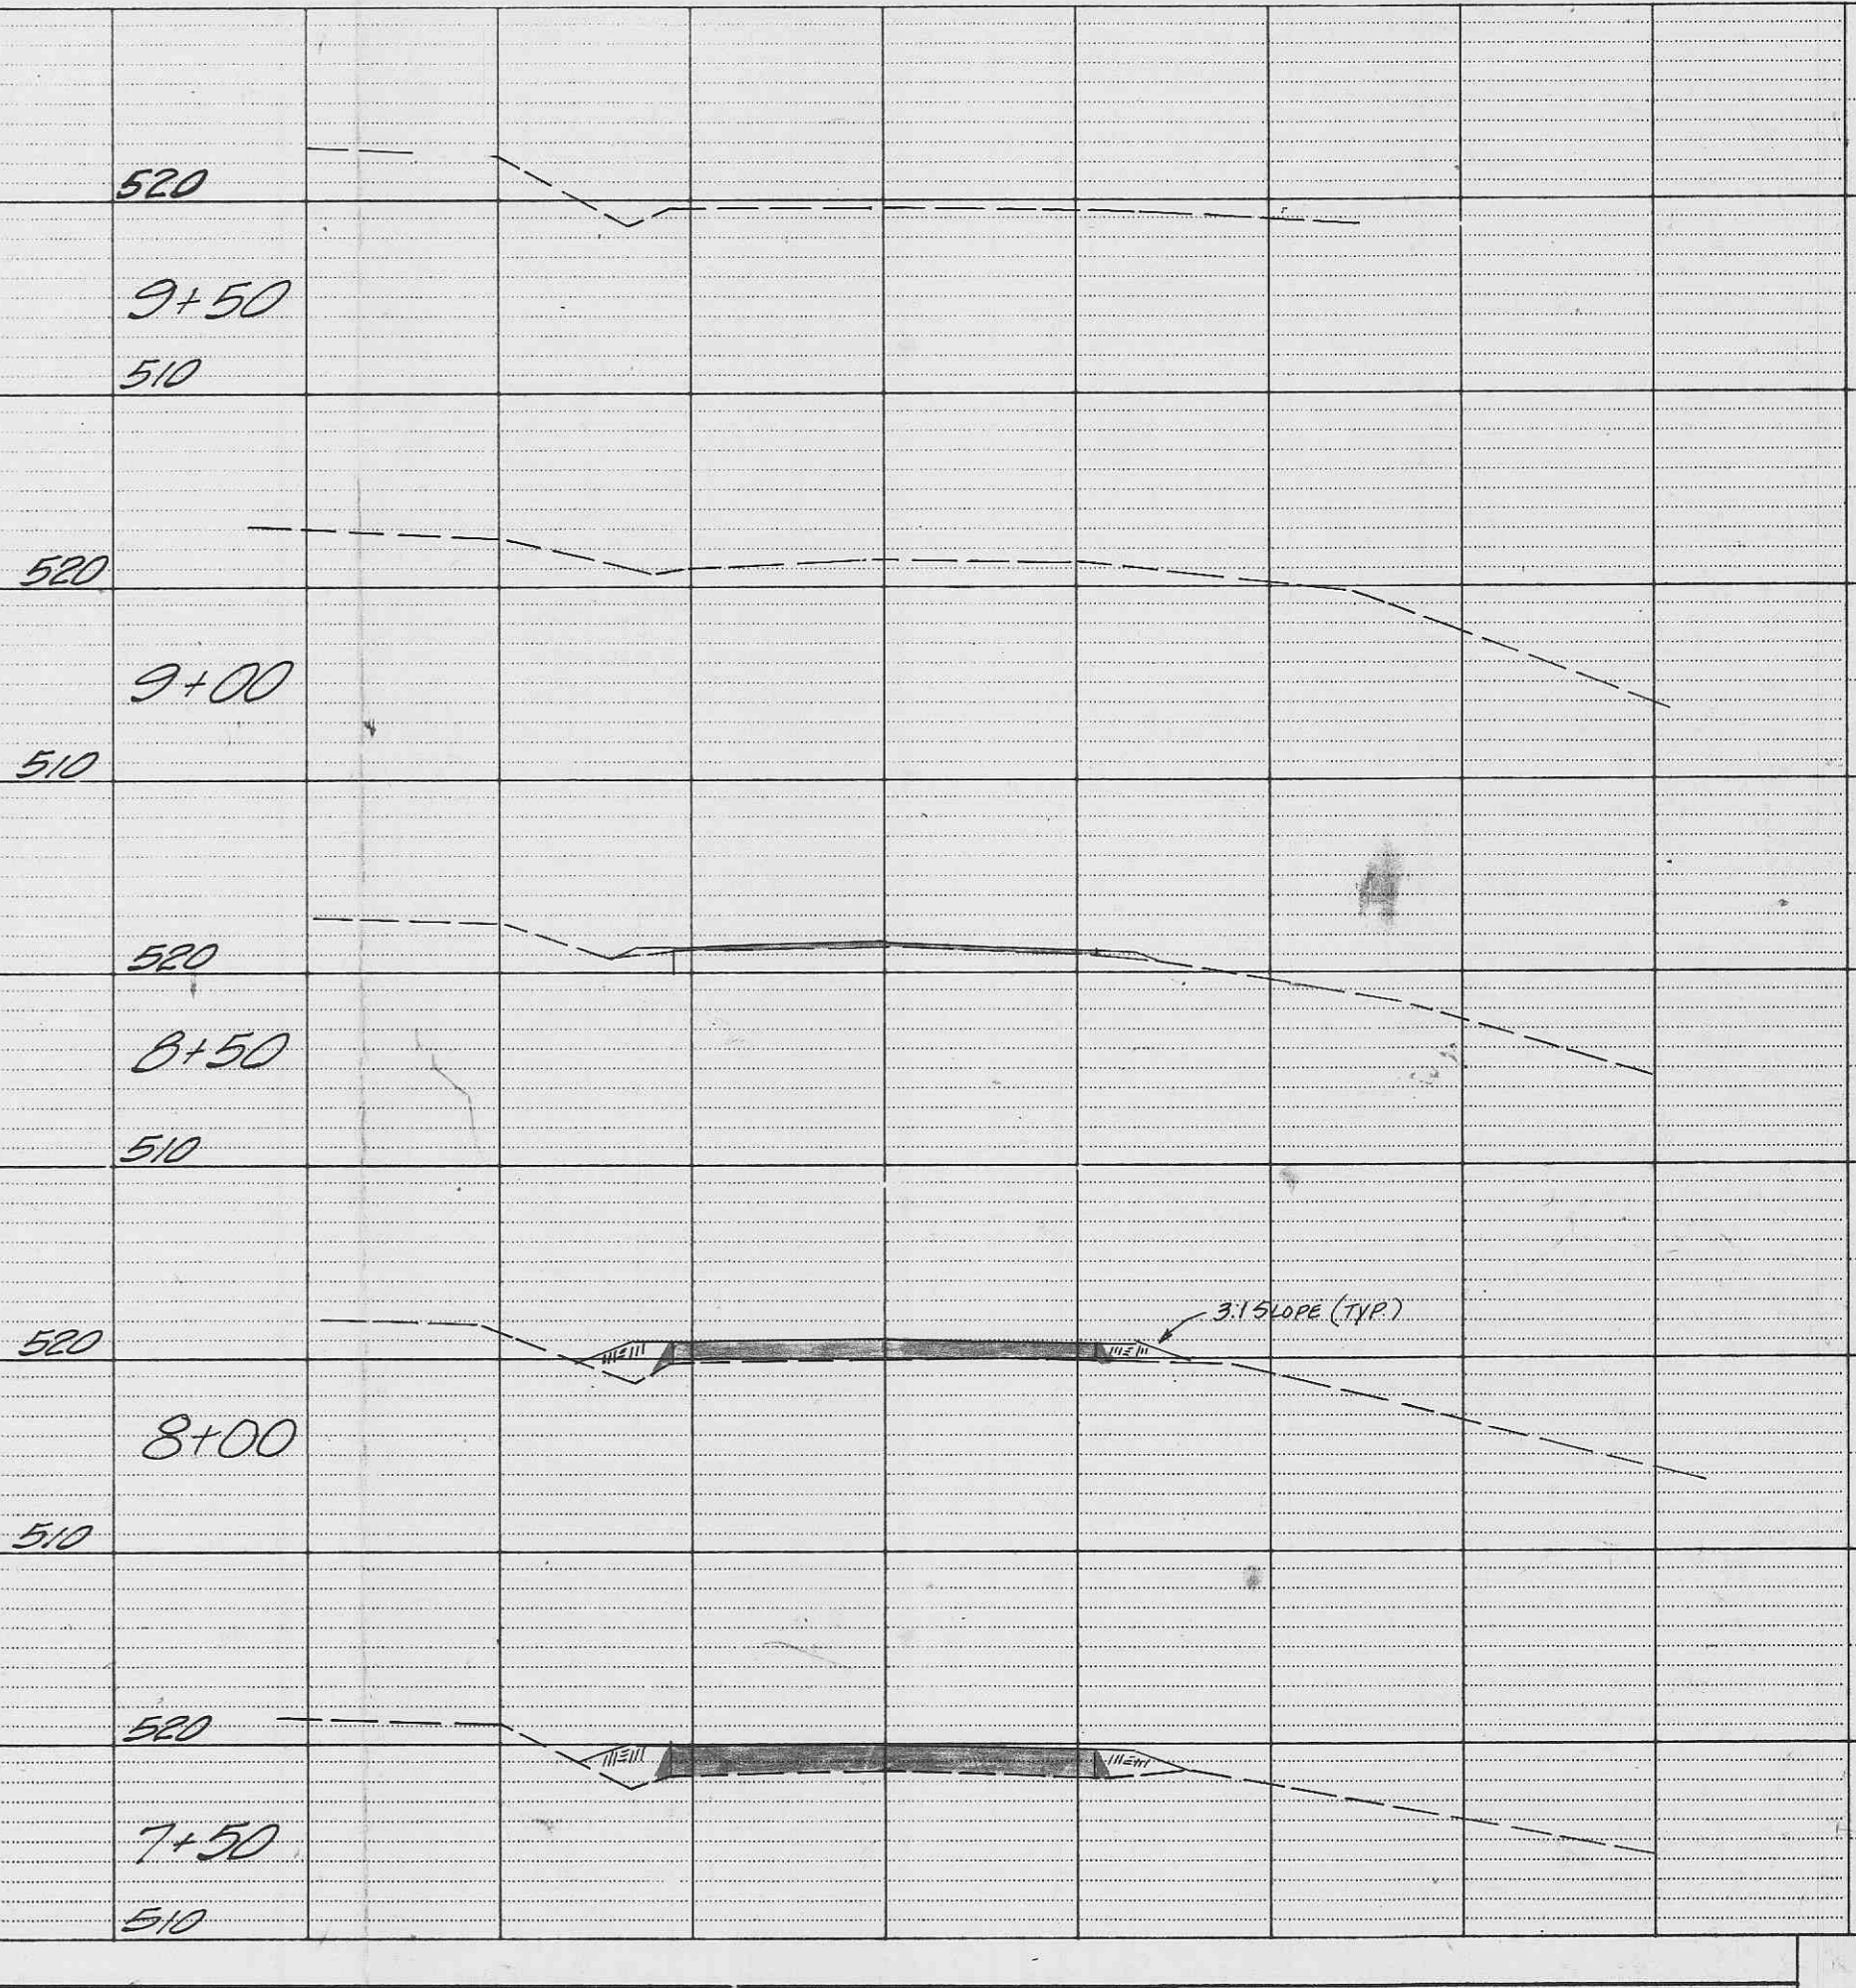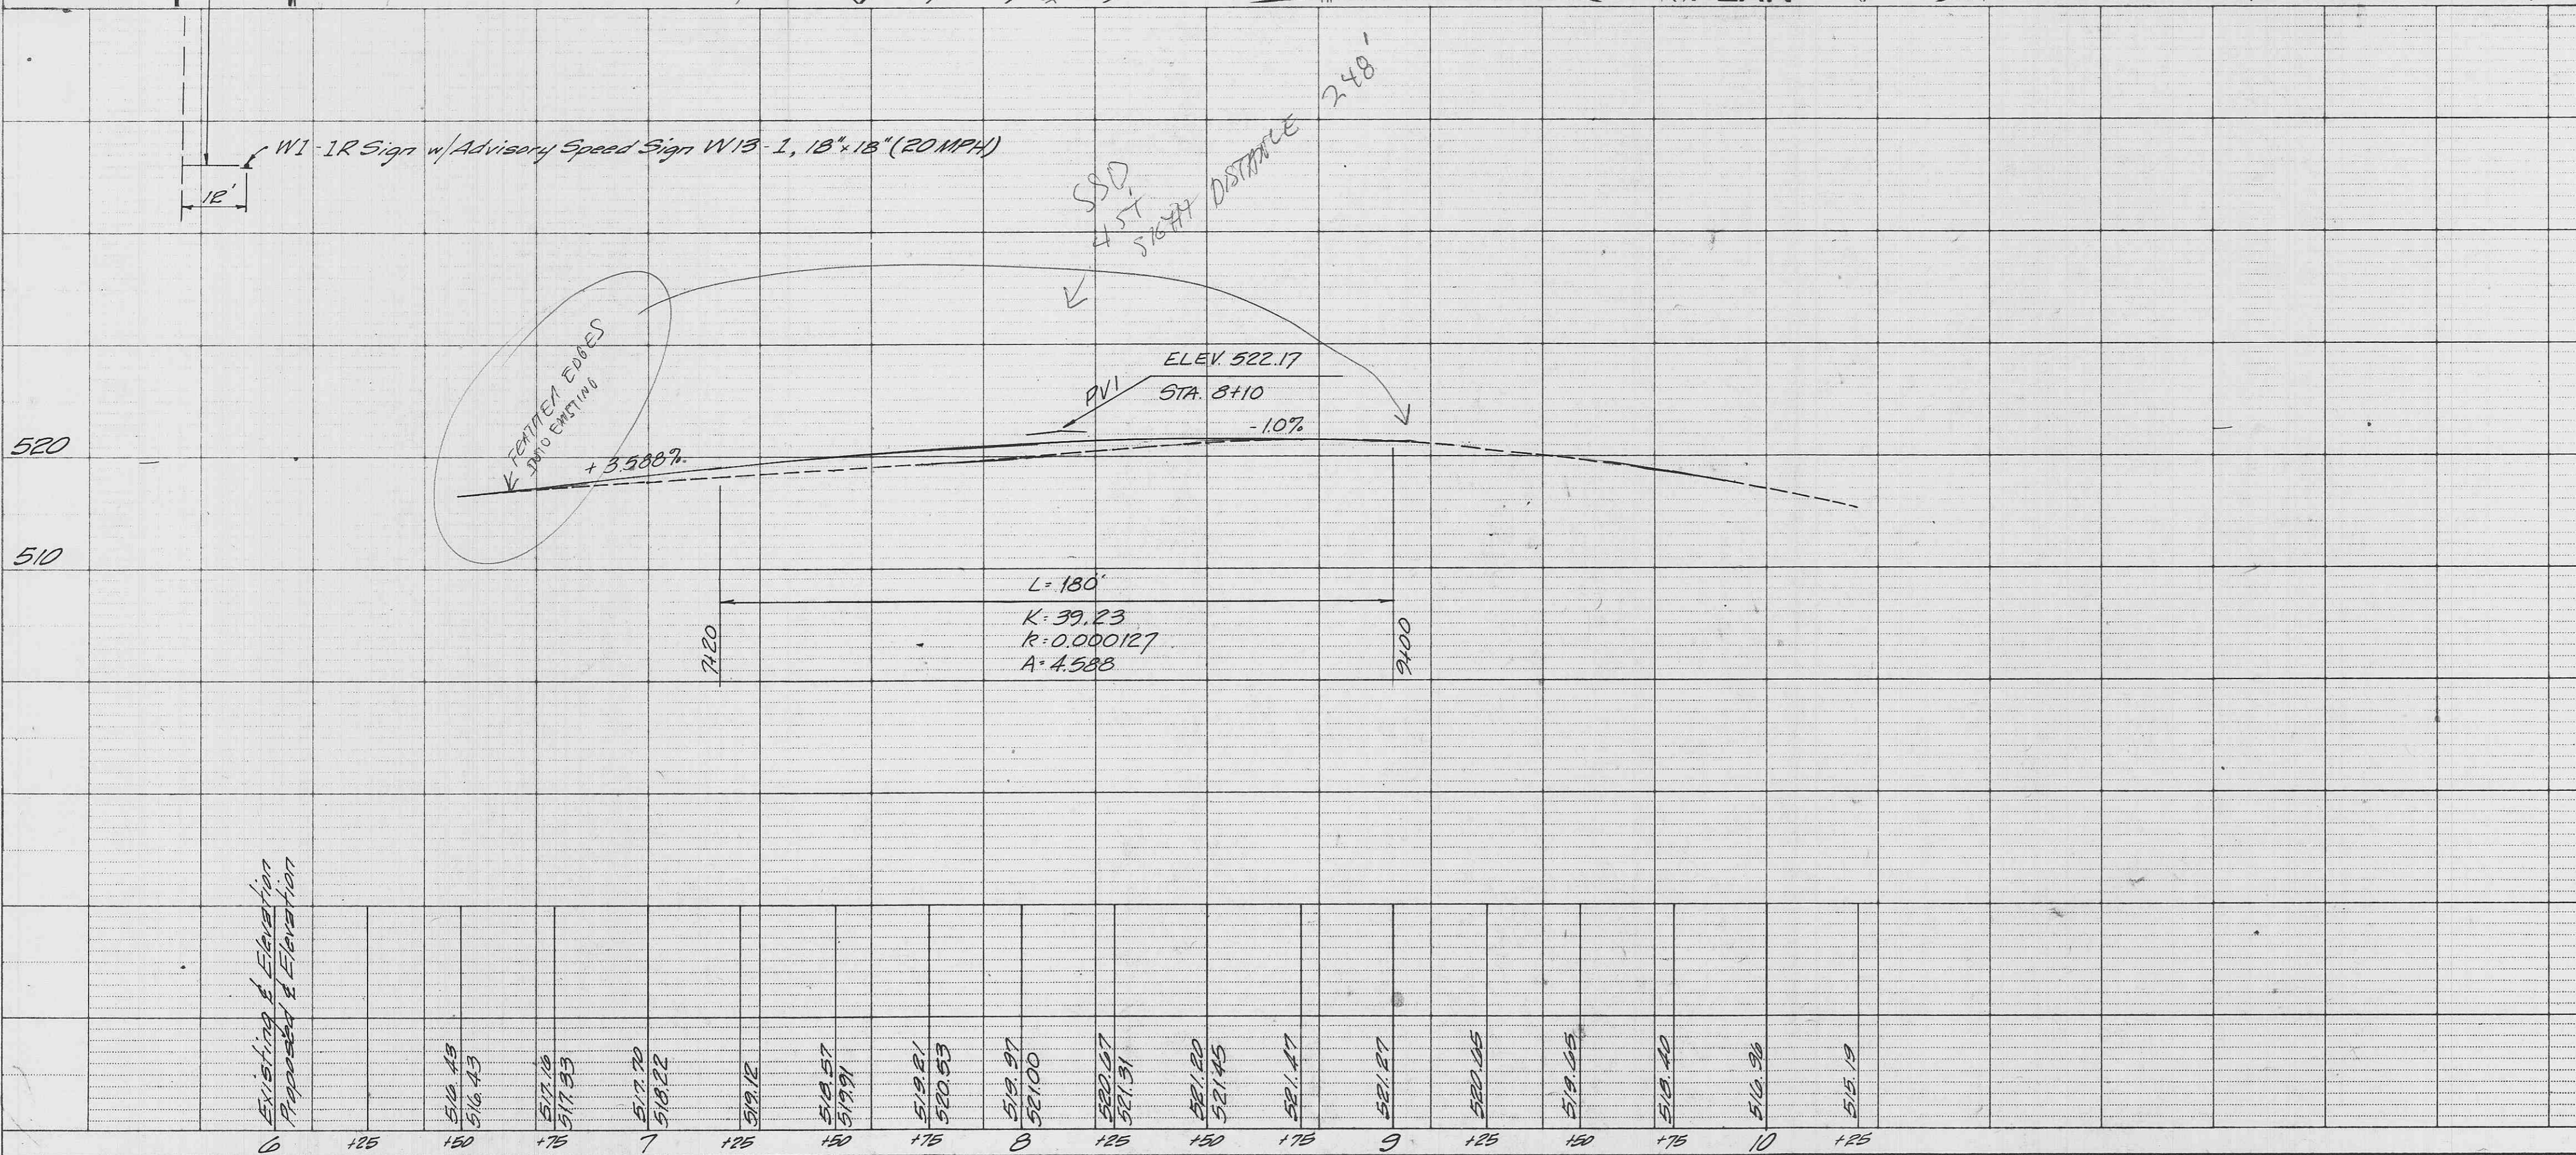

PROFILE

HIGHWAY FEDERAL AID SHEET
 PLATE 1-SINGLE PLAN AND PROFILE LINE AND DOT
 TELETYPE
 PRINTED IN U.S.A.

CROSS SECTIONS
 Horiz. 1"=10'
 Vert. 1"=10'