


**GENERAL NOTES:**  
 1. THESE PLANS ARE BASED ON THE ALTA/NSPS LAND TITLE SURVEY (SURVEY PROJECT #1807-109 DATED 01/08/19) PREPARED BY: MARLER SURVEYING COMPANY, INC. 11402 GRAVOIS ROAD, SUITE 200, ST. LOUIS, MO. 63126 (314) 729-1001  
 2. PRIOR TO CONSTRUCTION, CONTRACTOR TO CONTACT THE DESIGN ENGINEER AND ARCHITECT TO VERIFY THAT THEY ARE WORKING FROM THE MOST CURRENT SET OF PLANS AND SPECIFICATIONS.

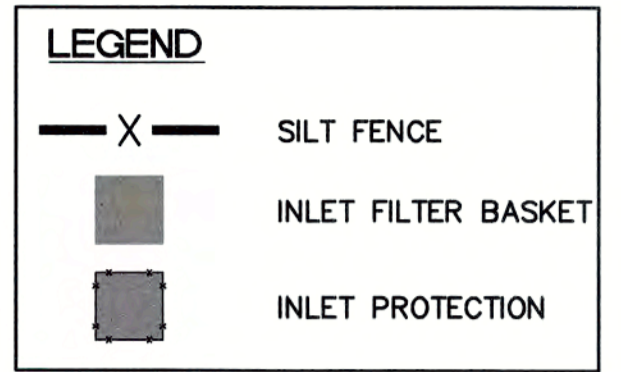

NO.	REVISIONS	DATE
1	BID SET	5/23/19
2	BID SET	6/10/19
3	PERMIT SET	6/13/19
4	NO REVISIONS	7/19/19
5	NO REVISIONS	11/22/19

Prepared For:

**DXU ARCHITECTS**  
 412 South Wells, 2nd Floor  
 Chicago, IL 60607

**OBERWEIS RESTAURANT**  
 1816 Highway K  
 O'Fallon, St. Charles County, Missouri, 63366

Prepared By:

2651 Ginger Woods Parkway, Suite 100, Aurora, IL 60502  
 phone 630-375-1800 fax 630-236-9800 www.watermark-engineering.com

WATERMARK ENGINEERING RESOURCES, LTD.  
 MISSOURI STATE CERTIFICATE OF AUTHORITY #201601512


DATE:

EXP:  
 JEFFREY C. MILLER - ENGINEER  
 MO# 2016015595

CHECKED BY: J.MILLER	DESIGN BY: M.HANSEN	DRAWN BY: K.P., M.H.	DATE: MAY 23, 2019	SCALE: 1" = 20'	PROJECT NO.: 18-085
----------------------	---------------------	----------------------	--------------------	-----------------	---------------------

SEE EROSION CONTROL NOTES AND DETAILS ON SHEET C-9

NO RECORD INFORMATION

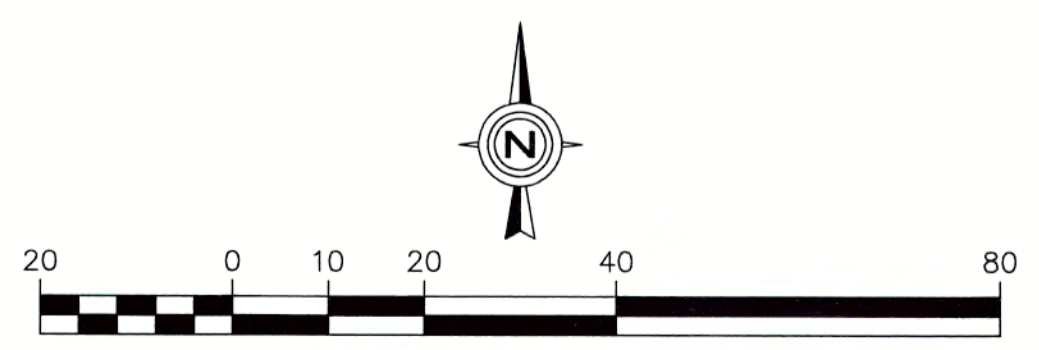

**PHASE I SOIL EROSION CONTROL PLAN**