



G1 ACCESSIBLE AIR ALCOVE PLAN

1/2" = 1'-0"
A1/AS101

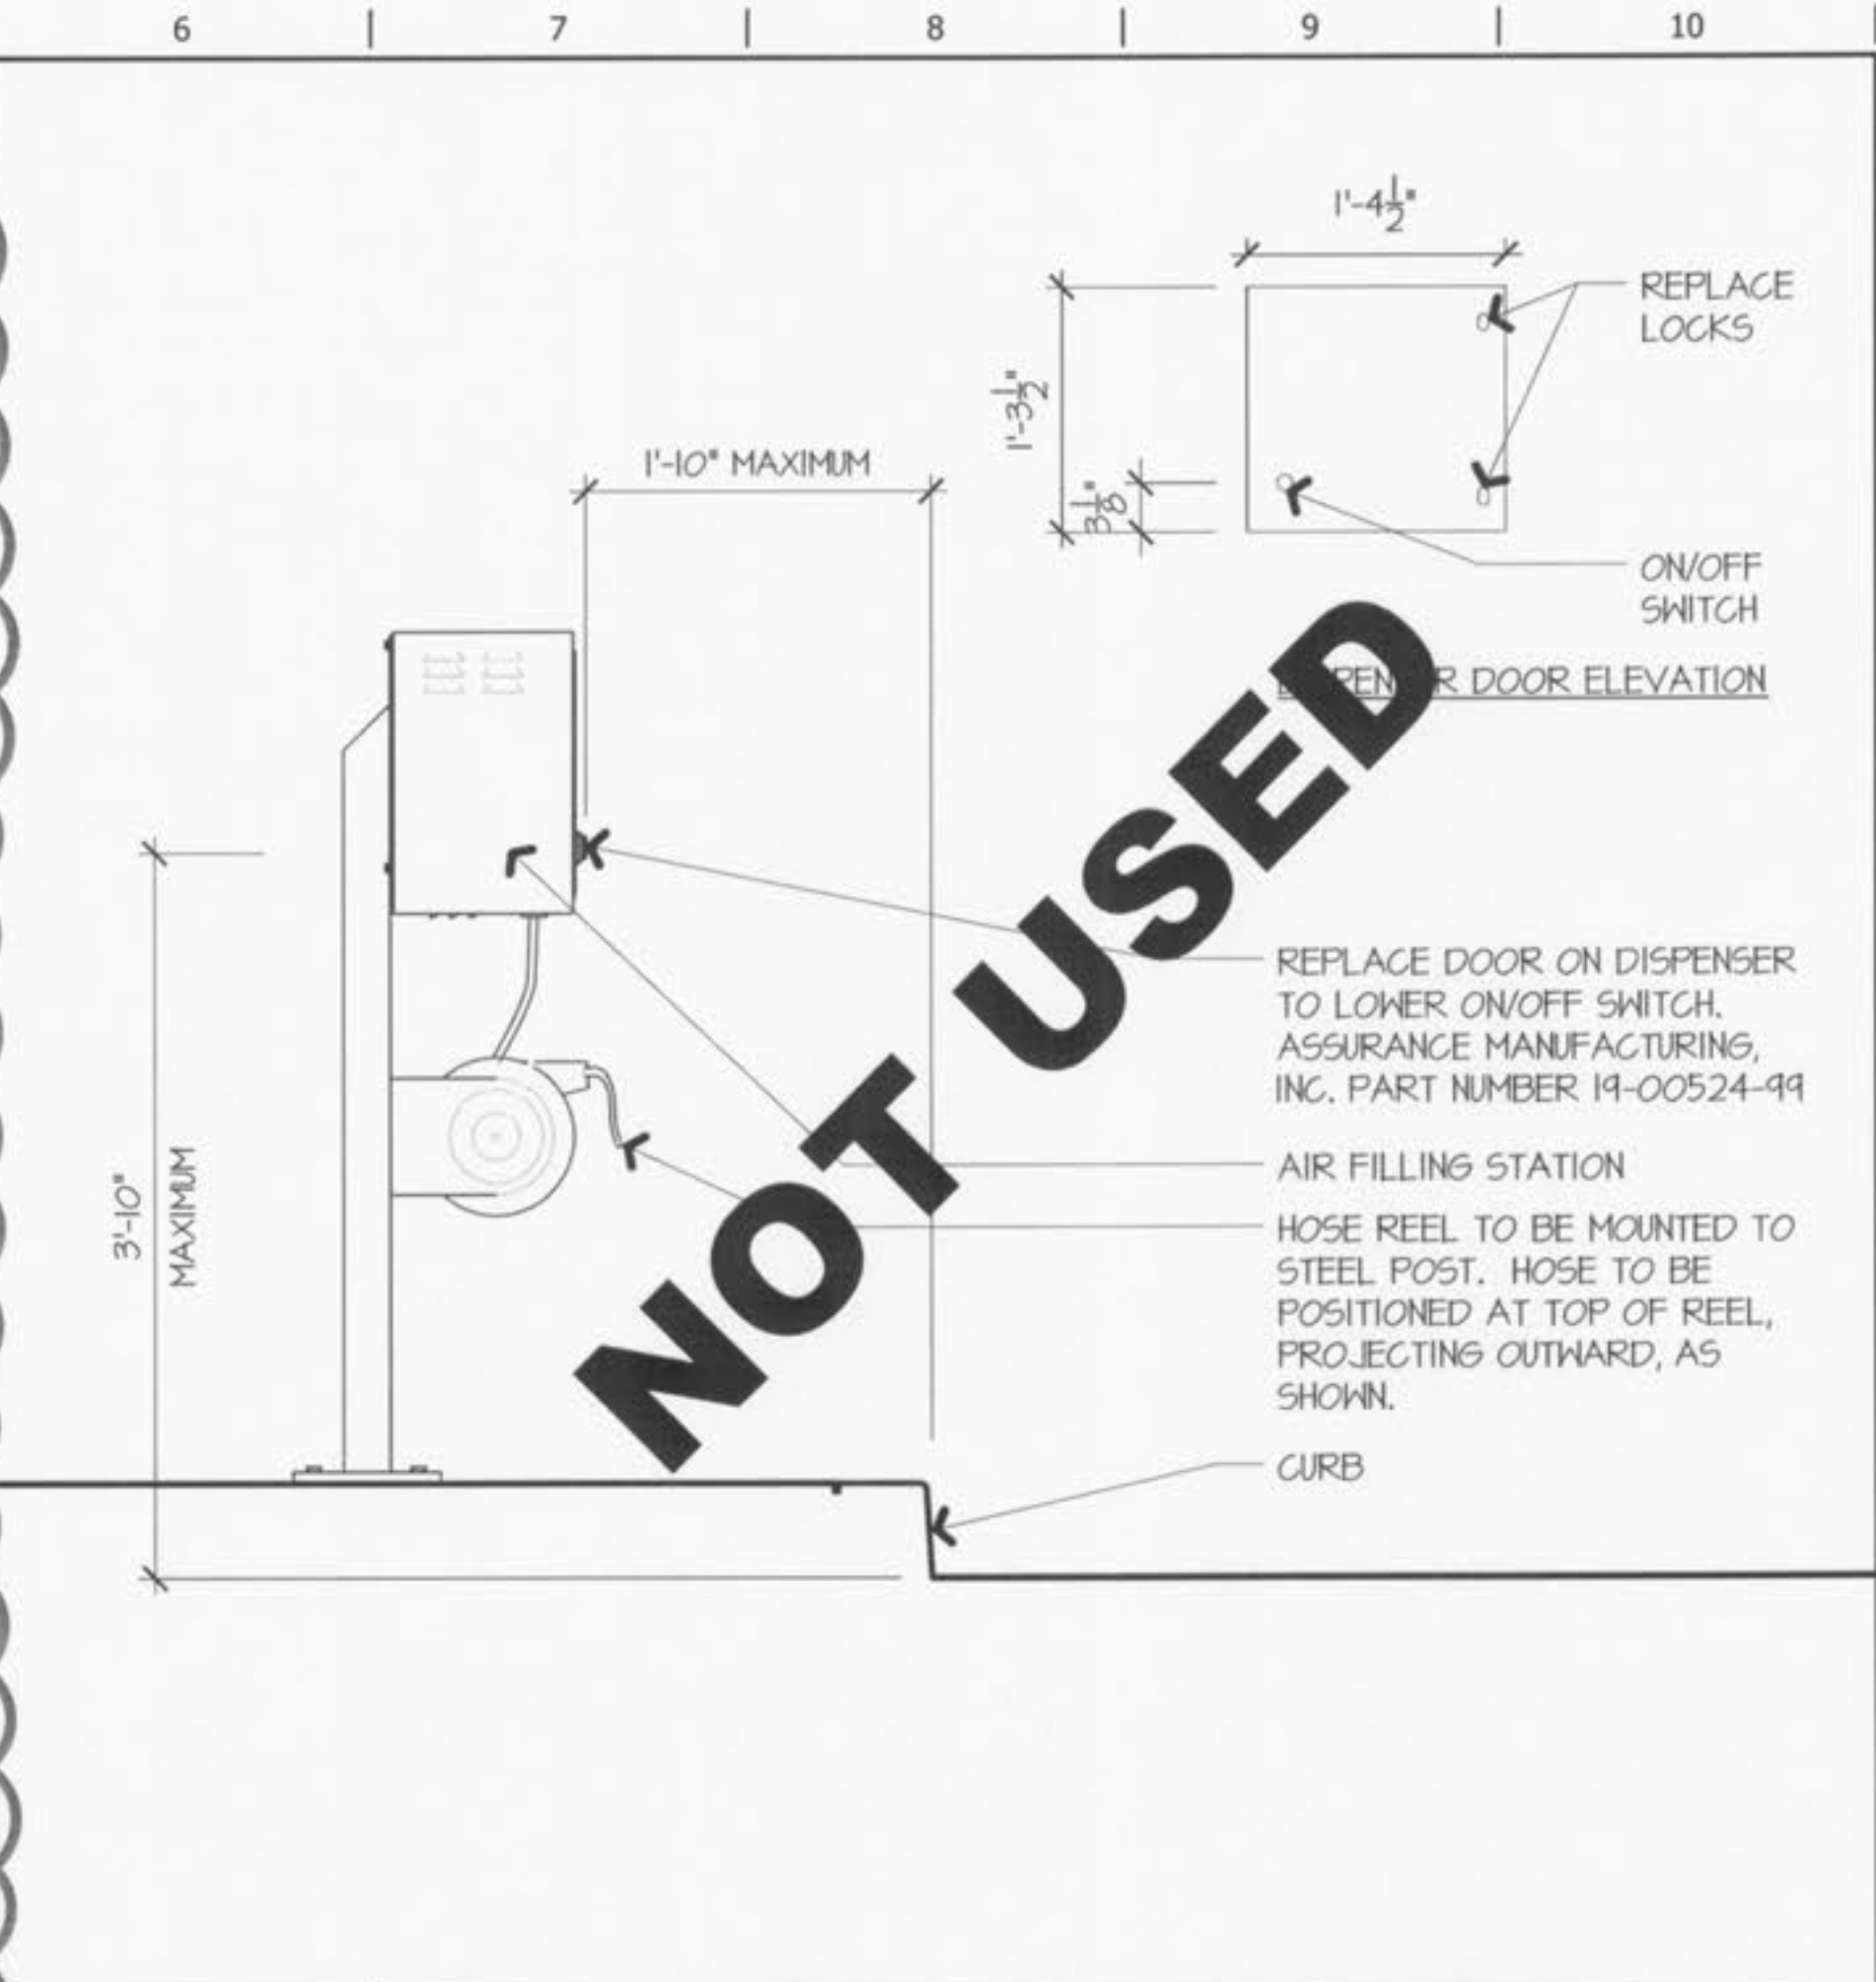


G6 CURB MOUNTED AIR DISPENSER DETAIL

1" = 1'-0"

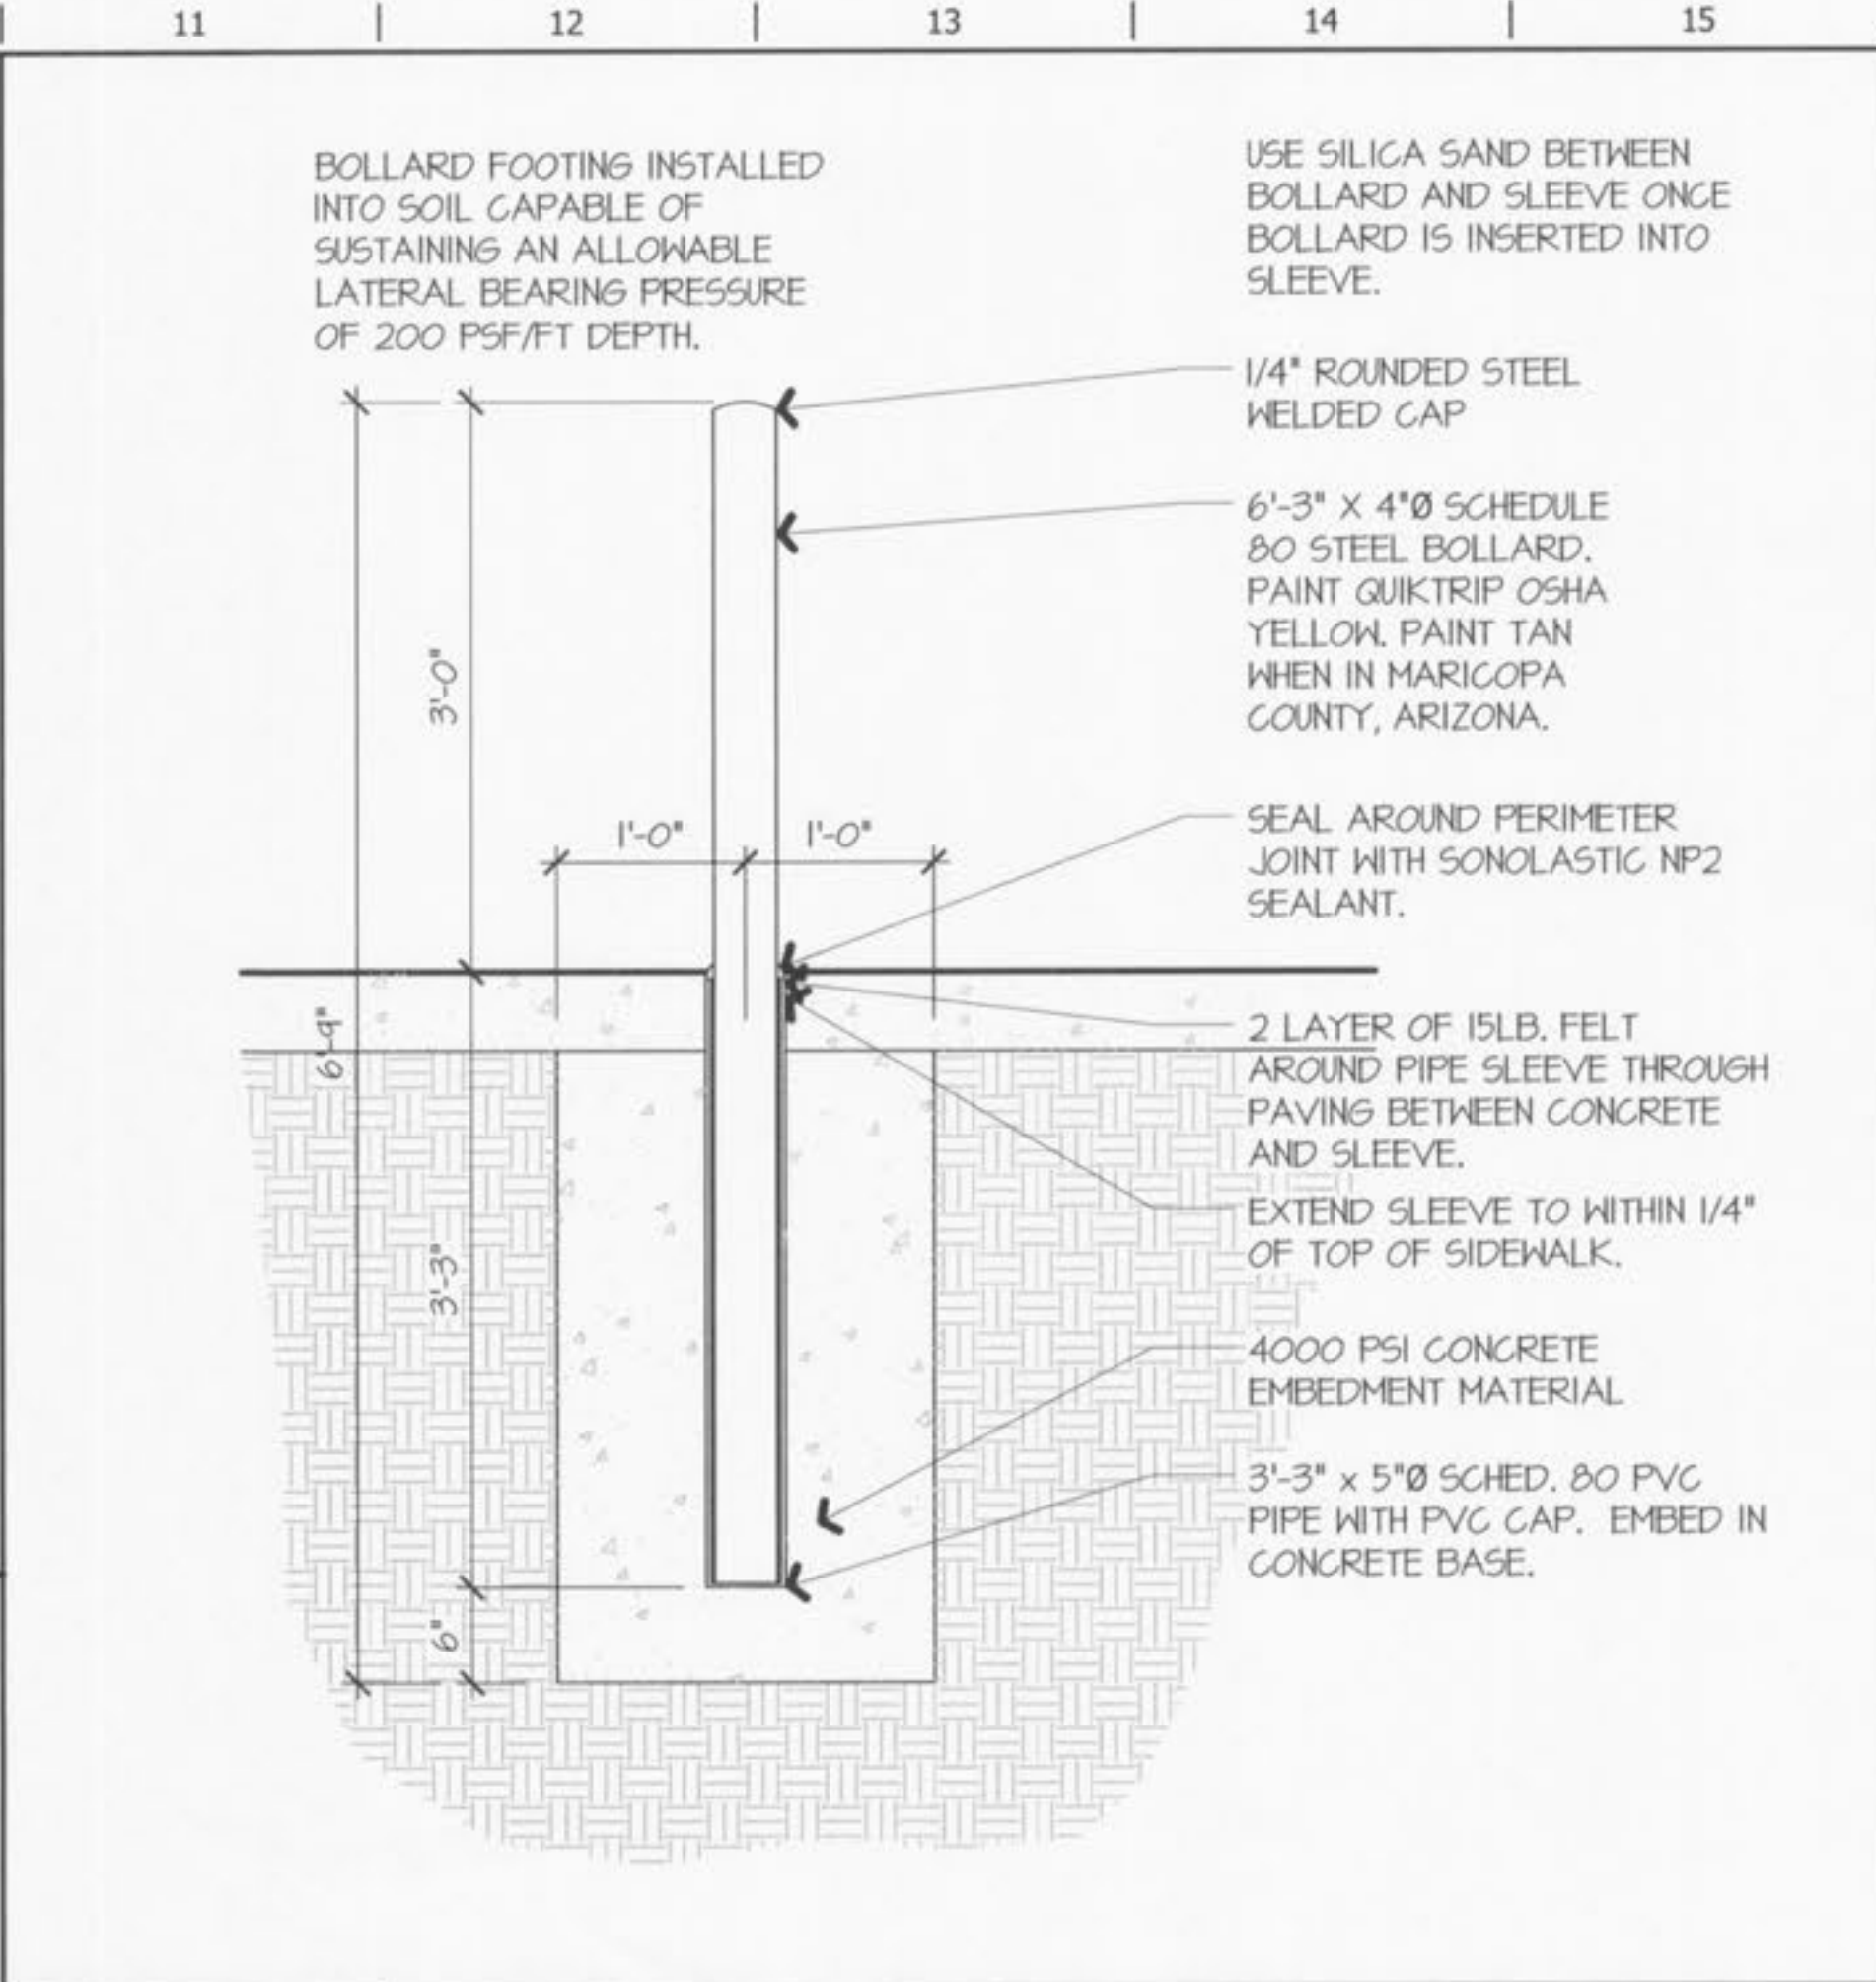


G11 AIR DISPENSER BOLLARD DETAIL

1" = 1'-0"
G1/AS130

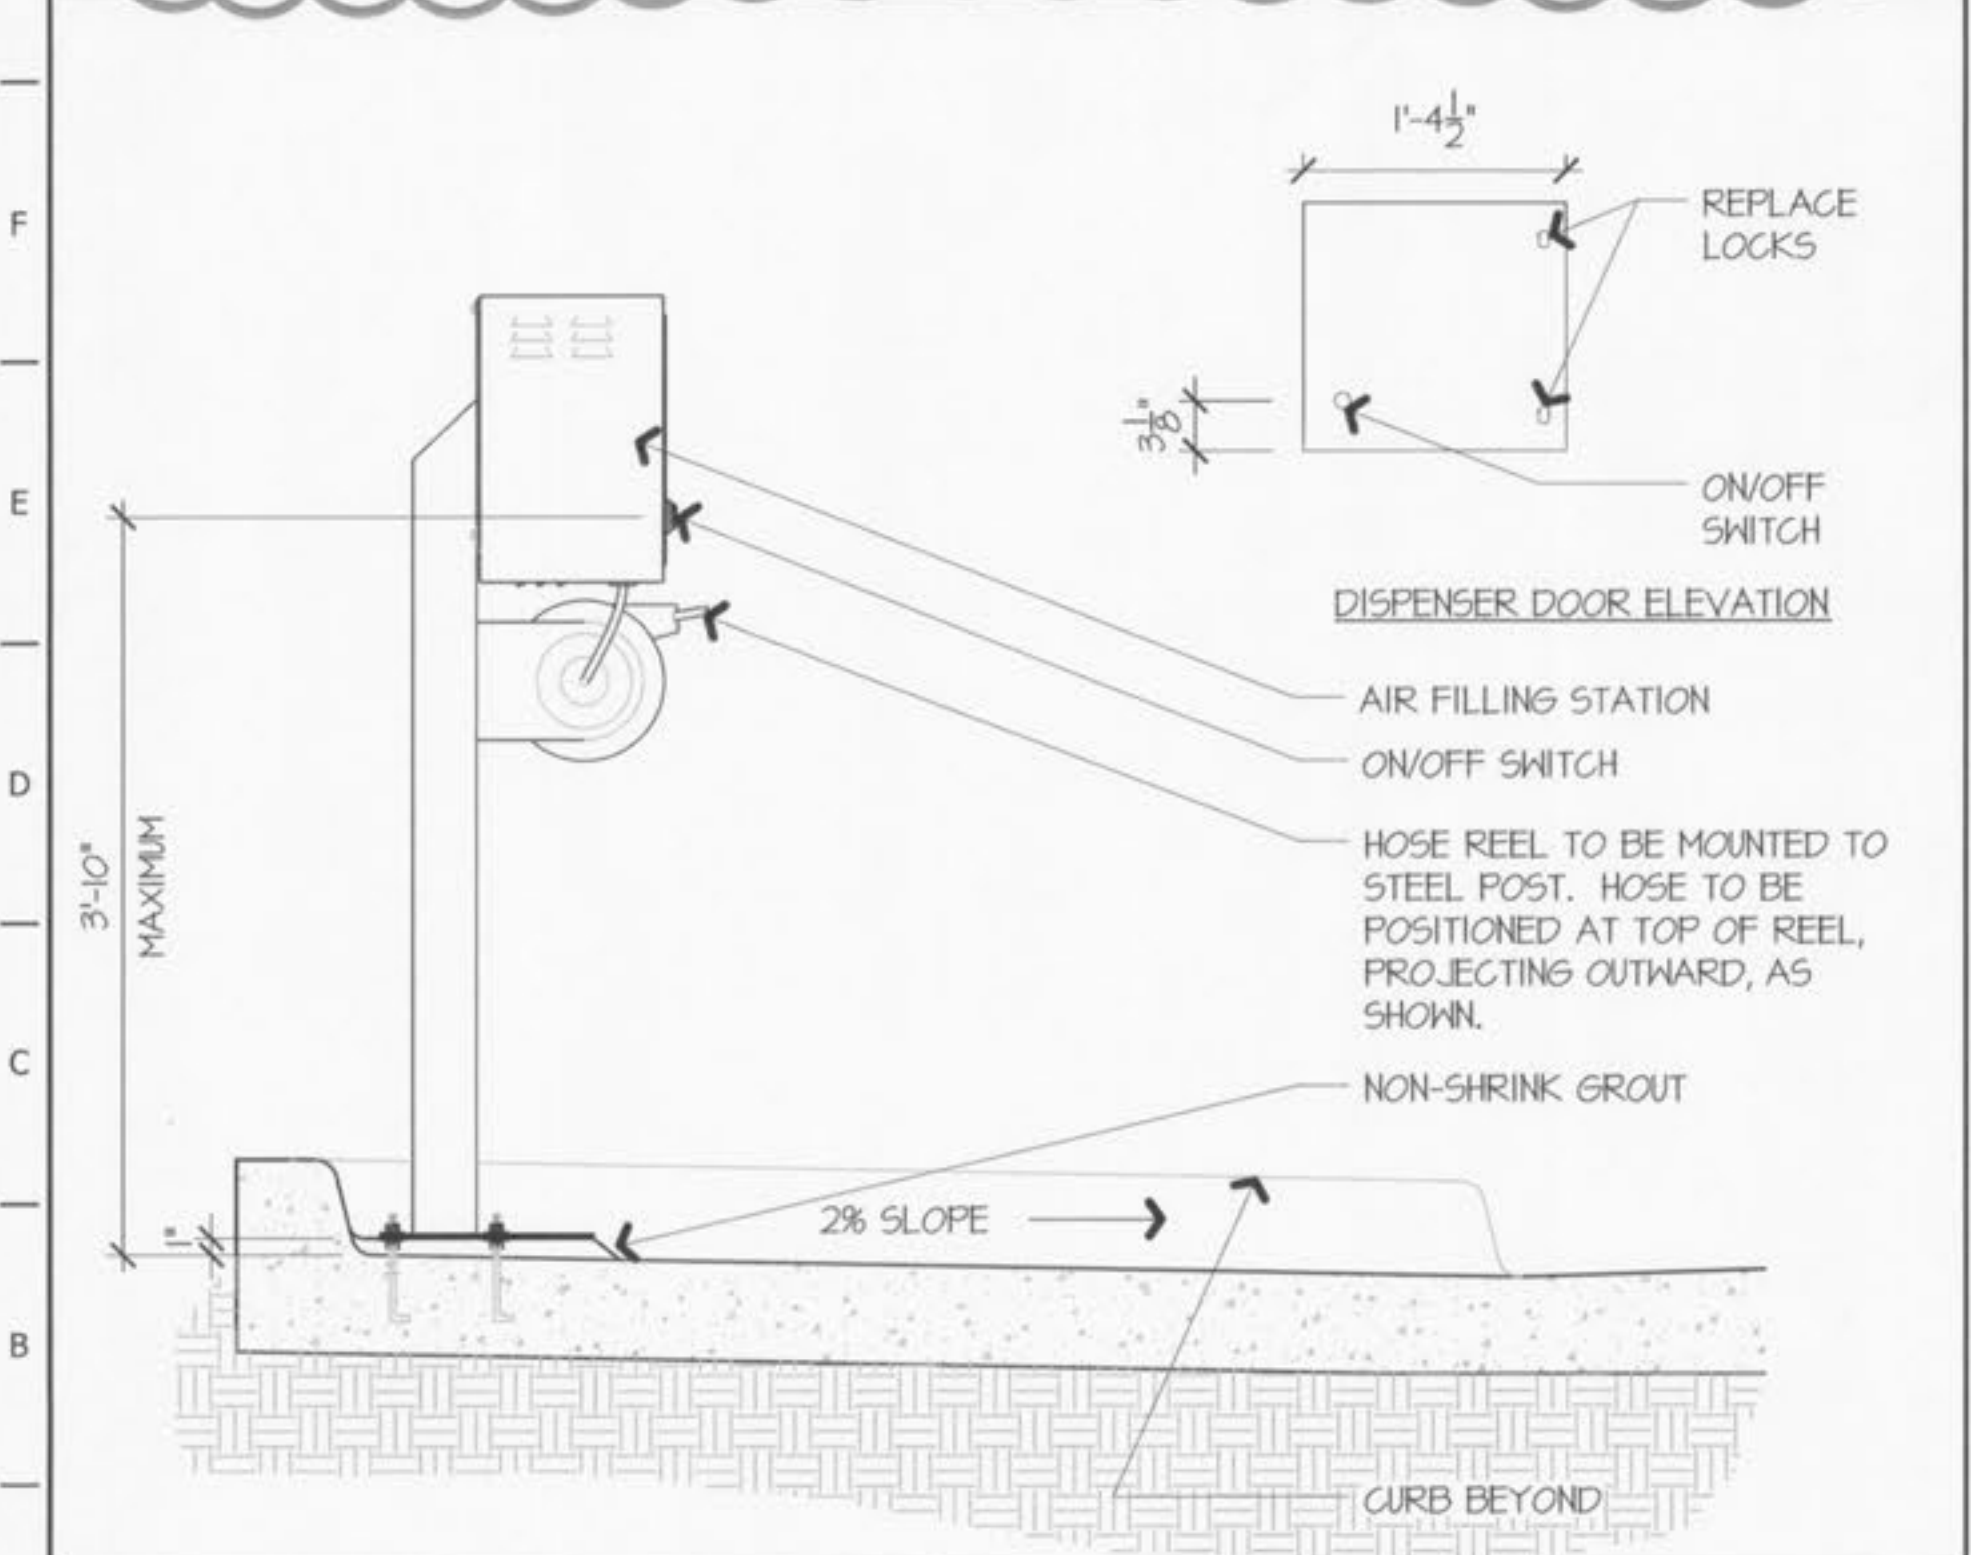

A1 ALCOVE AIR DISPENSER DETAIL

1" = 1'-0"
G1/AS130

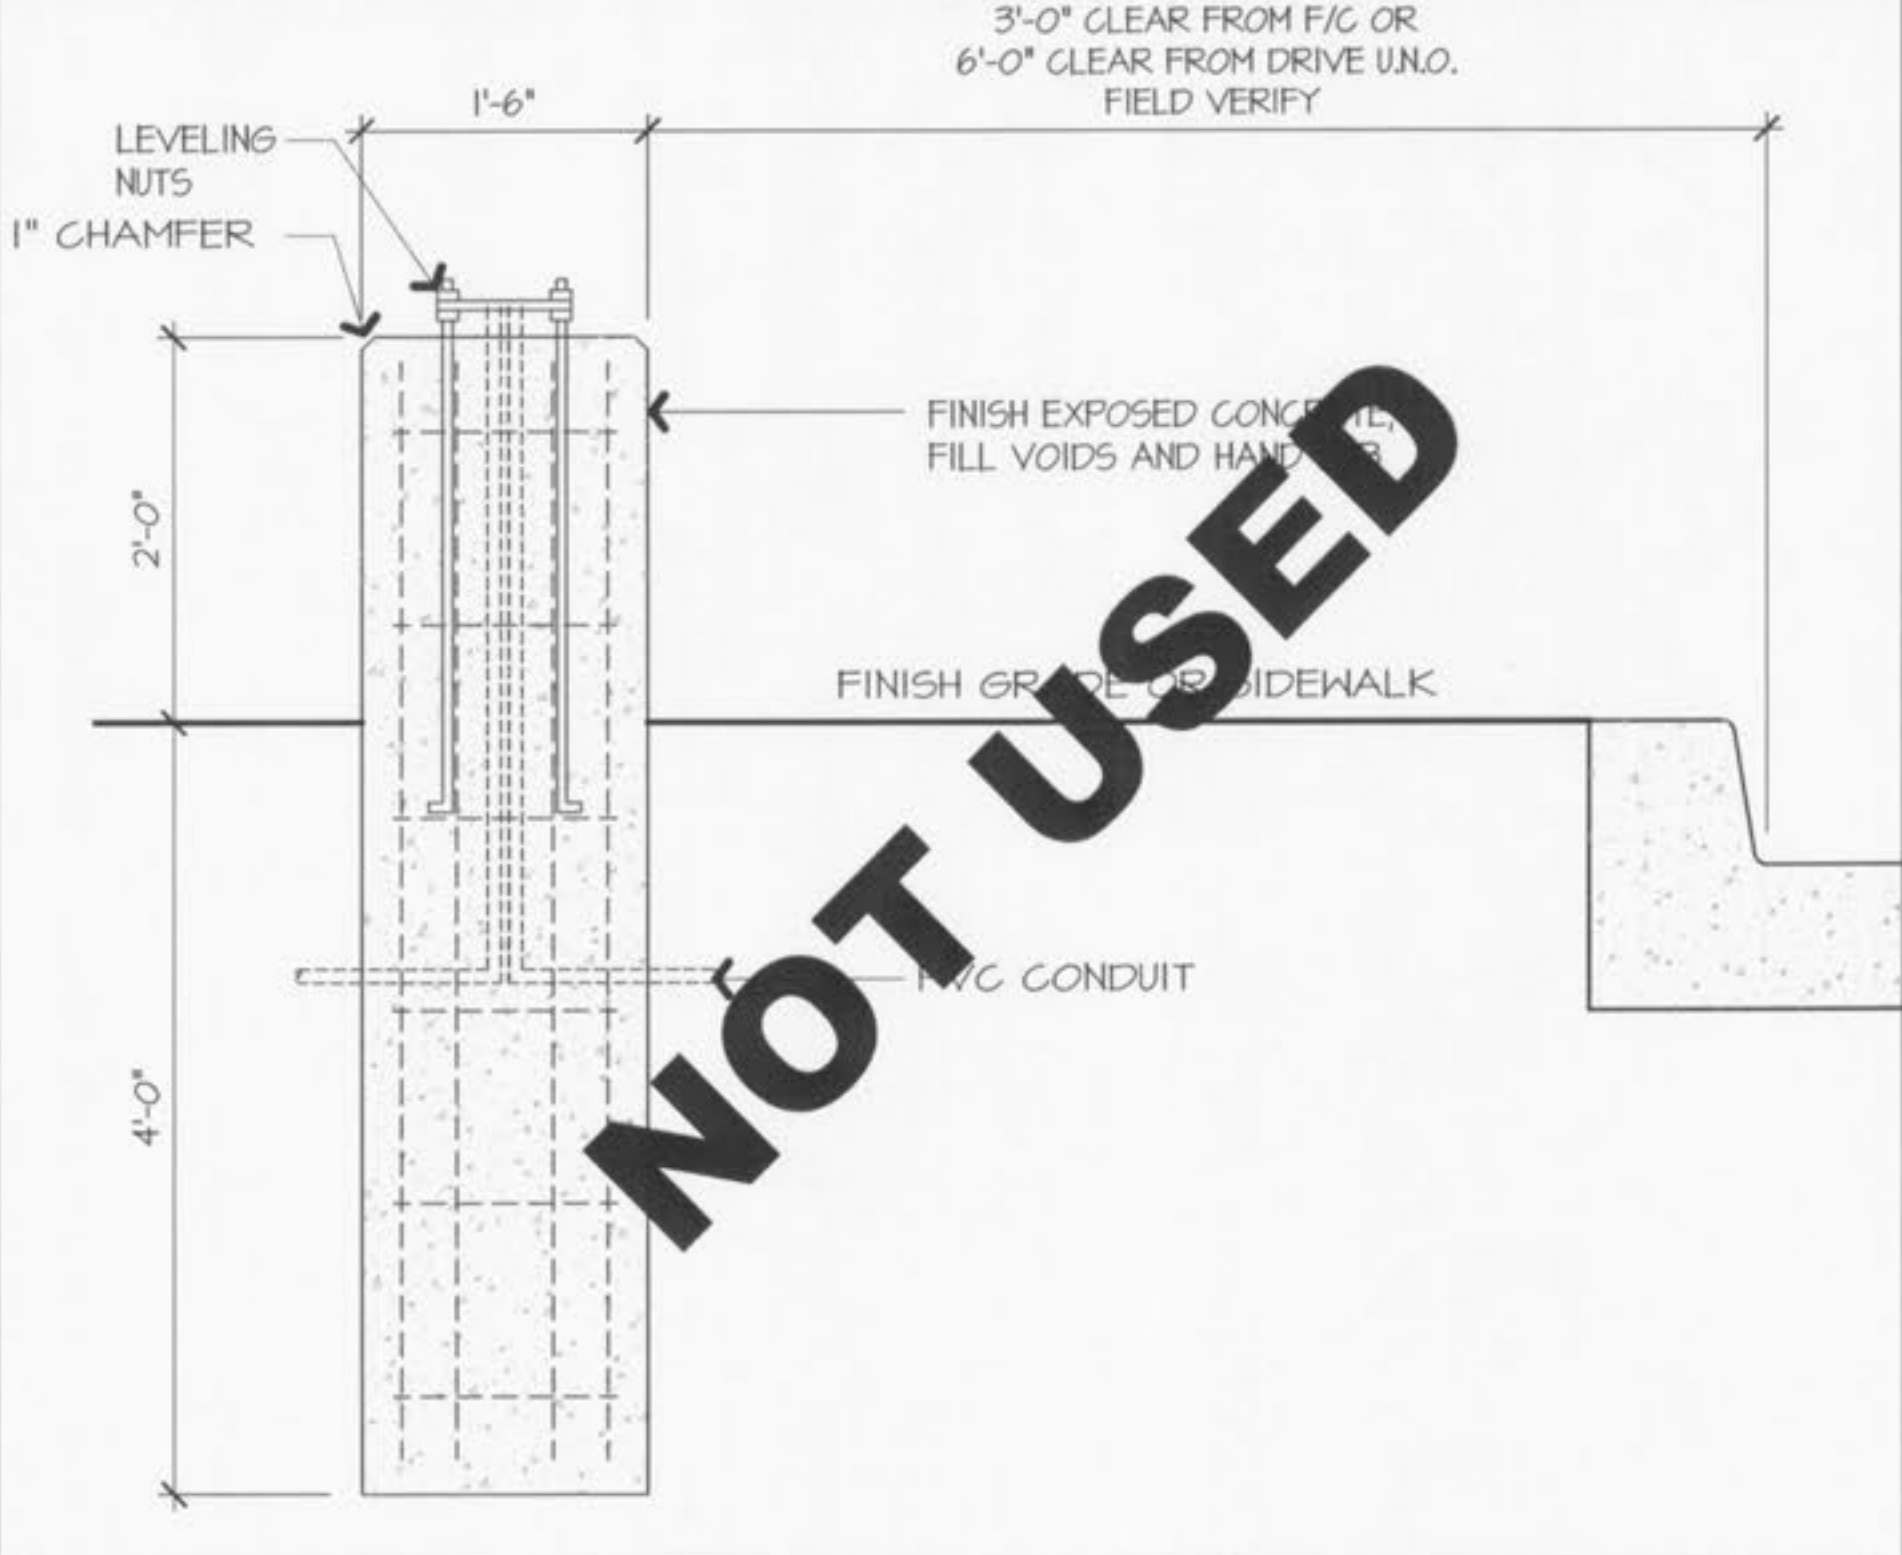

A6 SITE LIGHT POLE BASE DETAIL

1" = 1'-0"



A11 SITE LIGHT POLE BASE DETAIL

1" = 1'-0"

STATE OF MISSOURI REGISTERED PROFESSIONAL ENGINEER
T. L. LANDERS
MCINTOSH I.R.
AR007257
LICENSE NUMBER: AR007257
EXPIRES: 12/31/2013
SIGNATURE DATE: JAN 08 2012
McIntosh
The McIntosh Group, LLC
2800 South Boulder, Suite 300
Tulsa, Oklahoma 74119
Telephone 918.585.8555
Telefax 918.583.7282

Quik Trip No. 662
955 Bryan Rd.
O'Fallon, MO 63366

QT
PROTOTYPE: P-01
DIVISION: 6
VERSION: 1
DATE: 09/08/2011

REV	DATE	DESCRIPTION
1	1/6/12	CODE REVIEW COMMENTS

SHEET TITLE:
Air Dispenser Details

SHEET NUMBER:
AS 130