
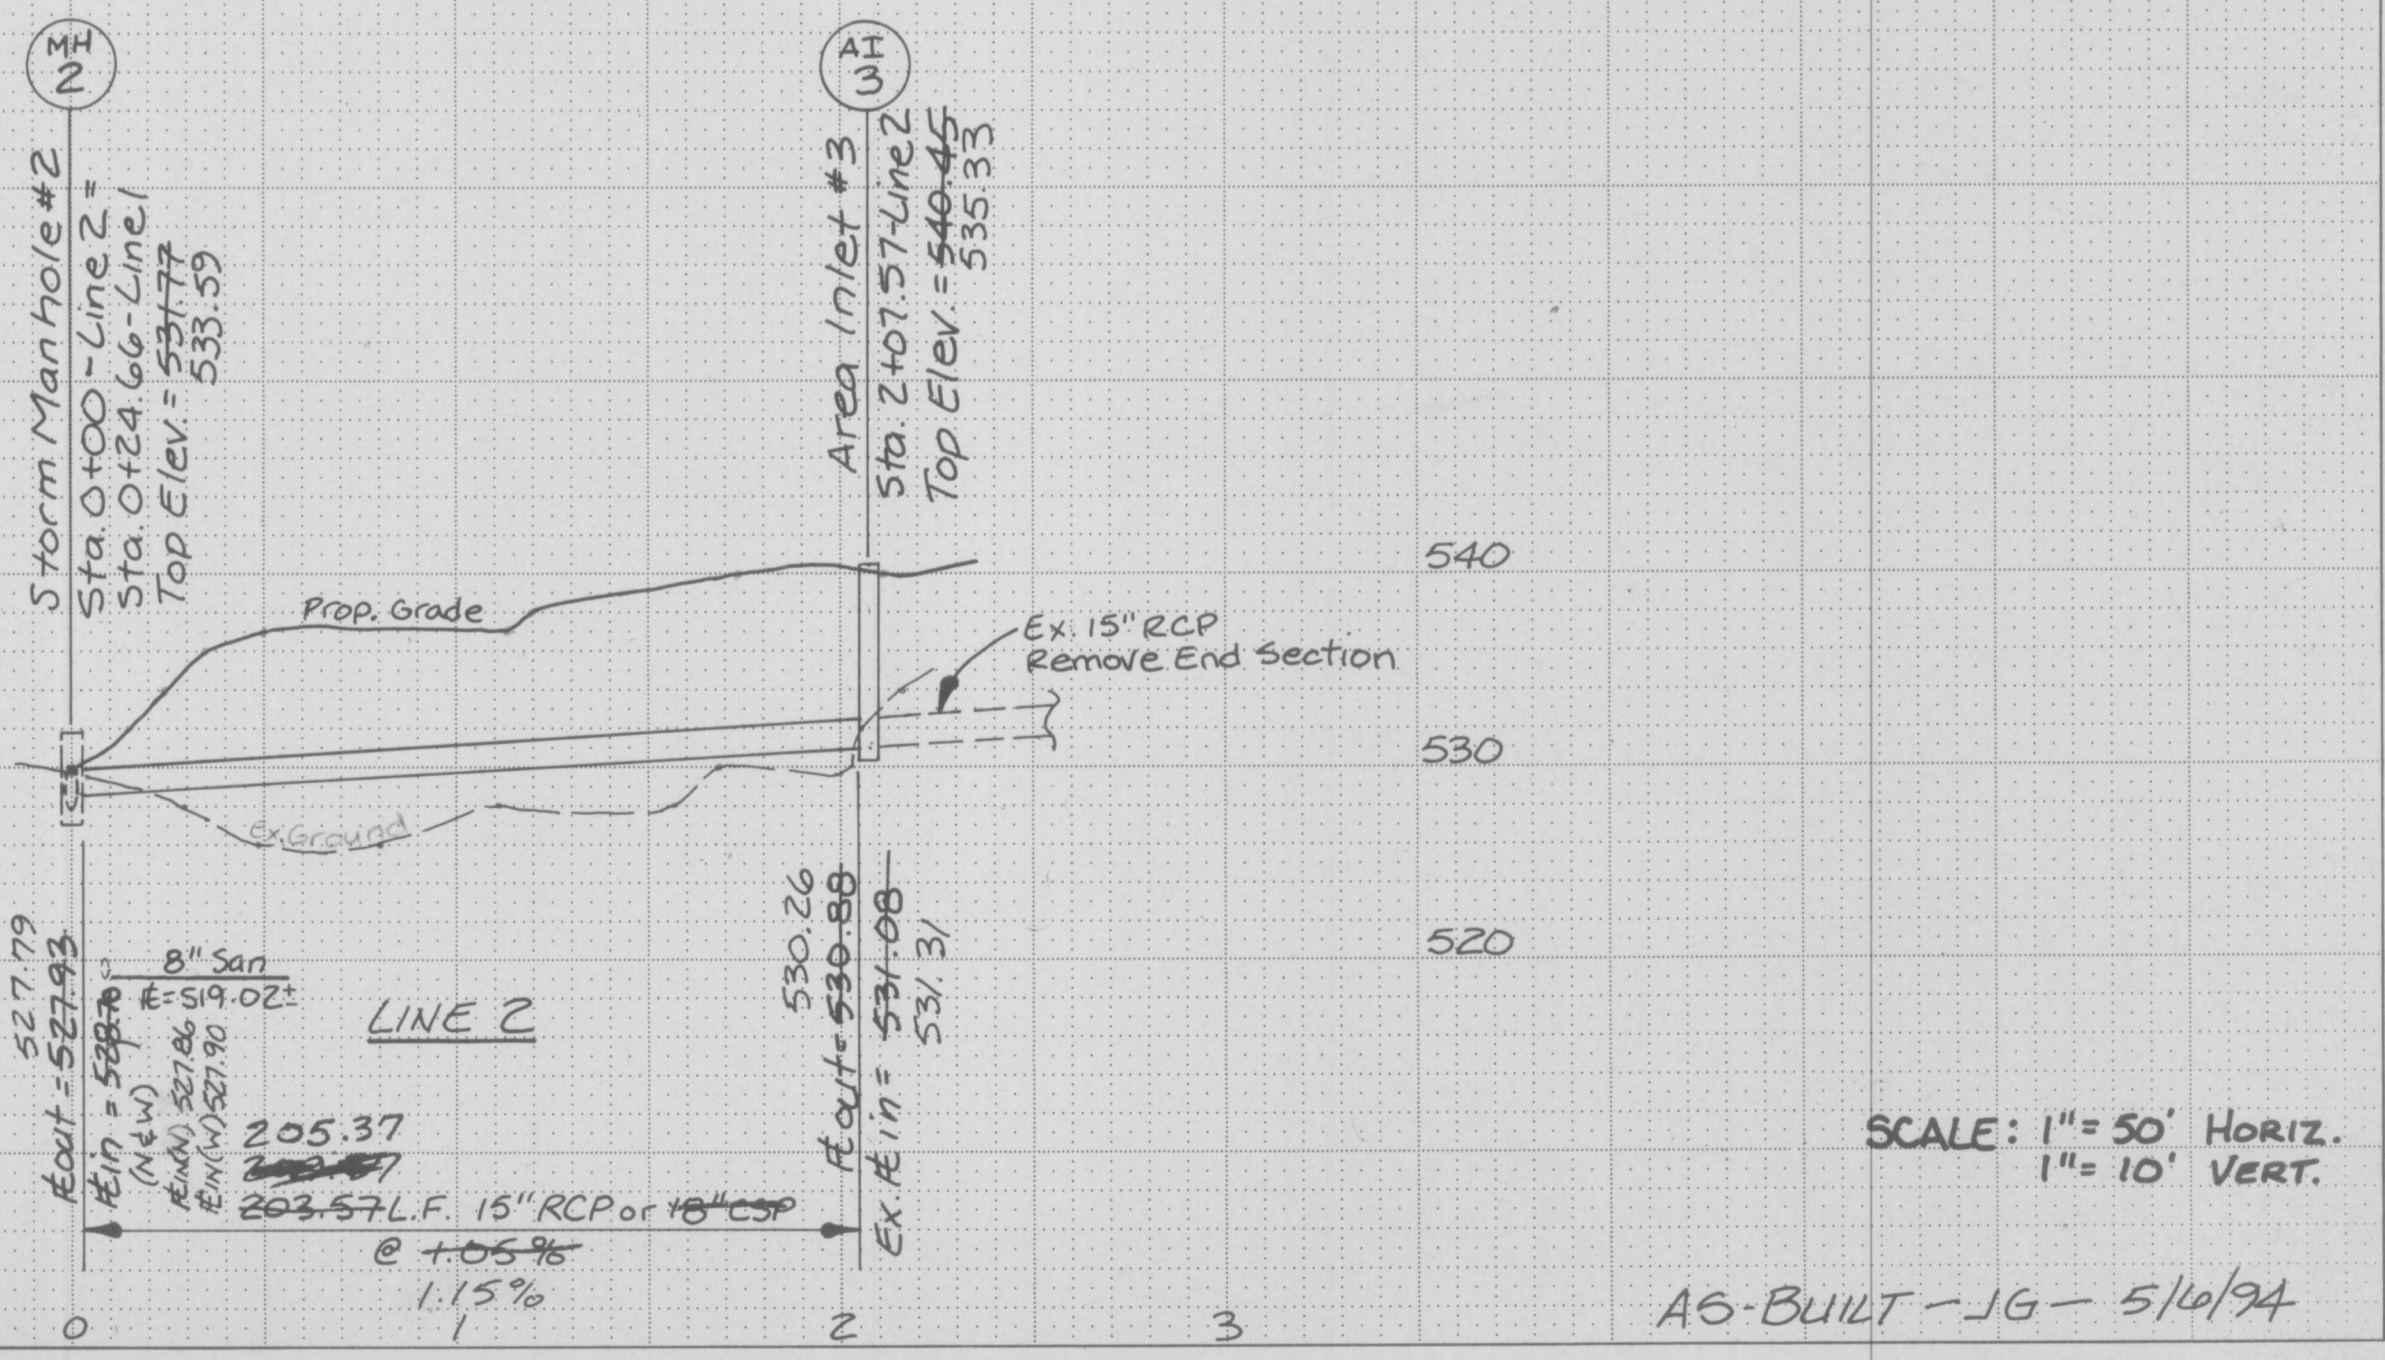
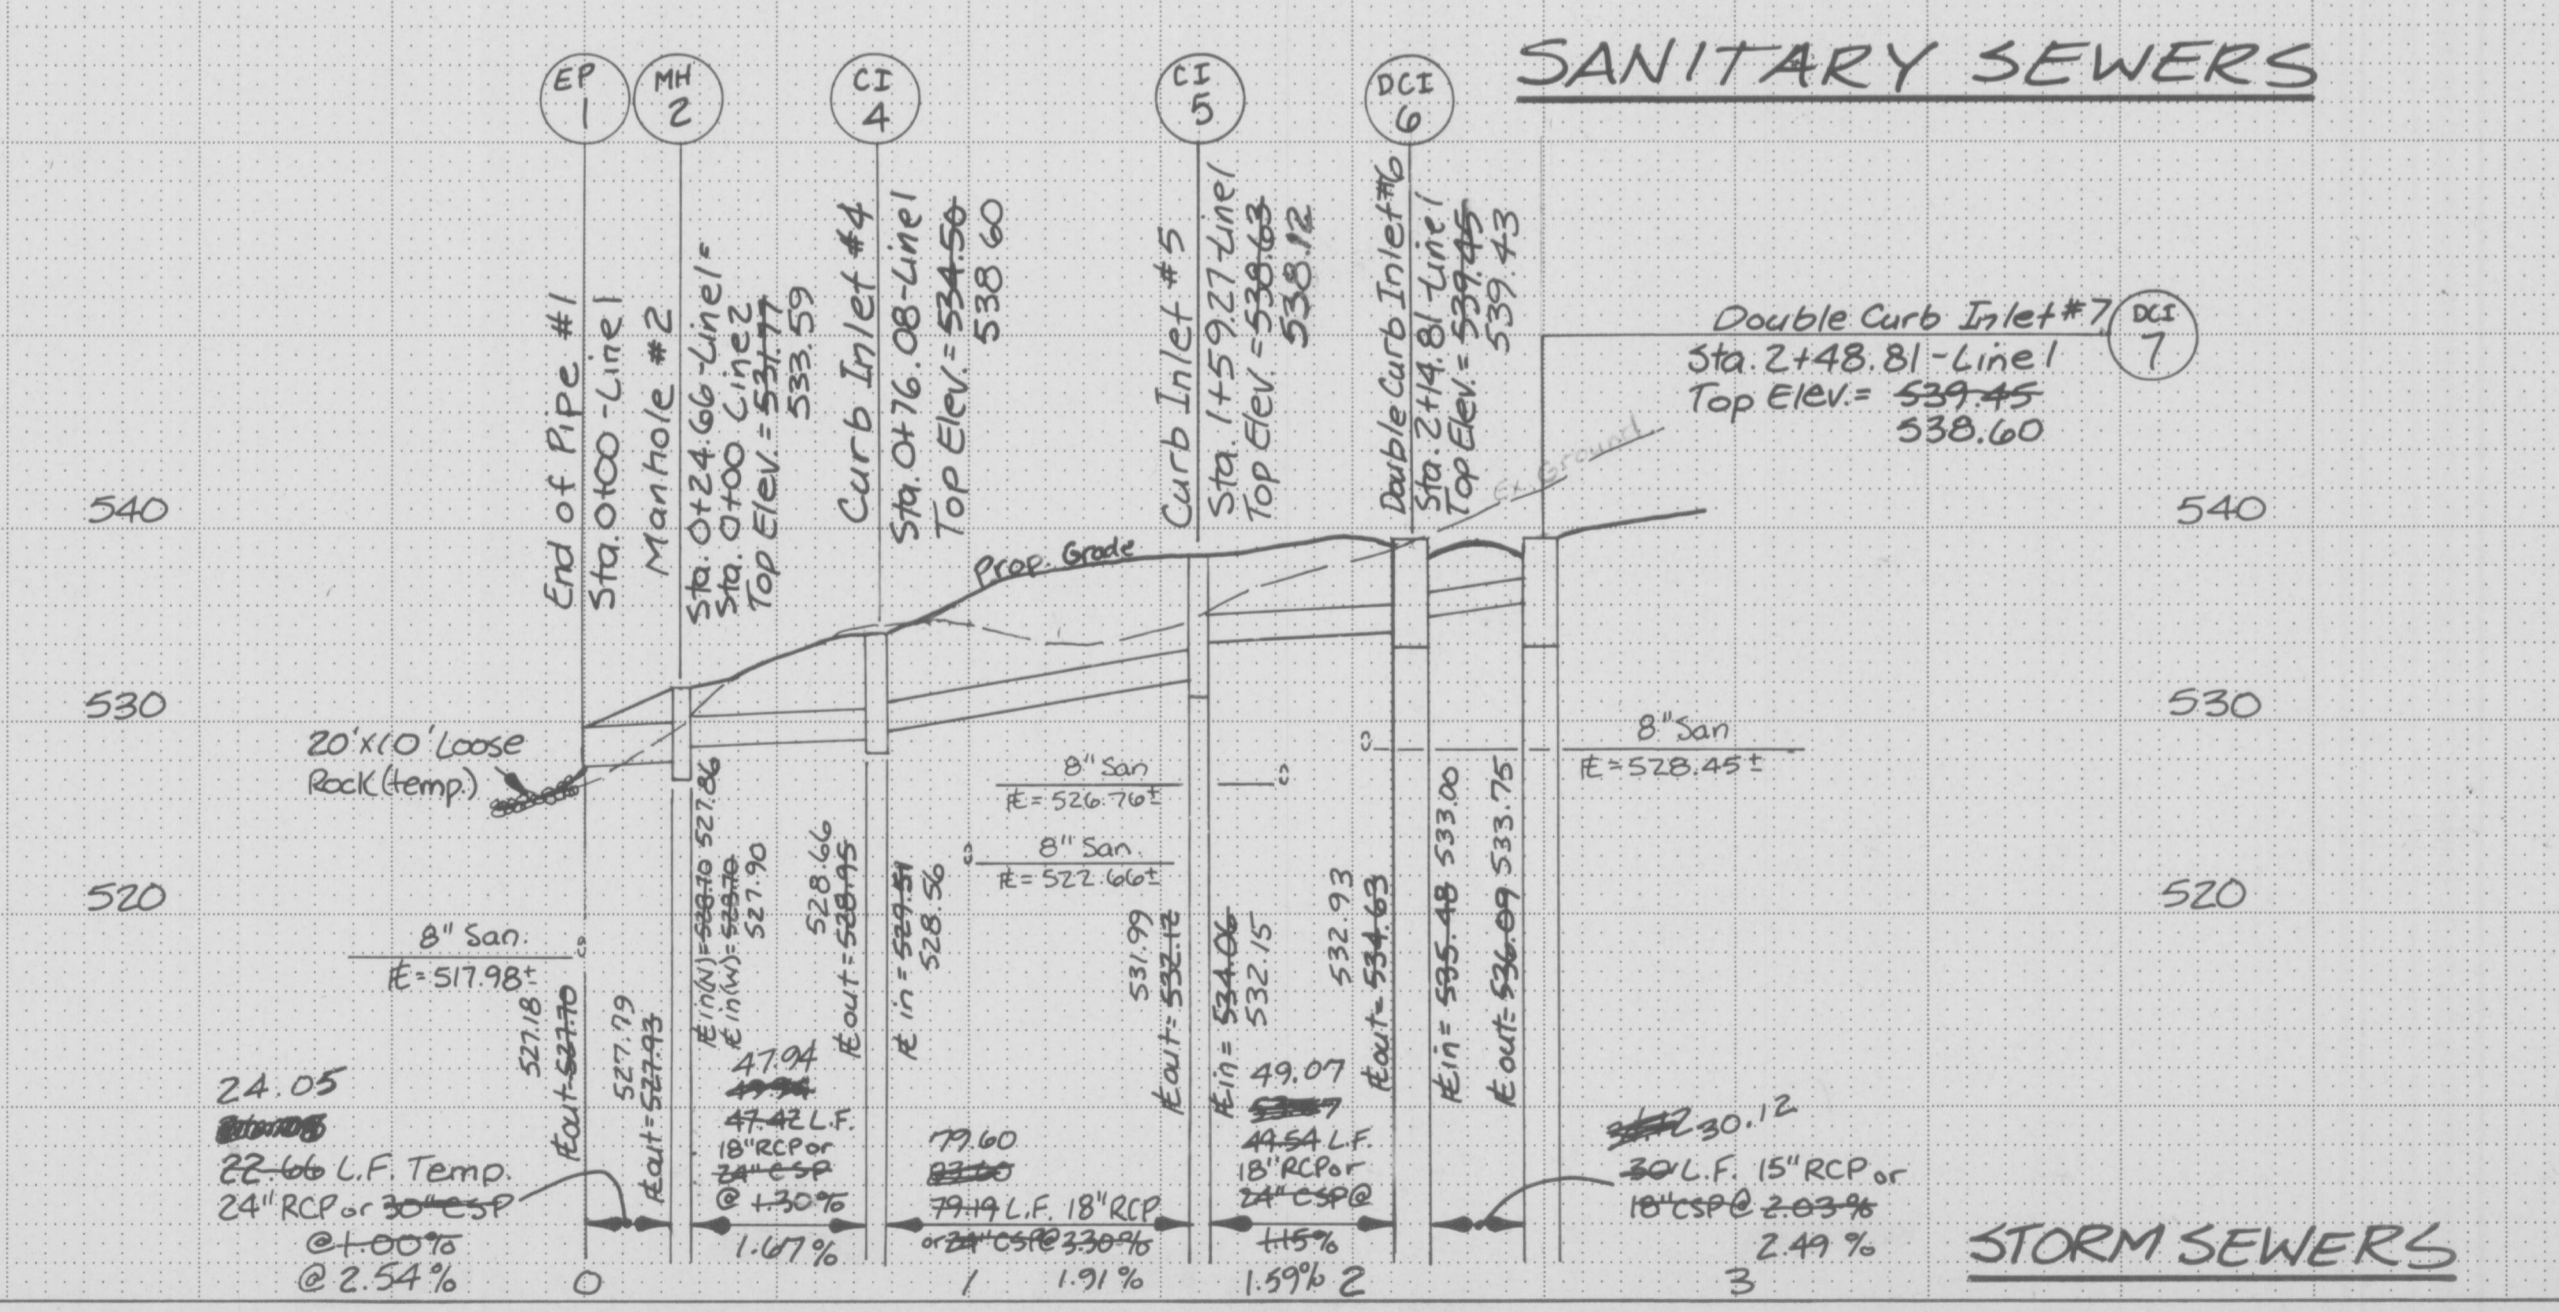
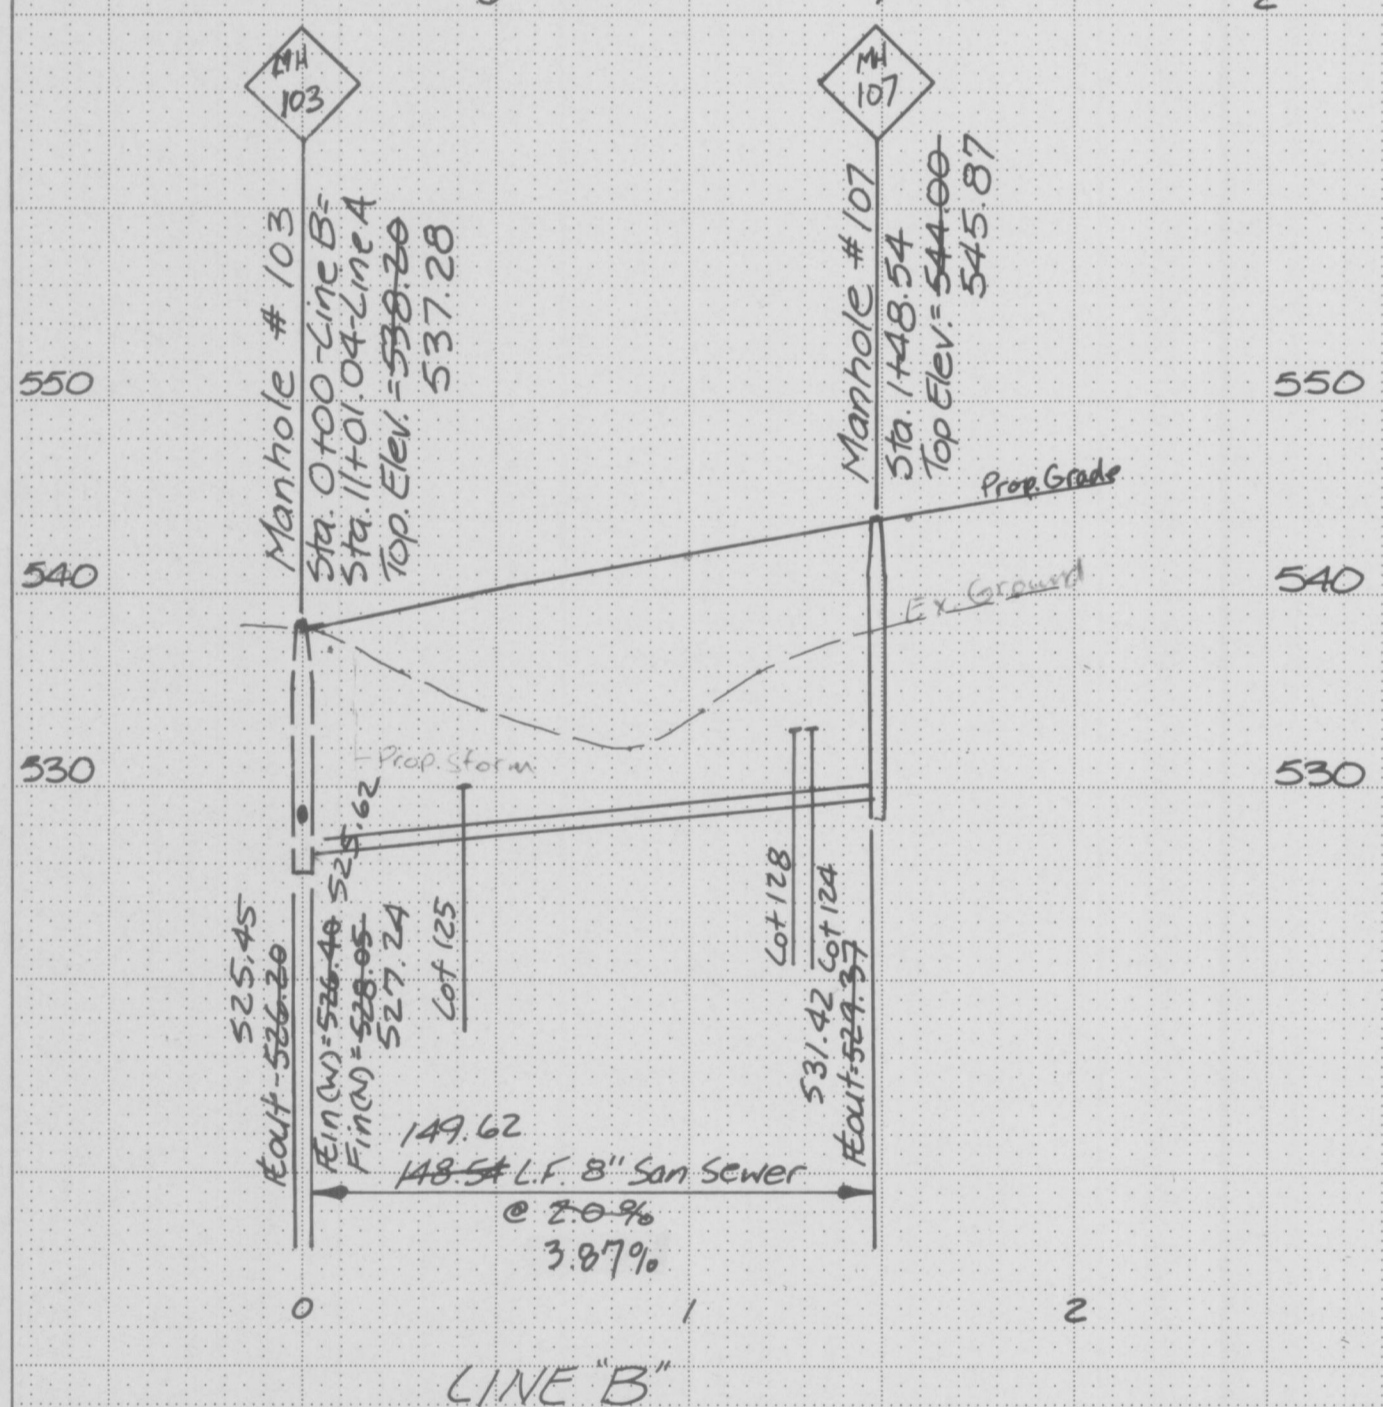


<b>GBA</b> GEORGE BUTLER ASSOCIATES, INC. Engineers / Architects / Landscape Architects / Planners	PROJECT	SHEET NO.	TOTAL SHEETS
	SANITARY & STORM SEWER PROFILES	5	9
	PROJECT NO.: 6803	DATE: JUNE 1993	
	REVISIONS: Min. cover note - J.G. - 7/19/93		

AS-BUILT - JG - 5/16/94

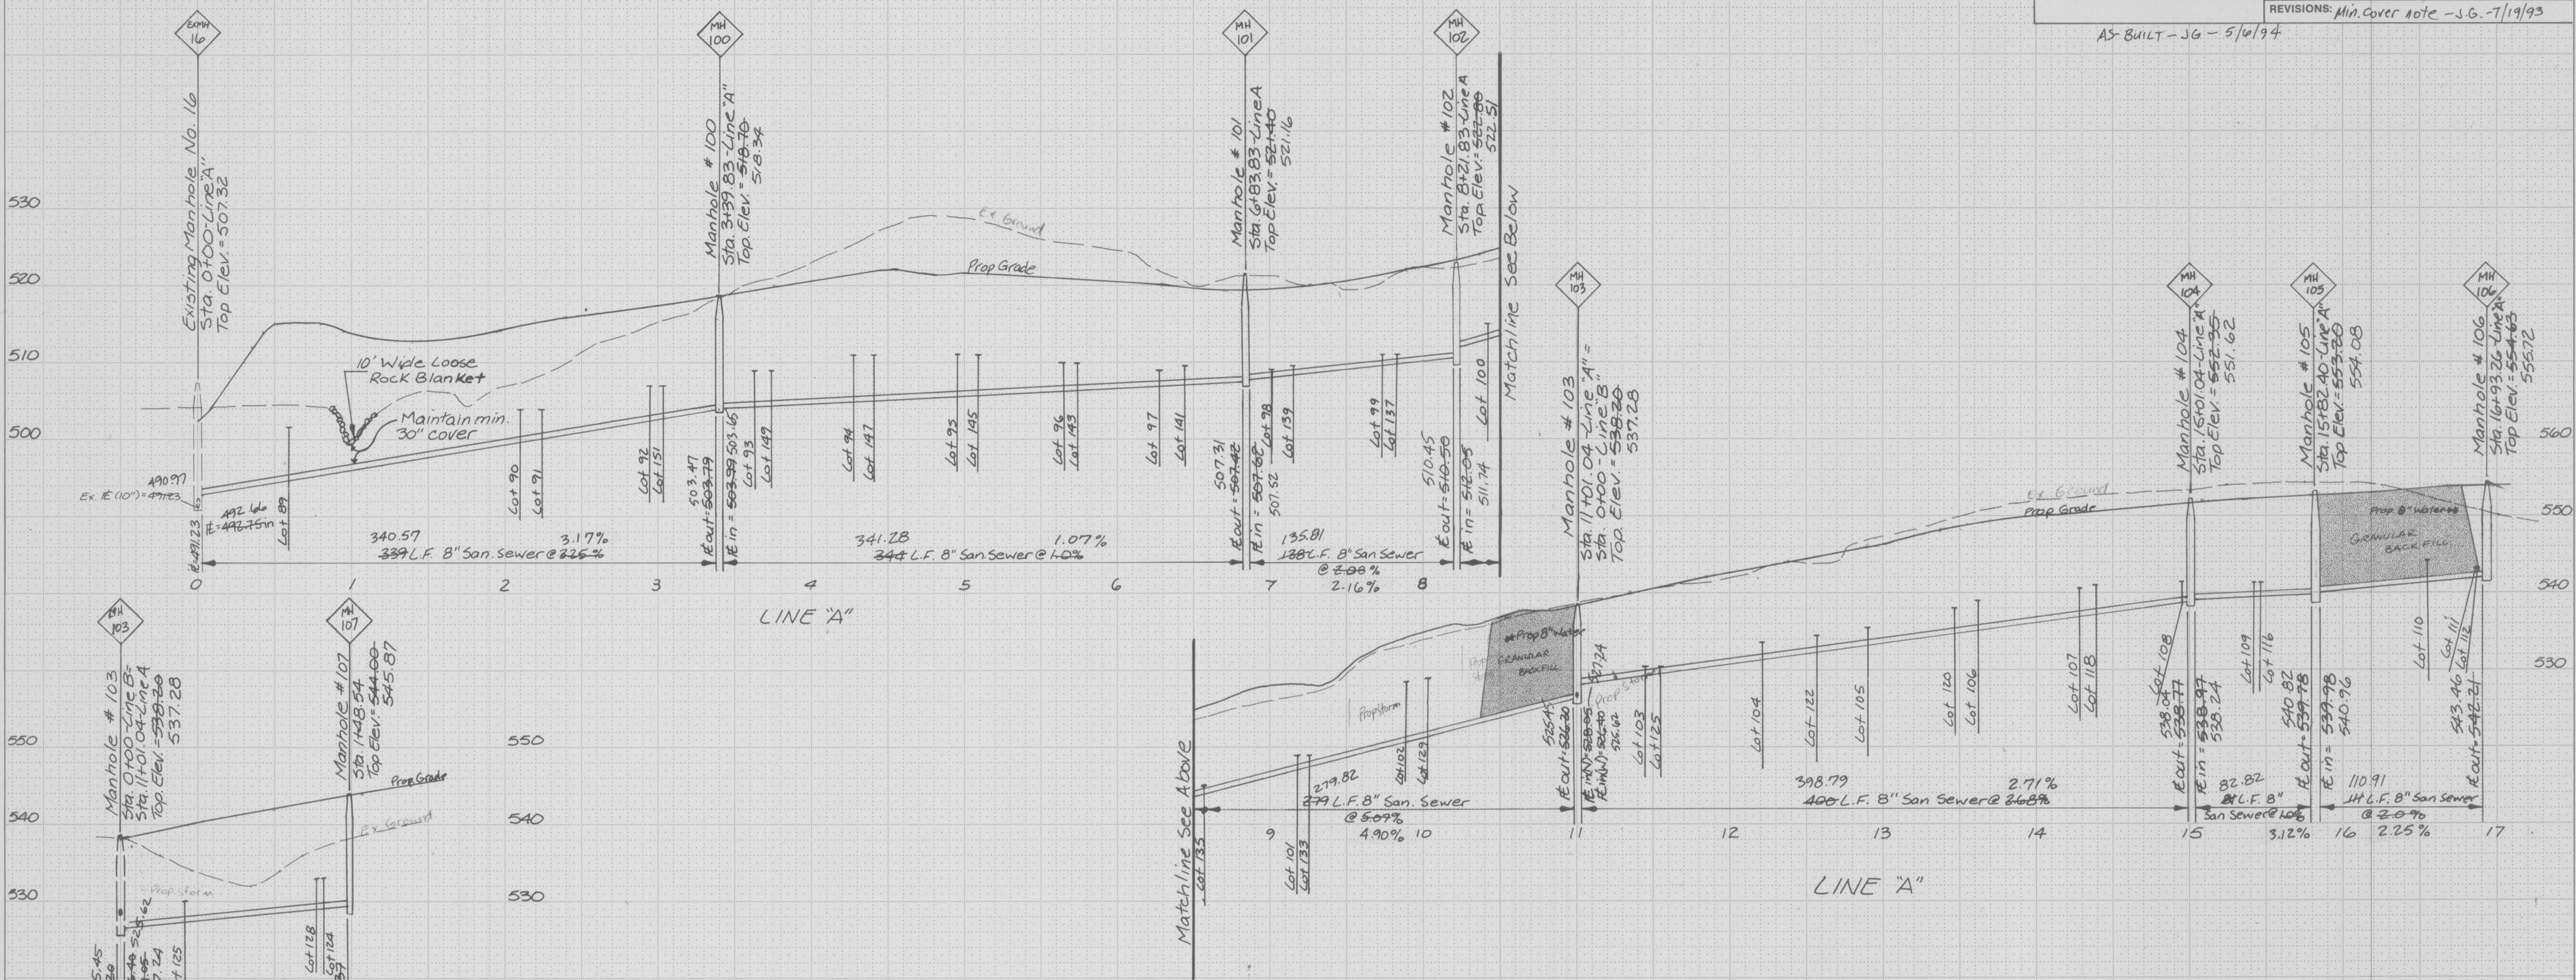

SCALE: 1" = 50' HORIZ.  
1" = 10' VERT.

A6-BUILT - JG - 5/16/94