

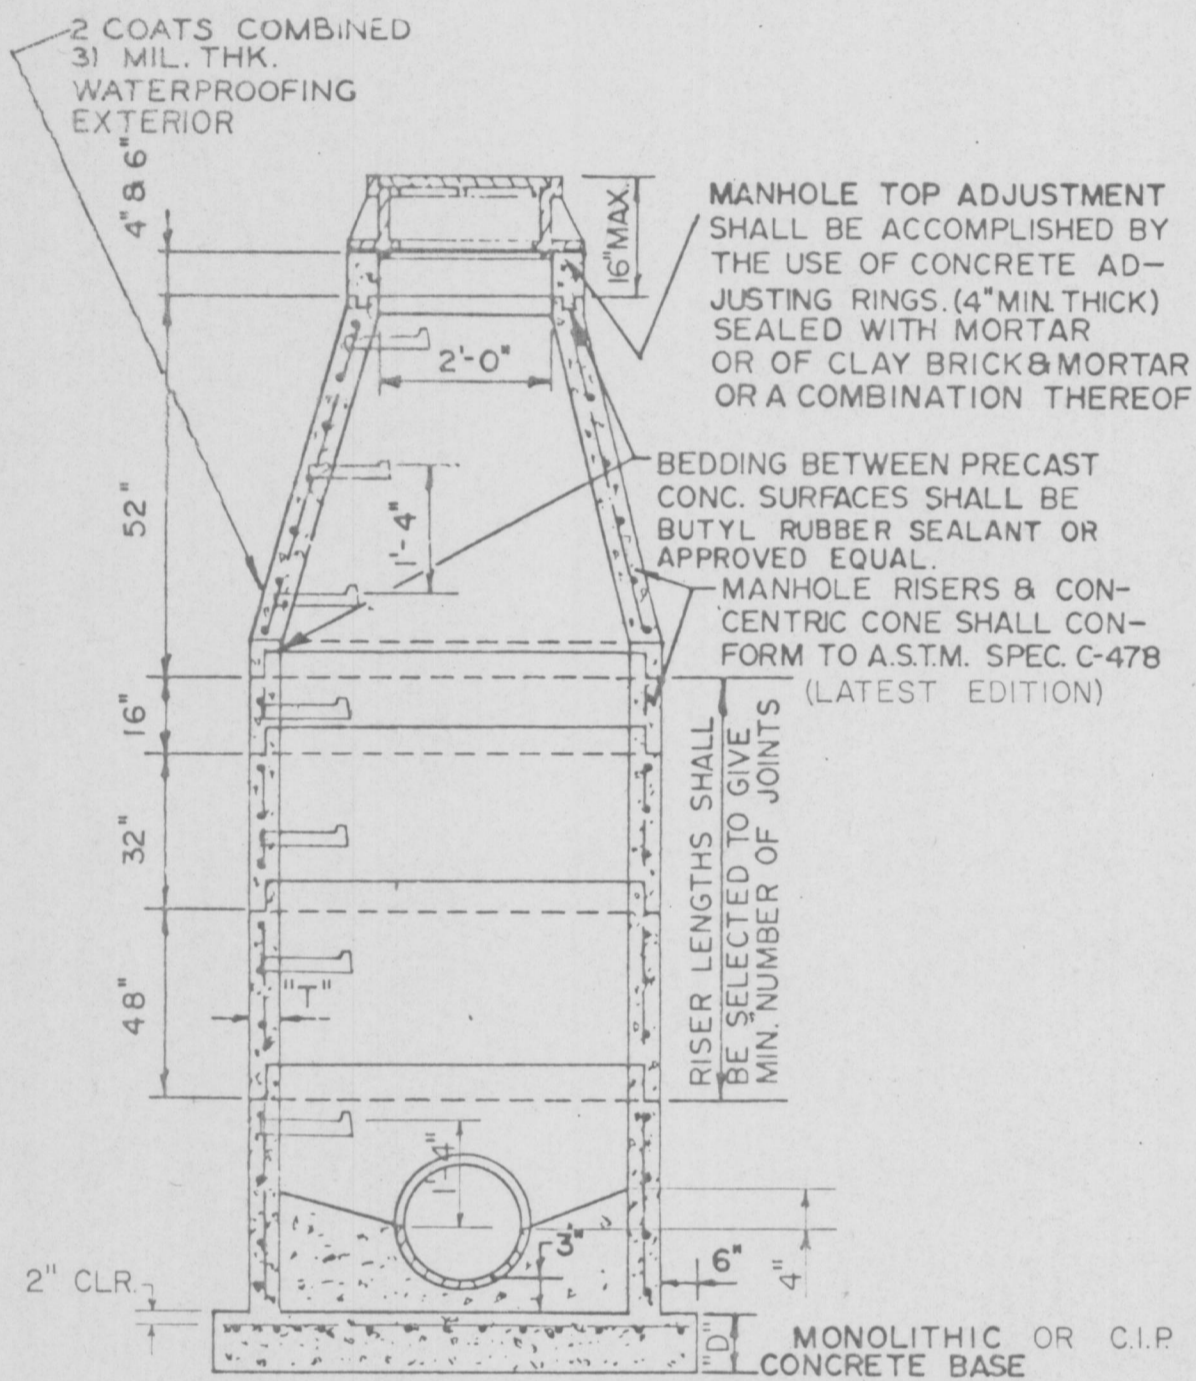


WALL THICKNESS	"T" DIM PRE CAST
48"	5"
60"	6"
72"	7"


MANHOLE BASE THICKNESS	
DEPTH (FEET)	"D" DIM.
0-20	8" w/ 4 BARS @ 12" CTRS. EACH WAY
20-30	8" w/ 4 BARS @ 9" CTRS. EACH WAY
30-40	10" w/ 5 BARS @ 10" CTRS. EACH WAY

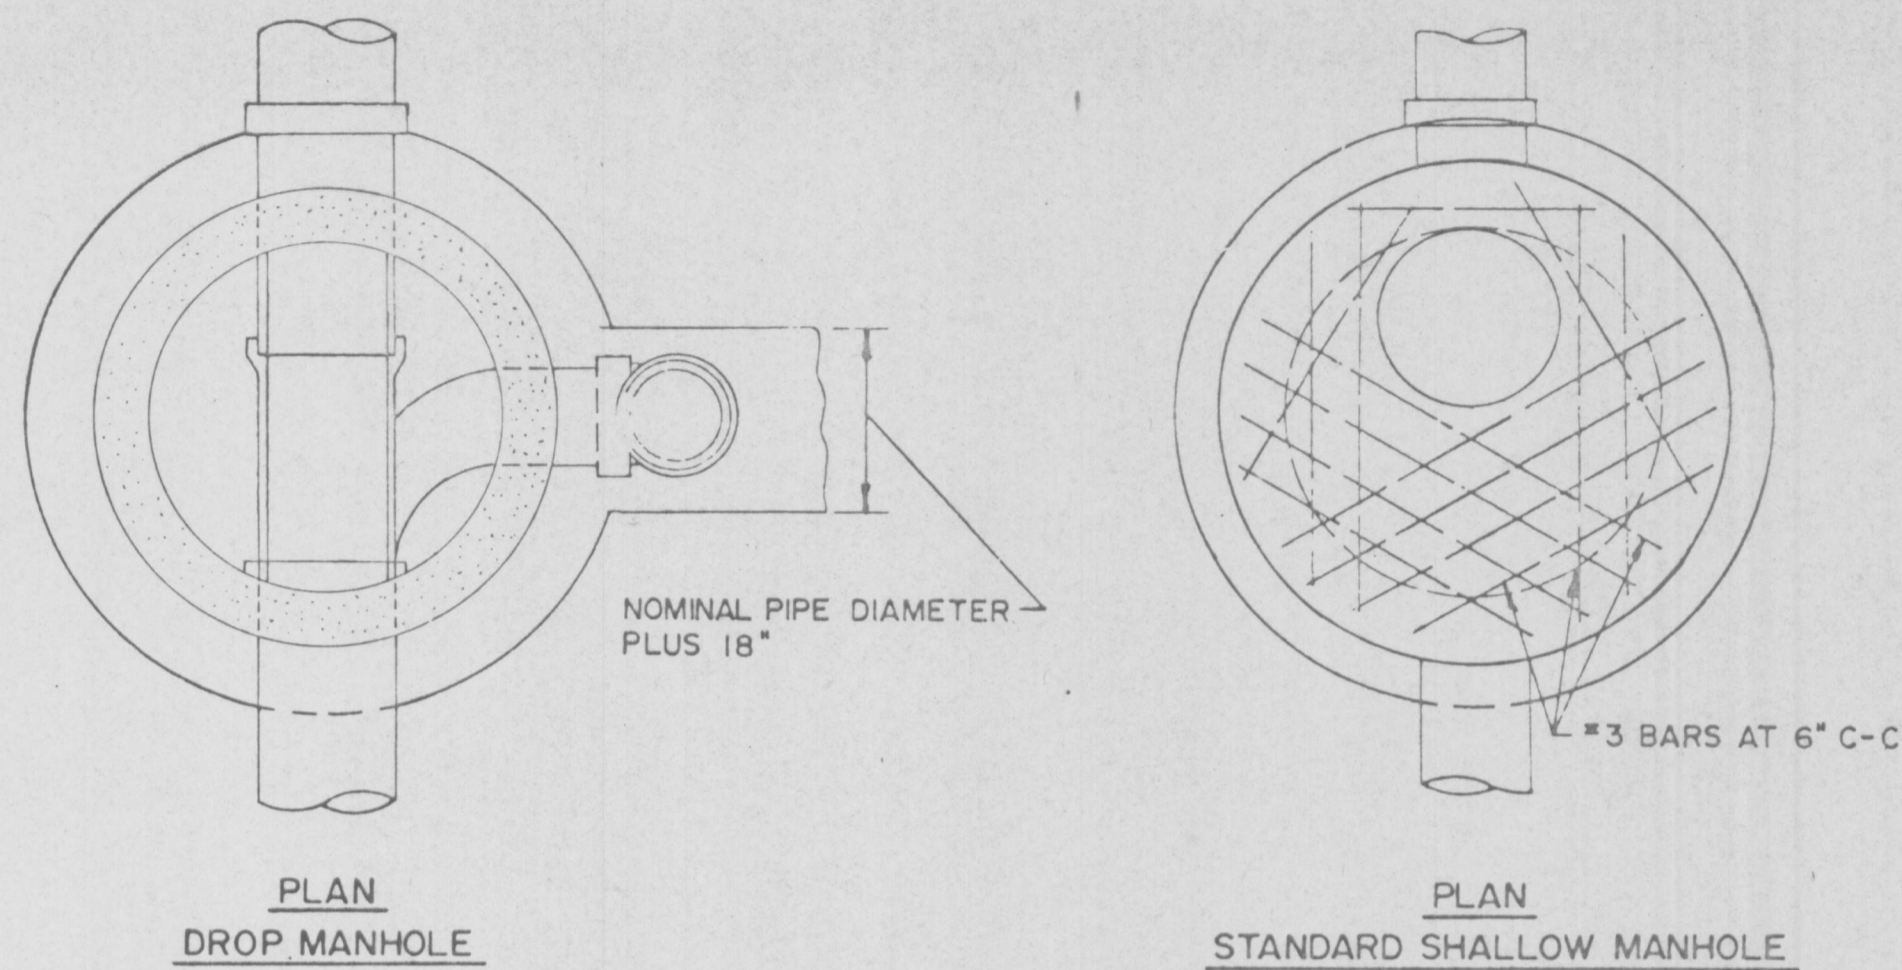


SECTION PRECAST CONCRETE MANHOLE

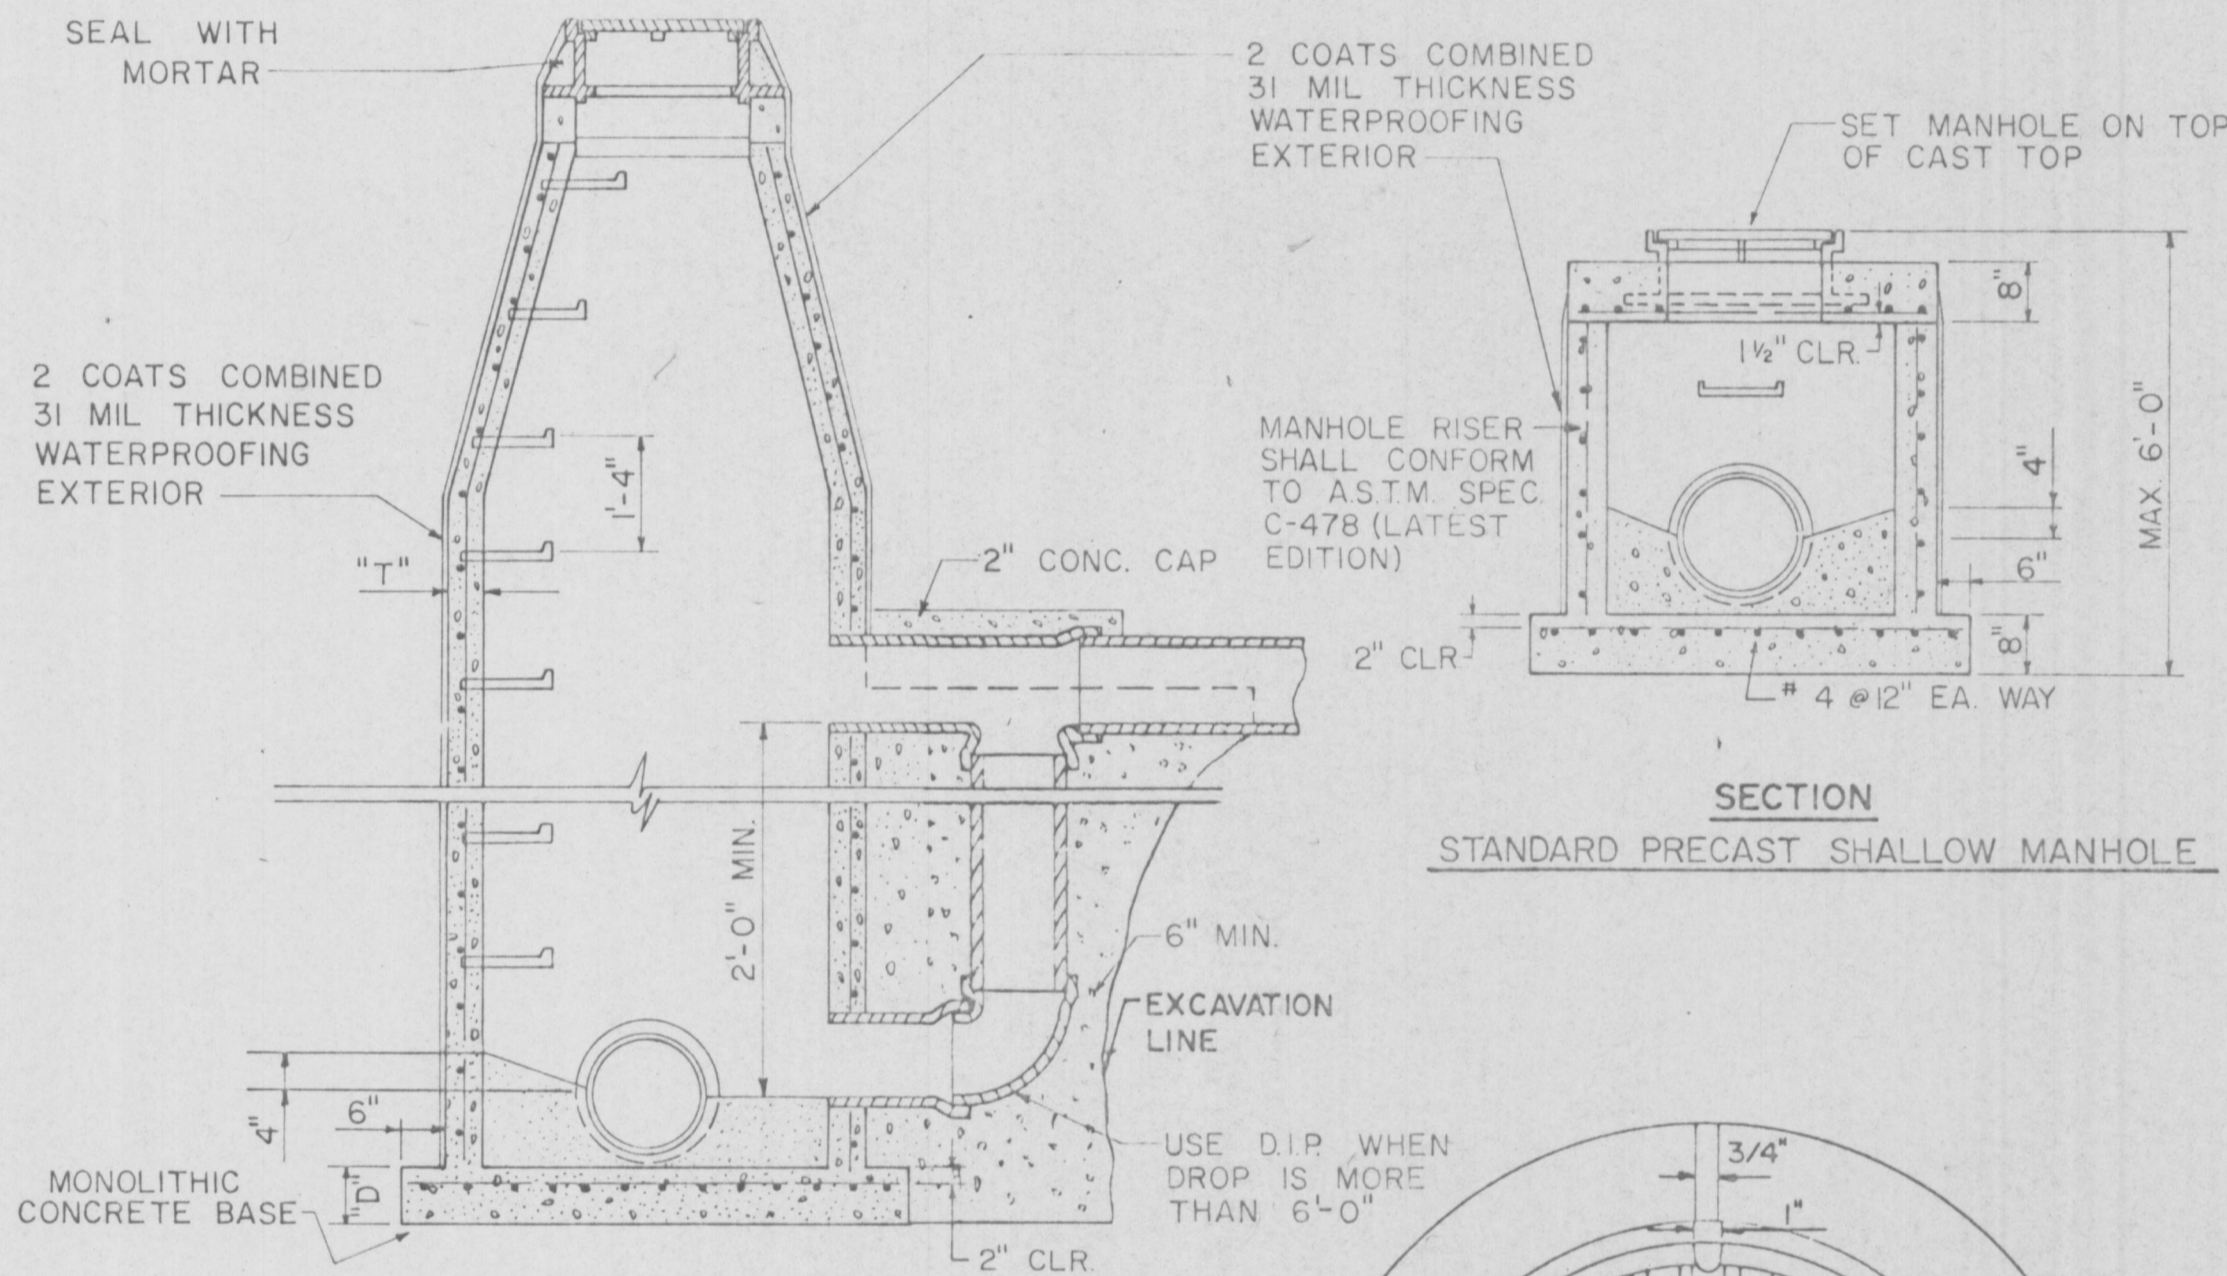


SECTION DROP MANHOLE

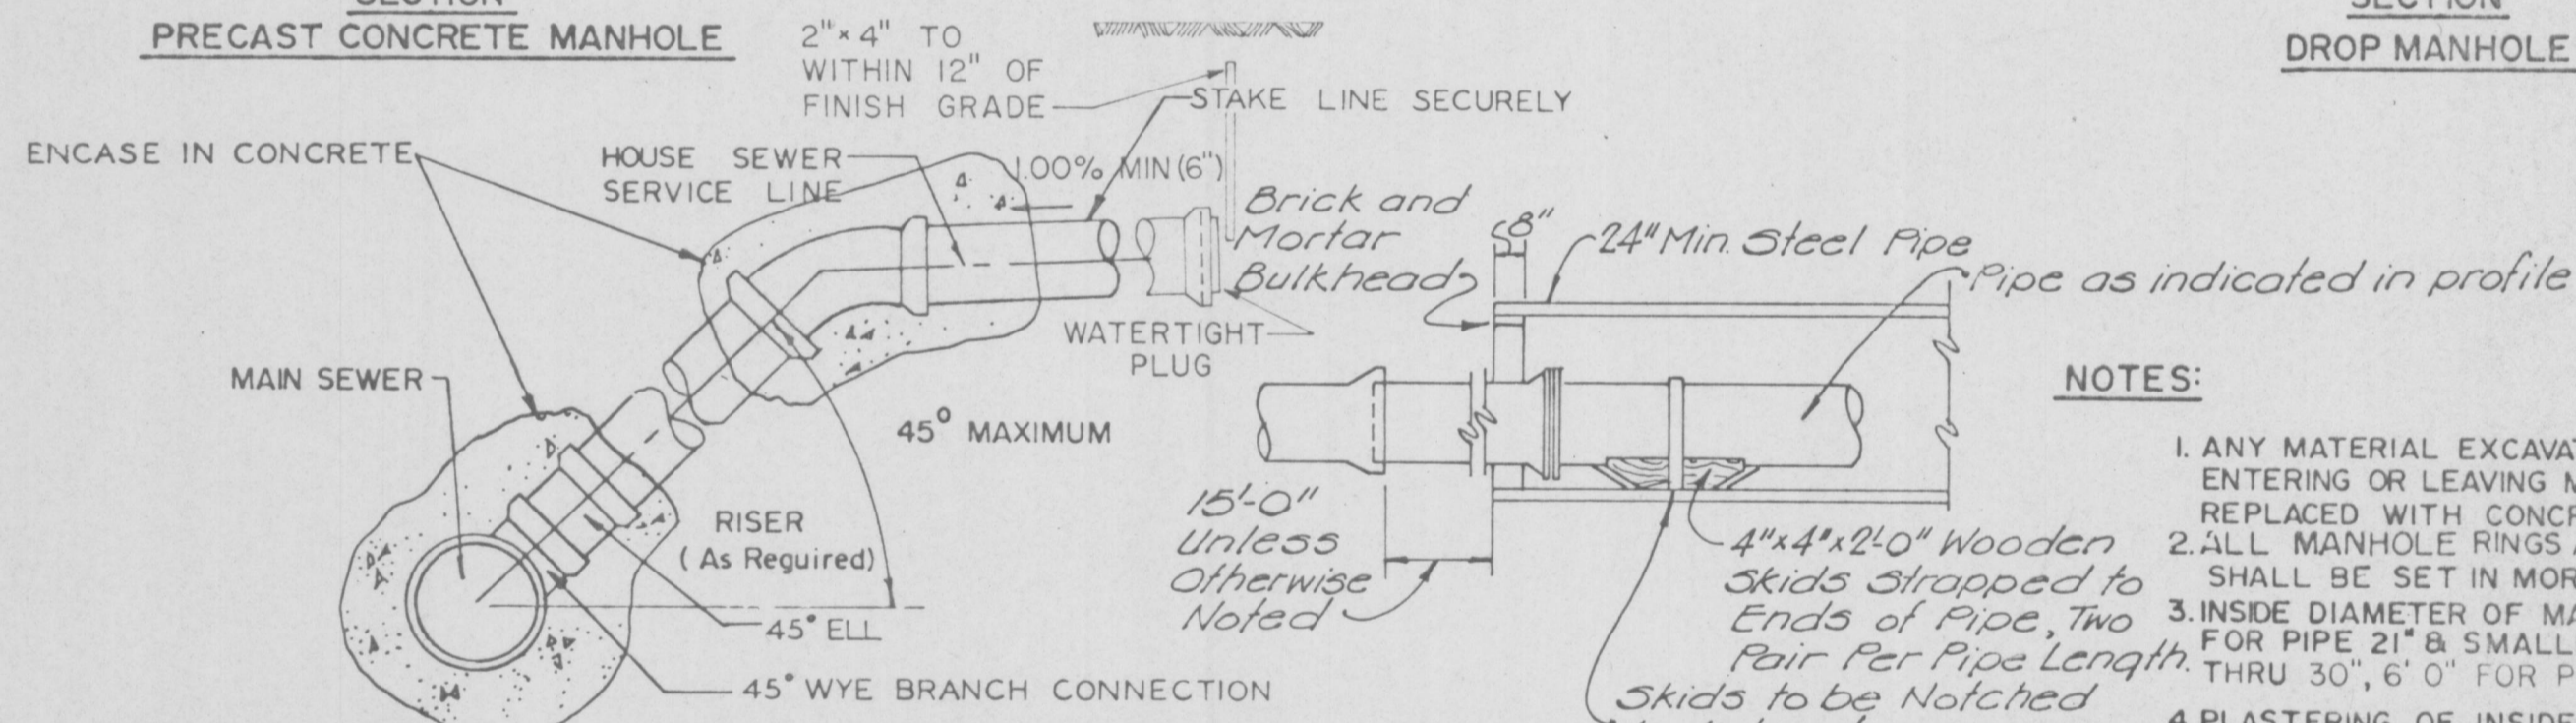

SEWER SERVICE CONNECTION

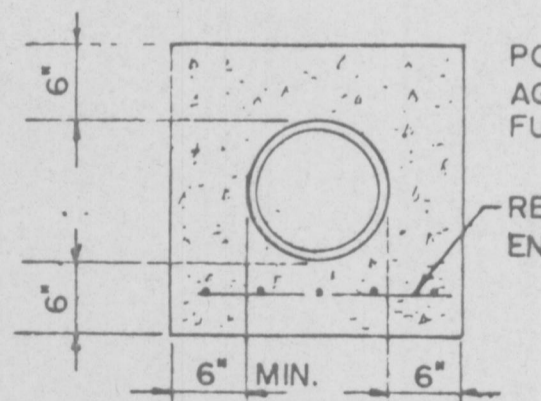


CONCRETE ENCASEMENT

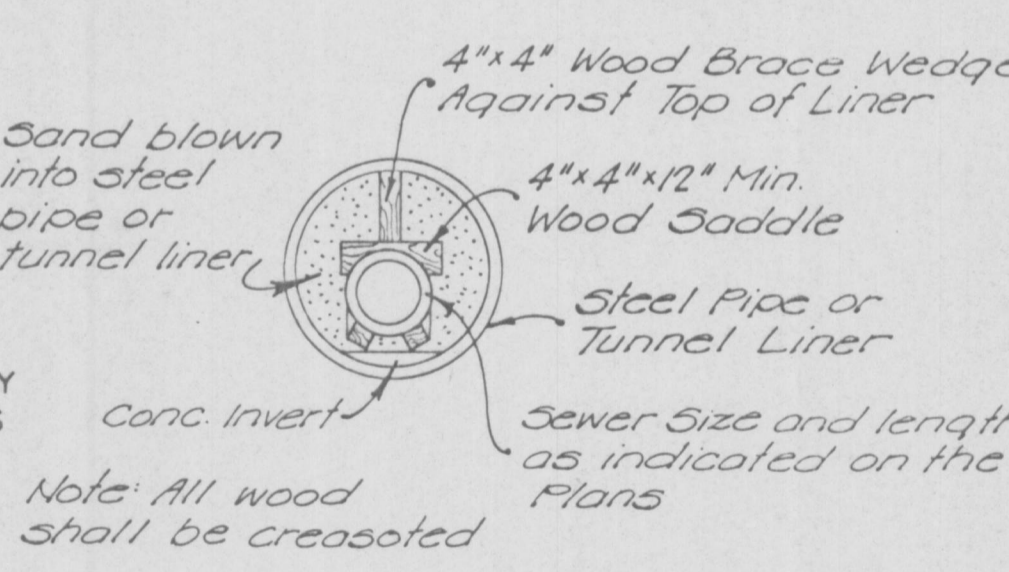

DETAIL OF CROSSING IN CONDUIT


NOTES:

1. ANY MATERIAL EXCAVATED BENEATH PIPE ENTERING OR LEAVING MANHOLES SHALL BE REPLACED WITH CONCRETE.
2. ALL MANHOLE RINGS AND ADJUSTING RINGS SHALL BE SET IN MORTAR.
3. INSIDE DIAMETER OF MANHOLES TO BE 4'-0" FOR PIPE 21" & SMALLER, 5'-0" FOR PIPE 24" THRU 30", 6'-0" FOR PIPE OVER 30"
4. PLASTERING OF INSIDE OF MANHOLES SHALL BE THE OPTION OF THE CONTRACTOR.
5. ALL SEWERS EXTENDING FROM MANHOLES SHALL BE SUPPORTED WITH CONCRETE TO FIRST JOINT.
6. CONTRACTOR SHALL BE PAID FOR 6" CONCRETE ENCASEMENT AROUND PIPE AS SHOWN IN DETAIL.
7. LAMP LINES BEFORE AND AFTER INSTALLATION OF CONCRETE ENCASEMENT.
8. PRECAST MANHOLE SHALL BE WATERPROOFED OUTSIDE.
9. ALL CONC MANHOLES TO HAVE RUBBER GASKET ON ALL PIPE OPENINGS.

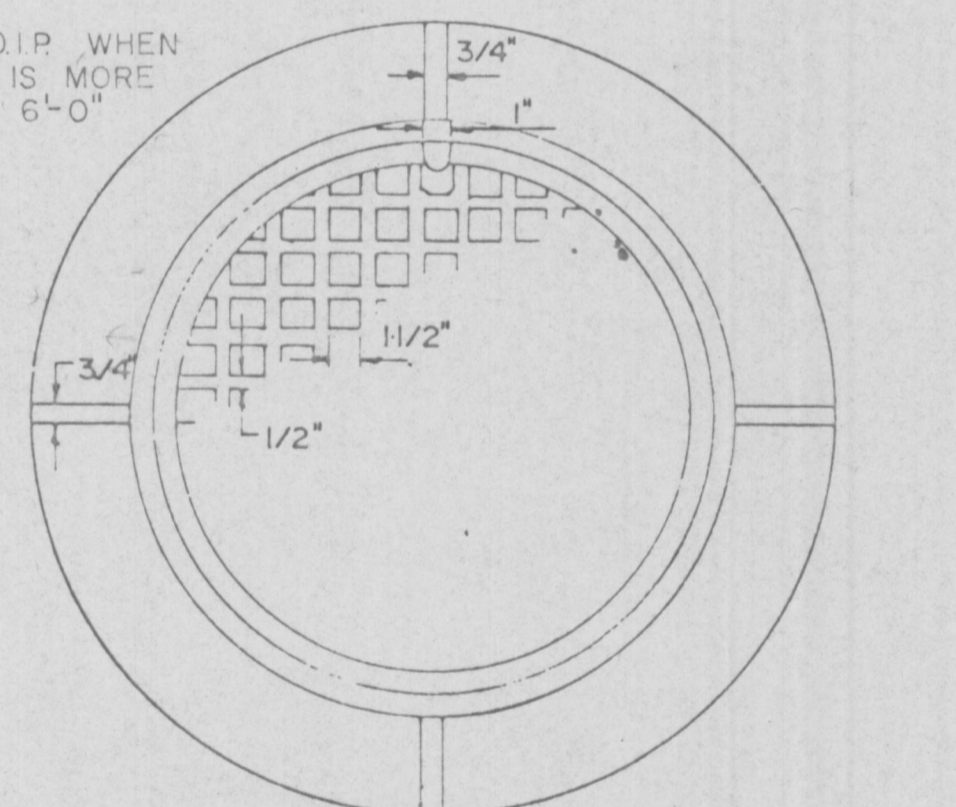

STANDARD MANHOLE RING AND COVER

CLAY & BAILEY - NO. 2008
NEENAH - R-1736
DEETER - 1315
OR EQUAL

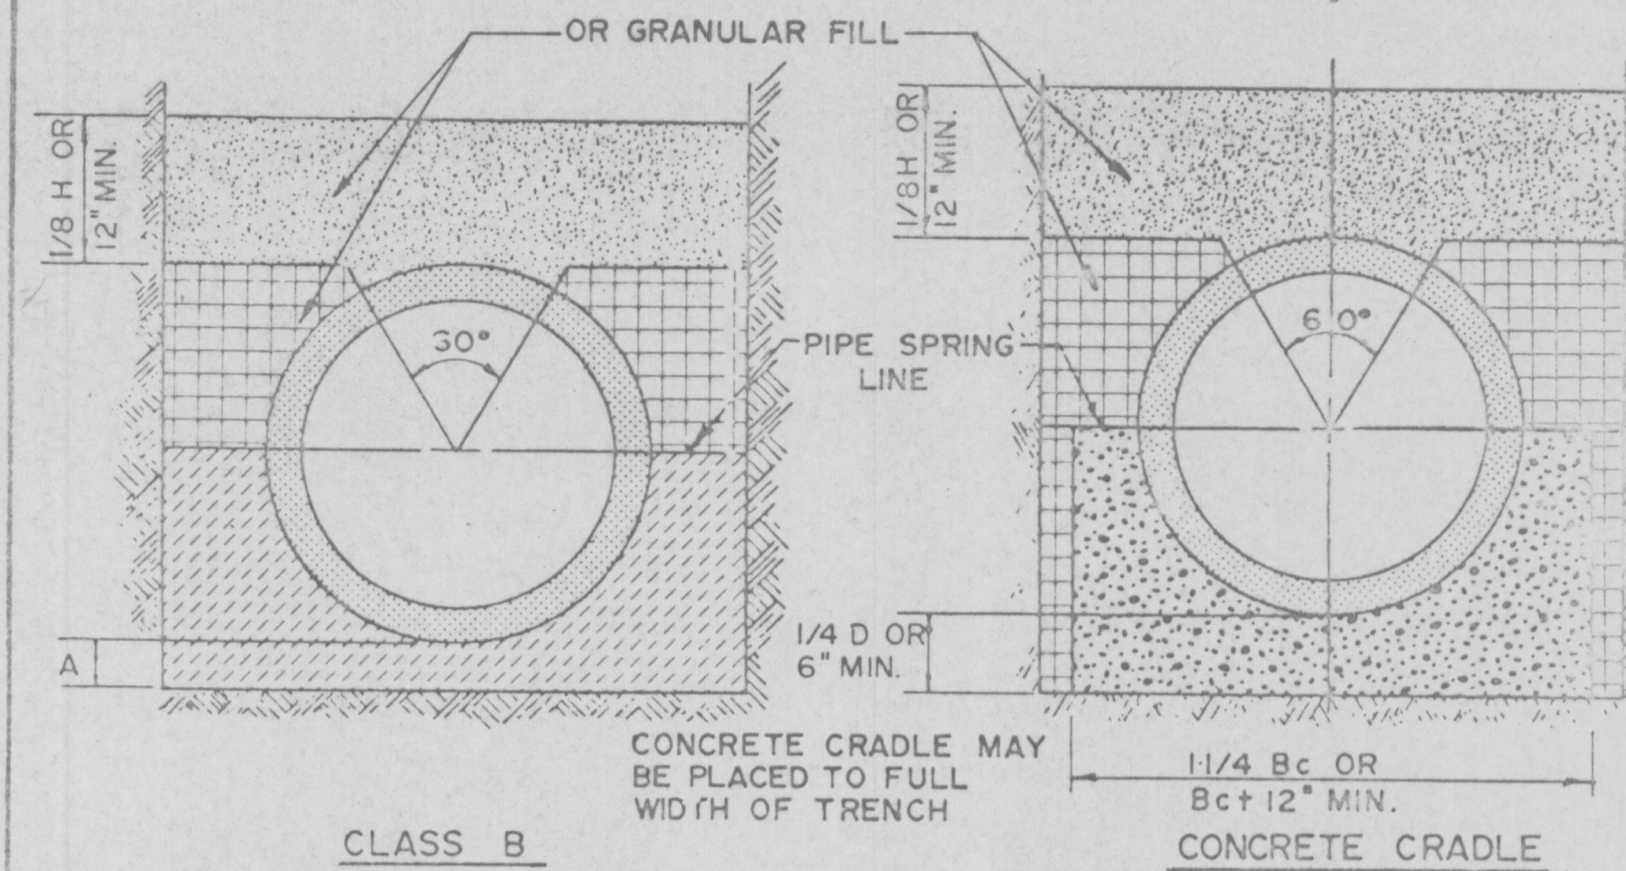

CLASS B BEDDING DETAILS

LEGEND:

- Bc OUTSIDE DIA. OF PIPE
- H BACKFILL COVER ABOVE TOP OF PIPE
- D NOMINAL PIPE SIZE
- A FILL BELOW PIPE (SEE TABLE BELOW)



[Pattern]	HAND PLACED BACKFILL
[Pattern]	TAMPED BACKFILL
[Pattern]	GRANULAR FILL
[Pattern]	CONCRETE

TABLE OF FILL BELOW PIPE


D	A MIN.
27" & SMALLER	3"
30" TO 60"	4"
66" & LARGER	6"

NOTES:


1. GRANULAR FILL TO BE CRUSHED STONE OR PEA GRAVEL WITH NOT LESS 95% PASSING 1/2" AND NOT LESS THAN 95% TO BE RETAINED ON A #4, TO BE PLACED IN NOT MORE THAN 6" LAYERS AND COMPACTED BY SLICING WITH A SHOVEL. (1/2" & #4 REFERS TO SIEVE SIZE.)
2. TAMPED BACKFILL SHALL BE FINELY DIVIDED JOB EXCAVATED MATERIAL FREE FROM DEBRIS, ORGANIC MATERIAL AND STONES, COMPACTED TO 95% MAXIMUM DENSITY AS DETERMINED BY AASHTO STANDARD METHOD T-99. GRANULAR FILL MAY BE SUBSTITUTED FOR TAMPED BACKFILL TO TOP OF THE PIPE.
3. HAND PLACED BACKFILL SHALL BE FINELY DIVIDED MATERIAL FREE FROM DEBRIS AND STONES.
4. ALL BEDDING DETAILS APPLY TO BUILDING SEWER SERVICE LINES AS WELL AS OTHER SEWERS.
5. CONCRETE CRADLE SHALL BE USED WHEN TRENCH WIDTH EXCEEDS 24" PLUS THE PIPE DIAMETER.
6. PVC PIPE SHALL BE BEDDED IN ACCORDANCE WITH ASTM D 2321 USING CLASS I (3/4" TO 1/4") GRANULAR MATERIAL.

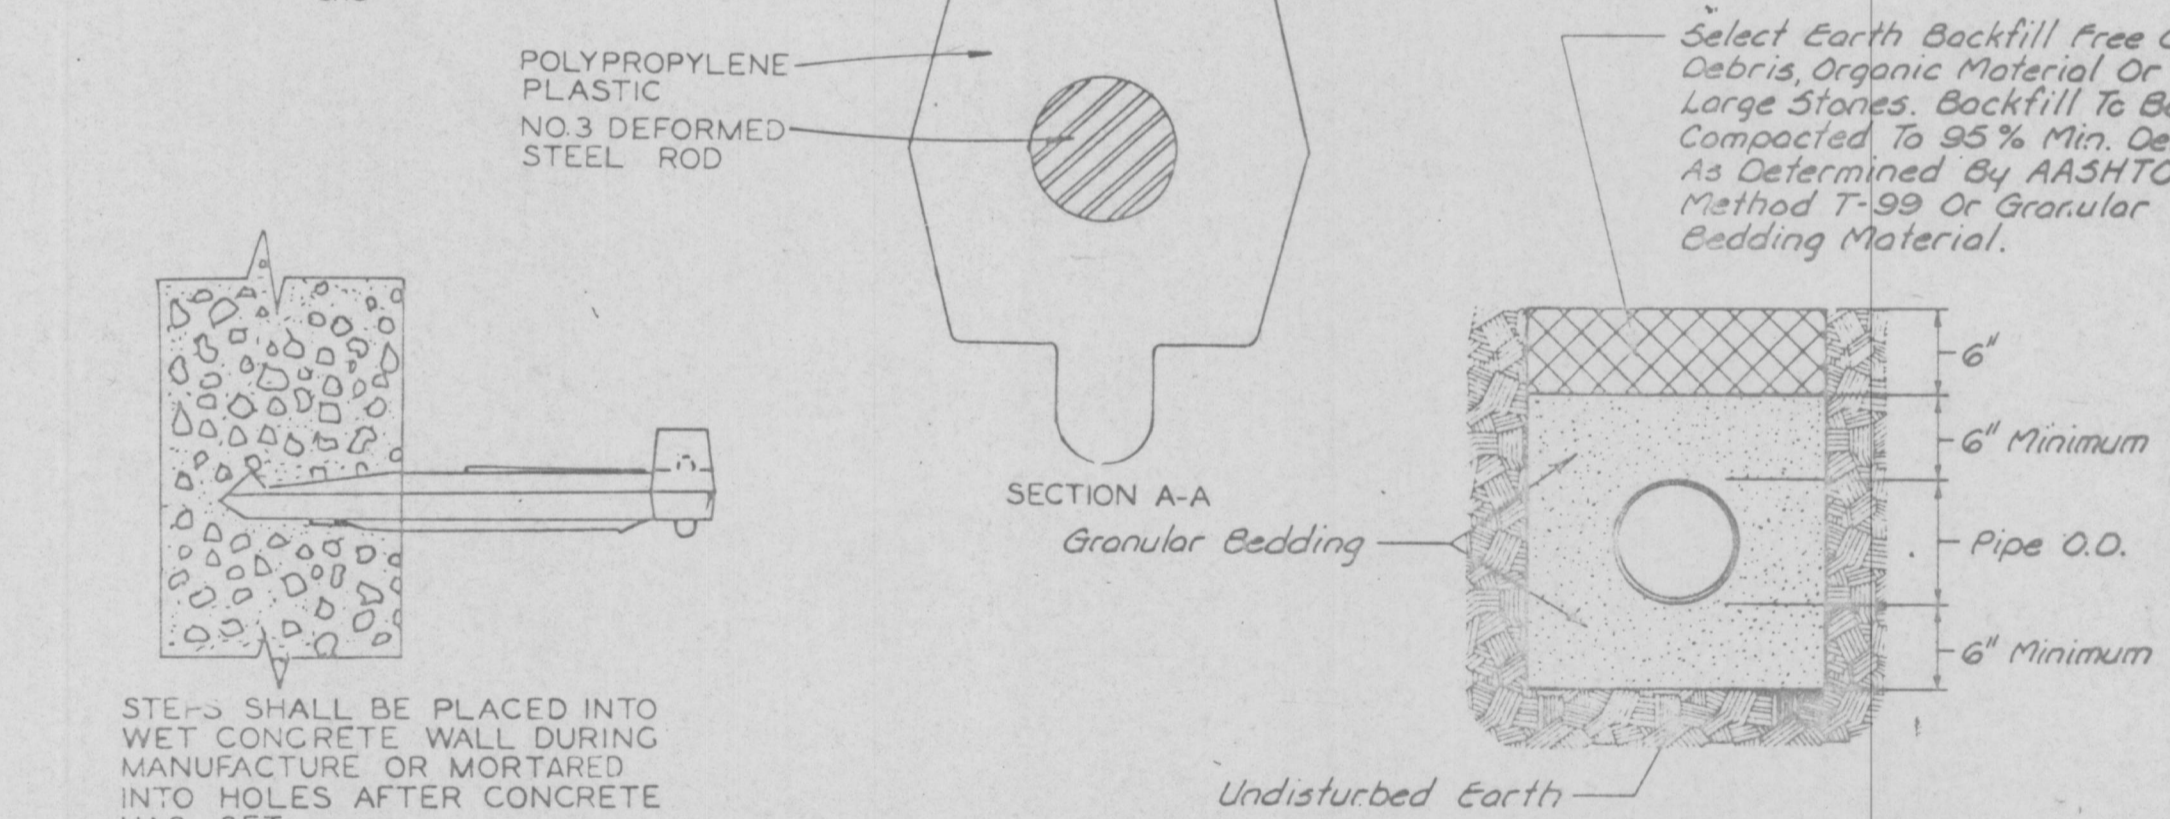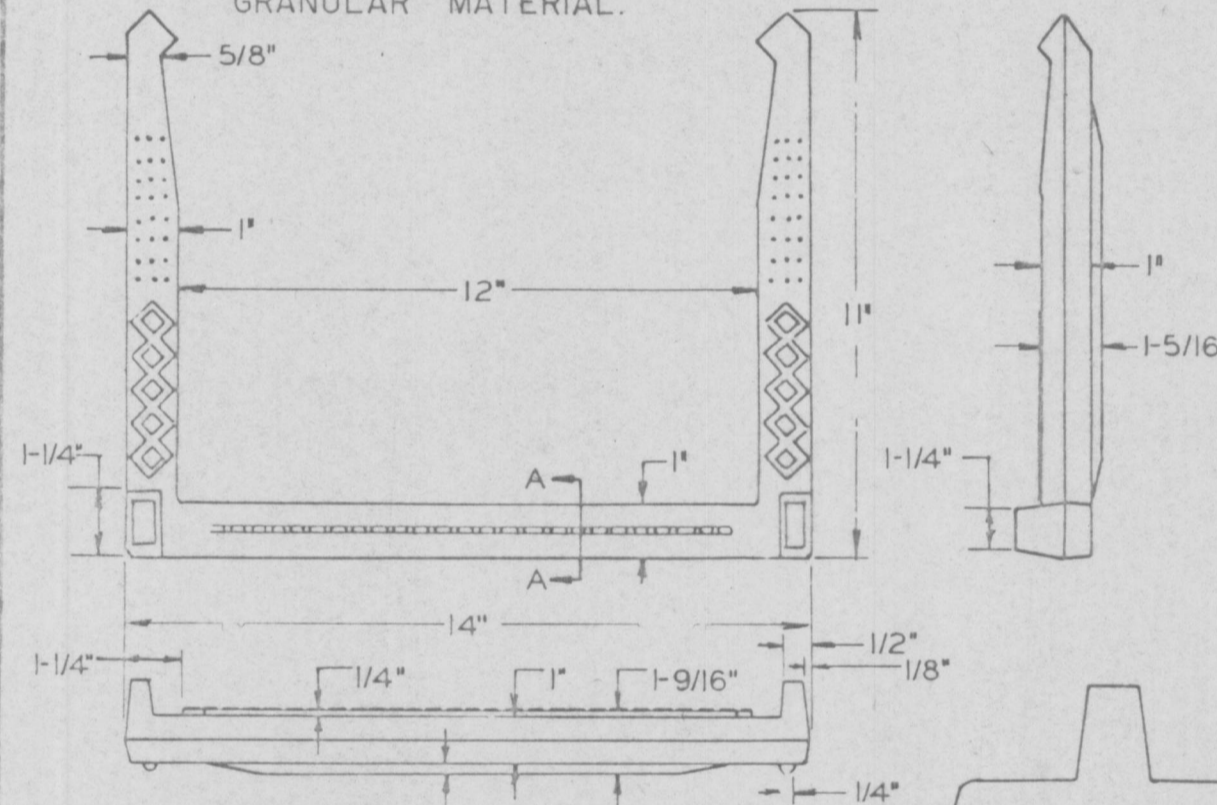

STEPS SHALL BE PLACED INTO WET CONCRETE WALL DURING MANUFACTURE OR MORTARED INTO HOLES AFTER CONCRETE HAS SET.

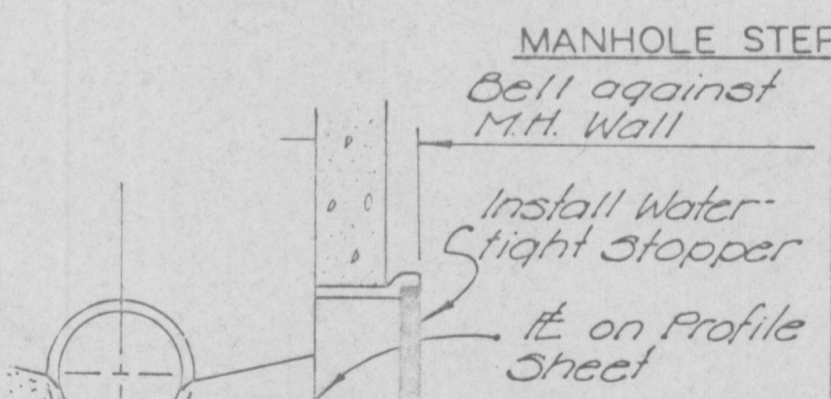

MANHOLE STUBOUT

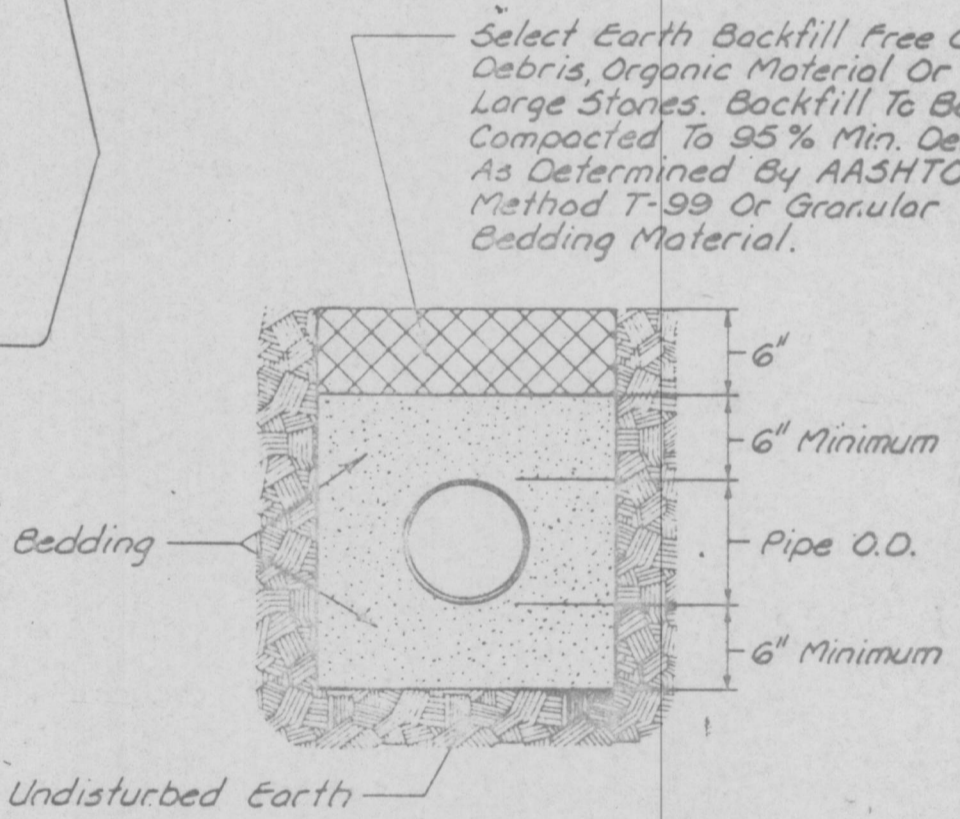

FLEXIBLE PIPE BEDDING DETAIL

GBA
GEORGE BUTLER ASSOCIATES
CONSULTING ENGINEERS ARCHITECTS
LANDSCAPE ARCHITECTS PLANNERS

OFFICES:
SUITE 300-A FAIRWAY OFFICE CENTER
4710 JOHNSON DRIVE - SHAWNEE MISSION KANSAS 66205
1100 CITY CENTER SQUARE
1100 MAIN / KANSAS CITY / MISSOURI 64108
SUITE 134 LAKE SIDE PLAZA B
6700 CORPORATE DRIVE - KANSAS CITY MISSOURI 64120

SANITARY SEWER DETAILS

DESIGNED BY GRH DRAWN BY JG CHECKED BY GRH

JOB NO	6803
DATE	JUNE 1993
SCALE	As Shown
SHEET	8 OF 9

AS-BUILT-S.G-5/23/94