


WATER AS-BUILTS FOR HOMEFIELD SQUARE - VILLAGE P

A TRACT OF LAND BEING PART OF
FRACTIONAL SECTION 16, TOWNSHIP 47 NORTH,
RANGE 3 EAST OF THE FIFTH PRINCIPAL MERIDIAN,
CITY OF O'FALLON, ST. CHARLES COUNTY, MISSOURI

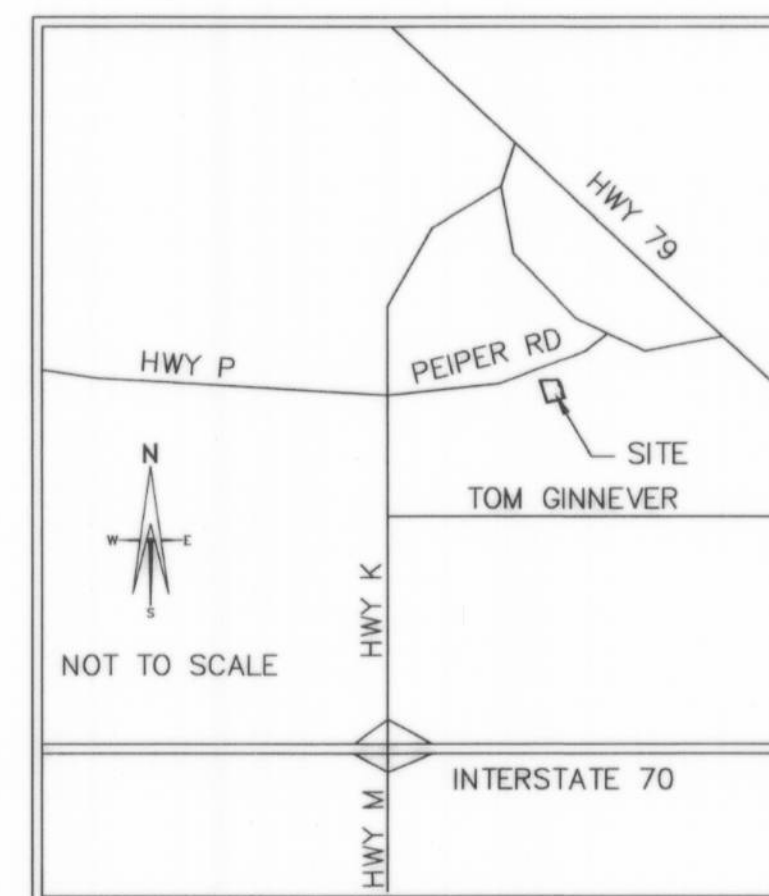

LOCATION MAP

DEVELOPMENT NOTES

1. AREA OF TRACT 12.23 ACRES
2. SITE SERVED BY:

CITY OF O'FALLON SEWER DISTRICT
AMERENUE ELECTRIC COMPANY
ST. CHARLES GAS COMPANY
CITY OF O'FALLON WATER
VERISON TELEPHONE COMPANY
FORT ZUMWALT SCHOOL DISTRICT
O'FALLON FIRE PROTECTION DISTRICT

SHEET INDEX

COVER SHEET	1
FLAT PLAN	2

PREPARED FOR:

T.R. HUGHES INC.
239 FOX HILL ROAD
ST. CHARLES, MO. 63301

THE EXISTING FIRE HYDRANTS AND VALVES LOCATIONS WITH
RESPECT TO EXISTING OR PROPOSED EASEMENTS HAVE BEEN
MEASURED. THE RESULTS OF THOSE MEASUREMENTS ARE SHOWN ON
THIS SET OF AS-BUILT PLANS.

ST. CHARLES ENGINEERING AND SURVEYING, INC.

ENGINEERS AUTHENTICATION


The responsibility for professional engineering liability on this project
is hereby limited to the set of plans authenticated by the seal,
signature, and date hereunder attached. responsibility is disclaimed
for all other engineering plans involved in the project and
specifically excludes revisions after this date unless
re-authenticated.

Michael Newell Meinert 9/9/03
MICHAEL NEWELL MEINERTS
MISSOURI PROFESSIONAL ENGINEER NUMBER E-22483

HOMEFIELD SQUARE
VILLAGE P
WATER
AS-BUILTS

ST. CHARLES ENGINEERING & SURVEYING, INC.
801 S. FIFTH STREET, SUITE 202
ST. CHARLES, MO 63301
TEL: (636) 947-0607 FAX: (636) 947-2448

SE

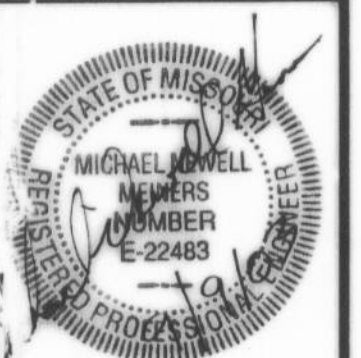

ORDER NO.



09-1153

DATE

09/09/03

1

Homefield Vill P App 5/1/03 ABC
Homefield Square Village P Water As built

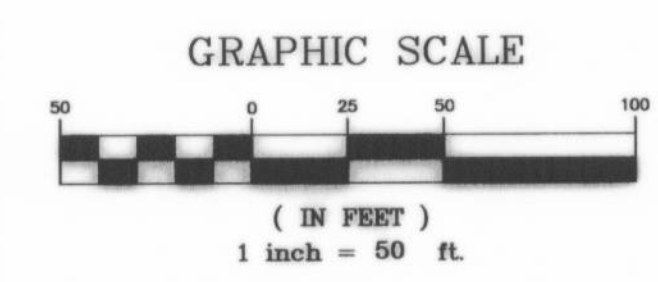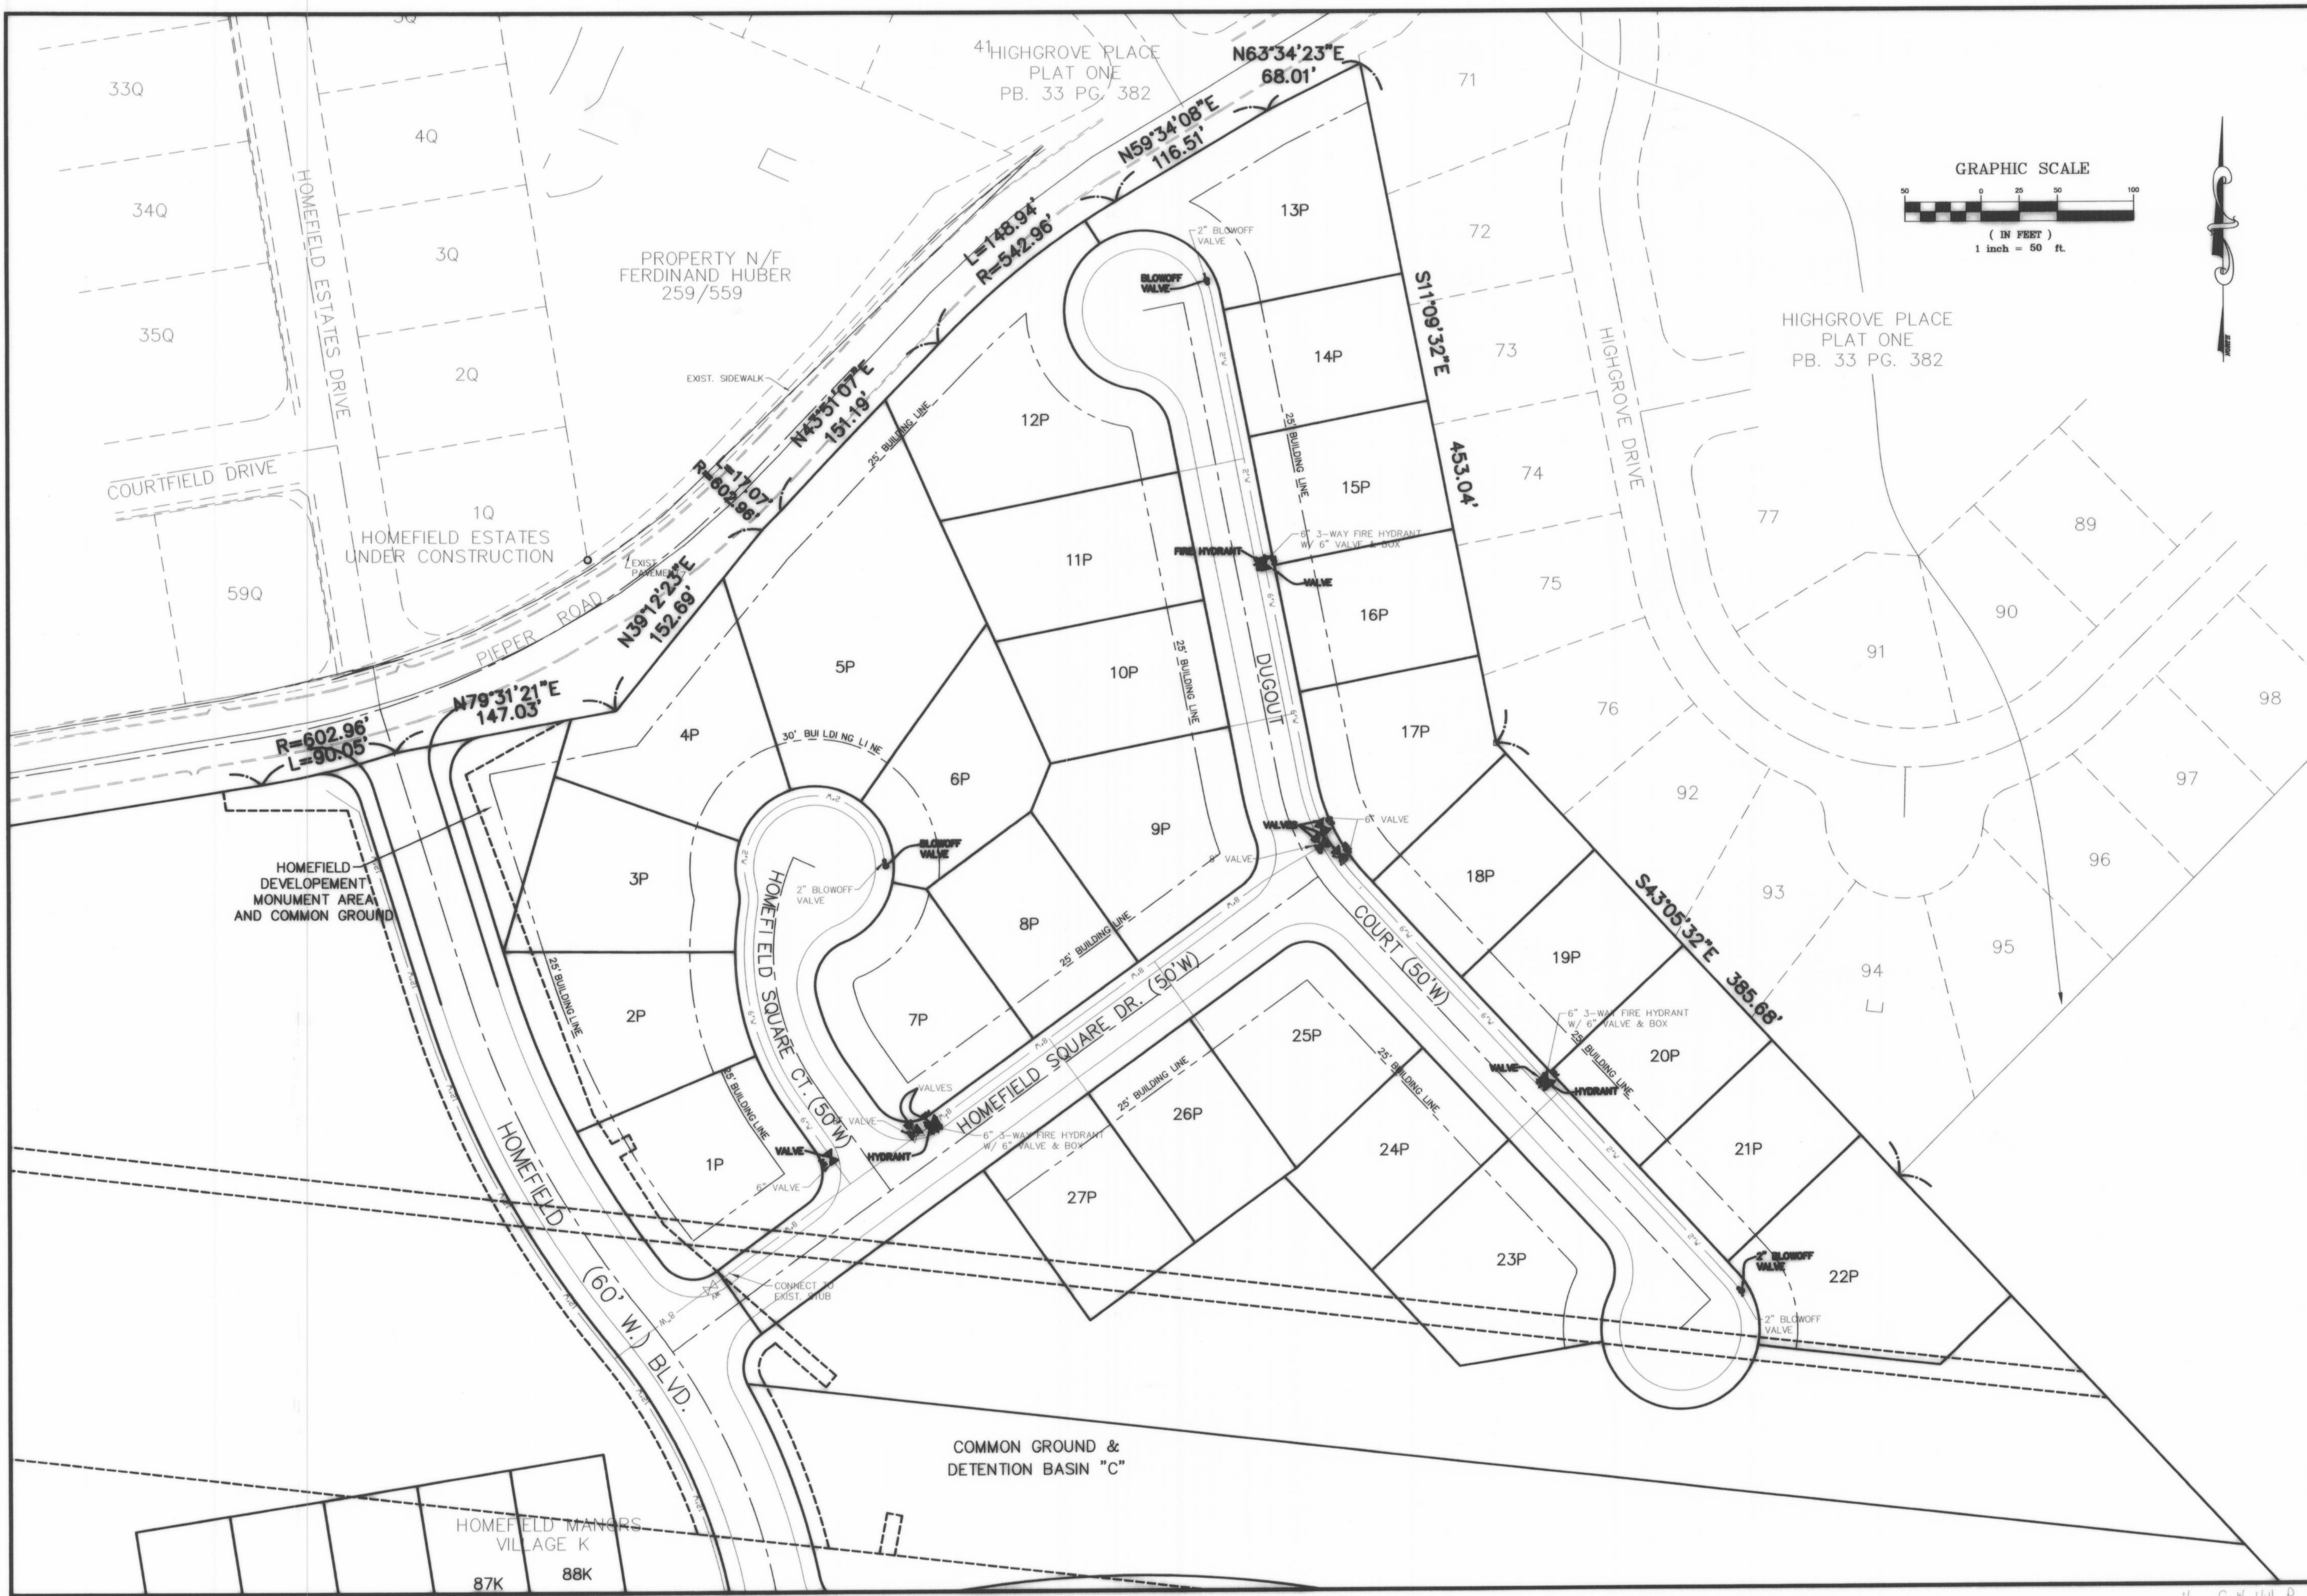

9/8/03		JESSICA SILVERBERG	
HOMEFIELD SQUARE VILLAGE P WATER AS-BUILTS			
ST. CHARLES ENGINEERING & SURVEYING, INC. 801 S. FIFTH STREET, SUITE 202 ST. CHARLES, MO 63301 TEL: (636) 947-0607 FAX: (636) 947-2446			
ORDER NO. 09-1153			
DATE 09/08/03			
1			

Homefield Vill P App S/M/05 ASB
Homefield Square Village P Water As-Built