


**NOTE:**  
Existing underground (U/G), overhead (O.H.) utilities and drainage structures have been plotted from available information and therefore, their locations must be considered approximate only. It is the responsibility of the individual contractors to notify the utility companies before actual construction.

Project Benchmark: "I" @ Doctor's Office, West of Highway "K" Near Southeast Corner of Building. Elev. 571.81

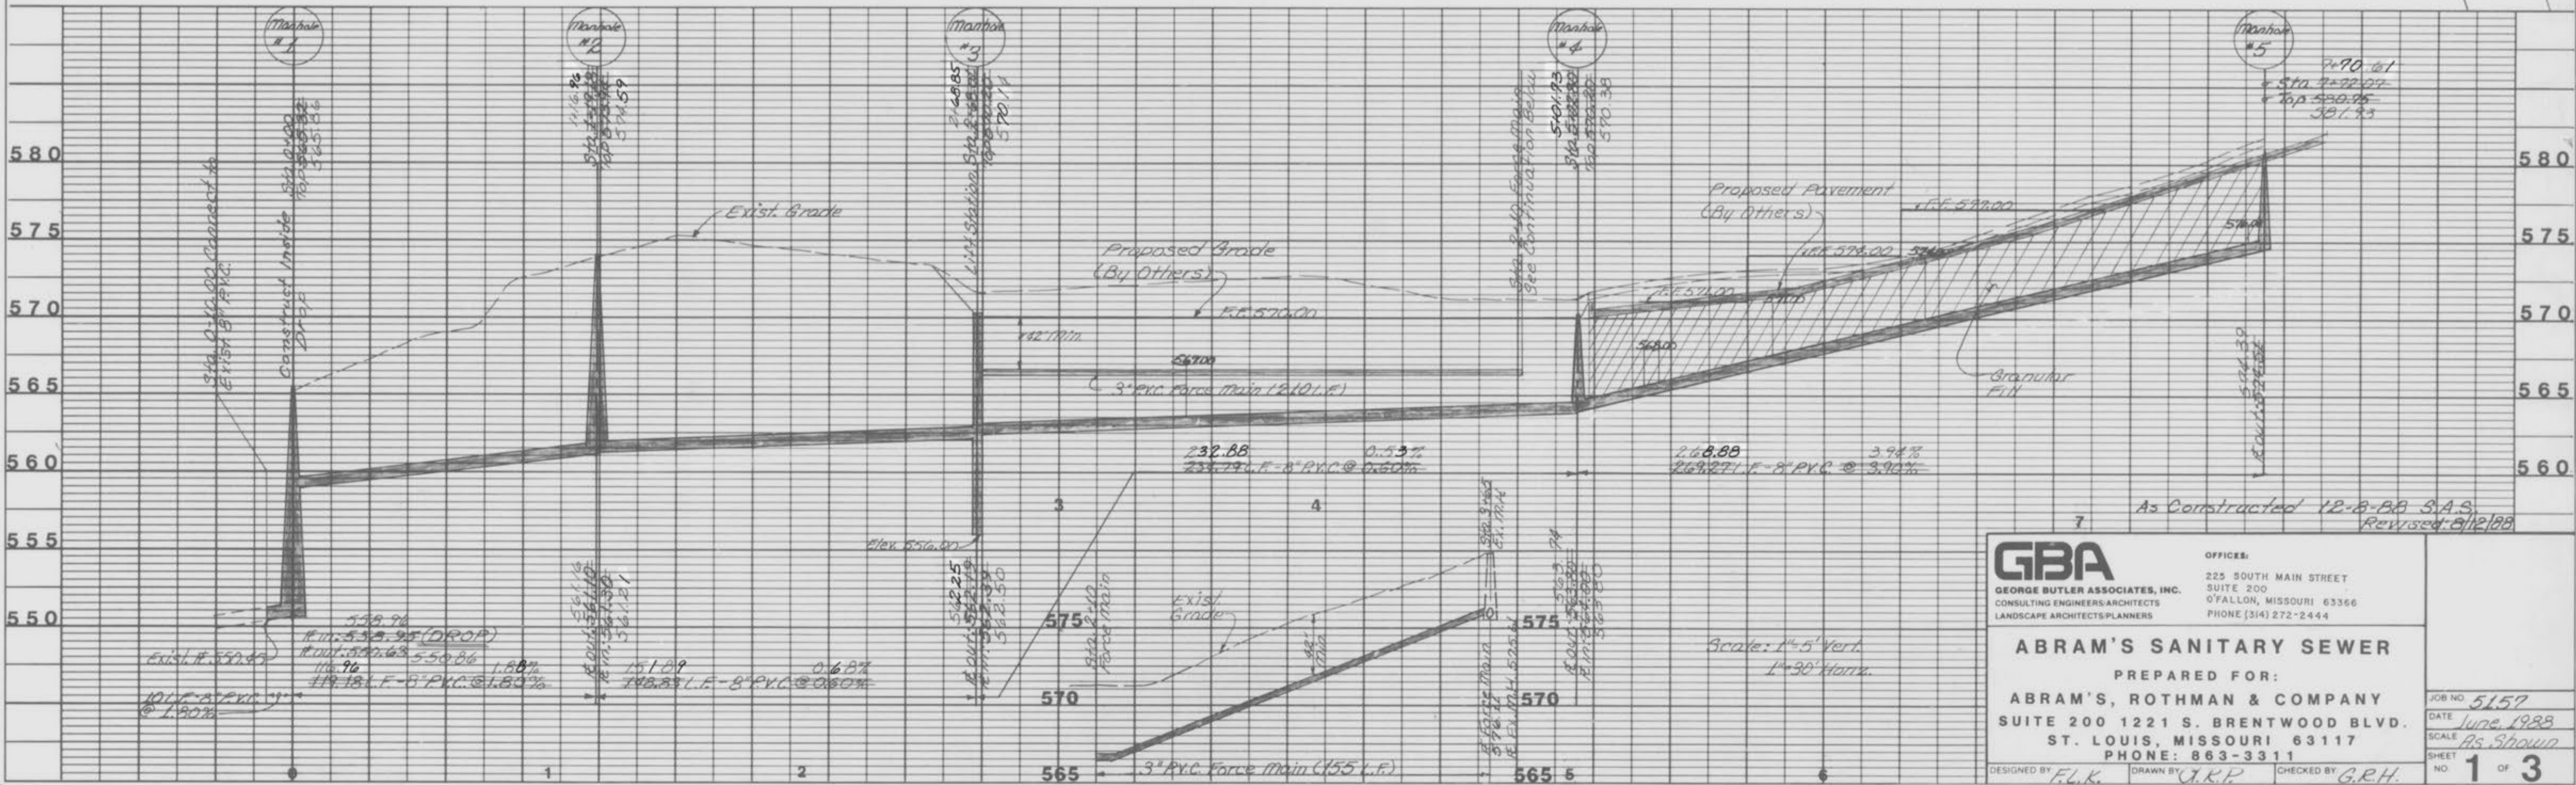

**GBA**  
GEORGE BUTLER ASSOCIATES, INC.  
CONSULTING ENGINEERS/ARCHITECTS  
LANDSCAPE ARCHITECTS/PLANNERS

OFFICES:  
225 SOUTH MAIN STREET  
SUITE 200  
O'FALLON, MISSOURI 63366  
PHONE (314) 272-2444

**ABRAM'S SANITARY SEWER**  
PREPARED FOR:  
**ABRAM'S, ROTHMAN & COMPANY**  
SUITE 200 1221 S. BRENTWOOD BLVD.  
ST. LOUIS, MISSOURI 63117  
PHONE: 863-3311

DESIGNED BY: *FLK* DRAWN BY: *GRP* CHECKED BY: *G.R.H.*

JOB NO. 5157  
DATE June 1988  
SCALE As Shown  
SHEET NO. 1 OF 3

PROPERTY OF  
CITY OF O'FALLON  
BUILDINGS DEPARTMENT